

STATE OF HAWAII


## DEPARTMENT OF TRANSPORTATION

HIGHWAYS DIVISION HONOLULU, HAWAII "AS-BUILT" PLANS FOR

## FARRINGTON HIGHWAY RESURFACING

PILIOKOE BRIDGE TO VICINITY OF ALIINUI DRIVE PROJECT NO. 93A-02-98M

DISTRICT OF EWA

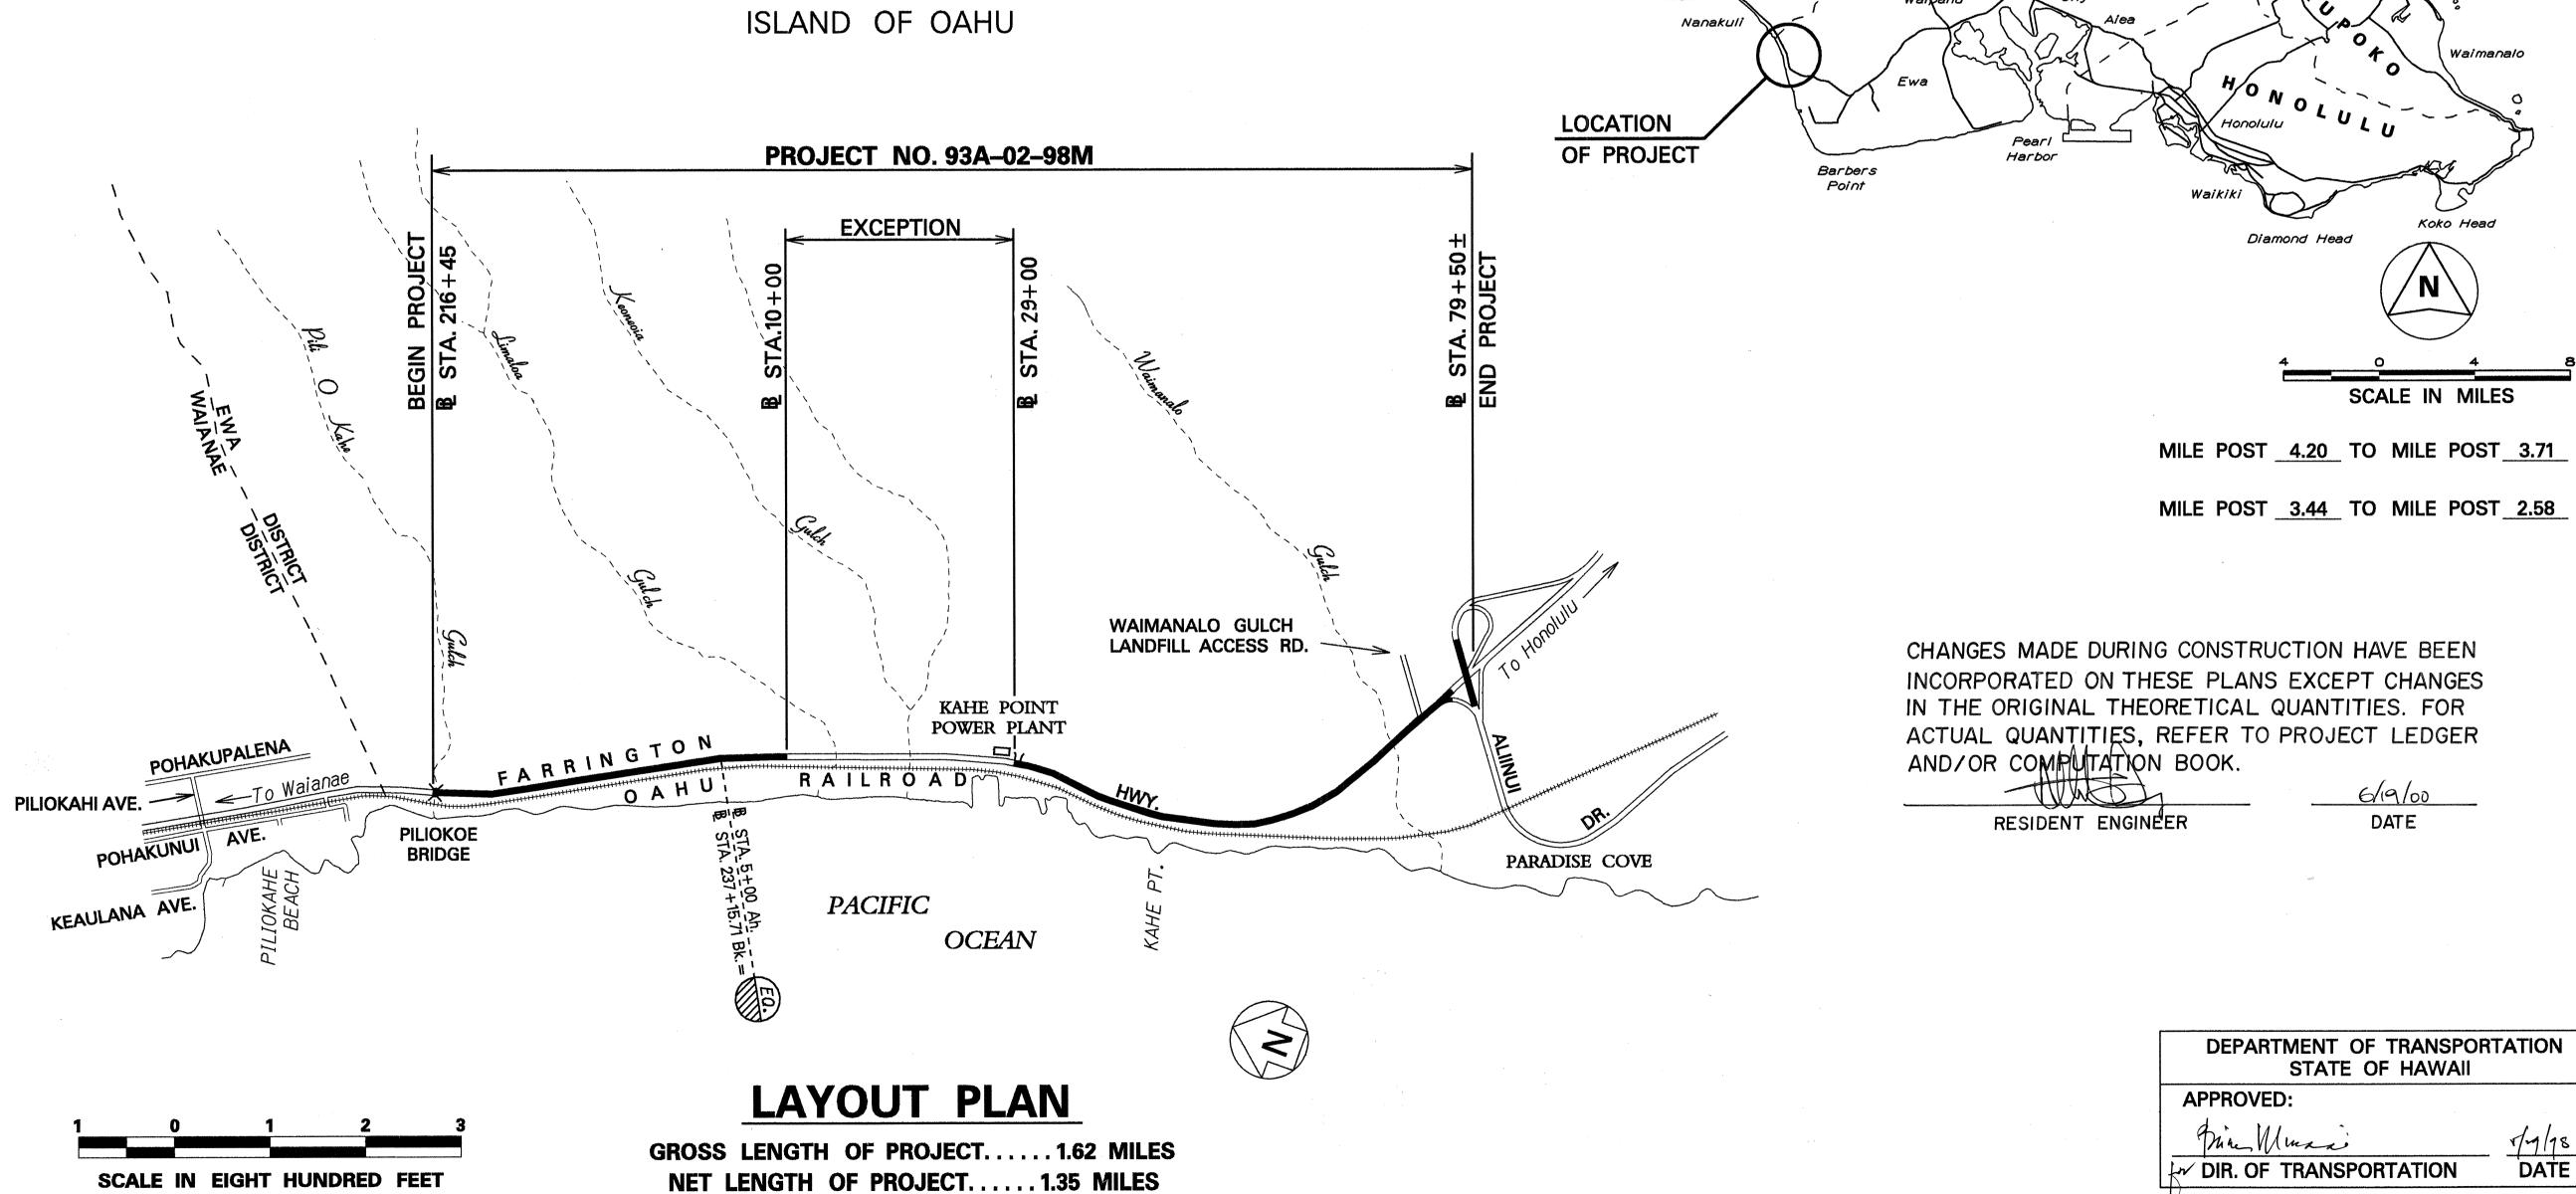

STATE OF HAWAII Waiahole

FED. ROAD DIST. NO.

FISCAL SHEET YEAR NO.

27

1998

PROJ. NO.

93A-02-98M