

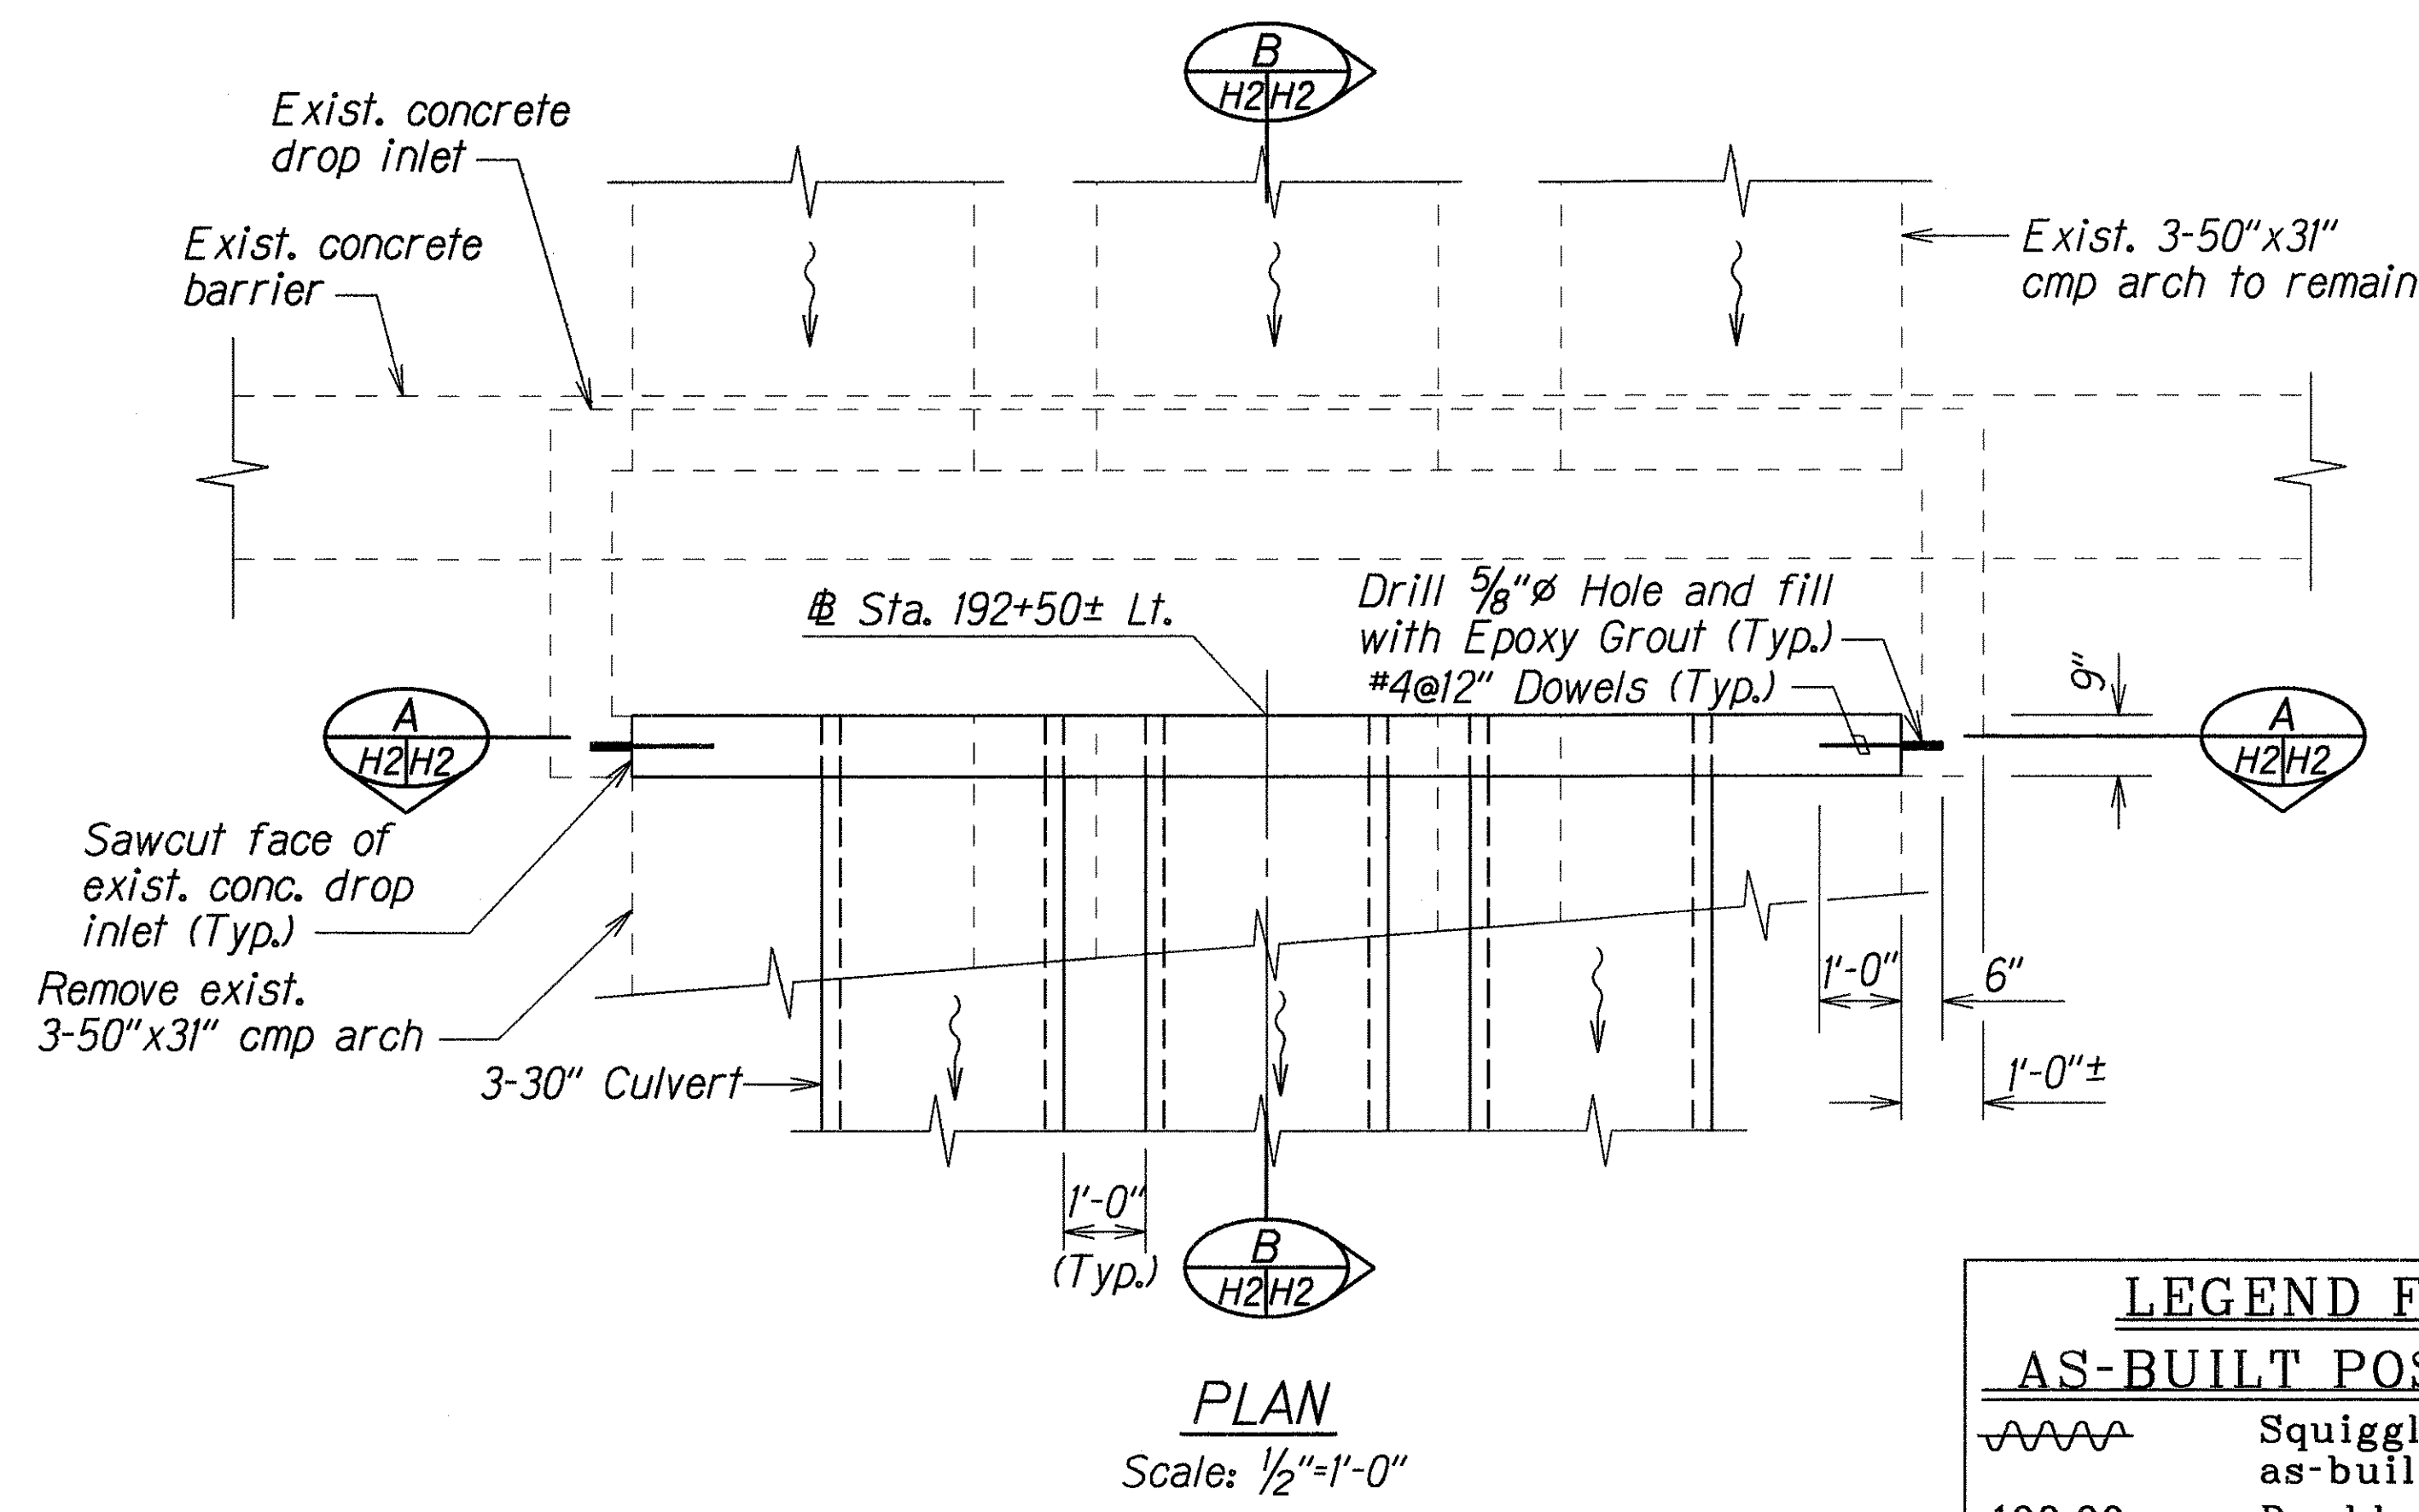
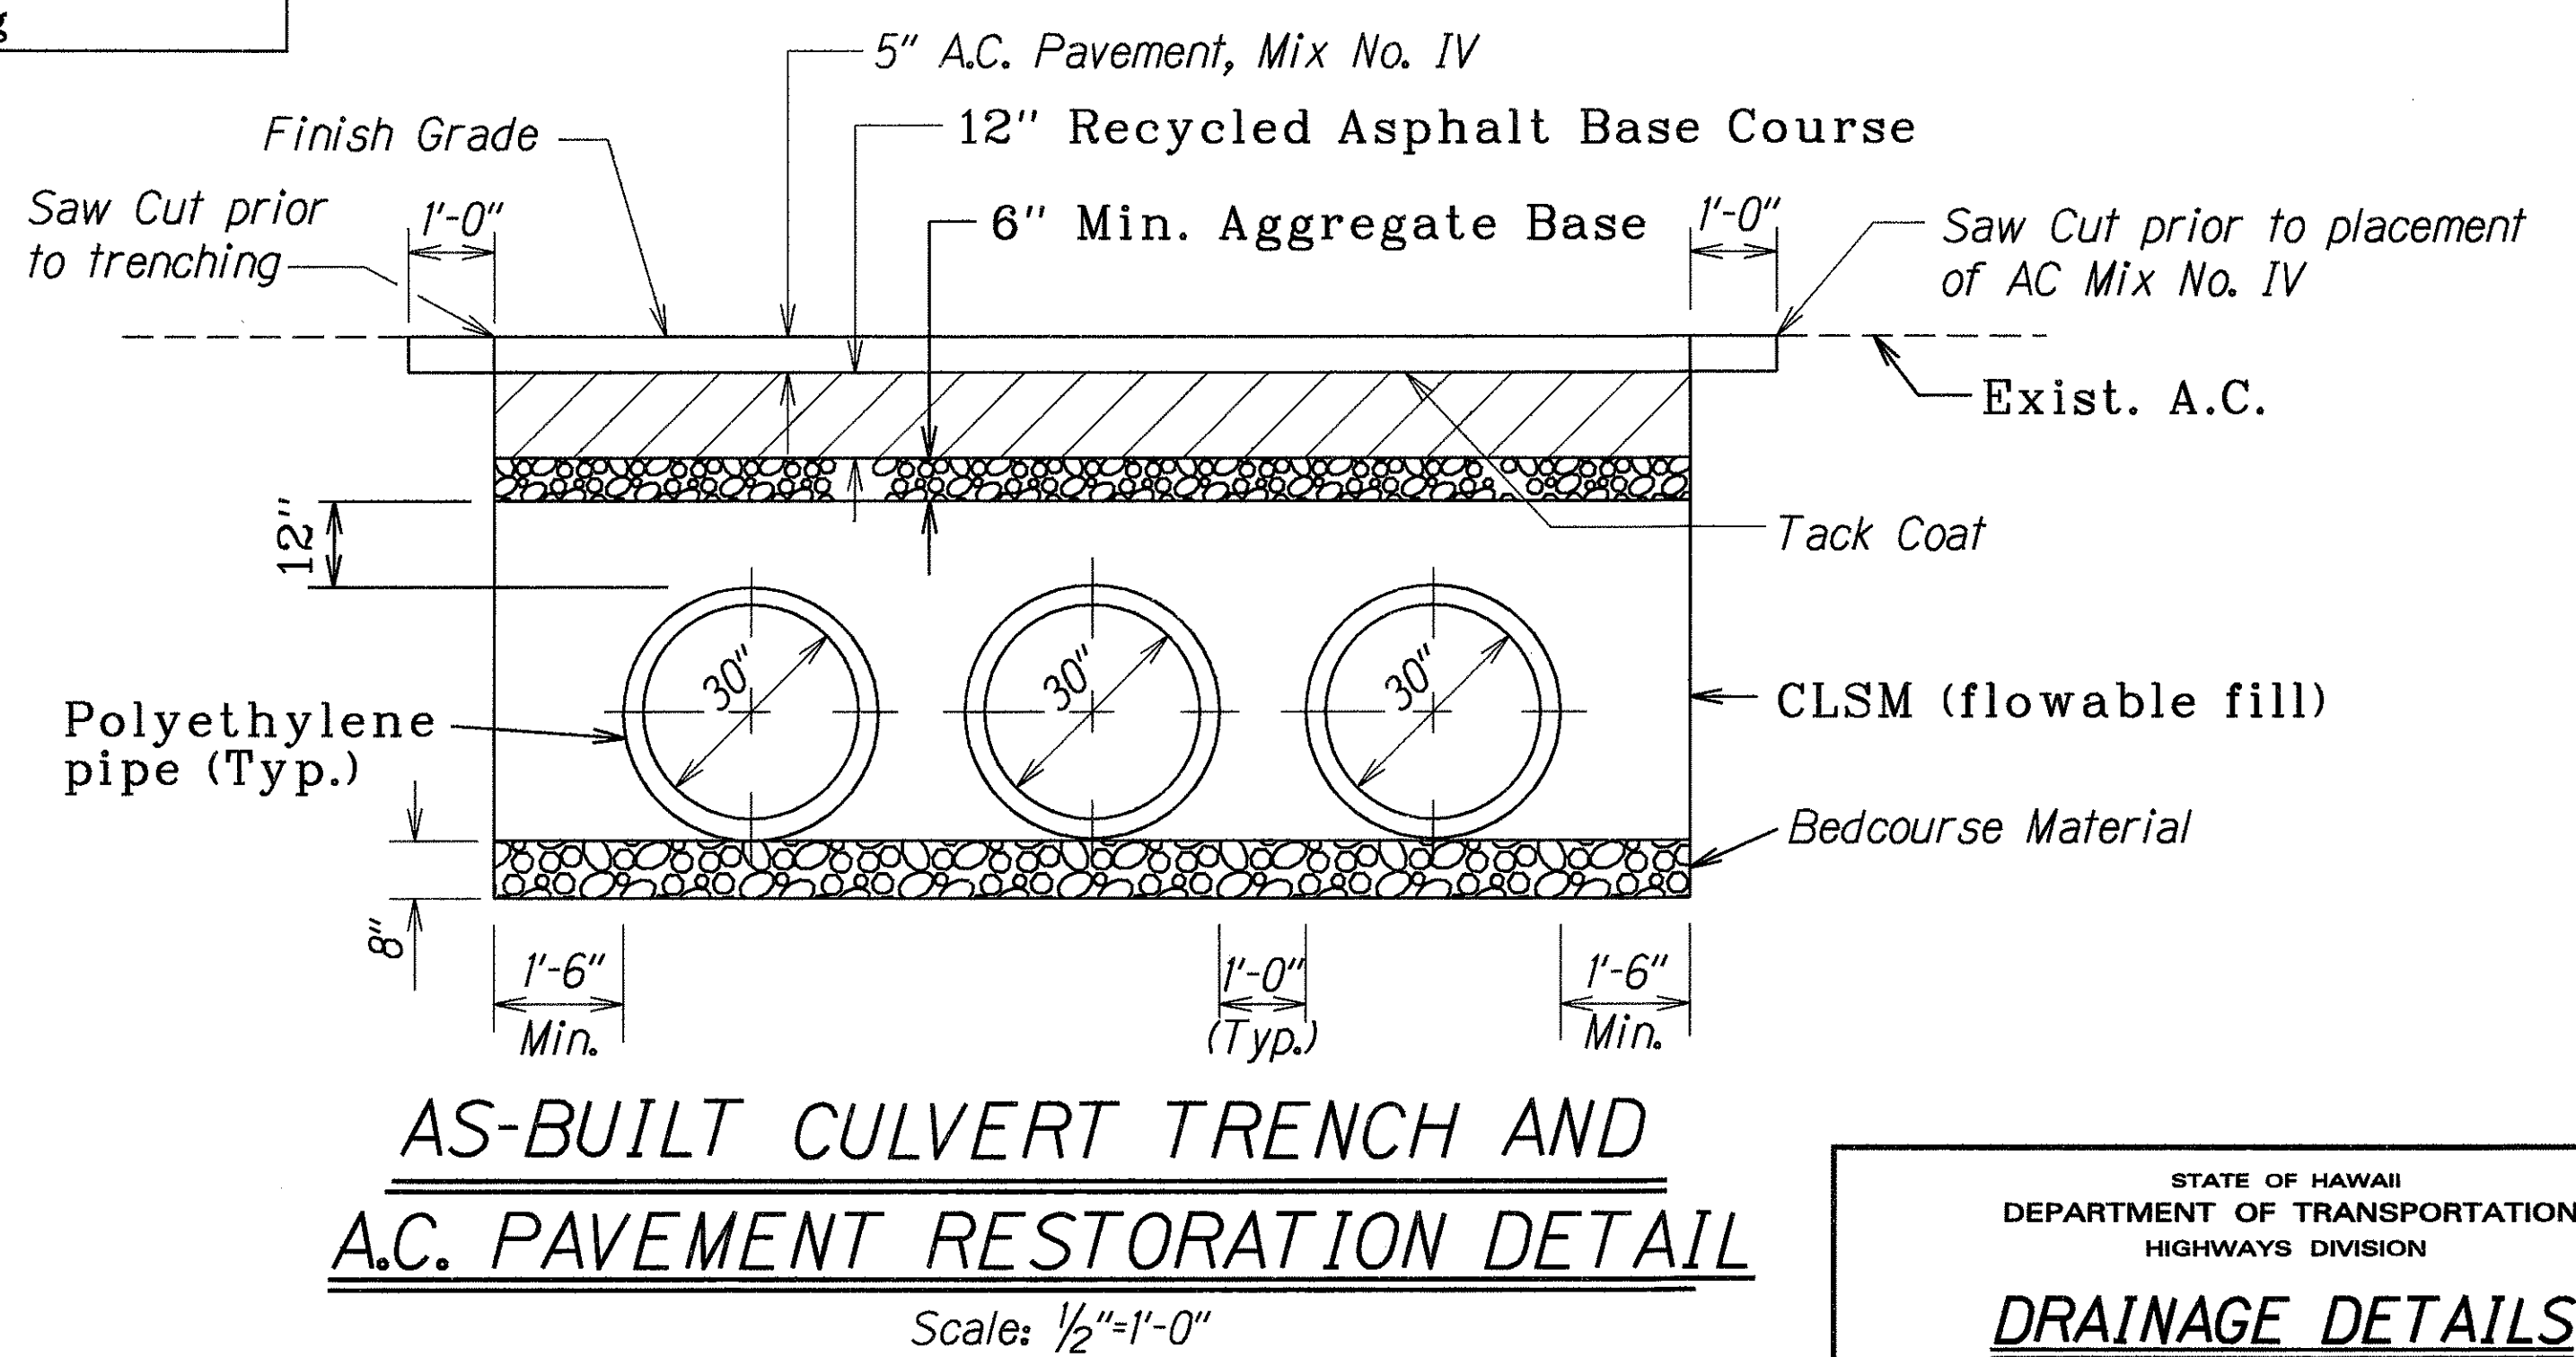


FED. ROAD DIST. NO.	STATE	PROJ. NO.	FISCAL YEAR	SHEET NO.	TOTAL SHEETS
HAWAII	HAW.	93A-03-98M	1998	4	5

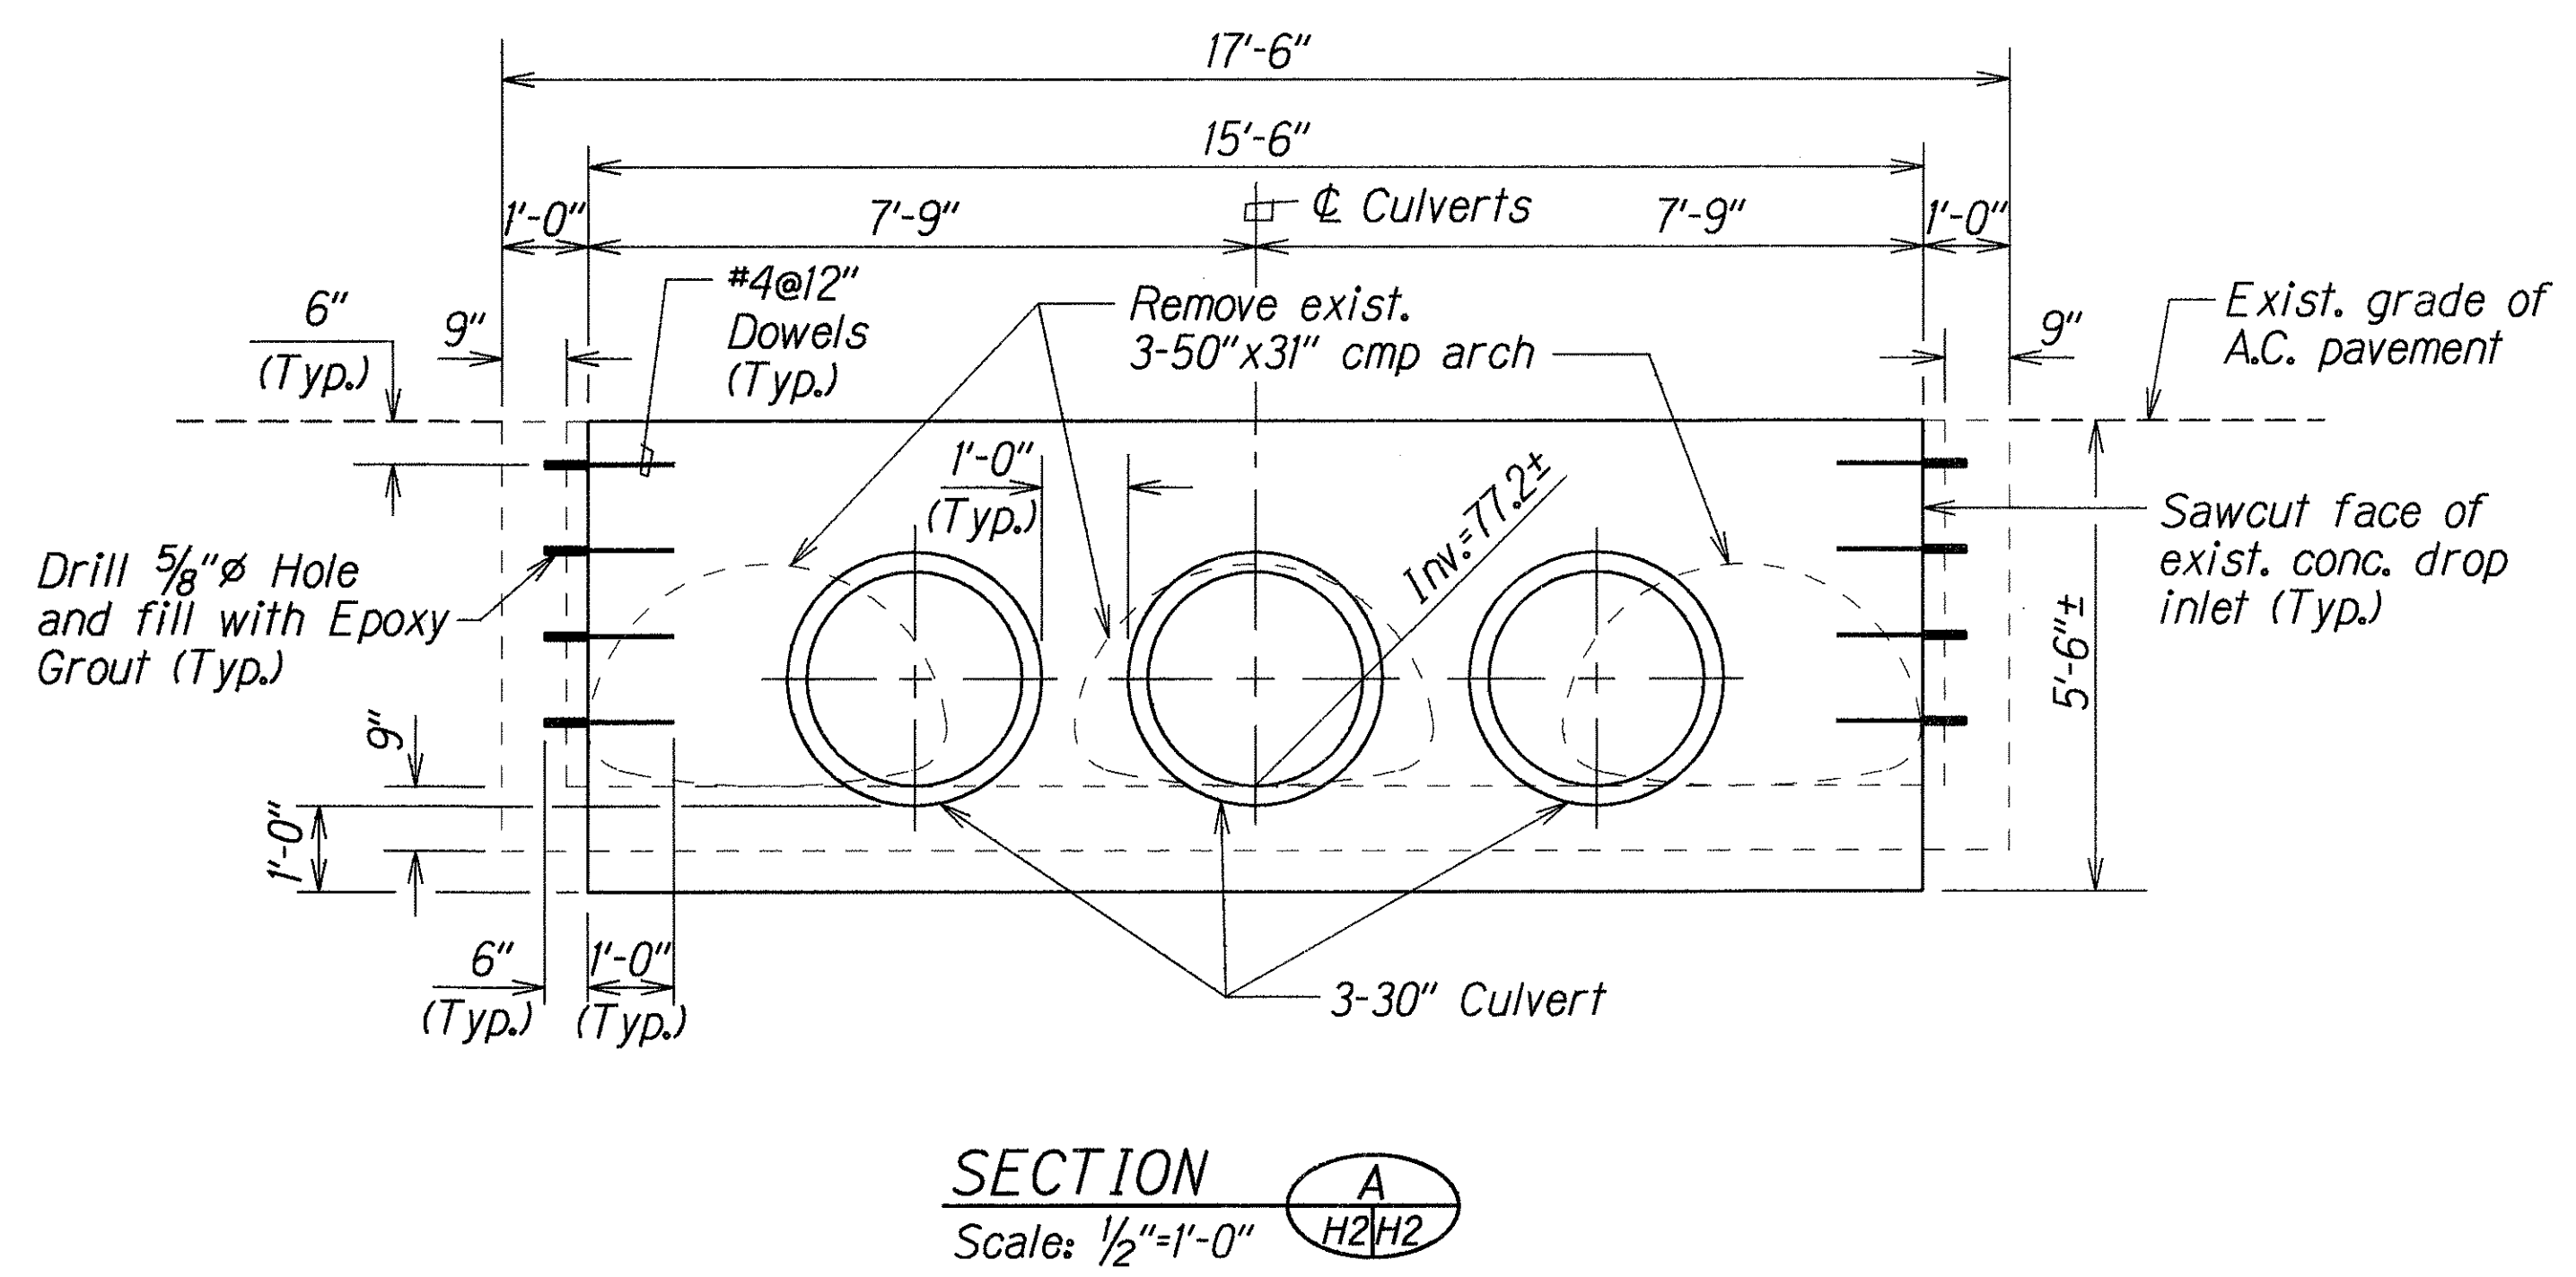

LEGEND FOR AS-BUILT POSTINGS	
	Squiggly line for as-built deletion
	Double line for as-built deletion
Roadway	Text for as-built posting

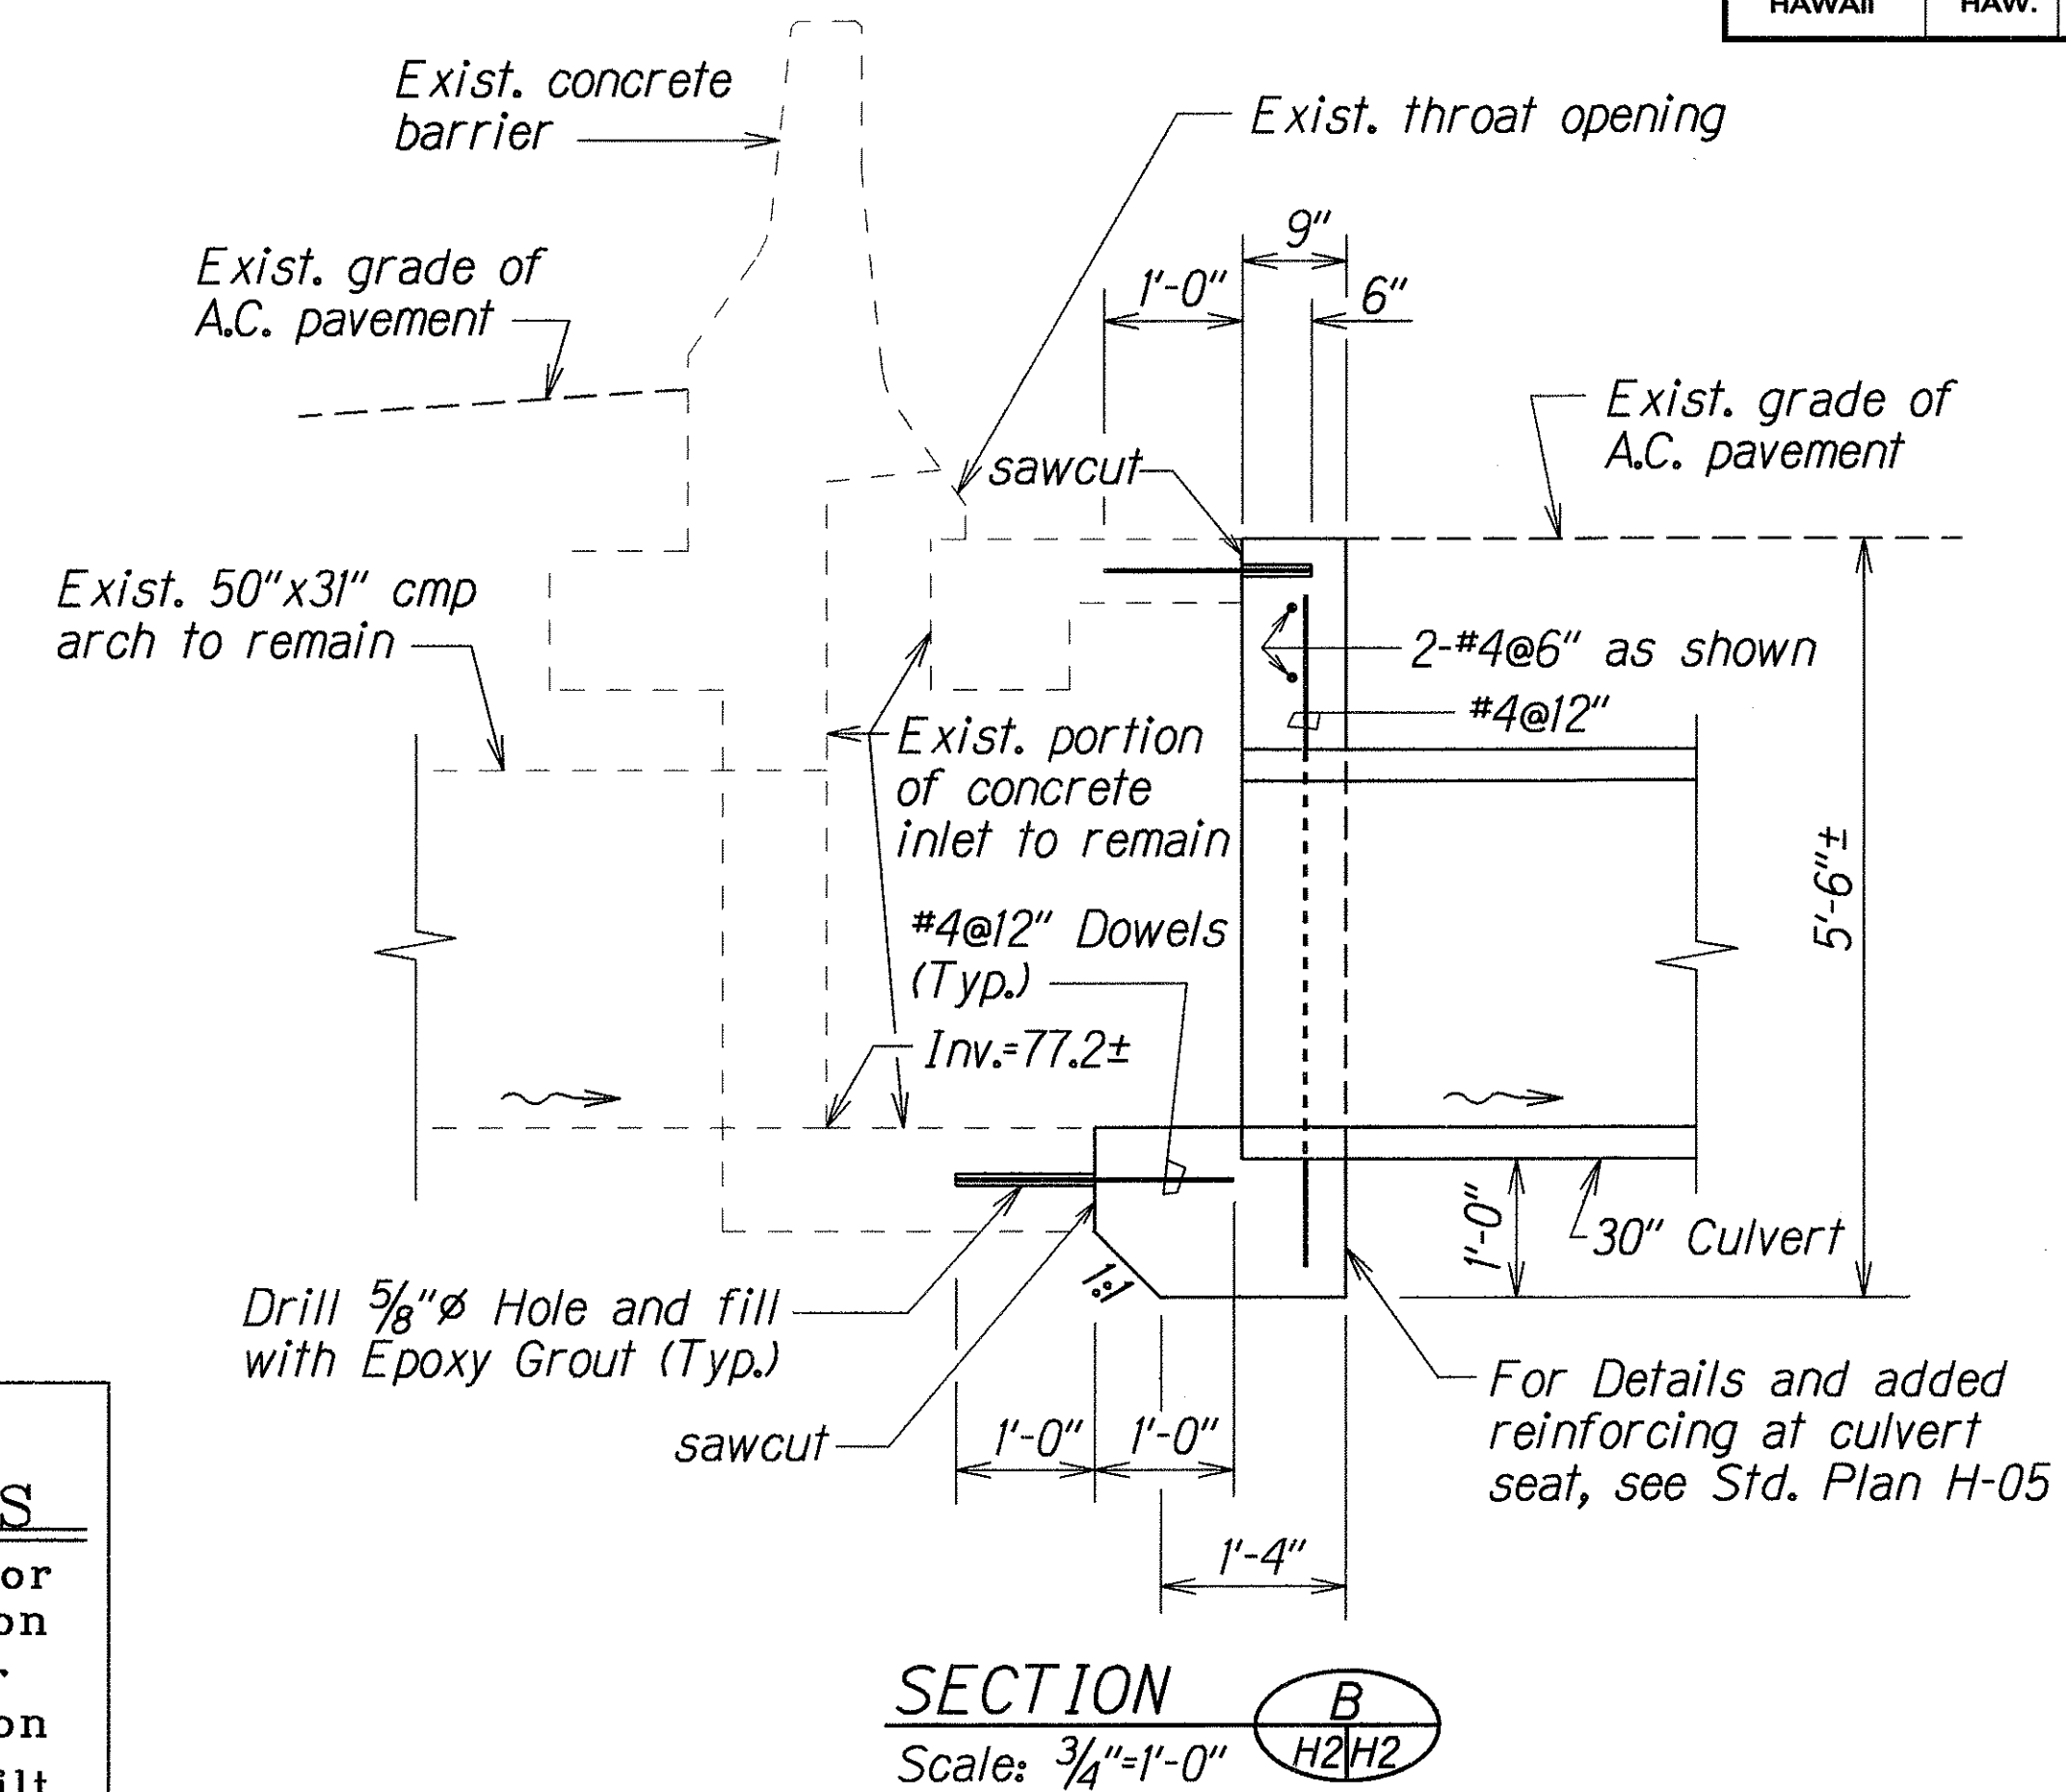

DETAILS OF 3-30" CULVERT CONNECTION TO MODIFIED CONCRETE DROP INLET

ORIGINAL PLAN	DATE
DESIGNED BY R. KAWAMURA, C. MALISIDA	1/7/98
CHECKED BY	






STATE OF HAWAII
DEPARTMENT OF TRANSPORTATION
HIGHWAYS DIVISION

DRAINAGE DETAILS
FARRINGTON HIGHWAY
Repair Triple CMP Culverts
at Palailai Interchange
Project No. 93A-03-98M

Scale: As Shown Date: Jan. 1998

SHEET No. H2 OF 3 SHEETS

FED. ROAD DIST. NO.	STATE	PROJ. NO.	FISCAL YEAR	SHEET NO.	TOTAL SHEETS
HAWAII	HAW.	93A-03-98M	1998	5	5

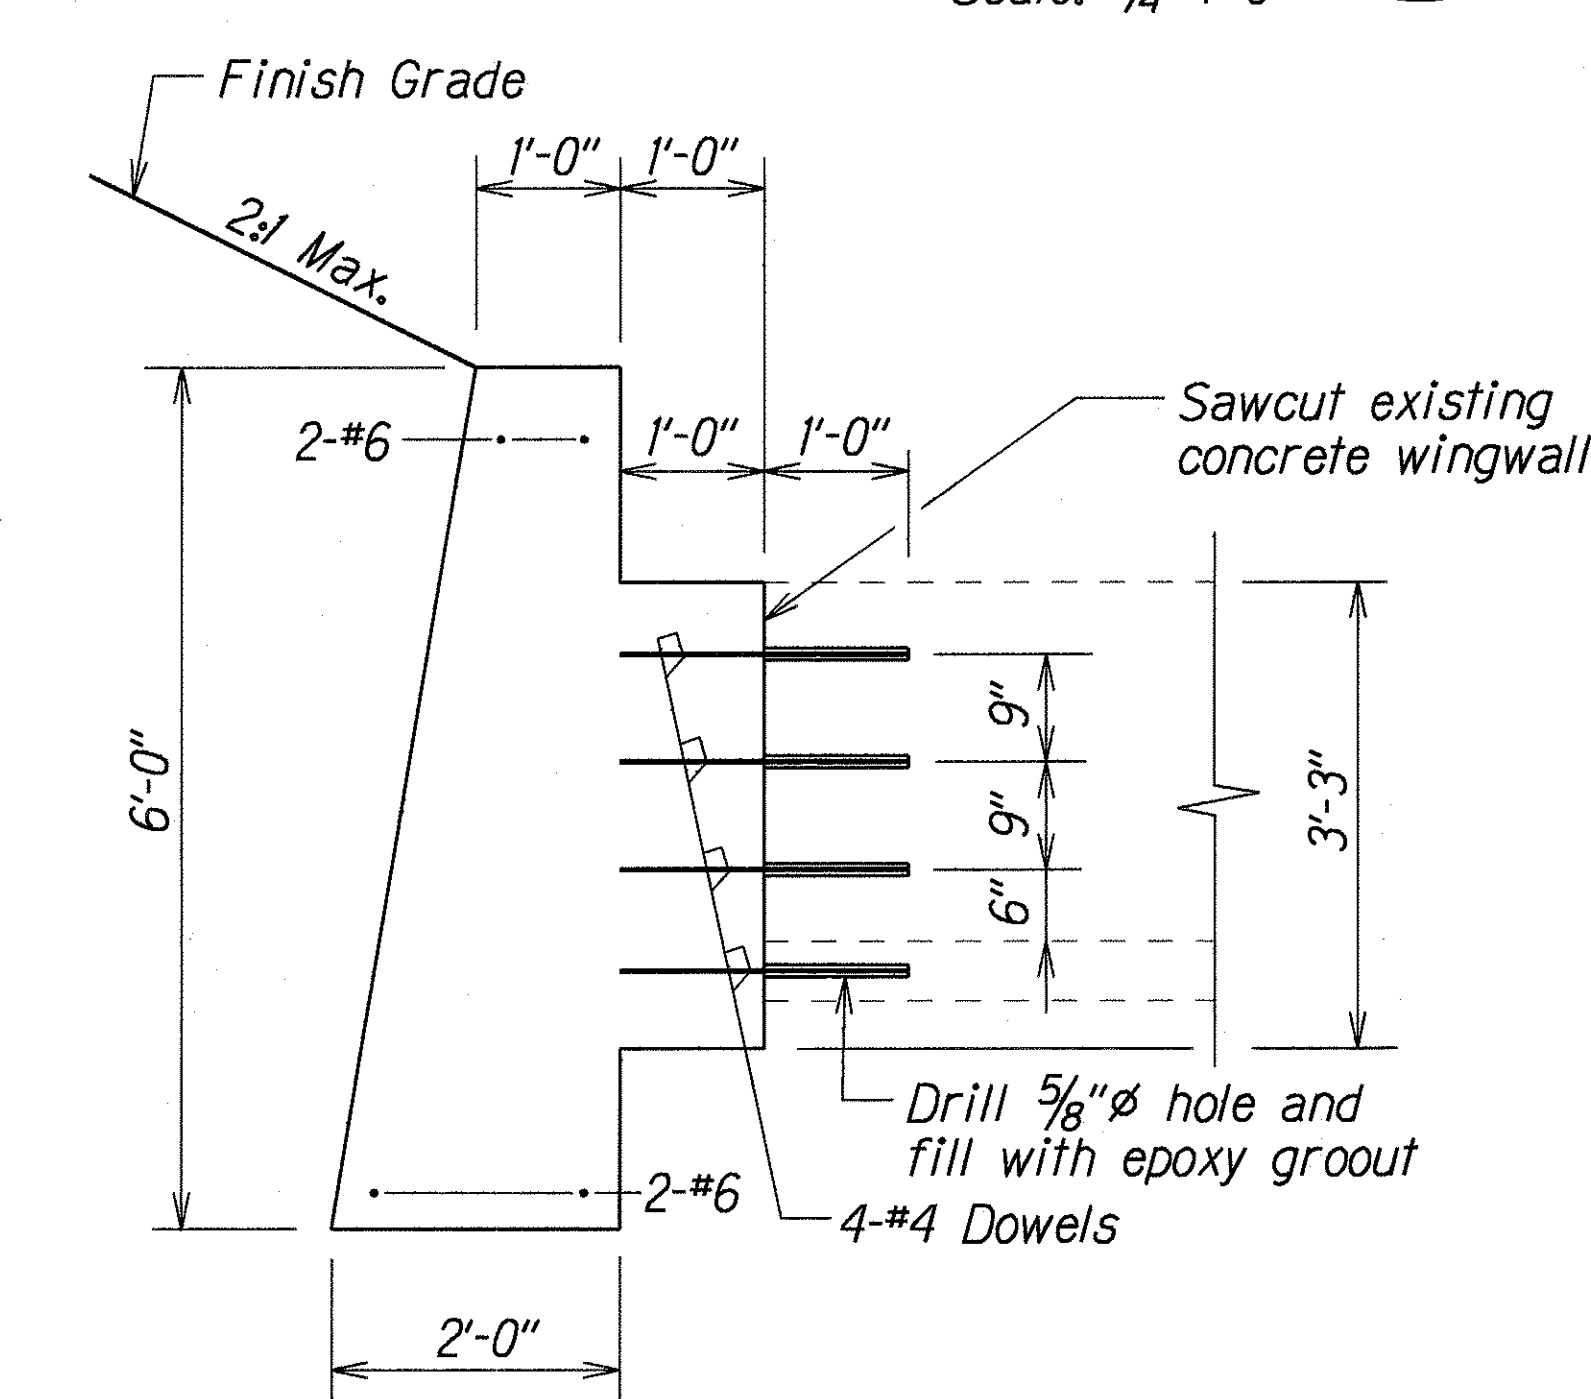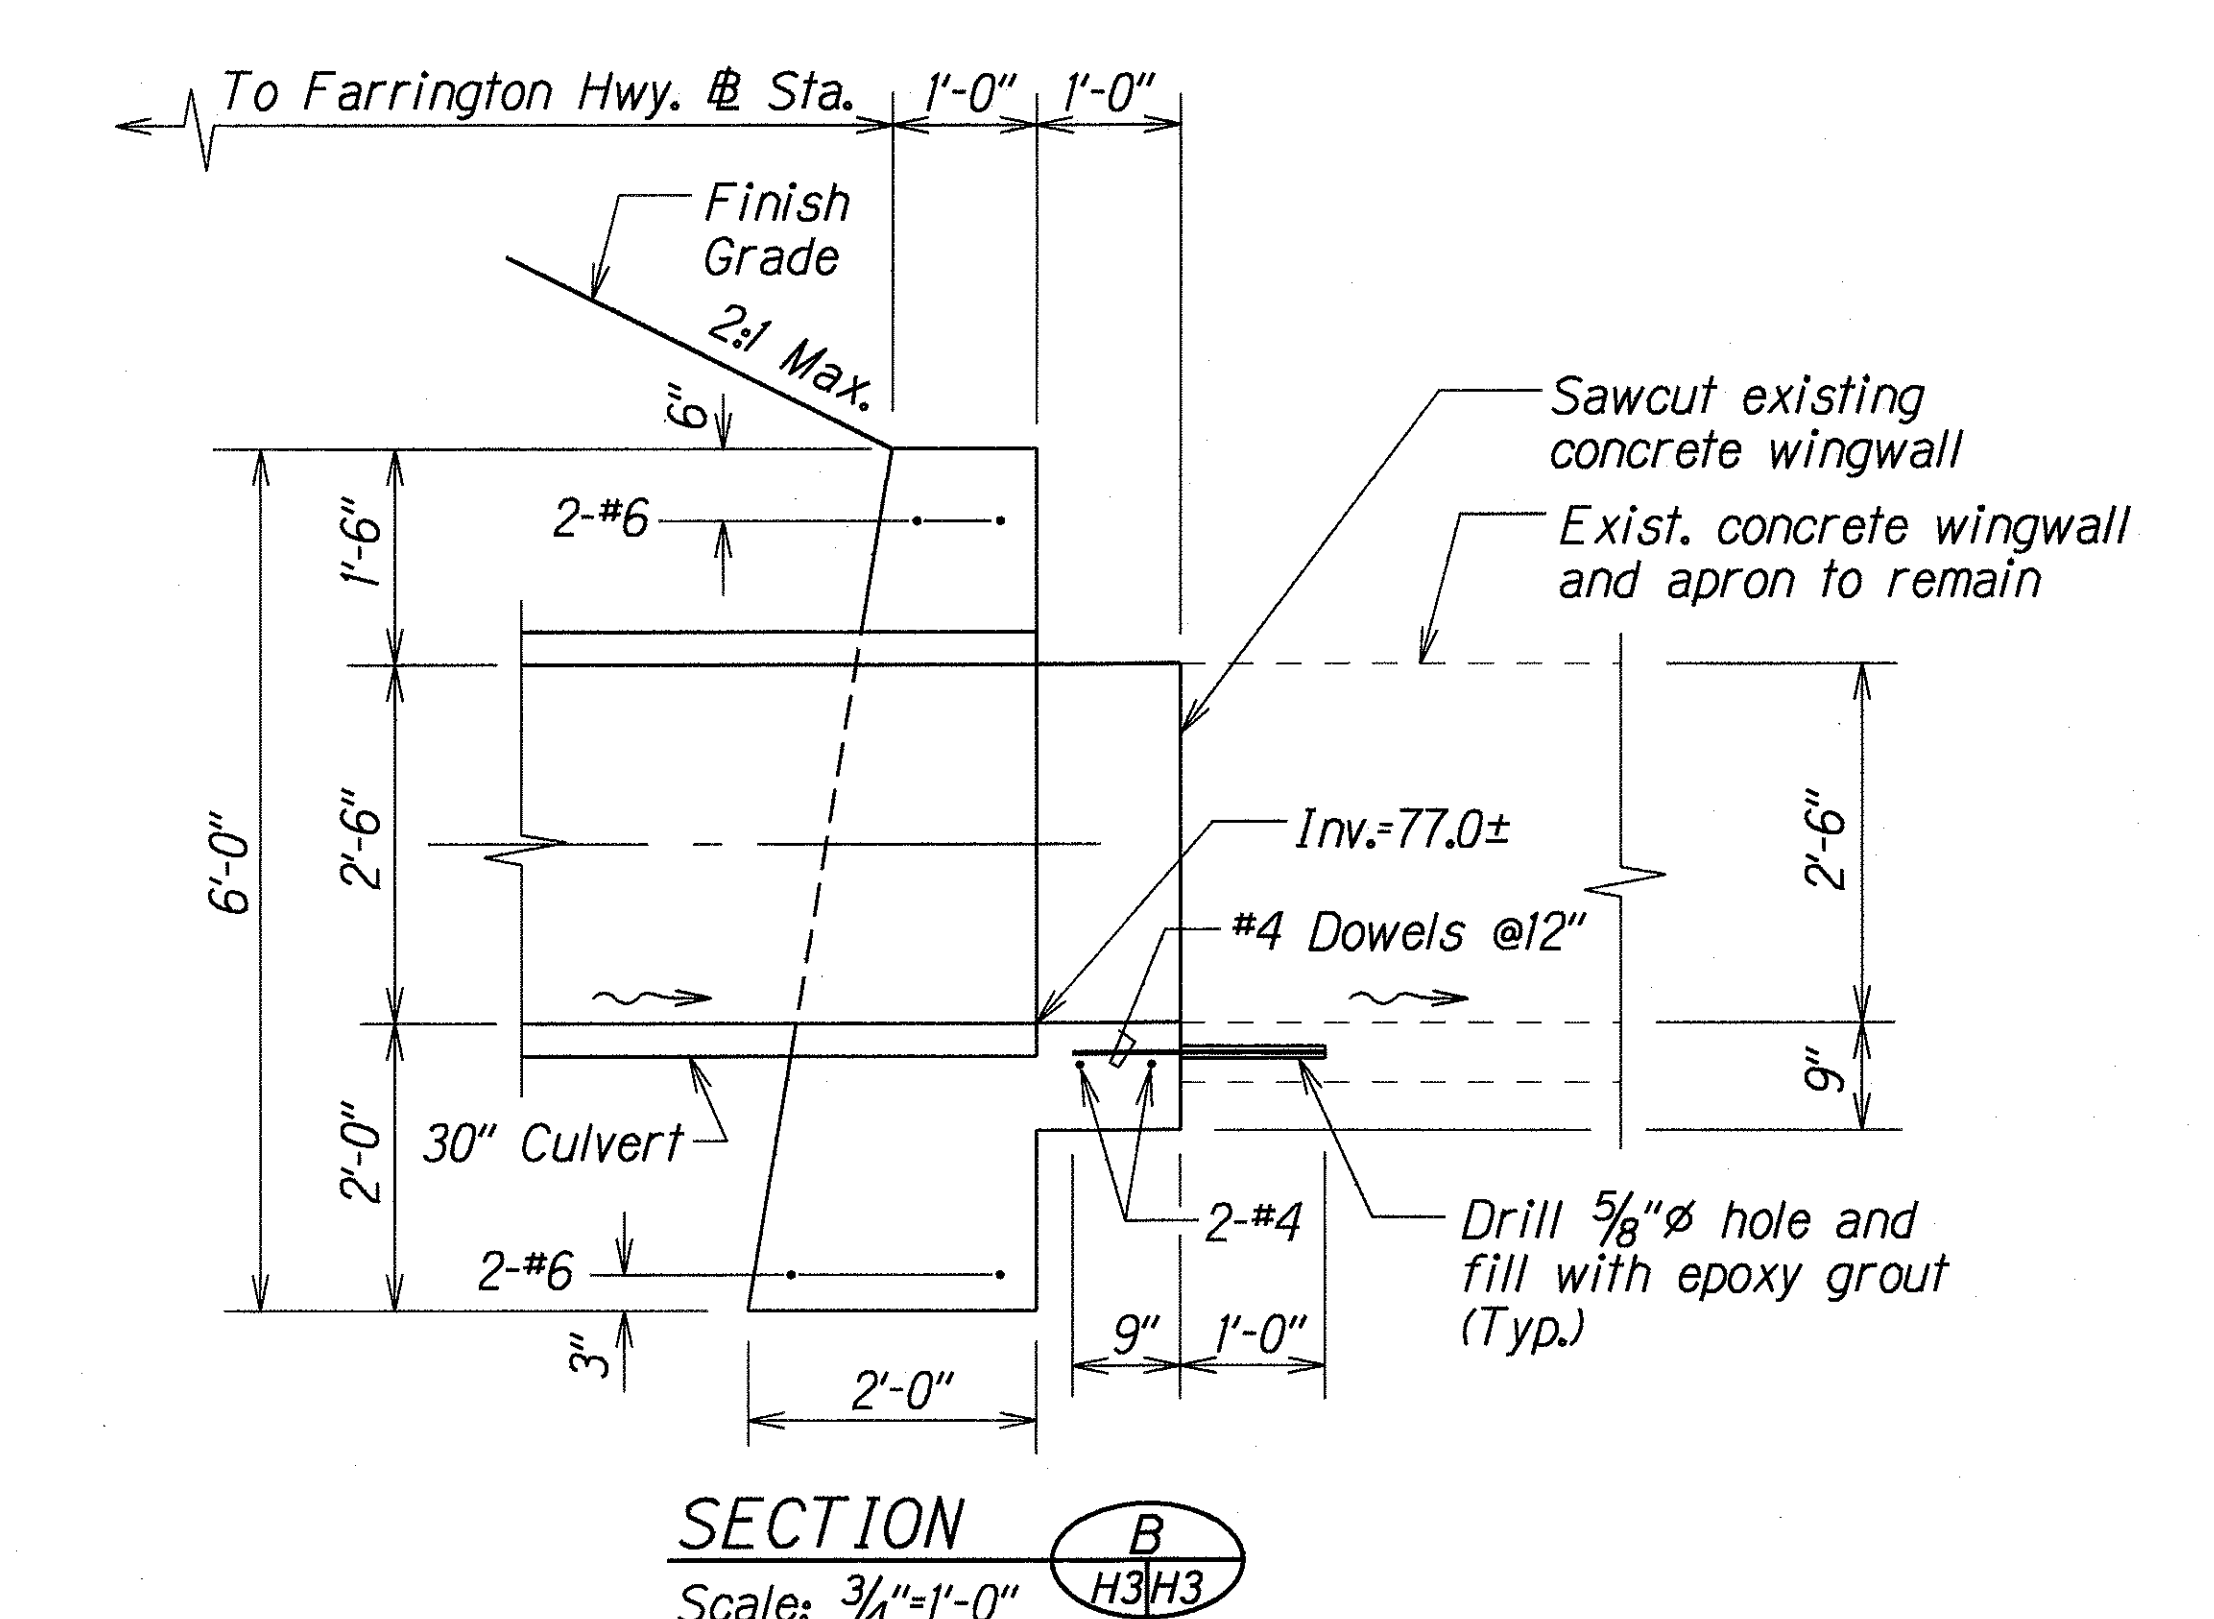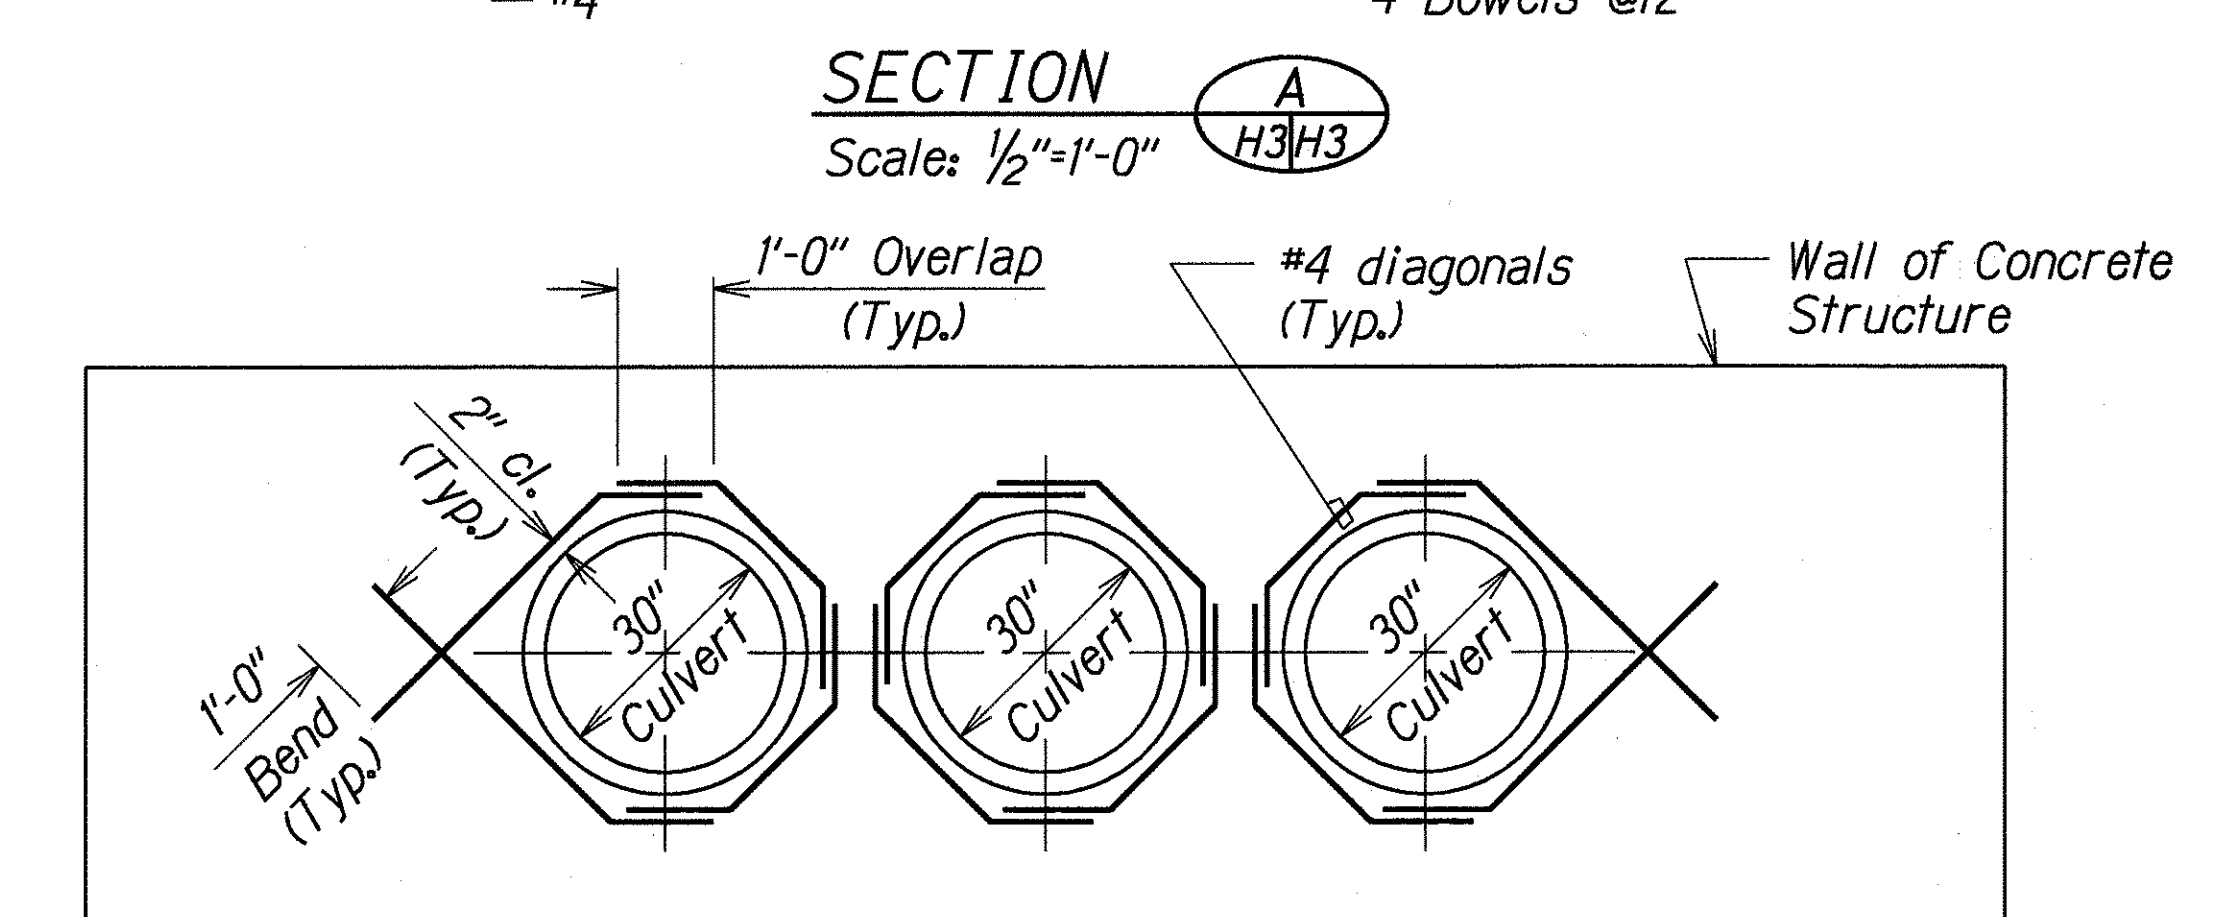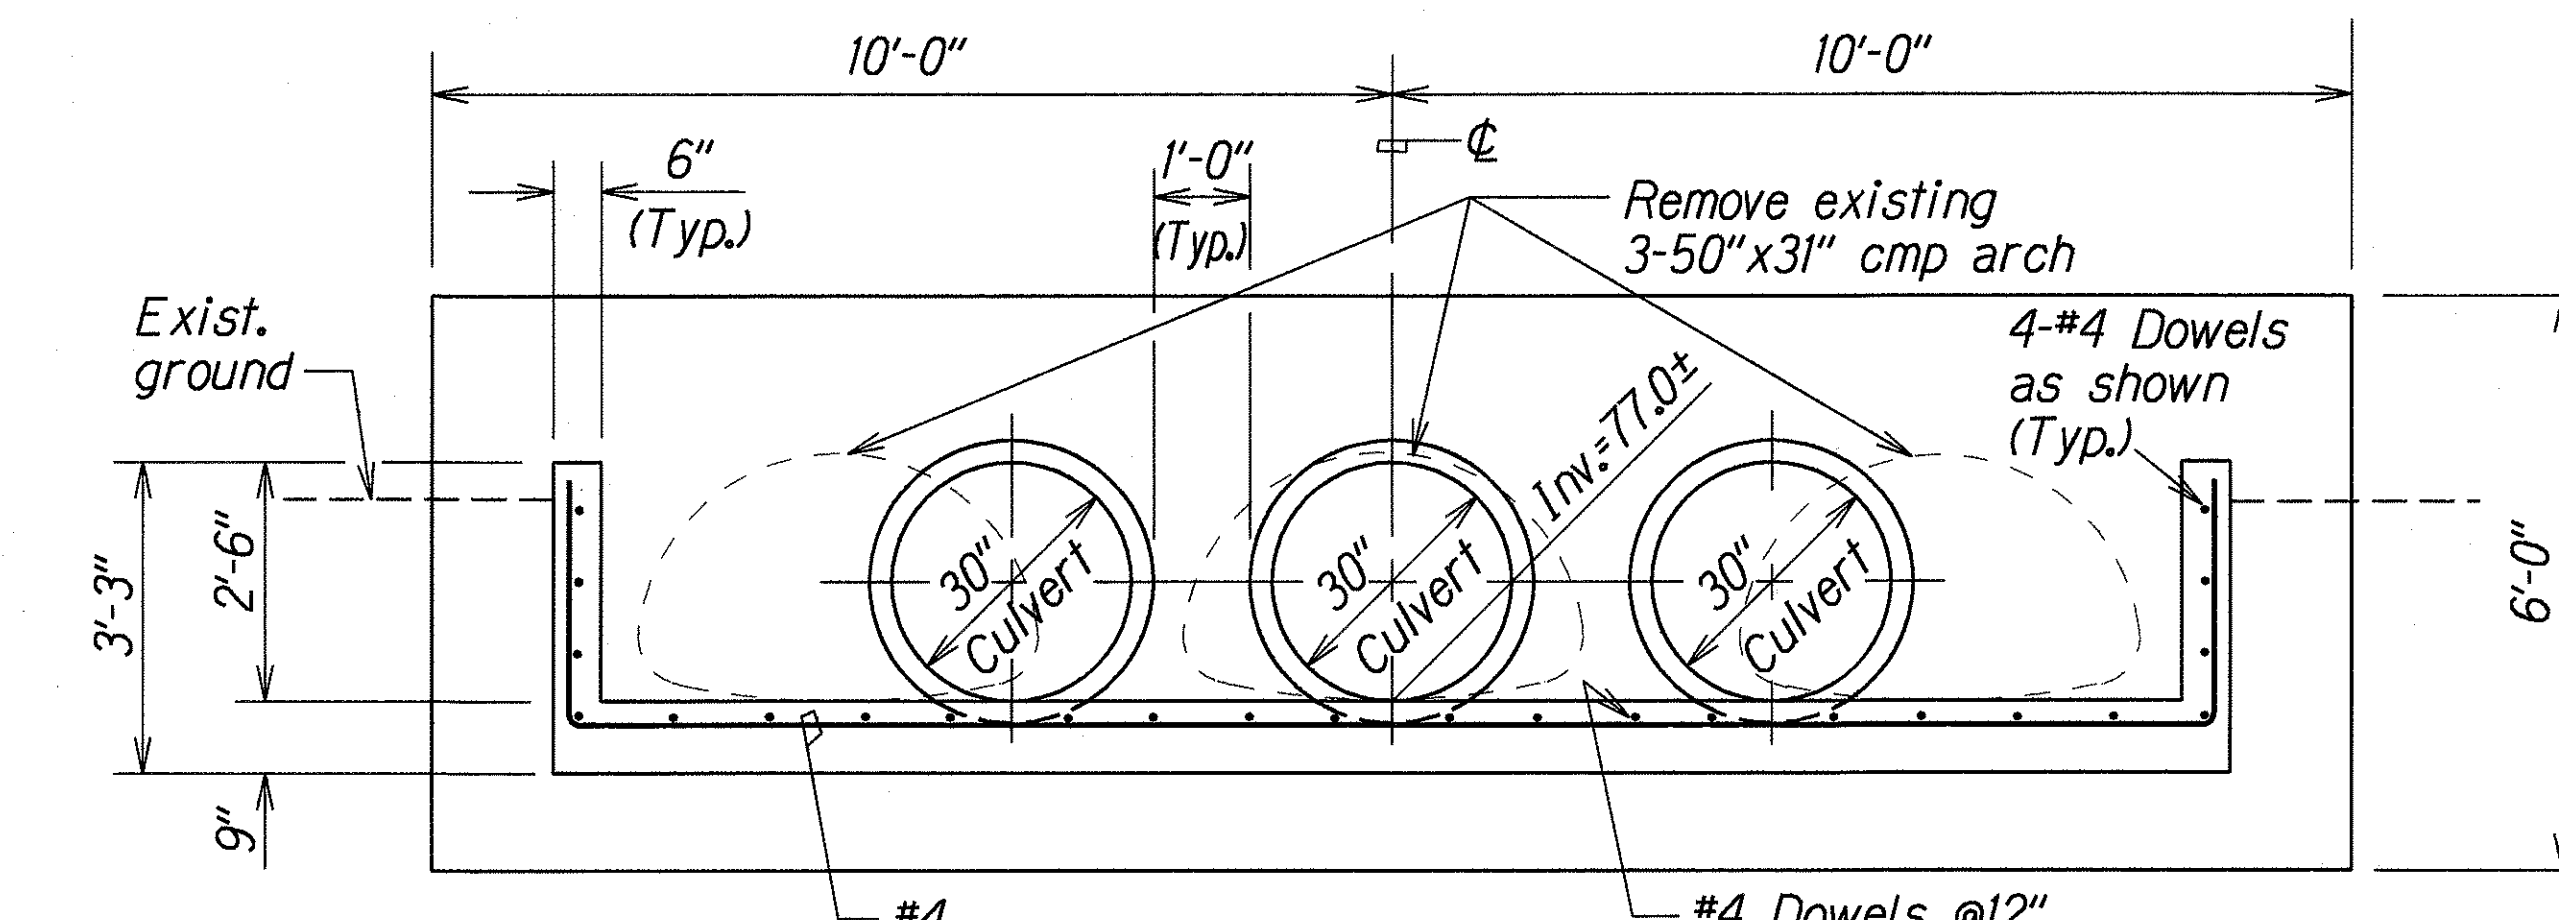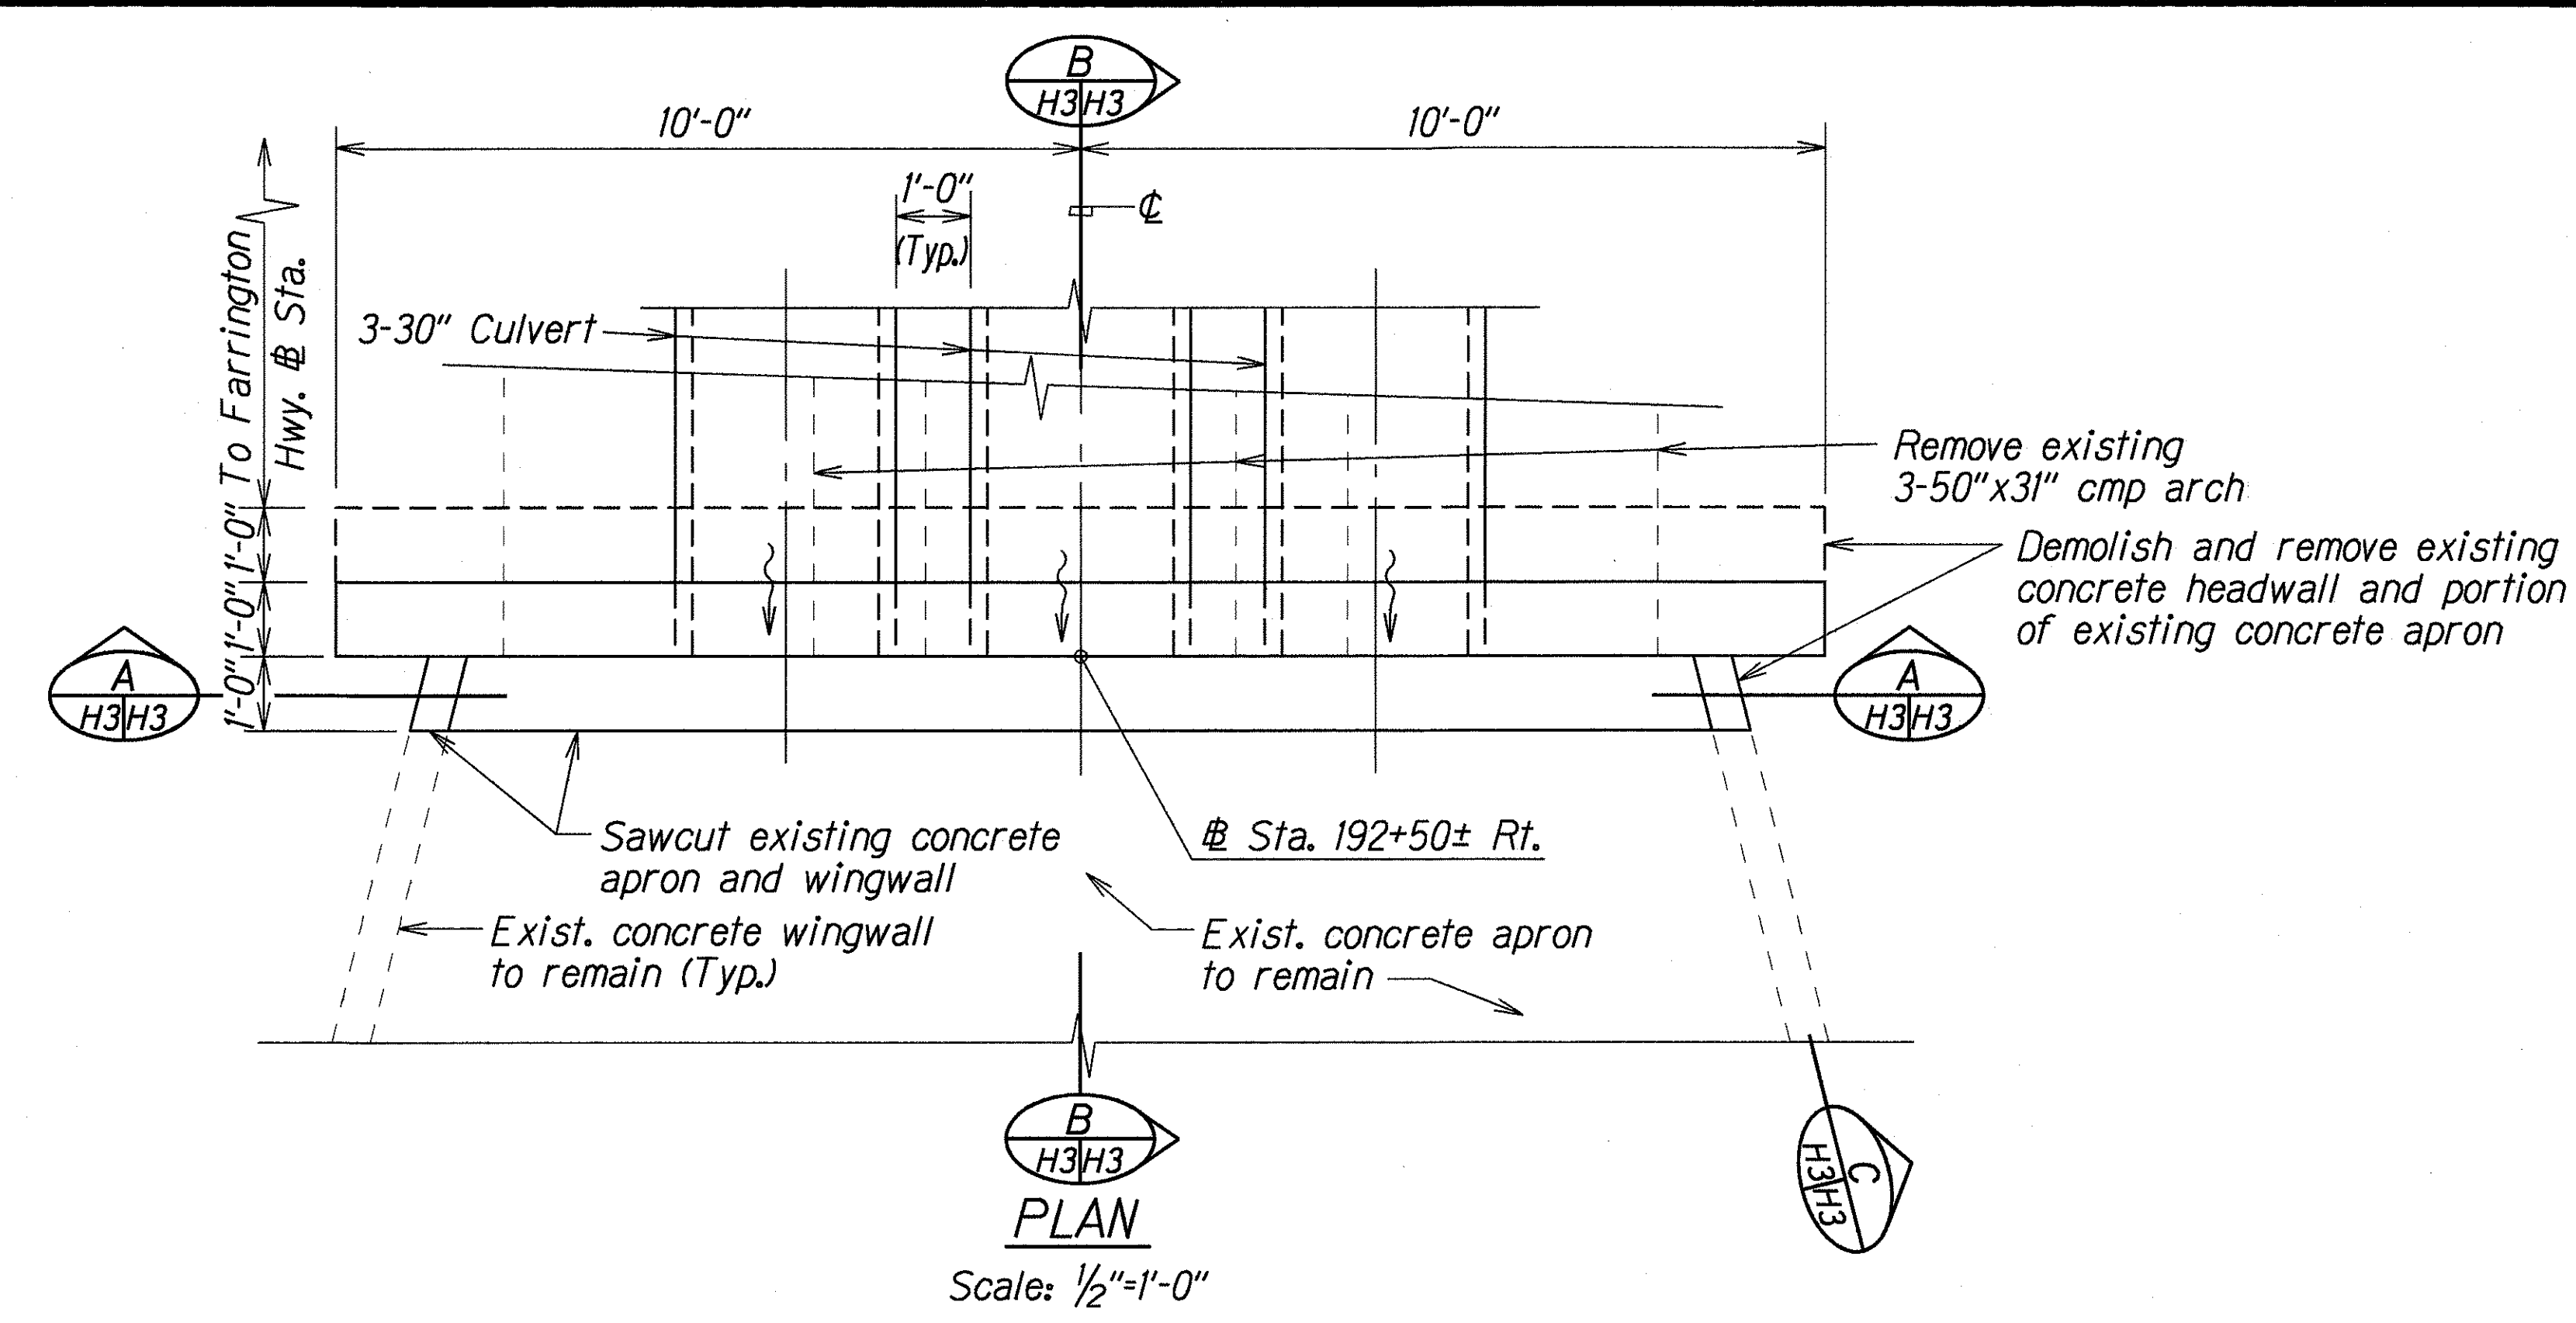

TYPICAL DETAIL OF ADDED REINFORCING AROUND CULVERTS

DETAILS OF MODIFIED OUTLET STRUCTURE

STATE OF HAWAII
DEPARTMENT OF TRANSPORTATION
HIGHWAYS DIVISION

DRAINAGE DETAILS

FARRINGTON HIGHWAY
Repair Triple CMP Culverts
at Palailai Interchange
Project No. 93A-03-98M

Scale: As Shown Date: Jan. 1998

SHEET No. H3 OF 3 SHEETS

ORIGINAL PLAN	DATE	1/7/98
SURVEY PLOTTED BY		
DRAWN BY		
TRACED BY		
NOTED BY		
CHECKED BY		