

INDEX TO DRAWINGS	
SHEET NO.	DESCRIPTION
1	TITLE SHEET
2	STANDARD PLANS SUMMARY
3	DRAINAGE PLAN
4-5	DRAINAGE DETAILS

STATE OF HAWAII

DEPARTMENT OF TRANSPORTATION

HIGHWAYS DIVISION

HONOLULU, HAWAII

"AS-BUILT"


PLANS FOR

FARRINGTON HIGHWAY

REPAIR TRIPLE CMP CULVERTS AT PALAILAI INTERCHANGE


PROJECT NO. 93A-03-98M

DISTRICT OF EWA
ISLAND OF OAHU



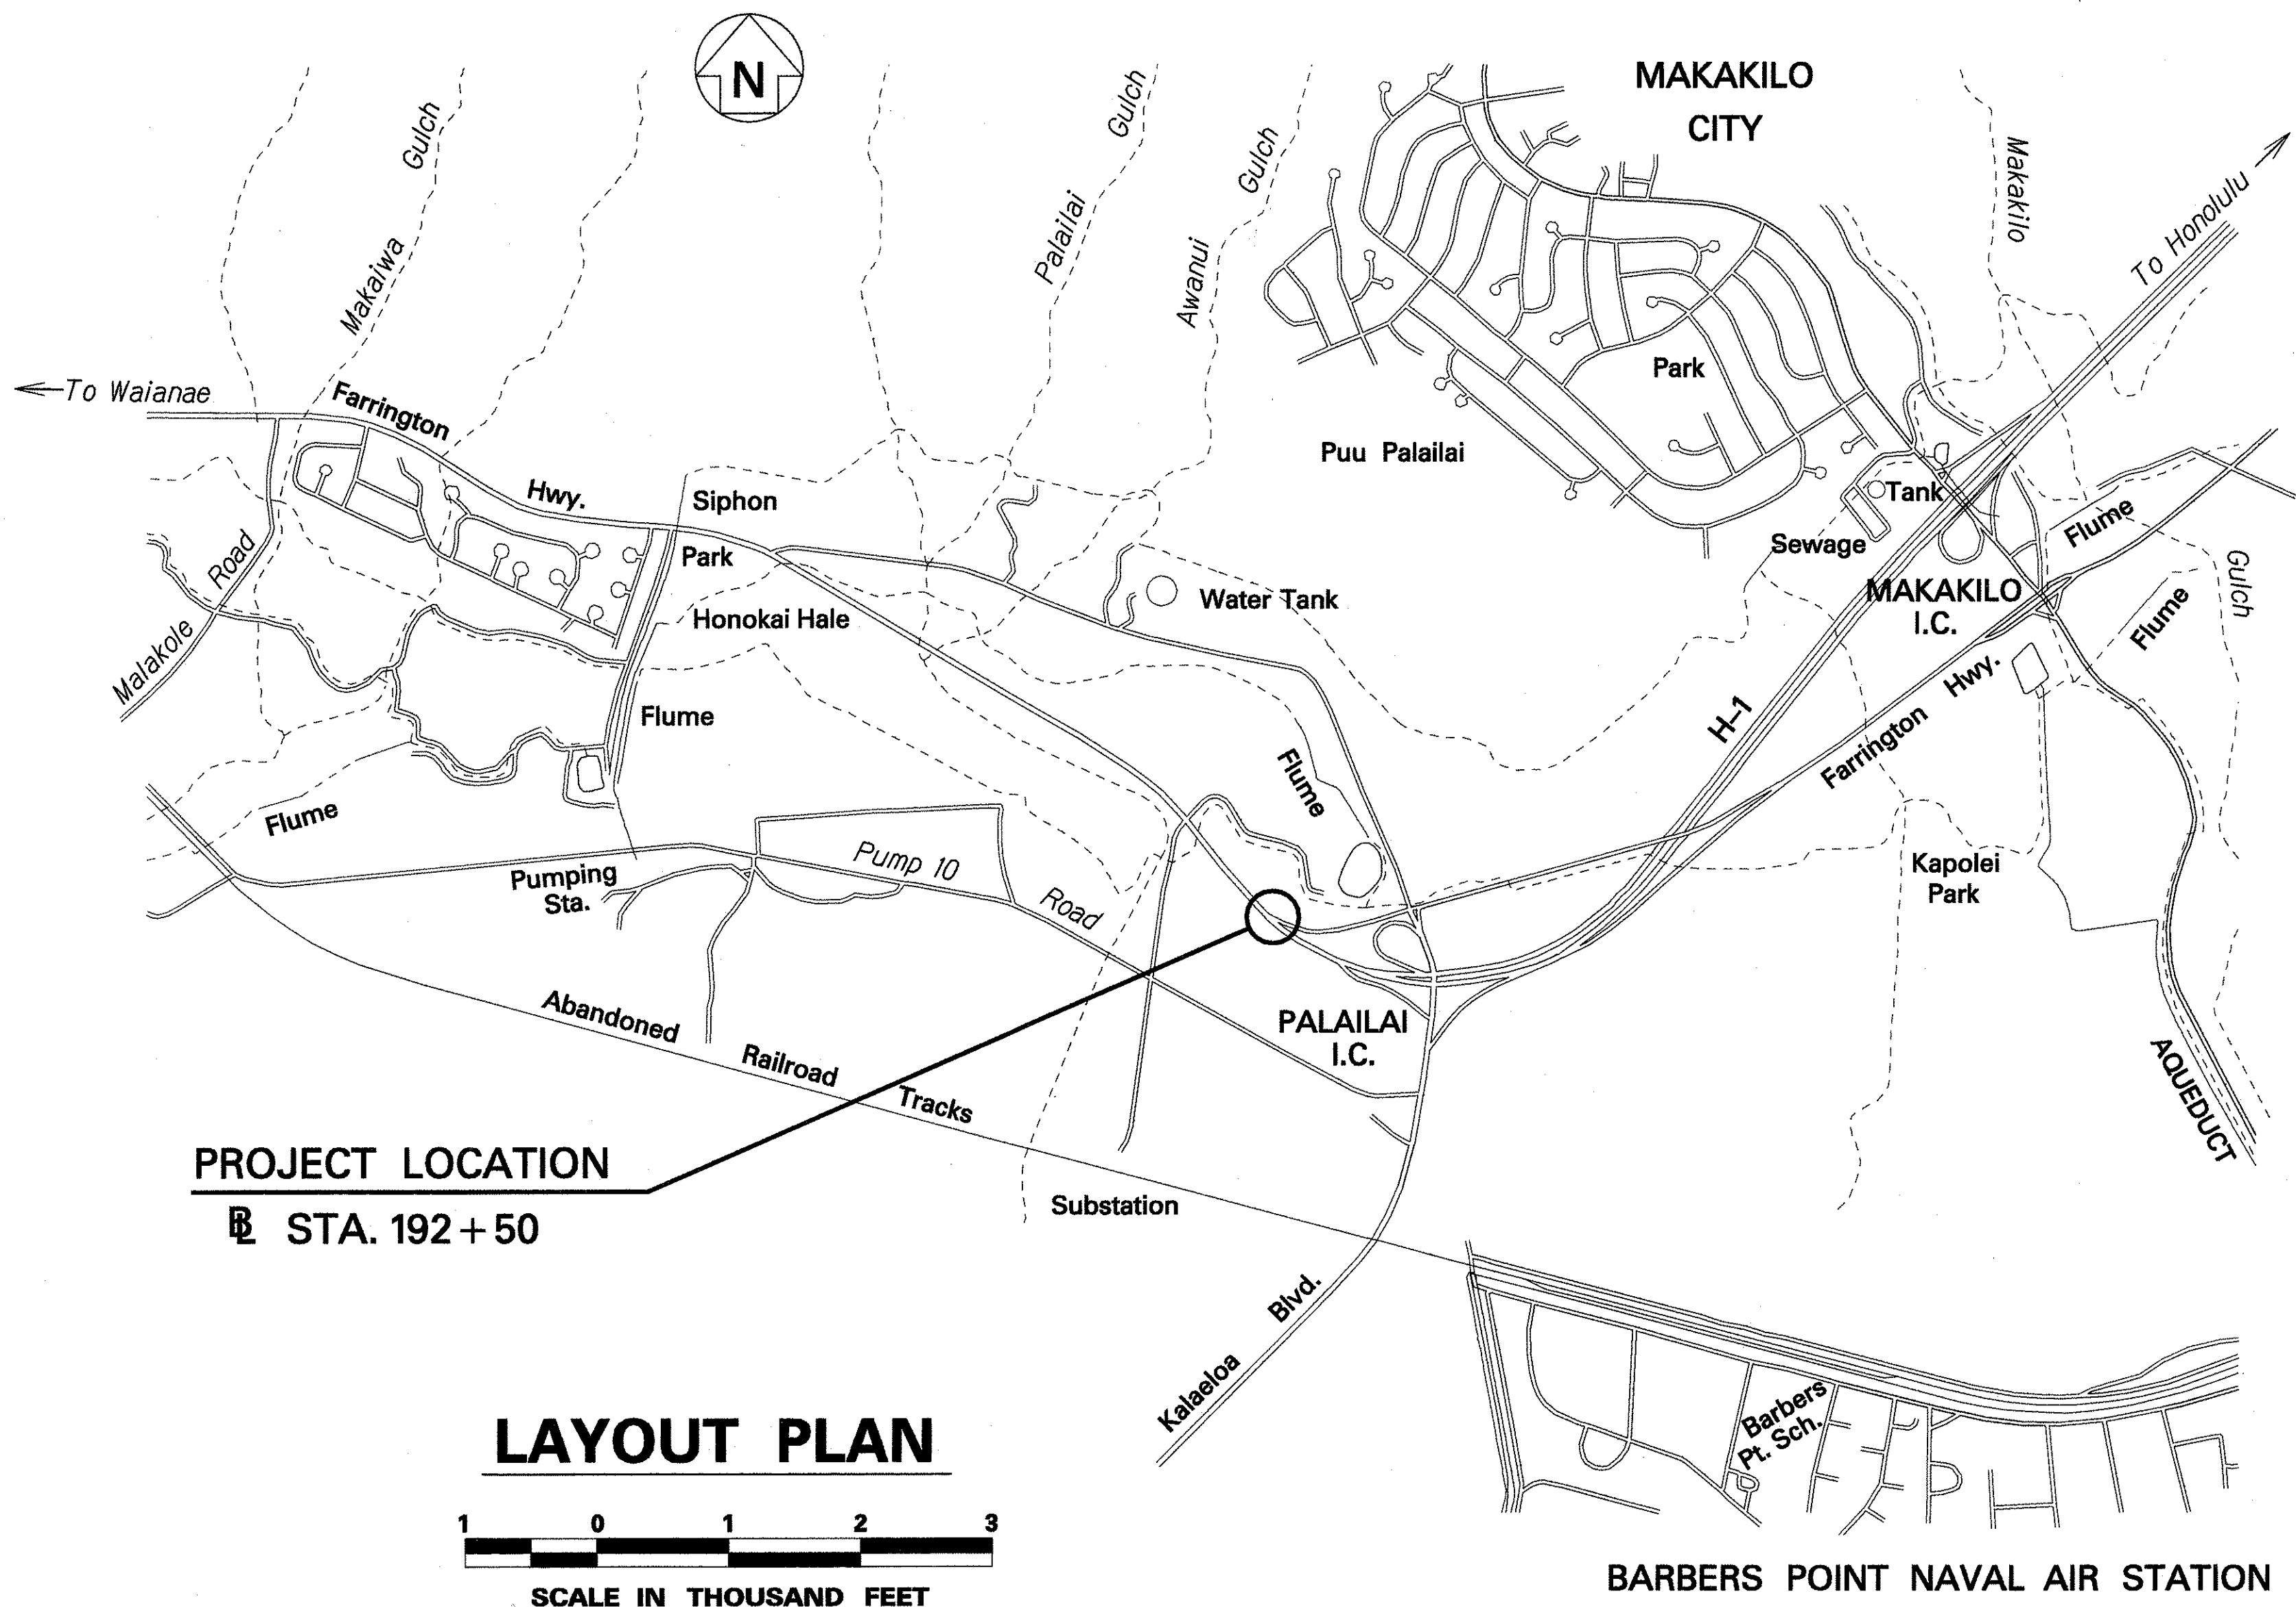


PROJECT LOCATION

STA. 192 + 50

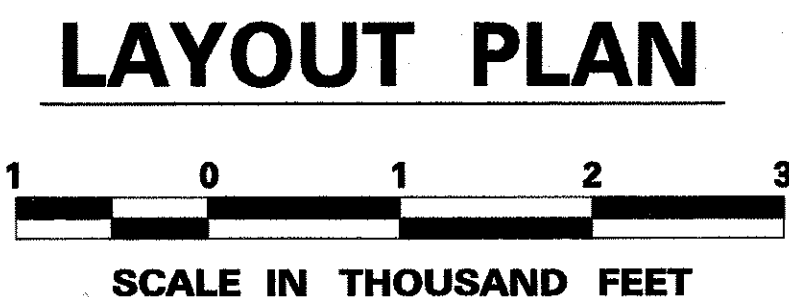

FED. ROAD DIST. NO.	STATE	PROJ. NO.	FISCAL YEAR	SHEET NO.	TOTAL SHEETS
HAWAII	HAW.	93A-03-98M	1998	1	5

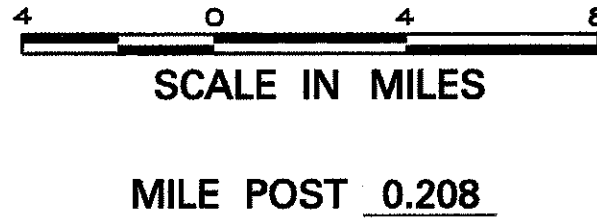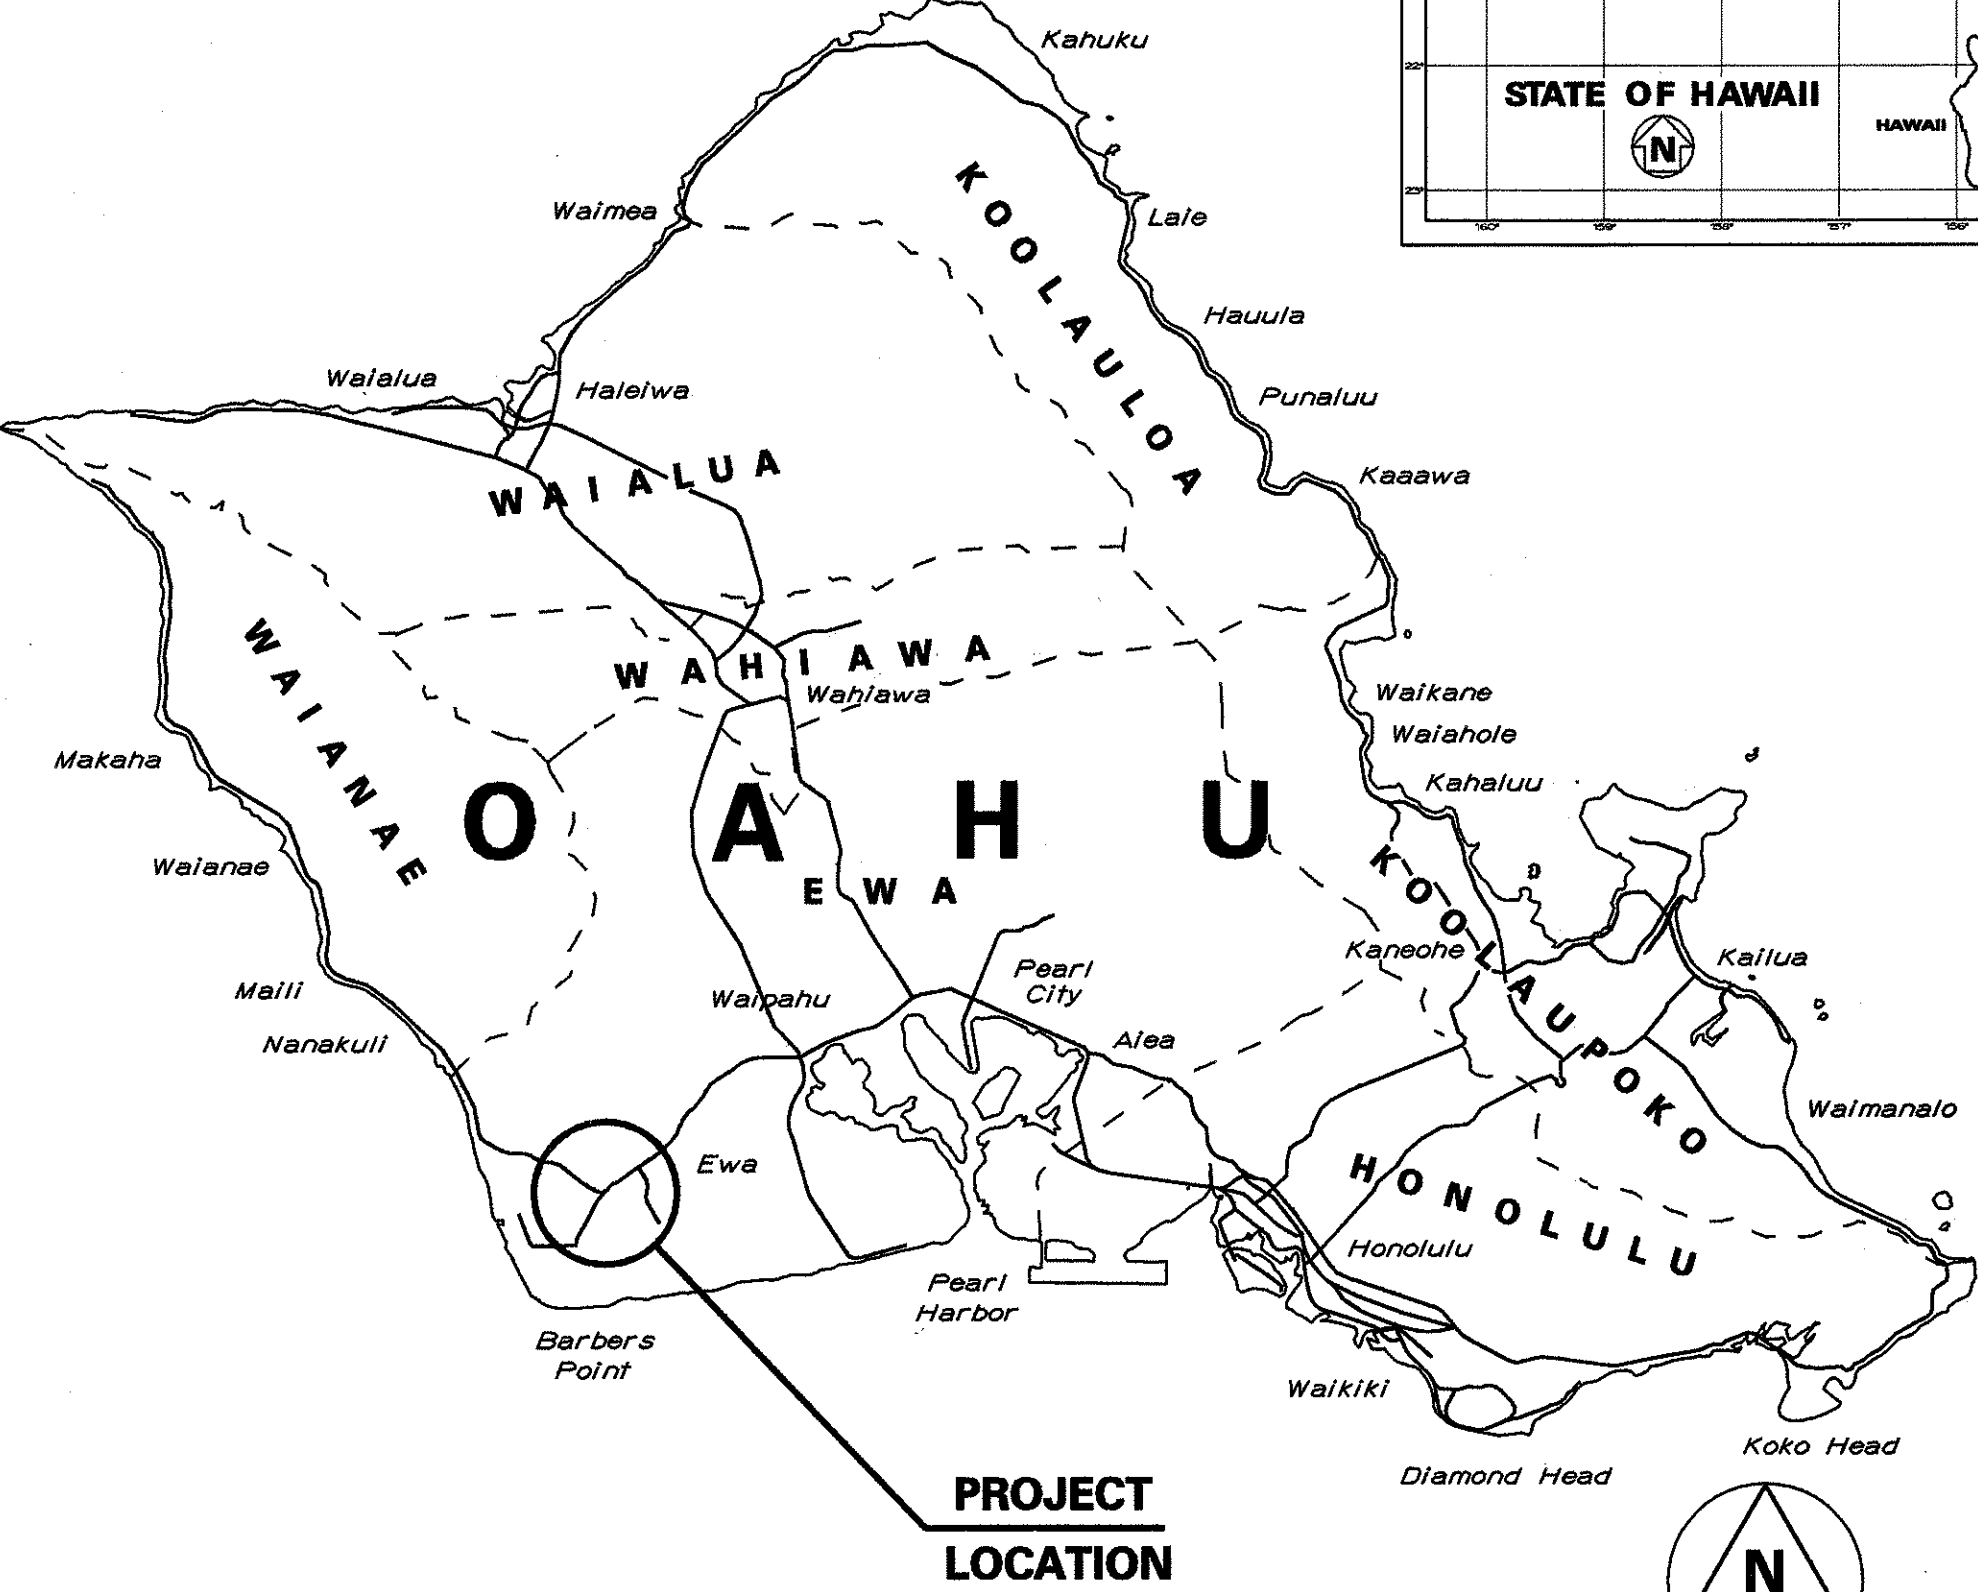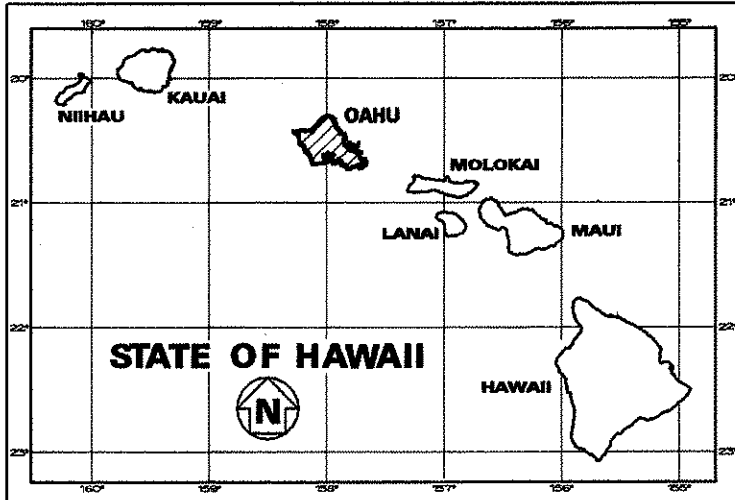

CHANGES MADE DURING CONSTRUCTION HAVE BEEN INCORPORATED ON THESE PLANS EXCEPT CHANGES IN THE ORIGINAL QUANTITIES.

RESIDENT ENGINEER

DATE 1/6/99

DEPARTMENT OF TRANSPORTATION STATE OF HAWAII	
APPROVED:	DATE
<i>Kay L. Loo</i>	2/9/98
DIR. OF TRANSPORTATION	DATE

ROSS HIRONAKA

DESIGNED BY

HWY-DH

587-2250

PHONE

DATE

FEB. 1998

DATE