



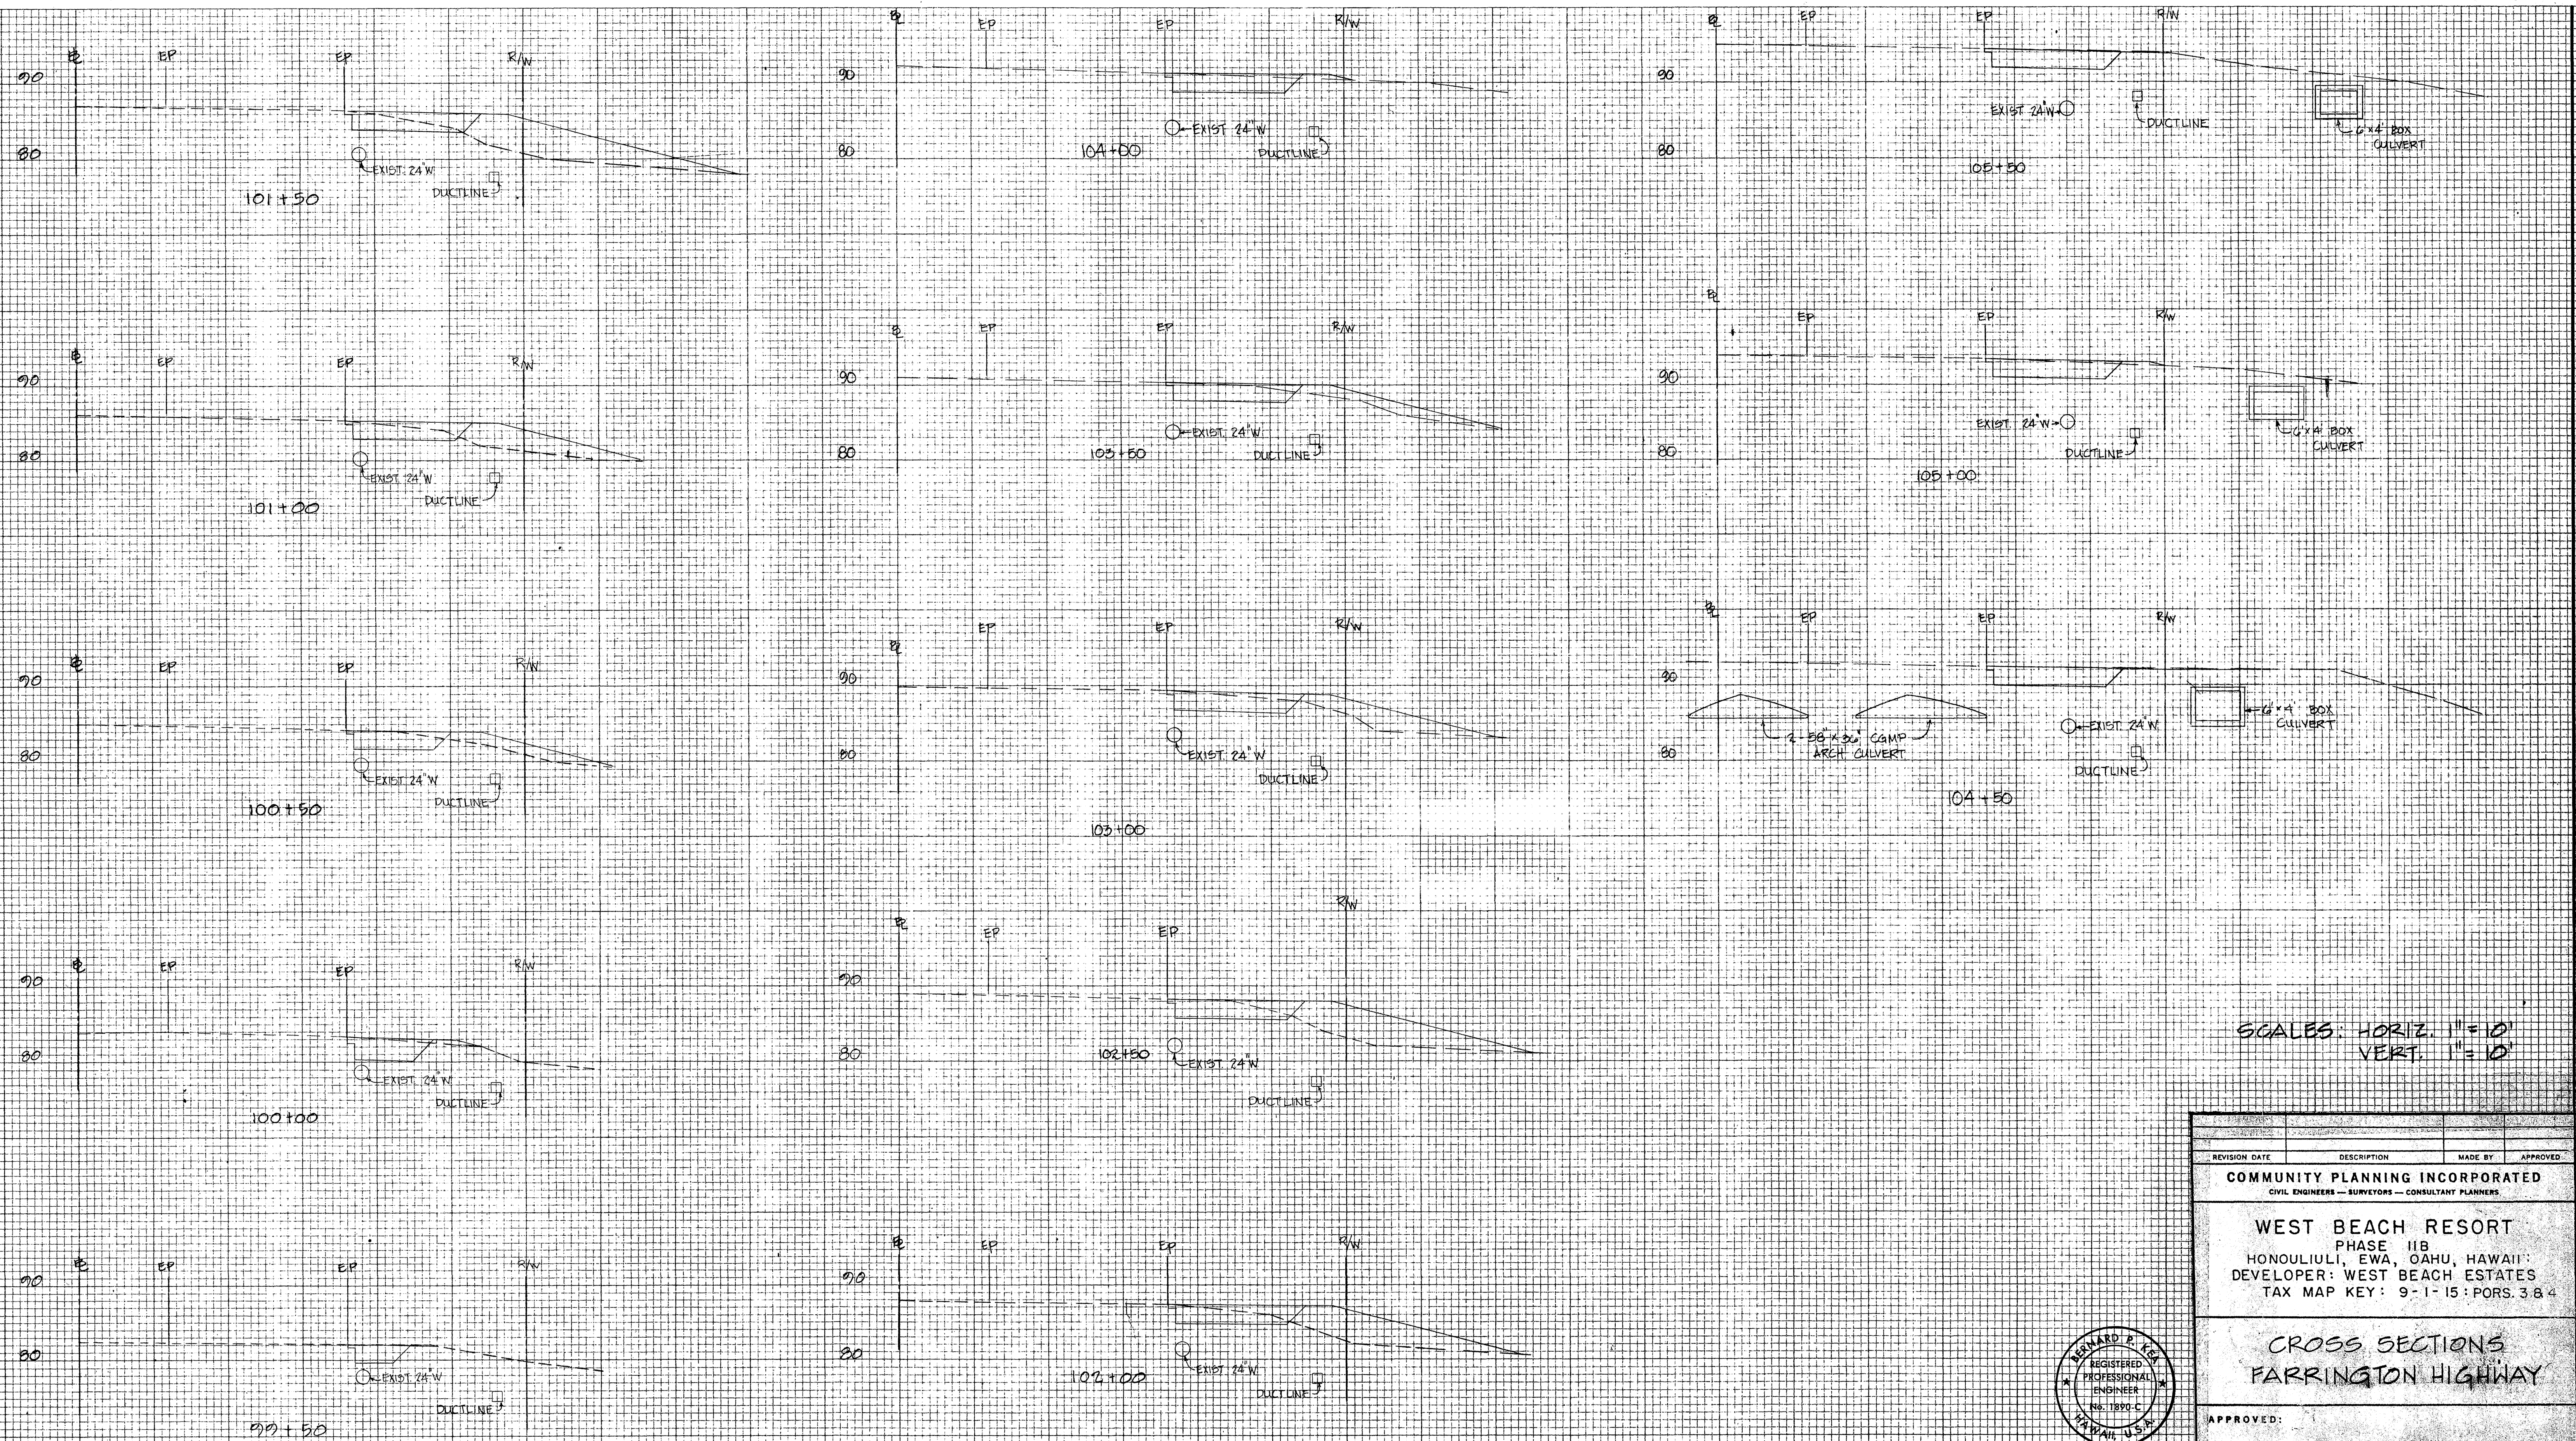

SCALES: HORIZ. 1"=10'
 VERT. 1"=10'

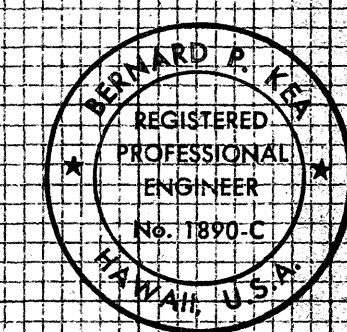


THIS WORK WAS PREPARED BY
 ME OR UNDER MY SUPERVISION

REVISION DATE	DESCRIPTION	MADE BY	APPROVED
COMMUNITY PLANNING INCORPORATED CIVIL ENGINEERS — SURVEYORS — CONSULTANT PLANNERS			
WEST BEACH RESORT PHASE IIB HONOLULU, EWA, OAHU, HAWAII DEVELOPER: WEST BEACH ESTATES TAX MAP KEY: 9-1-15: PORS. 3 & 4			
CROSS SECTIONS FARRINGTON HIGHWAY			
APPROVED: <i>Bernard P. Kim</i> REGISTERED PROFESSIONAL ENGINEER			





SCALES: HORIZ. 1" = 10'
VERT. 1" = 10'

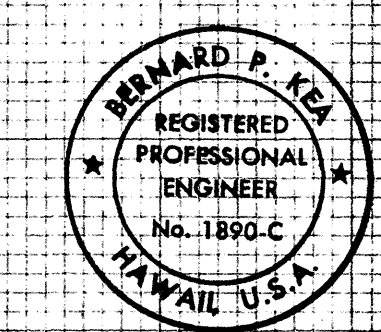


THIS WORK WAS PREPARED BY ME OR UNDER MY SUPERVISION

REVISION DATE	DESCRIPTION	MADE BY	APPROVED
COMMUNITY PLANNING INCORPORATED CIVIL ENGINEERS — SURVEYORS — CONSULTANT PLANNERS			
WEST BEACH RESORT PHASE IIB HONOLULU, EWA, OAHU, HAWAII DEVELOPER: WEST BEACH ESTATES TAX MAP KEY: 9-1-15: PORS. 3 & 4			
CROSS SECTIONS FARRINGTON HIGHWAY			
APPROVED: <i>Edward P. Teta</i> REGISTERED PROFESSIONAL ENGINEER			
FILE	POCKET	FOLDER	NO.

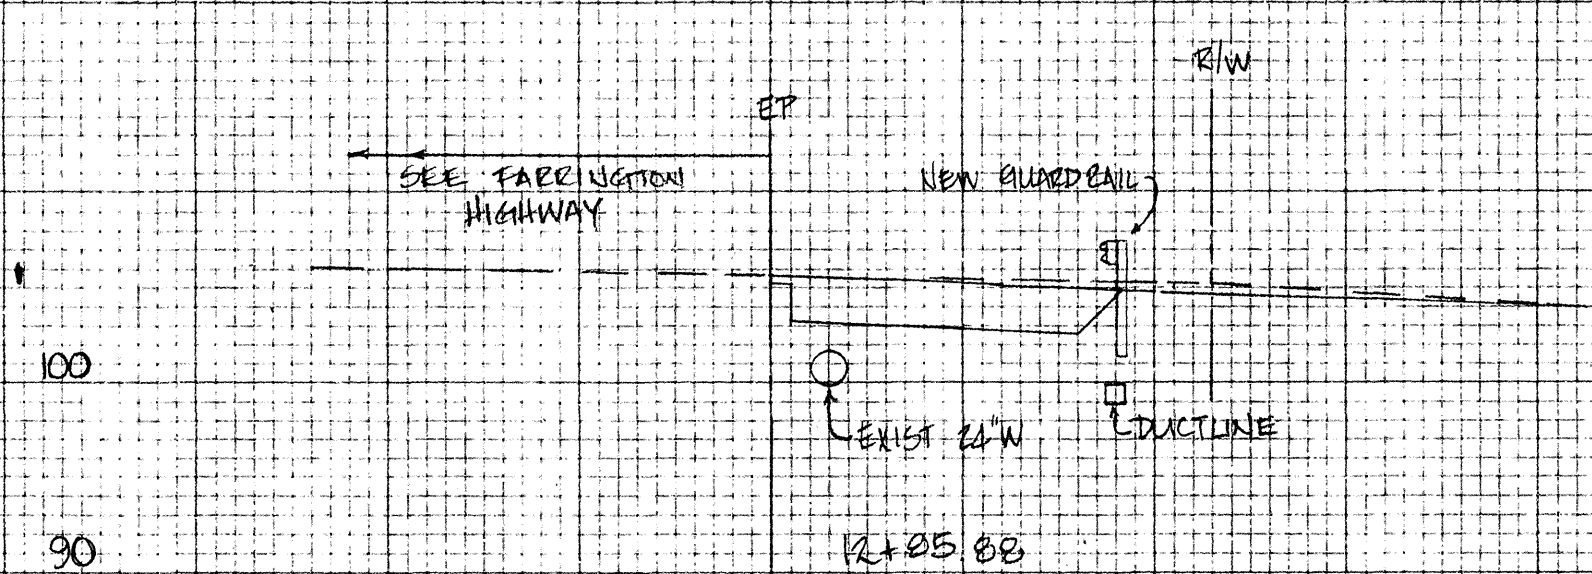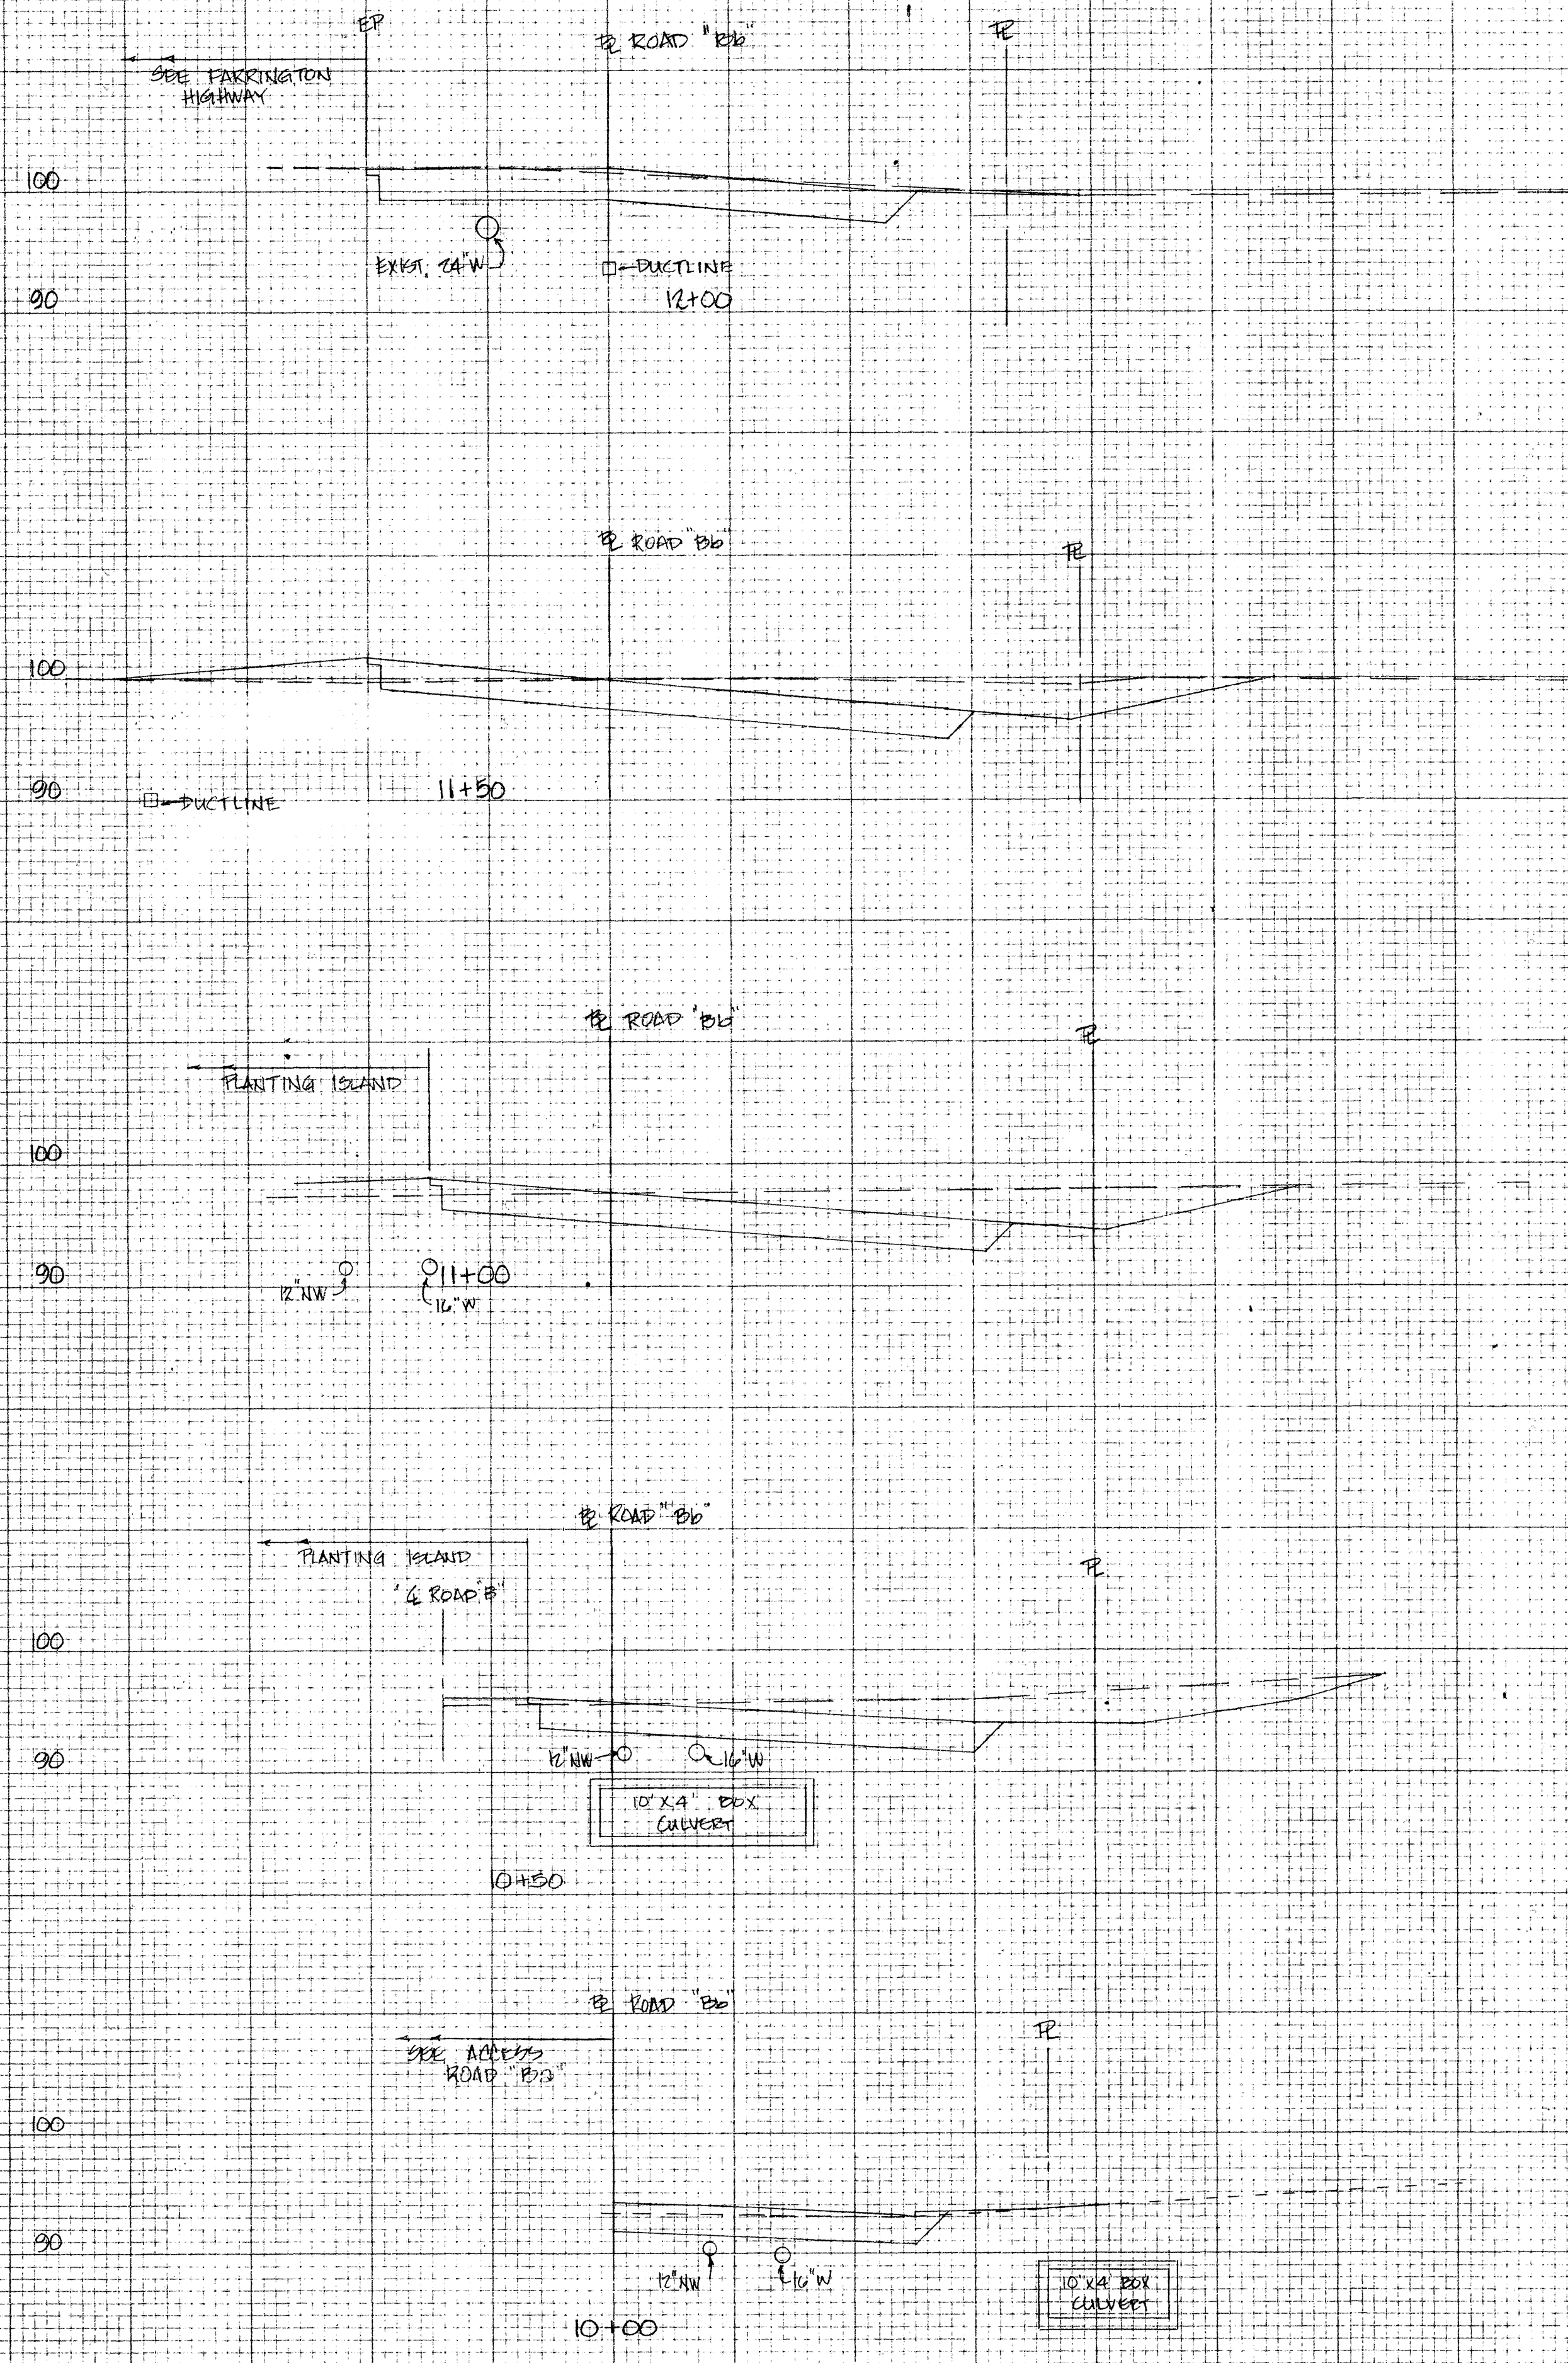







SCALES: HORIZ. 1" = 10'
VERT. 1" = 10'

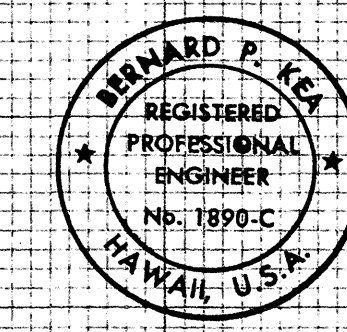


THIS WORK WAS PREPARED BY
ME OR UNDER MY SUPERVISION

REVISION DATE	DESCRIPTION	MADE BY	APPROVED
COMMUNITY PLANNING INCORPORATED CIVIL ENGINEERS - SURVEYORS - CONSULTANT PLANNERS			
WEST BEACH RESORT PHASE IIB HONOLULU, EWA, OAHU, HAWAII DEVELOPER: WEST BEACH ESTATES TAX MAP KEY: 9-1-15: PORS. 3 & 4			
CROSS SECTIONS ACCESS ROAD "BB"			
APPROVED: <i>Bernard P. Kwa</i> REGISTERED PROFESSIONAL ENGINEER			

RECORD DRAWINGS
MADE IN U.S.A.

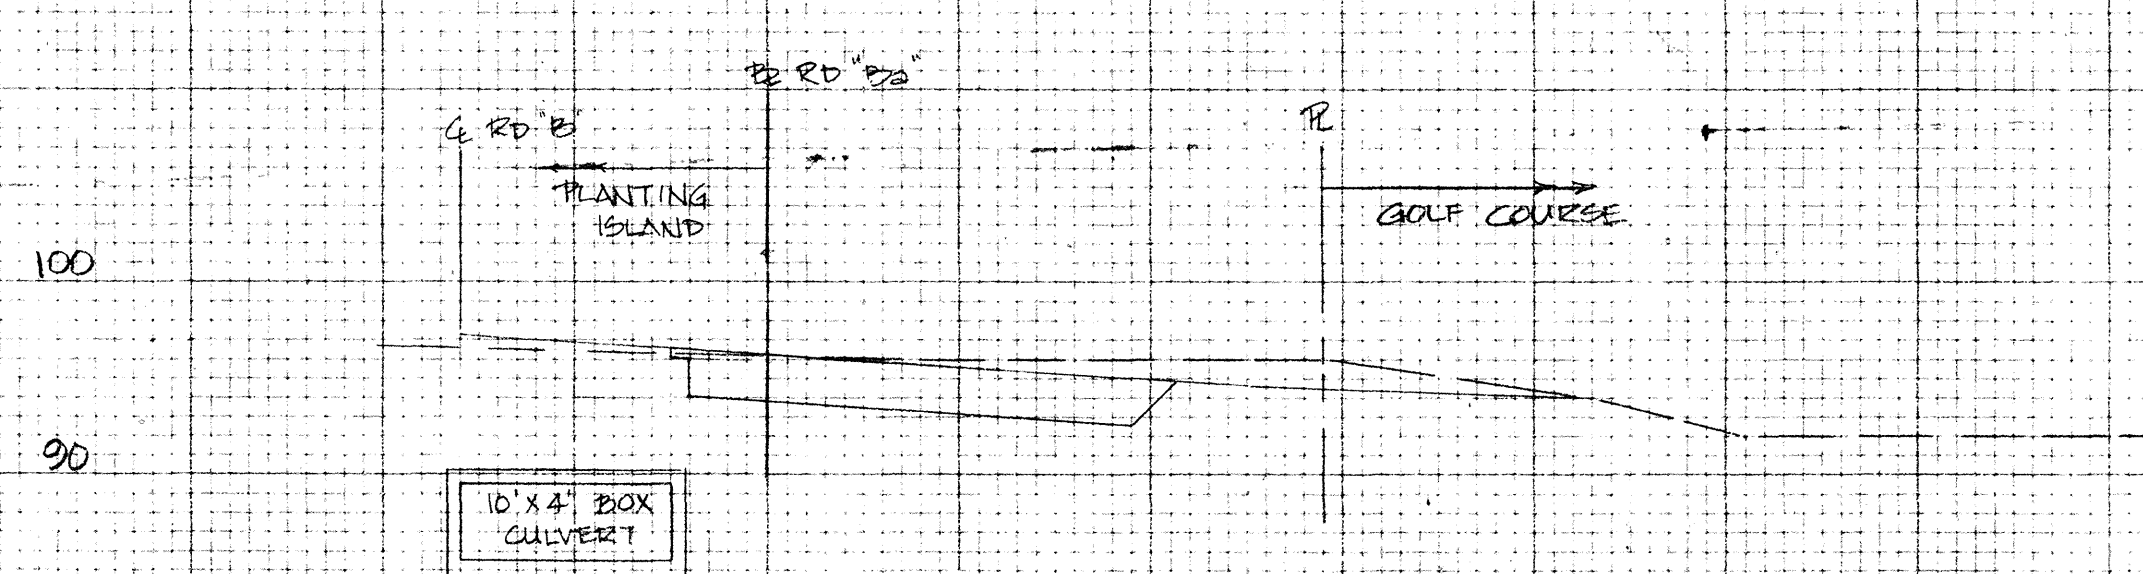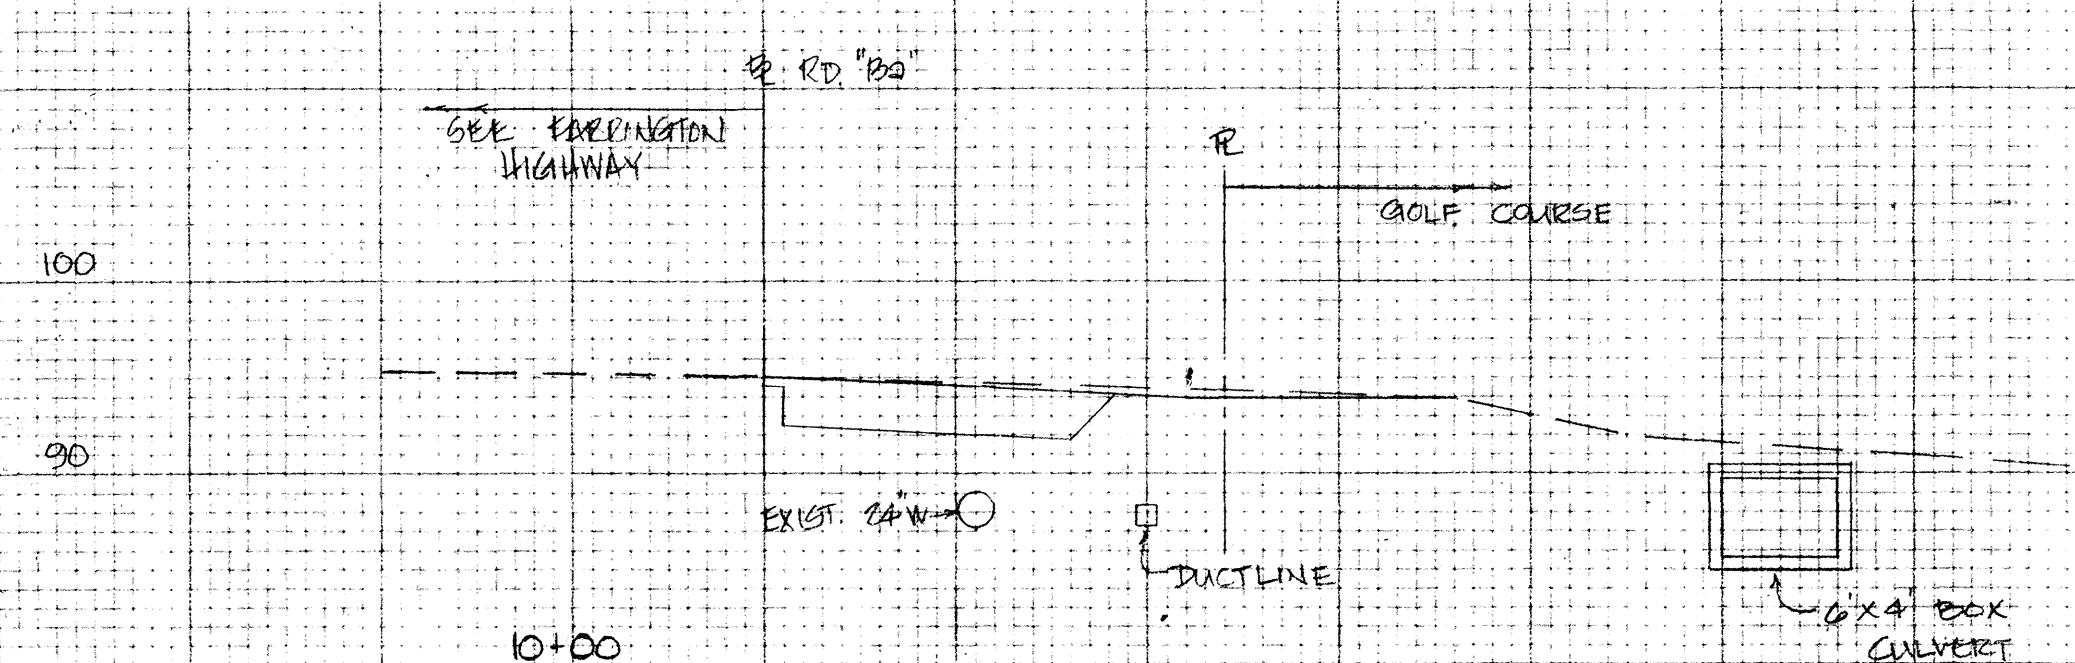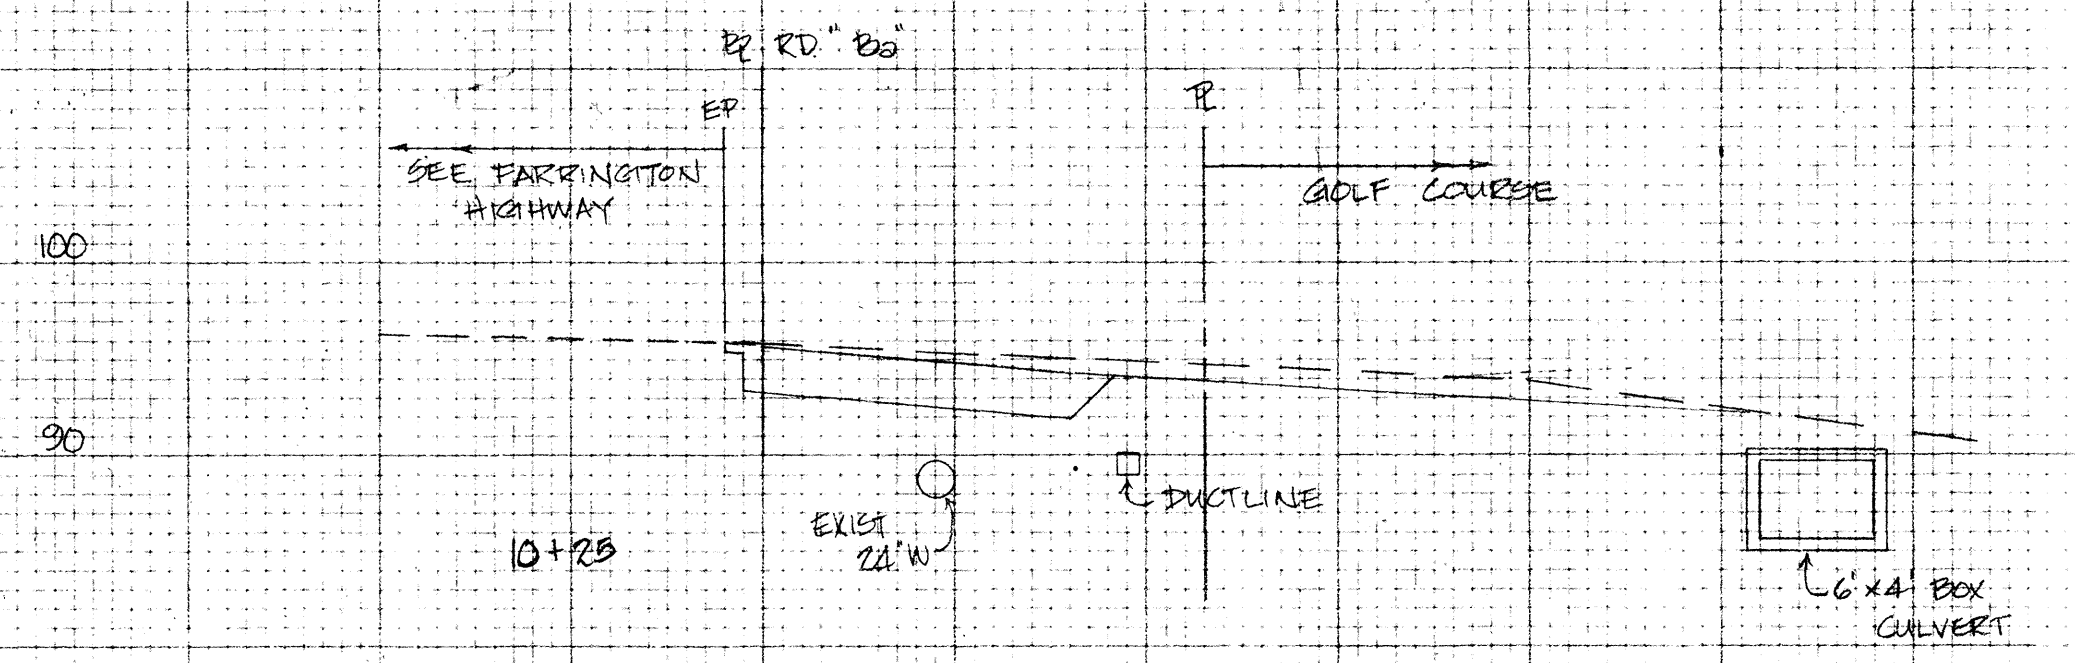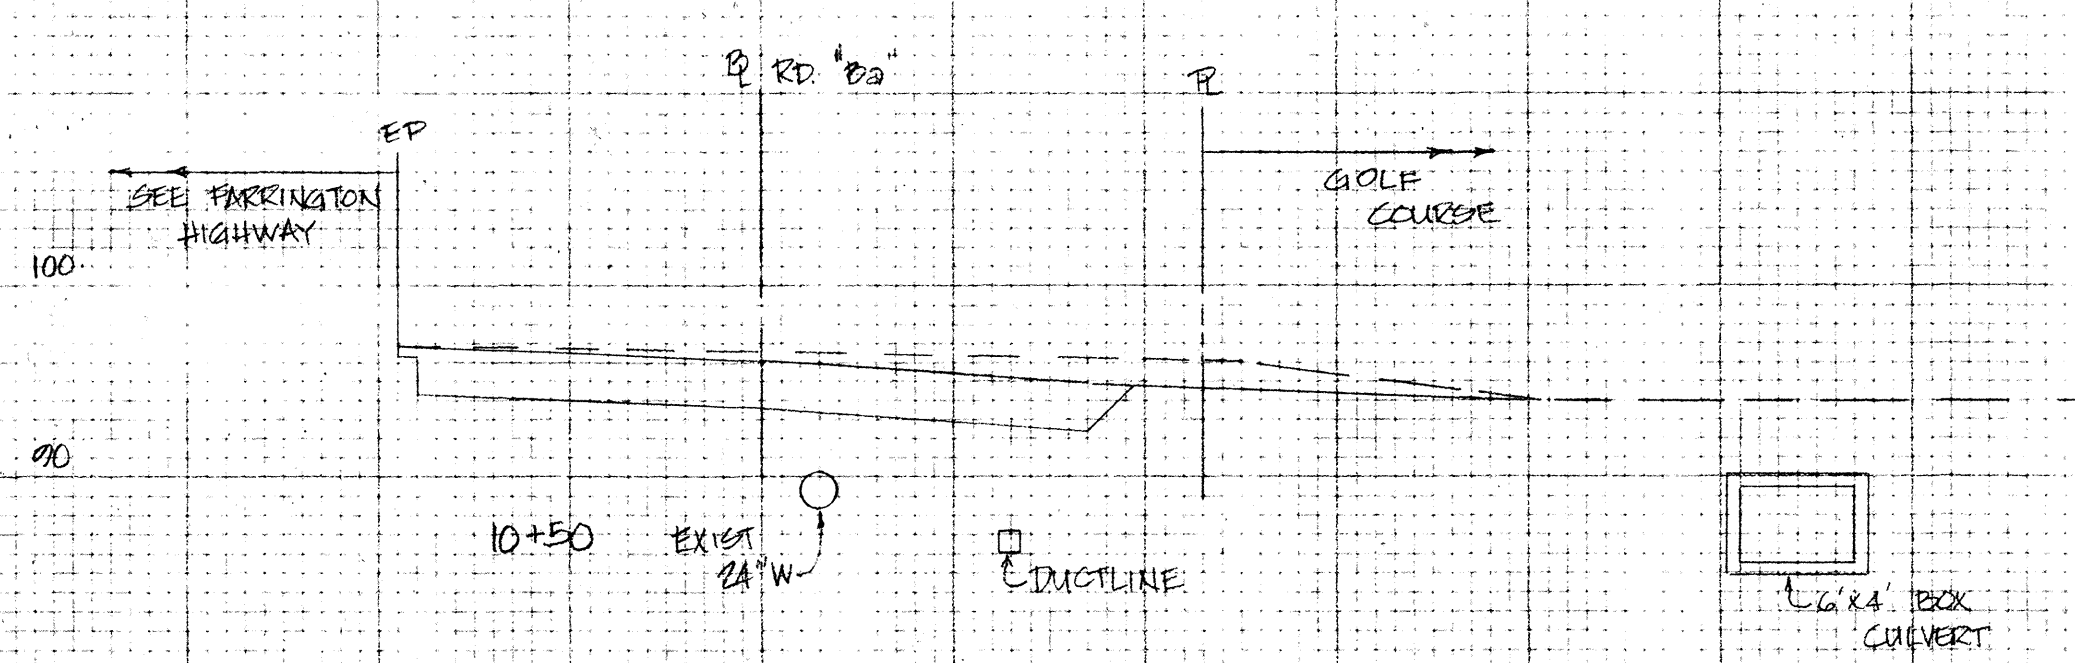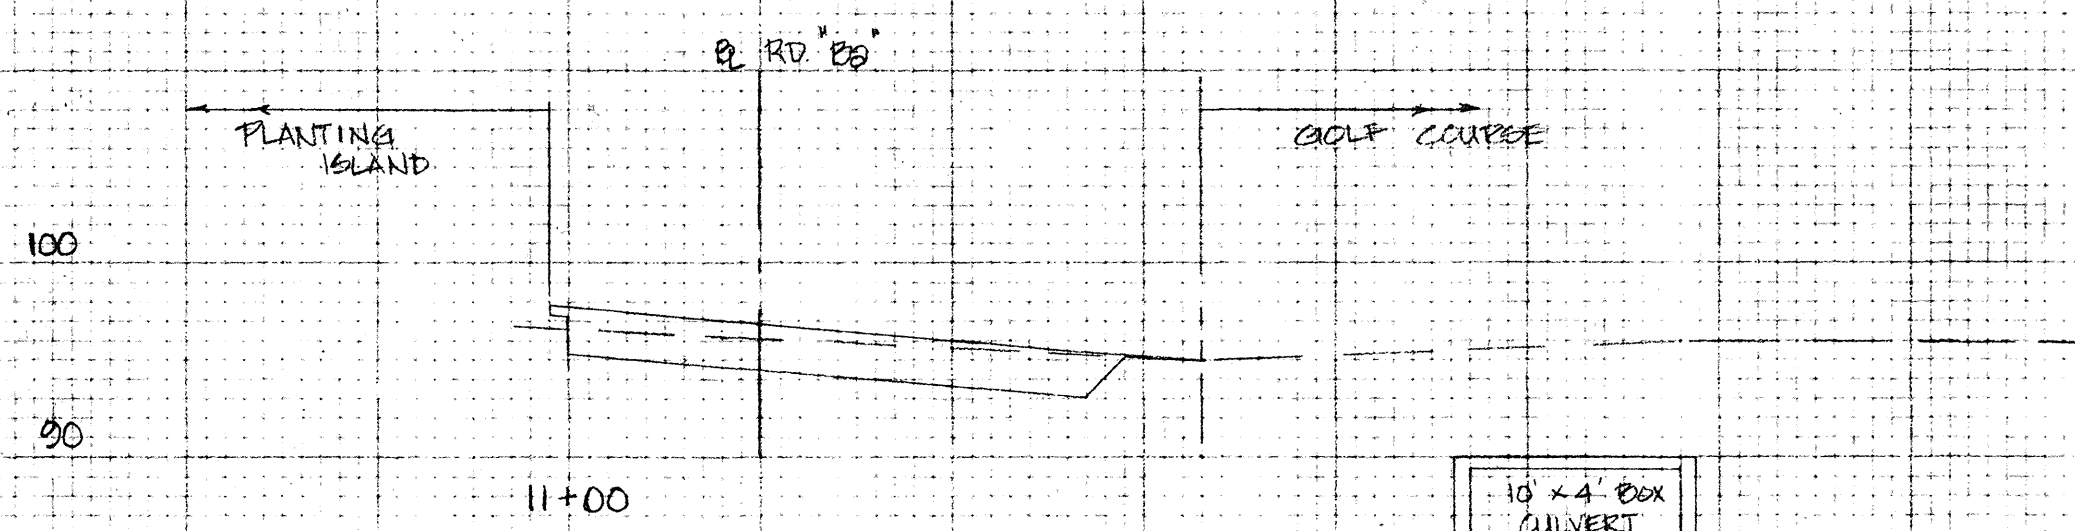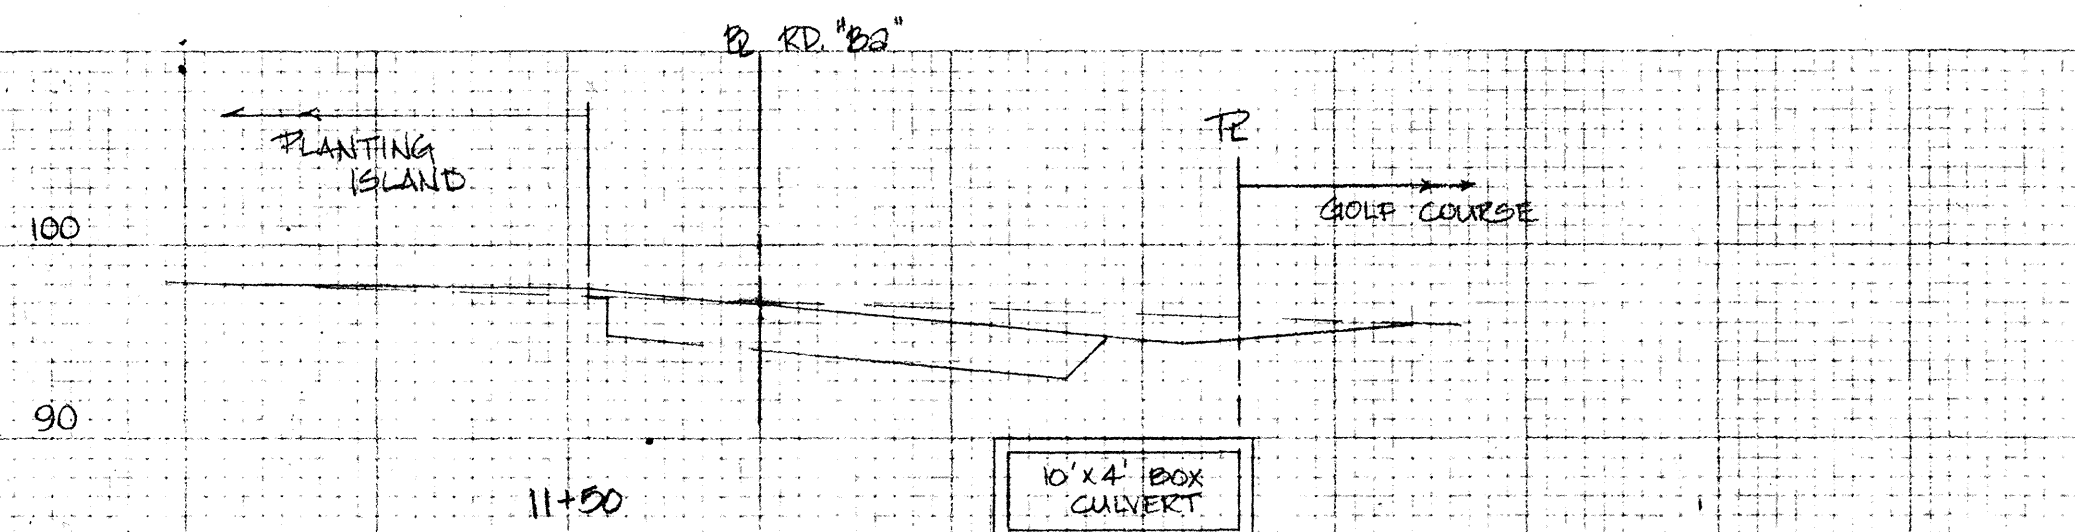

SCALES: HORIZ. 1" = 10'
VERT. 1" = 10'

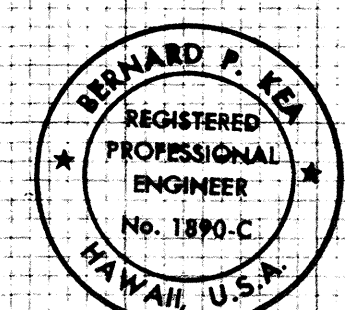

THIS WORK WAS PREPARED BY
ME OR UNDER MY SUPERVISION

REVISION DATE	DESCRIPTION	MADE BY	APPROVED
COMMUNITY PLANNING INCORPORATED CIVIL ENGINEERS - SURVEYORS - CONSULTANT PLANNERS			
WEST BEACH RESORT PHASE IIB HONOLULU, EWA, OAHU, HAWAII DEVELOPER: WEST BEACH ESTATES TAX MAP KEY: 9-1-15: PORS. 3 & 4			
CROSS SECTIONS ACCESS ROAD "B2"			
APPROVED: <i>Bernard P. Kwa</i> REGISTERED PROFESSIONAL ENGINEER			