


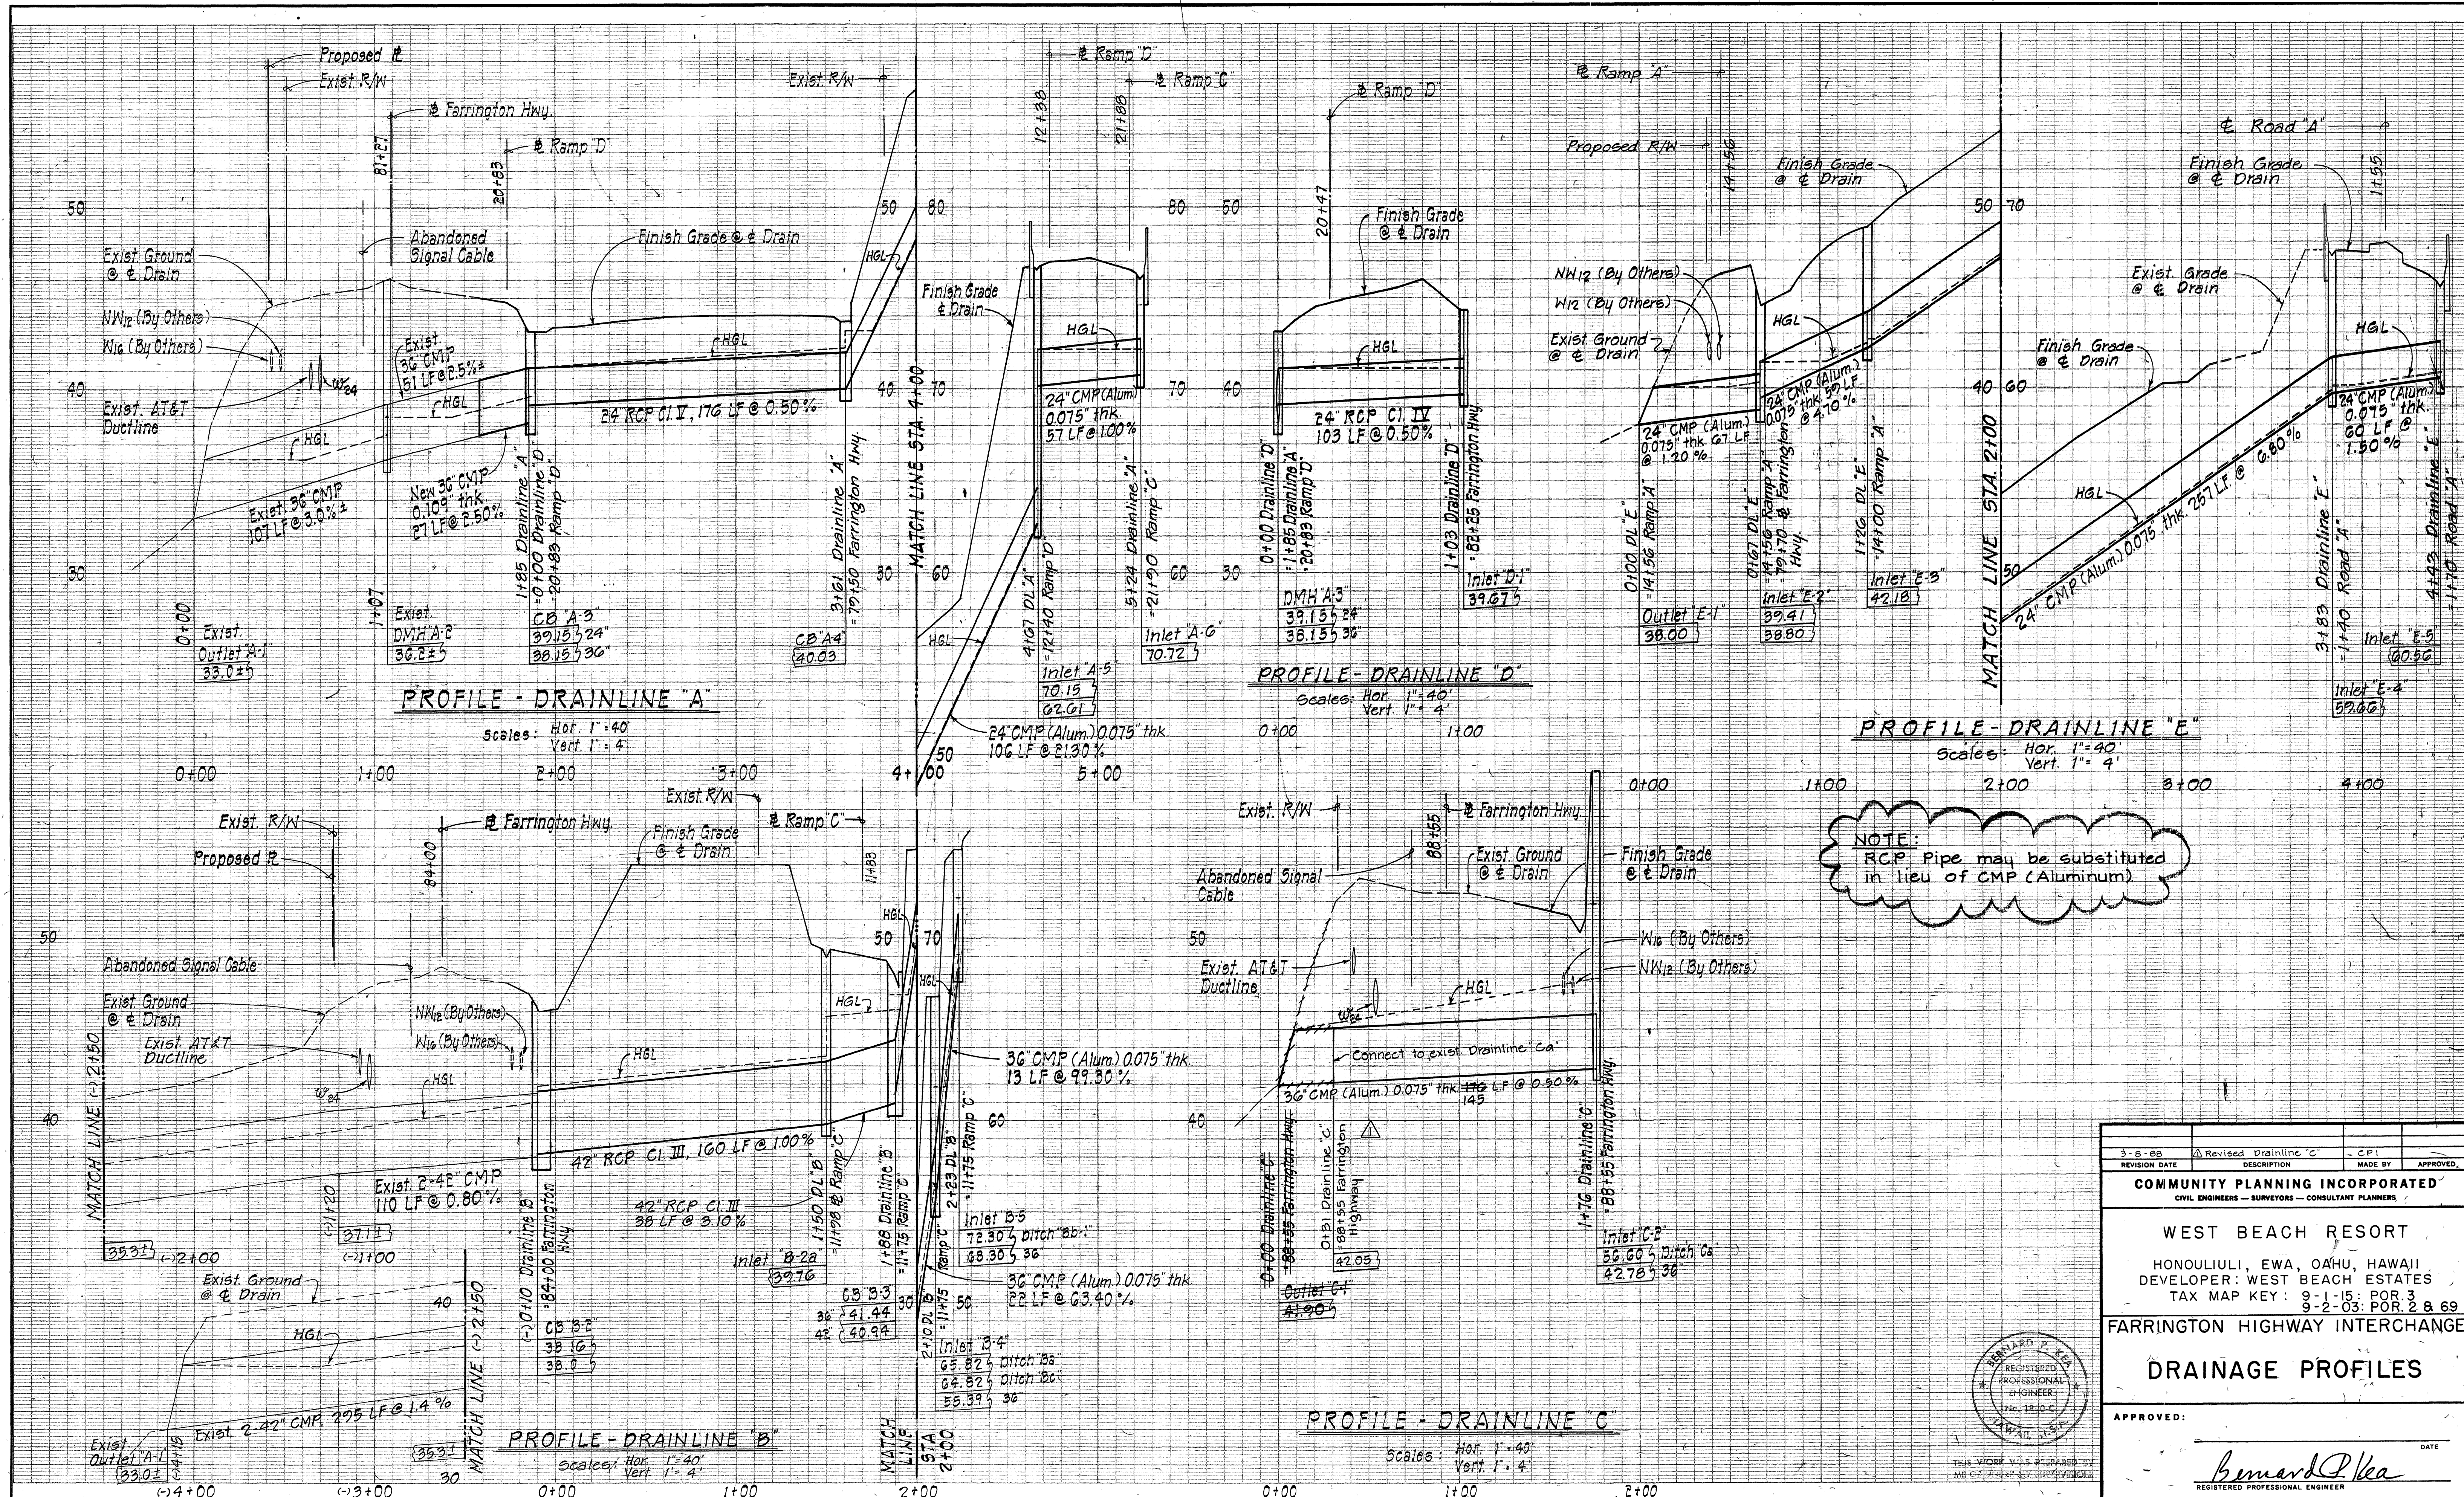

3-8-88	Revised Drainline "C"	CPI	
REVISION DATE	DESCRIPTION	MADE BY	APPROVED
COMMUNITY PLANNING INCORPORATED CIVIL ENGINEERS - SURVEYORS - CONSULTANT PLANNERS			
WEST BEACH RESORT HONOLULU, EWA, OAHU, HAWAII DEVELOPER: WEST BEACH ESTATES TAX MAP KEY: 9-1-15; POR 3 9-2-03; POR 2 & 69			
FARRINGTON HIGHWAY INTERCHANGE			
DRAINAGE PROFILES			
APPROVED: <i>Bernard P. Kea</i> DATE:			
REGISTERED PROFESSIONAL ENGINEER No. 12,100-C HAWAII			
THIS WORK WAS PREPARED BY MR. C. J. JENSEN BY SUPERVISION			
FILE	POCKET	FOLDER	NO.

RECORD DRAINAGE