





TRUE NORTH
Scale: 1"=40'

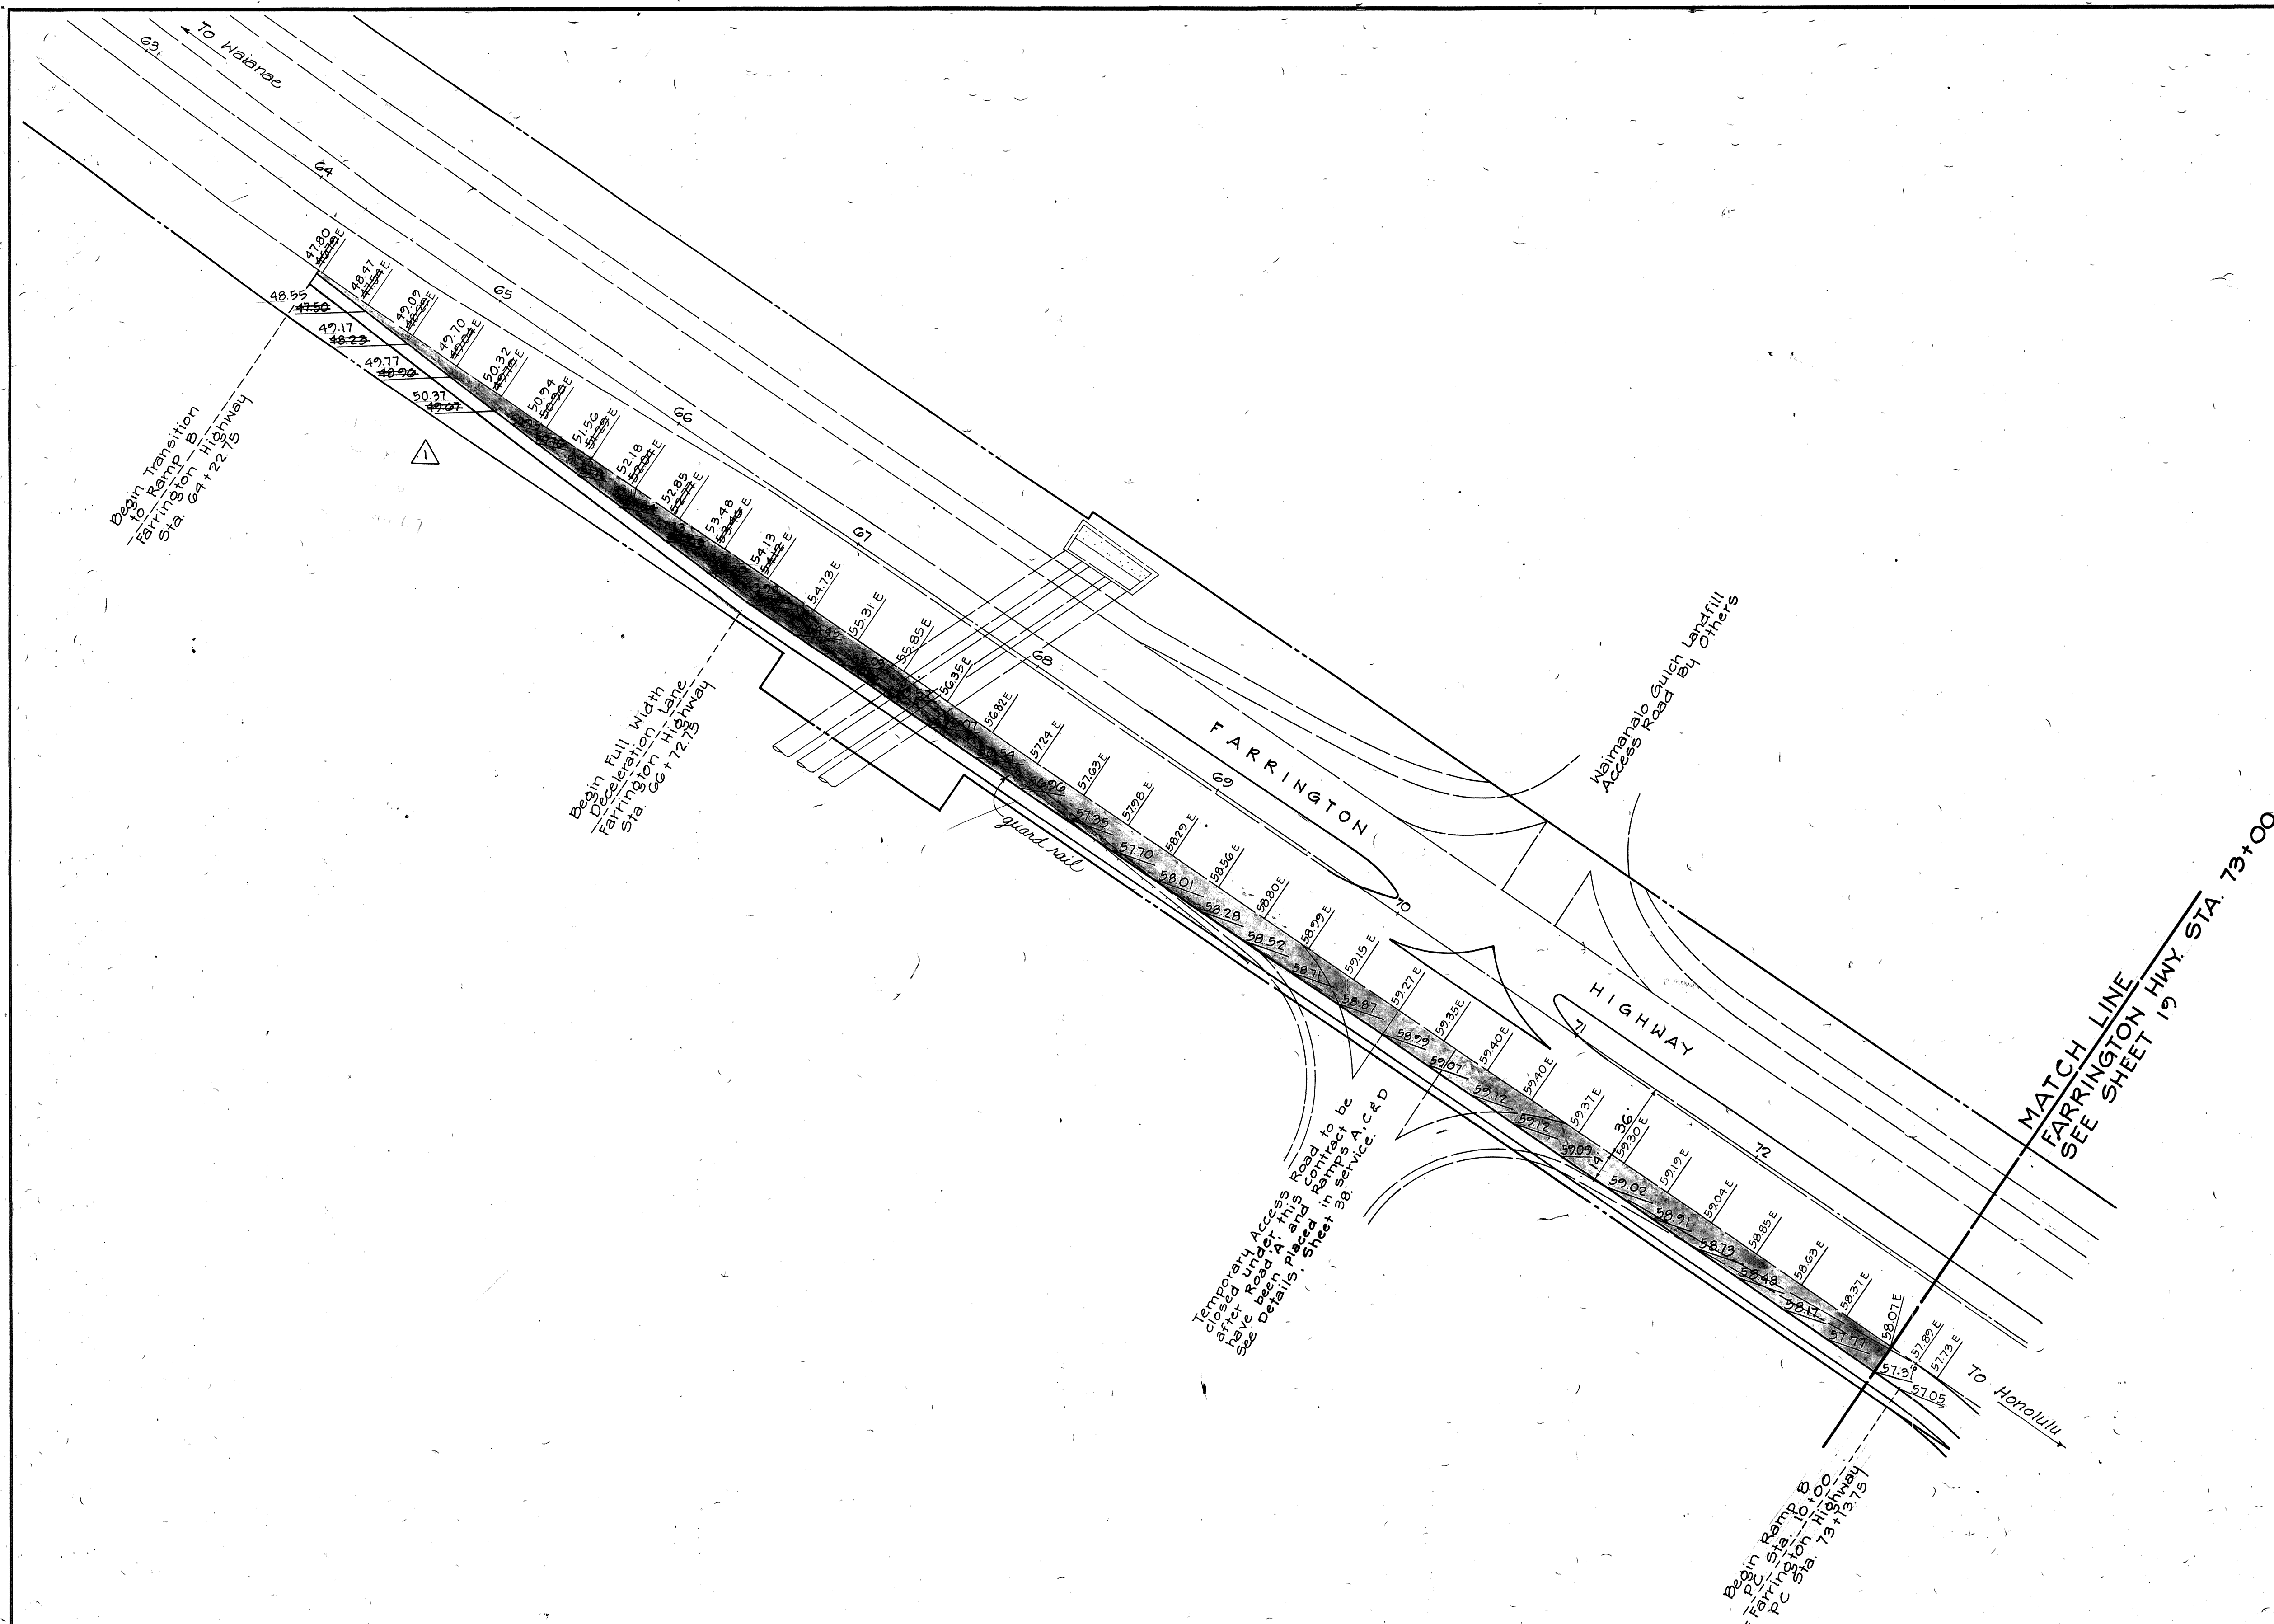


THIS WORK WAS PREPARED BY
ME OR UNDER MY SUPERVISION.

3-9-89	Revised Grades	CPI	APPROVED
REVISION DATE	DESCRIPTION	MADE BY	APPROVED
COMMUNITY PLANNING INCORPORATED CIVIL ENGINEERS — SURVEYORS — CONSULTANT PLANNERS			
WEST BEACH RESORT HONOLULU, EWA, OAHU, HAWAII DEVELOPER: WEST BEACH ESTATES TAX MAP KEY: 9-1-15: POR. 3 9-2-03: POR. 2 & 69			
FARRINGTON HIGHWAY INTERCHANGE			
RAMP TERMINAL DETAILS			
APPROVED: Bernard P. Kea REGISTERED PROFESSIONAL ENGINEER			

RECORD DRAWINGS

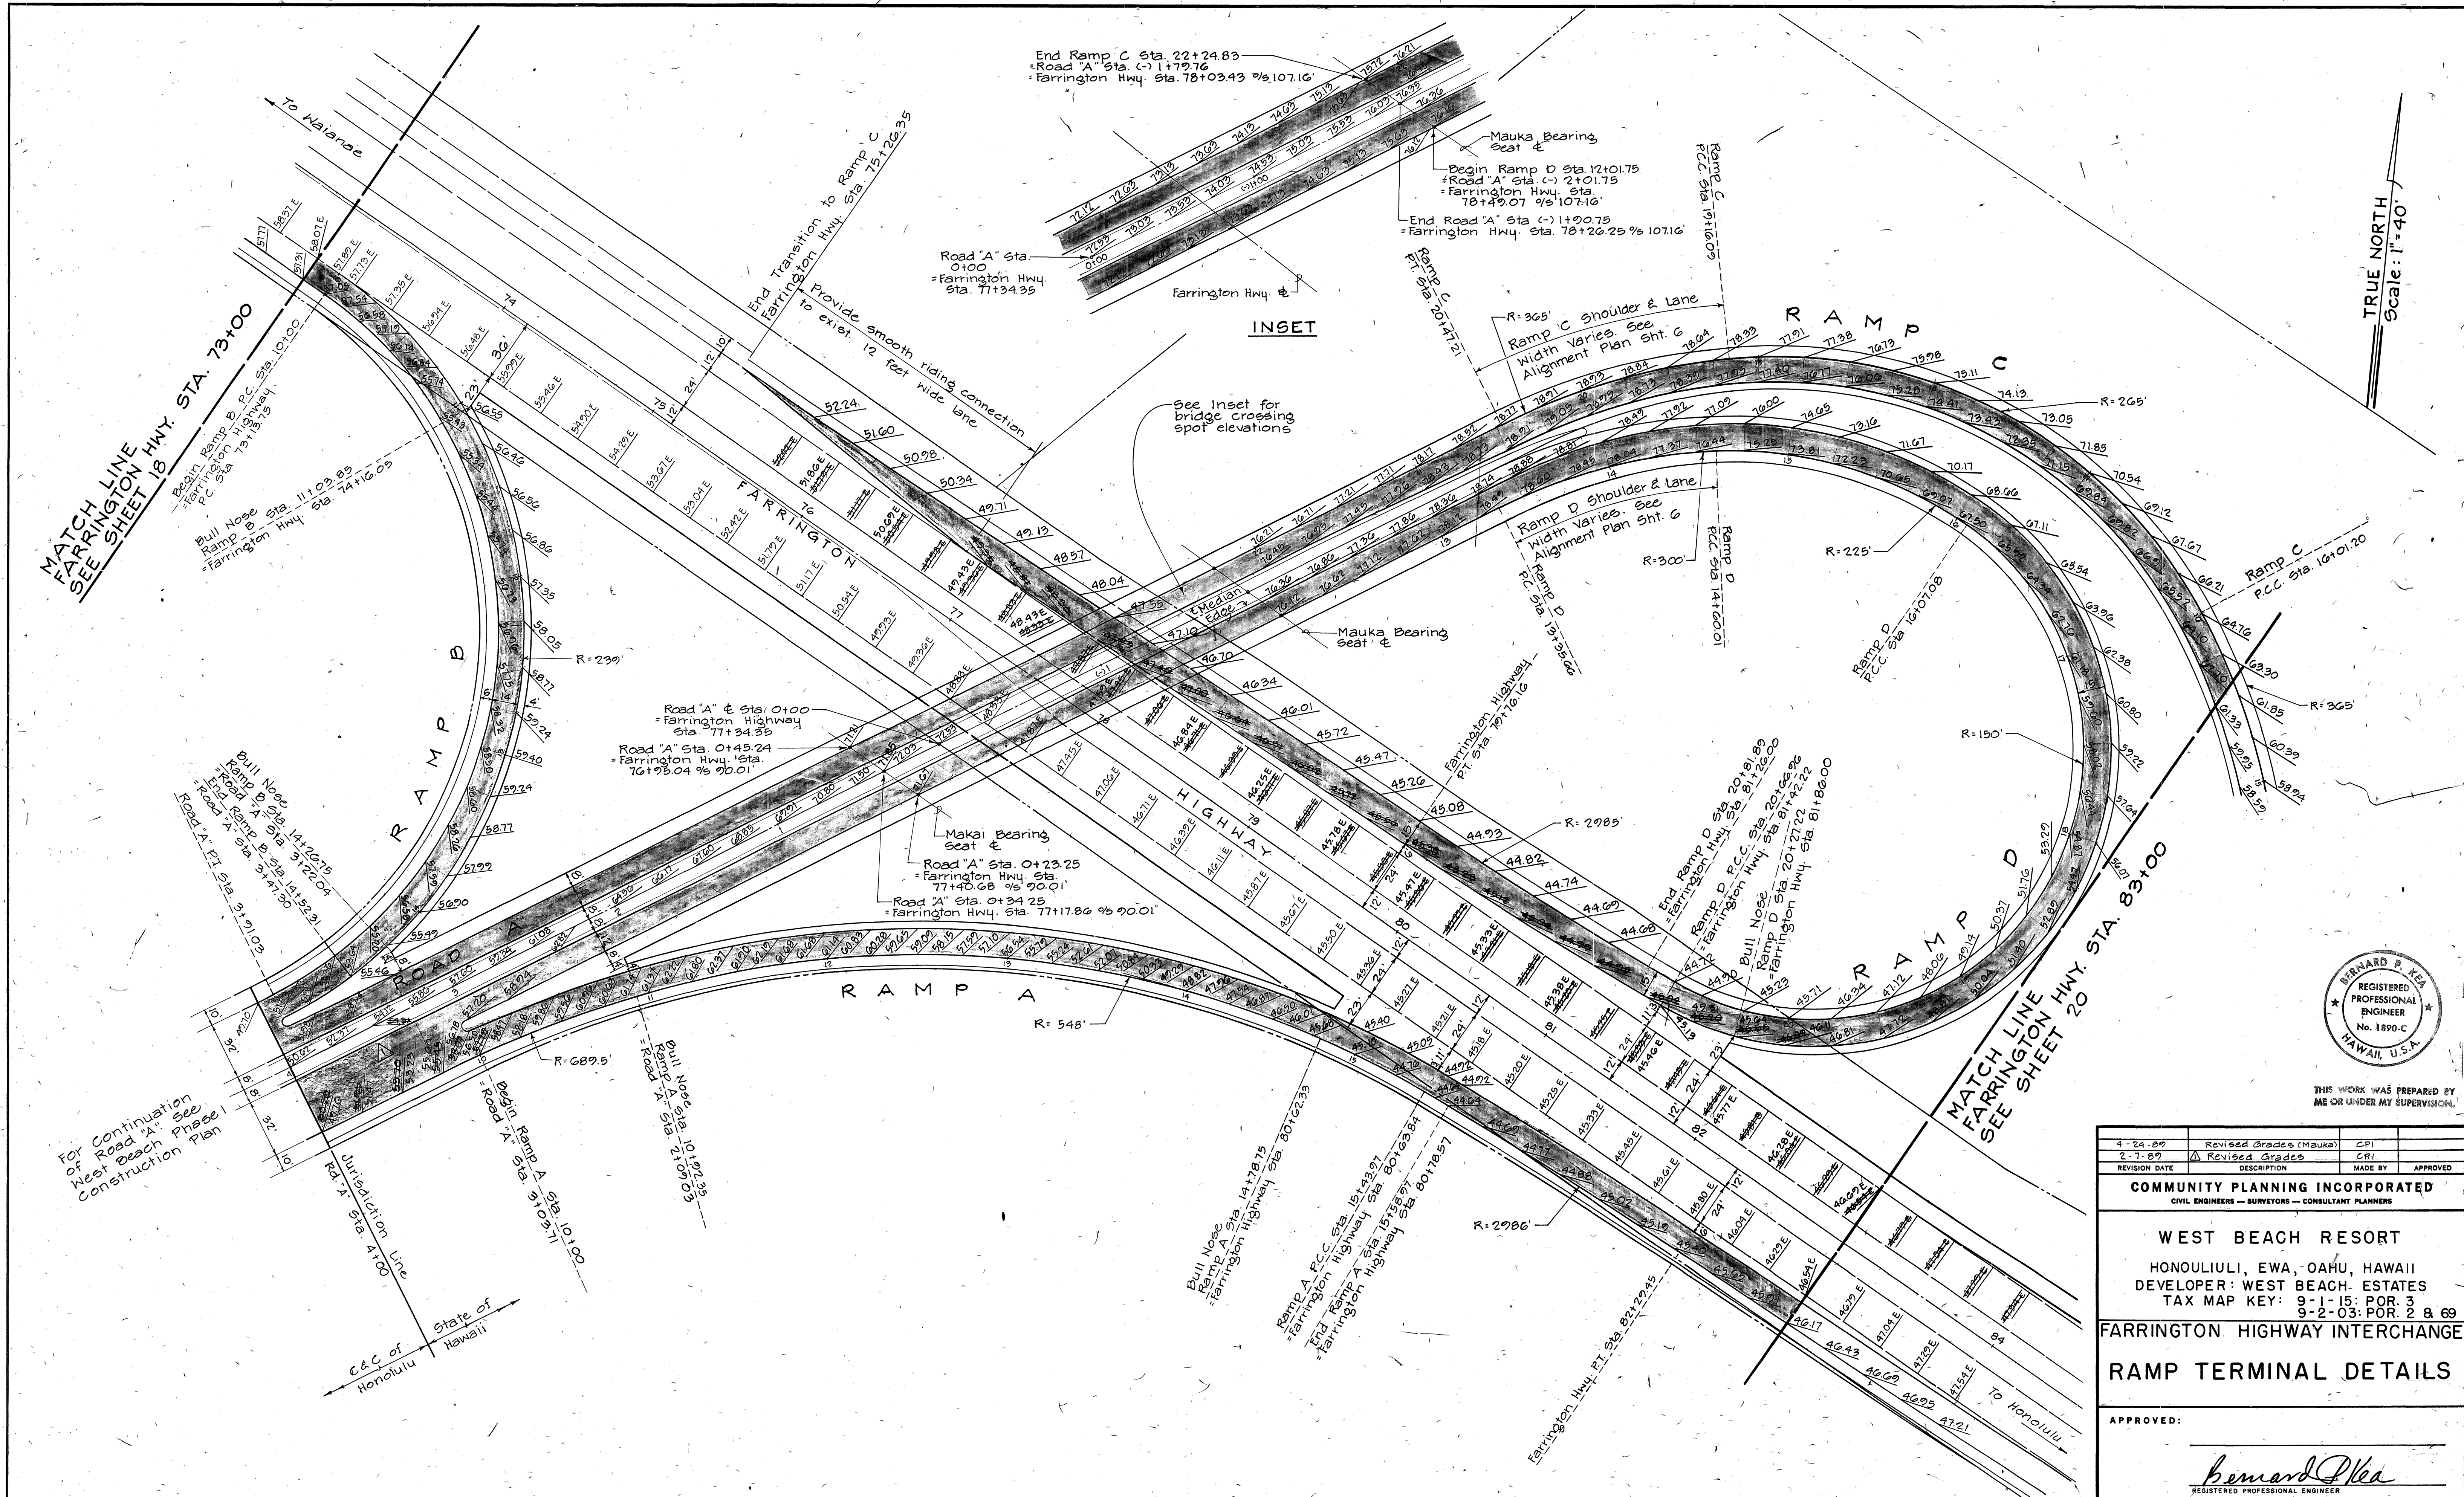

TRUE NORTH
Scale: 1"=40'

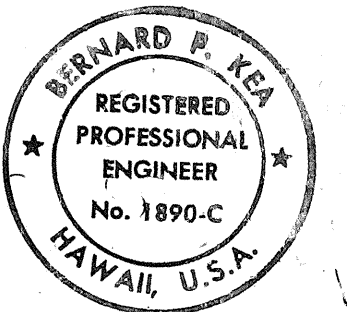


THIS WORK WAS PREPARED BY
ME OR UNDER MY SUPERVISION.


4-24-89	Revised Grades (Mauka)	CPI
2-7-89	Revised Grades	CPI
REVISION DATE	DESCRIPTION	MADE BY APPROVED
COMMUNITY PLANNING INCORPORATED		
CIVIL ENGINEERS - SURVEYORS - CONSULTANT PLANNERS		
WEST BEACH RESORT		
HONOLULU, EWA, OAHU, HAWAII		
DEVELOPER: WEST BEACH ESTATES		
TAX MAP KEY: 9-1-15; POR. 3		
9-2-03; POR. 2 & 69		
FARRINGTON HIGHWAY INTERCHANGE		
RAMP TERMINAL DETAILS		
APPROVED:		
Bernard P. Kea		
REGISTERED PROFESSIONAL ENGINEER		
FILE	POCKET	FOLDER NO.

RECORD DRAWING

SHEET 12 OF 22 SHEETS

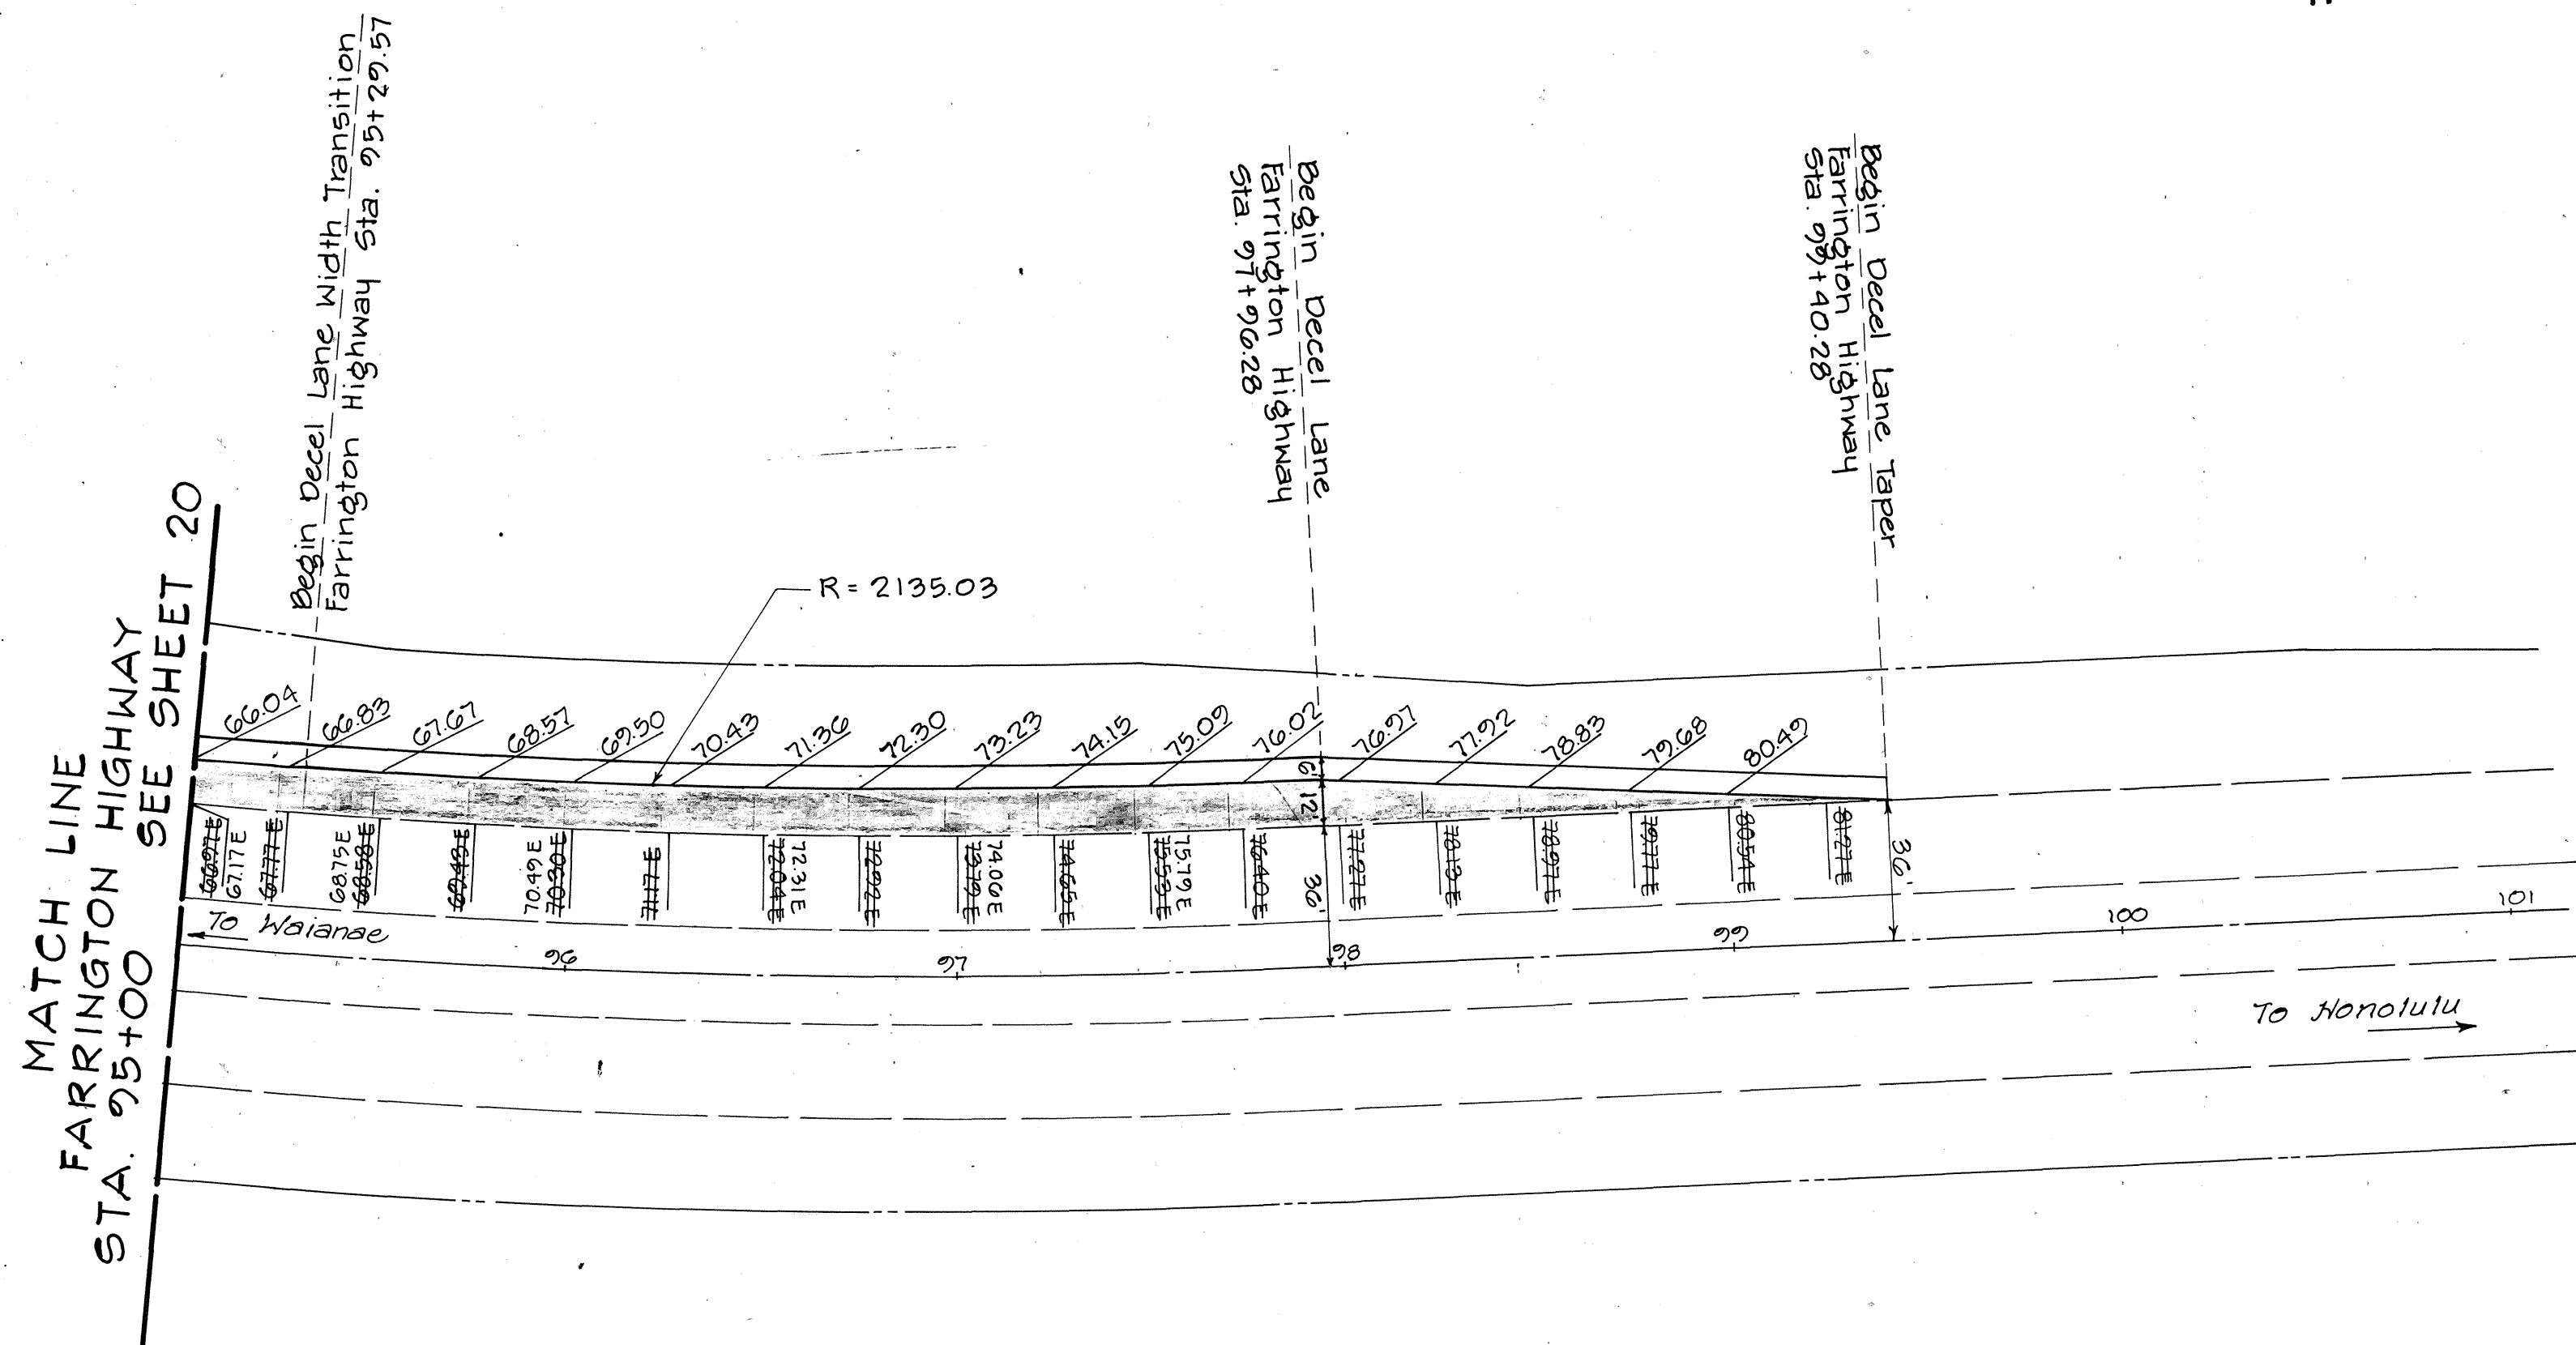

TRUE NORTH
Scale: 1"=40'

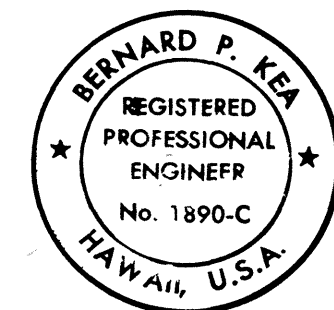

THIS WORK WAS PREPARED BY
ME OR UNDER MY SUPERVISION.

4-24-89	Revised Grades (Mauka)	CPI	
REVISION DATE	DESCRIPTION	MADE BY	APPROVED
COMMUNITY PLANNING INCORPORATED CIVIL ENGINEERS — SURVEYORS — CONSULTANT PLANNERS			
WEST BEACH RESORT HONOLULU, EWA, OAHU, HAWAII DEVELOPER: WEST BEACH ESTATES TAX MAP KEY: 9-1-15: POR. 3 9-2-03: POR. 2 & 69			
FARRINGTON HIGHWAY INTERCHANGE RAMP TERMINAL DETAILS			
APPROVED: <i>Bernard P. Kea</i> REGISTERED PROFESSIONAL ENGINEER			