


THIS WORK WAS PREPARED BY ME OR UNDER MY SUPERVISION.

| REVISION DATE | DESCRIPTION | MADE BY | APPROVED |
|--|-------------|---------|----------|
| COMMUNITY PLANNING INCORPORATED CIVIL ENGINEERS - SURVEYORS - CONSULTANT PLANNERS | | | |
| WEST BEACH RESORT HONOLULU, EWA, OAHU, HAWAII DEVELOPER: WEST BEACH ESTATES TAX MAP KEY: 9-1-15: POR. 3 9-2-03: POR. 2 & 69 | | | |
| FARRINGTON HIGHWAY INTERCHANGE SIGNING AND STRIPING PLAN | | | |
| APPROVED: <i>Bernard P. Kea</i> REGISTERED PROFESSIONAL ENGINEER | | | |

RECORD DRAWING

SHEET 22 OF 27 SHEETS

TRUE NORTH
Scale: 1"=40'

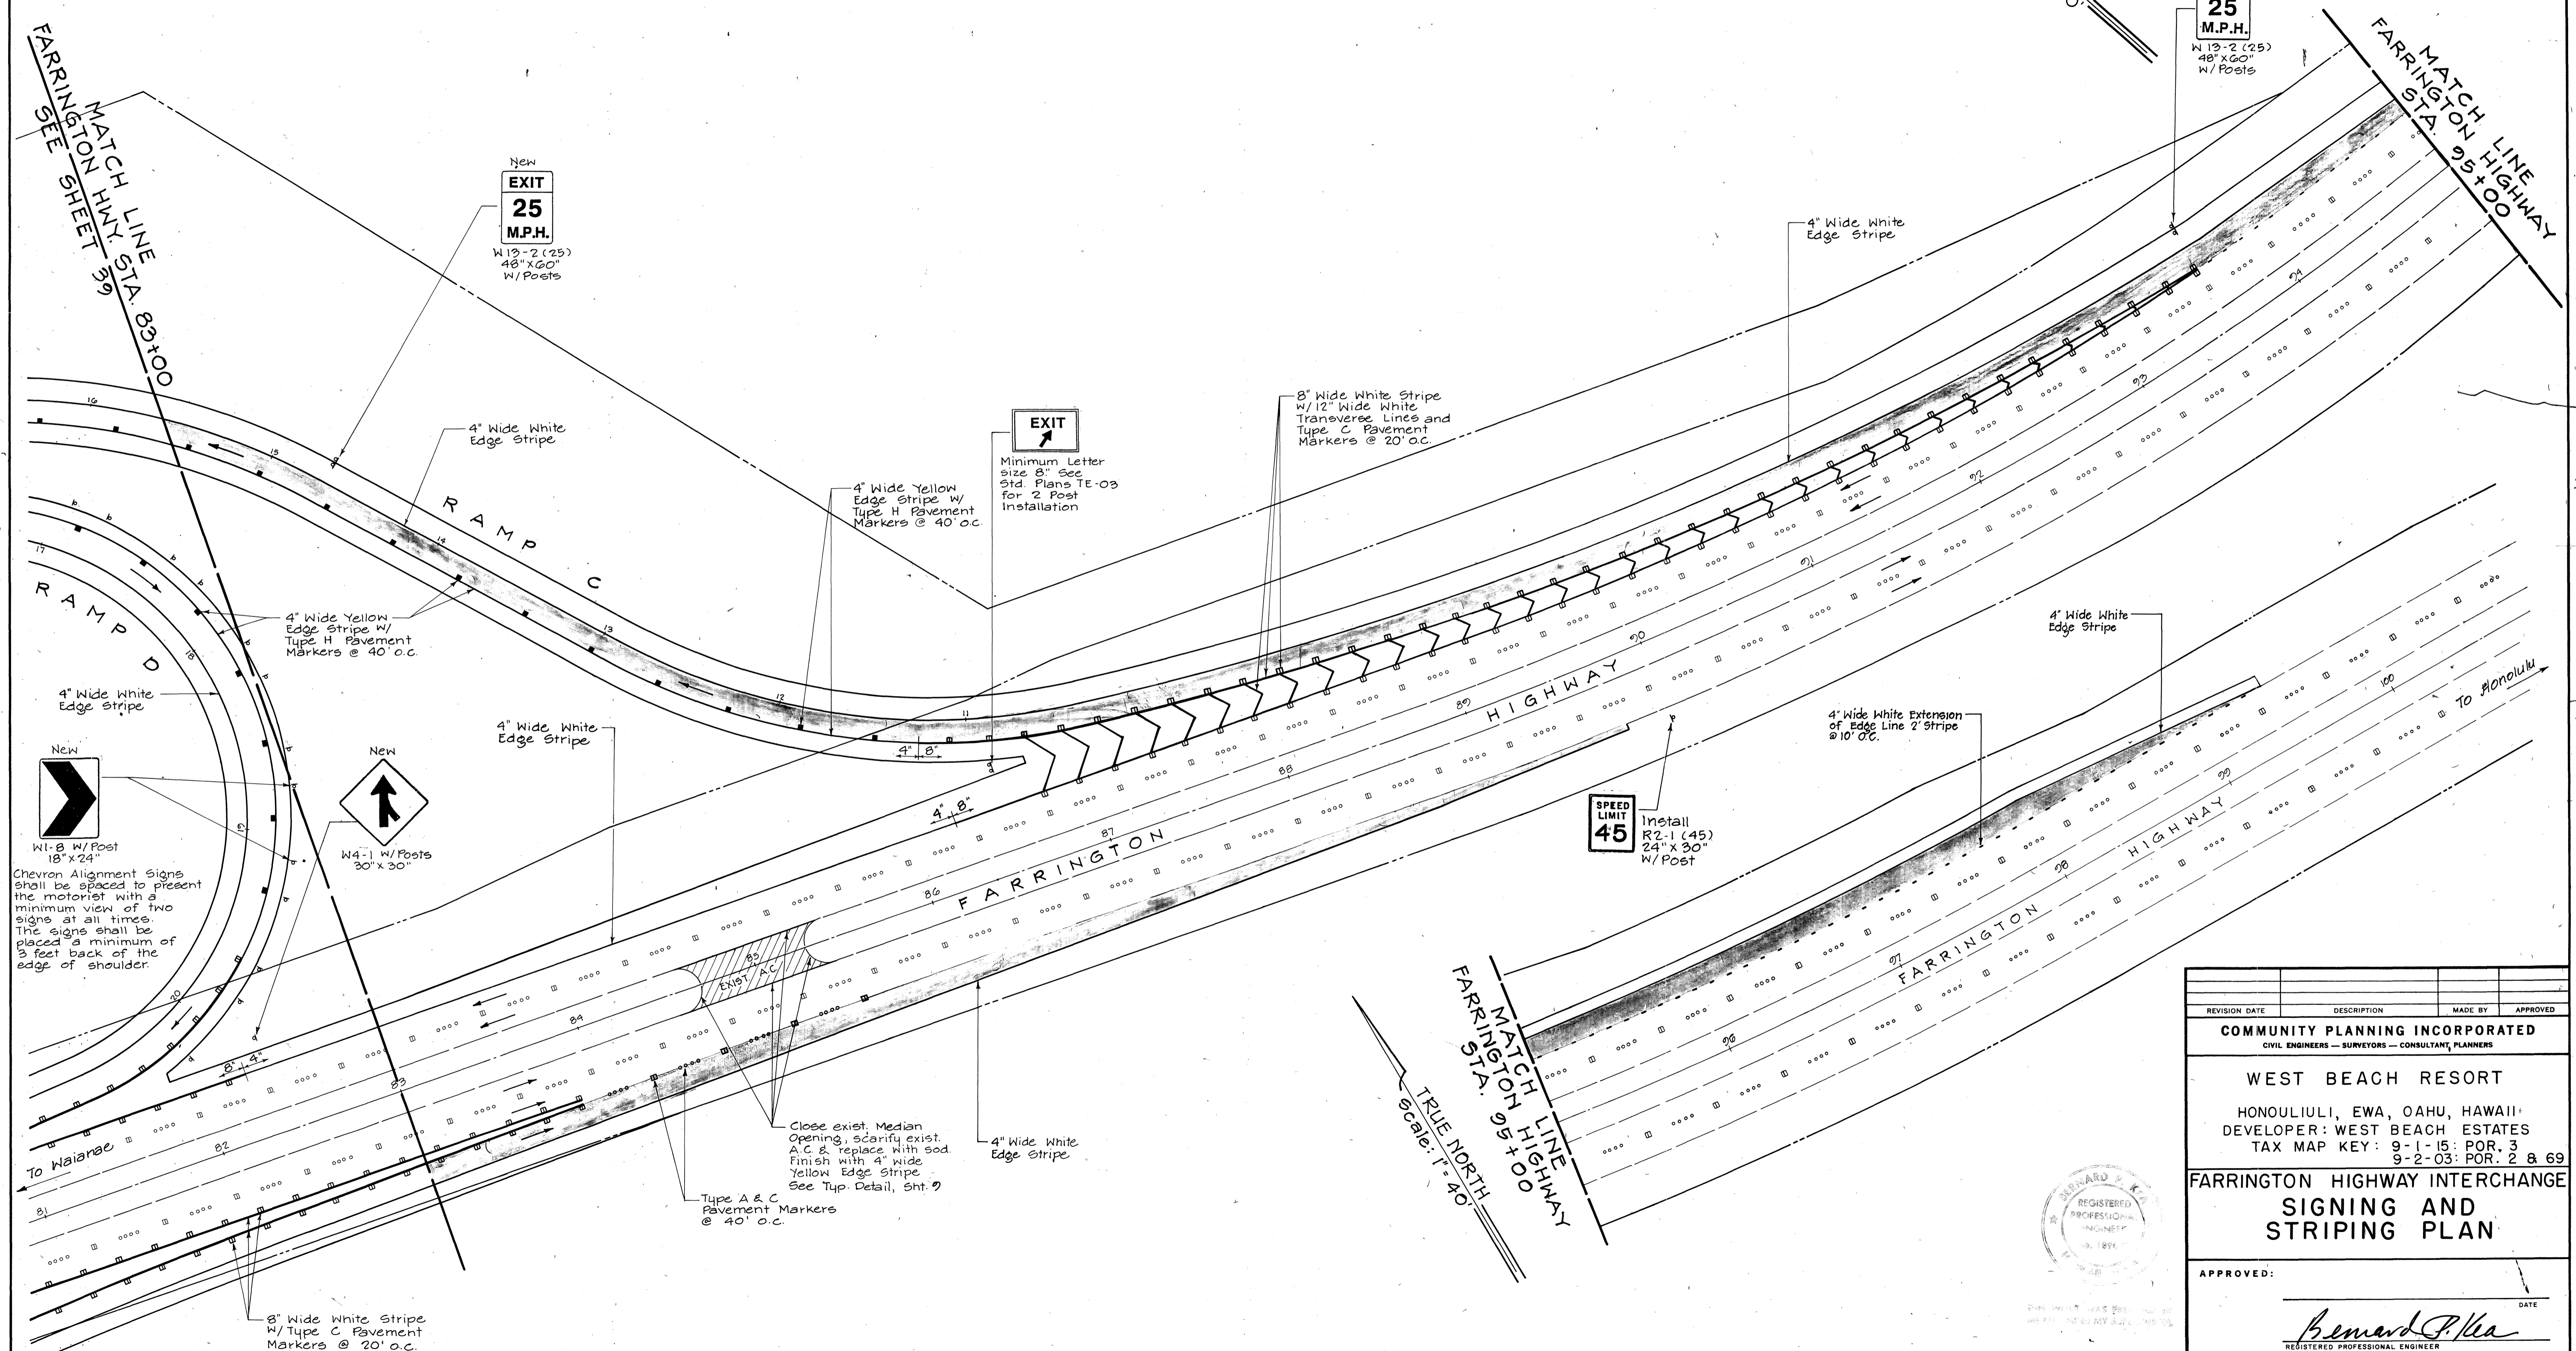

New
EXIT
25
M.P.H.
W13-2 (25)
48" x 60"
W/ Posts

EXIT
Minimum Letter
size 8" Sec
Std. Plans TE-03
for 2 Post
Installation

New
EXIT
25
M.P.H.
W13-2 (25)
48" x 60"
W/ Posts

SPEED
LIMIT
45
Install
R2-1 (45)
24" x 30"
W/ Post

New
W1-B W/ Post
18" x 24"

New
W4-1 W/ Posts
30" x 30"

Chevron Alignment Signs
shall be spaced to present
the motorist with a
minimum view of two
signs at all times.
The signs shall be
placed a minimum of
3 feet back of the
edge of shoulder.

Type A & C
Pavement Markers
@ 40' o.c.

Close exist. Median
Opening, scarify exist.
A.C. & replace with sod.
Finish with 4" wide
Yellow Edge Stripe
See Typ. Detail, Sht. 9

8" Wide White Stripe
W/ Type C Pavement
Markers @ 20' o.c.

| REVISION DATE | DESCRIPTION | MADE BY | APPROVED |
|--|-------------|---------|----------|
| COMMUNITY PLANNING INCORPORATED CIVIL ENGINEERS - SURVEYORS - CONSULTANTS, PLANNERS | | | |
| WEST BEACH RESORT HONOLULU, EWA, OAHU, HAWAII DEVELOPER: WEST BEACH ESTATES TAX MAP KEY: 9-1-15: POR. 3 9-2-03: POR. 2 & 69 | | | |
| FARRINGTON HIGHWAY INTERCHANGE SIGNING AND STRIPING PLAN | | | |
| APPROVED: | | | DATE |
| <i>Bernard P. Ka</i> REGISTERED PROFESSIONAL ENGINEER | | | |
| FILE | POCKET | FOLDER | NO. |