
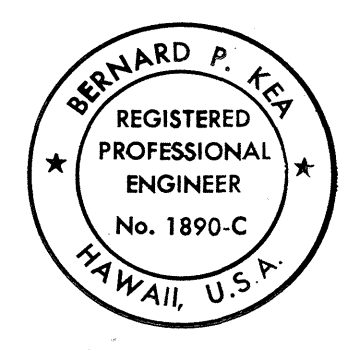
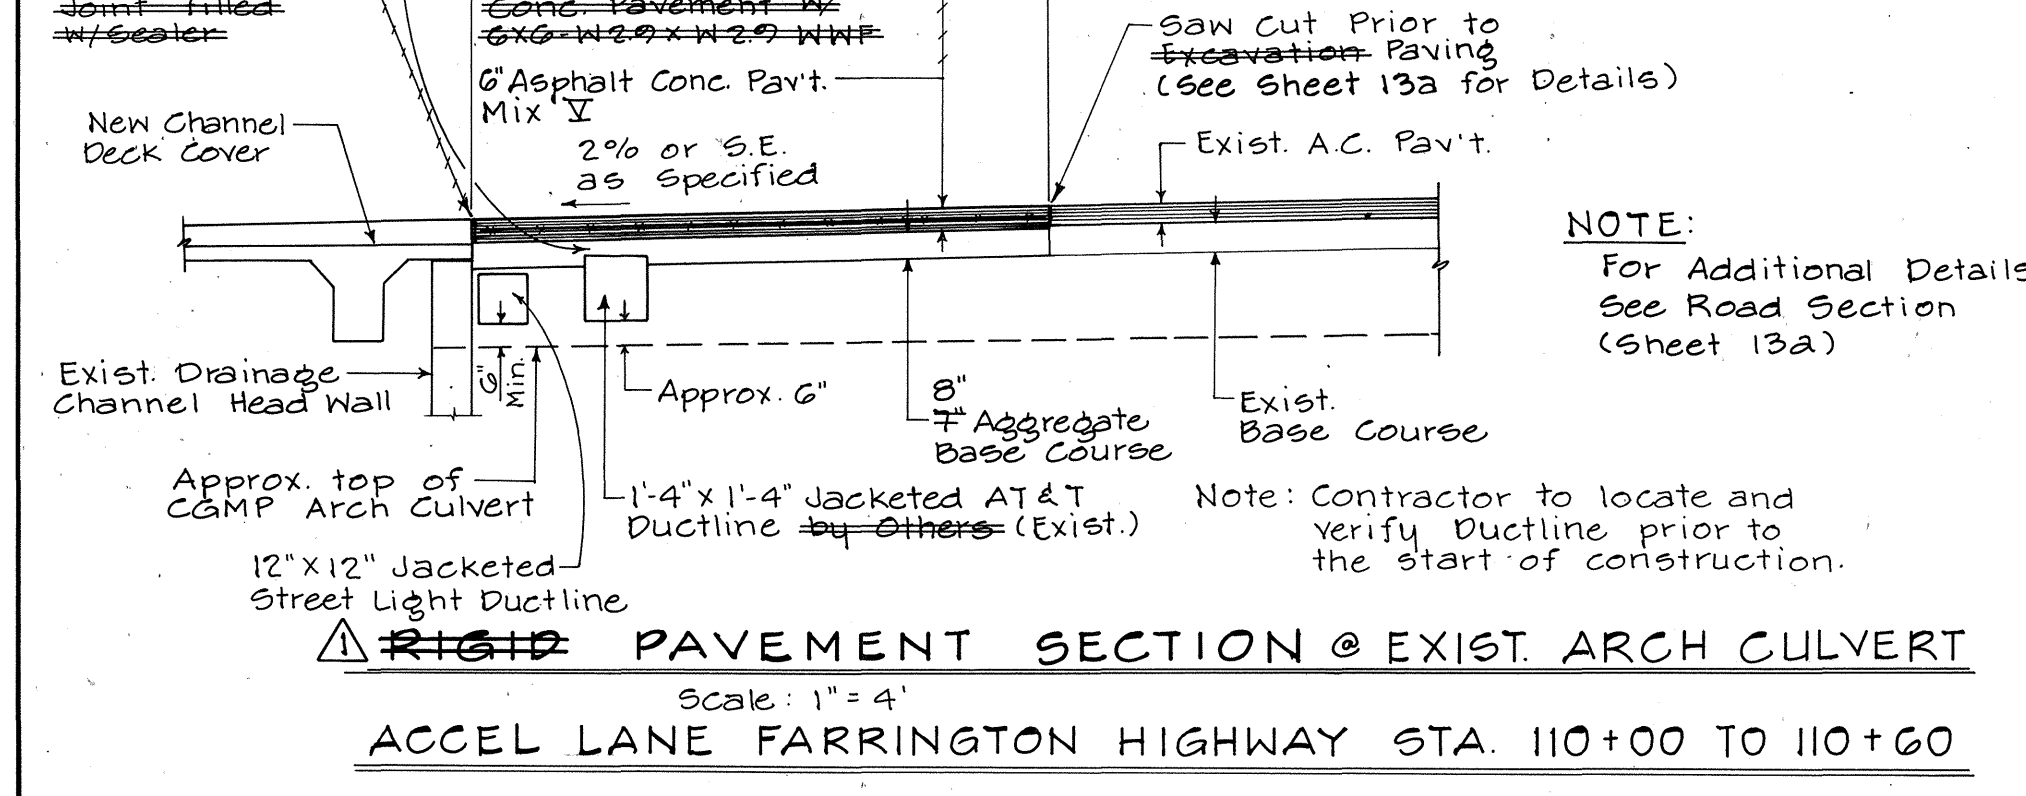
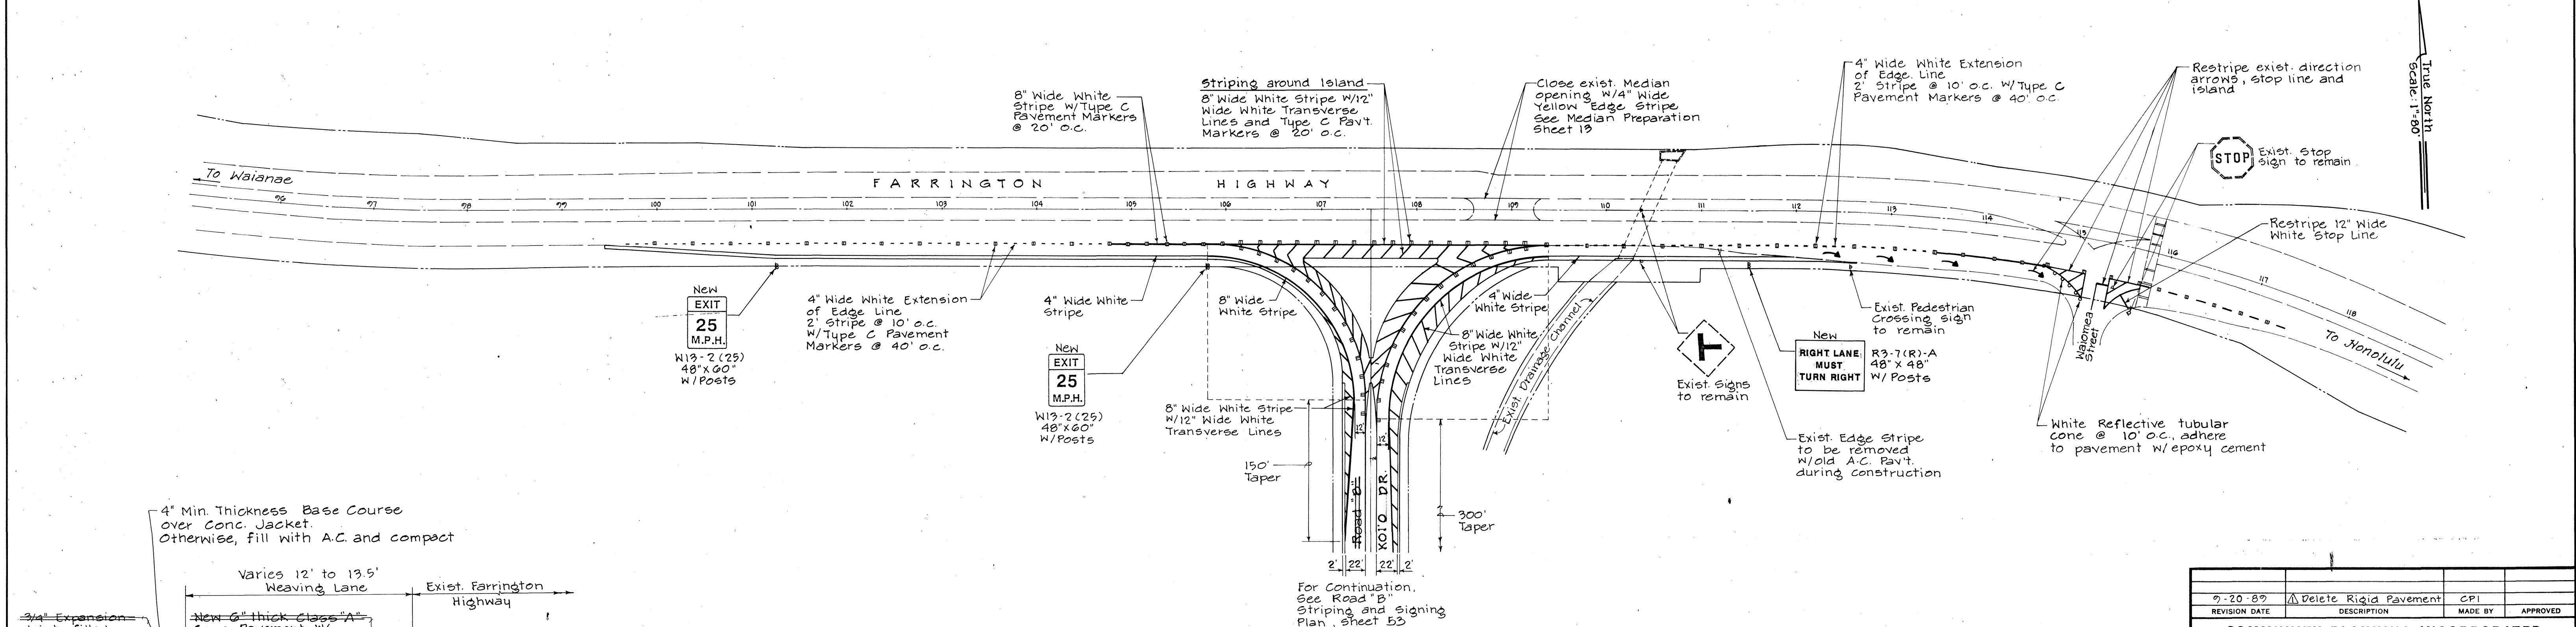


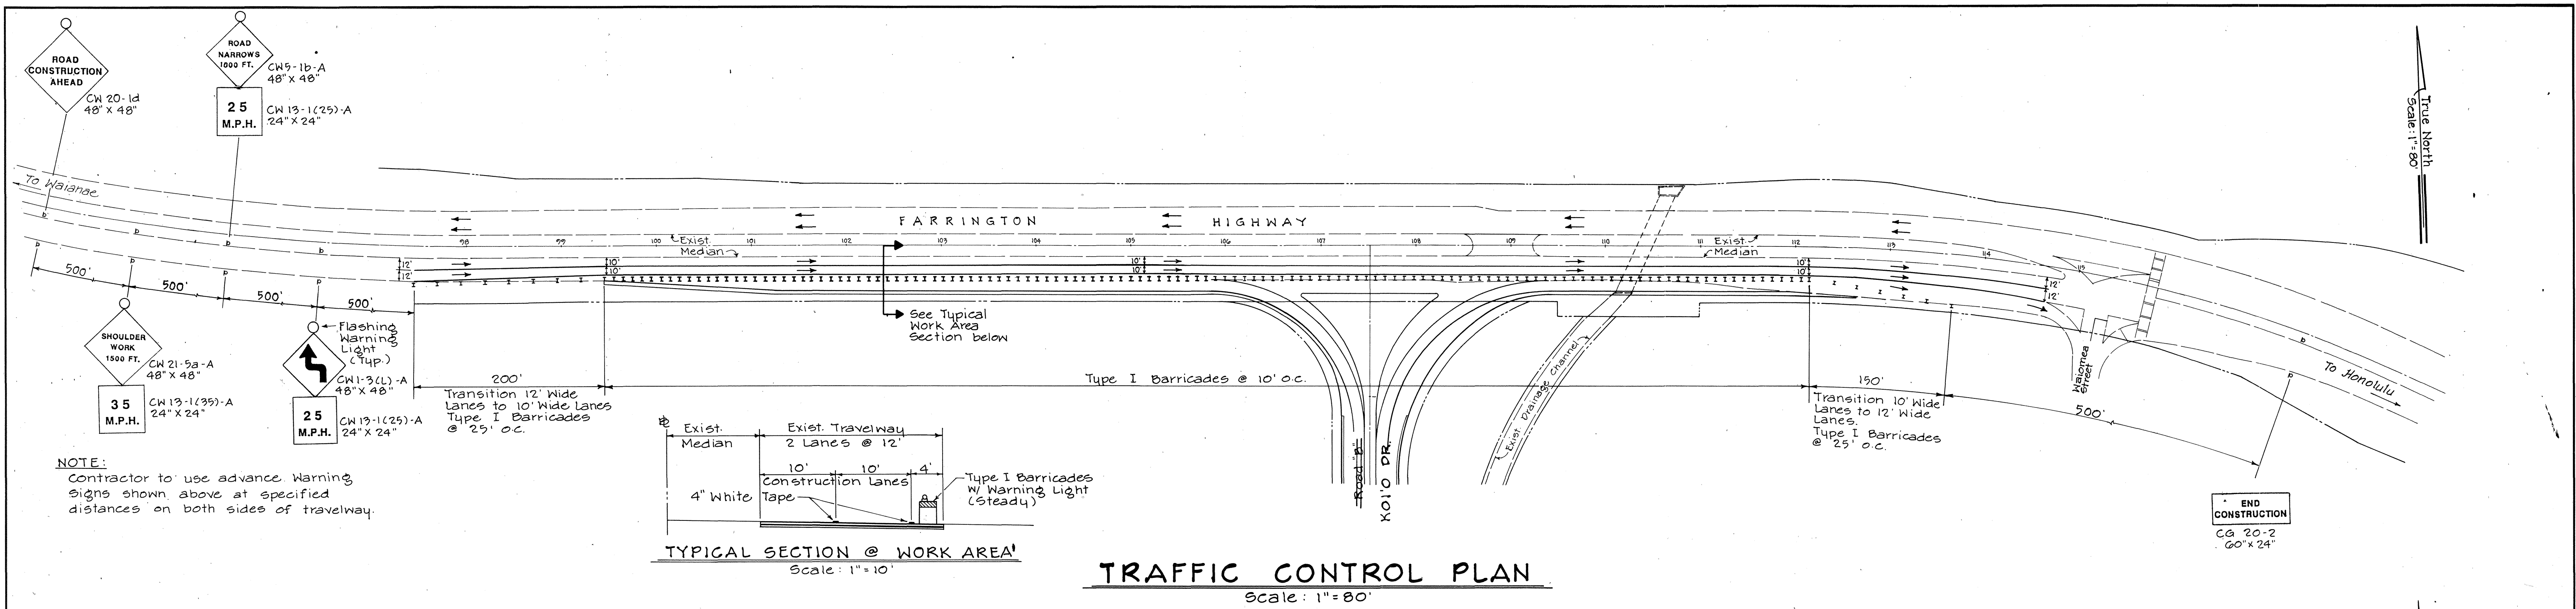

9-20-89	Delete Rigid Pavement	CPI	APPROVED
REVISION DATE	DESCRIPTION	MADE BY	APPROVED
COMMUNITY PLANNING INCORPORATED CIVIL ENGINEERS — SURVEYORS — CONSULTANT PLANNERS			
WEST BEACH RESORT PHASE IIB HONOLULU, EWA, OAHU, HAWAII DEVELOPER: WEST BEACH ESTATES TAX MAP KEY: 9-1-15:PORS. 3 & 4			
FARRINGTON HIGHWAY TRAFFIC CONTROL AND STRIPING PLAN			
APPROVED:			
THIS WORK WAS PREPARED BY ME OR UNDER MY SUPERVISION			