


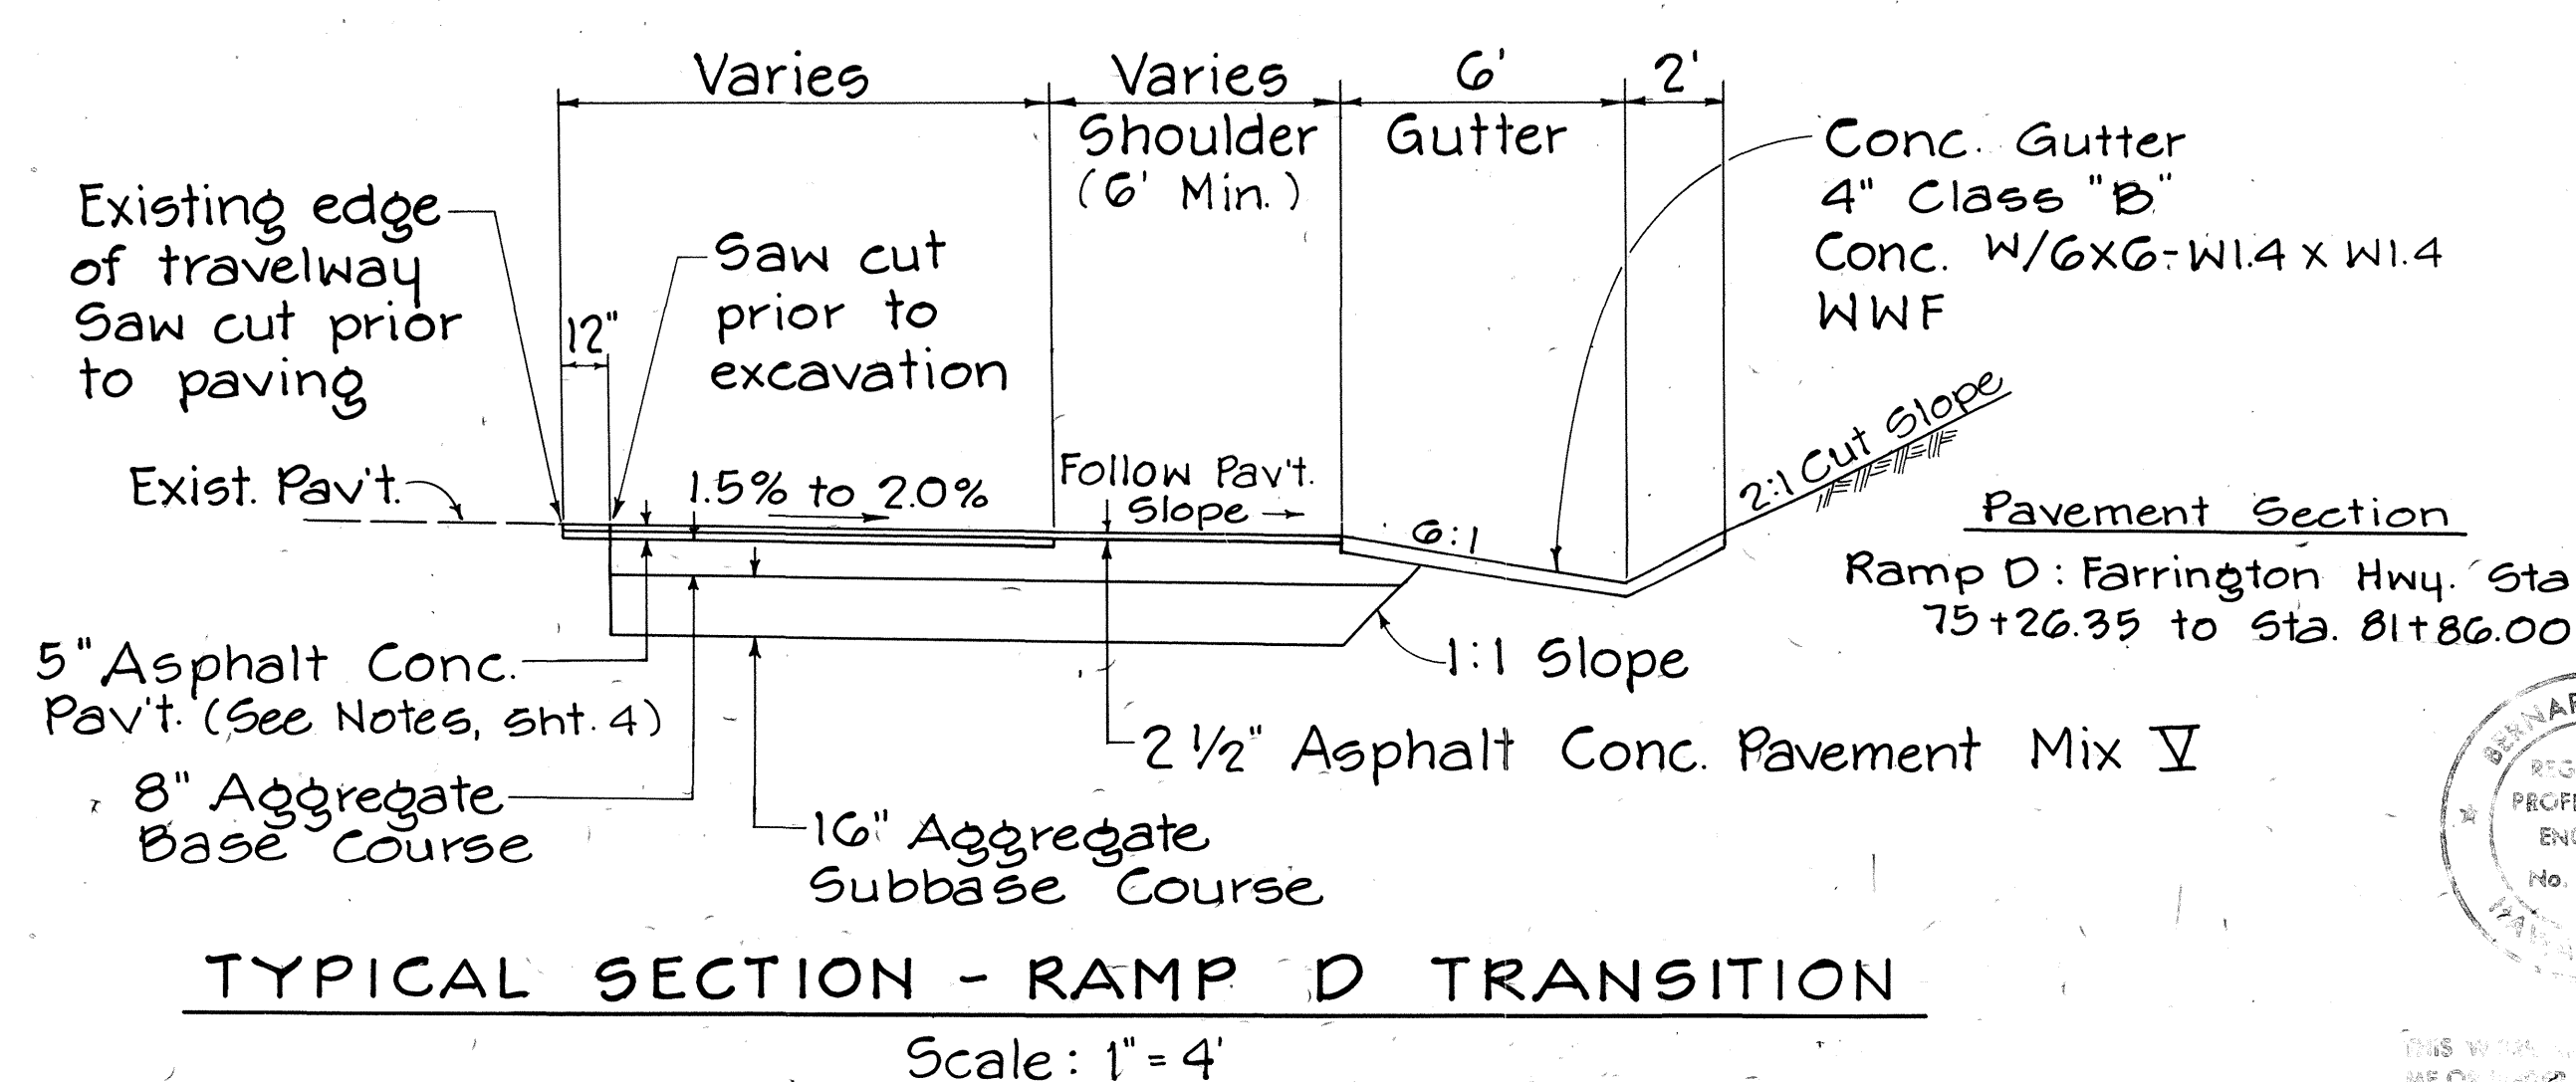
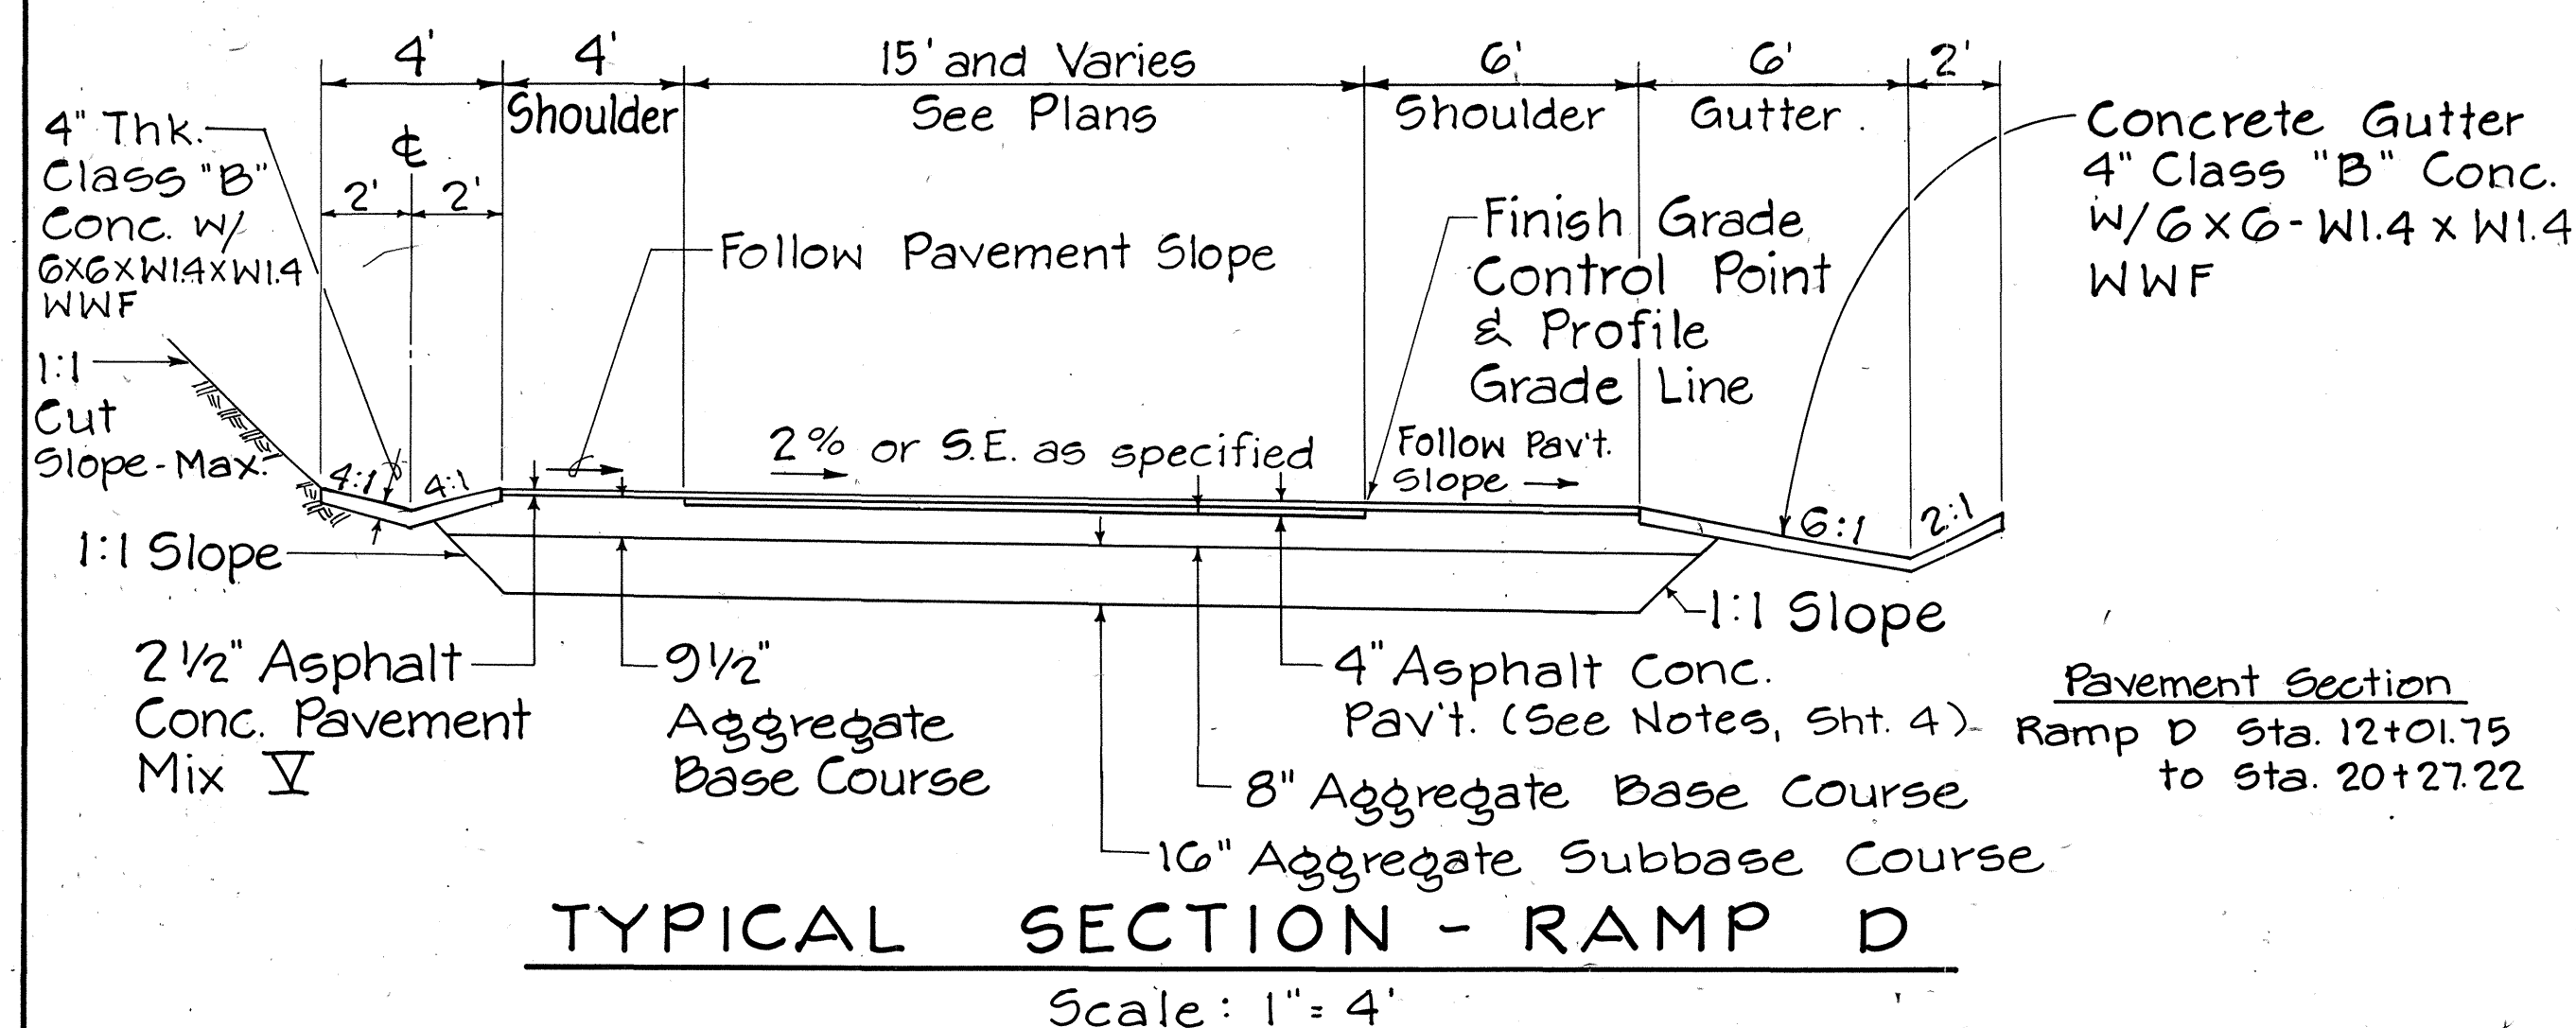
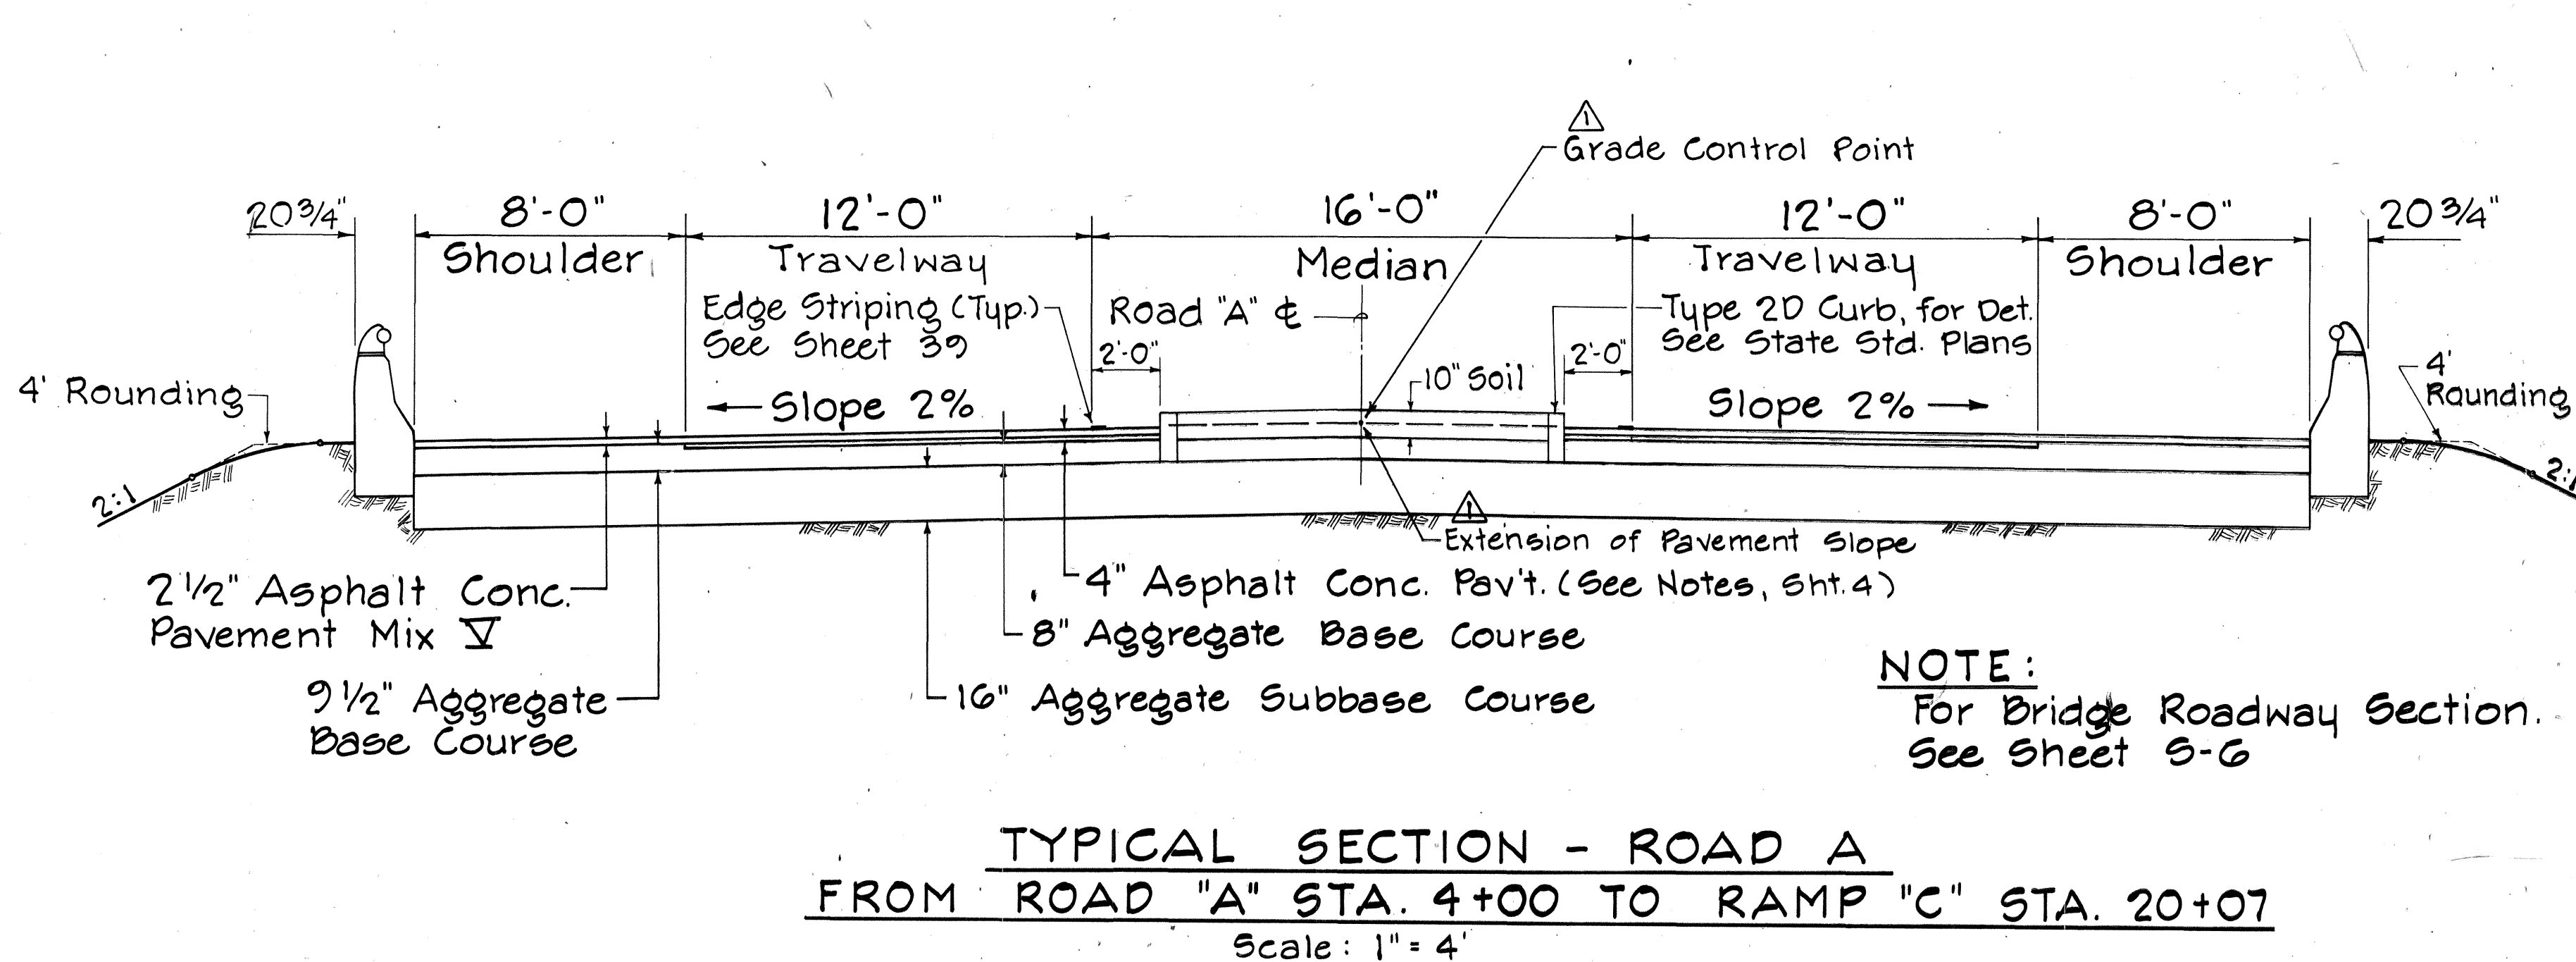
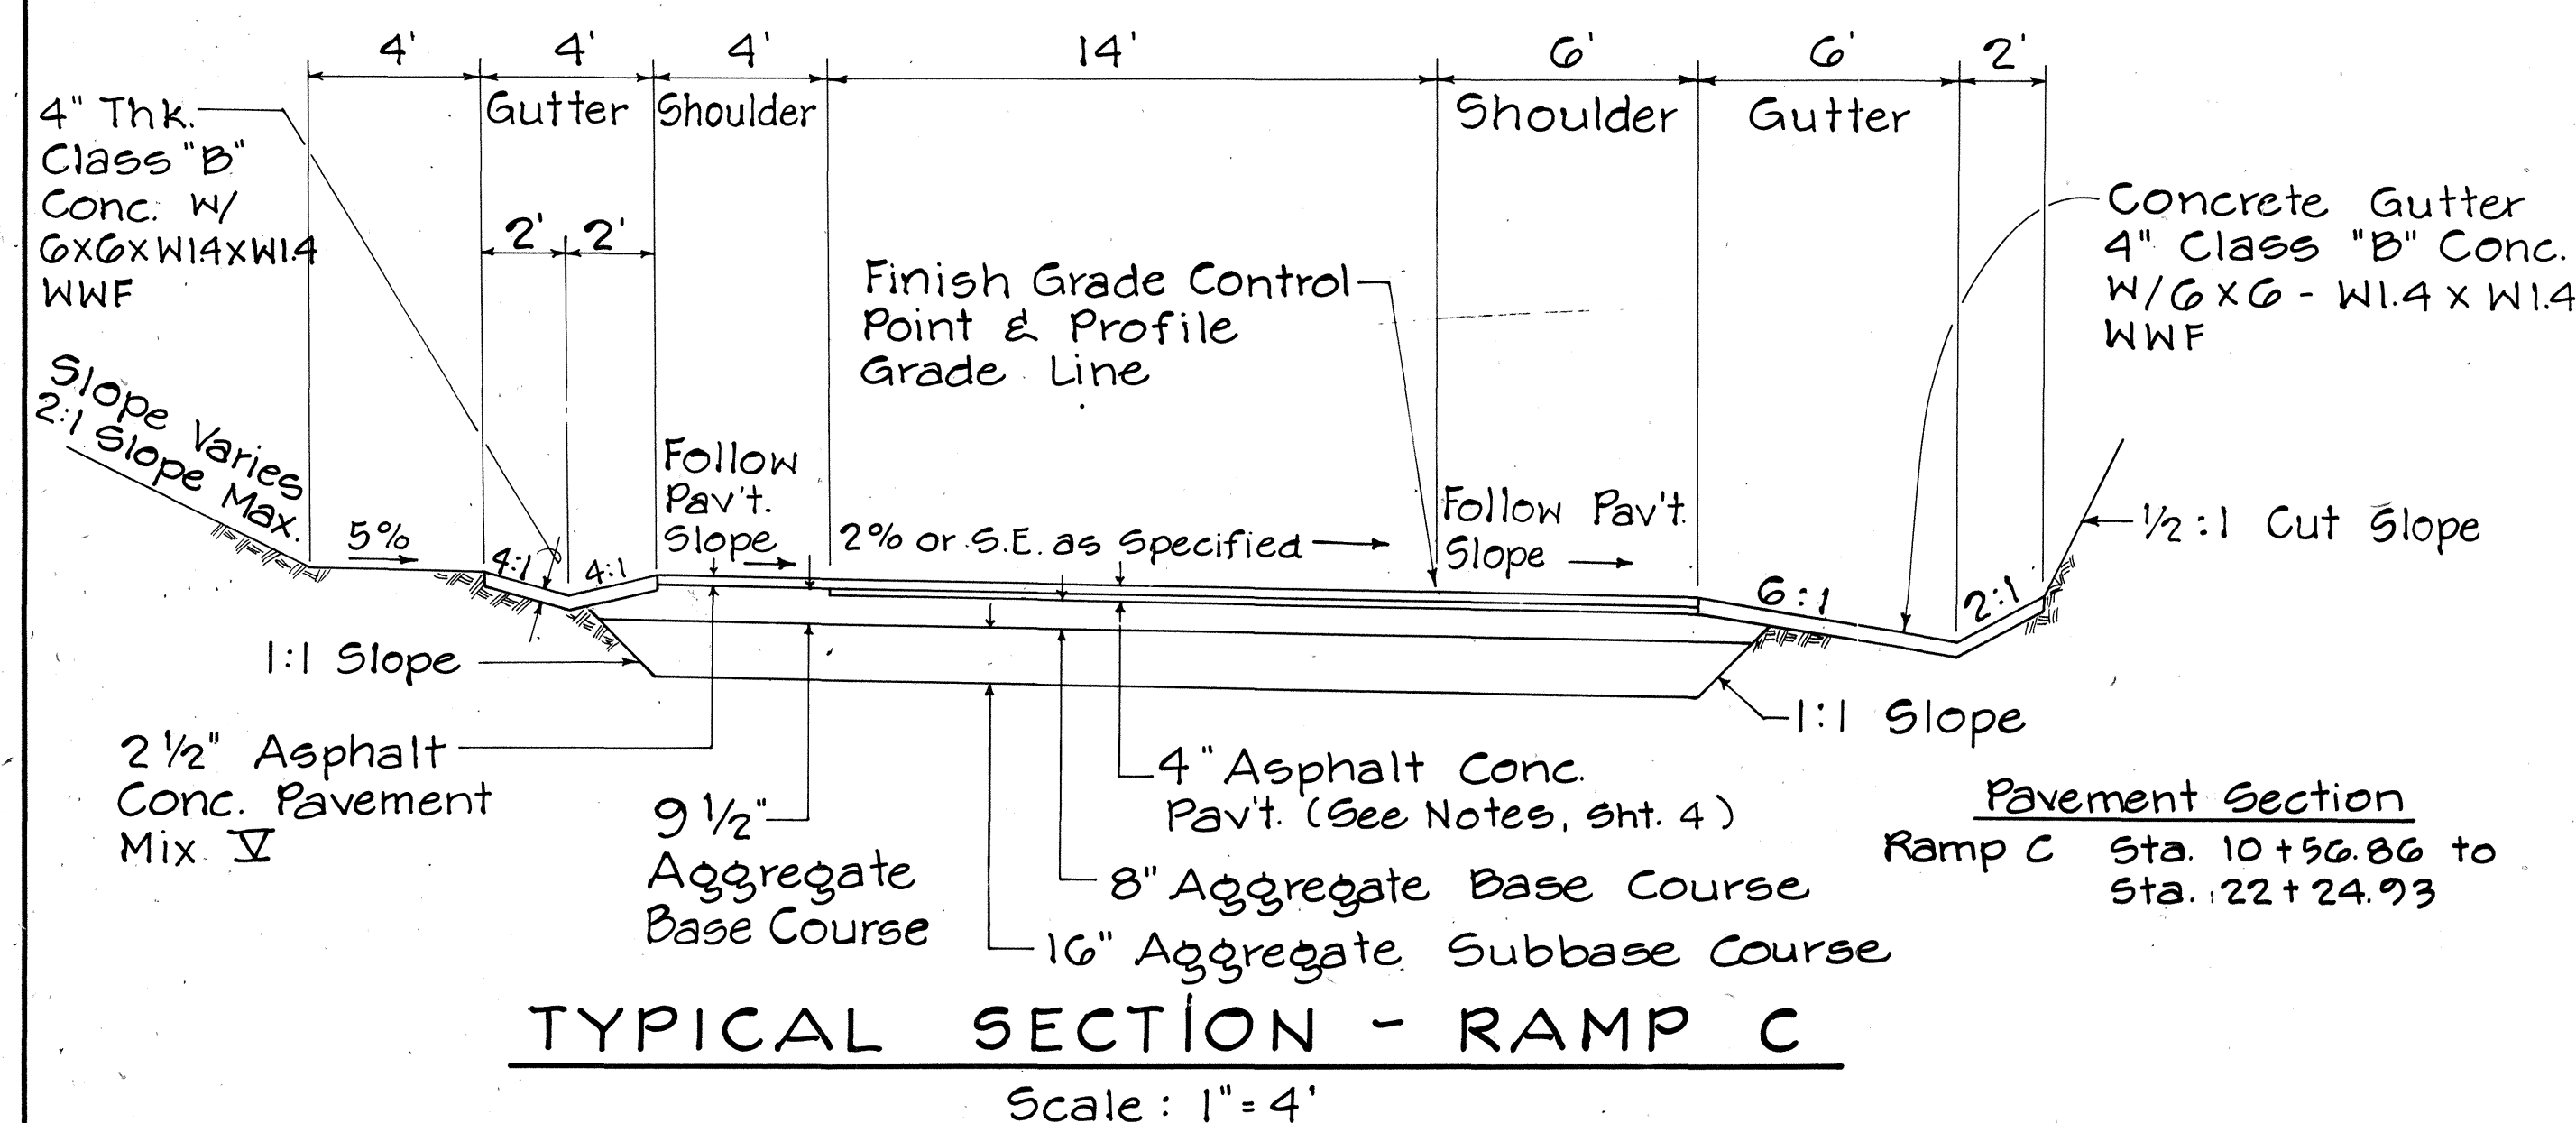
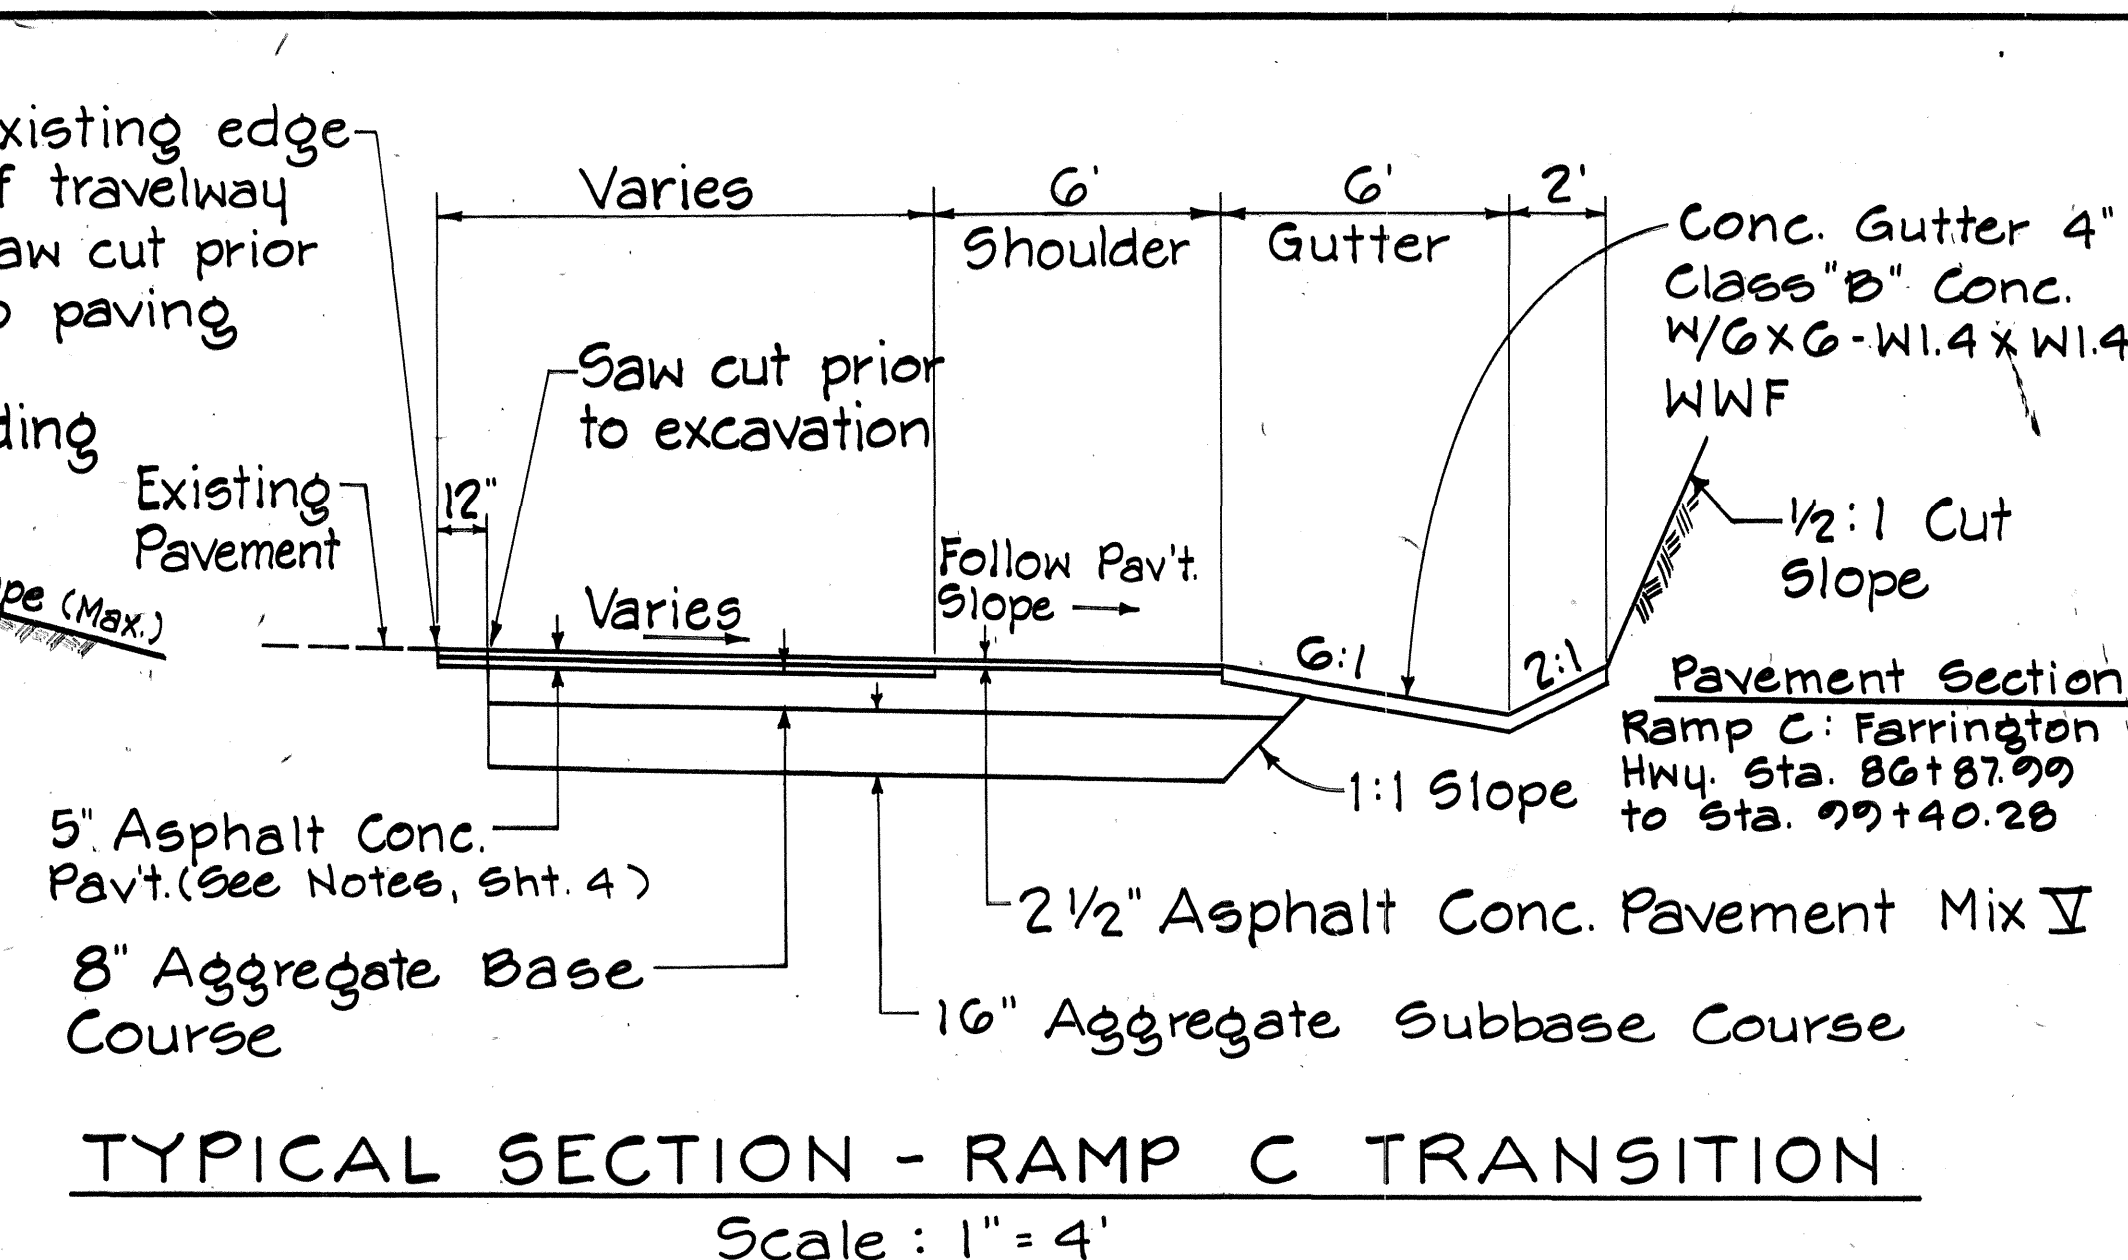
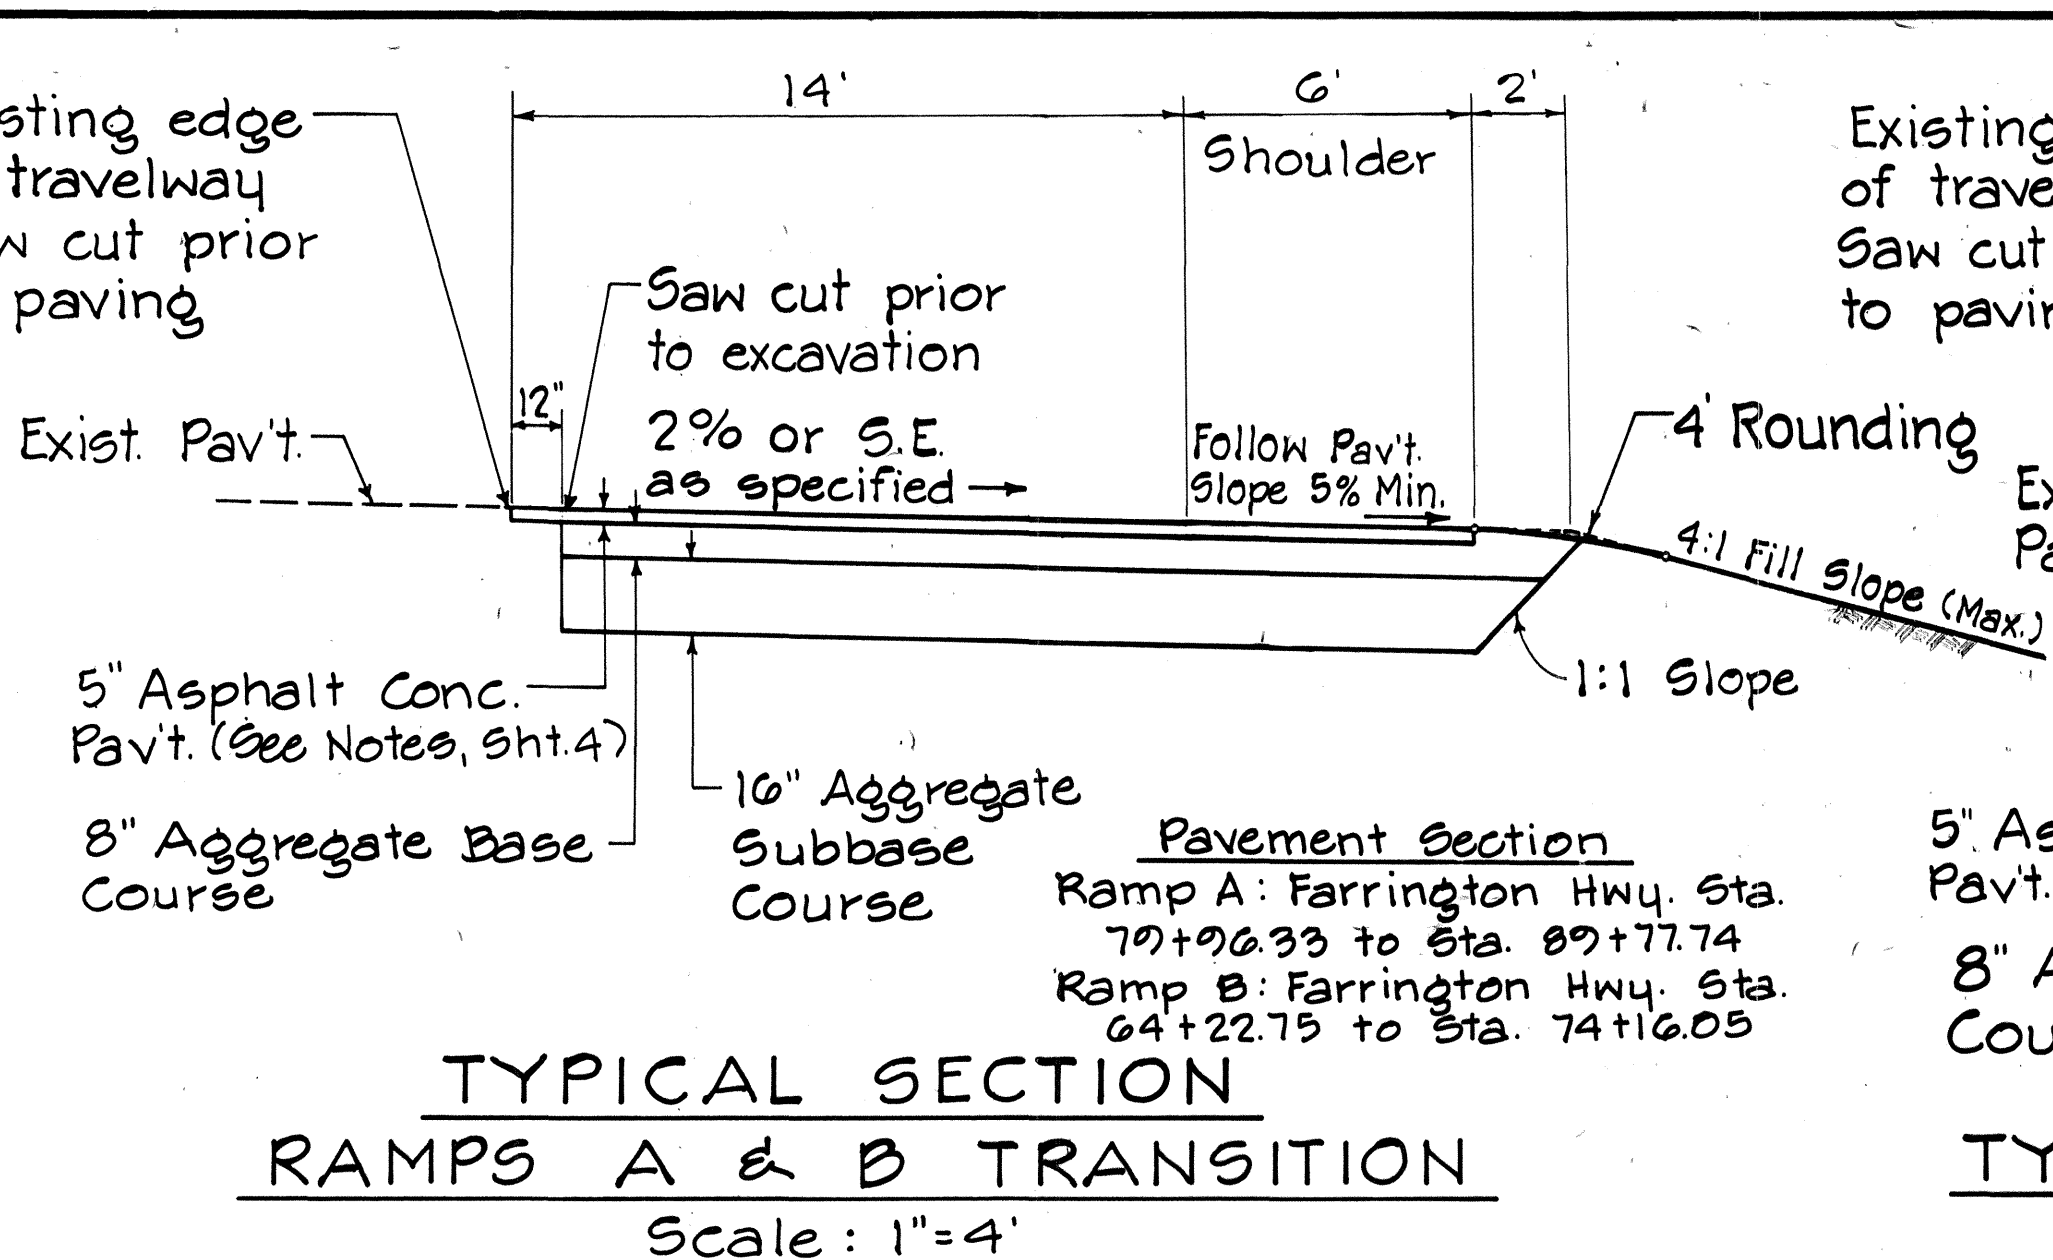


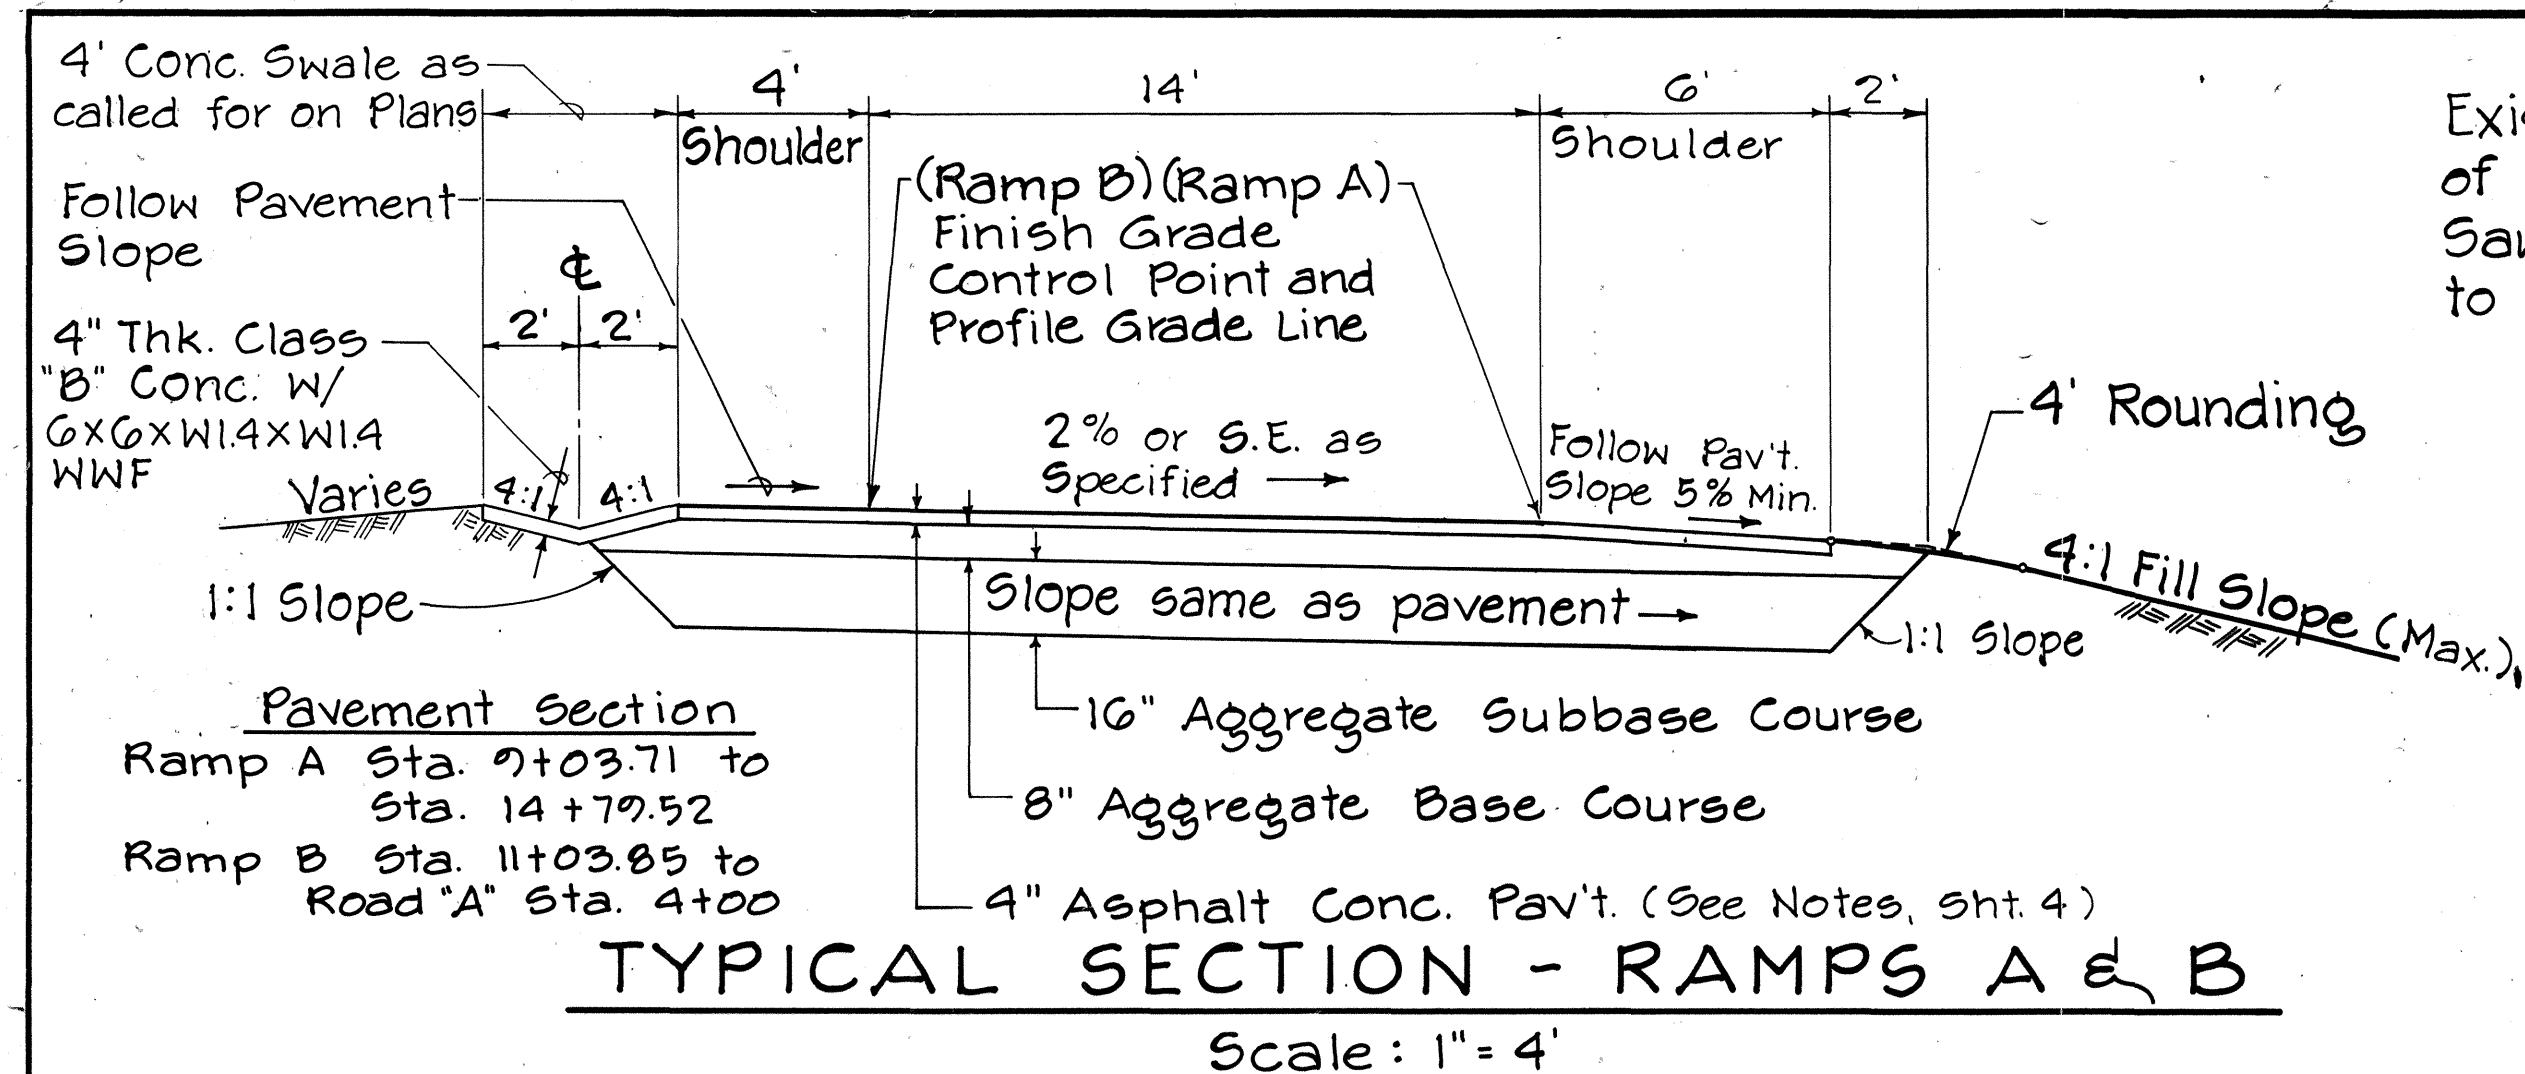


2-7-80	Added Grade Control Point	CPI	MADE BY	APPROVED
COMMUNITY PLANNING INCORPORATED				
CIVIL ENGINEERS - SURVEYORS - CONSULTANT PLANNERS				
WEST BEACH RESORT				
HONOLULU, EWA, OAHU, HAWAII				
DEVELOPER: WEST BEACH ESTATES				
TAX MAP KEY: 9-1-15: POR. 3				
9-2-03: POR. 2 & 69				
FARRINGTON HIGHWAY INTERCHANGE				
TYPICAL SECTIONS				
APPROVED FOR GRADING ONLY:				
Main T. Pulea				
CHIEF, DIVISION OF ENGINEERING				
8/1/87				
B. P. Pulea				
REGISTERED PROFESSIONAL ENGINEER				

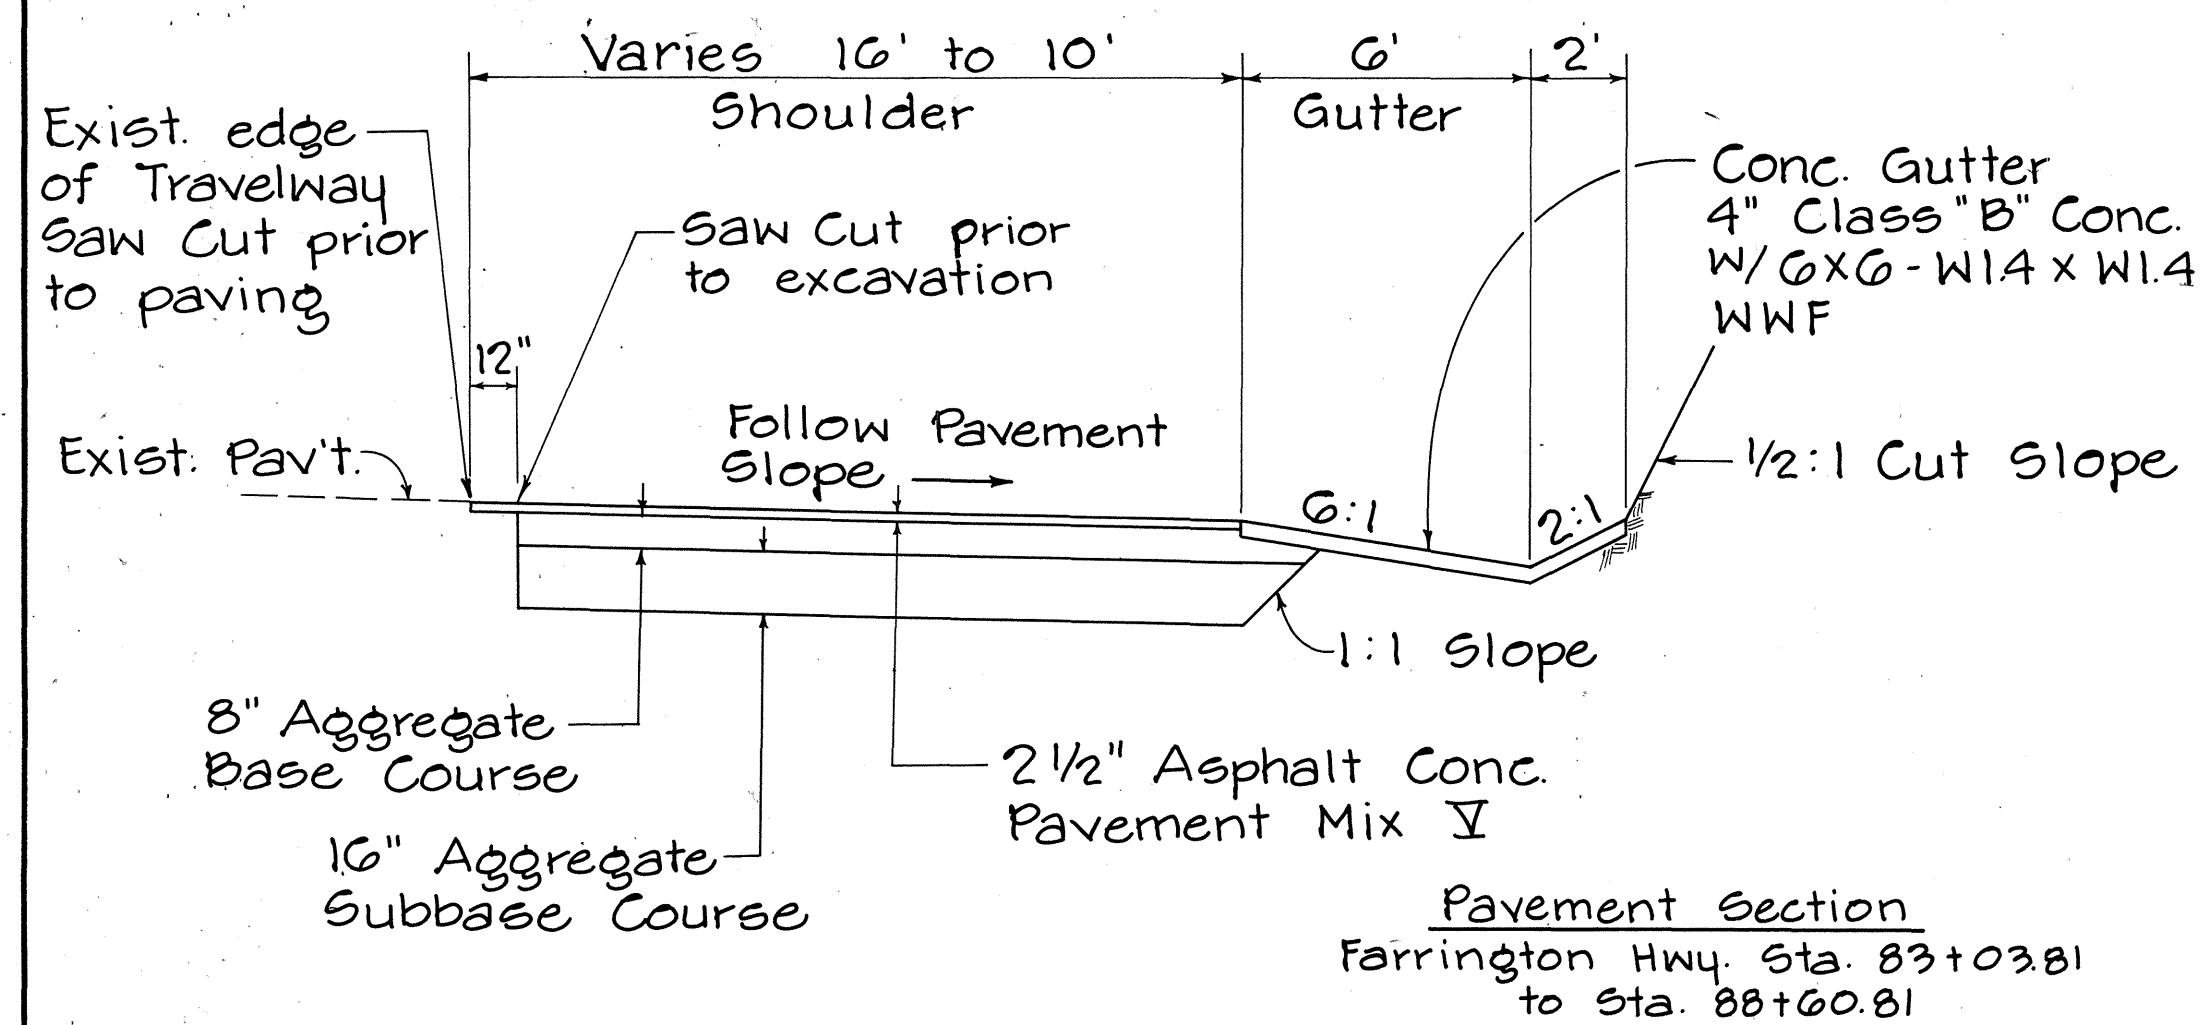

TYPICAL SECTION - FARRINGTON HIGHWAY
@ RAMP C ESCAPE LANE
 Scale: 1" = 4'-0"

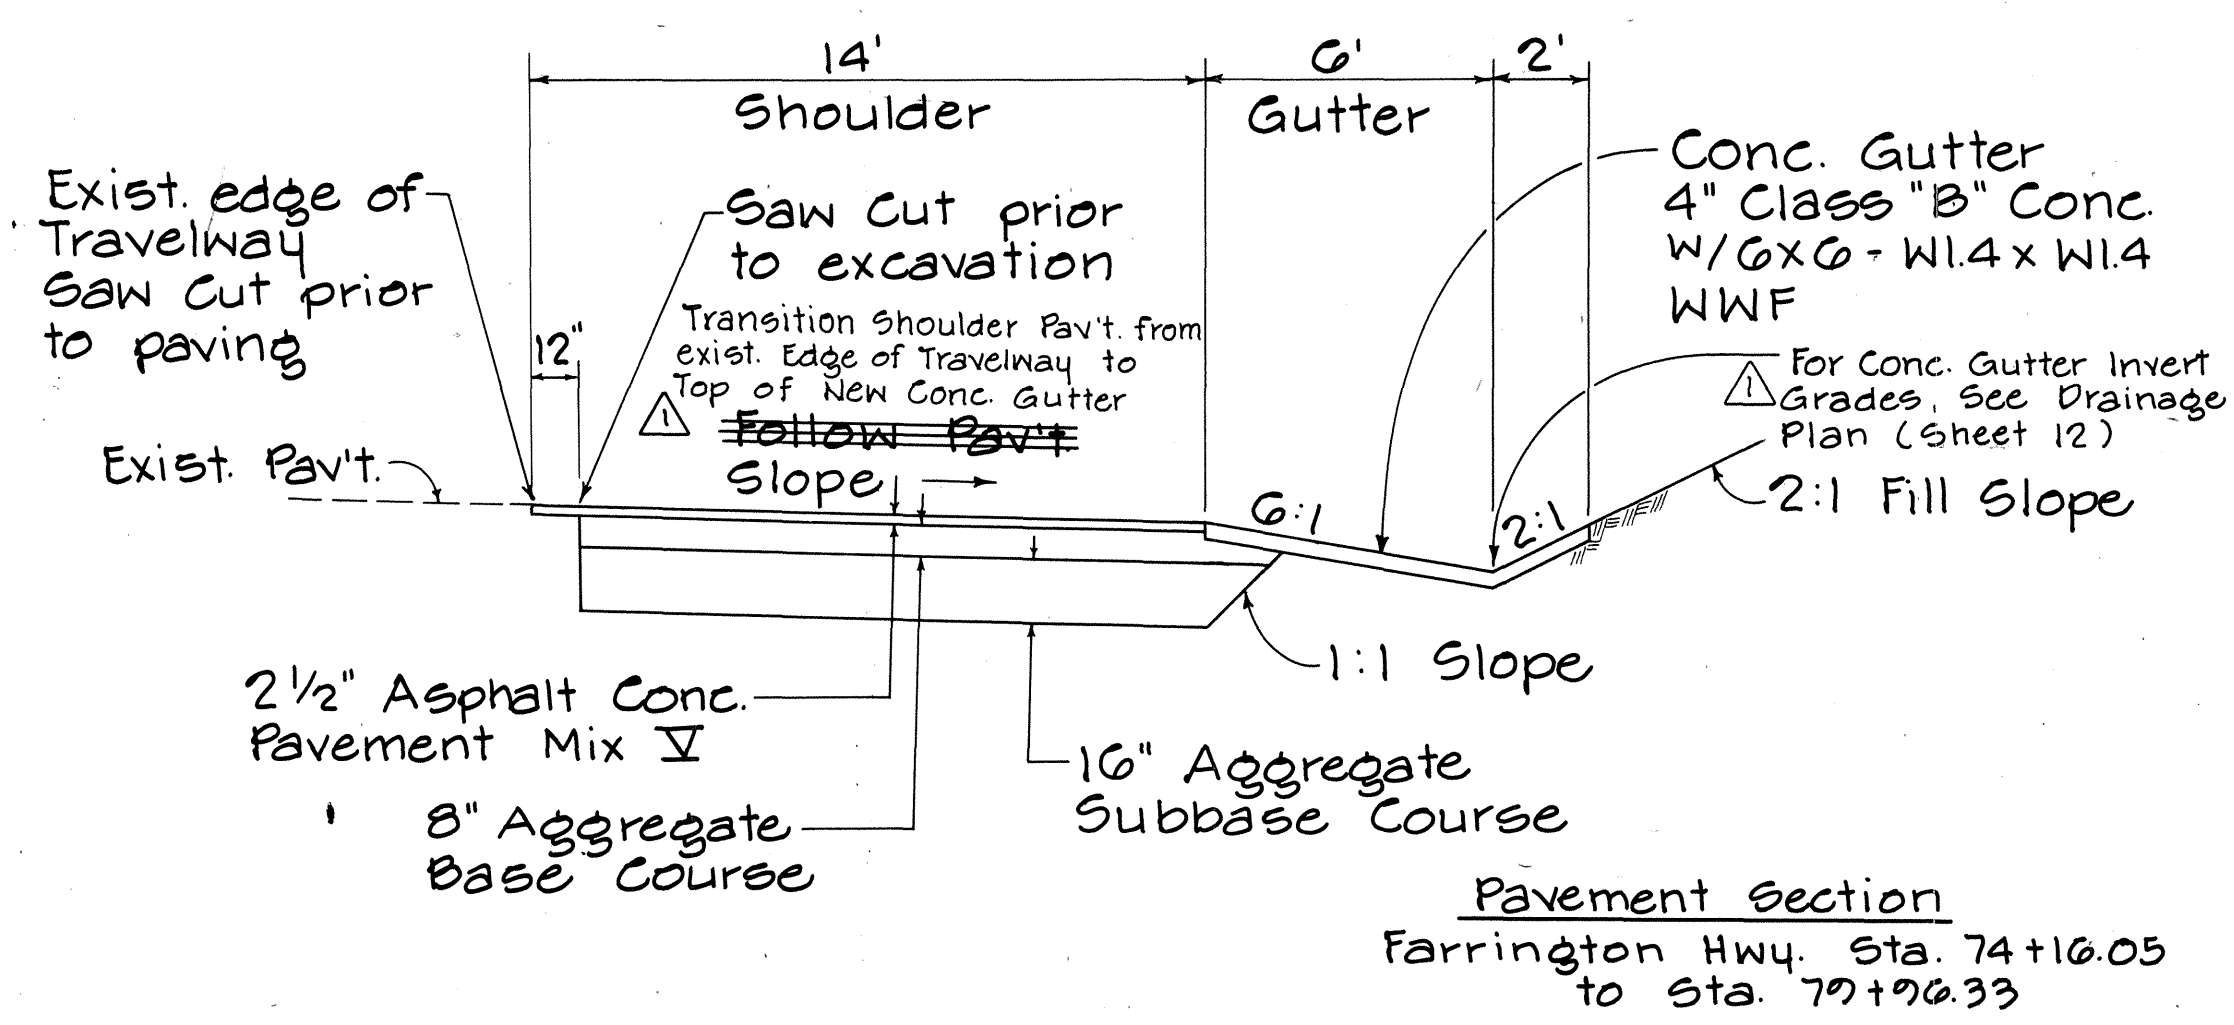


TYPICAL SECTION - FARRINGTON HIGHWAY
BETWEEN RAMPS A & B TRANSITIONS
 Scale: 1" = 4'-0"

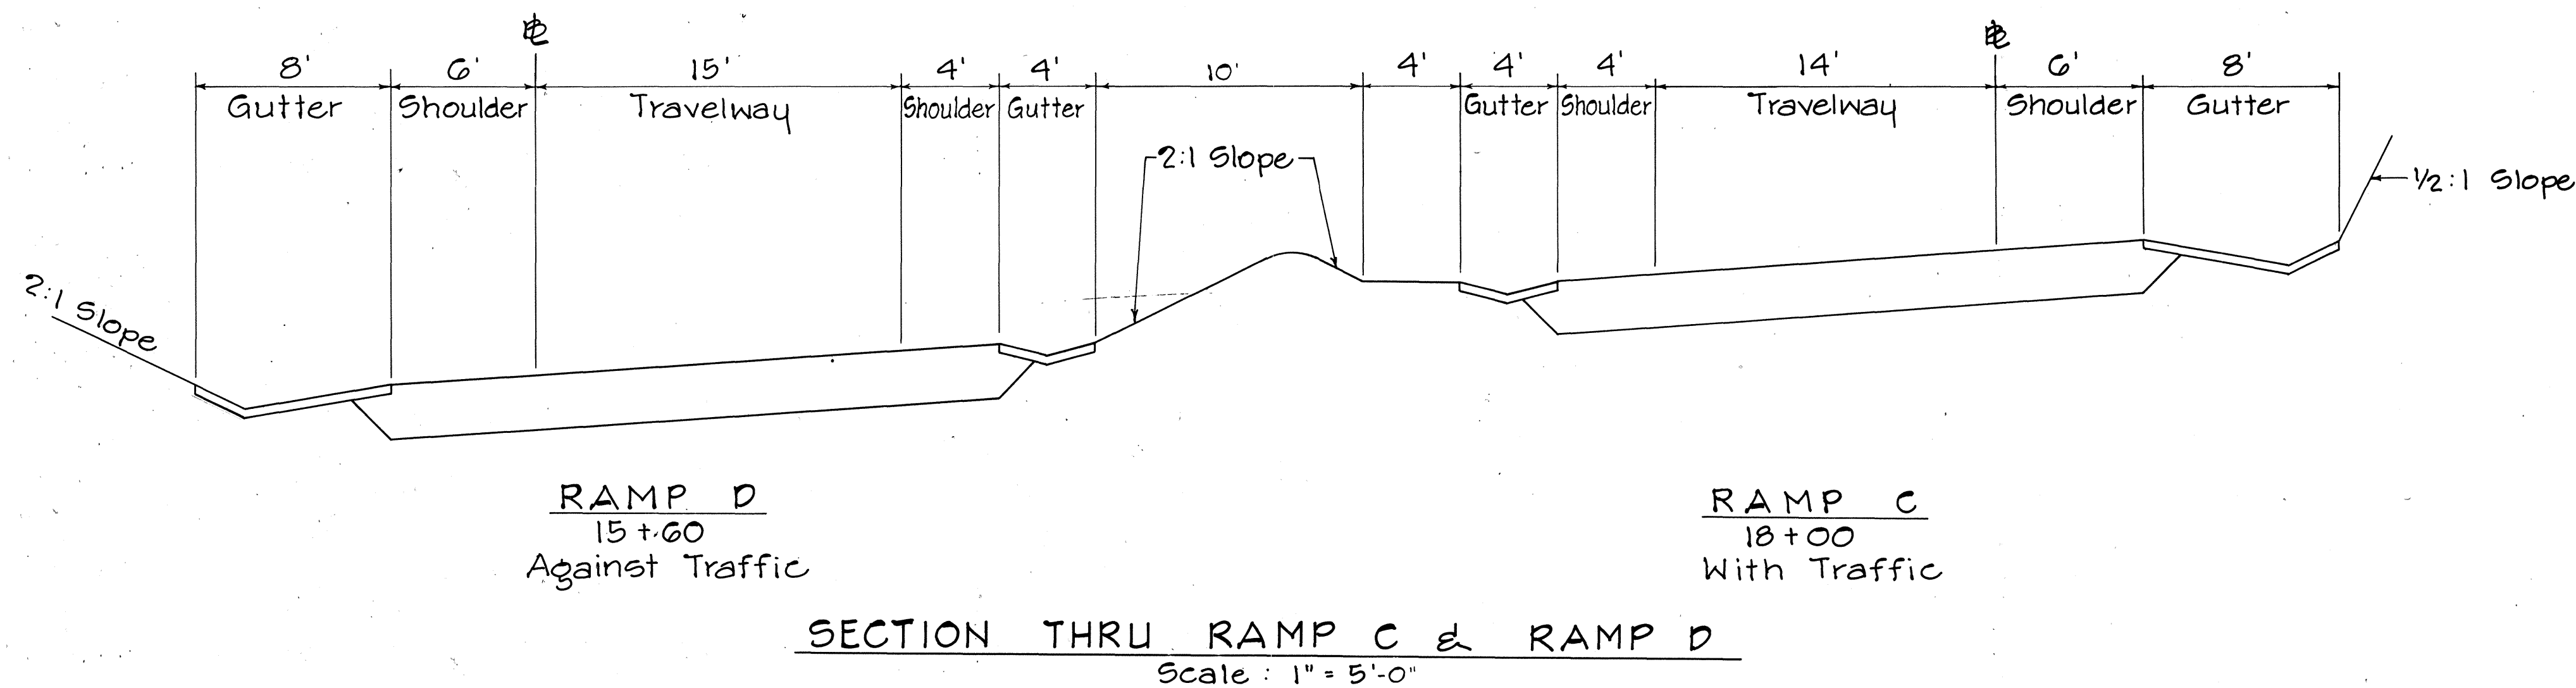

NOTES:

- 5" A.C. Pavement shall consist of
 2" Asphalt Conc. Pav't. Mix No. V, Surface Course
 3" Asphalt Conc. Pav't. Mix No. III, Leveling Courses
- 4" A.C. Pavement shall consist of
 2" Asphalt Conc. Pav't. Mix No. V, Surface Course
 2" Asphalt Conc. Pav't. Mix No. III, Leveling Courses

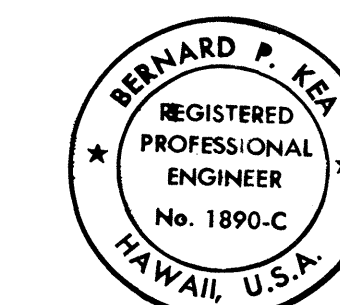

THIS WORK WAS PREPARED BY
 ME OR UNDER MY SUPERVISION

10-21-88	Deleted & Added New Notes	CPI	
REVISION DATE	DESCRIPTION	MADE BY	APPROVED
COMMUNITY PLANNING INCORPORATED CIVIL ENGINEERS - SURVEYORS - CONSULTANT PLANNERS			
WEST BEACH RESORT HONOLULU, EWA, OAHU, HAWAII DEVELOPER: WEST BEACH ESTATES TAX MAP KEY: 9-1-15: POR. 3 9-2-03: POR. 2 & 69			
FARRINGTON HIGHWAY INTERCHANGE			
TYPICAL SECTIONS			
APPROVED FOR GRADING ONLY:			
CHIEF, DIVISION OF ENGINEERING, D.R.W.		DATE	
Bernard P. Kea			
REGISTERED PROFESSIONAL ENGINEER			