

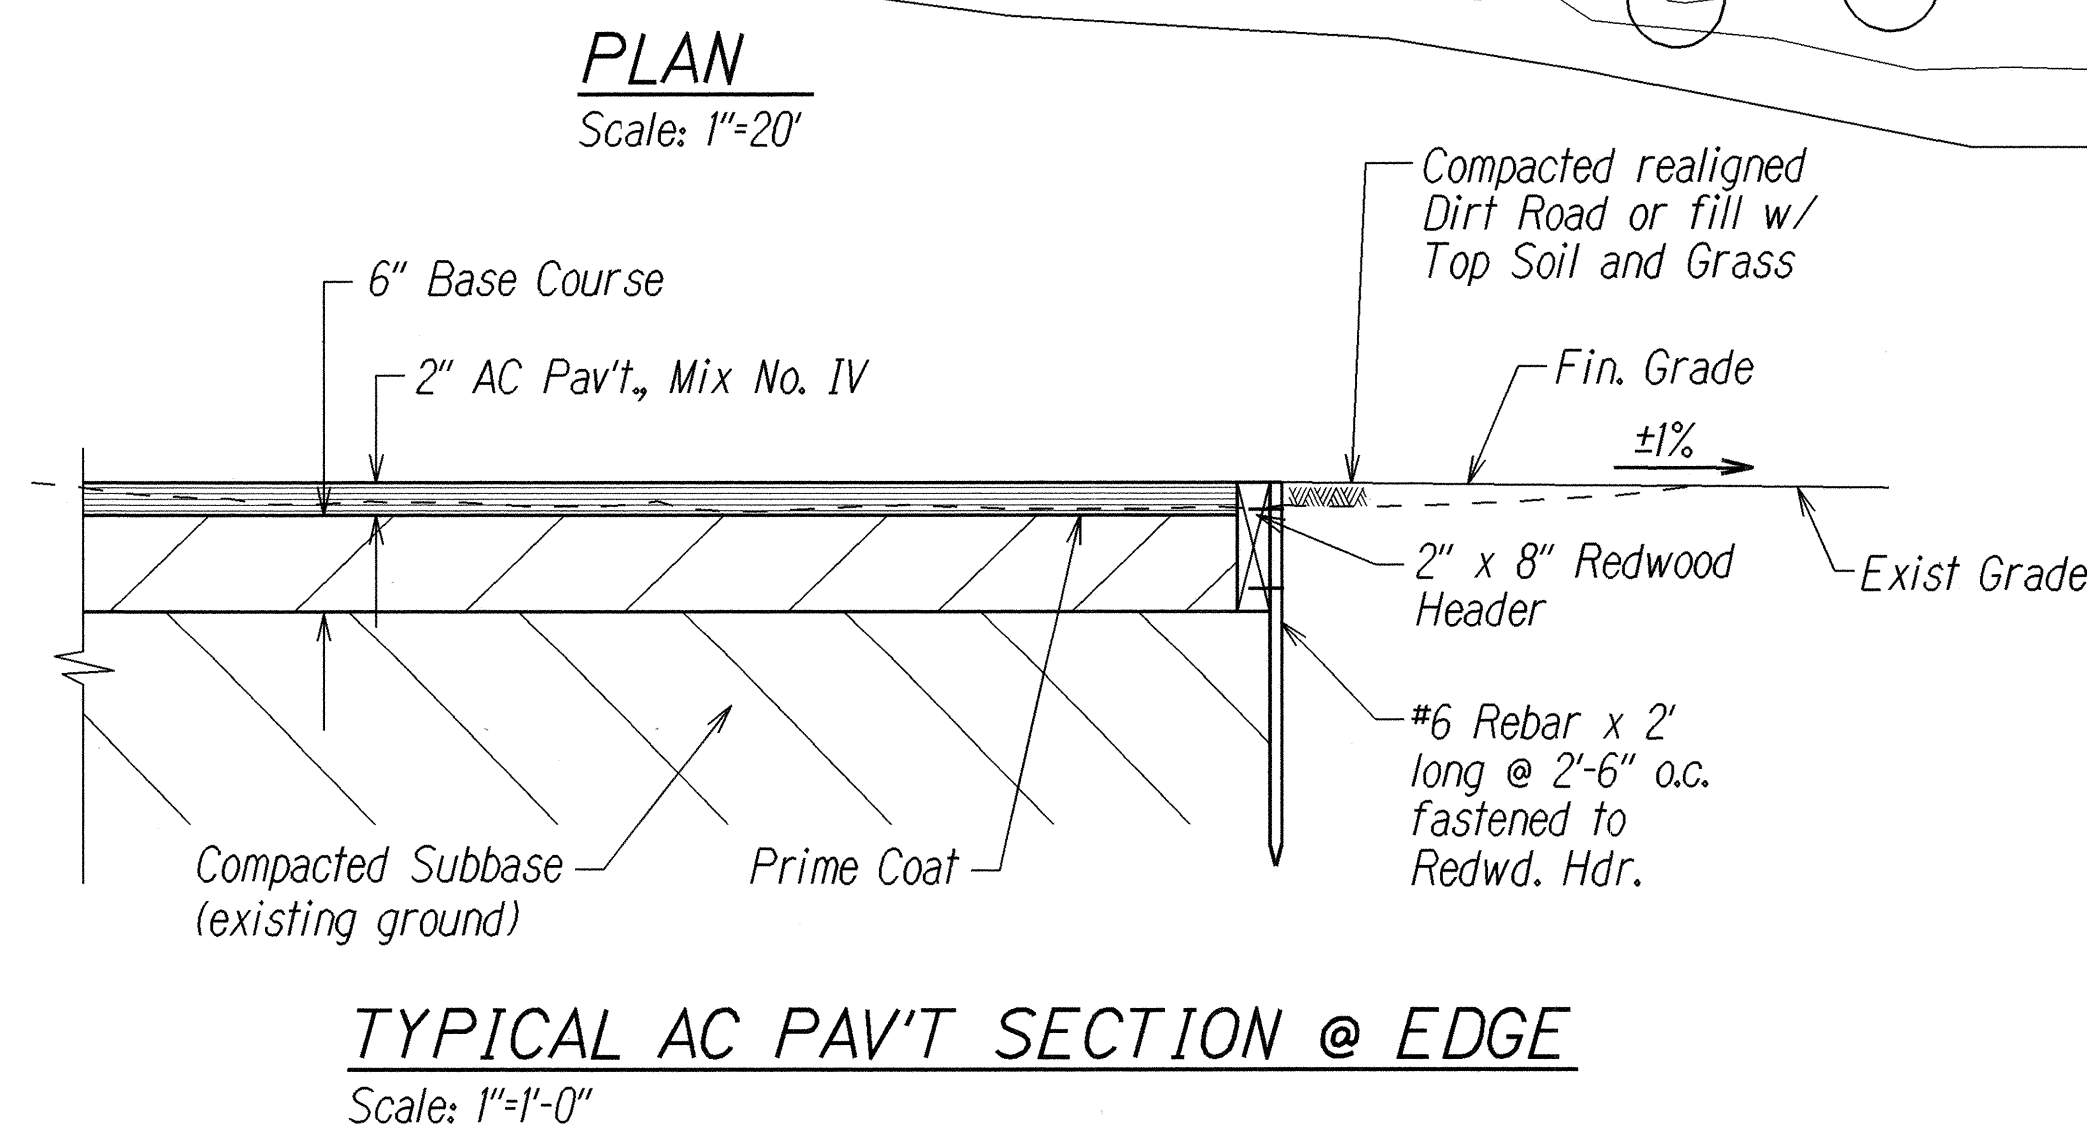
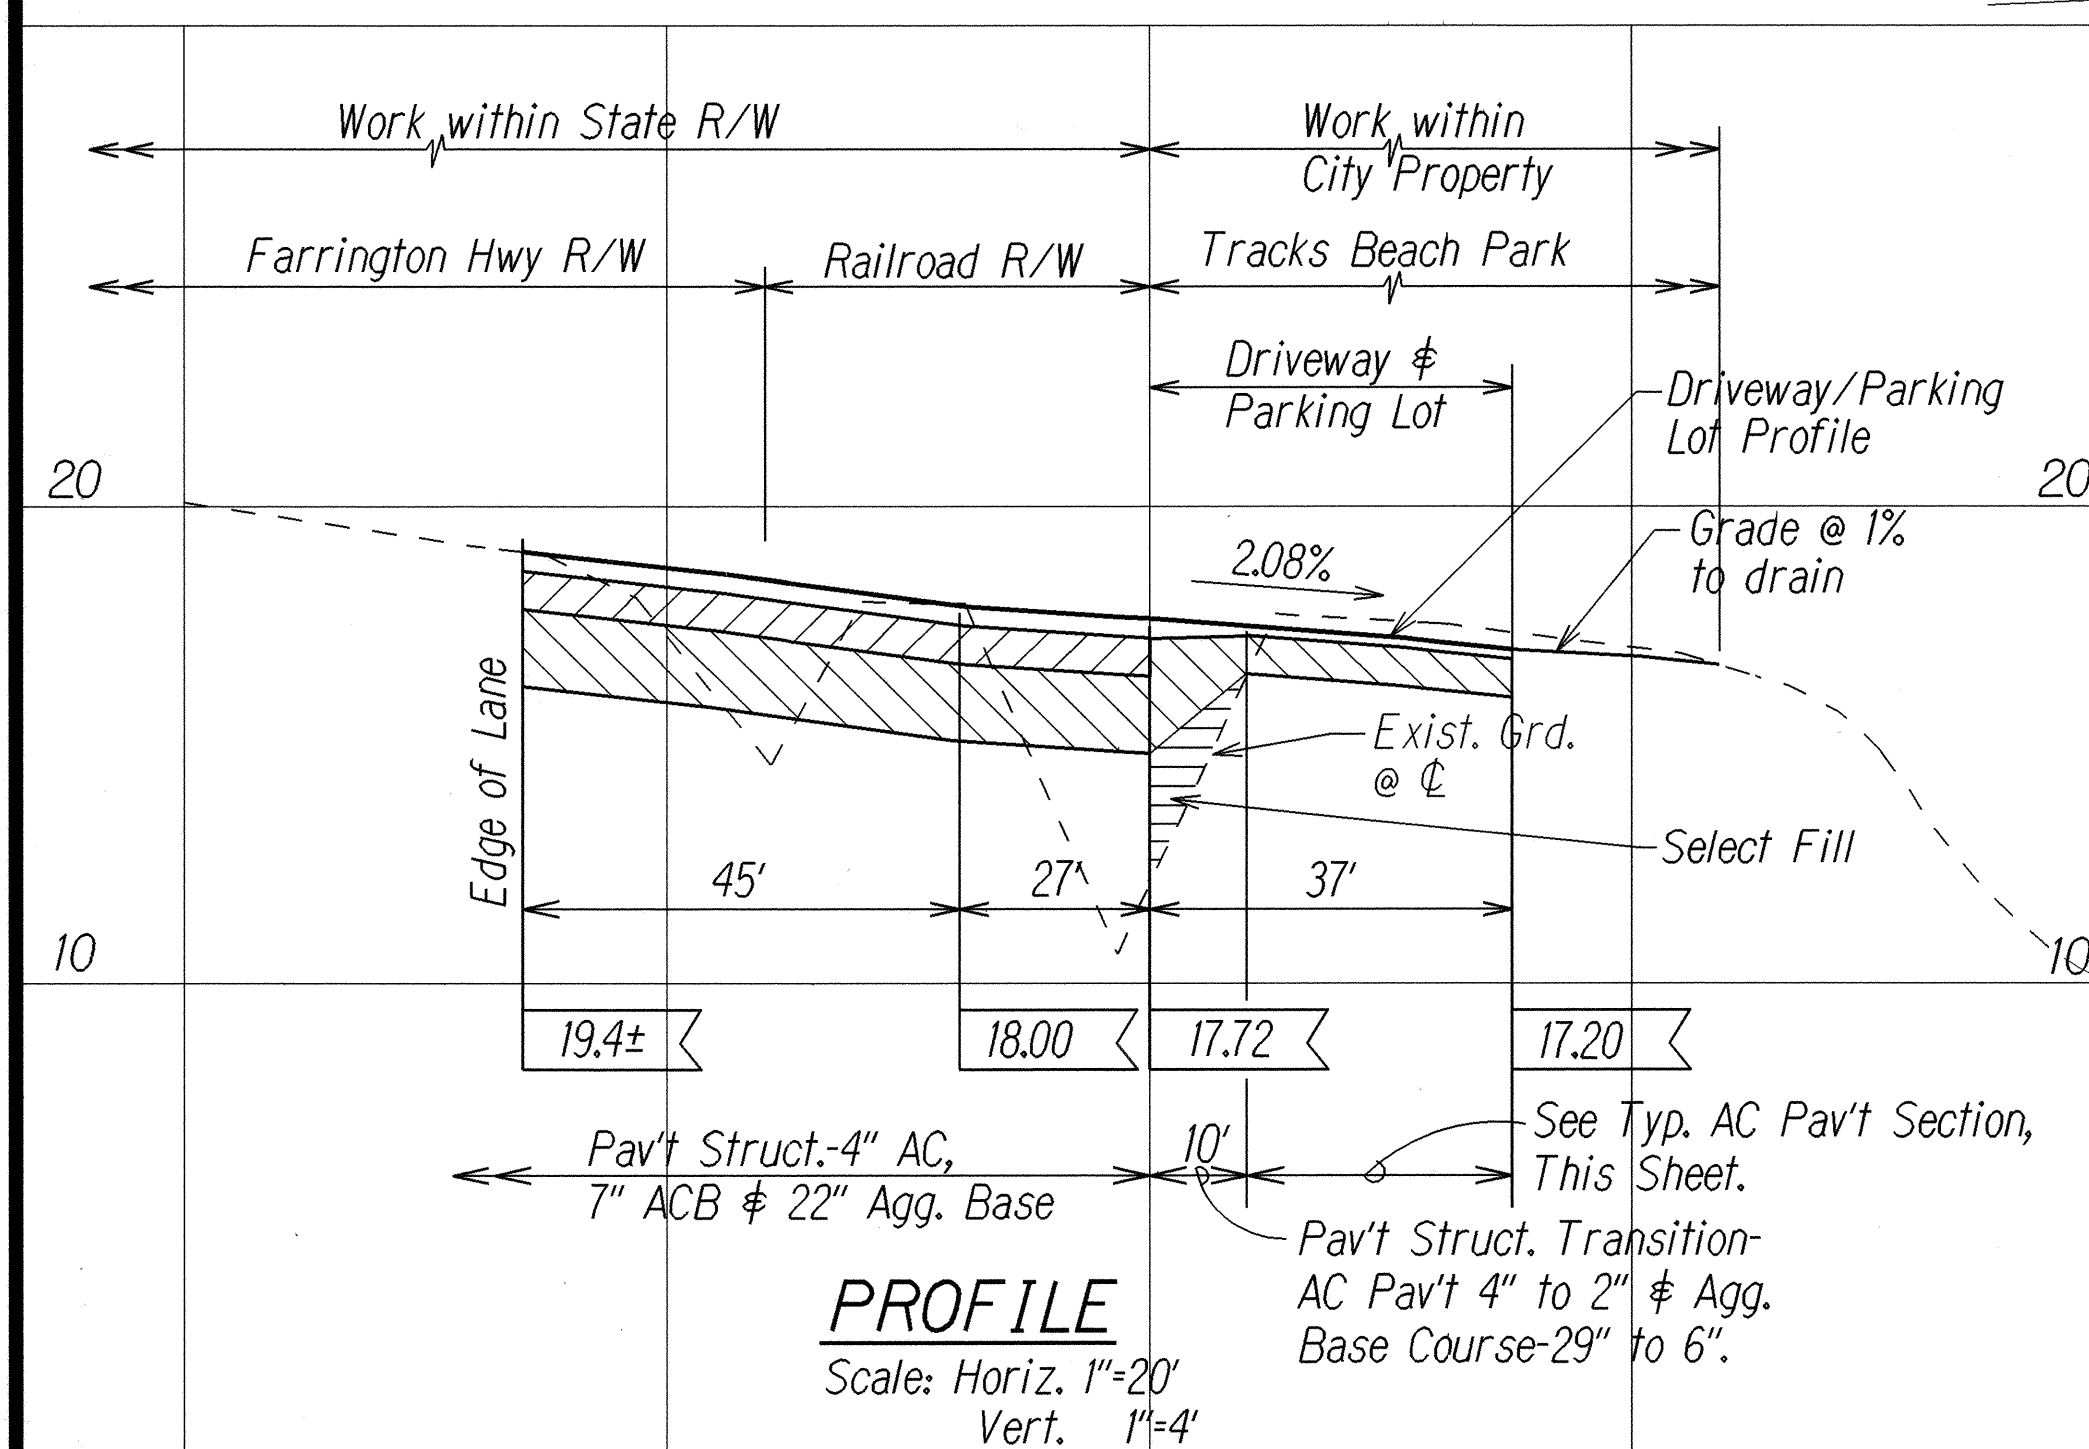


FED. ROAD DIST. NO.	STATE	FED. AID PROJ. NO.	FISCAL YEAR	SHEET NO.	TOTAL SHEETS
HAWAII	HAW.	NH-093-1(19)	1999	49	49

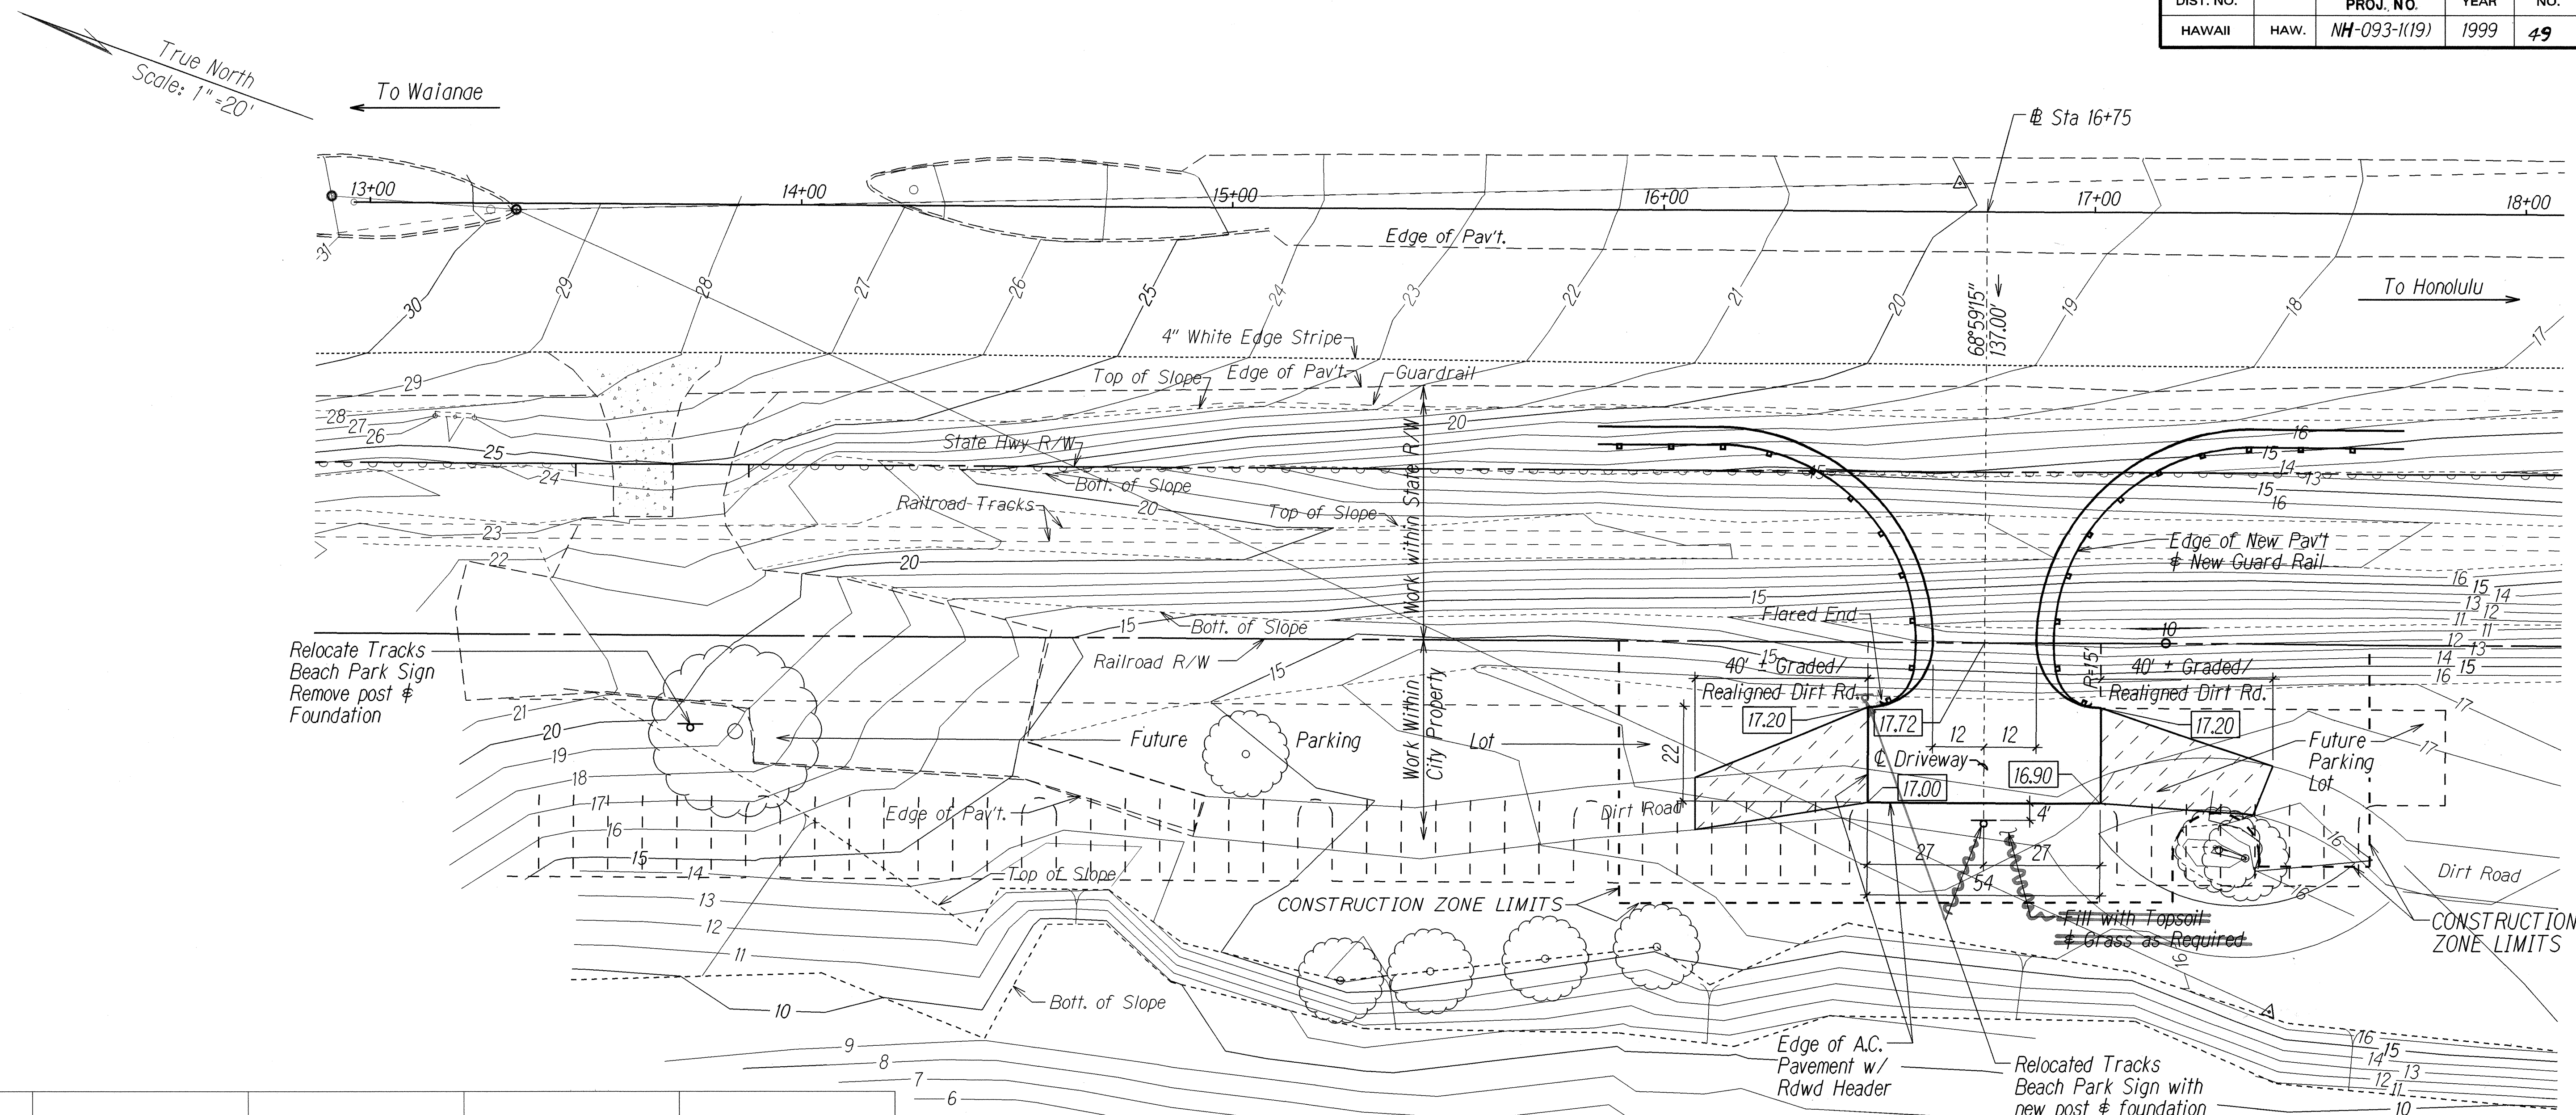

NOTES:

- The following work shall not be measured or paid for separately: — 5 — 4 —
1. Reinforcing steel, Redwood Header and Prime Coat shall be incidental to AC Pavement.
 2. Grading/Realigned Dirt Road shall be incidental to Roadway Excavation.
 3. Select Fill shall be selected from Roadway Excavation and shall be incidental to Roadway Excavation.
 4. Remove existing post and foundation shall be incidental to Relocated Park Sign with new post and foundation.

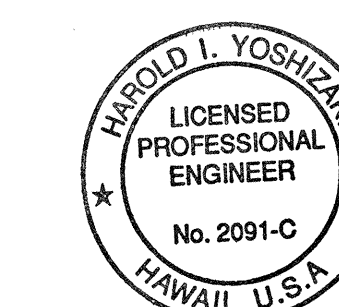

THIS WORK WAS PREPARED BY ME OR UNDER MY SUPERVISION.
Harold I. Yoshizaki
SHIMABUKURO, ENDO & YOSHIZAKI, INC.
1124 12th Avenue
Honolulu, Hawaii 96816

STATE OF HAWAII DEPARTMENT OF TRANSPORTATION HIGHWAYS DIVISION **TRACKS BEACH PARK DRIVEWAY PLAN**

FARRINGTON HWY. IMPROVEMENTS
Vicinity of Tracks Beach Park
FED. AID. PROJECT NO. NH-093-1(19)

SCALE: AS SHOWN DATE: SHEET No. 1 OF 1 SHEETS

"AS-BUILT"