



FED. ROAD DIST. NO.	STATE	FED. AID PROJ. NO.	FISCAL YEAR	SHEET NO.	TOTAL SHEETS
HAWAII	HAW.	NH-093-1(19)	1999	7	49

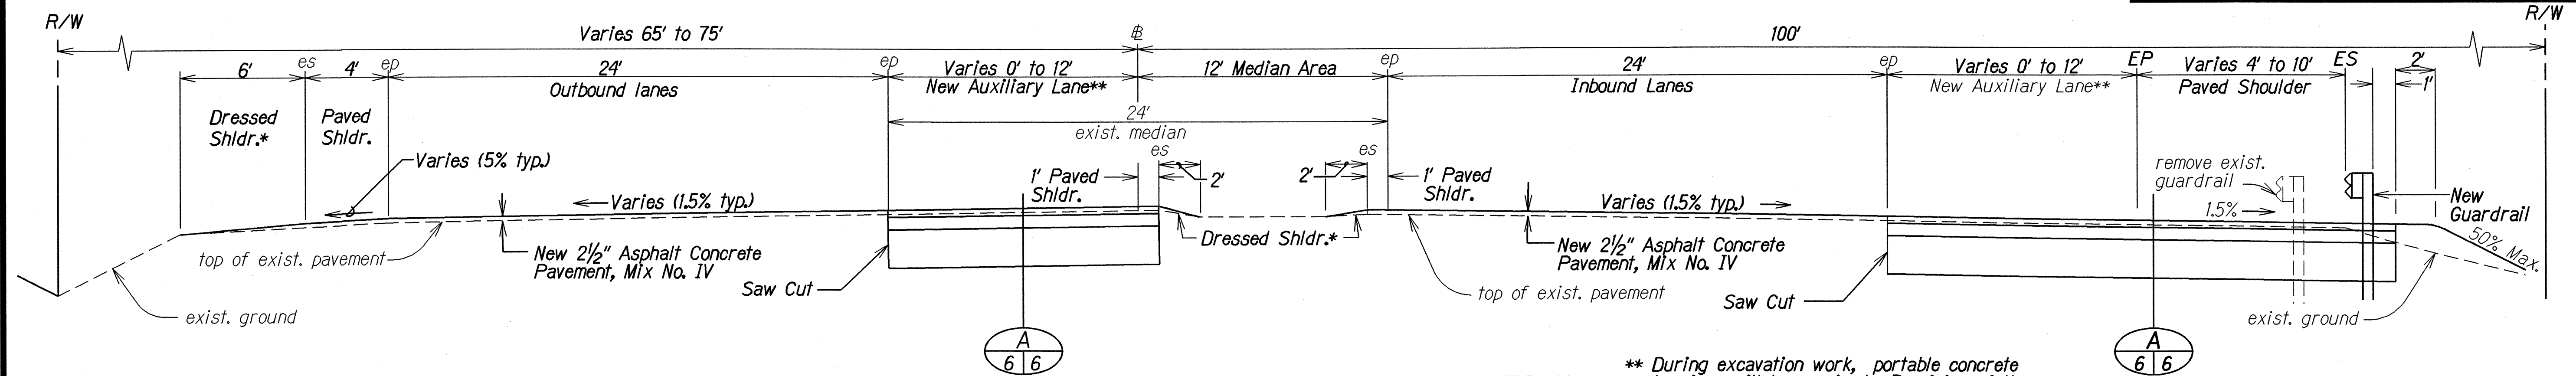

TYPICAL ROADWAY SECTION

Scale: 1/4"=1'


** During excavation work, portable concrete barriers will be required. Provision of these shall be paid for under item 645.2000 - Additional Police Officers and/or Traffic Control Devices.

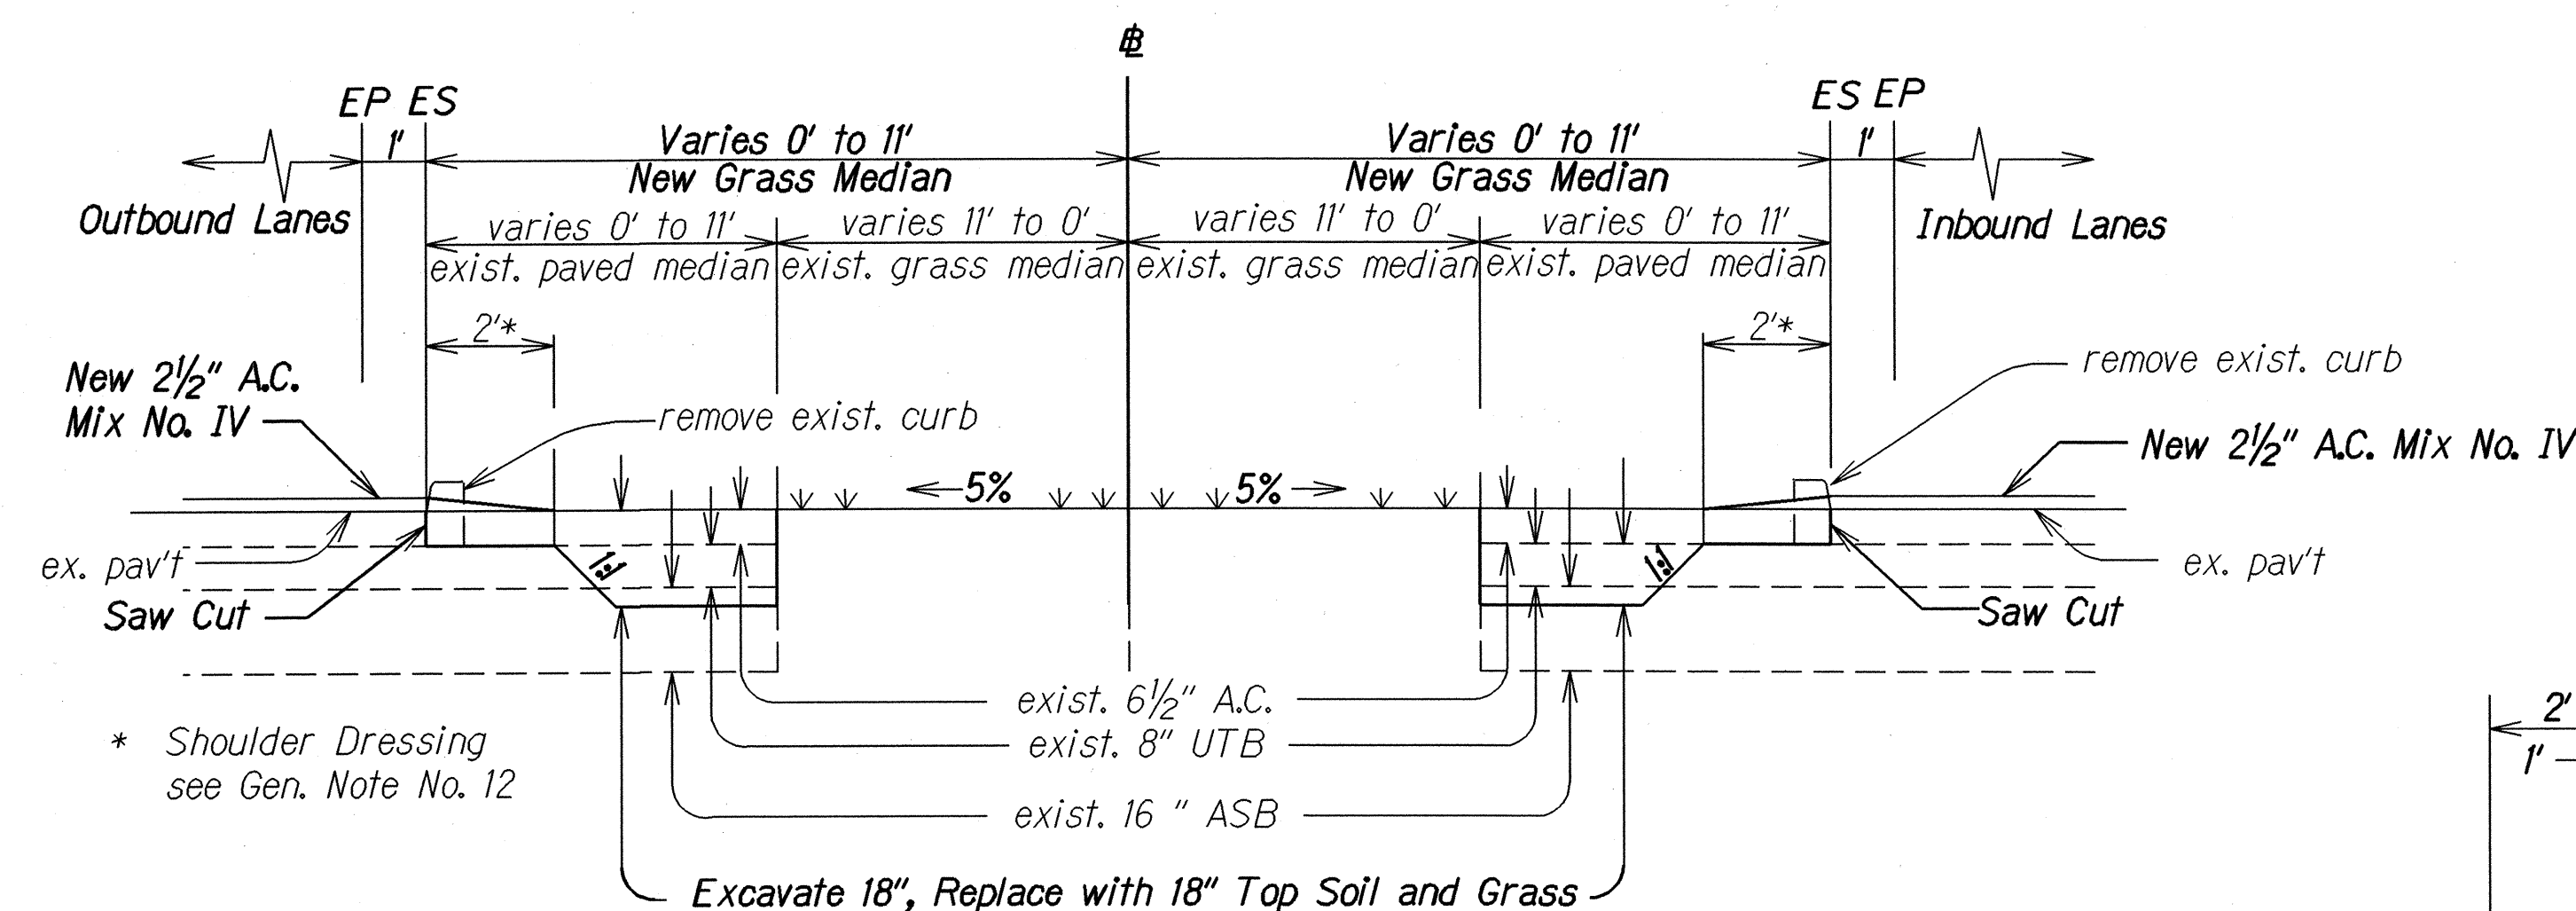

MEDIAN CLOSURE DETAIL


STA. 12+55± to # STA. 15+20±

Scale: 3/8"=1'

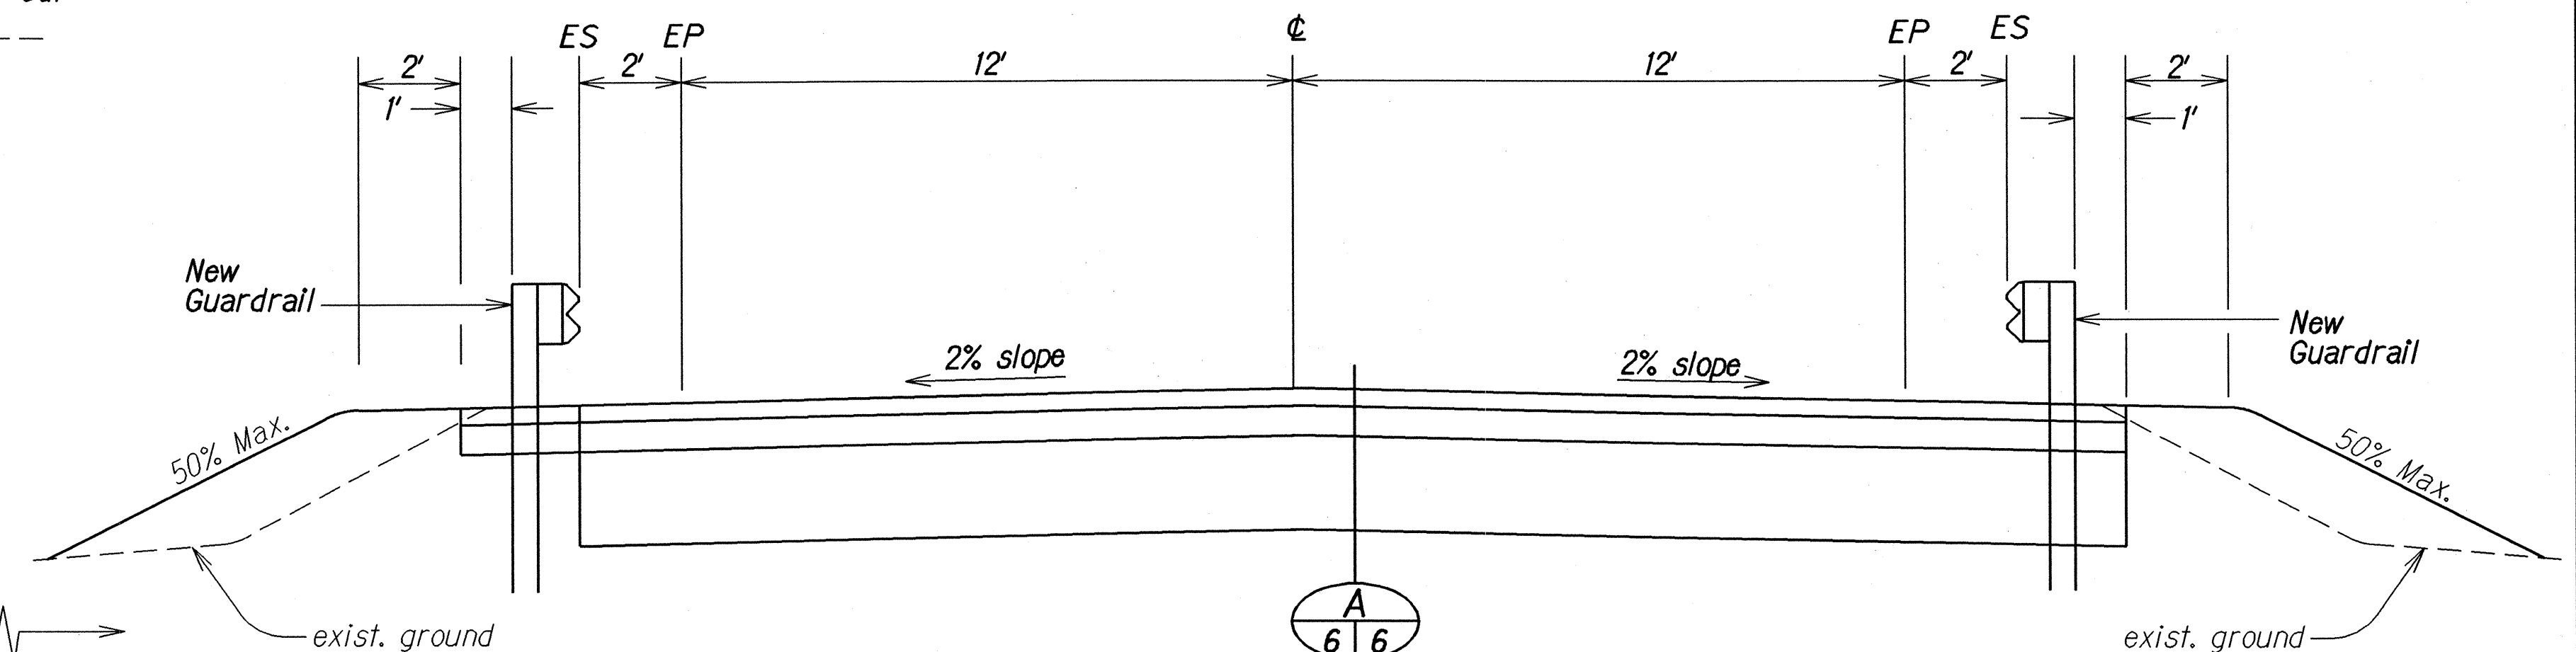

TYPICAL SECTION - NEW PARK ENTRANCE


Scale: 3/8"=1'

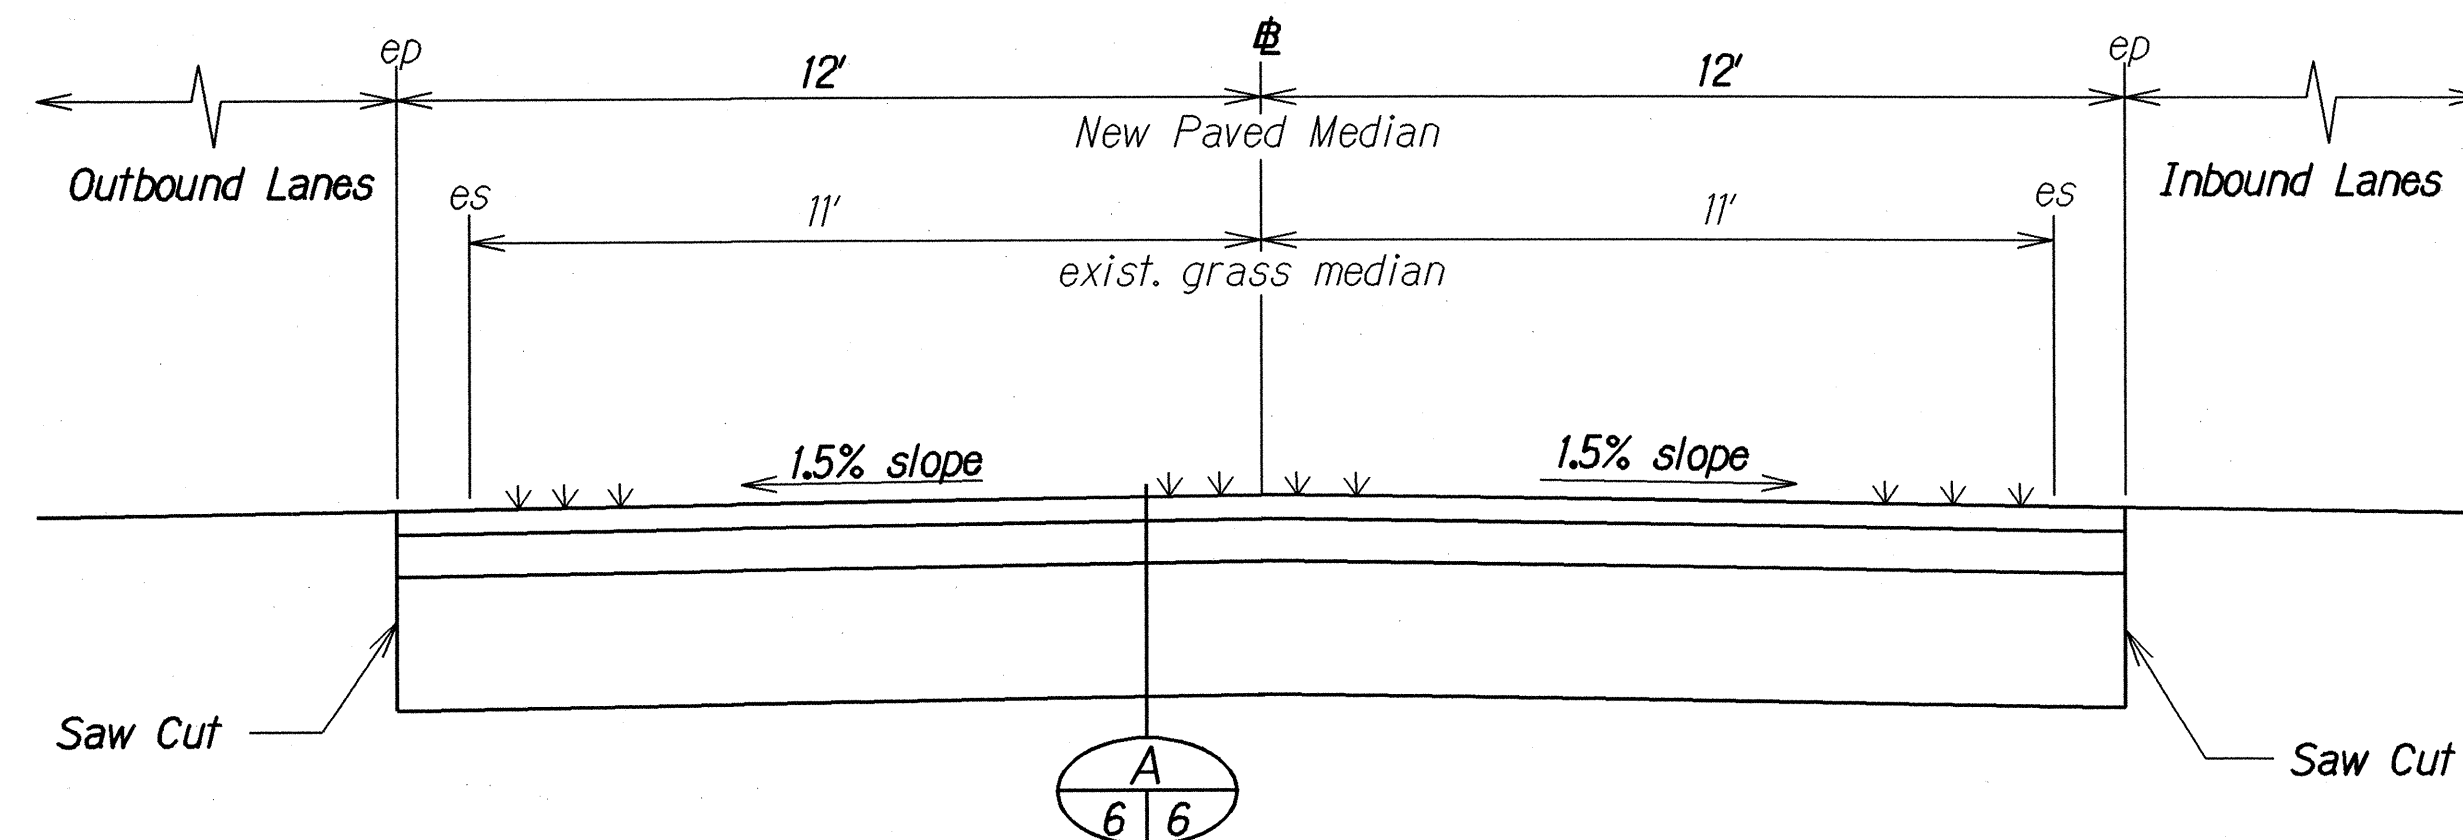

TYPICAL ROADWAY SECTION AT NEW MEDIAN OPENING

STA. 16+00± TO # STA. 17+50±

Scale: 3/8"=1'

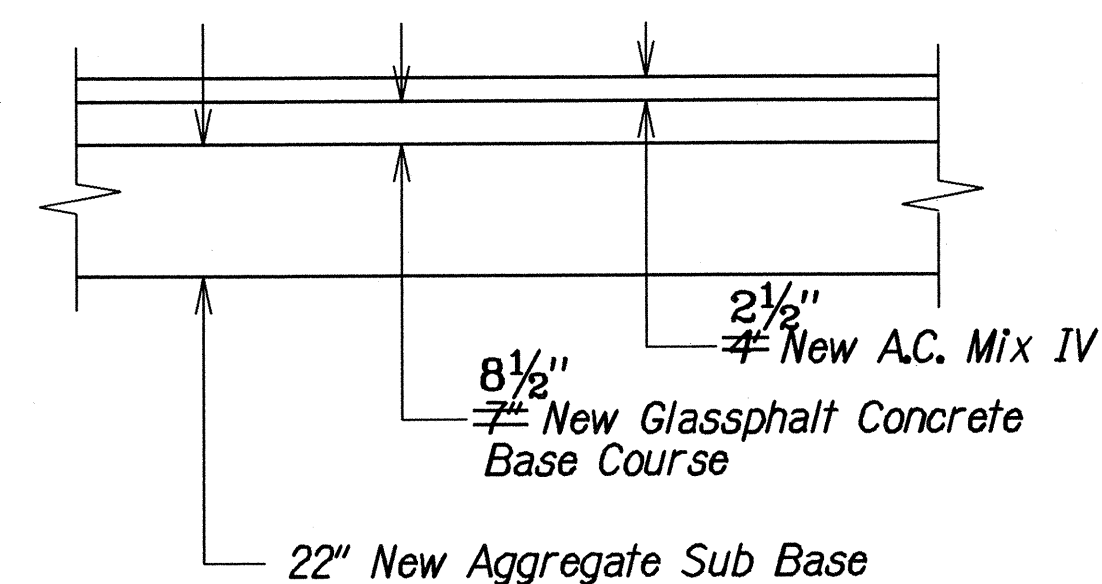

DETAIL

Scale: 3/8"=1'

A 6/6


LEGEND FOR AS-BUILT POSTINGS	
	Squiggly line for as-built deletion
	Double line for as-built deletion
Roadway	Text for as-built posting

STATE OF HAWAII DEPARTMENT OF TRANSPORTATION HIGHWAYS DIVISION	
TYPICAL SECTIONS	
FARRINGTON HIGHWAY IMPROVEMENTS Vicinity of Tracks Beach Park Federal Aid Project No. NH-093-1(19)	
Scale: As Shown	Date: May, 1999
SHEET No. 1 OF 3 SHEETS	


"AS-BUILT"

SURVEY PLOTTED BY	DATE
PLAN	10/28/98
DESIGNED BY	12/12/98
QUANTITIES BY	
CHECKED BY	


FED. ROAD DIST. NO.	STATE	FED. AID PROJ. NO.	FISCAL YEAR	SHEET NO.	TOTAL SHEETS
HAWAII	HAW.	NH-093-1(19)	1999	8	49

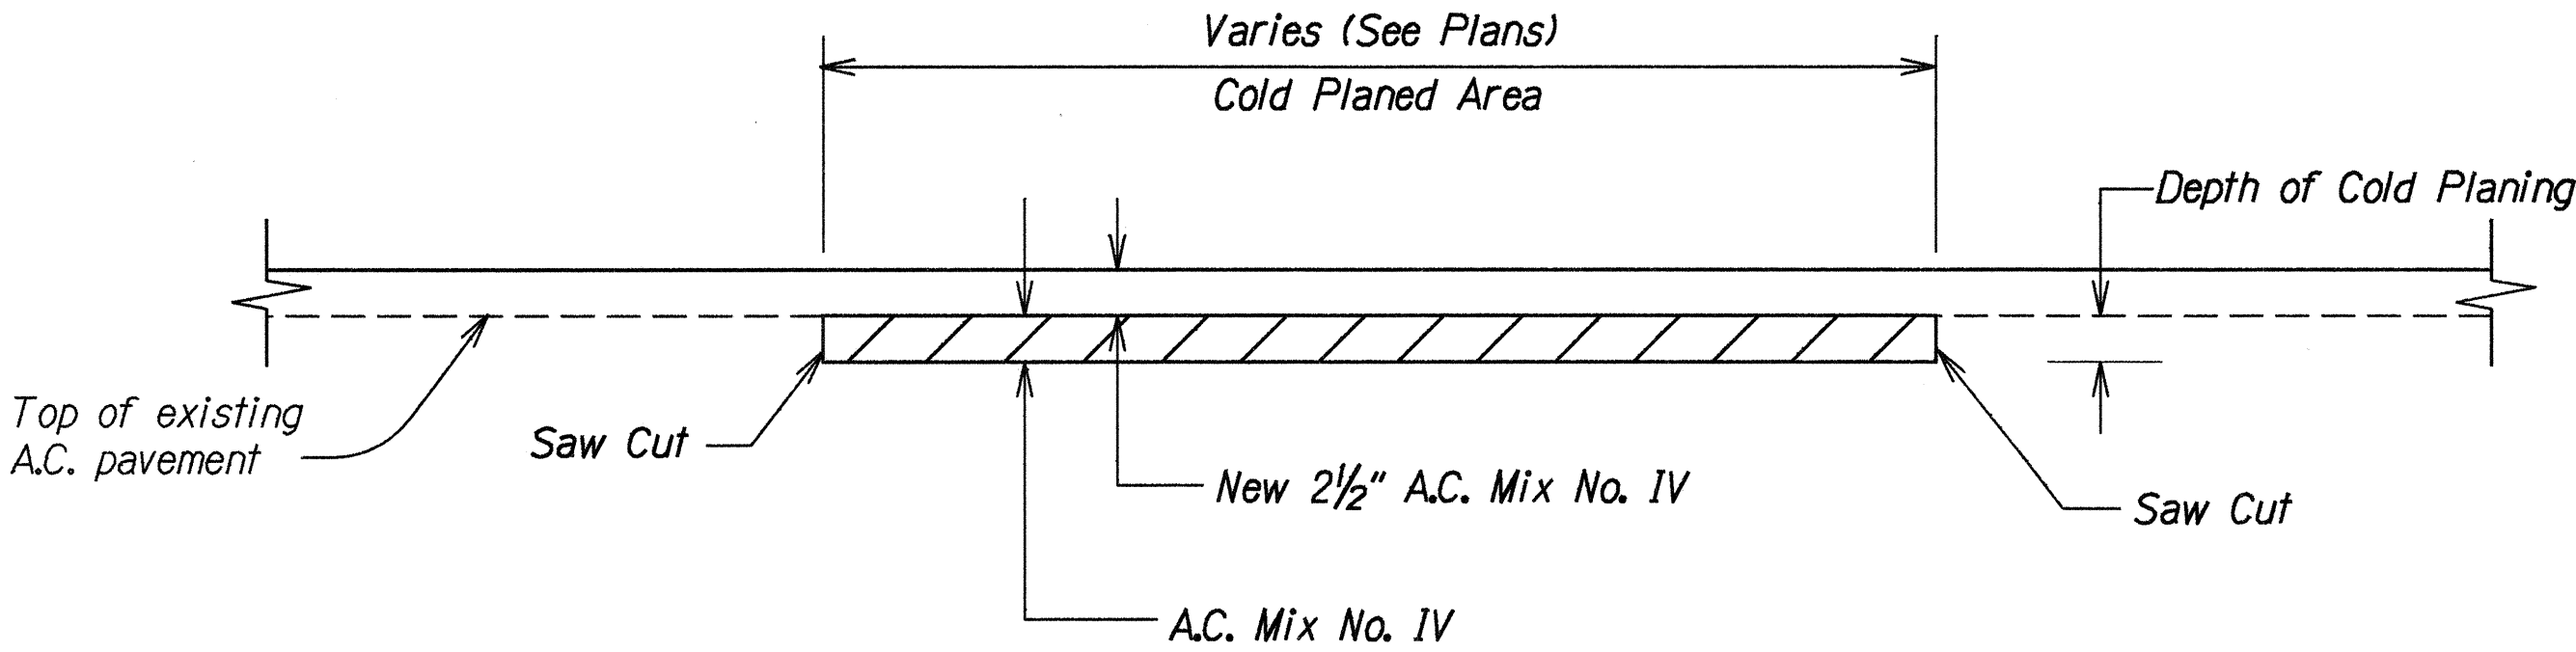

TYPICAL COLD PLANED AREA
Not To Scale

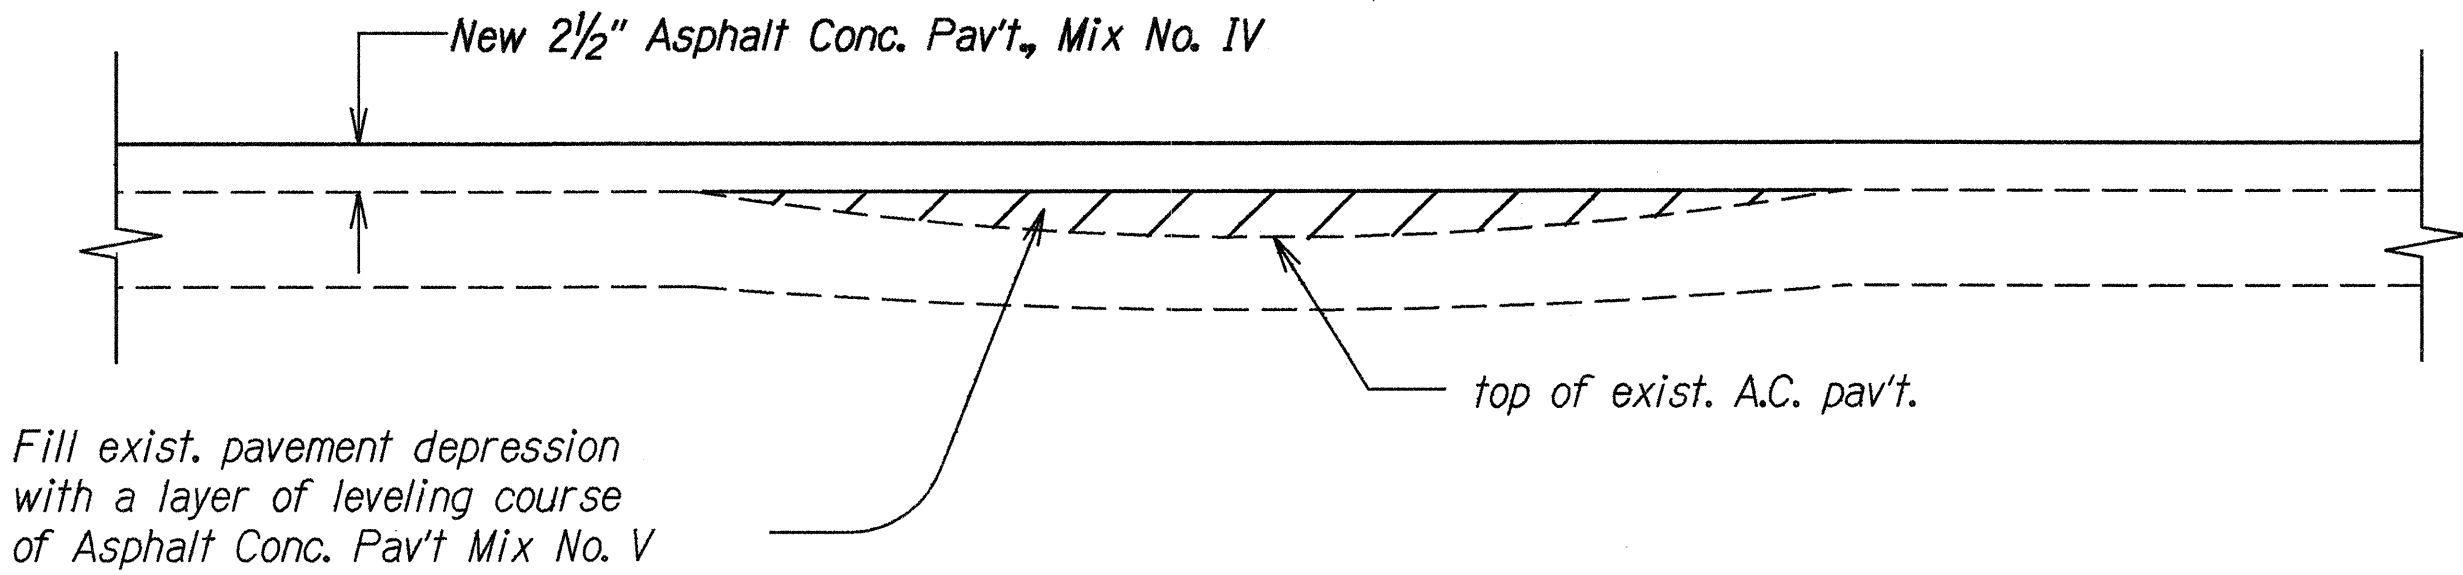

LEVELING COURSE DETAIL
Not To Scale

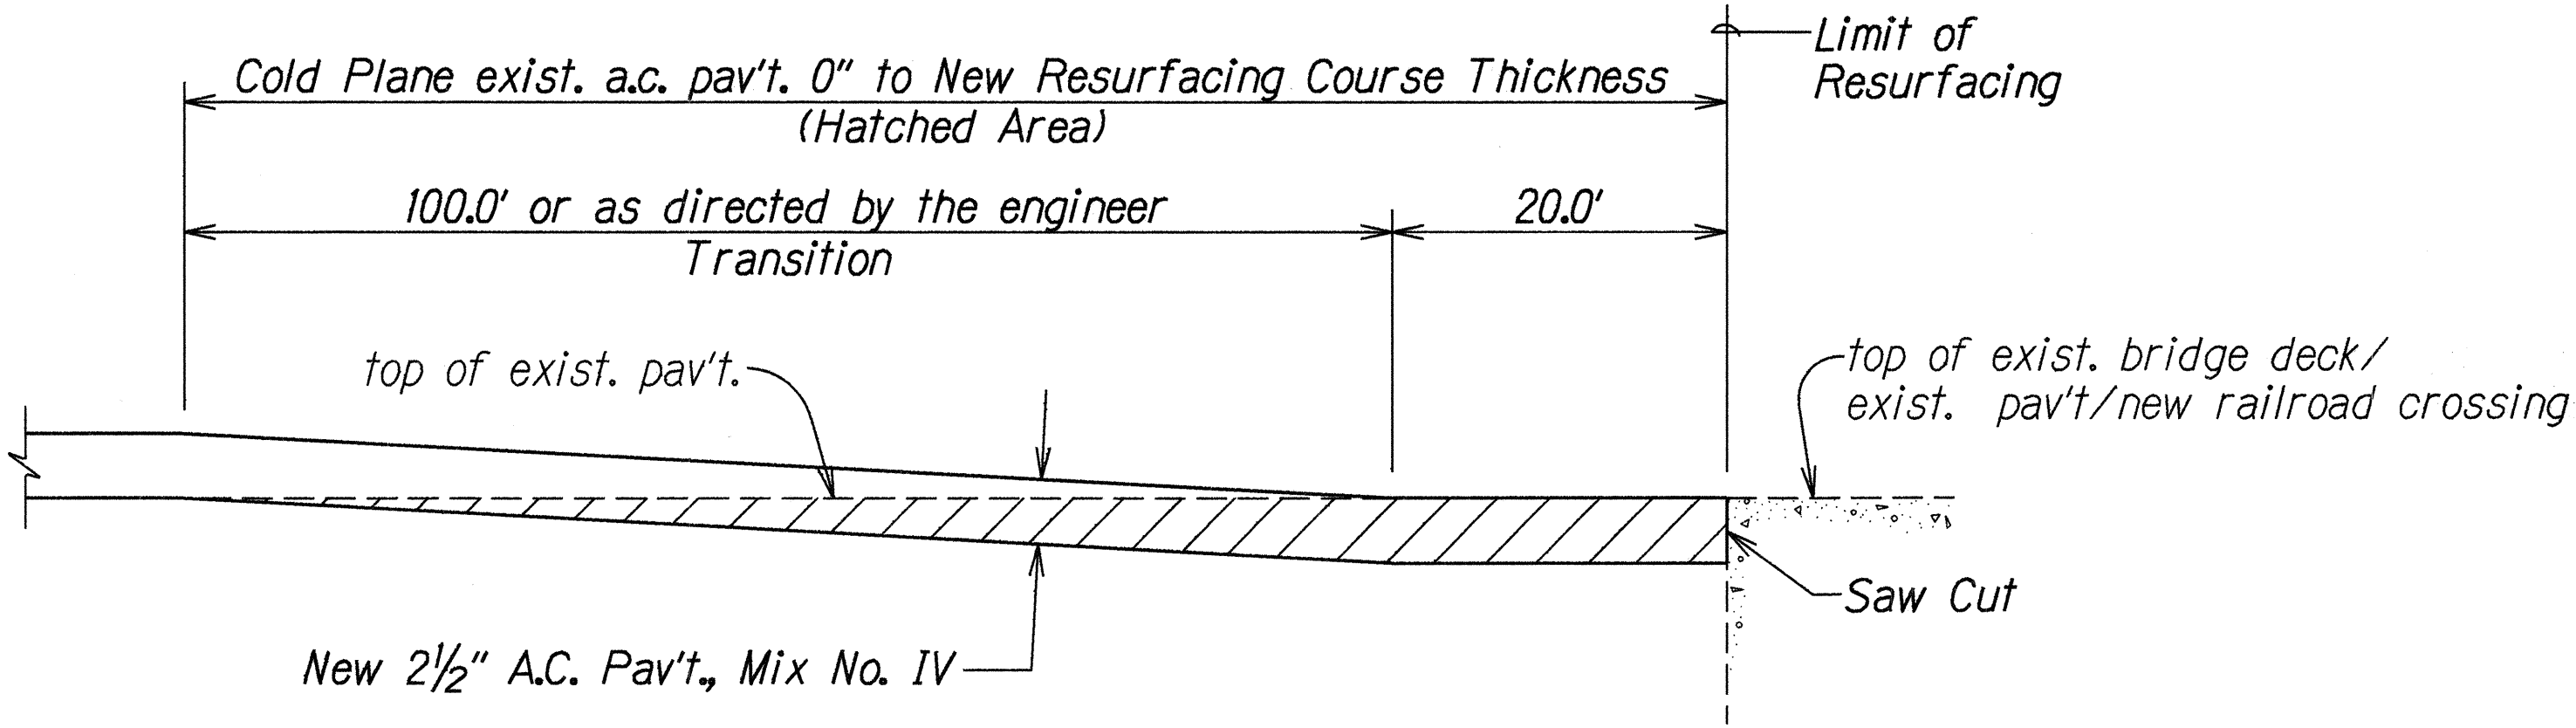

COLD PLANED TRANSITION
Not to Scale

Note: Cold planed transitions will be considered incidental to A.C. Mix IV.

ORIGINAL PLAN	SURVEY PLOTTED BY	DATE
NOTE BOOK	DRAWN BY	10/22/99
addgwen	TRACED BY	12/12/99
No. 0474502	CHECKED BY	

STATE OF HAWAII
DEPARTMENT OF TRANSPORTATION
HIGHWAYS DIVISION

TYPICAL DETAILS
FARRINGTON HIGHWAY IMPROVEMENTS
Vicinity of Tracks Beach Park
Federal Aid Project No. NH-093-1(19)
Scale: As Shown Date: May, 1999
SHEET No. 2 OF 3 SHEETS

