


INDEX TO DRAWINGS

SHEET NO.	DESCRIPTION
1	TITLE SHEET
2	STANDARD PLANS SUMMARY
3	GENERAL NOTES
4	GENERAL NOTES (CONTINUED), UTILITY SYMBOLS AND LEGEND
5-17	HIGHWAY LIGHTING PLANS
18-21	HIGHWAY LIGHTING DETAILS (ALT I)
22-25	HIGHWAY LIGHTING DETAILS (ALT II)
26	HIGHWAY LIGHTING DETAILS
27	MISCELLANEOUS DETAILS

FED. ROAD DIST. NO.	STATE	PROJ. NO.	FISCAL YEAR	SHEET NO.	TOTAL SHEETS
HAWAII	HAW.	93A-07-98	2000	1	27

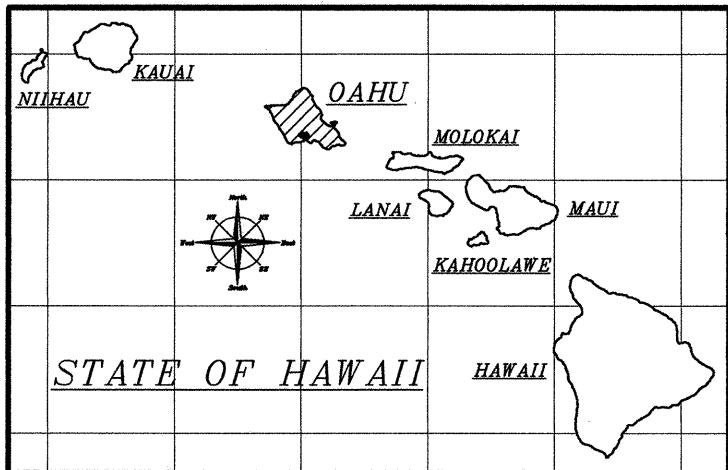

STATE OF HAWAII
DEPARTMENT OF TRANSPORTATION
HIGHWAYS DIVISION
HONOLULU, HAWAII
"AS-BUILT"
PLANS FOR
FARRINGTON HIGHWAY
LIGHTING IMPROVEMENTS
ALA HEMA STREET TO PILIOKOE BRIDGE
PROJECT NO. 93A-07-98

DISTRICT OF WAIANAE
ISLAND OF OAHU

LOCATION OF
PROJECT

SCALE IN MILES

MILE POST 11.290 TO MILE POST 14.220

LOCATION PLAN

GROSS LENGTH OF PROJECT 7.070 MILES

SCALE IN THOUSAND FEET

CHANGES MADE DURING CONSTRUCTION HAVE BEEN INCORPORATED ON THESE PLANS EXCEPT CHANGES IN THE ORIGINAL THEORETICAL QUANTITIES. FOR ACTUAL QUANTITIES, REFER TO PROJECT LEDGER AND/OR COMPUTATION BOOK.

RESIDENT ENGINEER DATE

DEPARTMENT OF TRANSPORTATION
STATE OF HAWAII

APPROVED:
DIR. OF TRANSPORTATION DATE

SHEET No. 1 OF 27 SHEETS

ORIGINAL PLAN	SURVEY PLOTTED BY	DATE
NOTE BOOK	DRAWN BY	
	DESIGNED BY	
	CHECKED BY	
No.		

M & E Pacific, Inc. DESIGNED BY V. Liorin P.S. & E. BY 692-7675 PHONE May, 2000 DATE

BEGIN PROJECT
@ STA. 28+00

PHASE II

PHASE I

PHASE II

TMK: 8-5-03, 08, 10 TO 13;
8-6-01, 15 TO 18;
8-7-01, 05 TO 08, 11 TO 17, 20, 23 TO
26, 28, 31, 33 TO 35;
8-9-01, 02, 05 TO 07