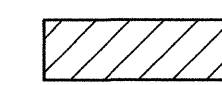



FED. ROAD DIST. NO.	STATE	PROJ. NO.	FISCAL YEAR	SHEET NO.	TOTAL SHEETS
HAWAII	HAW.	93A-03-97	1998	3	18

GENERAL NOTES

1. The scope of work for this project consists of installing a new traffic signal system with appurtenances; reconstructing pavement; constructing new pavement; removing, relocating and installing signing, striping, and markings and relocating power poles (by HTCO).
2. The Contractor is reminded of the requirements of Subsection 108.01 – Subletting of Contract, which requires him to perform work amounting to not less than 50 percent of the total contract cost less deductible items. Non-compliance with this Subsection may be grounds for rejection of bid.
3. The Contractor's attention is directed to the following Sections of the Special Provisions : Subsection 107.13 – Public Convenience and Safety; Subsection 107.21 – Contractor's Responsibility For Utility Property And Services; and Section 645 –Traffic Control.
4. At the end of each day's work, the Contractor shall remove all equipment and other obstructions to permit free and safe passage of public traffic.
5. The existence and location of underground utilities, manholes, monuments and structures as shown on the plans are from the latest available data but the accuracy is not guaranteed. The encountering of other obstacles during the course of work is possible. The Contractor shall be held liable for any damages incurred to the existing facilities and/or improvements as a result of his operations.
6. The exact locations and limits or areas to be reconstructed and cold planed shall be determined in the field by the Engineer.
7. The Contractor shall notify in writing, the Oahu Transit Services, Inc. Roads Supervision Office, 811 Middle St., Hon., HI 96819 (ph. #848-4571) seven (7) days prior to any paving operations.
8. The Contractor shall notify the Engineer in writing, two (2) weeks prior to starting paving operations.
9. The Contractor shall remove and dispose of all existing raised pavement markers, that are not incorporated into the new work.
10. Smooth riding connections shall be constructed at all interfaces of new and reconstructed pavement with the existing, including the beginning and end of project, connecting approaches, side streets and driveways as shown on the plans and/or as directed by the Engineer.
11. Dressing of shoulder and bus turnout shall consist of clearing, grubbing, grading, reshaping and compacting the unpaved shoulders with suitable material as shown on the plans and/or as directed by the Engineer. This work shall be considered incidental to the various contract items.
12. Earth swale shall be graded to drain. This work shall be considered incidental to the various contract items.
13. The contractor shall provide for access to and from all existing side streets and driveways at all times.
14. All saw cutting work shall be considered incidental to the various contract items.

LEGEND

-  Reconstruction or New A.C. Pavement Area
- e— Existing Electrical Line
- E— New Electrical Line
- o_{jp} Existing Joint Pole
- o_{pp} Existing Power Pole
- o_{emh} Existing Electric Manhole
- o_{EMH} Adjusted Elec. MH Frame/Cover
- o_{EMH} New Electric Manhole
- t— Existing Telephone Line
- T— New Telephone Line
- o_{tp} Existing Telephone Pole
- o_{tmh} Existing Telephone Manhole
- o_{TMH} Adjusted Tele. MH Frame/Cover
- o_{TMH} New Telephone Manhole
- sc— Existing Signal Corps Line
- SC— New Signal Corps Line
- tv— Existing TV Cable
- TV— New TV Cable
- w-12— Existing 12" Water Line
- o_{wmh} Existing Water Manhole
- o_{av} Existing Water Air Valve
- o_{wv} Existing Water Valve Box
- o_{WV} Adjusted Water Valve Box
- o_{wv} Existing Water Meter
- o_{fh} Existing Fire Hydrant
- s-12— Existing Sewer Line
- o_{smh} Existing Sewer Manhole
- g-6— Existing 6" Gas Line
- o_{gv} Existing Gas Valve Box
- o_{gmh} Existing Gas Manhole
- o_{mon.} Existing Monument
- b Existing Traffic Sign
- o Existing Highway Lighting Standard

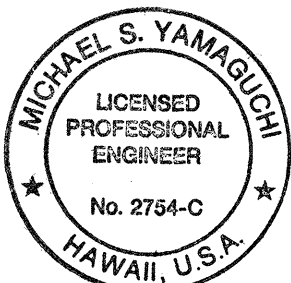

THIS WORK WAS PREPARED BY
ME OR UNDER MY SUPERVISION
By: *Michael S. Yamaguchi*
FUJITA & ASSOCIATES

STATE OF HAWAII
DEPARTMENT OF TRANSPORTATION
HIGHWAYS DIVISION

LEGEND AND
GENERAL NOTES

FARRINGTON HIGHWAY
Intersection Improvements at Maliona St.

Project No. 93A-03-97

Date: Apr. 1998