


Farrington Hwy. @ Sta. 111+48± to @ Sta. 112+15± Lt.
Remove 67± L.F. of damaged guardrail & Install 67± L.F.
of Strong Post W-Beam Guardrail.


FED. ROAD DIST. NO.	STATE	PROJ. NO.	FISCAL YEAR	SHEET NO.	TOTAL SHEETS
HAWAII	HAW.	93A-06-98	2001	17	68

Farrington Hwy @ Sta. 112+10± to 112+35± Lt.
Remove 25± L.F. of Substandard Guardrail
Install 25± L.F. of Strong Post W-Beam
Guardrail (See Sht. C-6)

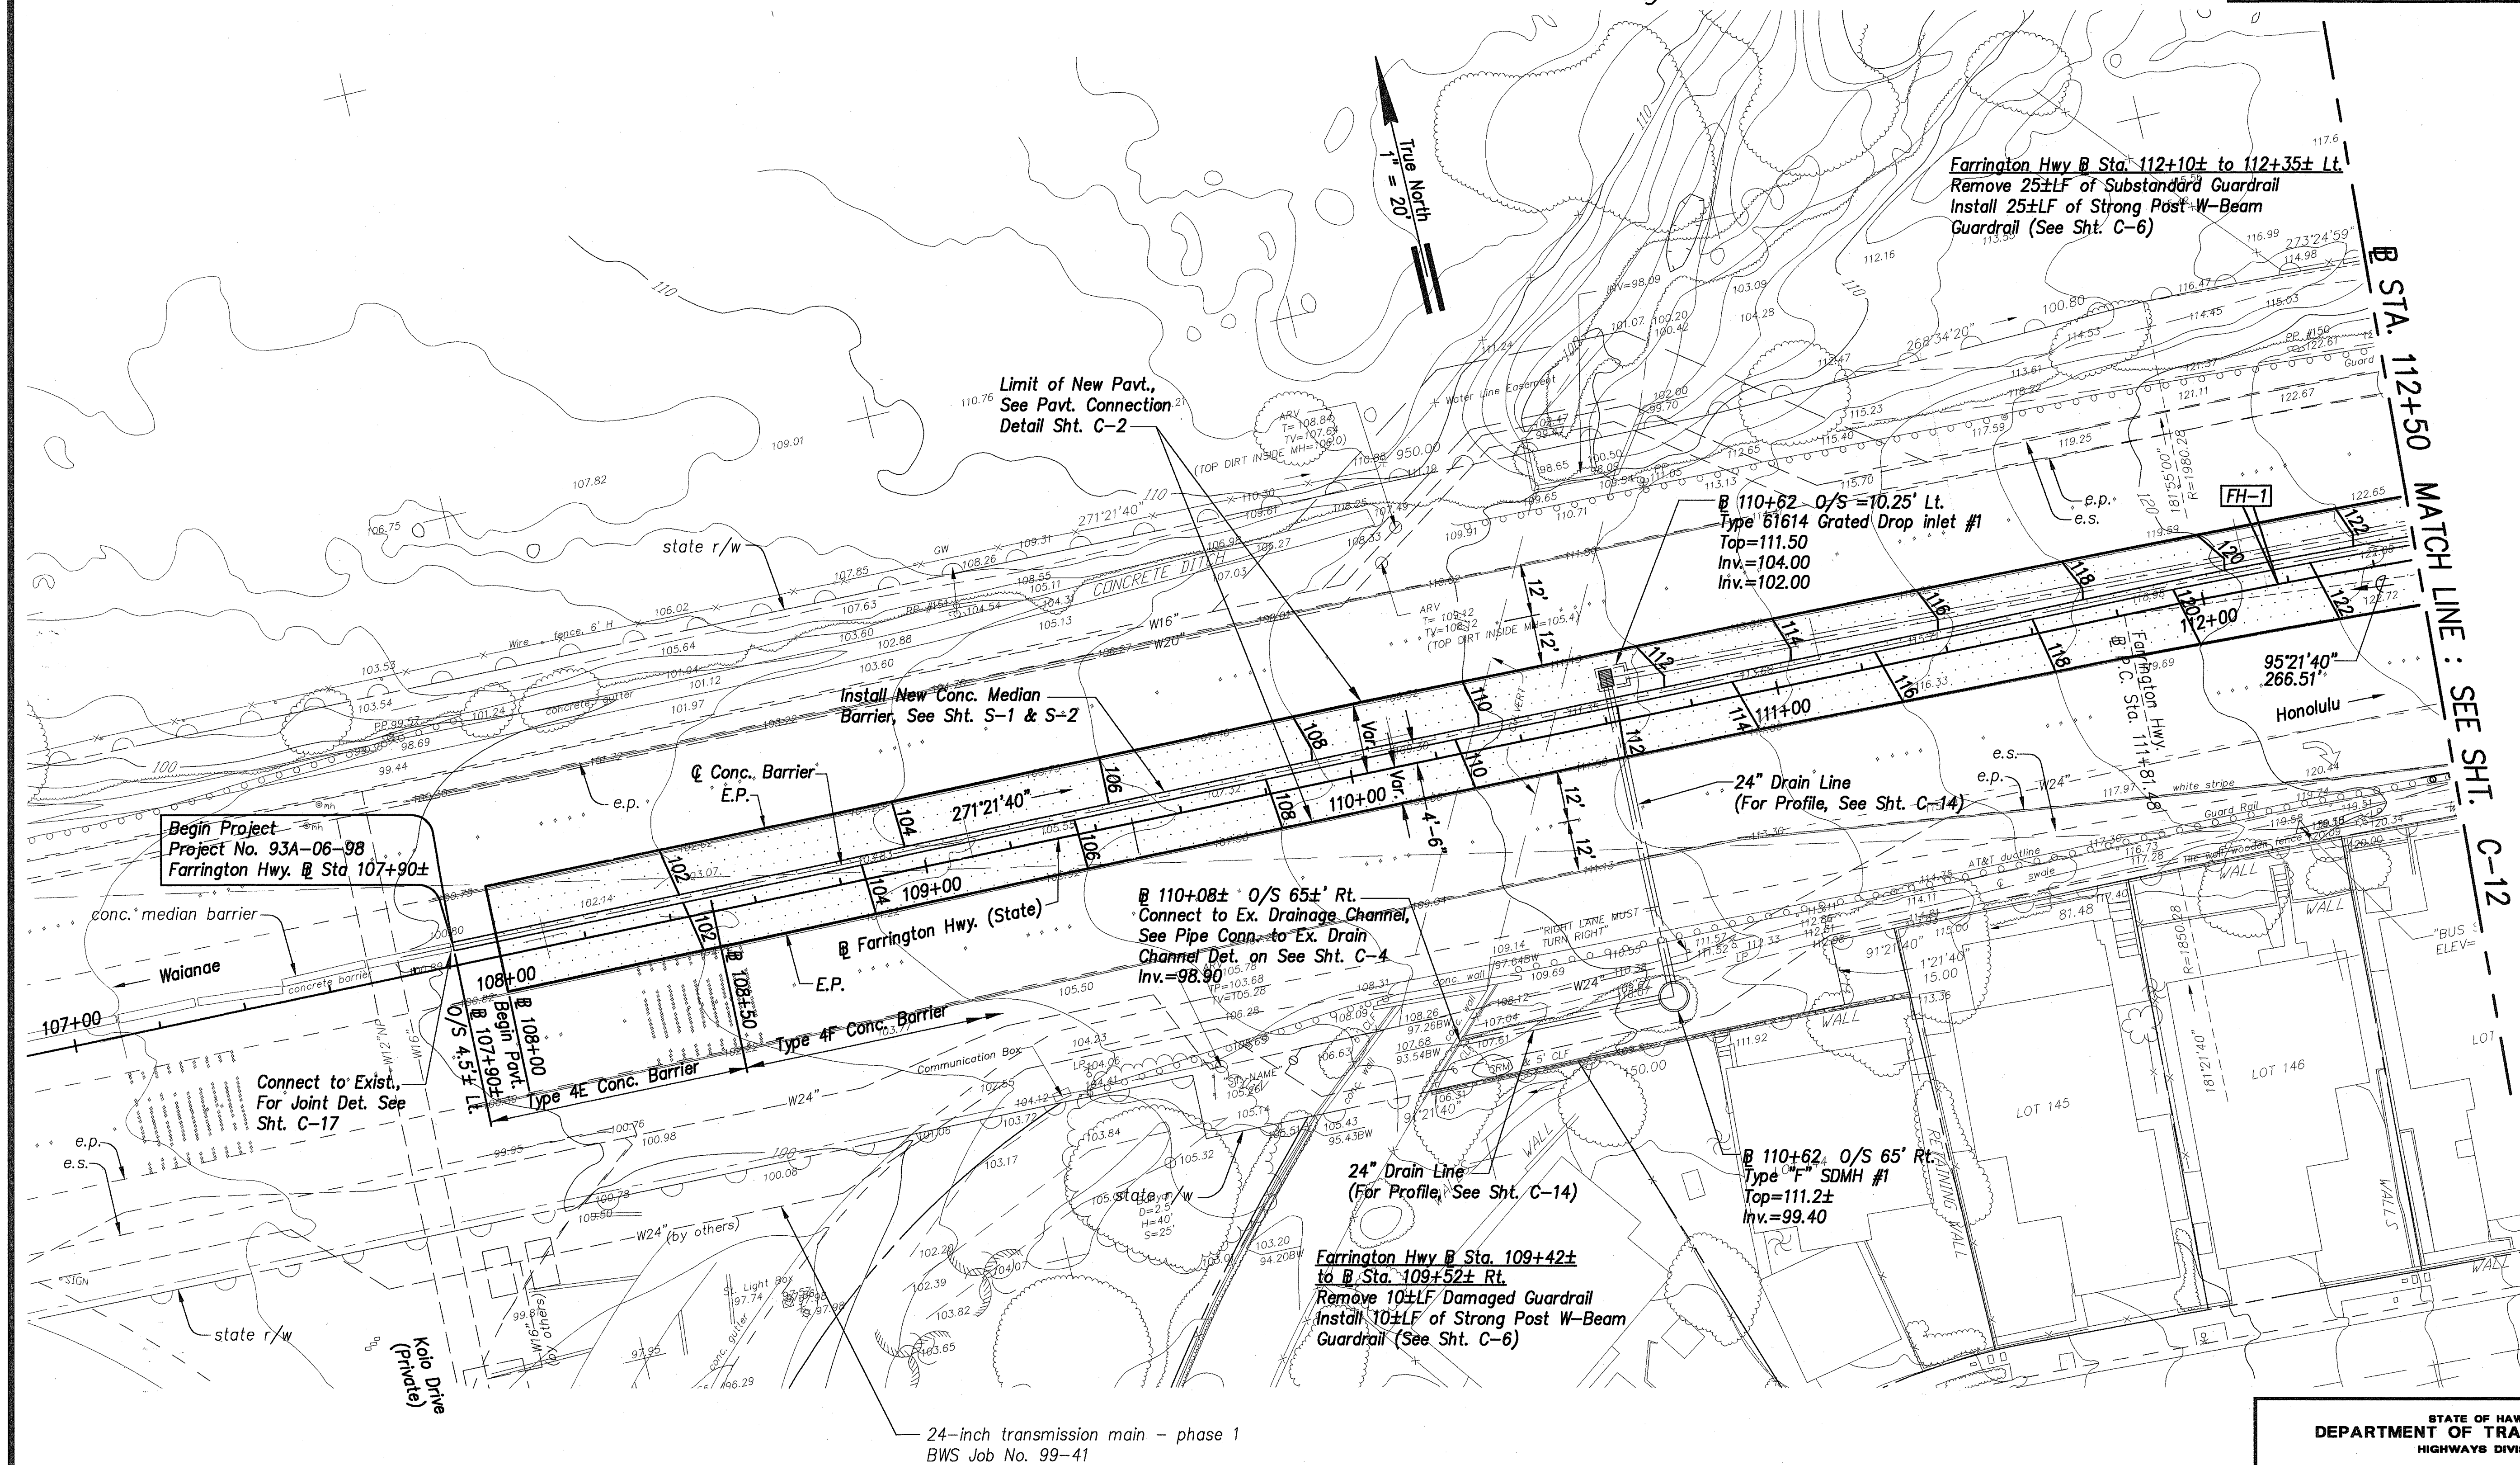

Curve Data


FH-1	
Δ	08°00'00"
R	1910.28'
T	133.58'
C	266.51'
Lc	266.73'

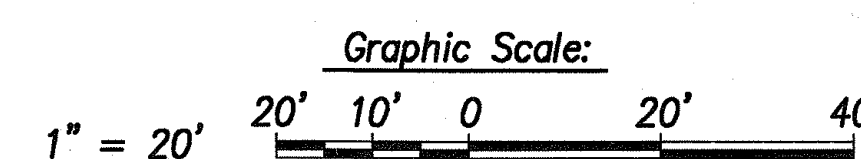

APPROVED:

Catharine R. Dungea 3/30/01

for CHIEF, PLANNING & ENGINEERING, BWS DATE

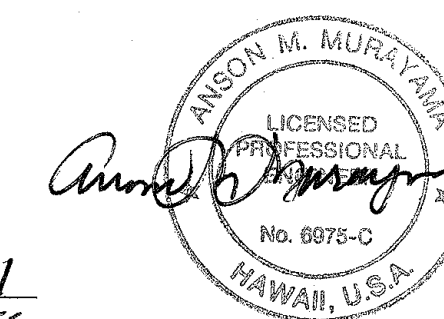

STATE OF HAWAII
DEPARTMENT OF TRANSPORTATION
HIGHWAYS DIVISION

INTERSECTION IMPROVEMENT PLAN

FARRINGTON HIGHWAY
Intersection Improvements at Waiomea Street
Project No. 93A-06-98


Scale: 1" = 20' Date: August 2000

SHEET No. C-11 OF 29 SHEETS

"AS-BUILT"

FED. ROAD DIST. NO.	STATE	PROJ. NO.	FISCAL YEAR	SHEET NO.	TOTAL SHEETS
HAWAII	HAW.	93A-06-98	2001	19	68

Note:
Trees to remain, contractor
to work around ex. trees.

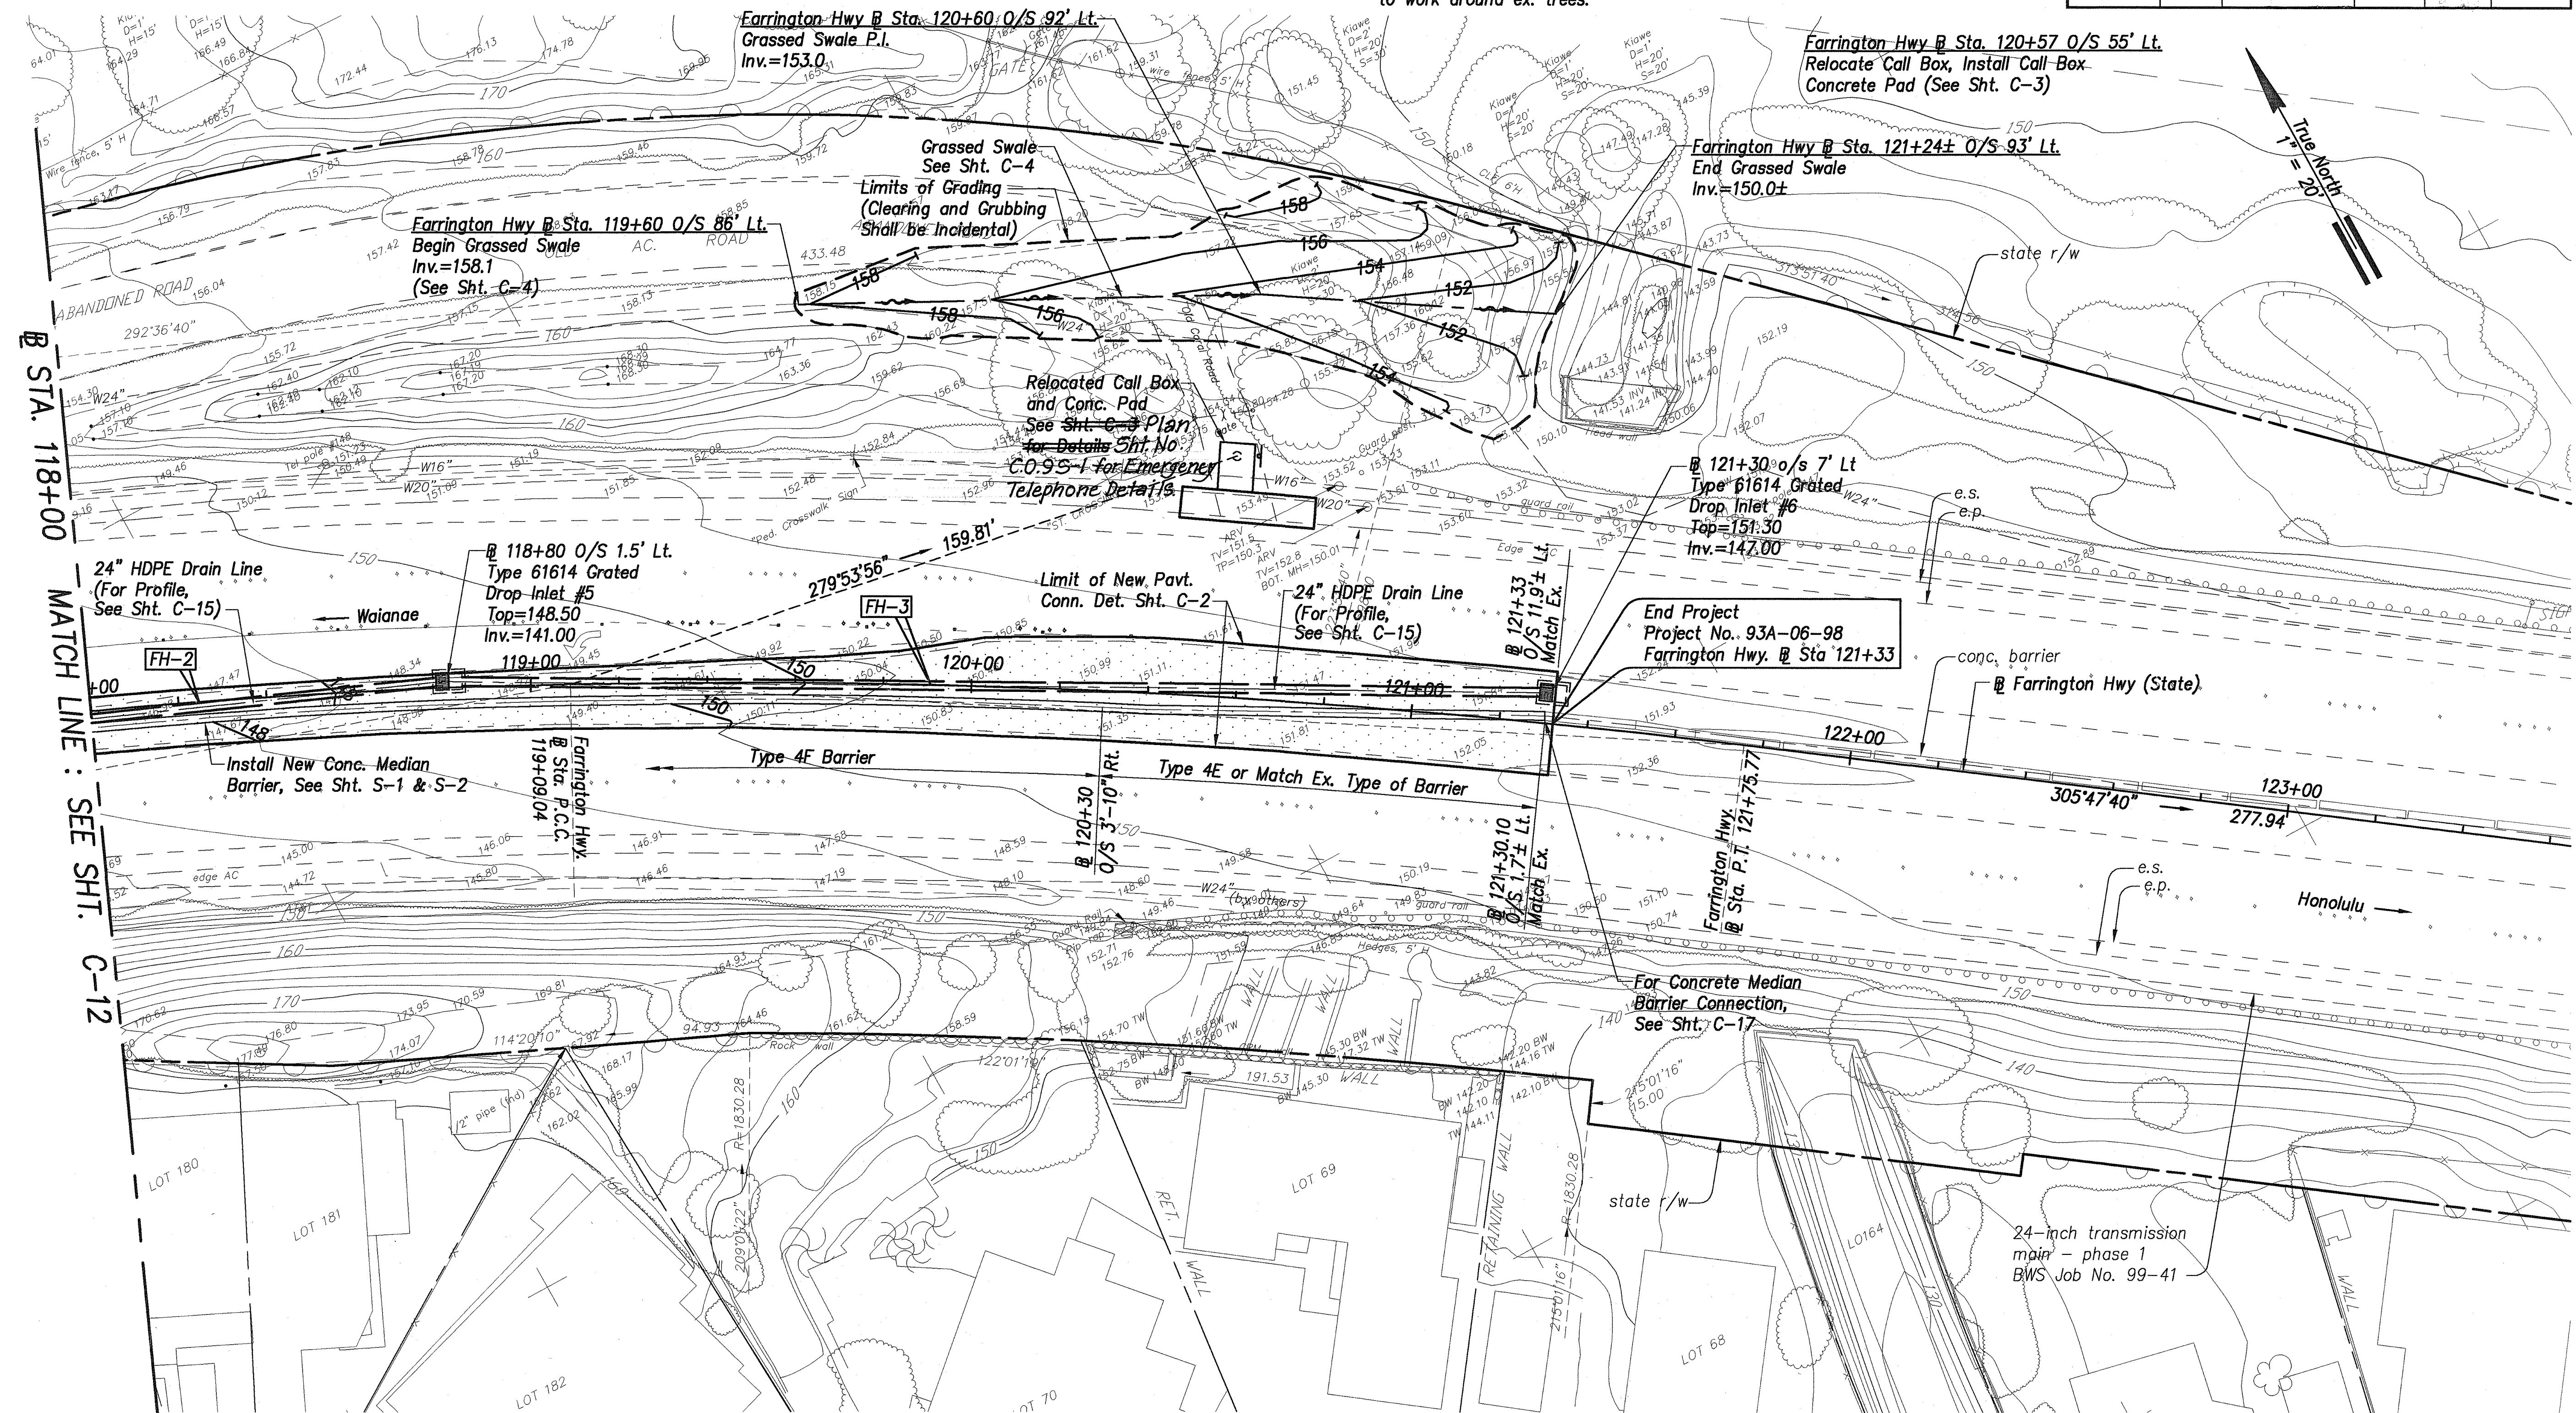


	FH-2	FH-3
Δ	18°26'00"	08°00'00"
R	1432.40'	1910.28'
T	232.43'	133.58'
C	458.85'	266.51'
L _c	460.84'	266.73'

Graphic Scale:

1" = 20'

20' 10' 0 20' 40'

APPROVED: Catherine R. Dungea 3/20/01
for CHIEF, PLANNING & ENGINEERING, BWS ^{MD} DATE

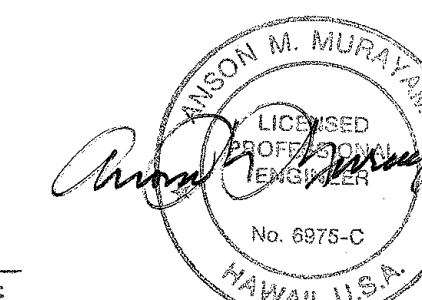

STATE OF HAWAII
DEPARTMENT OF TRANSPORTATION
HIGHWAYS DIVISION

INTERSECTION IMPROVEMENT PLAN

FARRINGTON HIGHWAY
Intersection Improvements at Waiomea Street
Project No. 93A-06-98

Scale: 1" = 20' Date: August 2000

SHEET No. C-13 OF 29 SHEETS

"AS-BUILT"