

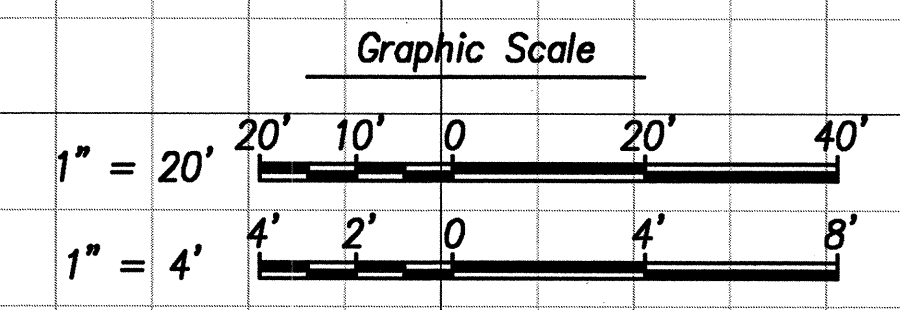
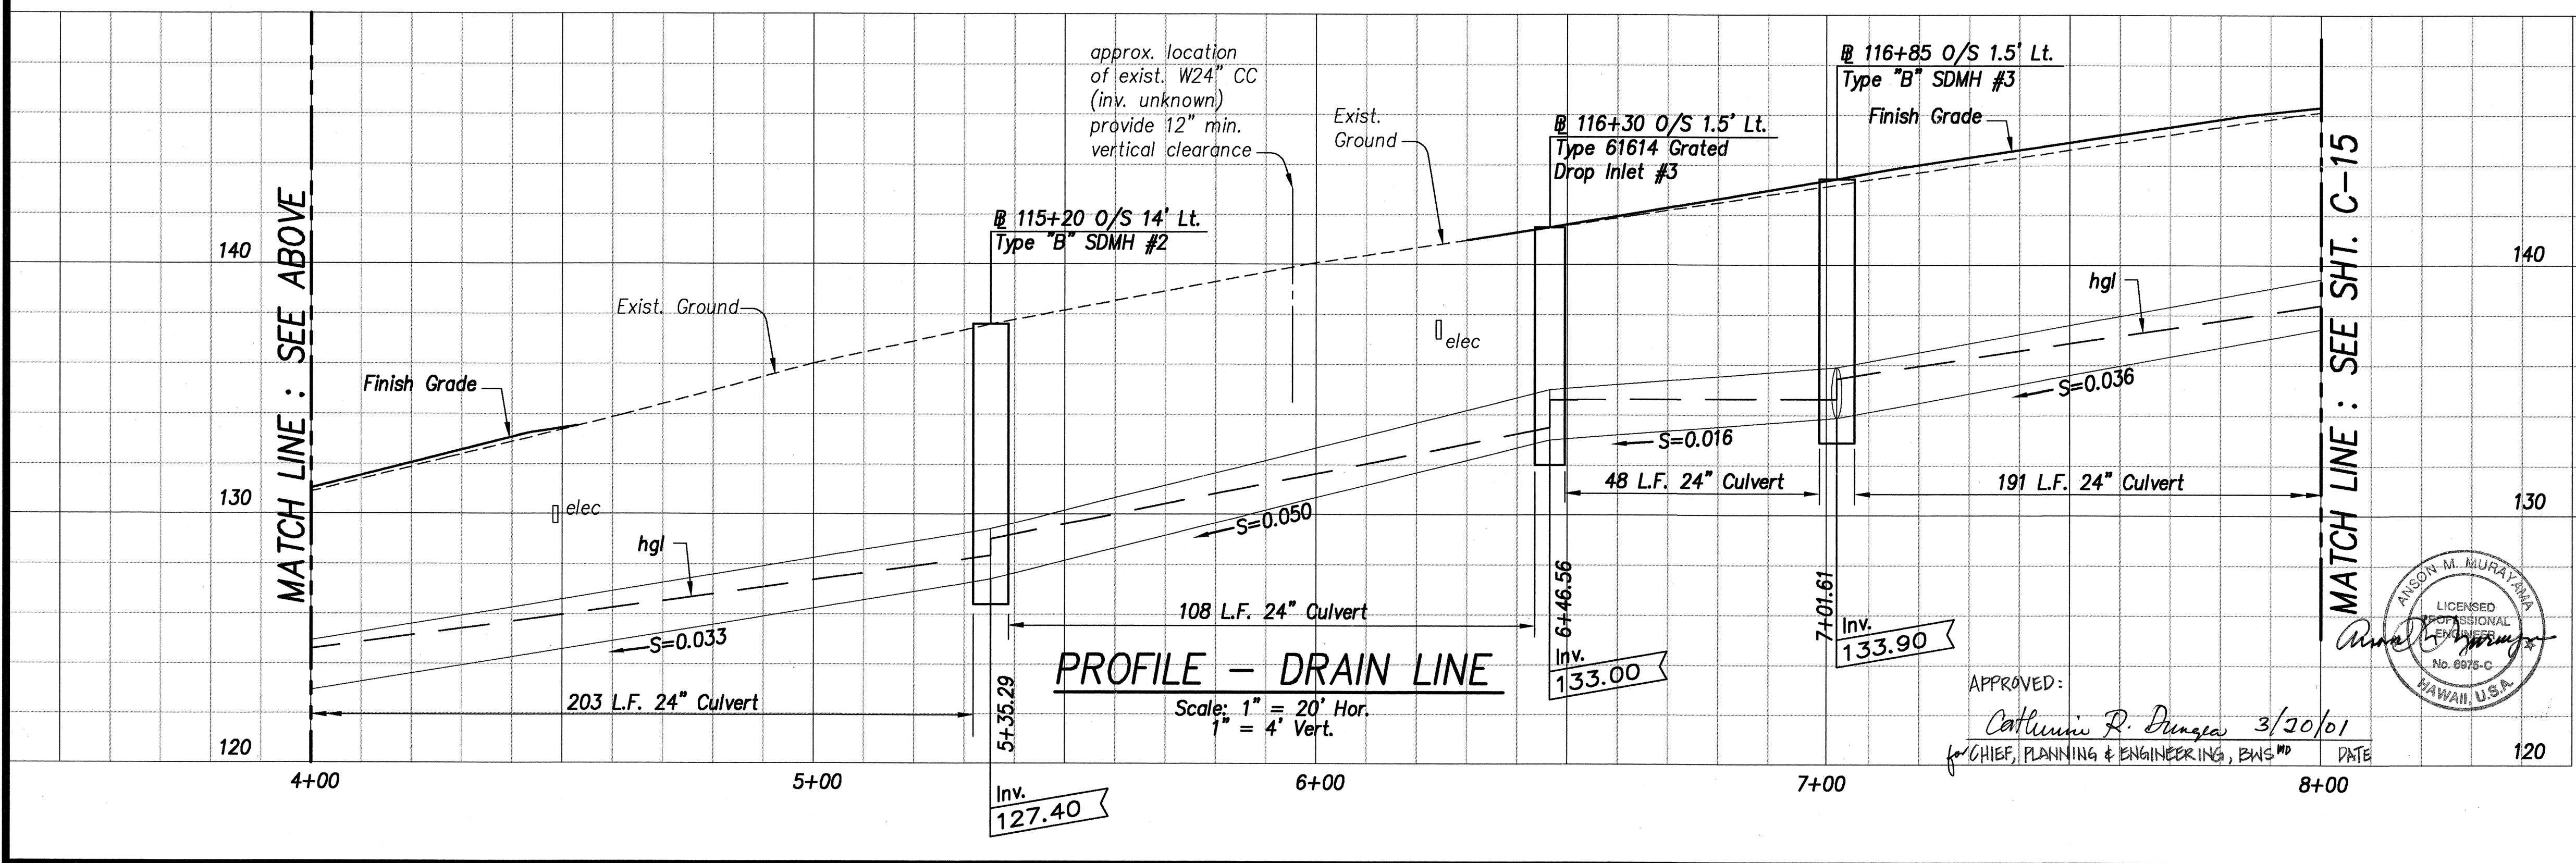


FED. ROAD DIST. NO.	STATE	PROJ. NO.	FISCAL YEAR	SHEET NO.	TOTAL SHEETS
HAWAII	HAW.	93A-06-98	2001	20	68

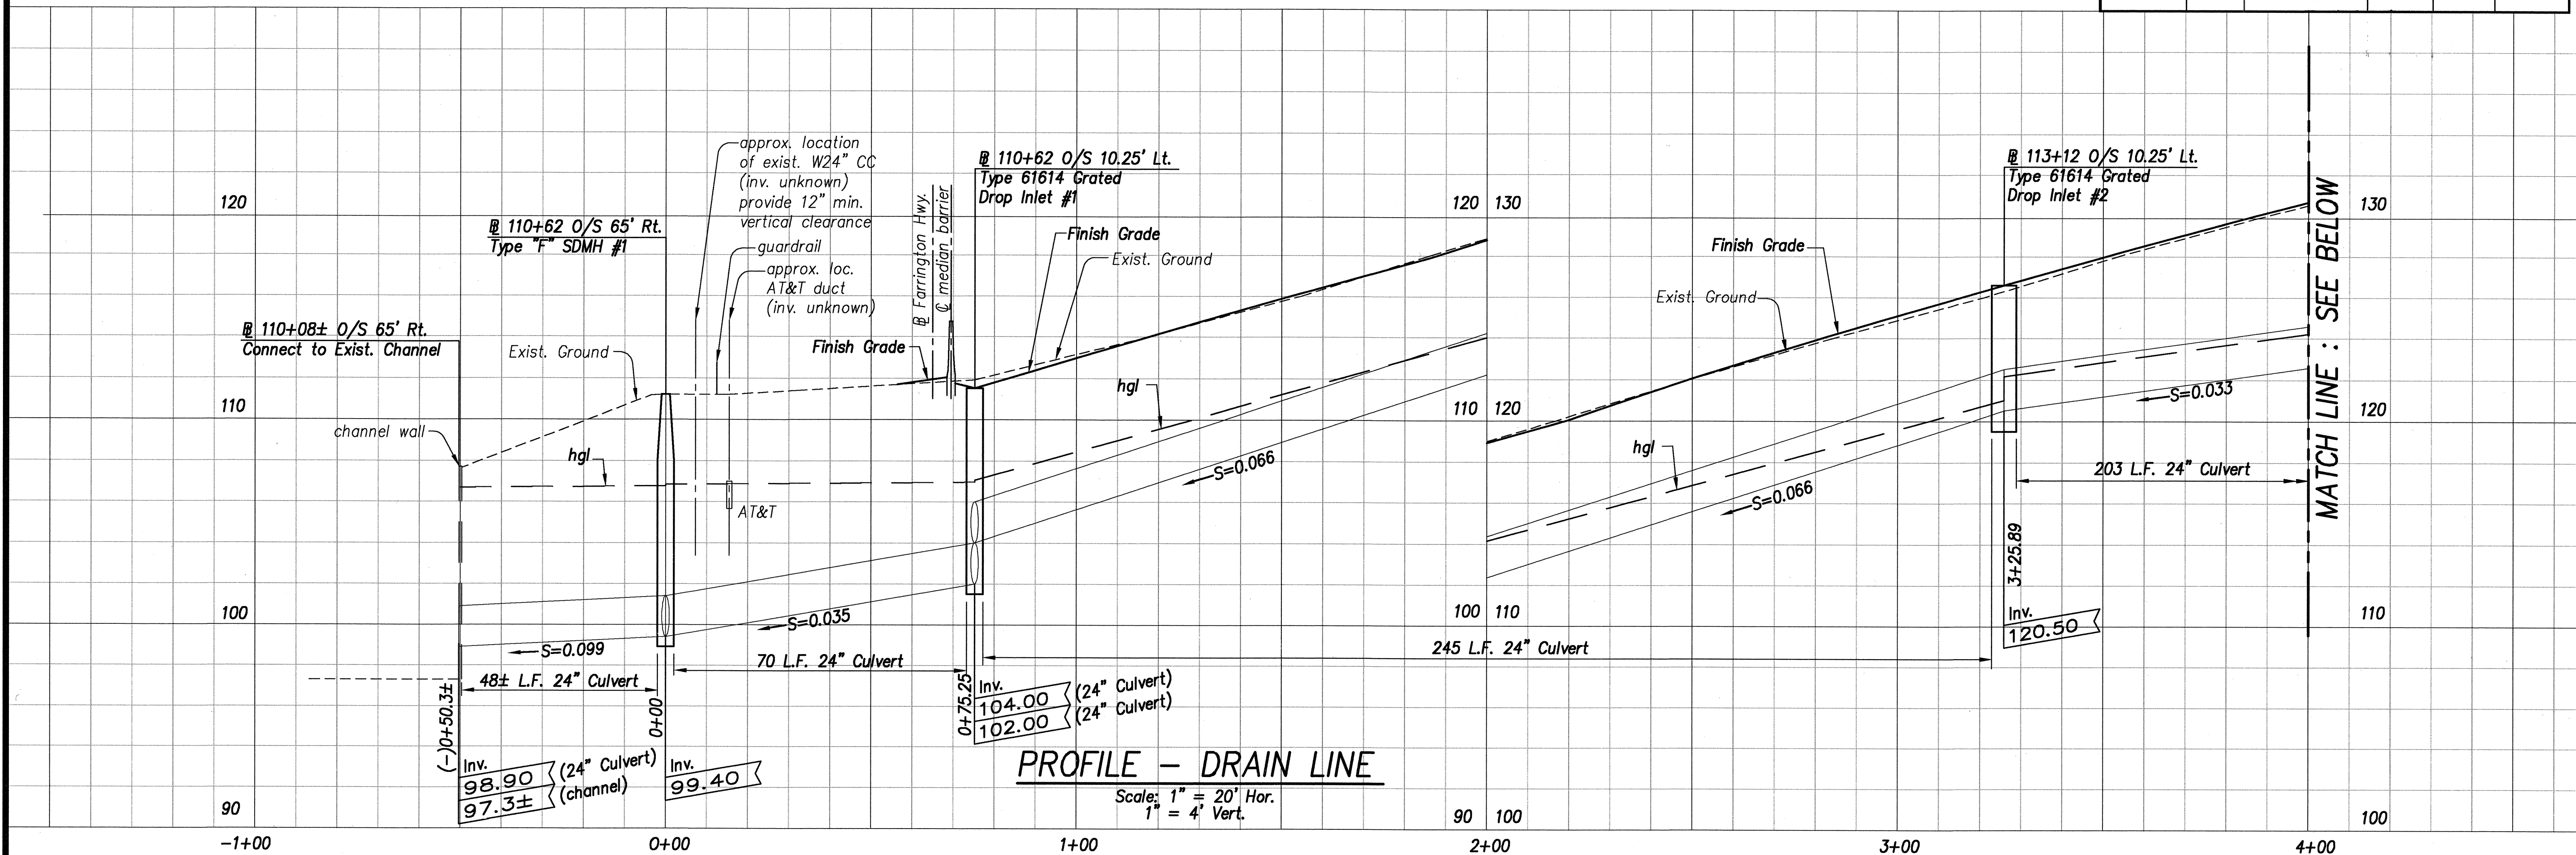

SURVEY PLOTTED BY	DATE
DRAWN BY	
CHECKED BY	
NOTED BY	
QUANTITIES BY	
CHECKED BY	
NO.	

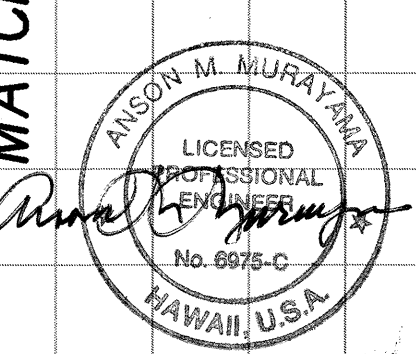

APPROVED:
Catherine R. Dunne 3/20/01
for CHIEF, PLANNING & ENGINEERING, BWS MD DATE

STATE OF HAWAII
DEPARTMENT OF TRANSPORTATION
HIGHWAYS DIVISION




PROFILE - DRAIN LINE

FARRINGTON HIGHWAY
Intersection Improvements at Waiomea Street
Project No. 93A-06-98


Scale: 1" = 20' Date: August 2000

SHEET No. C-14 OF 29 SHEETS

FED. ROAD DIST. NO.	STATE	PROJ. NO.	FISCAL YEAR	SHEET NO.	TOTAL SHEETS
HAWAII	HAW.	93A-06-98	2001	21	68

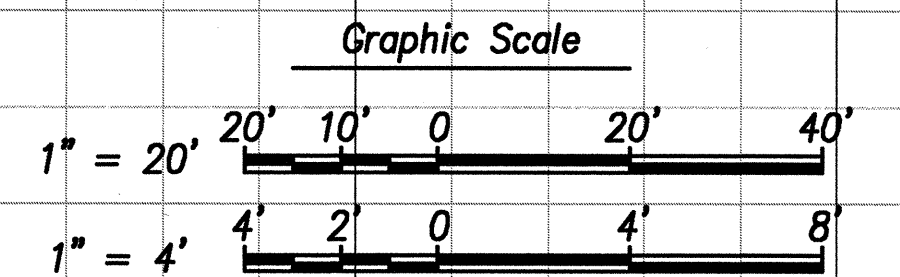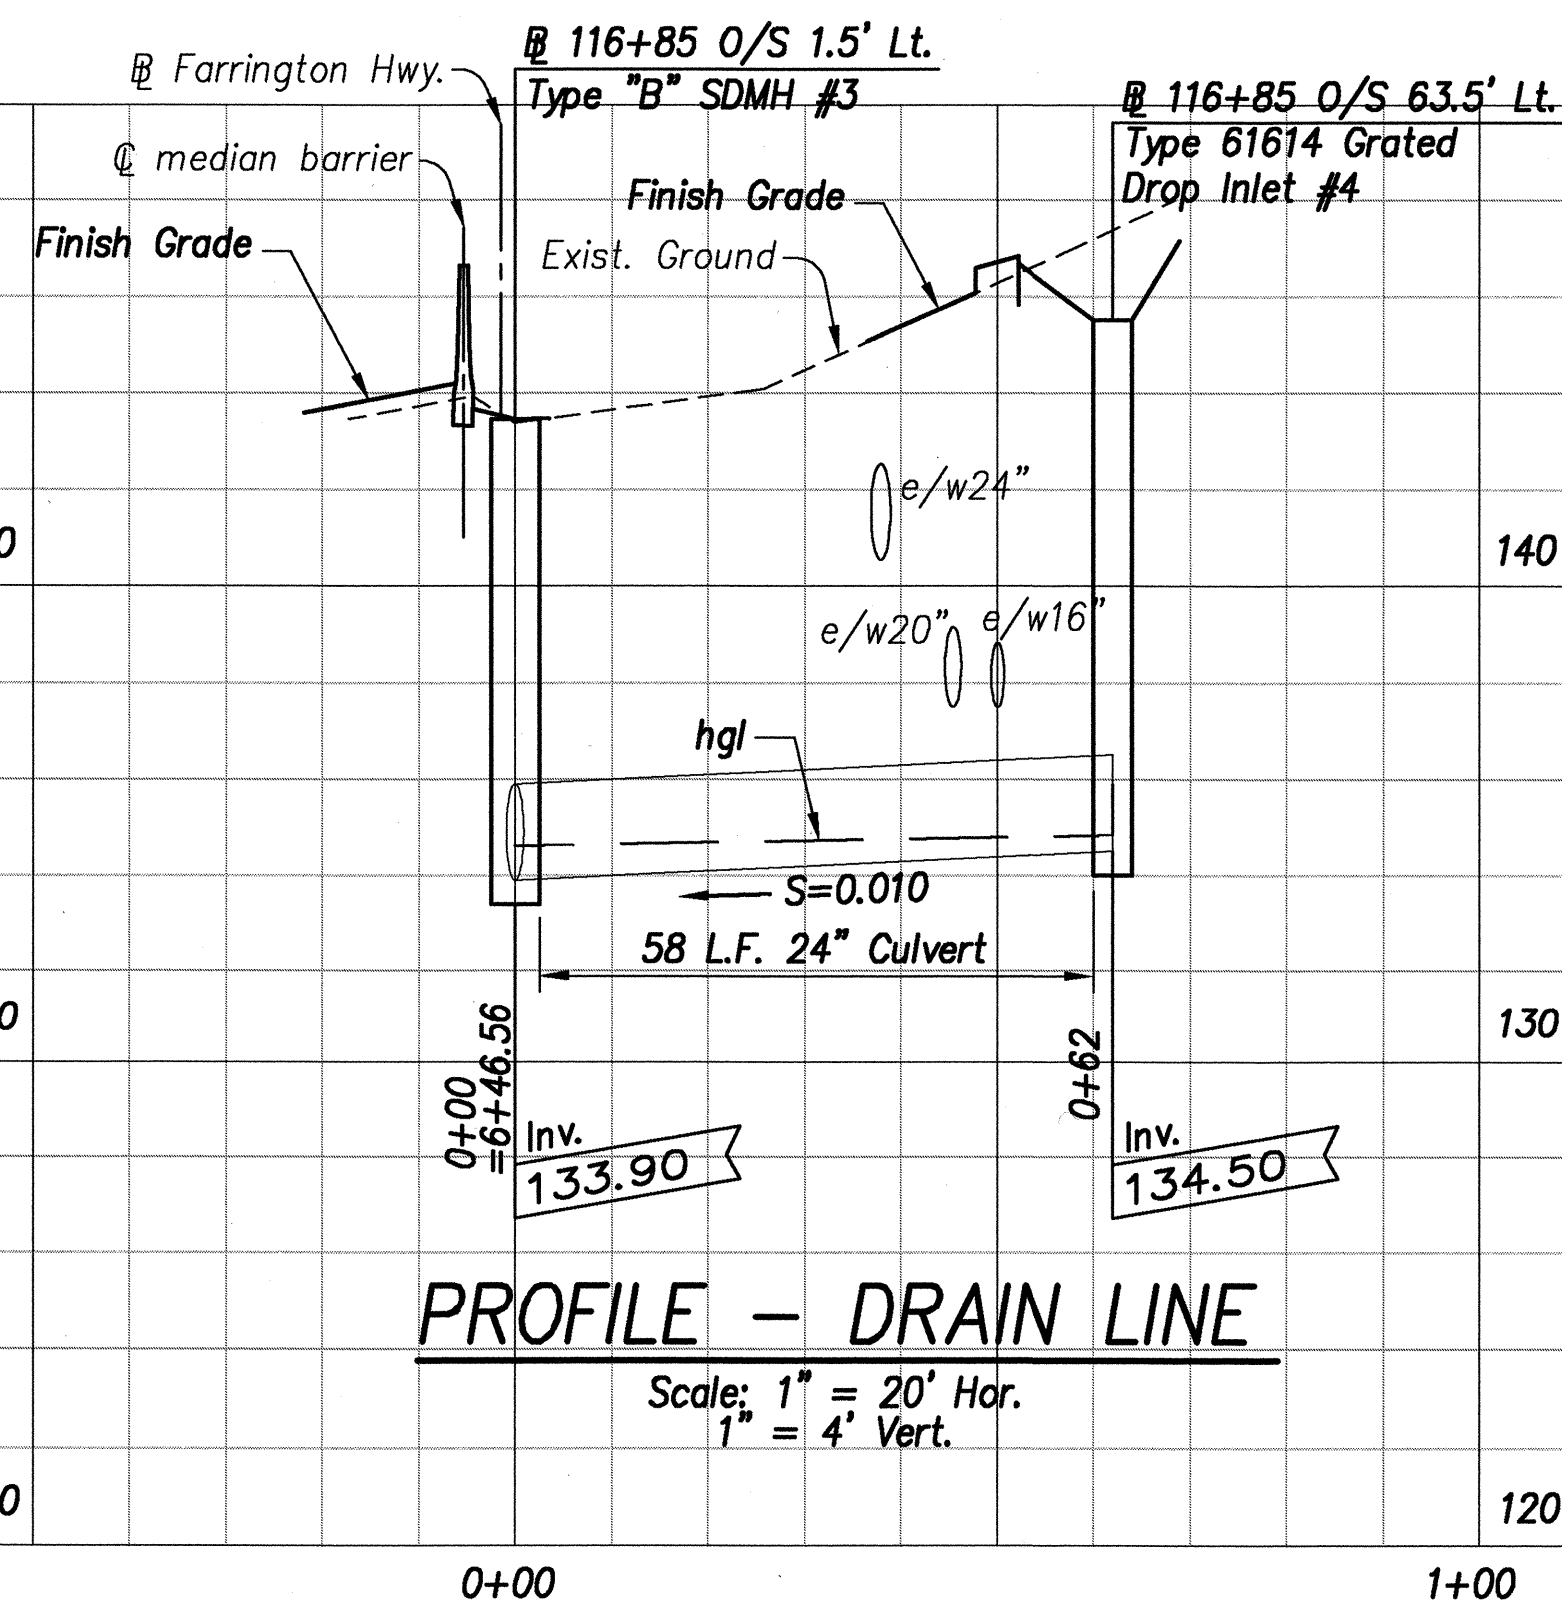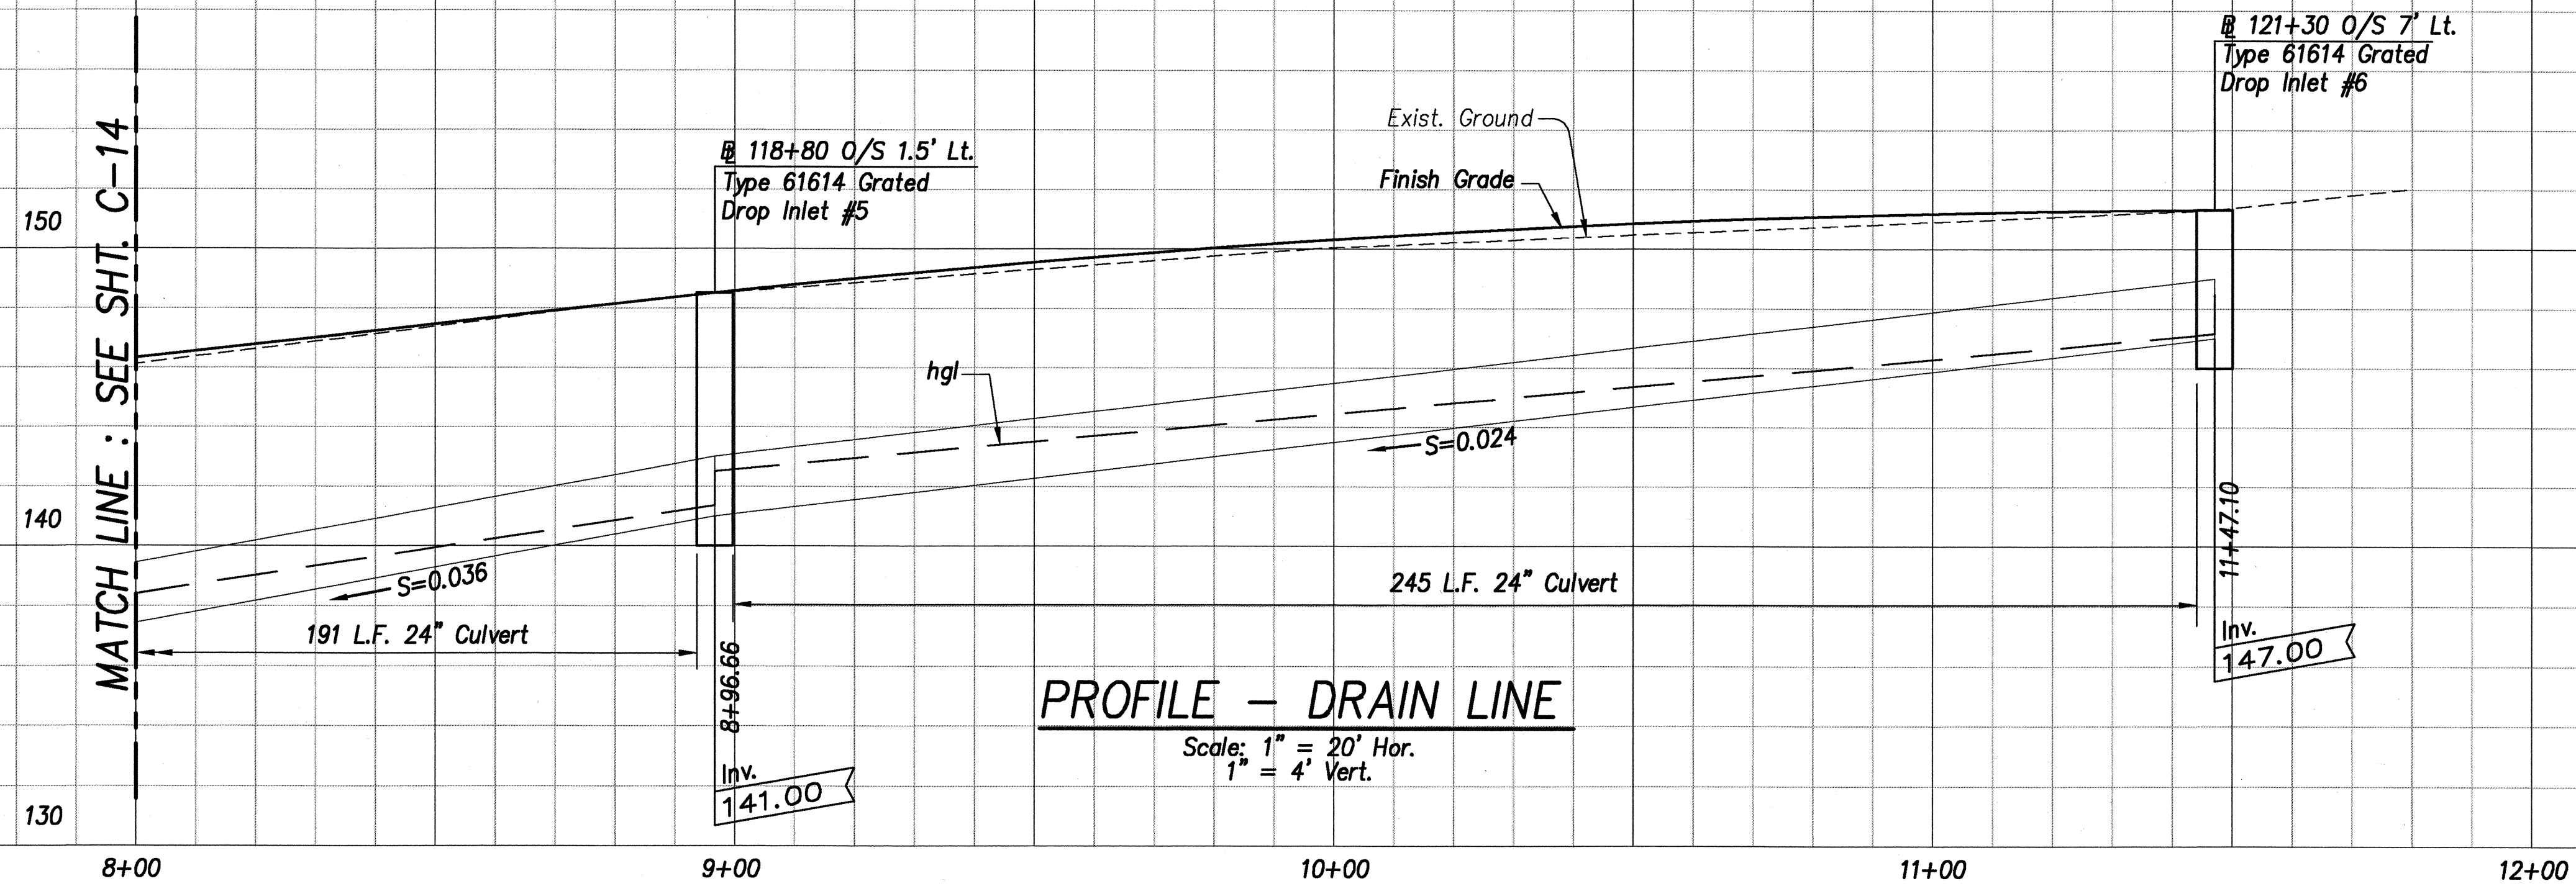

APPROVED:
Caroline R. Dwyer 3/20/01
 for CHIEF, PLANNING & ENGINEERING, BNSM DATE

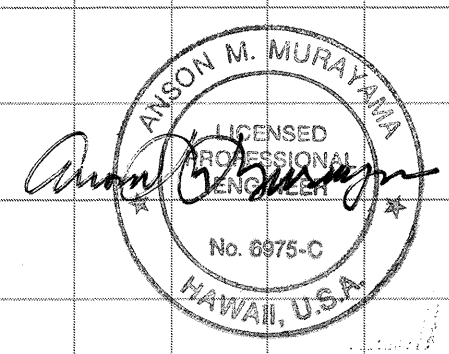

STATE OF HAWAII
 DEPARTMENT OF TRANSPORTATION
 HIGHWAYS DIVISION

PROFILE-DRAINLINE

FARRINGTON HIGHWAY
 Intersection Improvements at Waiomea Street
 Project No. 93A-06-98

Scale: 1" = 20' Date: August 2000

SHEET No. C-15 OF 29 SHEETS

SURVEY PLANNED BY	DATE
DRAWN BY	
TRACED BY	
CHECKED BY	
NOTE BOOK	
No.	