

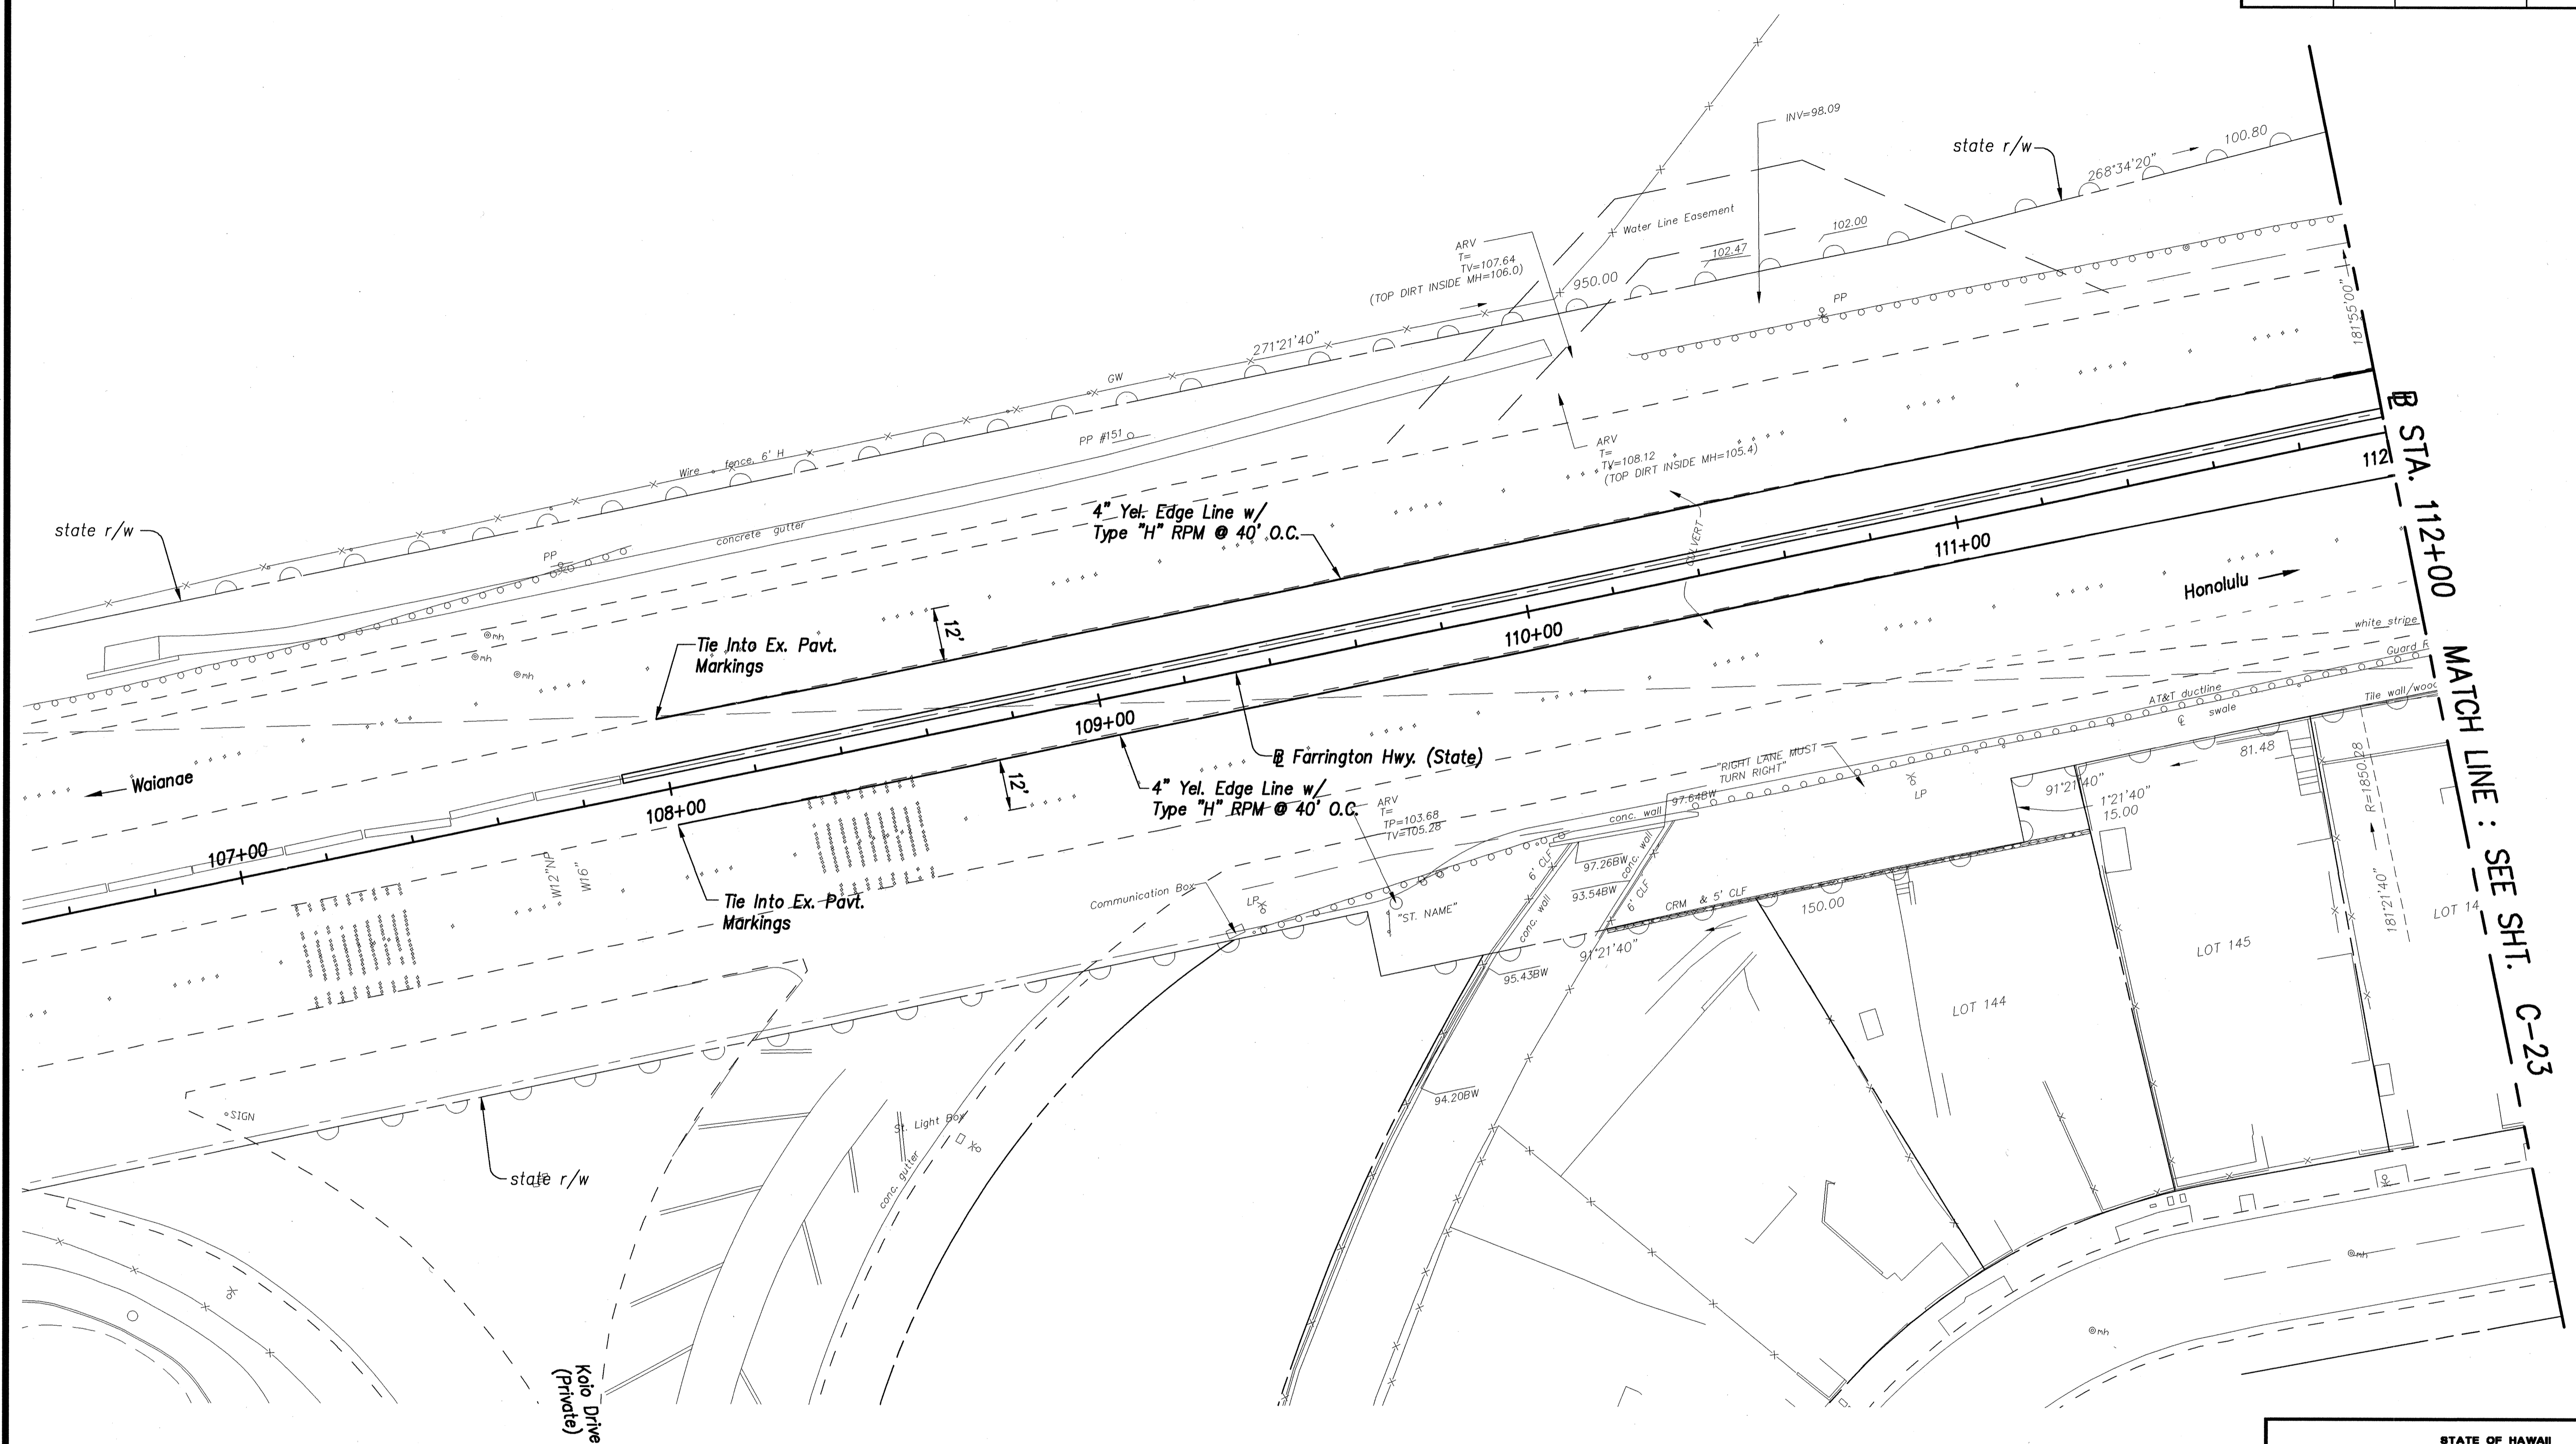


FED. ROAD DIST. NO.	STATE	PROJ. NO.	FISCAL YEAR	SHEET NO.	TOTAL SHEETS
HAWAII	HAW.	93A-06-98	2001	28	68

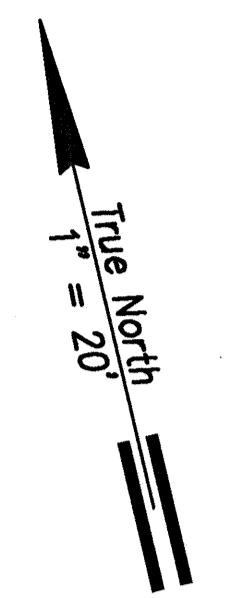

SURVEY PLATTED BY	DATE
DRAWN BY	
DESIGNED BY	
QUANTITIES BY	
CHECKED BY	
ORIGINAL PLAN	
NOTE BOOK	
No.	

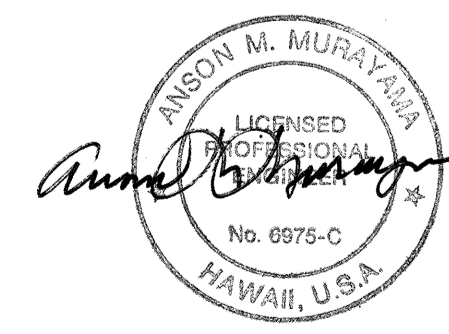

STATE OF HAWAII
DEPARTMENT OF TRANSPORTATION
HIGHWAYS DIVISION



SIGNING AND STRIPING PLAN

FARRINGTON HIGHWAY
Intersection Improvements at Waiomea Street
Project No. 93A-06-98

Scale: 1" = 20' Date: August 2000


SHEET No. C-22 OF 29 SHEETS

FED. ROAD DIST. NO.	STATE	PROJ. NO.	FISCAL YEAR	SHEET NO.	TOTAL SHEETS
HAWAII	HAW.	93A-06-98	2001	30	68

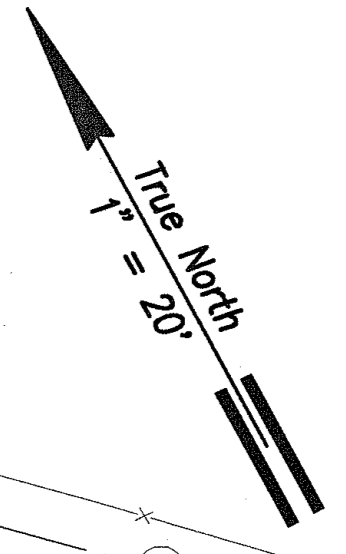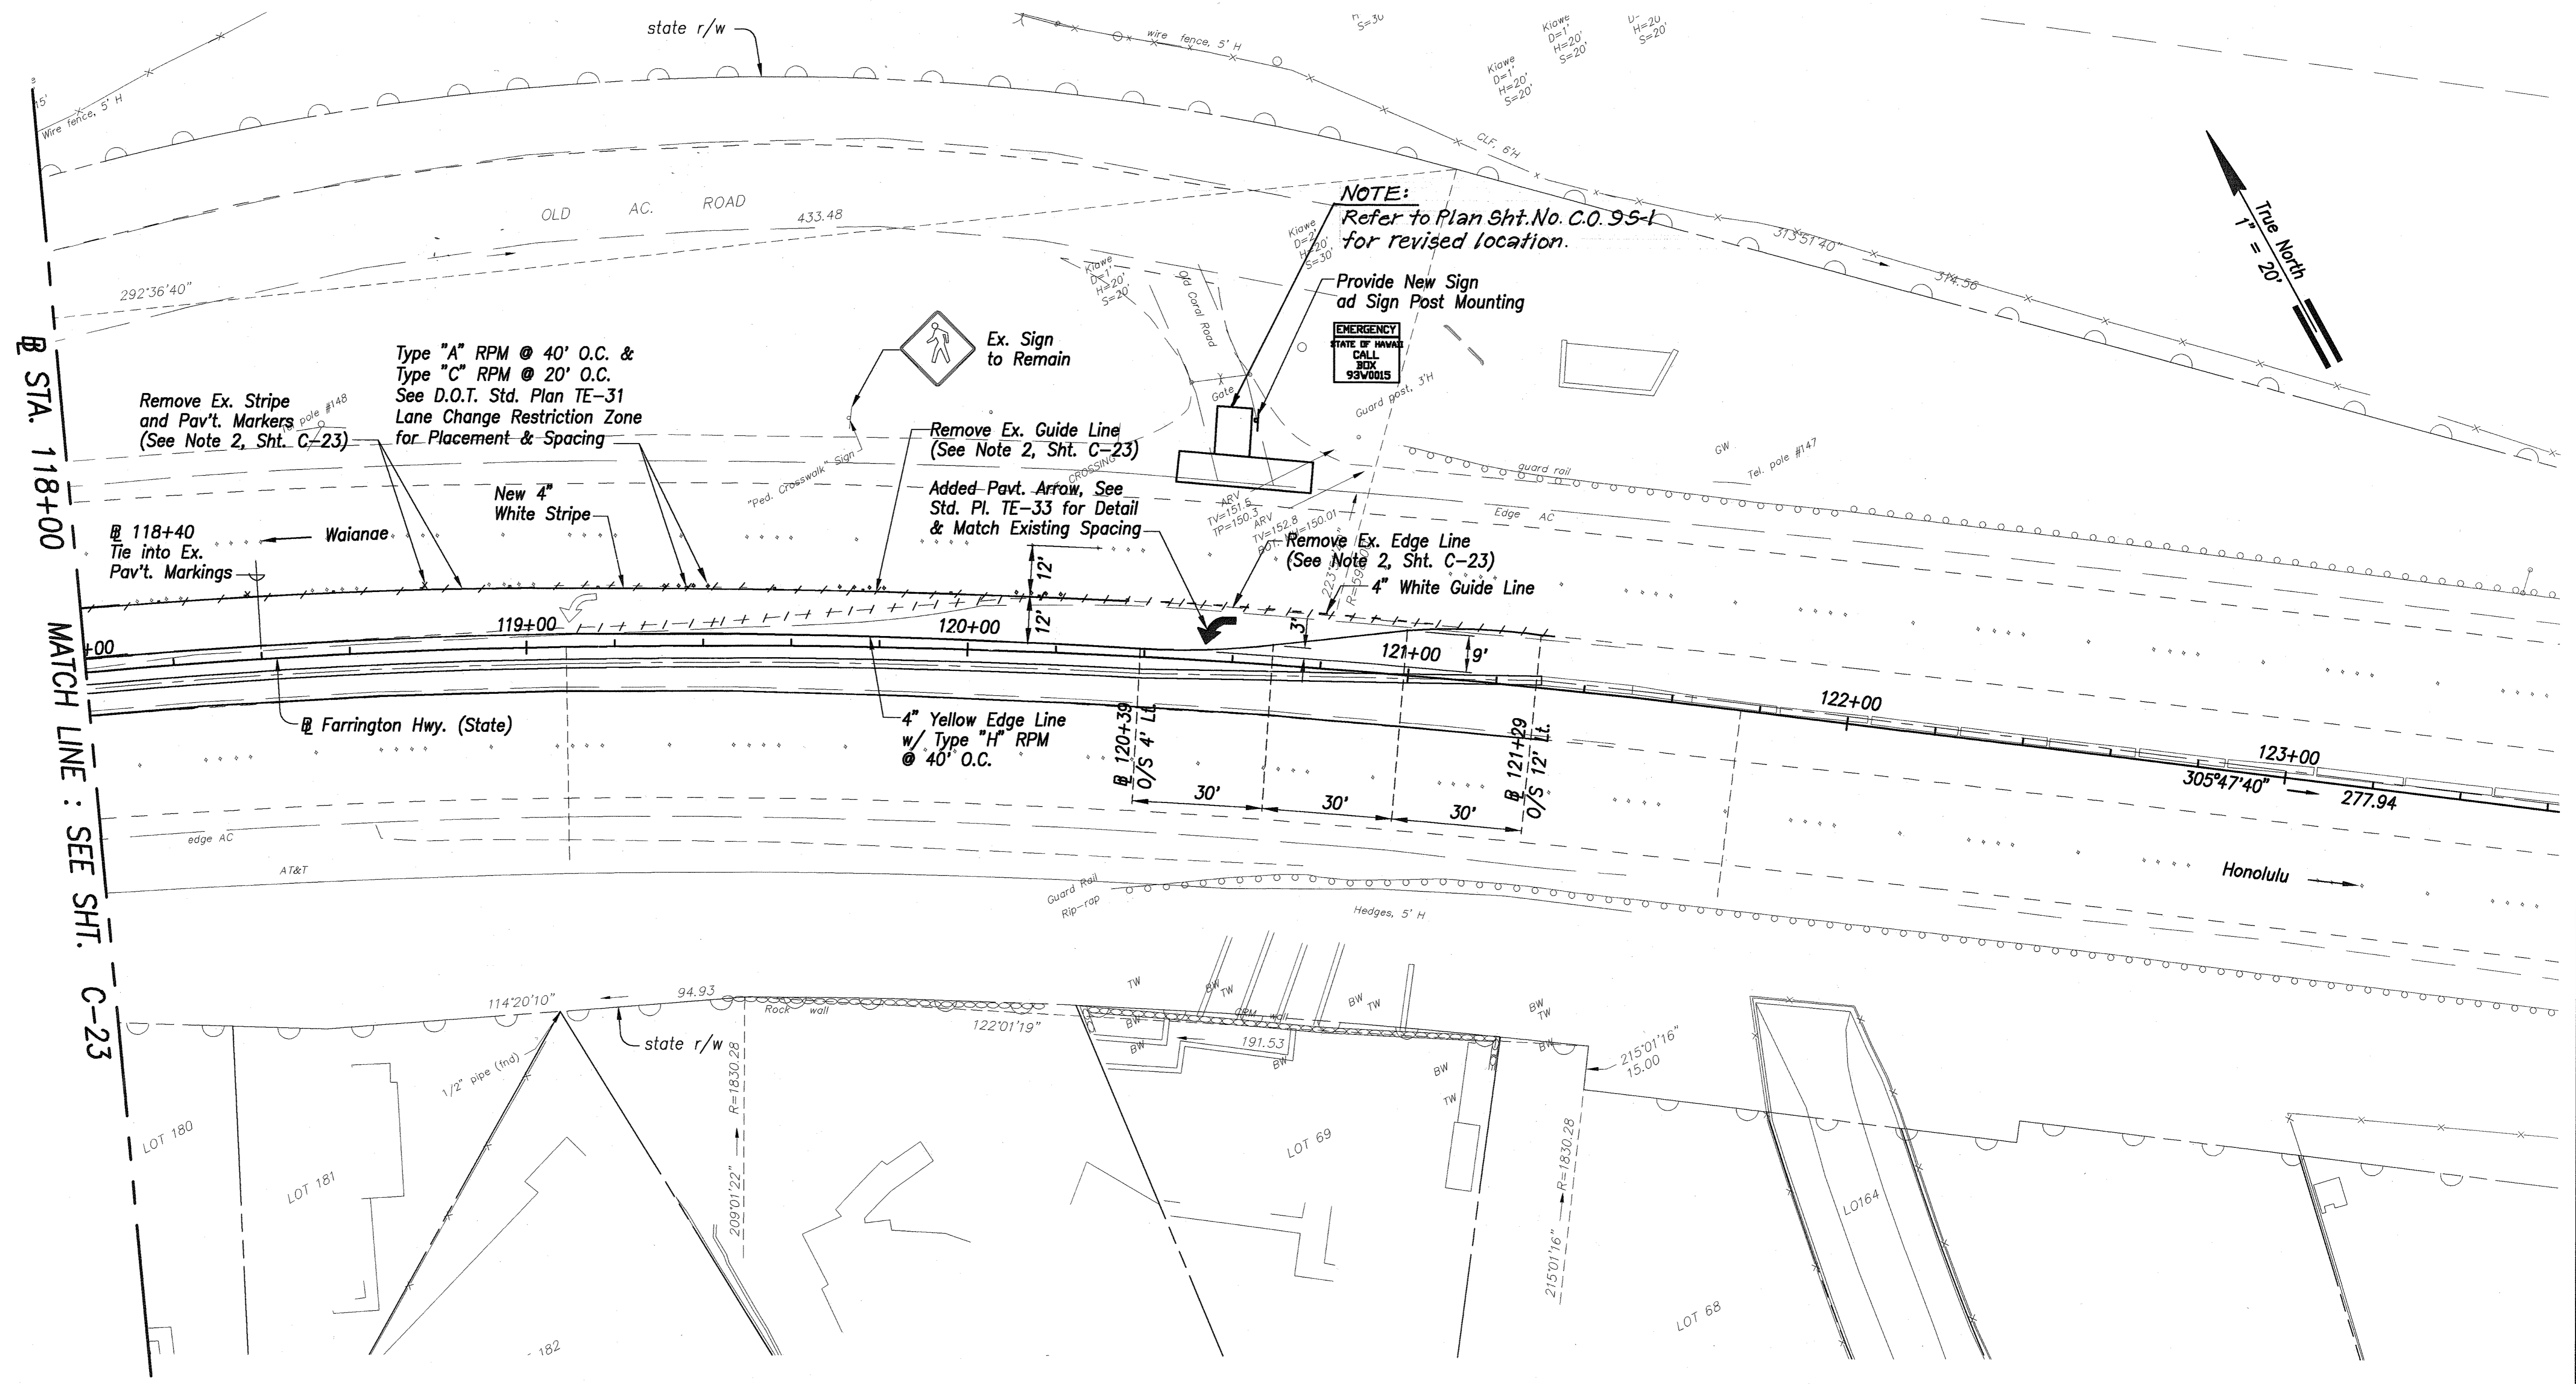

NOTE:
Refer to Plan Sht. No. C.O. 95-1 for revised location.

Provide New Sign and Sign Post Mounting

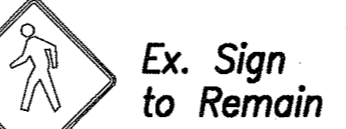

Ex. Sign to Remain

Remove Ex. Guide Line (See Note 2, Sht. C-23)

Added Pavt. Arrow, See Std. Pl. TE-33 for Detail & Match Existing Spacing

Remove Ex. Edge Line (See Note 2, Sht. C-23)

4" White Guide Line

4" Yellow Edge Line w/ Type "H" RPM @ 40' O.C.


Type "A" RPM @ 40' O.C. & Type "C" RPM @ 20' O.C. See D.O.T. Std. Plan TE-31 Lane Change Restriction Zone for Placement & Spacing

Remove Ex. Stripe and Pav't. Markers (See Note 2, Sht. C-23)

STA. 118+00

MATCH LINE: SEE SHT. C-23

SURVEY PLOTTED BY	DATE
DRAWN BY	
TRACED BY	
DESIGNED BY	
CHECKED BY	
ORIGINAL PLAN	
NOTE BOOK	
No.	

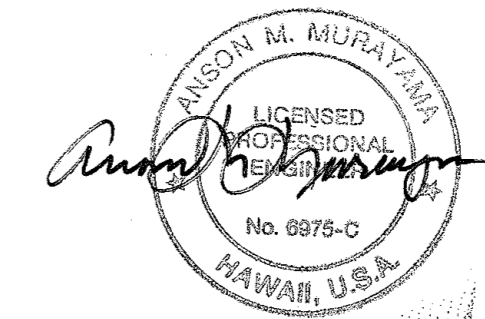

STATE OF HAWAII
DEPARTMENT OF TRANSPORTATION
HIGHWAYS DIVISION

SIGNING AND STRIPING PLAN


FARRINGTON HIGHWAY
Intersection Improvements at Waiomea Street
Project No. 93A-06-98

Scale: 1" = 20' Date: August 2000

SHEET No. C-24 OF 29 SHEETS

"AS-BUILT"


FED. ROAD DIST. NO.	STATE	FED. AID PROJ. NO.	FISCAL YEAR	SHEET NO.	TOTAL SHEETS
HAWAII	HAW.	93A-06-98	2001	31	66

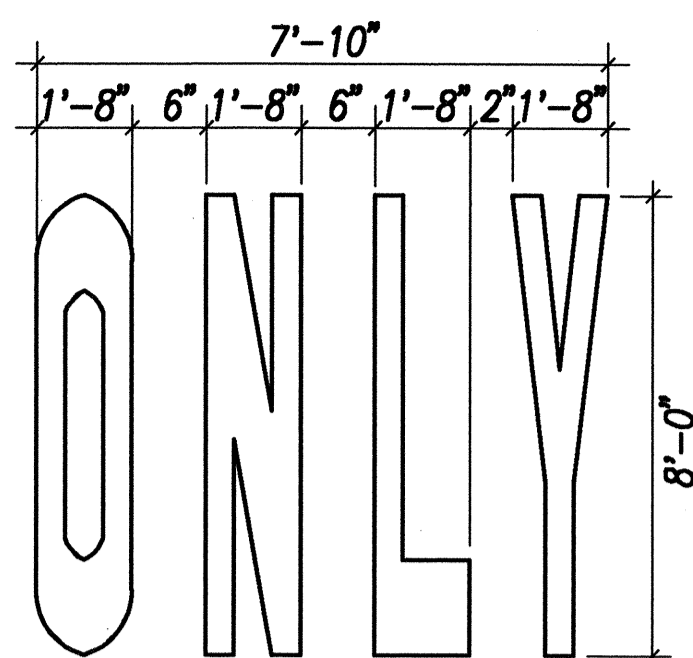


Note
When this marking is used, it shall be painted in each lane of traffic approaching the intersection

STANDARD DETAIL OF THE WORD "ONLY" - 8'-0" SIZE
Not to Scale


Broken White Lane Line

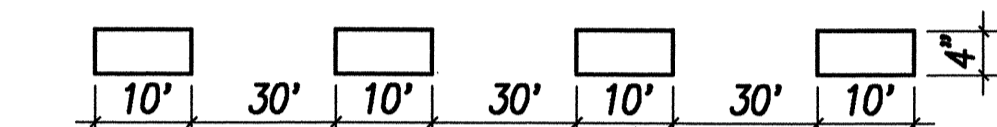


Solid White Edge Line or Lane Line

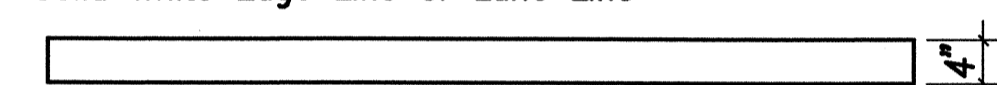


Solid White Channelizing Line

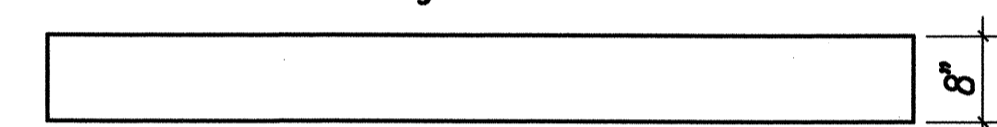


Guide Line (White or Yellow)

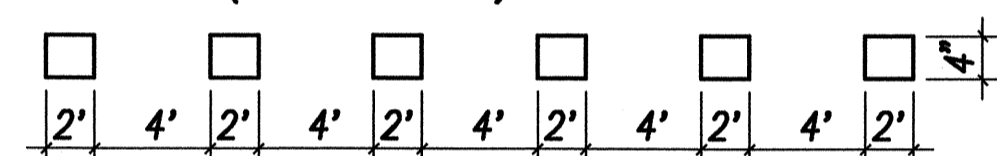


Bike Lane Guide Line (White)

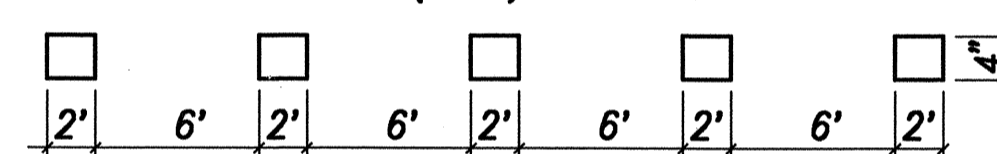


Yellow Edge Line

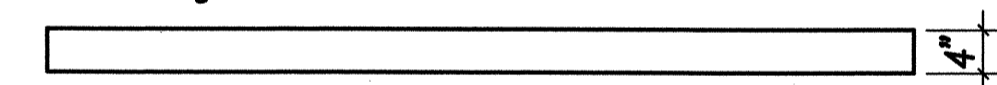


Double Solid (White or Yellow)

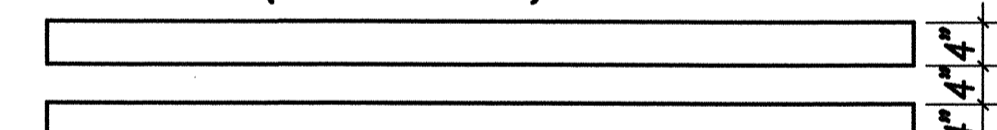


TYPES OF LONGITUDINAL LINES
Not to Scale

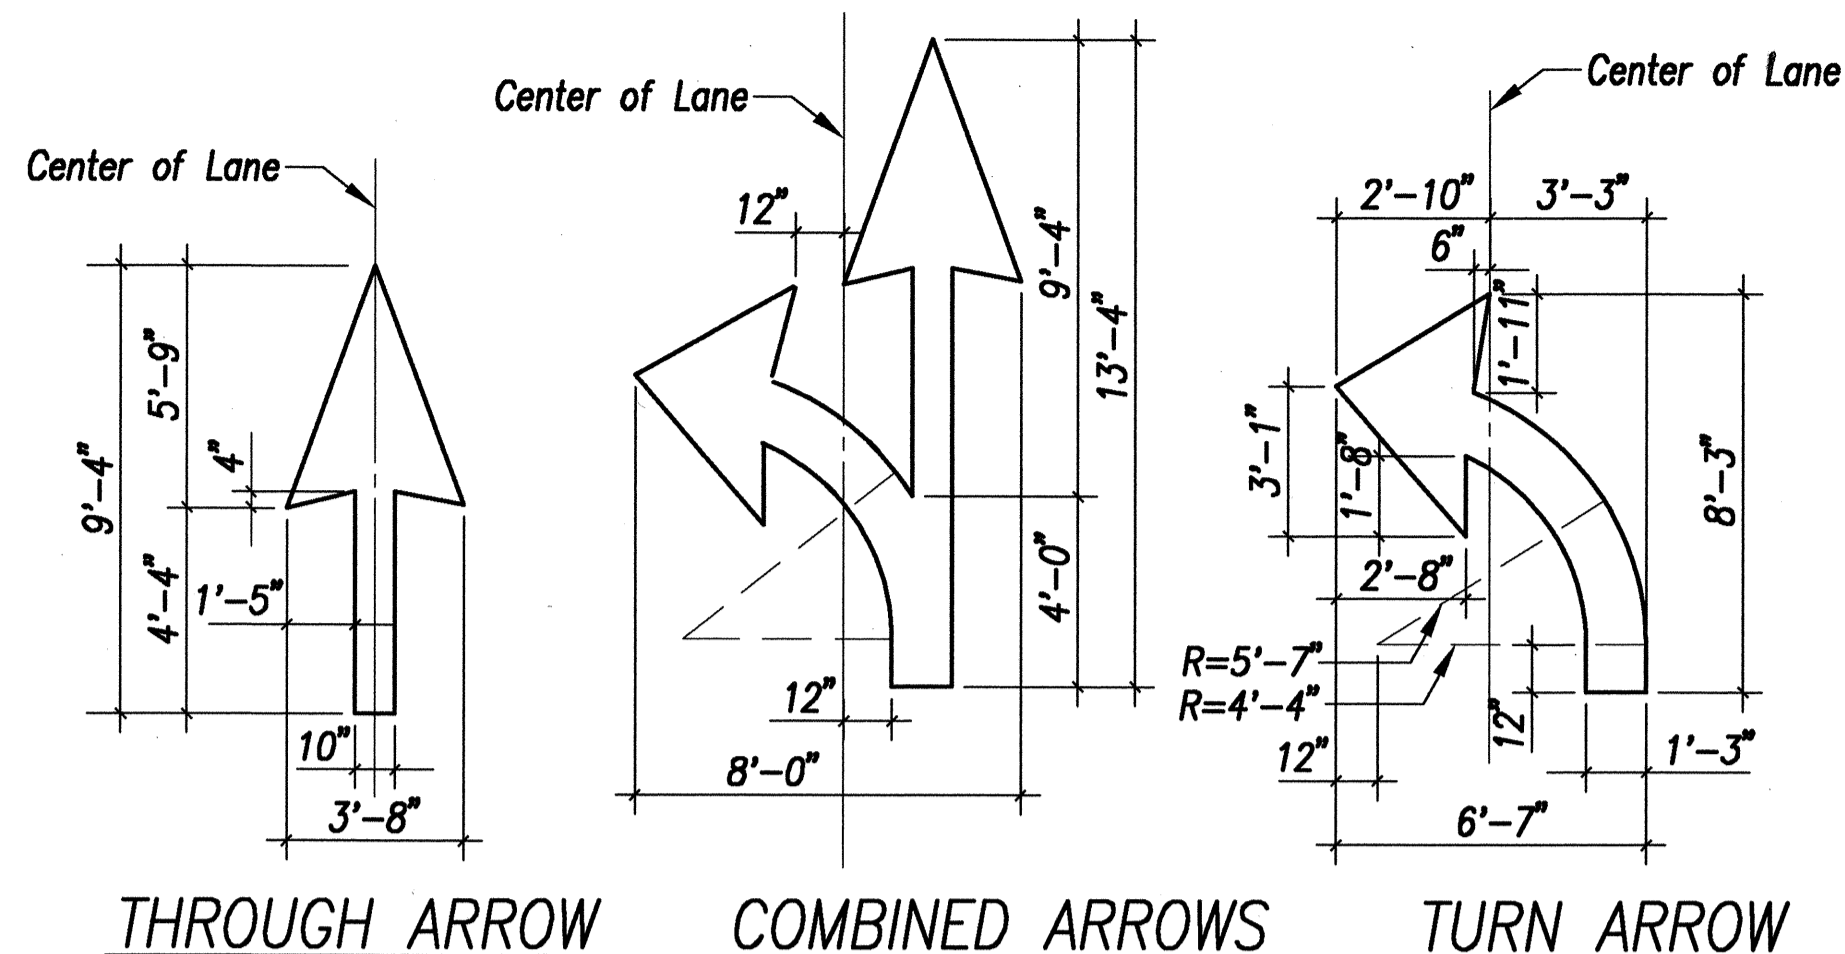

STANDARD PAVEMENT MARKINGS
Not to Scale

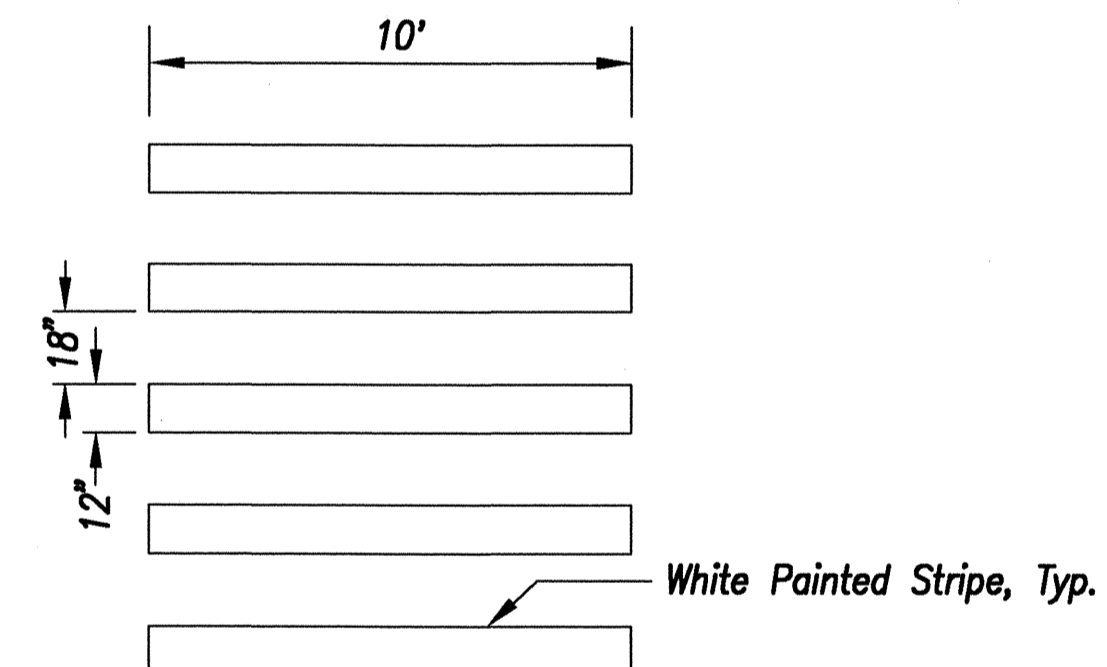


TYPICAL CROSSWALK
Scale: 1" = 4'

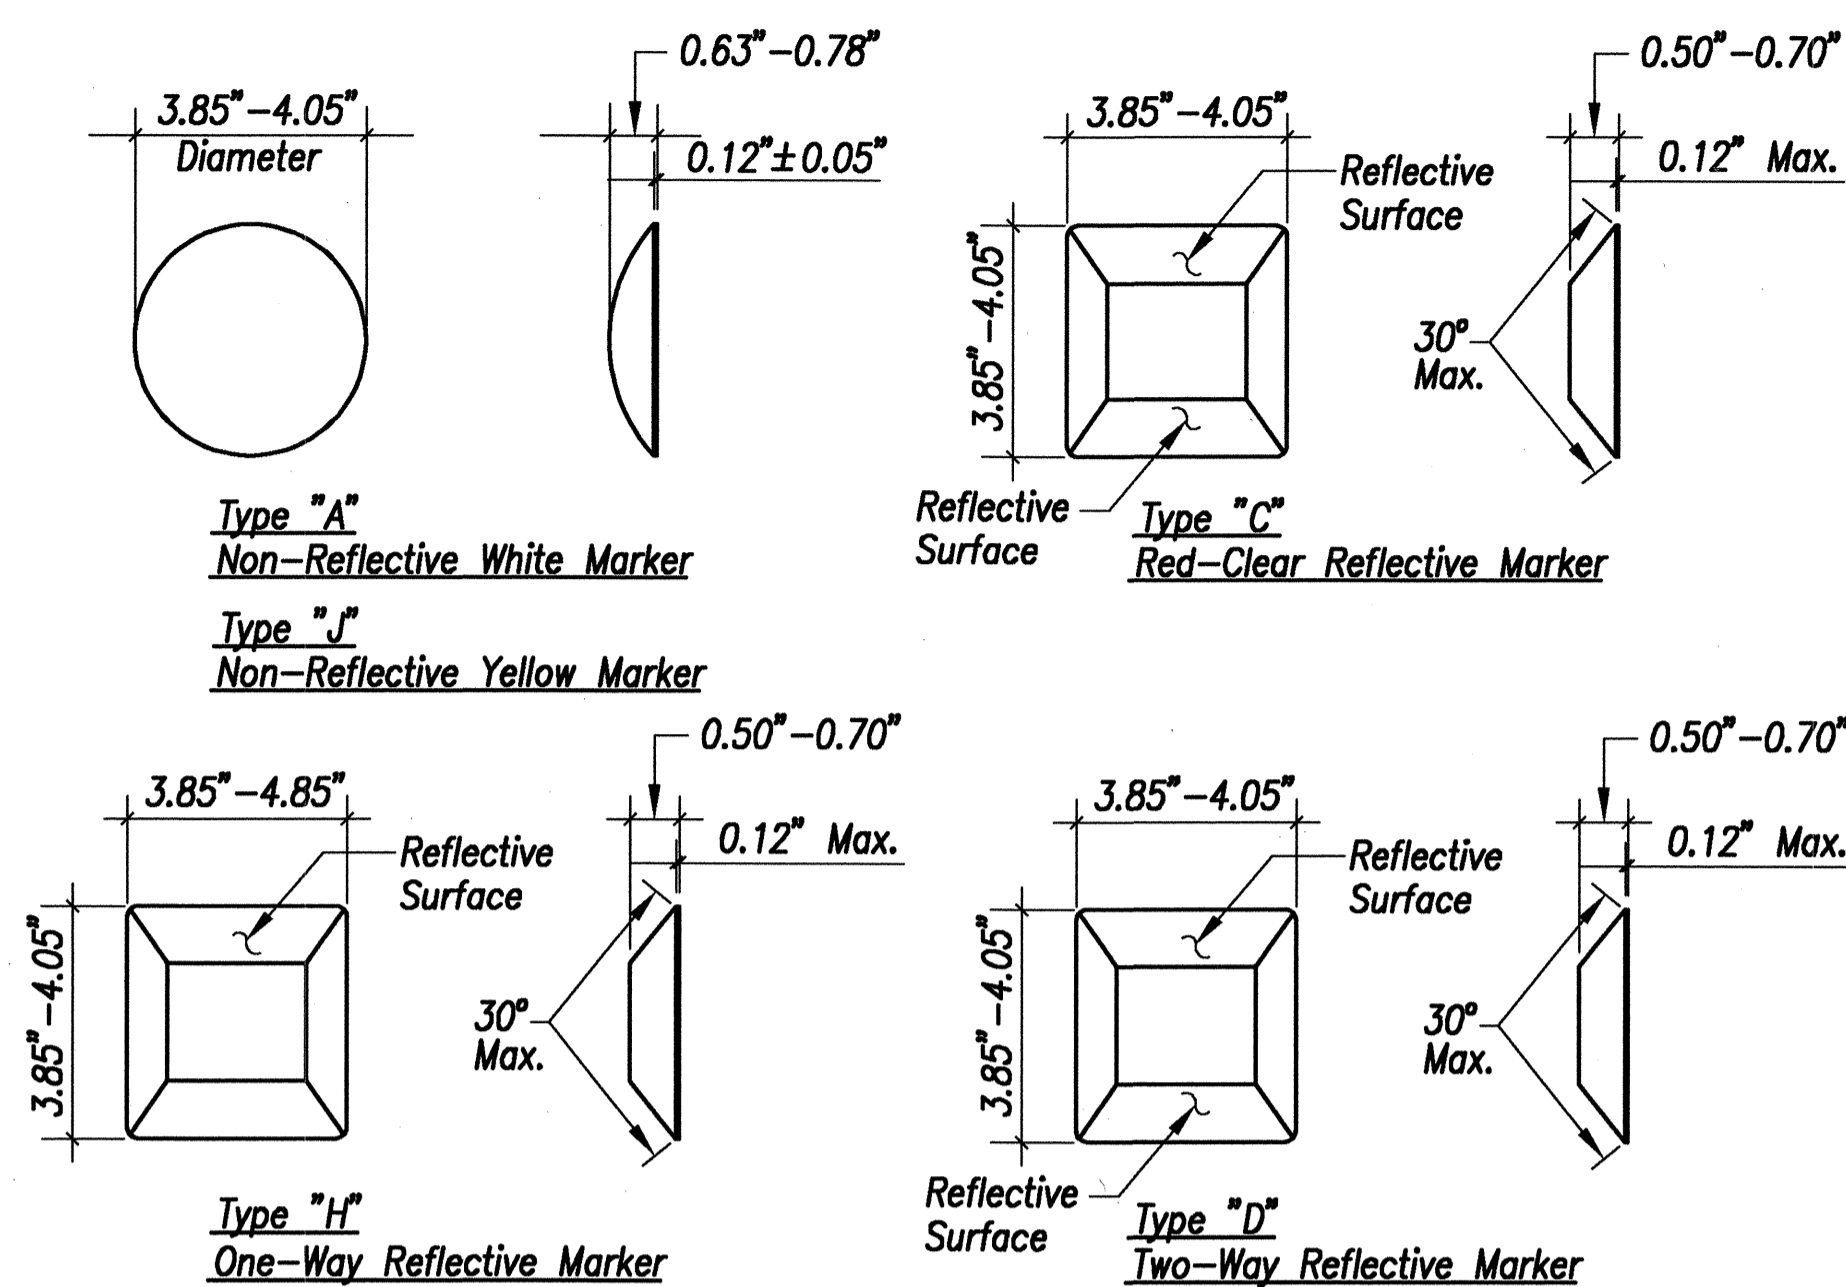


STANDARD RAISED PAVEMENT MARKERS
Not to Scale

Note: See Standard Plan TE-01 to TE-03 for Miscellaneous Sign Details and Sign Post Mounting Details.

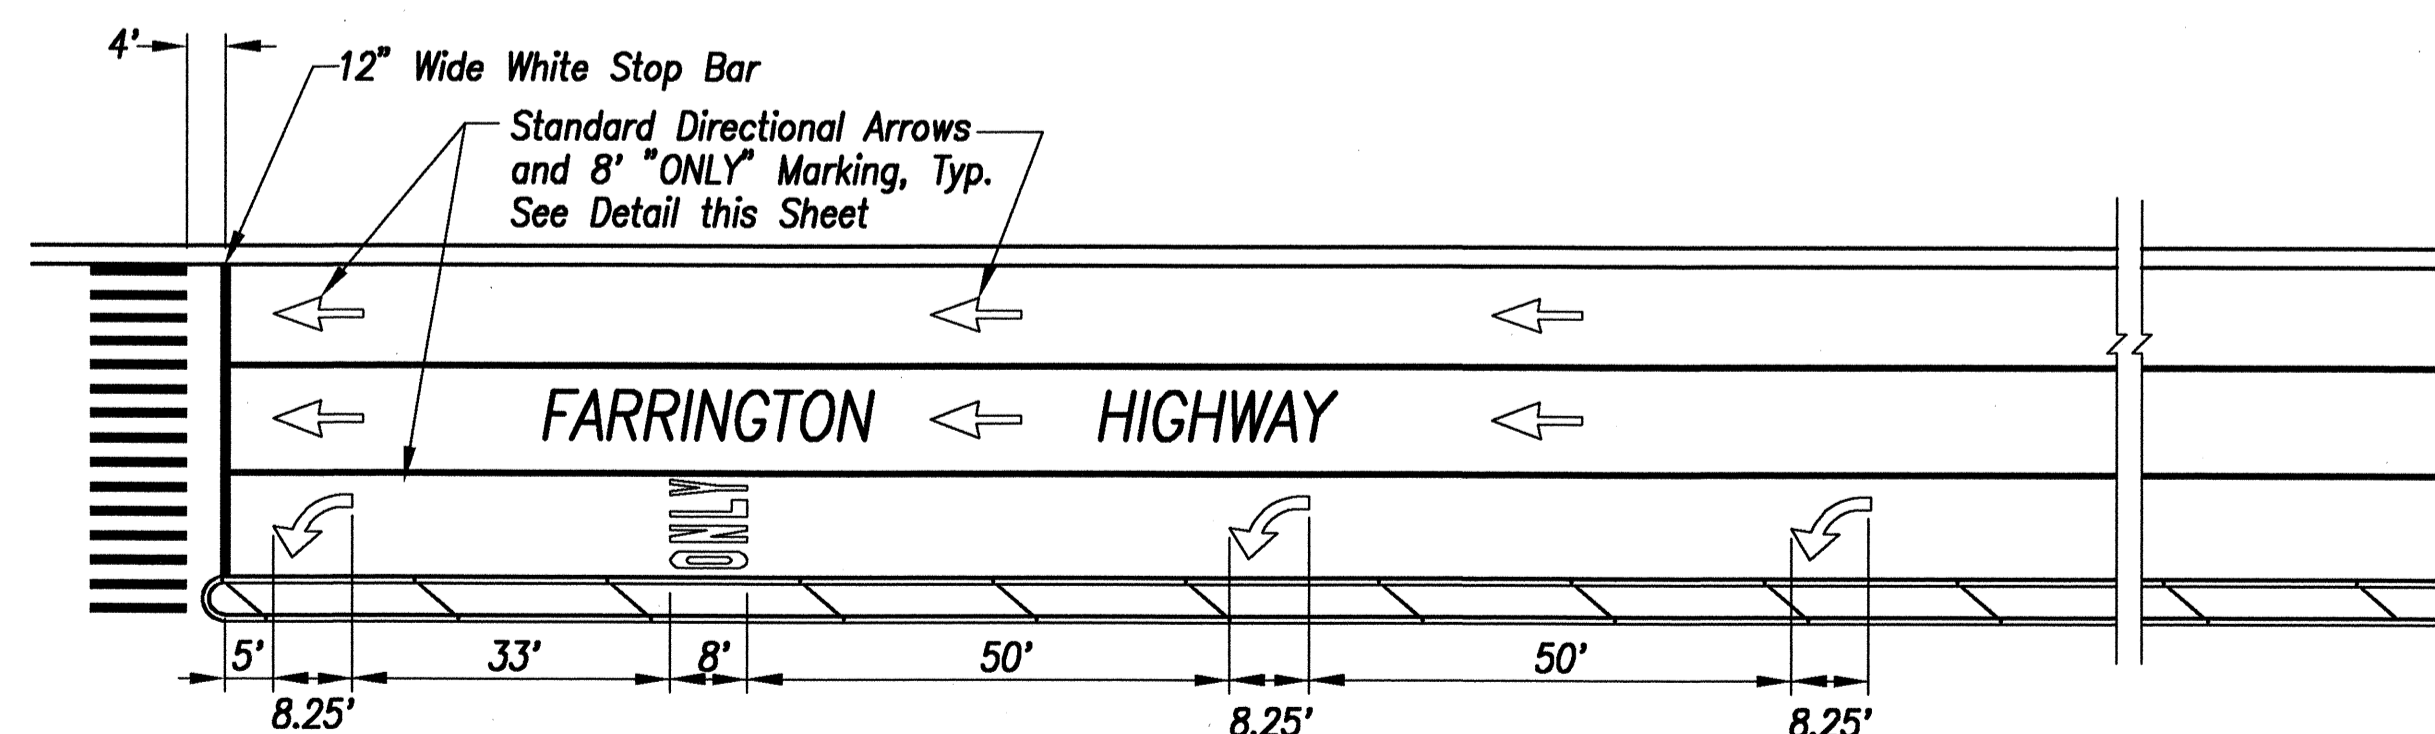

TYPICAL PLACEMENT OF DIRECTIONAL ARROWS & "ONLY"
Not to Scale

SURVEY PLOTTED BY	DATE
DRAWN BY	
TRACED BY	
NOTED BY	
QUANTITIES BY	
CHECKED BY	
ORIGINAL PLAN	
NOTE BOOK	
No.	

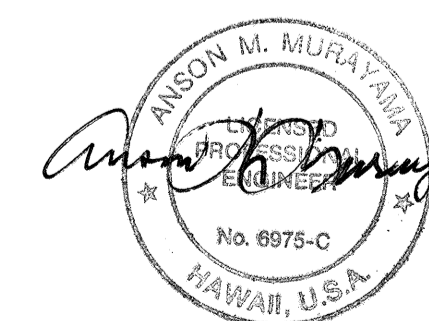

STATE OF HAWAII
DEPARTMENT OF TRANSPORTATION
HIGHWAYS DIVISION

SIGNING & STRIPING DETAILS

FARRINGTON HIGHWAY
Intersection Improvements at Waiomea Street
Project No. 93A-06-98

Scale: As Shown Date: August 2000

SHEET No. C-25 OF 29 SHEETS