


FED. ROAD DIST. NO.	STATE	PROJ. NO.	FISCAL YEAR	SHEET NO.	TOTAL SHEETS
HAWAII	HAW.	93A-06-98	2001	39	68





ORIGINAL PLAN	DATE
NOTED BY	
DESIGNED BY	
CHECKED BY	
DATE	

LAST SAVE: 08/09/00 @ 07:14:20 BY: TE PLOT SC 1480
Z:\ACAD\PROJECTS\93A\06\98\93A-06-98-39.DWG

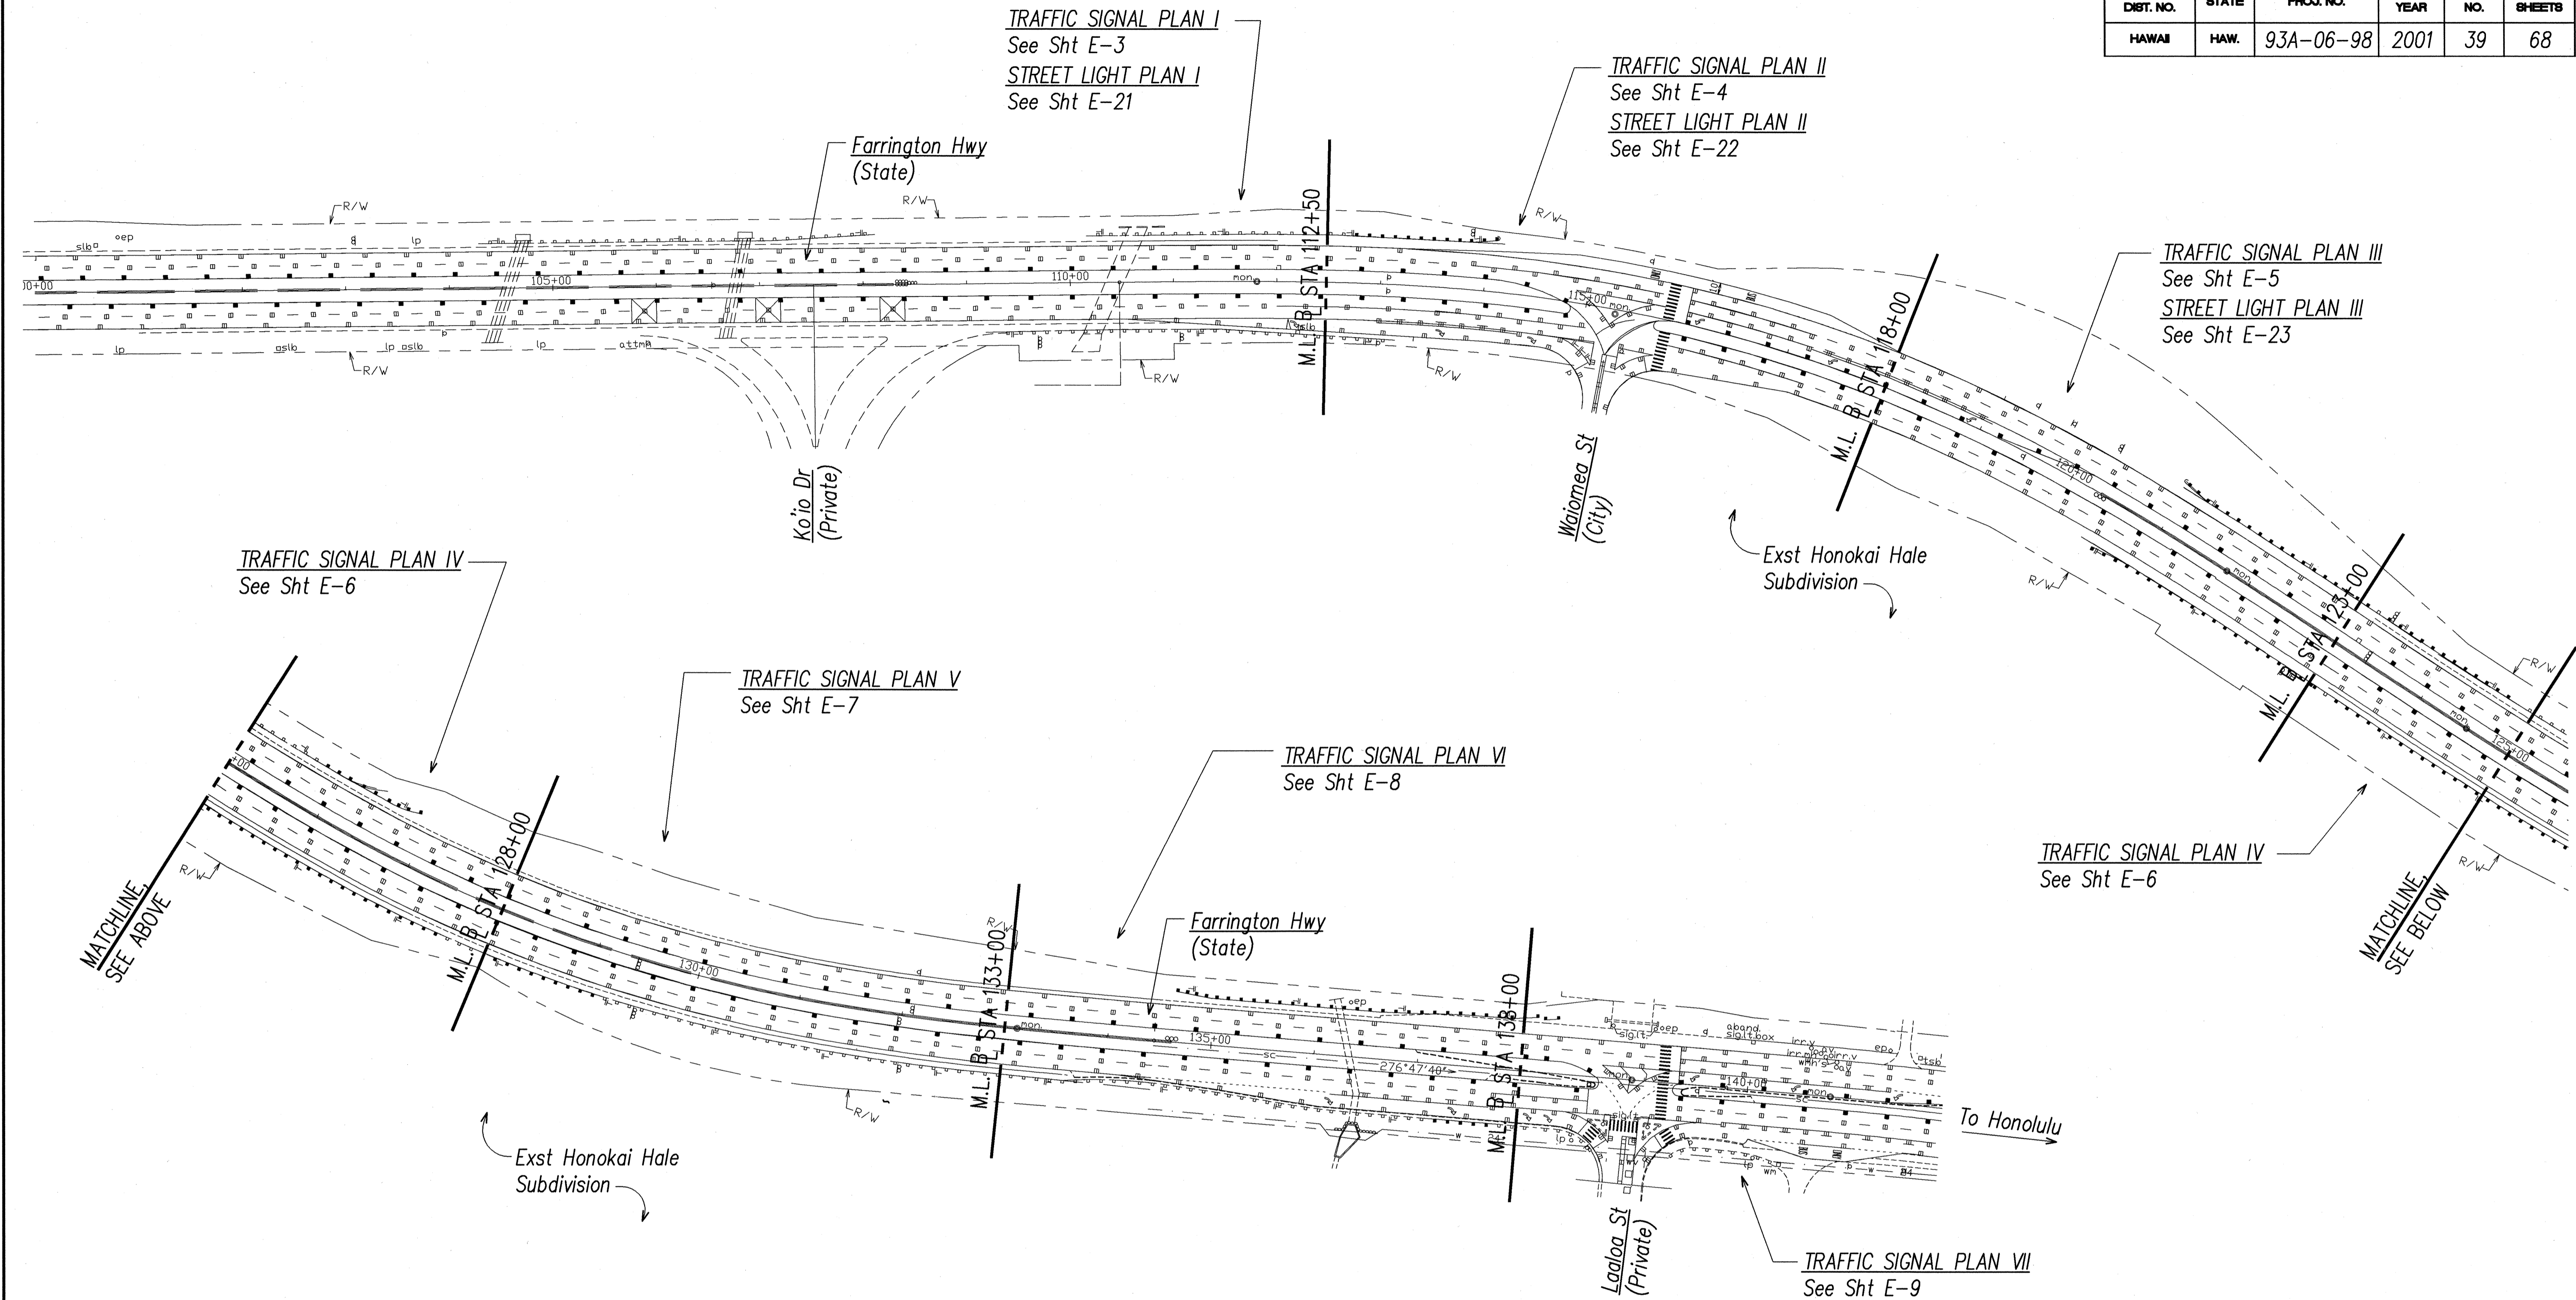

STREET LIGHT AND TRAFFIC SIGNAL SITE PLAN SCALE: 1" = 80'-0"

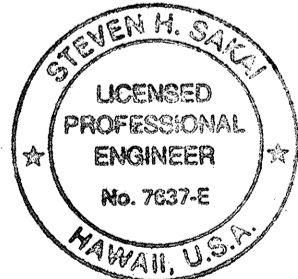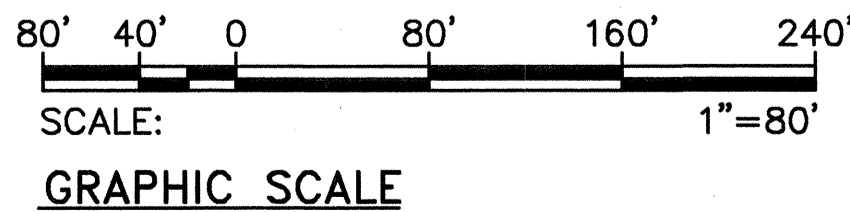

THIS WORK WAS PREPARED BY ME
OR UNDER MY SUPERVISION
Steven H. Saka

STATE OF HAWAII
DEPARTMENT OF TRANSPORTATION
HIGHWAYS DIVISION


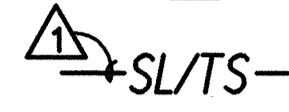
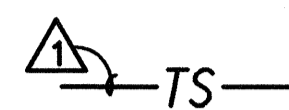
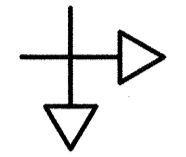

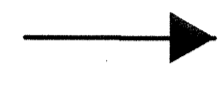
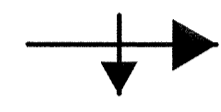
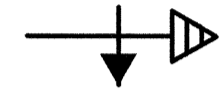
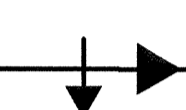
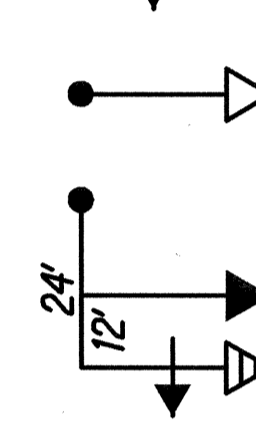
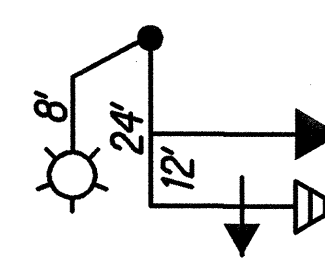
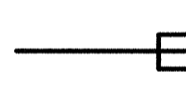






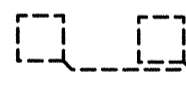
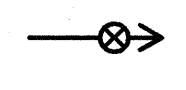
**STREET LIGHT AND TRAFFIC SIGNAL
SITE PLAN**
FARRINGTON HIGHWAY
Intersection Improvements at Waioimea Street
Project No. 93A-06-98
Scale: As Noted Date: AUGUST 2000
SHEET No. E-1 OF 30 SHEETS

TRAFFIC SIGNAL NOTES


FED. ROAD DIST. NO.	STATE	PROJ. NO.	FISCAL YEAR	SHEET NO.	TOTAL SHEETS
HAWAII	HAW.	93A-06-98	2001	40	68

1. The locations of the Traffic Signal Standards, Traffic Signal Standards w/Mast Arms, Pedestrian Push Buttons, Traffic Controller, Pullboxes, Conduits and Loop Detectors shall be staked out in the field by the Contractor and approval of the locations shall be obtained from the Engineer prior to construction and installation.
2. All splicing shall be done in the pullboxes.
3. Furnishing and installing the conduit stubouts (pullboxes to edge of pavement) will not be paid for separately but shall be considered incidental to the various contract items.
4. A solid #8 bare copper wire shall be pulled with the traffic signal control cable for equipment ground. Cost shall be incidental to the installation of the control cable.
5. All Traffic signal controller equipment shall be completely wired in the cabinet and shall control the traffic signals as called for in the plans.
6. The loop amplifier units furnished for this project shall be capable of operating the loop detector configurations shown on the plans. Cost for the loop amplifier shall be incidental to the installation of the loop detector.
7. Should any defect be encountered during the warranty period, the manufacturer will be notified and he shall promptly correct such defect. Service call (by factory qualified representative) during the warranty period for repairs or other maintenance shall be answered within 24 hours and shall be done at no expense to the State. All repairs shall be done as soon as possible.
8. All traffic signal work shall conform to the requirements of the "Manual On Uniform Traffic Control Devices For Streets And Highways", Federal Highway Administration (1988) and Amendments.
9. Locations of pavement markings and markers (lane lines, Stop lines, crosswalk, etc.) shown on the plans shall be verified with the Engineer prior to the installation of the traffic signal system.
10. The Contractor shall notify the Traffic Control Branch, Department of Transportation Services, City & County of Honolulu, (phone no. 523-4589) two weeks prior to commencing any work on the traffic signal system.
11. The Department of Transportation Services, City & County of Honolulu, will assist the Engineer in construction inspection for the traffic signal system. The Contractor shall notify the Traffic Control Branch, Department of Transportation Services, three (3) working days prior to commencing work on the traffic signal system (phone no. 523-4589).
12. Connecting into existing traffic signal system and making all necessary adjustments shall not be paid for separately, but considered incidental to the various traffic signal contract items.
13. All conduits between pullboxes and Traffic Signal Standards shall not be paid for separately but considered incidental to the various contract items.
14. All Signal-Drop Cables (Type 5 cable) from the various types traffic signal head on the traffic signal standards and mast arms to the pullboxes shall not be paid for separately but considered incidental to the traffic signal head.
15. After installing the cables in the conduits, the Contractor shall duct seal all conduits in the controller cabinet, pullboxes and standards with an Engineer approved product. The cost for duct sealing the conduits shall not be paid for separately but considered incidental to the various contract items.

TRAFFIC SIGNAL LEGEND

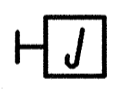-  New Traffic Signal Master & Local Controller
-  New Street Light & Traffic Signal Conduits & Cables
-  New Traffic Signal Conduits & Cables
-  New 12" <<< Traffic Signal Head
-  New 12" RYG Traffic Signal Head
-  New 12" RY< Traffic Signal Head
-  New 12" RY< Traffic Signal Head (Programmed Visibility)
-  New 12" RYG < Fiber Optic Traffic Signal Head
-  New Type I Traffic Signal Standard w/Traffic Signal Head as specified on plan
-  New Type II Traffic Signal Standard w/Mast Arm and Traffic Signal Heads (length of mast arm & distance between signal heads as specified on plan)
-  New Type III Traffic Signal Standard w/mast arm, Highway Lighting Arm and Traffic Signal Heads. (Length of traffic signal and highway lighting arm & distance between signal heads as specified on plans)
-  New Pedestrian Signal Head
-  New Type A (Old Type B) Pullbox
-  New Type B (Old Type C) Pullbox
-  New Type C (Old Type D) Pullbox
-  New Concrete Stub-out Marker, See Det A/E-24
-  New Stainless Steel J-box, WP, See Plan for Size
-  New Loop Detectors
-  Existing Loop Detectors
-  New Opticom Receiver

ORIGINAL PLAN	SURVEY PLOTTED BY	DATE
NOTE BOOK	DRAWN BY	
QUANTITIES BY	TRACED BY	
CHECKED BY	NOTED BY	
	DATE	

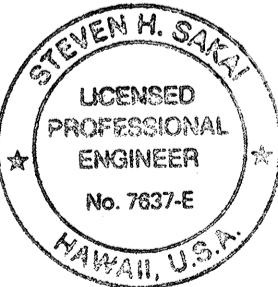

THIS WORK WAS PREPARED BY ME OR UNDER MY SUPERVISION
Steven H. Saka

STATE OF HAWAII
DEPARTMENT OF TRANSPORTATION
HIGHWAYS DIVISION

TRAFFIC SIGNAL LEGEND

FARRINGTON HIGHWAY
Intersection Improvements at Waiomea Street
Project No. 93A-06-98
Scale: None Date: AUGUST 2000

CONDUIT & WIRE SCHEDULE


[illegible]

See Typ Duct Section "C", Sht E-19 Unless
Indicated Otherwise

NOTES:

- 1 Sawcut Exst A.C. Pavement Prior to Trenching & Repaving. Repair to Match Exst. See Det A/E-19. Sawcutting & Repaving shall not be Paid for Separately, but shall be Considered Incidental to the Various Street Light & Traffic Signal Ductline Items.
- 2 Conduit Concealed in Concrete Barrier. Provide Expansion Couplings at Expansion Joints.

FED. ROAD DIST. NO.	STATE	PROJ. NO.	FISCAL YEAR	SHEET NO.	TOTAL SHEETS
HAWAII	HAW.	93A-06-98	2001	41	68


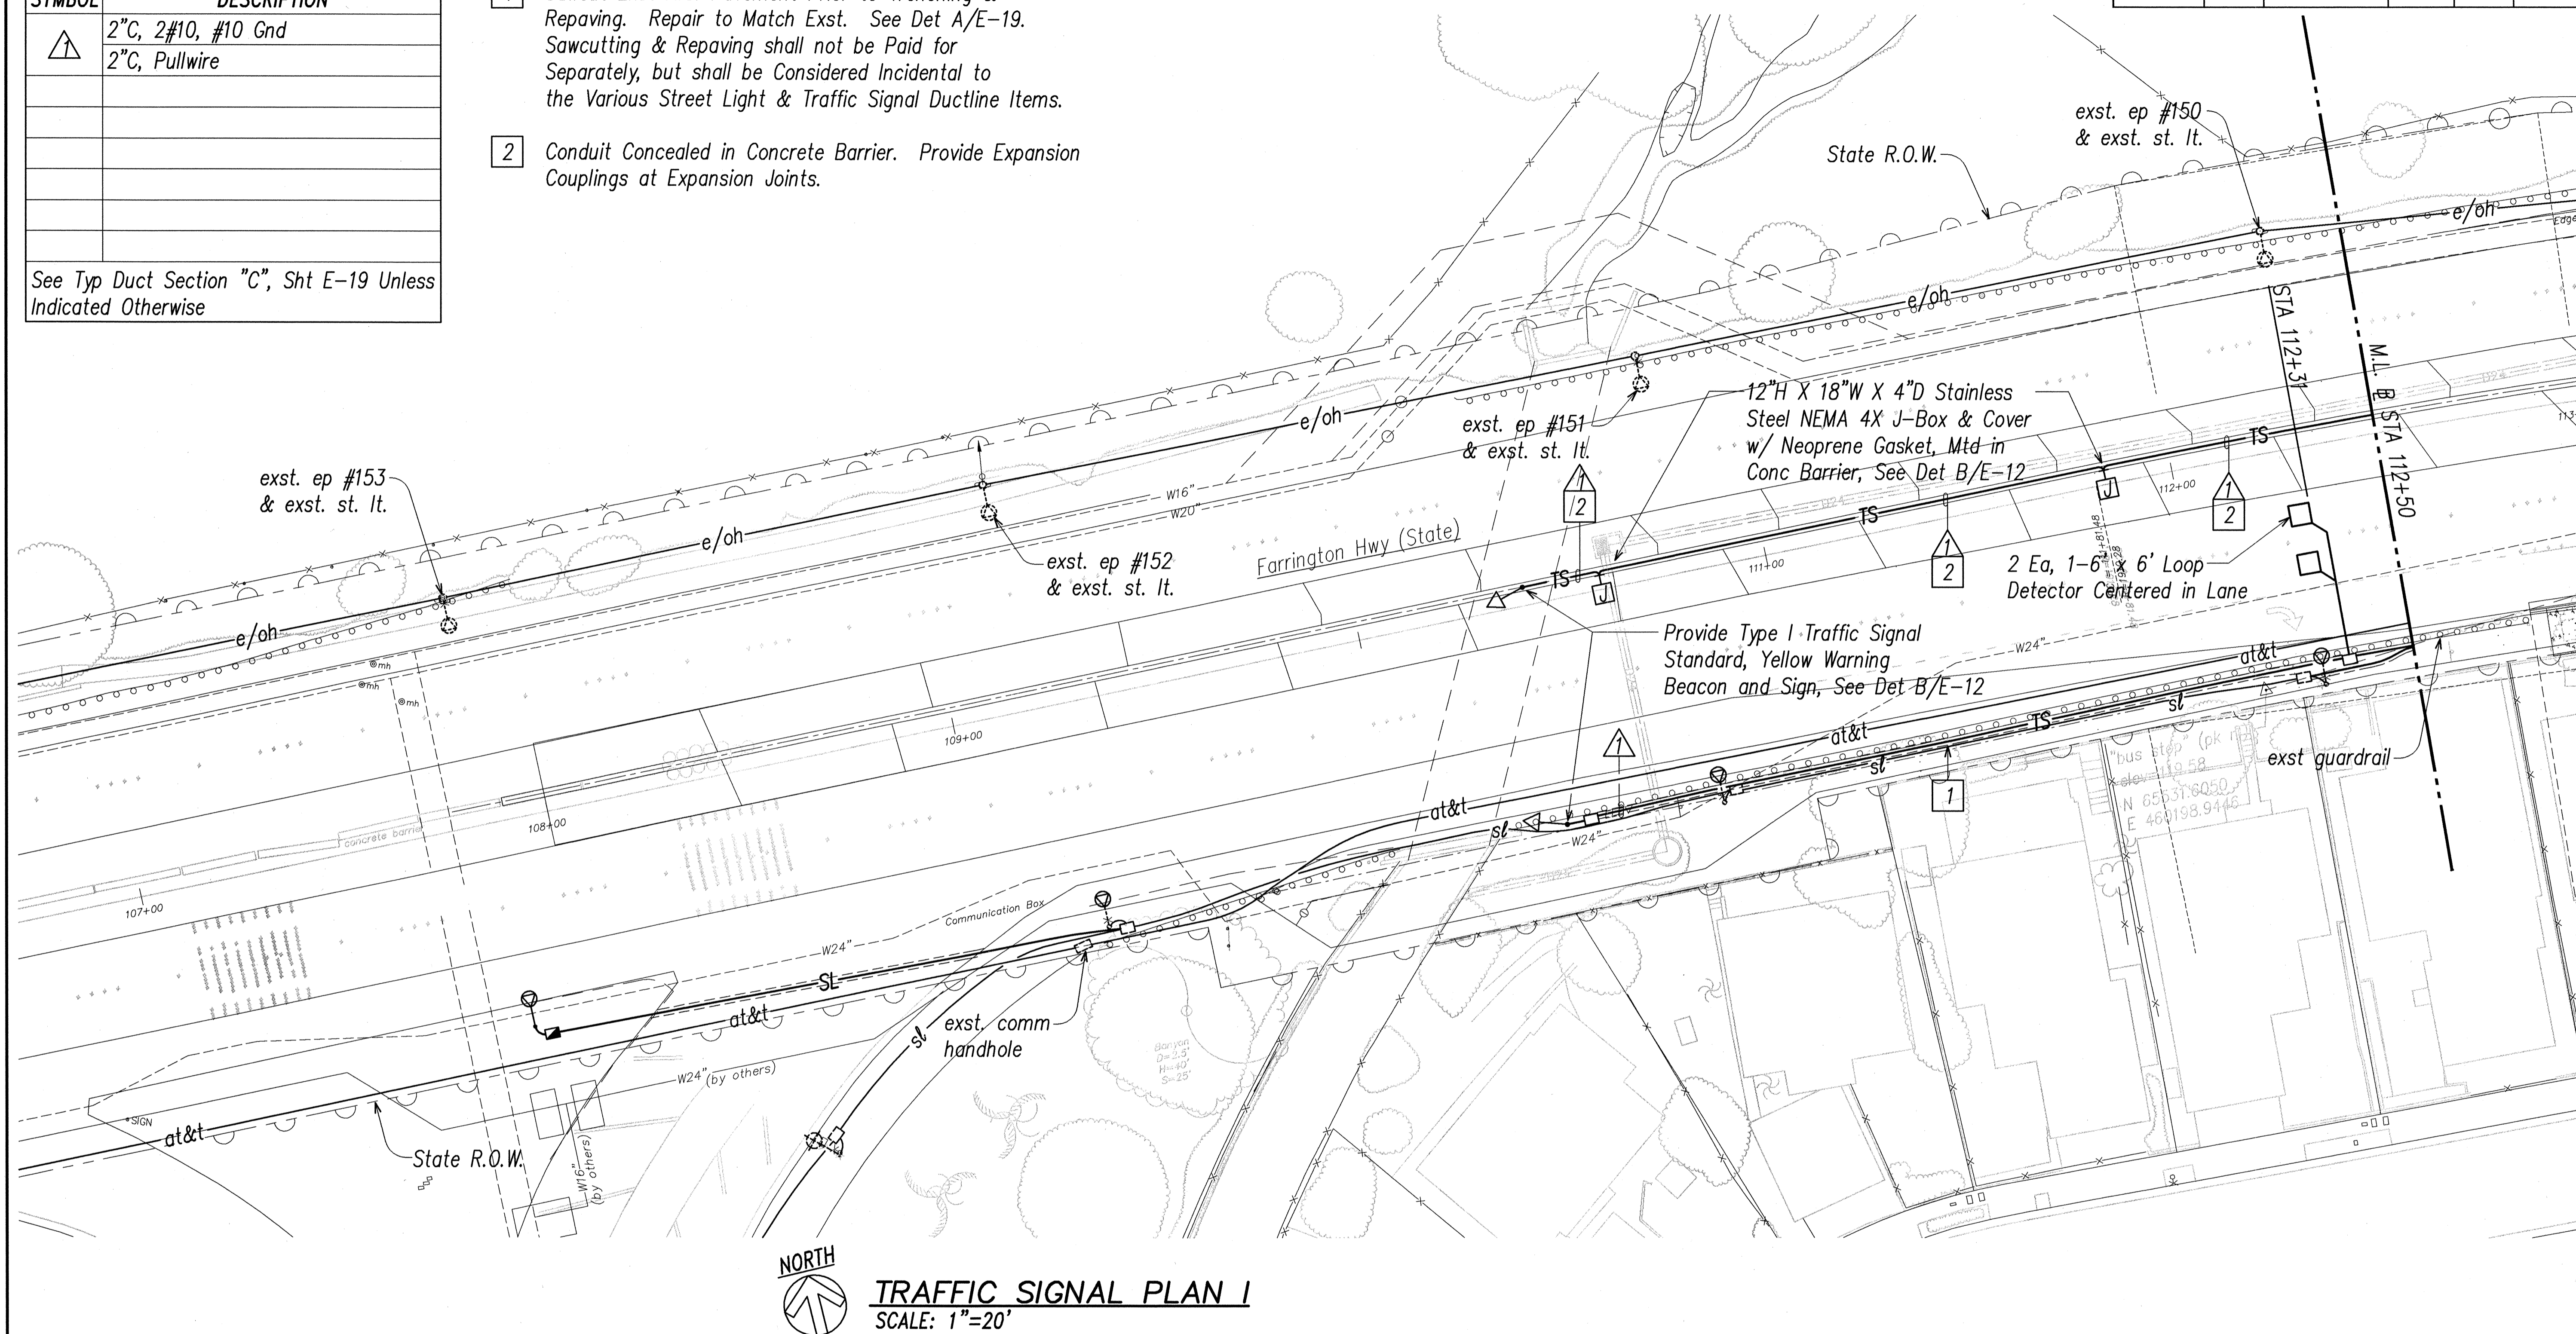


ORIGINAL PLAN	SURVEY PLOTTED BY _____ DATE _____
NOTE BOOK	DRAWN BY _____
	TRACED BY _____
	DESIGNED BY _____
	QUANTITIES BY _____
No. _____	CHECKED BY _____

LAST SAVE: 08/09/00 @ 07:15:10 BY: TE PLOT SC 1=20
Z: \ACAD\PROJECTS\98004\ROAD1 XREFS: WAIBASE TOPO

APPROVED:

Catharine Drungca 3/20/01
for CHIEF, PLANNING & ENGINEERING, BWS MD DATE

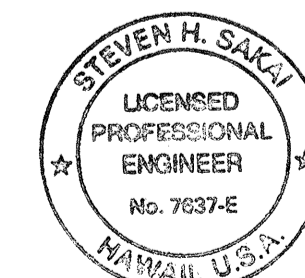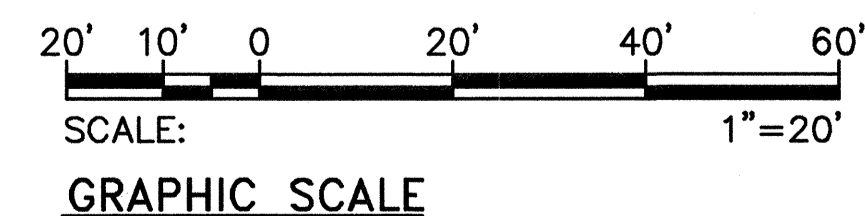

THIS WORK WAS PREPARED BY ME
OR UNDER MY SUPERVISION.
Steven F. Haba

STATE OF HAWAII
DEPARTMENT OF TRANSPORTATION
HIGHWAYS DIVISION


TRAFFIC SIGNAL PLAN 1

FARRINGTON HIGHWAY
Intersection Improvements at Waiomea Street
Project No. 93A-06-98

Scale: AS NOTED Date: AUGUST 2000

SHEET No. E-3 OF 30 SHEETS

FED. ROAD DIST. NO.	STATE	PROJ. NO.	FISCAL YEAR	SHEET NO.	TOTAL SHEETS
HAWAII	HAW.	93A-06-98	2001	42	68

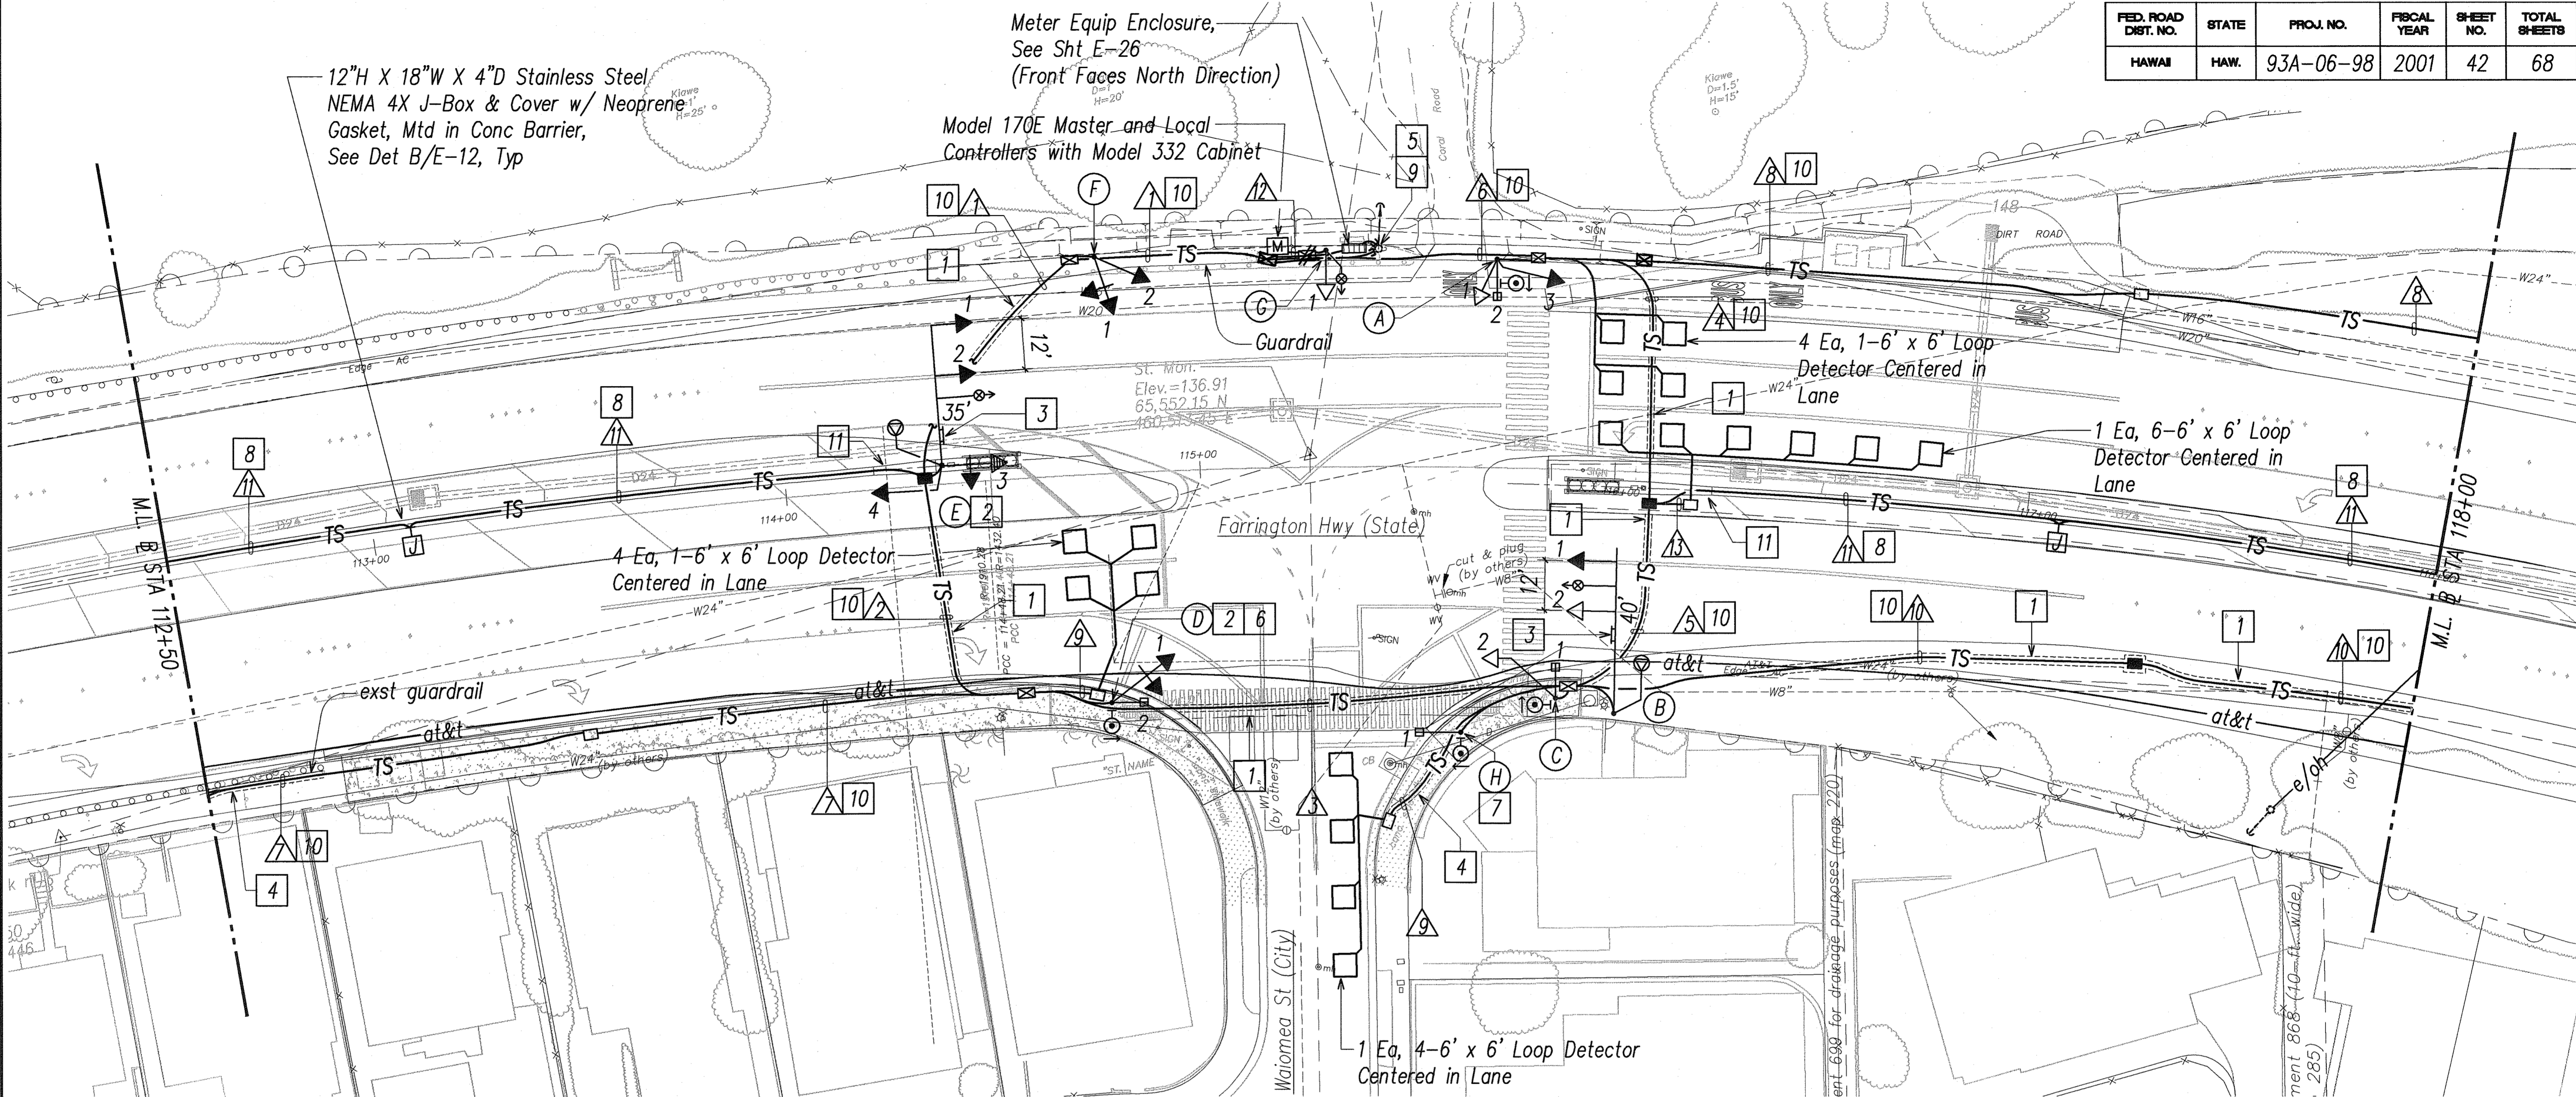

NOTES:

- 1 Sawcut Exst A.C. Pavement Prior to Trenching & Repaving. Repair to Match Exst. See Det A/E-19. Sawcutting & Repaving Exst A.C. Pavement shall not be Paid for Separately, but shall be Considered Incidental to the Various Traffic Signal Ductline Items.
- 2 Provide "On Left Arrow Only No U Turn" R17-3 (30" x 48") Sign.
- 3 Provide Street Name Sign, See Sht No. 35.
- 4 Sawcut Exst Conc Sidewalk at Scoreline Prior to Trenching. Repair to Match Exst. See Det A/E-19. Sawcutting & Repaving Exst Conc Pavement shall not be Paid for Separately, but shall be Considered Incidental to the Various Traffic Signal Ductline Items.
- 5 Stub 2"C & 3"C Up Exst Pole +10'-0" for HECO Service; 2"C +1'-0" for Future HECO Service, See Det C/E-12.
- 6 13' Type I Std.
- 7 8' Type I Std.
- 8 Conduit Concealed in Concrete Barrier. Provide Expansion Couplings at Expansion Joints.
- 9 Prior to Trench & Excavation Near Exst Pole, Contractor shall Coordinate Temporary Pole Bracing with HECO, See HECO Note 6, Sht 5.
- 10 Route Traffic Signal Ductline w/ Street Light Ductline, See Sht E-22
- 11 Transition to Concrete Barrier, See Det B/E-24.




TRAFFIC SIGNAL PLAN II

SCALE: 1"=20'

APPROVED:
Catharine Drugea 3/20/01
 CHIEF, PLANNING & ENGINEERING, BNS
 DATE

20' 10' 0 20' 40' 60'
 SCALE: 1"=20'
 GRAPHIC SCALE

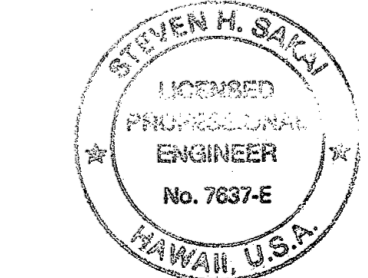

THIS WORK WAS PREPARED BY ME
 OR UNDER MY SUPERVISION
[Signature]

GENERAL NOTE:

1. See Sht E-10 for Phase Diagrams, Conduit & Wiring Schedule and Signal Head Legend; Sht E-14 for Ped Pushbutton Orientation.
2. Exst Overhead & Street Light System not Indicated for Clarity, See Sht E-22.


10/4/00	Del Street Name Sign Near TS Std "G"
DATE	REVISION
STATE OF HAWAII DEPARTMENT OF TRANSPORTATION HIGHWAYS DIVISION TRAFFIC SIGNAL PLAN II FARRINGTON HIGHWAY Intersection Improvements at Waimea Street Project No. 93A-06-98 Scale: As Noted Date: AUGUST 2000 SHEET No. E-4 OF 30 SHEETS	

SURVEY PLOTTED BY:	DATE:
DRAWN BY:	
DESIGNED BY:	
QUANTITIES BY:	
CHECKED BY:	
ORIGINAL PLAN	
NOTE BOOK	
No.	

LAST SAVE: 10/05/00 @ 15:52:27 BY: ON PLOT SC 14-20
 2:00 PM PROJECTS\9306A\9306A.DWG XREFS: WAIMEA.TXD

"AS-BUILT"

FED. ROAD DIST. NO.	STATE	PROJ. NO.	FISCAL YEAR	SHEET NO.	TOTAL SHEETS
HAWAII	HAW.	93A-06-98	2001	43	68

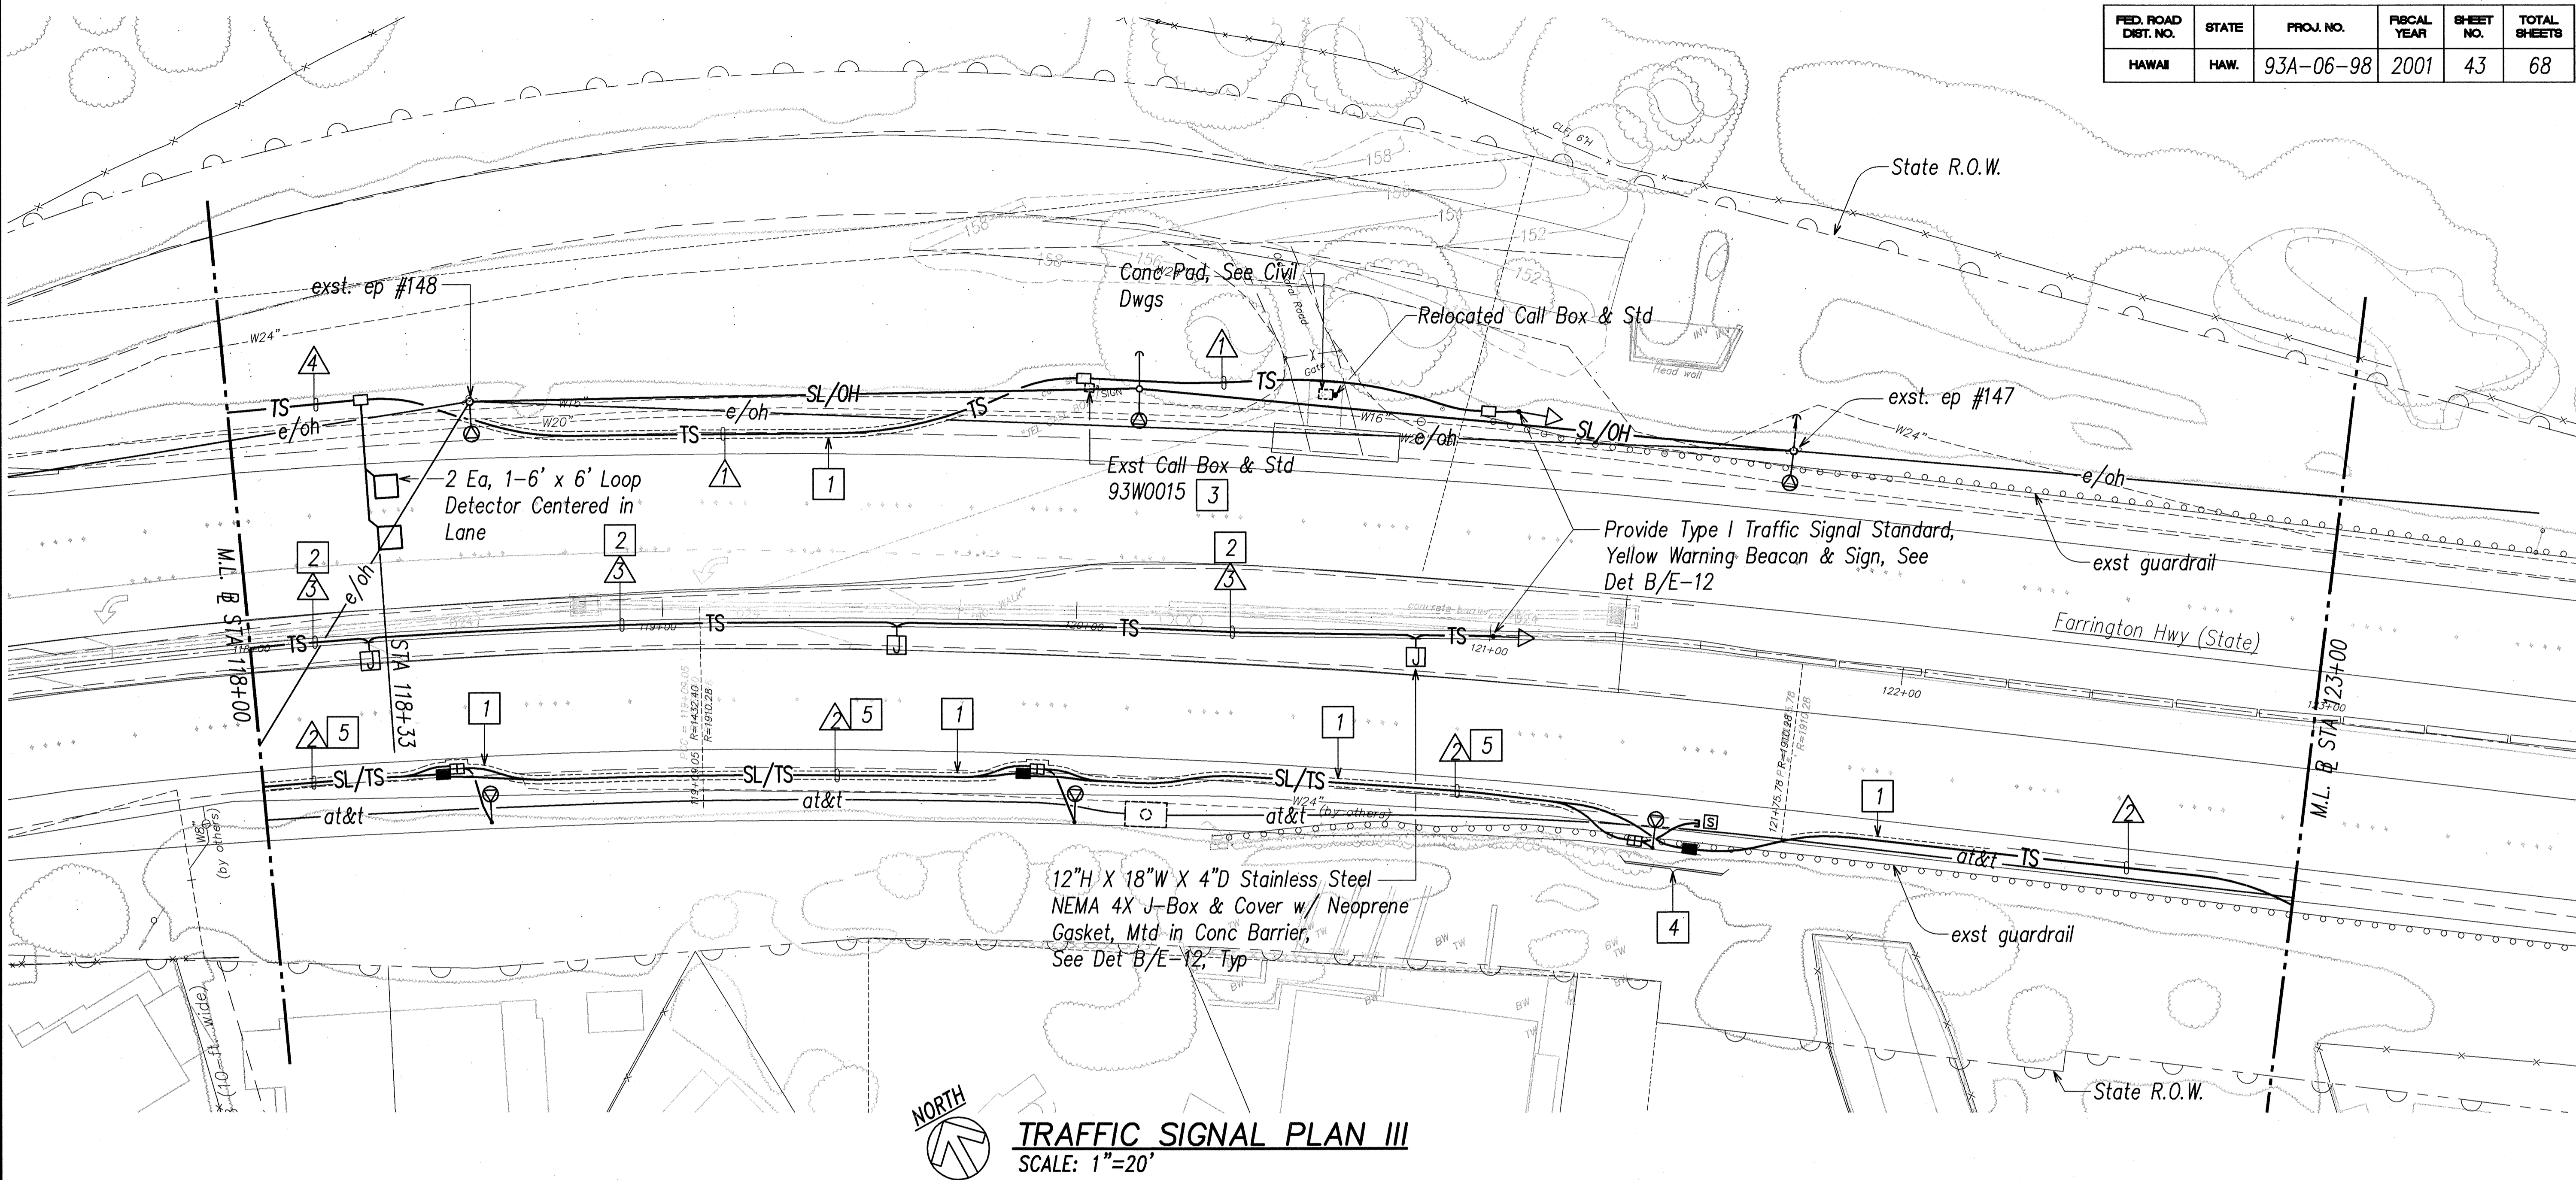

CONDUIT & WIRE SCHEDULE	
SYMBOL	DESCRIPTION
△1	2"C, 2#10, #10 Gnd
△2	2"C, Pullwire
△3	2"C, 1-12 Pair #19
△4	2"C, 2#10, #10 Gnd
△5	2"C, Pullwire
△6	2"C, 1-2/C#14, 2#10, #10 Gnd


See Typ Duct Section "C", Sht E-19 Unless Indicated Otherwise

NOTES:


- 1 Sawcut Exst A.C. Pavement Prior to Trenching & Repaving. Repair to Match Exst. See Det A/E-19. Sawcutting & Repaving shall not be Paid for Separately, but shall be Considered Incidental to the Various Street Light & Traffic Signal Ductline Items.
- 2 Conduit Concealed in Concrete Barrier. Provide Expansion Couplings at Expansion Joints.
- 3 Excavate Around Exst Conc Foundation (24"D x 6"D Nom) & Relocate Exst Call Box Standard & Conc Foundation as Indicated on Plan. Provide Backfill & Compact to Match Exst.
- 4 Remove Exst Guardrail as Required to Install Ductline. Reinstall per State Std Details. Removal & Installation of Exst Guardrail shall not be Paid for Separately, but Considered Incidental to the Various Street Light & Traffic Signal Ductline Items.
- 5 Route Traffic Signal Ductline w/ Street Light Ductline, See Sht E-23

APPROVED:

Catherine R. Dunne 3/20/01
CHIEF, PLANNING & ENGINEERING, BWS

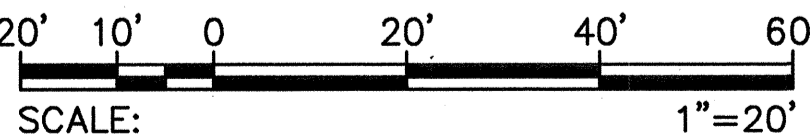

GRAPHIC SCALE

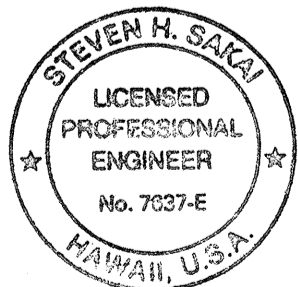

THIS WORK WAS PREPARED BY ME
OR UNDER MY SUPERVISION
Steven H. Sakai

STATE OF HAWAII
DEPARTMENT OF TRANSPORTATION
HIGHWAYS DIVISION

TRAFFIC SIGNAL PLAN III


FARRINGTON HIGHWAY
Intersection Improvements at Waiomea Street
Project No. 93A-06-98

Scale: As Noted Date: AUGUST 2000

SHEET No. E-5 OF 30 SHEETS

FED. ROAD DIST. NO.	STATE	PROJ. NO.	FISCAL YEAR	SHEET NO.	TOTAL SHEETS
HAWAII	HAW.	93A-06-98	2001	44	68

CONDUIT AND WIRE SCHEDULE	
Symbol	Description
	2"C, 1-12 Pair #19
	2"C, Pullwire
See Typ Duct Section "C", Sht E-19 Unless Indicated Otherwise	

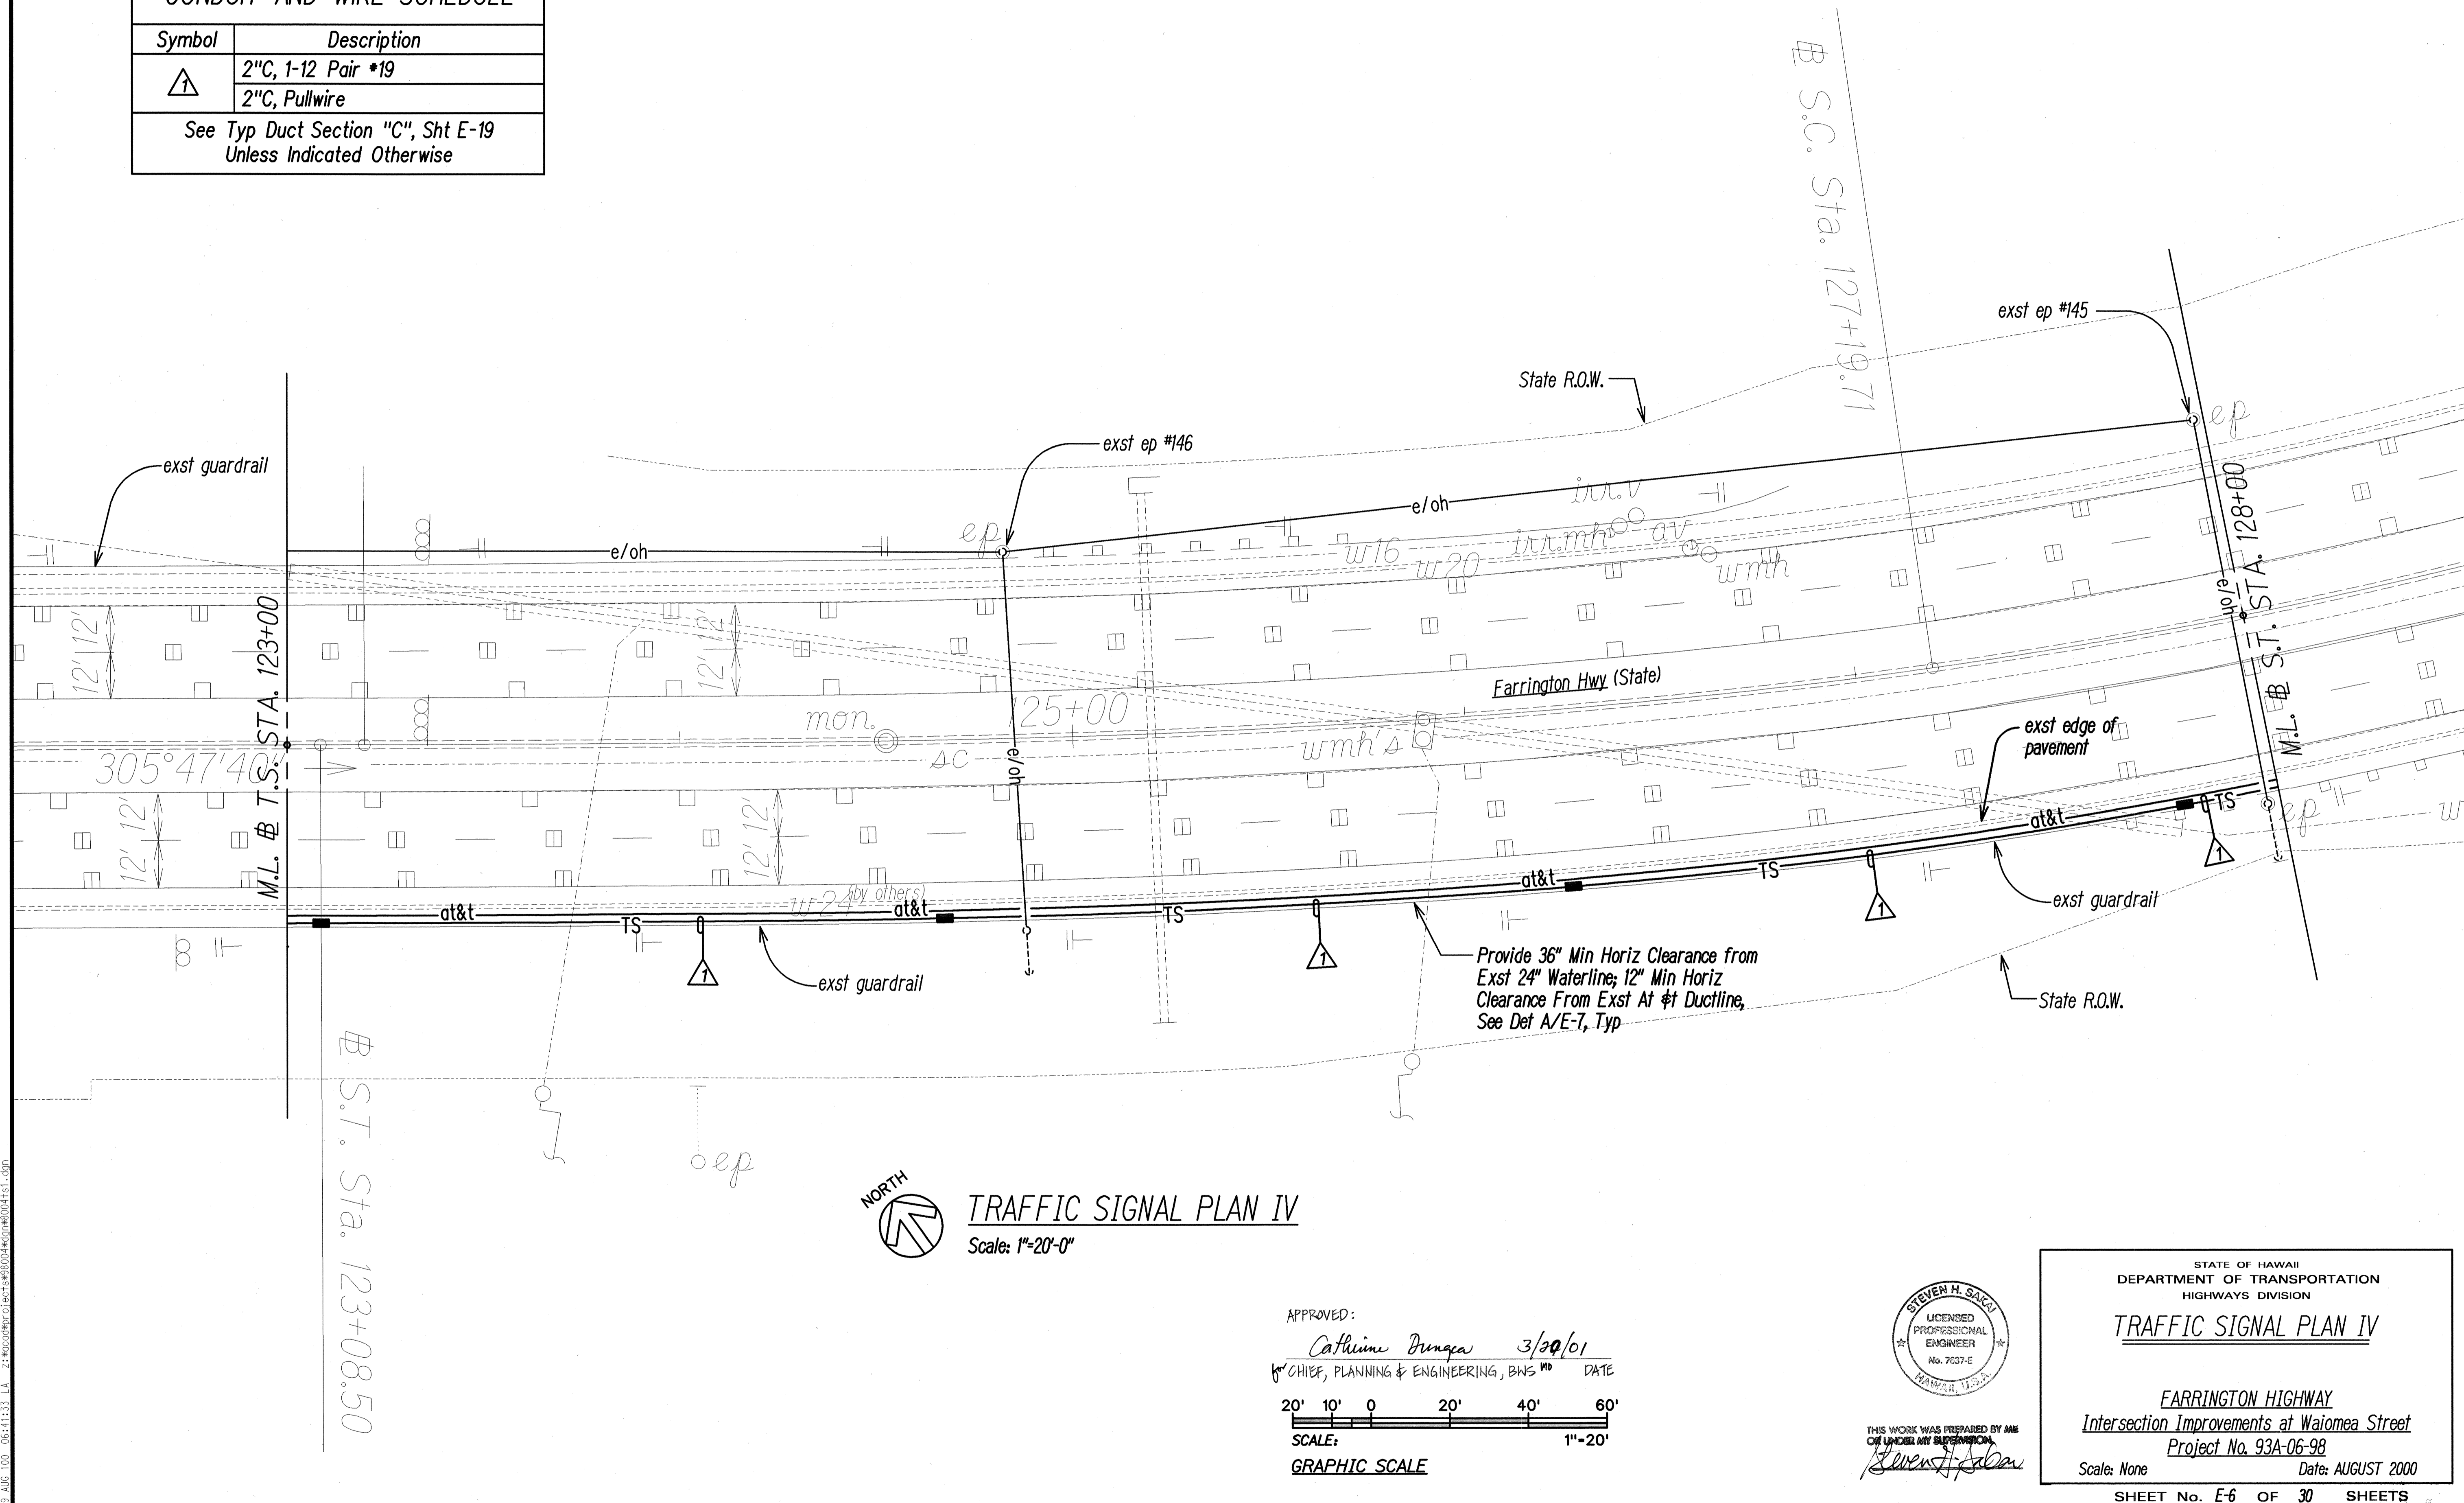


ORIGINAL PLAN	SURVEY PLOTTED BY	DATE
NOTE BOOK	DRAWN BY	
QUANTITIES BY	TRACED BY	
CHECKED BY	QUANTITIES BY	
N. 800161.dgn		

09 AUG 100 06:41:33 L.A. Z:\KODCH\Projects\93A06\93A060444.dgn



TRAFFIC SIGNAL PLAN IV
Scale: 1"=20'-0"

APPROVED:
Catharine Branga 3/24/01
CHIEF, PLANNING & ENGINEERING, BWS, MD DATE
20' 10' 0 20' 40' 60'
SCALE: 1"=20'
GRAPHIC SCALE

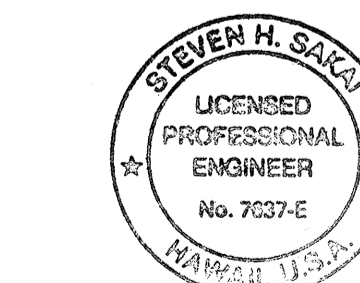



THIS WORK WAS PREPARED BY ME
OR UNDER MY SUPERVISION
Steven H. Sakai

STATE OF HAWAII DEPARTMENT OF TRANSPORTATION HIGHWAYS DIVISION	
TRAFFIC SIGNAL PLAN IV	
FARRINGTON HIGHWAY Intersection Improvements at Waiomea Street Project No. 93A-06-98	
Scale: None	Date: AUGUST 2000
SHEET No. E-6 OF 30 SHEETS	



FED. ROAD DIST. NO.	STATE	PROJ. NO.	FISCAL YEAR	SHEET NO.	TOTAL SHEETS
HAWAII	HAW.	93A-06-98	2001	45	68

CONDUIT AND WIRE SCHEDULE

Symbol	Description
	2"C, 1-12 Pair #19
	2"C, Pullwire
See Typ Duct Section "C", Sht E-19 Unless Indicated Otherwise	

Notes:

- 1 Not Used.
- 2 Remove Exst Guardrail as Required to Install Ductline. Reinstall per State Std Details. Removal & Reinstallation of Exst Guardrail Shall Not be Paid for Separately, but Considered Incidental to the Various Traffic Signal Ductline Items.

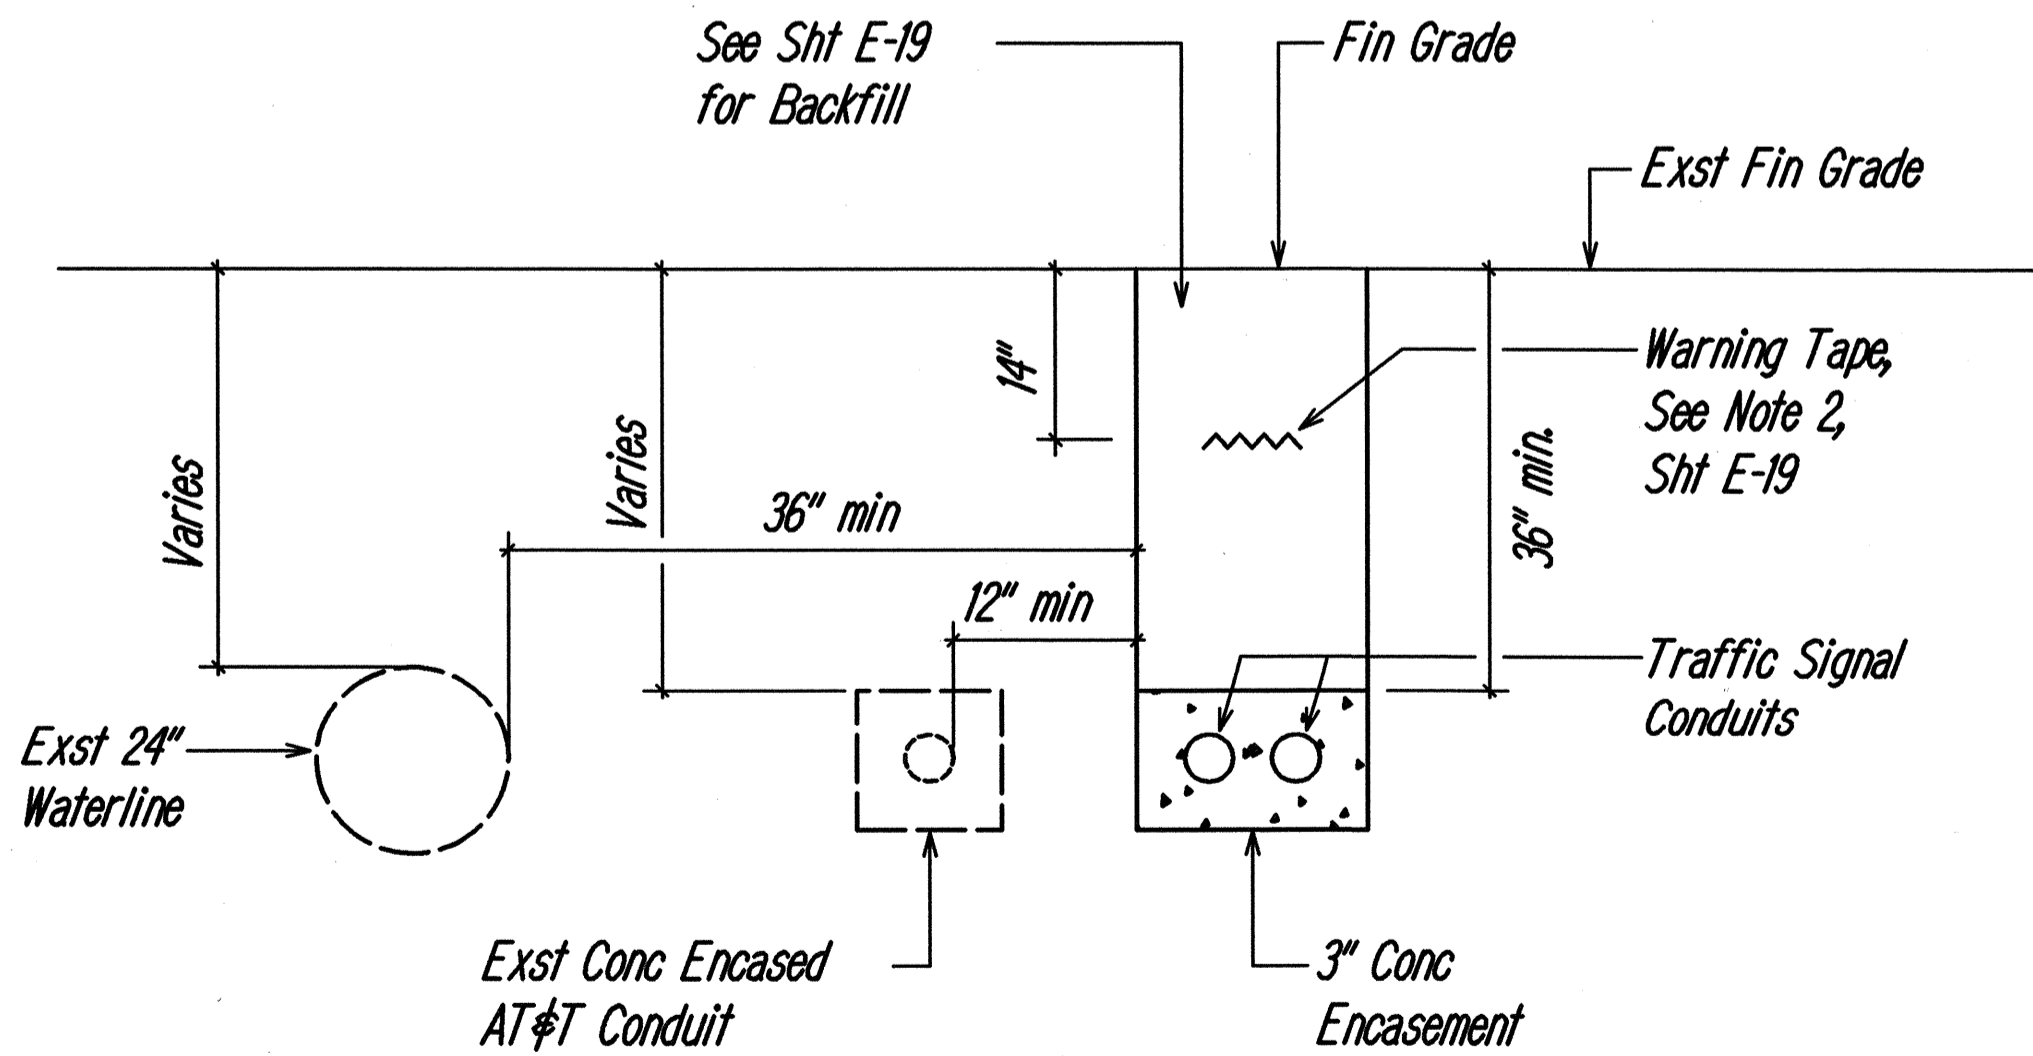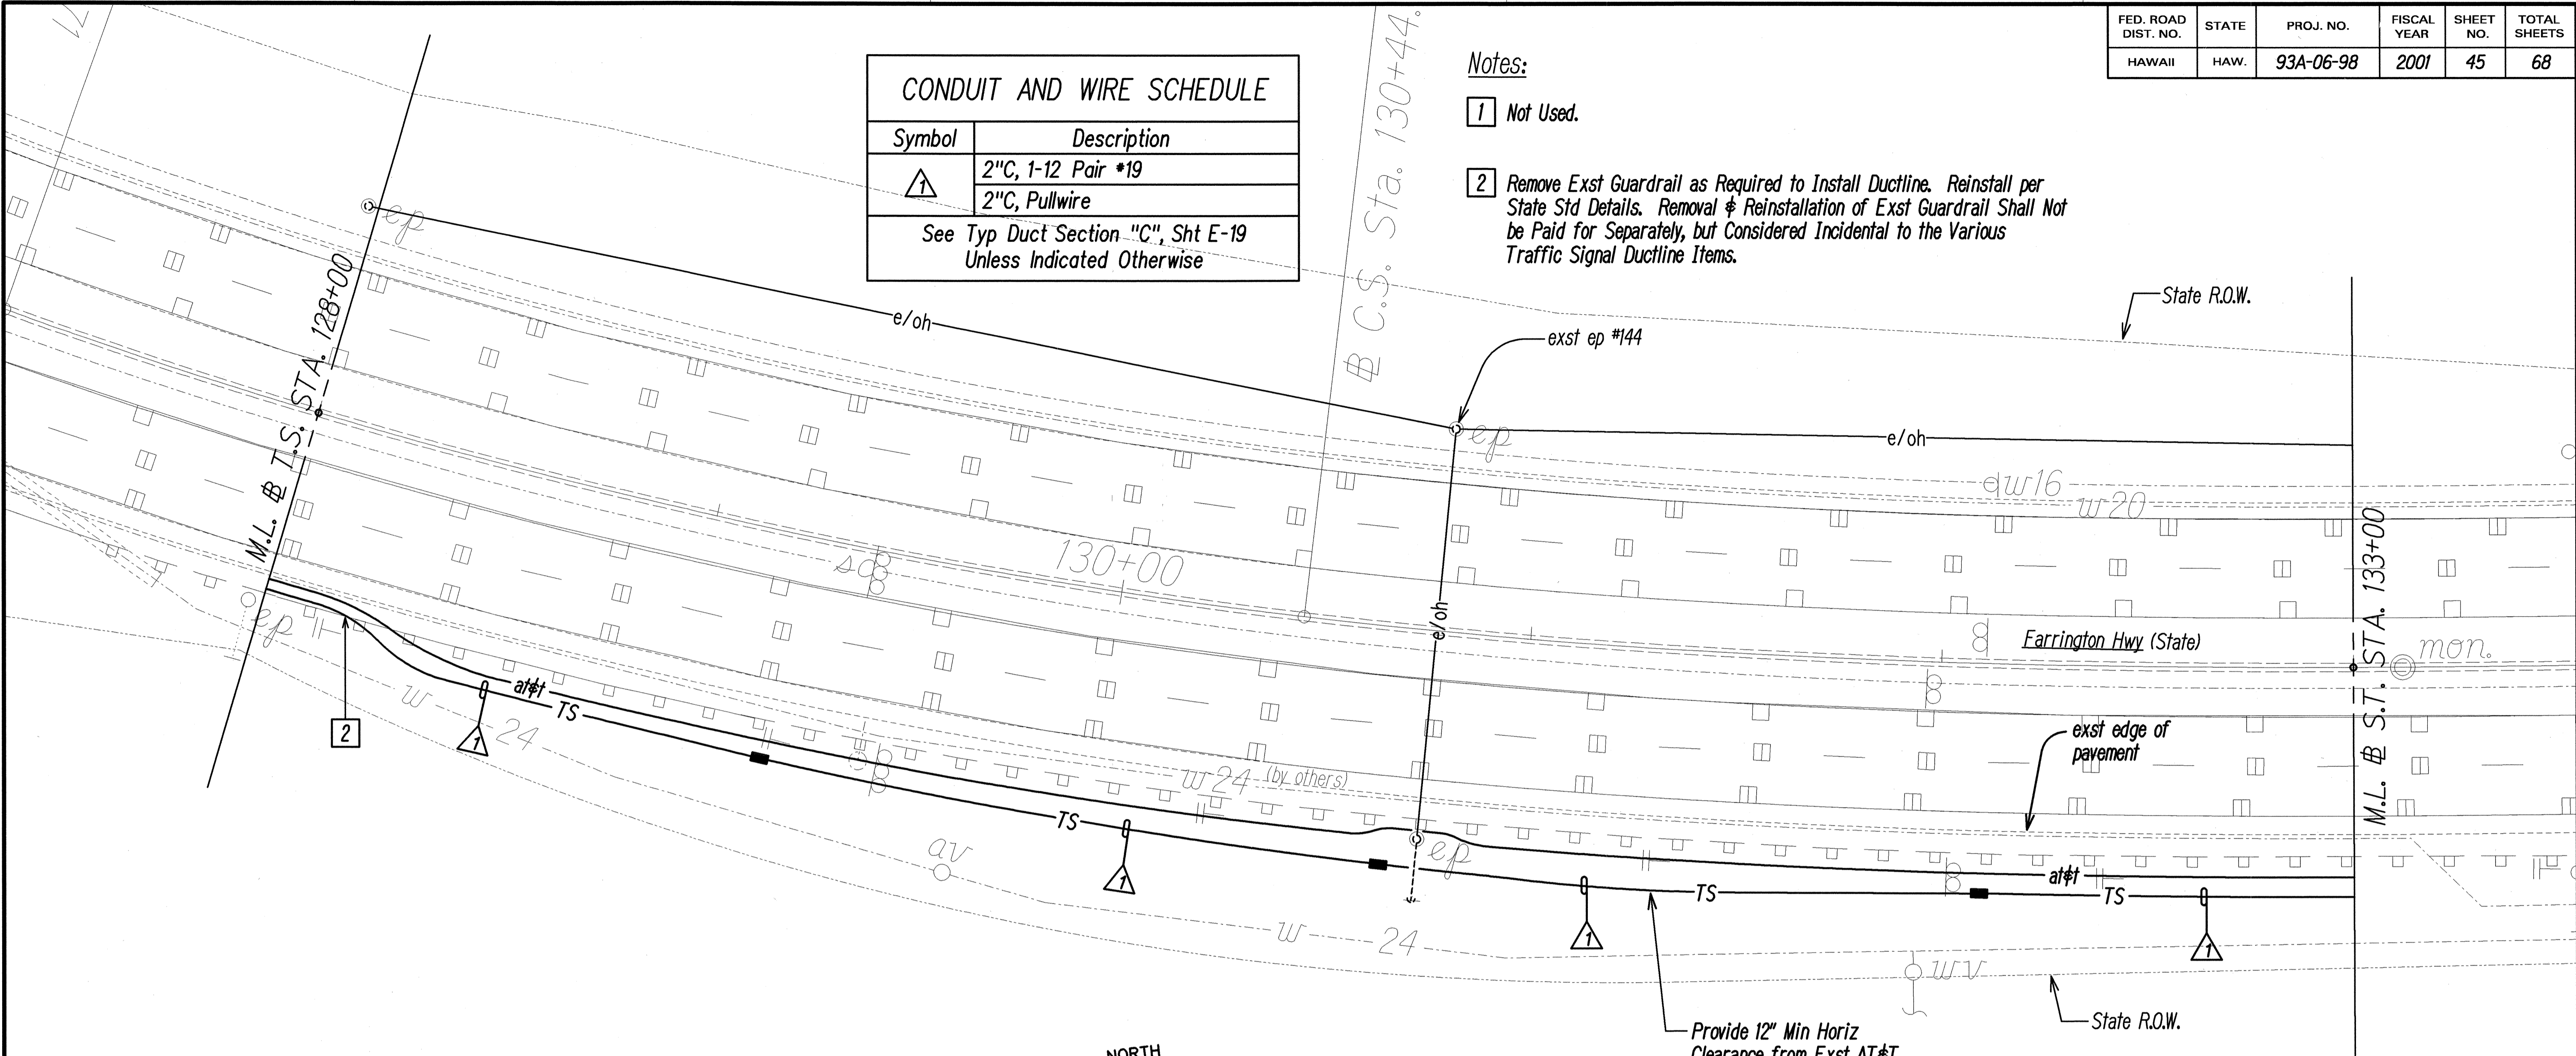

A E-7 TYPICAL SECTION X NOT TO SCALE




TRAFFIC SIGNAL PLAN V


Scale: 1"=20'-0"

APPROVED:

Catherine Brungo 3/20/01
CHIEF, PLANNING & ENGINEERING, BWS MD DATE

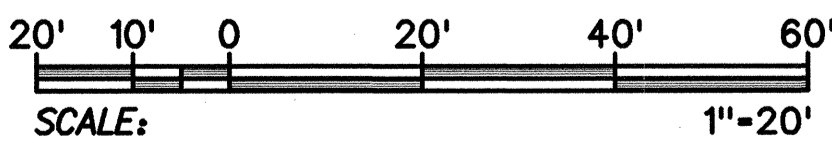

GRAPHIC SCALE

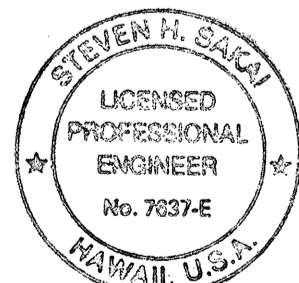

THIS WORK WAS PREPARED BY ME
OR UNDER MY SUPERVISION
Steven H. Sasaki


STATE OF HAWAII
DEPARTMENT OF TRANSPORTATION
HIGHWAYS DIVISION

TRAFFIC SIGNAL PLAN V

FARRINGTON HIGHWAY
Intersection Improvements at Waioeoa Street
Project No. 93A-06-98

Scale: None Date: AUGUST 2000

SHEET No. E-7 OF 30 SHEETS

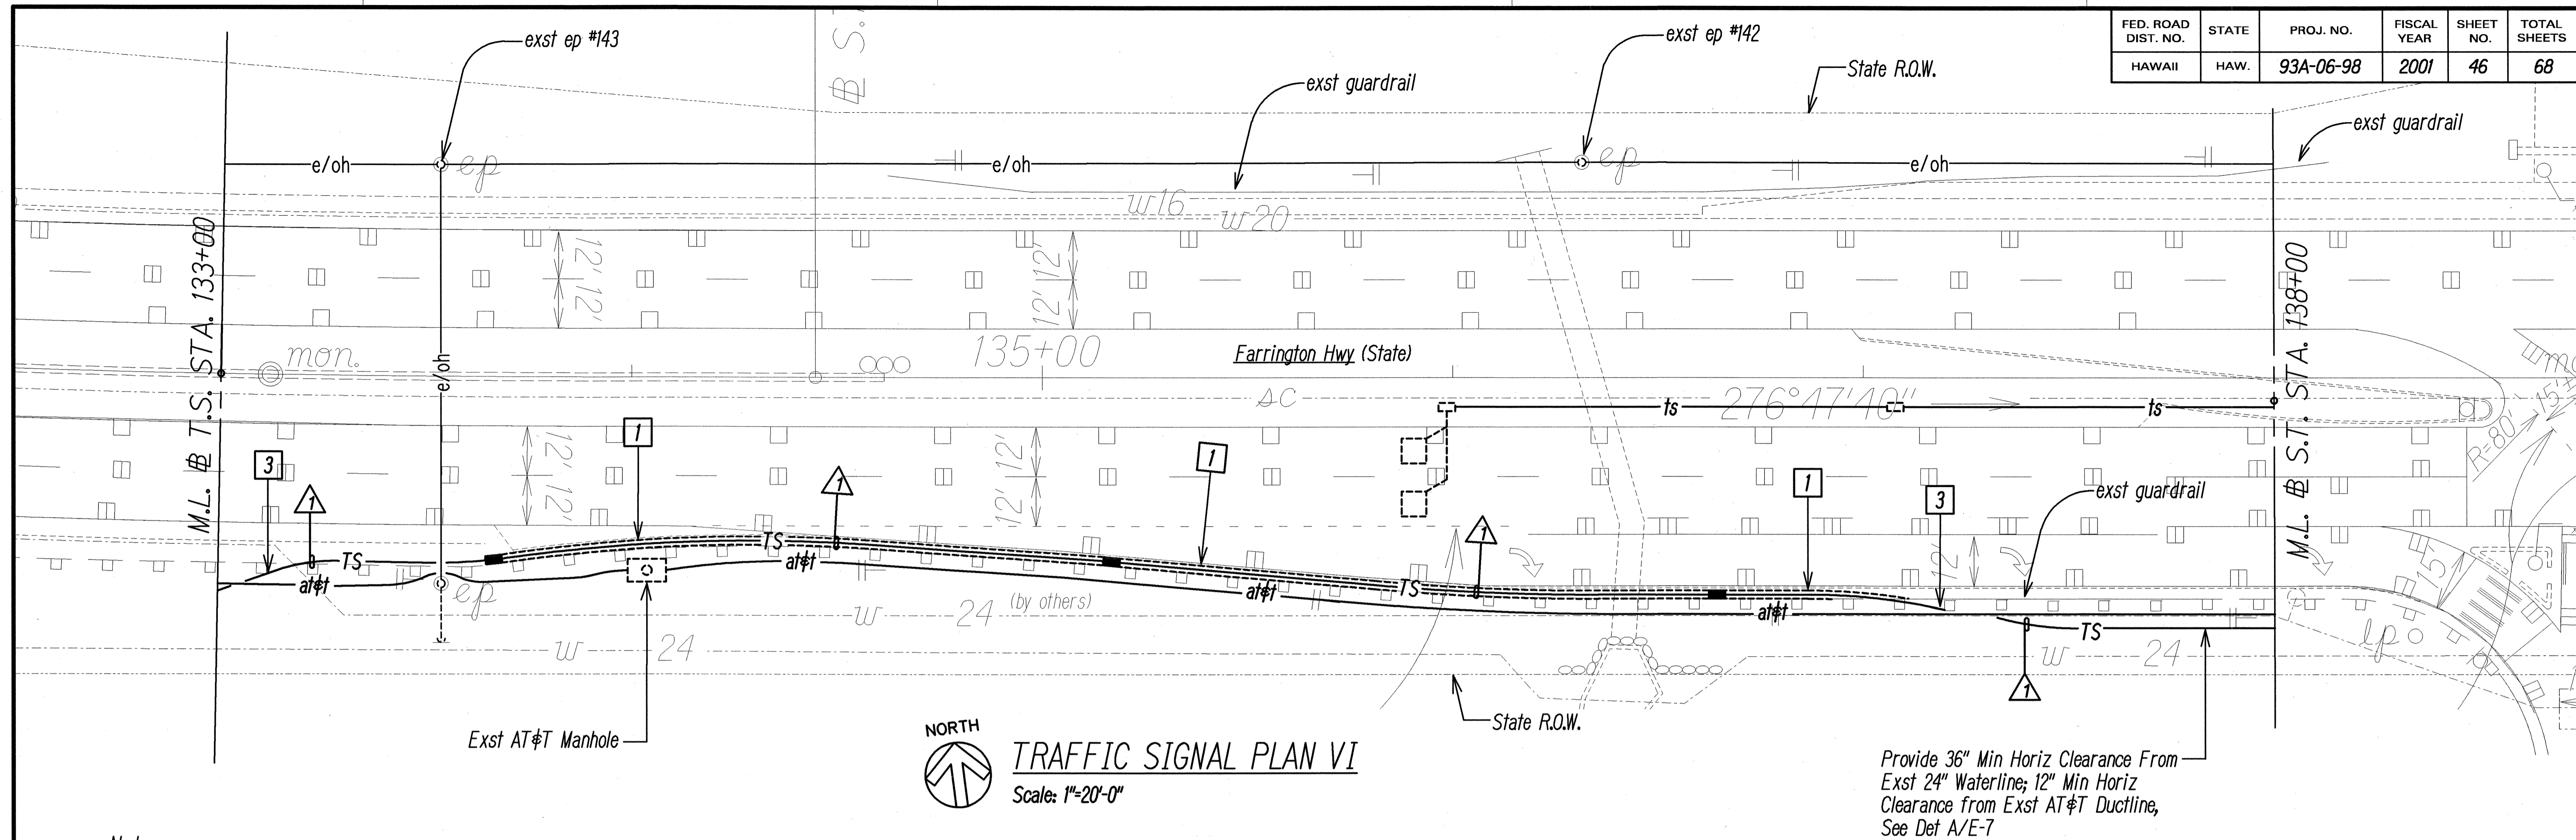

Notes:

- 1 Sawcut Exst AC. Pavement Prior to Trenching & Repaving. Repair to Match Exst, See Det A/E-19. Sawcutting & Repaving of Exst AC. Pavement Shall Not be Paid for Separately, but Considered Incidental to the Various Traffic Signal Ductline Items.
- 2 Not Used.
- 3 Remove Exst Guardrail as Required to Install Ductline. Reinstall per State Std Details. Removal & Reinstallation of Exst Guardrail shall not be Paid for Separately, but Considered Incidental to the Various Traffic Signal Ductline Items.

CONDUIT AND WIRING SCHEDULE


Symbol	Description
△	2"C, 1-12 Pair #19
	2"C, Pullwire
See Typ Duct Section "C", Sht E-19 Unless Indicated Otherwise	

APPROVED:

Catharine Dungea 3/20/01
CHIEF, PLANNING & ENGINEERING, BWS MD DATE

20' 10' 0 20' 40' 60'
SCALE: 1"=20'

GRAPHIC SCALE

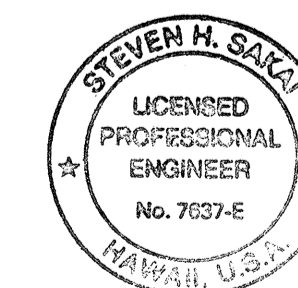

THIS WORK WAS PREPARED BY ME OR UNDER MY SUPERVISION
Steven H. Sakai

STATE OF HAWAII
DEPARTMENT OF TRANSPORTATION
HIGHWAYS DIVISION


TRAFFIC SIGNAL PLAN VI

FARRINGTON HIGHWAY
Intersection Improvements at Waiomea Street
Project No. 93A-06-98
Scale: None Date: AUGUST 2000

SHEET No. E-8 OF 30 SHEETS

CONDUIT AND WIRING SCHEDULE

Symbol	Description
△	2"C, 1-12 Pair *19
	2"C, Pullwire
△	Exst 2"C, Exst 1-26/C *14
	Exst 2"C, Exst 1-26/C *14
	Exst 2"C, Exst 1-3/C *6
	Exst 2"C, Exst 8-2/C *14
	Exst 2"C; Provide 3-Opticom Cable 1-12 Pair *19
△	Exst 2"C, Exst 1-26/C *14
	Exst 2"C, Exst 1-26/C* 14; Provide 2-Opticom Cable
	Exst 2"C, Exst 8-2/C *14
△	Exst 2"C, Exst 1-26/C *14
	Exst 2"C, Exst 4-2/C *14; Provide 2-Opticom Cable
△	Exst 2"C, Exst 1-26/C *14
	Exst 2"C; Provide 1-Opticom Cable
See Typ Duct Section "C", Sht E-19 Unless Indicated Otherwise	

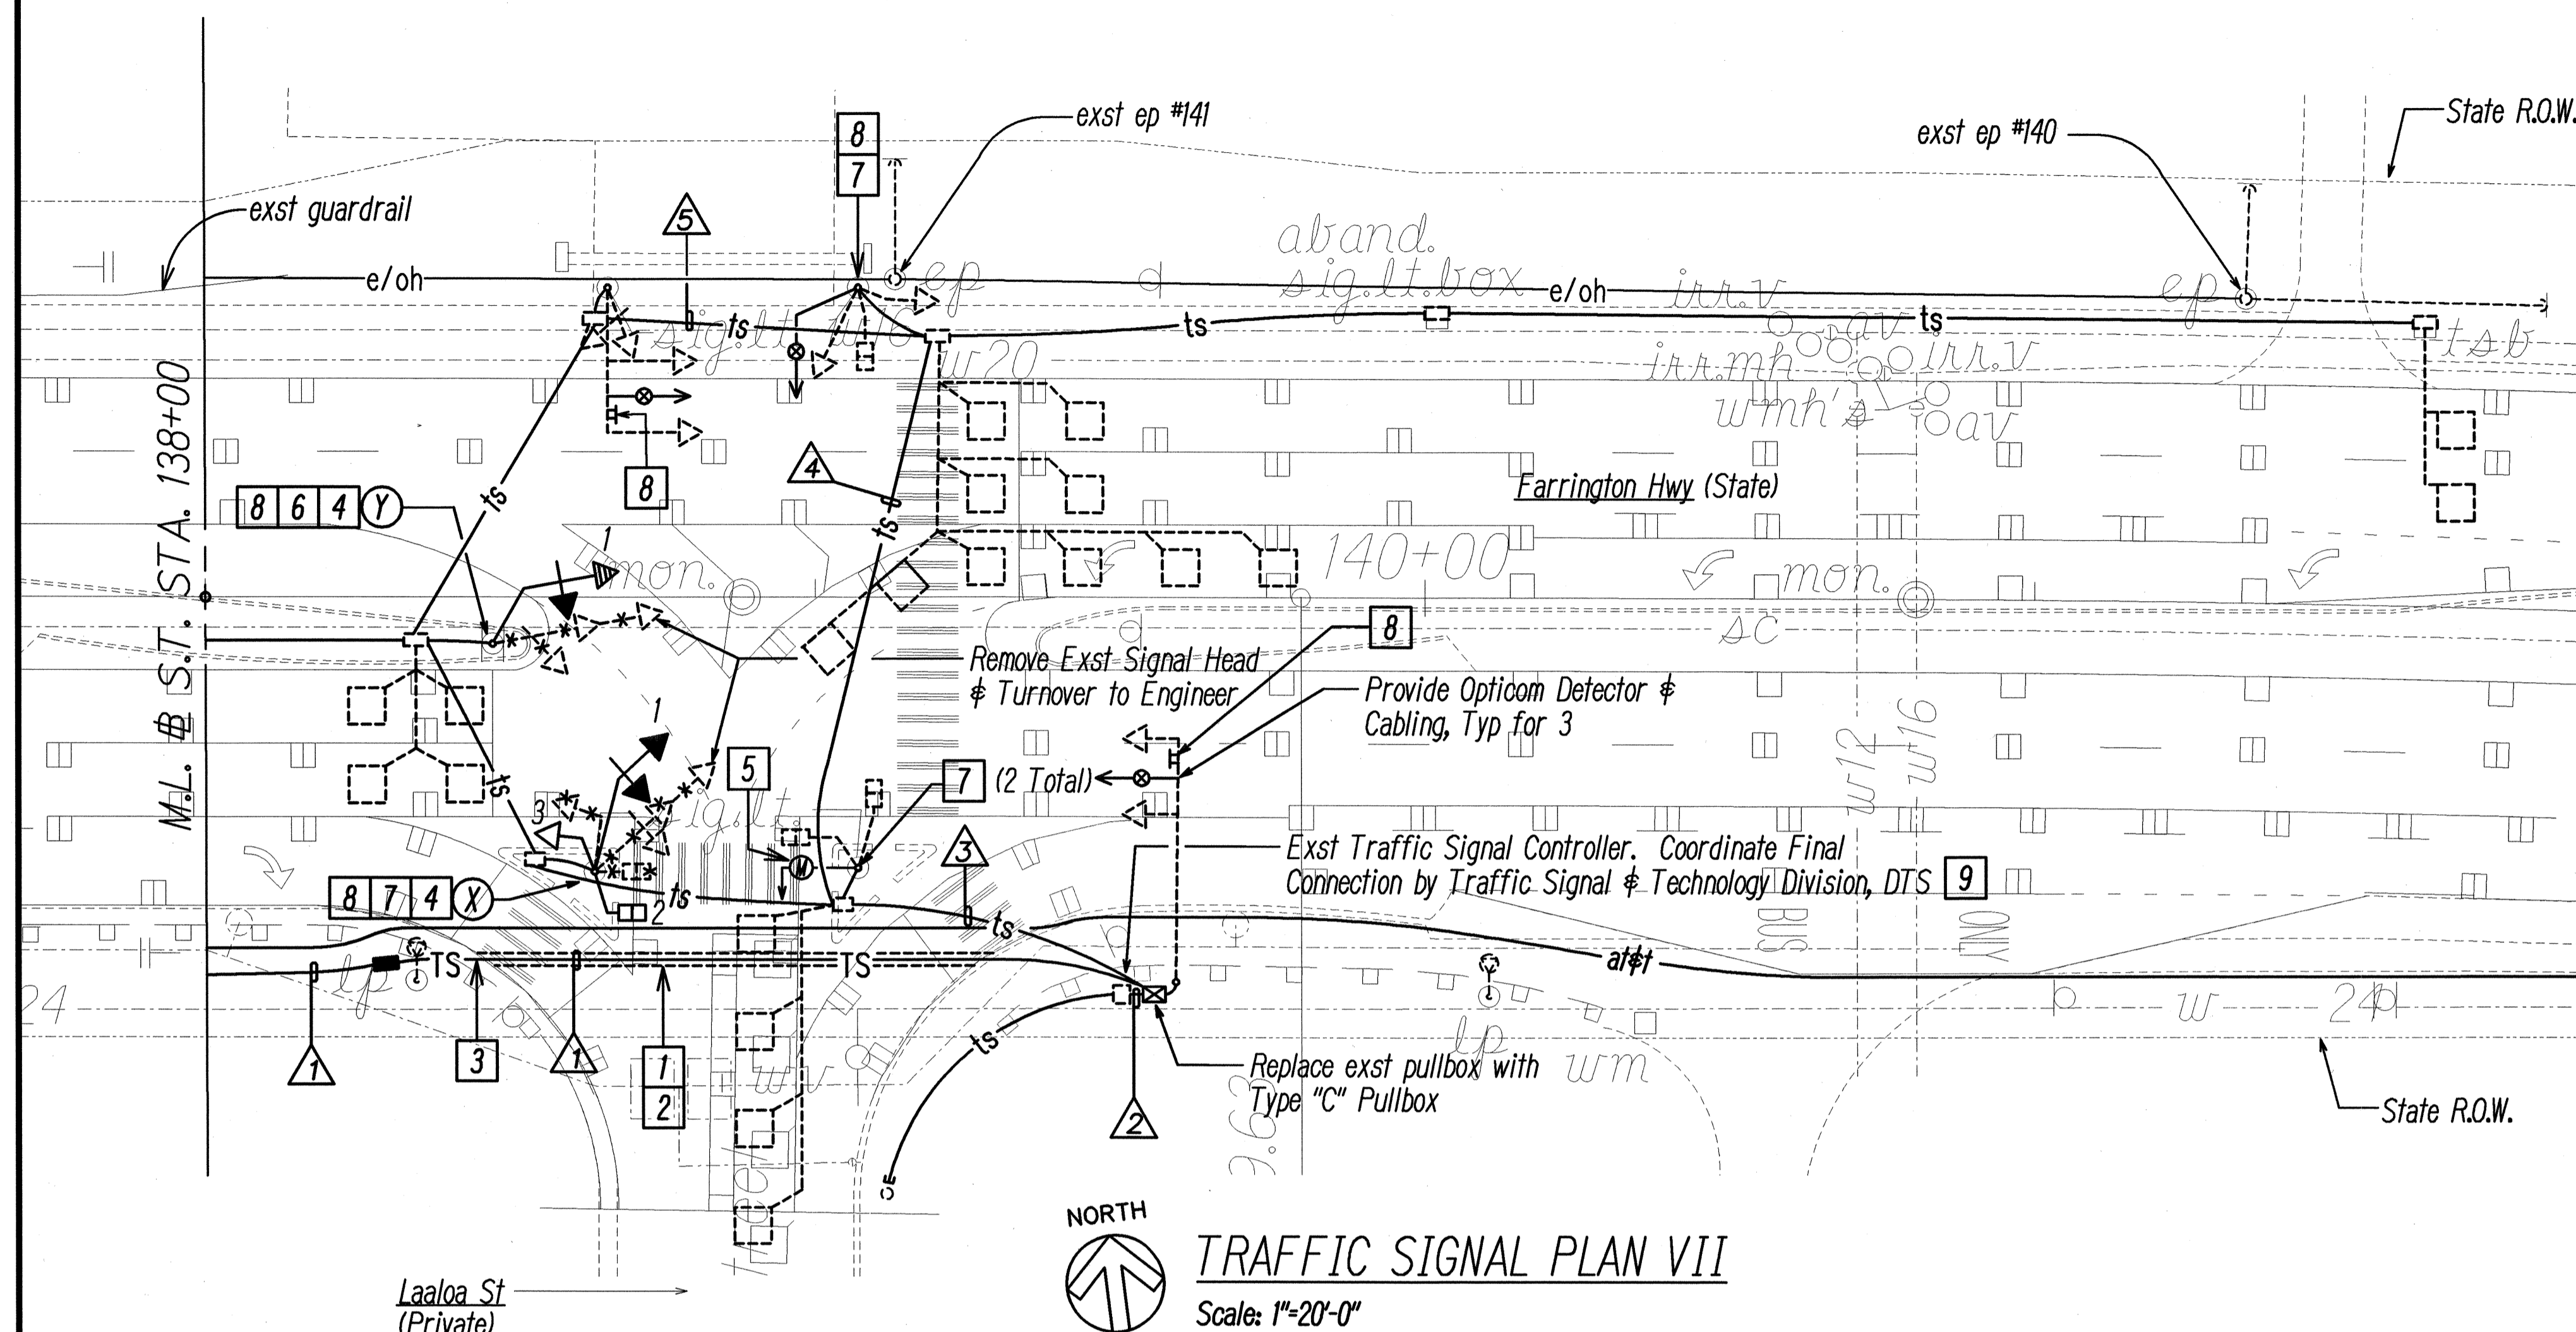


TRAFFIC SIGNAL PLAN VII
Scale: 1"=20'-0"

Notes:

- 1 Sawcut Exst A.C. Pavement Prior to Trenching & Repaving. Repair to Match Exst, See Det A/E-19. Sawcutting & Repaving of Exst A.C. Pavement Shall not be Paid for Separately, but Considered Incidental to the Various Traffic Signal Ductline Items.
- 2 Provide Striping & Loop Detectors Damaged by Trenching to Match Exst. Replacement Striping & Loop Detectors shall not be Paid for Separately, but Considered Incidental to the Various Traffic Signal Contract Items.
- 3 Remove Exst Guardrail as Required to Install Ductline. Reinstall per State Std Details. Removal & Reinstallation of Exst Guardrail shall not be Paid for Separately, but Considered Incidental to the Various Traffic Signal Ductline Items.
- 4 Remove Exst Traffic Signal Std. Provide 13' Type I Std, Traffic Signal Head as Indicated, "On Left Arrow Only & No U Turn" R17-3 Sign.
- 5 Provide Temp Approach-Only Microwave Detector, Mounting Bracket & Wiring During Replacement of Laaloa St Loop Detectors. Temp Detector shall not be Paid for Separately, but Considered Incidental to the Various Traffic Signal Contract Items.
- 6 Provide Stainless Steel Straps & Reinstall Exst "No U Turn" Sign. Reinstalling Sign shall not be Paid for Separately, but Considered Incidental to the Various Traffic Signal Items
- 7 Replace Exst Ped Pushbutton w/ New Ped Pushbutton, See Det C/E-11
- 8 Provide "Caution Signals Modified" Warning Sign. Sign shall not be Paid for Separately, but Considered Incidental to the various Traffic Signal Items
- 9 Provide 2 Each Model M752 Preemption Cards with 758 Aux. Interface Panel. Pre-emption card shall not be Paid for Separately but Considered Incidental to the Traffic Signal Controller Item.

APPROVED:
Catharine Dungea 3/20/01
 CHIEF, PLANNING & ENGINEERING, BWS MD DATE
 20' 10' 0 20' 40' 60'
 SCALE: 1"=20'
 GRAPHIC SCALE

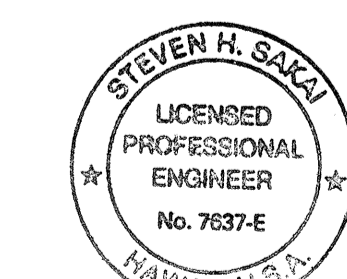

THIS WORK WAS PREPARED BY ANS
 OR UNDER MY SUPERVISION
Steven H. Saka

STATE OF HAWAII
DEPARTMENT OF TRANSPORTATION
HIGHWAYS DIVISION

TRAFFIC SIGNAL PLAN VII


FARRINGTON HIGHWAY
Intersection Improvements at Waiomea Street
Project No. 93A-06-98
Scale: None Date: AUGUST 2000

SHEET No. E-9 OF 30 SHEETS


47

				Signal Indication
12" RYGA Traffic Signal Head (L.E.D. Signal Assembly Except for Programmed Visibility Head)	12" RYG Traffic Signal Head (L.E.D. Signal Assembly Except for Programmed Visibility Head)	12" RYGA Traffic Signal Head (L.E.D. Signal Assembly Except for Programmed Visibility Head)	Pedestrian Signal Head	Description
D-1 E-3 (a), (c) F-1 X-1 (b) Y-1 (a), (b), (c)	A-1 X-3 (b) B-2 (a) C-2 G-1	A-3 B-1 (a) E-1 (a) E-2 (a) E-4 (a) F-2	A-2 C-1 D-2 H-1 X-2 (b)	Pole Letter-Signal Head Number

(a) Provide Back Plate for Signal Head. Back Plate shall not be paid for Separately, but Considered Incidental to the Signal Assembly Items
(b) Signal Head at Laaloa St Intersection
(c) Programmed Visibility Signal Head

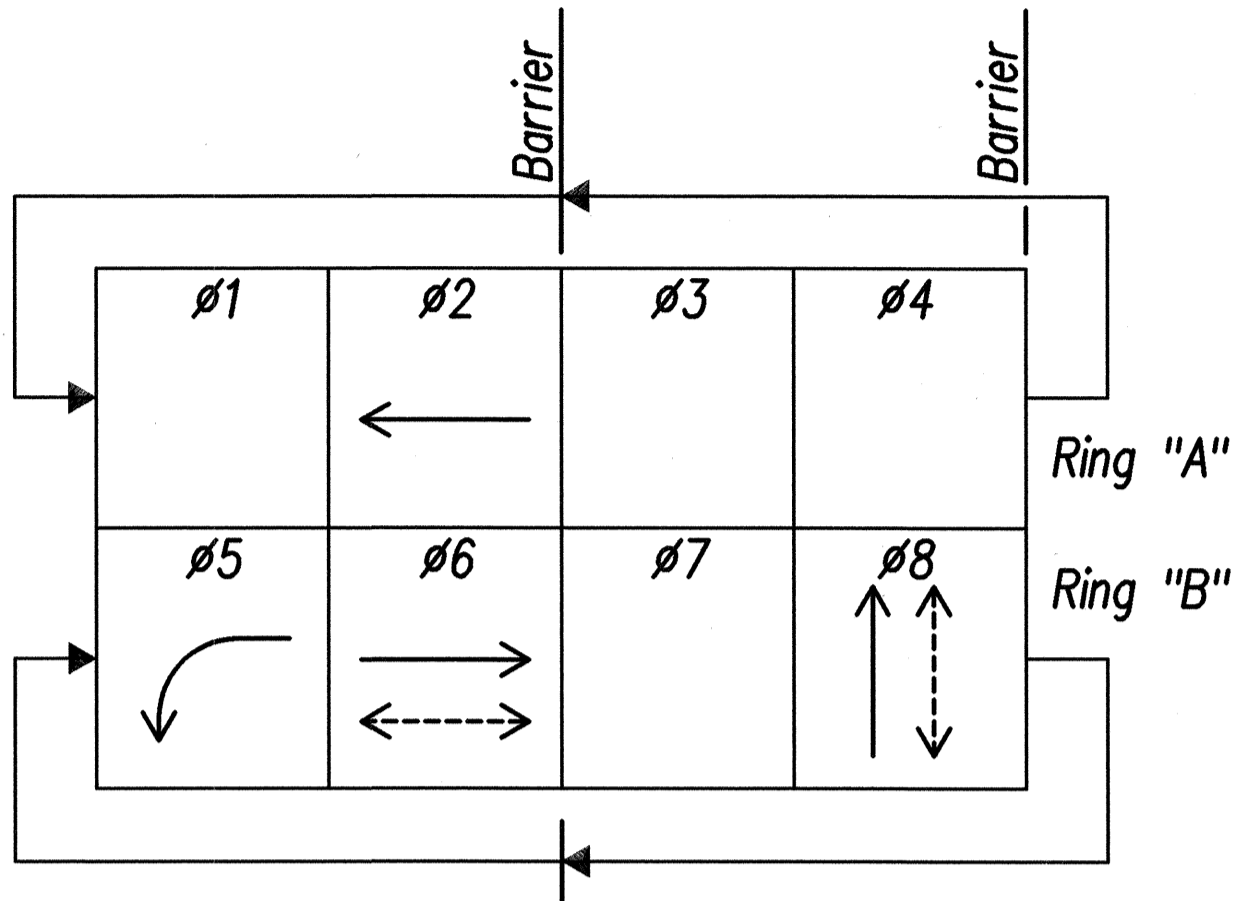

PHASE ASSIGNMENT DIAGRAM

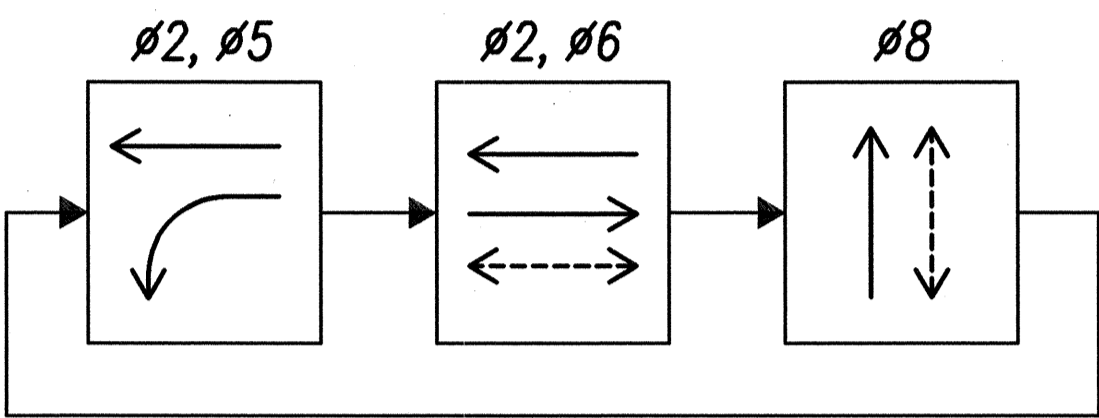


PHASING DIAGRAM

CONDUIT AND WIRING SCHEDULE (For Sheet E-4)

Symbol	Description	Symbol	Description	Symbol	Description
	2"C, 1-26/C *14, *8 Gnd		2"C, 1-26/C *14, *8 Gnd		2"C, 2-2/C *14
	2"C, 1-Opticom Cable		2"C, 7-2/C *14		
	2"C, 2-2/C *14, 2*10, *10 Gnd		2"C, 2*10, *10 Gnd		
	2"C, Pullwire		2"C, 1-12 Pair *19		
	2"C, 1-26/C *14, *8 Gnd		2"C, 1-Opticom Cable		2"C, 1-2/C *14, 2*10, *10 Gnd
	2"C, 2-2/C *14, 2*10, *10 Gnd				2"C, Pullwire
	2-2"C, Pullwire in Each				
	2"C, 1-26/C *14, *8 Gnd		2"C, 1-2/C *14, 2*10, *10 Gnd		2"C, 1-2/C *14
	2"C, 1-2/C *14		2"C, 1-2/C *14		
	2-2"C, Pullwire in Each		2"C, 1-12 Pair *19		
			2"C, Pullwire		
	2"C, 1-26/C *14, *8 Gnd		2"C, 1-2/C *14, 2*10, *10 Gnd		2"C, 1-2/C *14
	2"C, 5-2/C *14, 1-Opticom Cable		2"C, 1-2/C *14		
	2"C, 2*10, *10 Gnd		2"C, 1-12 Pair *19		
	2"C, 1-12 Pair *19		2"C, Pullwire		
	2"C, Pullwire		2"C, 3*8, *8 Gnd		2"C, 3-Opticom Cable
	2"C, 1-26/C *14, *8 Gnd		3"C, 2-26/C *14, *8 Gnd		2"C, 4*10, *10 Gnd
	2"C, 3-2/C *14, 1-Opticom Cable		3"C, 1-12 Pair *19		
	2"C, 1-12 Pair *19		3"C, 9-2/C *14		
	2"C, Pullwire		2"C, 3-Opticom Cable		2"C, 3-C, Pullwire in Each
			2"C, 4*10, *10 Gnd		

See Typ Duct Section "C", Sht E-19 Unless Indicated Otherwise.

ORIGINAL PLAN	DATE
DESIGNED BY	
DRAWN BY	
CHECKED BY	
NOTED BY	
APPROVED BY	

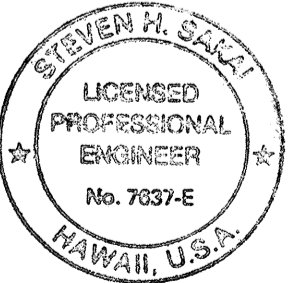

THIS WORK WAS PREPARED BY AN
OR UNDER MY SUPERVISION
Steven H. Sakai



STATE OF HAWAII
DEPARTMENT OF TRANSPORTATION
HIGHWAYS DIVISION

TRAFFIC SIGNAL DETAILS


FARRINGTON HIGHWAY
Intersection Improvements at Waiomea Street
Project No. 93A-06-98

Scale: None Date: AUGUST 2000


FED. ROAD DIST. NO.	STATE	PROJ. NO.	FISCAL YEAR	SHEET NO.	TOTAL SHEETS
HAWAII	HAW.	93A-06-98	2001	49	68

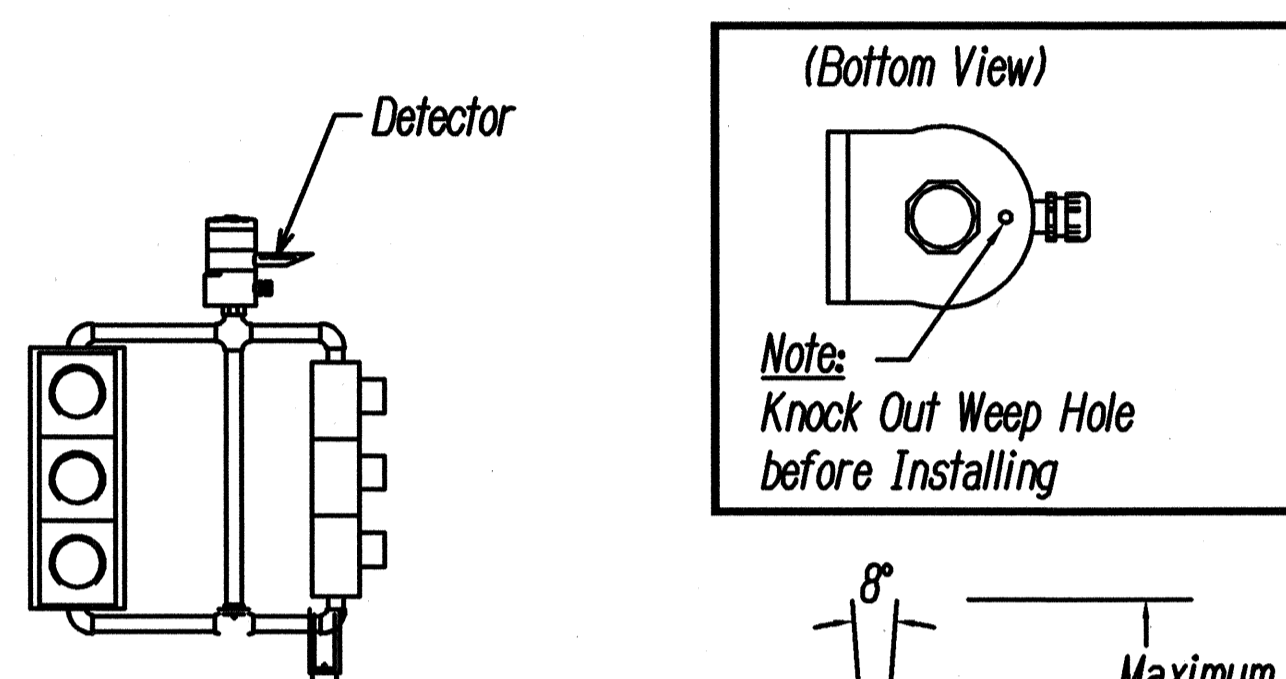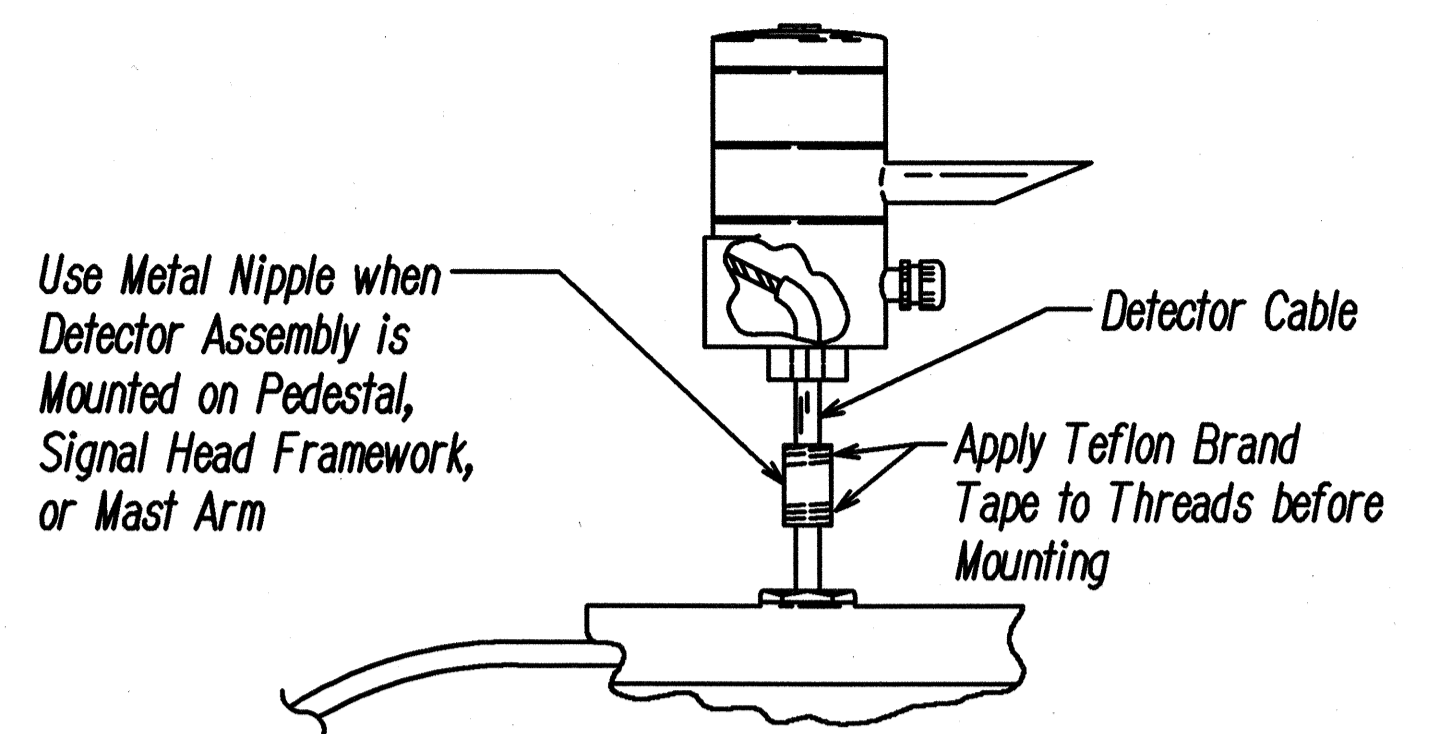

Note:
Detector Reception Angle varies with Distance. It is Approximately 8° at 1800 Feet (0.54km). Due to Reflection, Reception Angle is Increased at Close Range. The Detector must be Aligned within 8° of the Farthest Point where Priority Vehicle is to be Sensed.

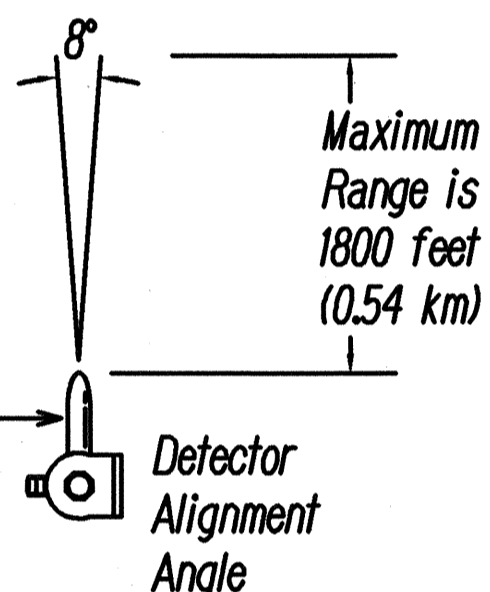


TYPICAL PEDESTAL/TYPE T.S.S. MOUNTING OF EVP DETECTOR

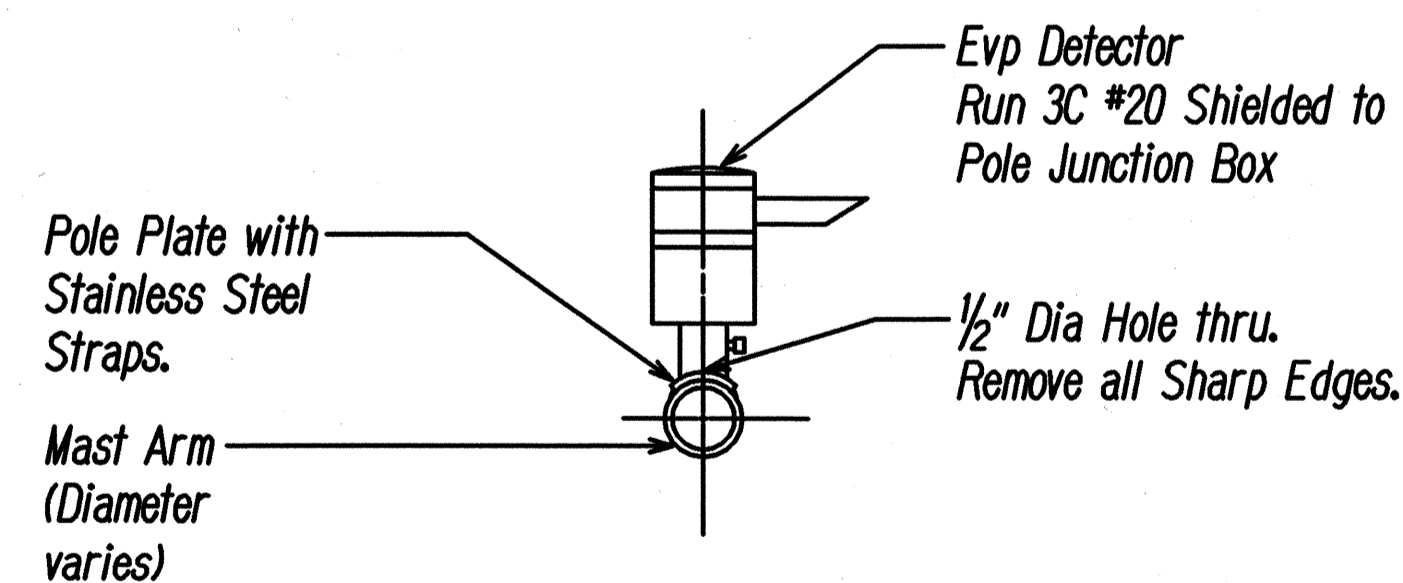


TYPICAL MAST ARM MOUNTING OF EVP DETECTOR

A
E-11
Not to Scale

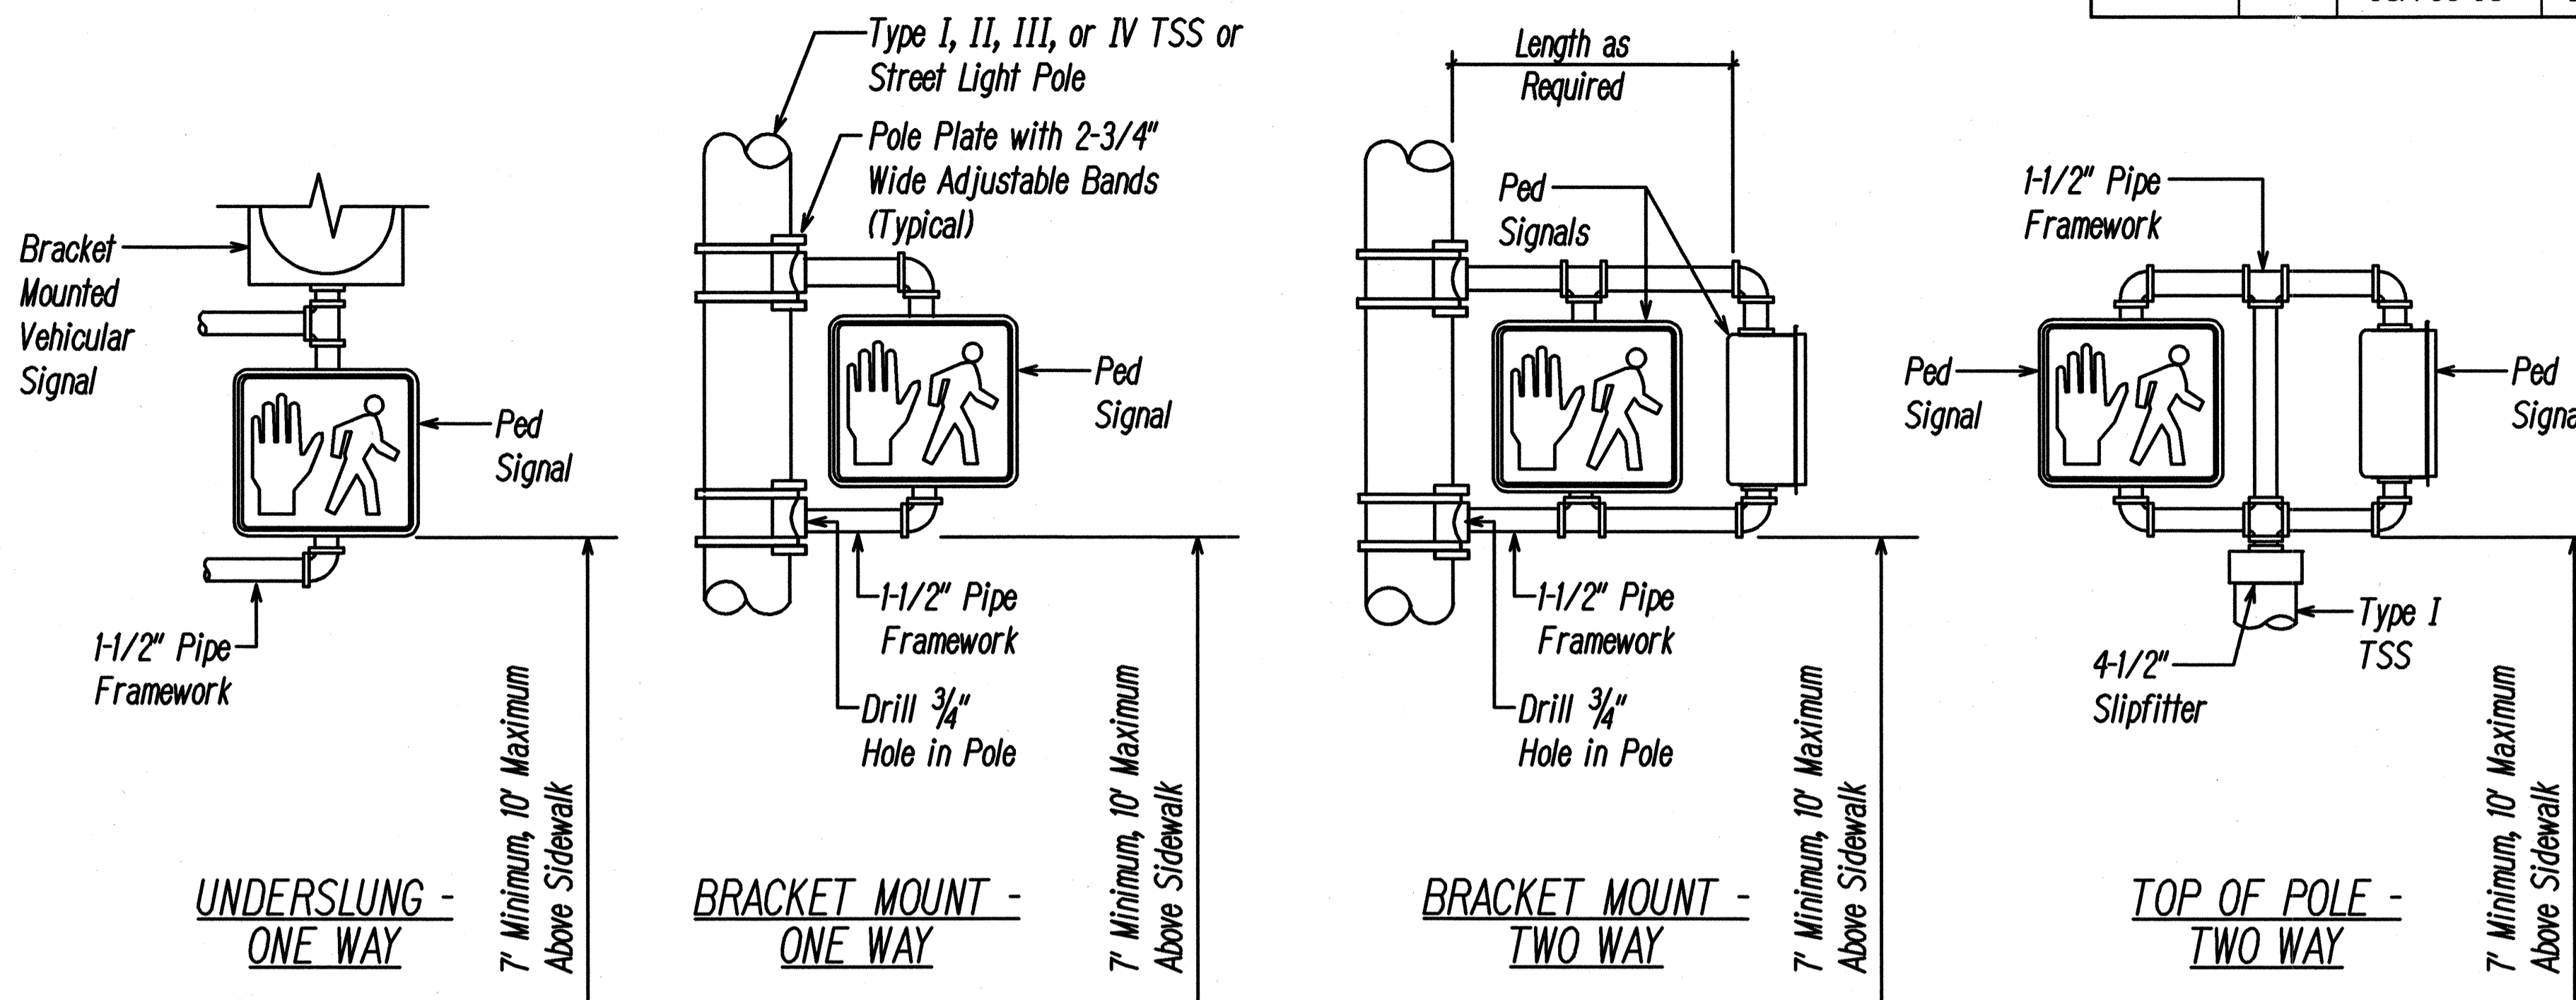

B
E-11
PEDESTRIAN SIGNAL MOUNTINGS
Not to Scale

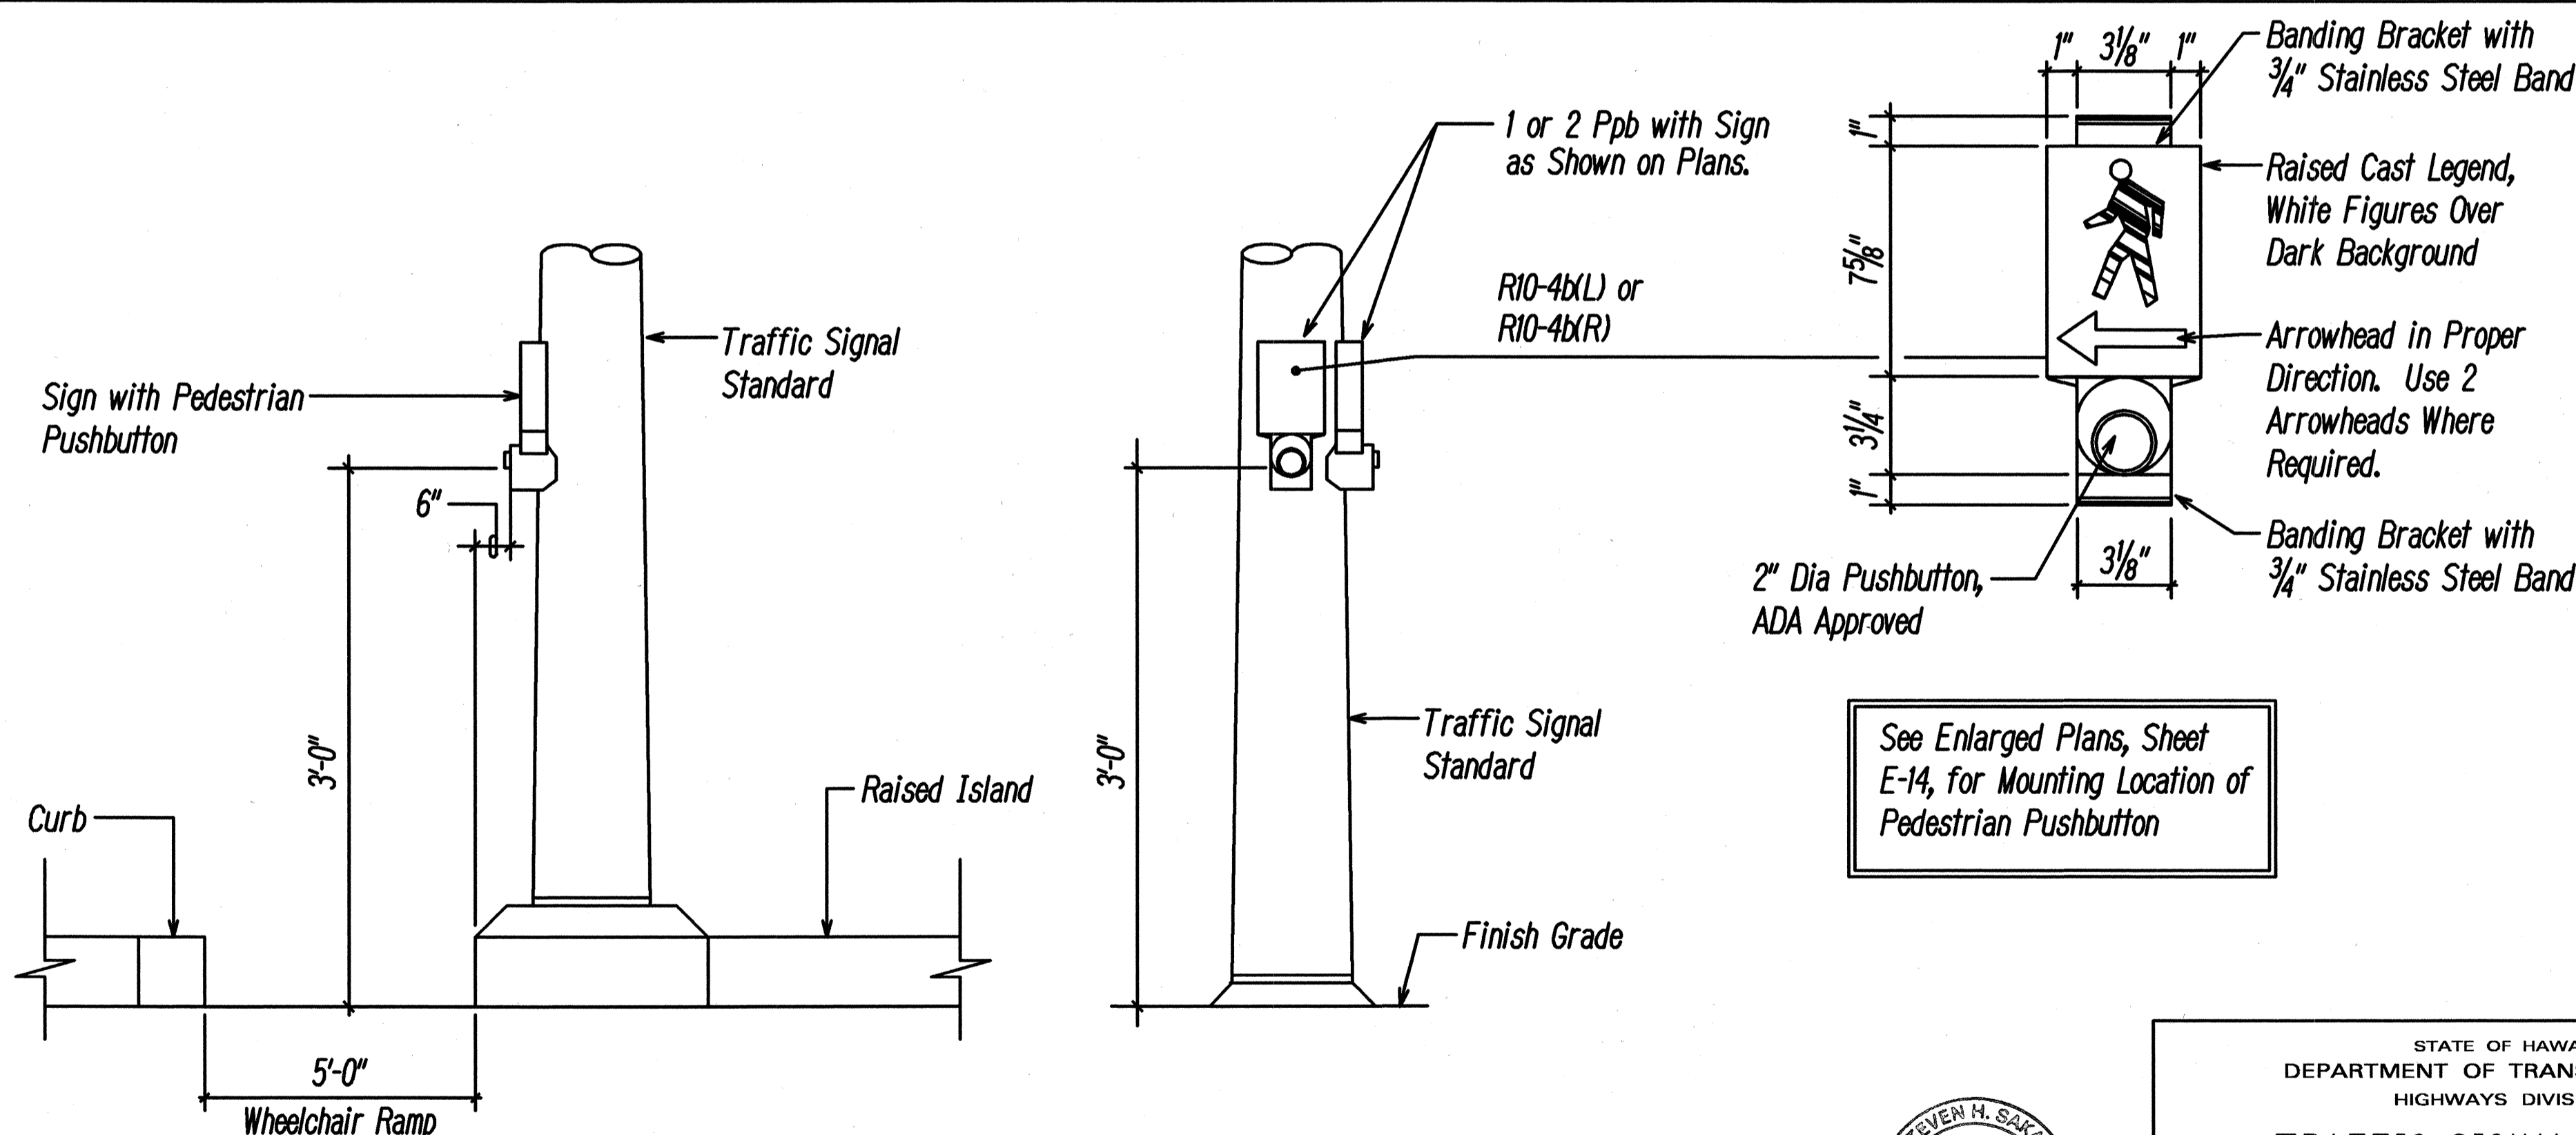


See Enlarged Plans, Sheet E-14, for Mounting Location of Pedestrian Pushbutton

AT RAISED CONCRETE ISLAND

AT SHOULDER

C
E-11
PEDESTRIAN PUSHBUTTON DETAILS
Not to Scale

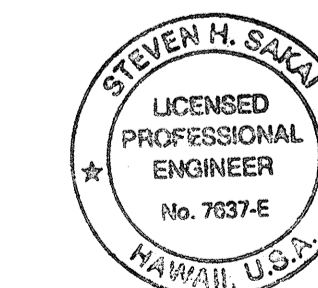

THIS WORK WAS PREPARED BY ME
OR UNDER MY SUPERVISION
DATE: 7/2001



STATE OF HAWAII
DEPARTMENT OF TRANSPORTATION
HIGHWAYS DIVISION

TRAFFIC SIGNAL DETAILS



FARRINGTON HIGHWAY
Intersection Improvements at Waiomea Street
Project No. 93A-06-98
Scale: None
Date: AUGUST 2000

SHEET No. E-11 OF 30 SHEETS

FED. ROAD DIST. NO.	STATE	PROJ. NO.	FISCAL YEAR	SHEET NO.	TOTAL SHEETS
HAWAII	HAW.	93A-06-98	2001	50	68

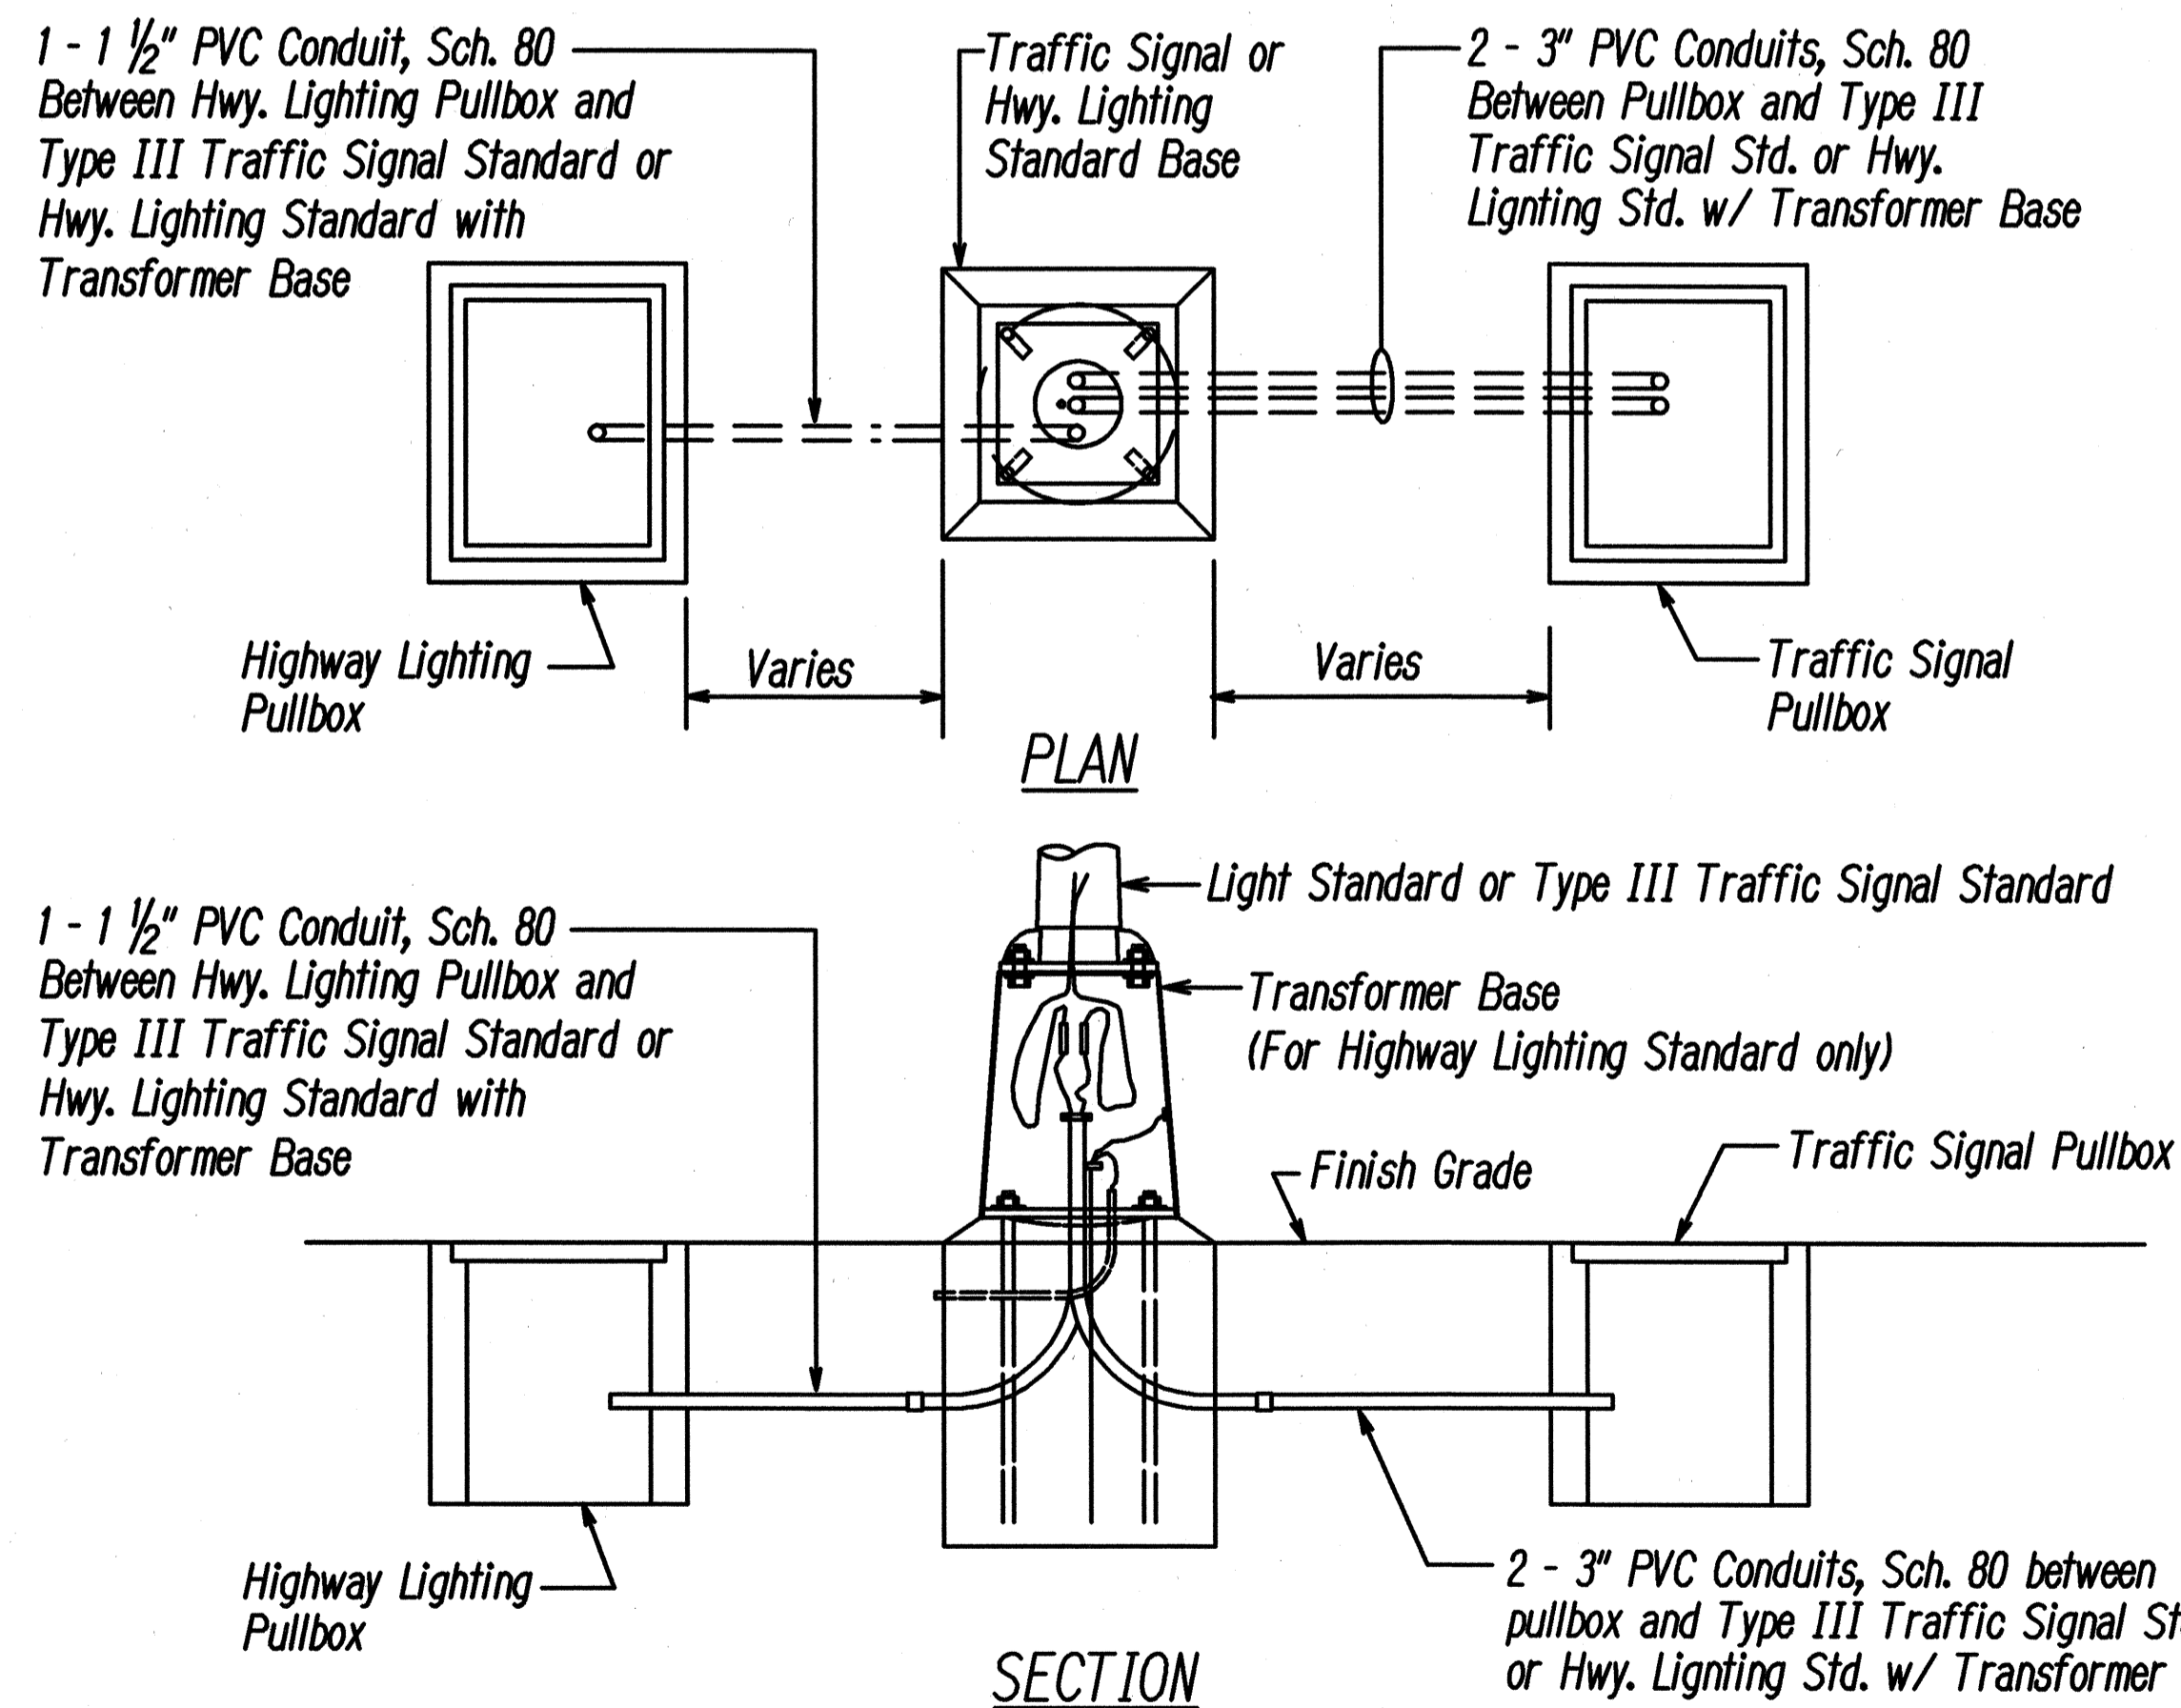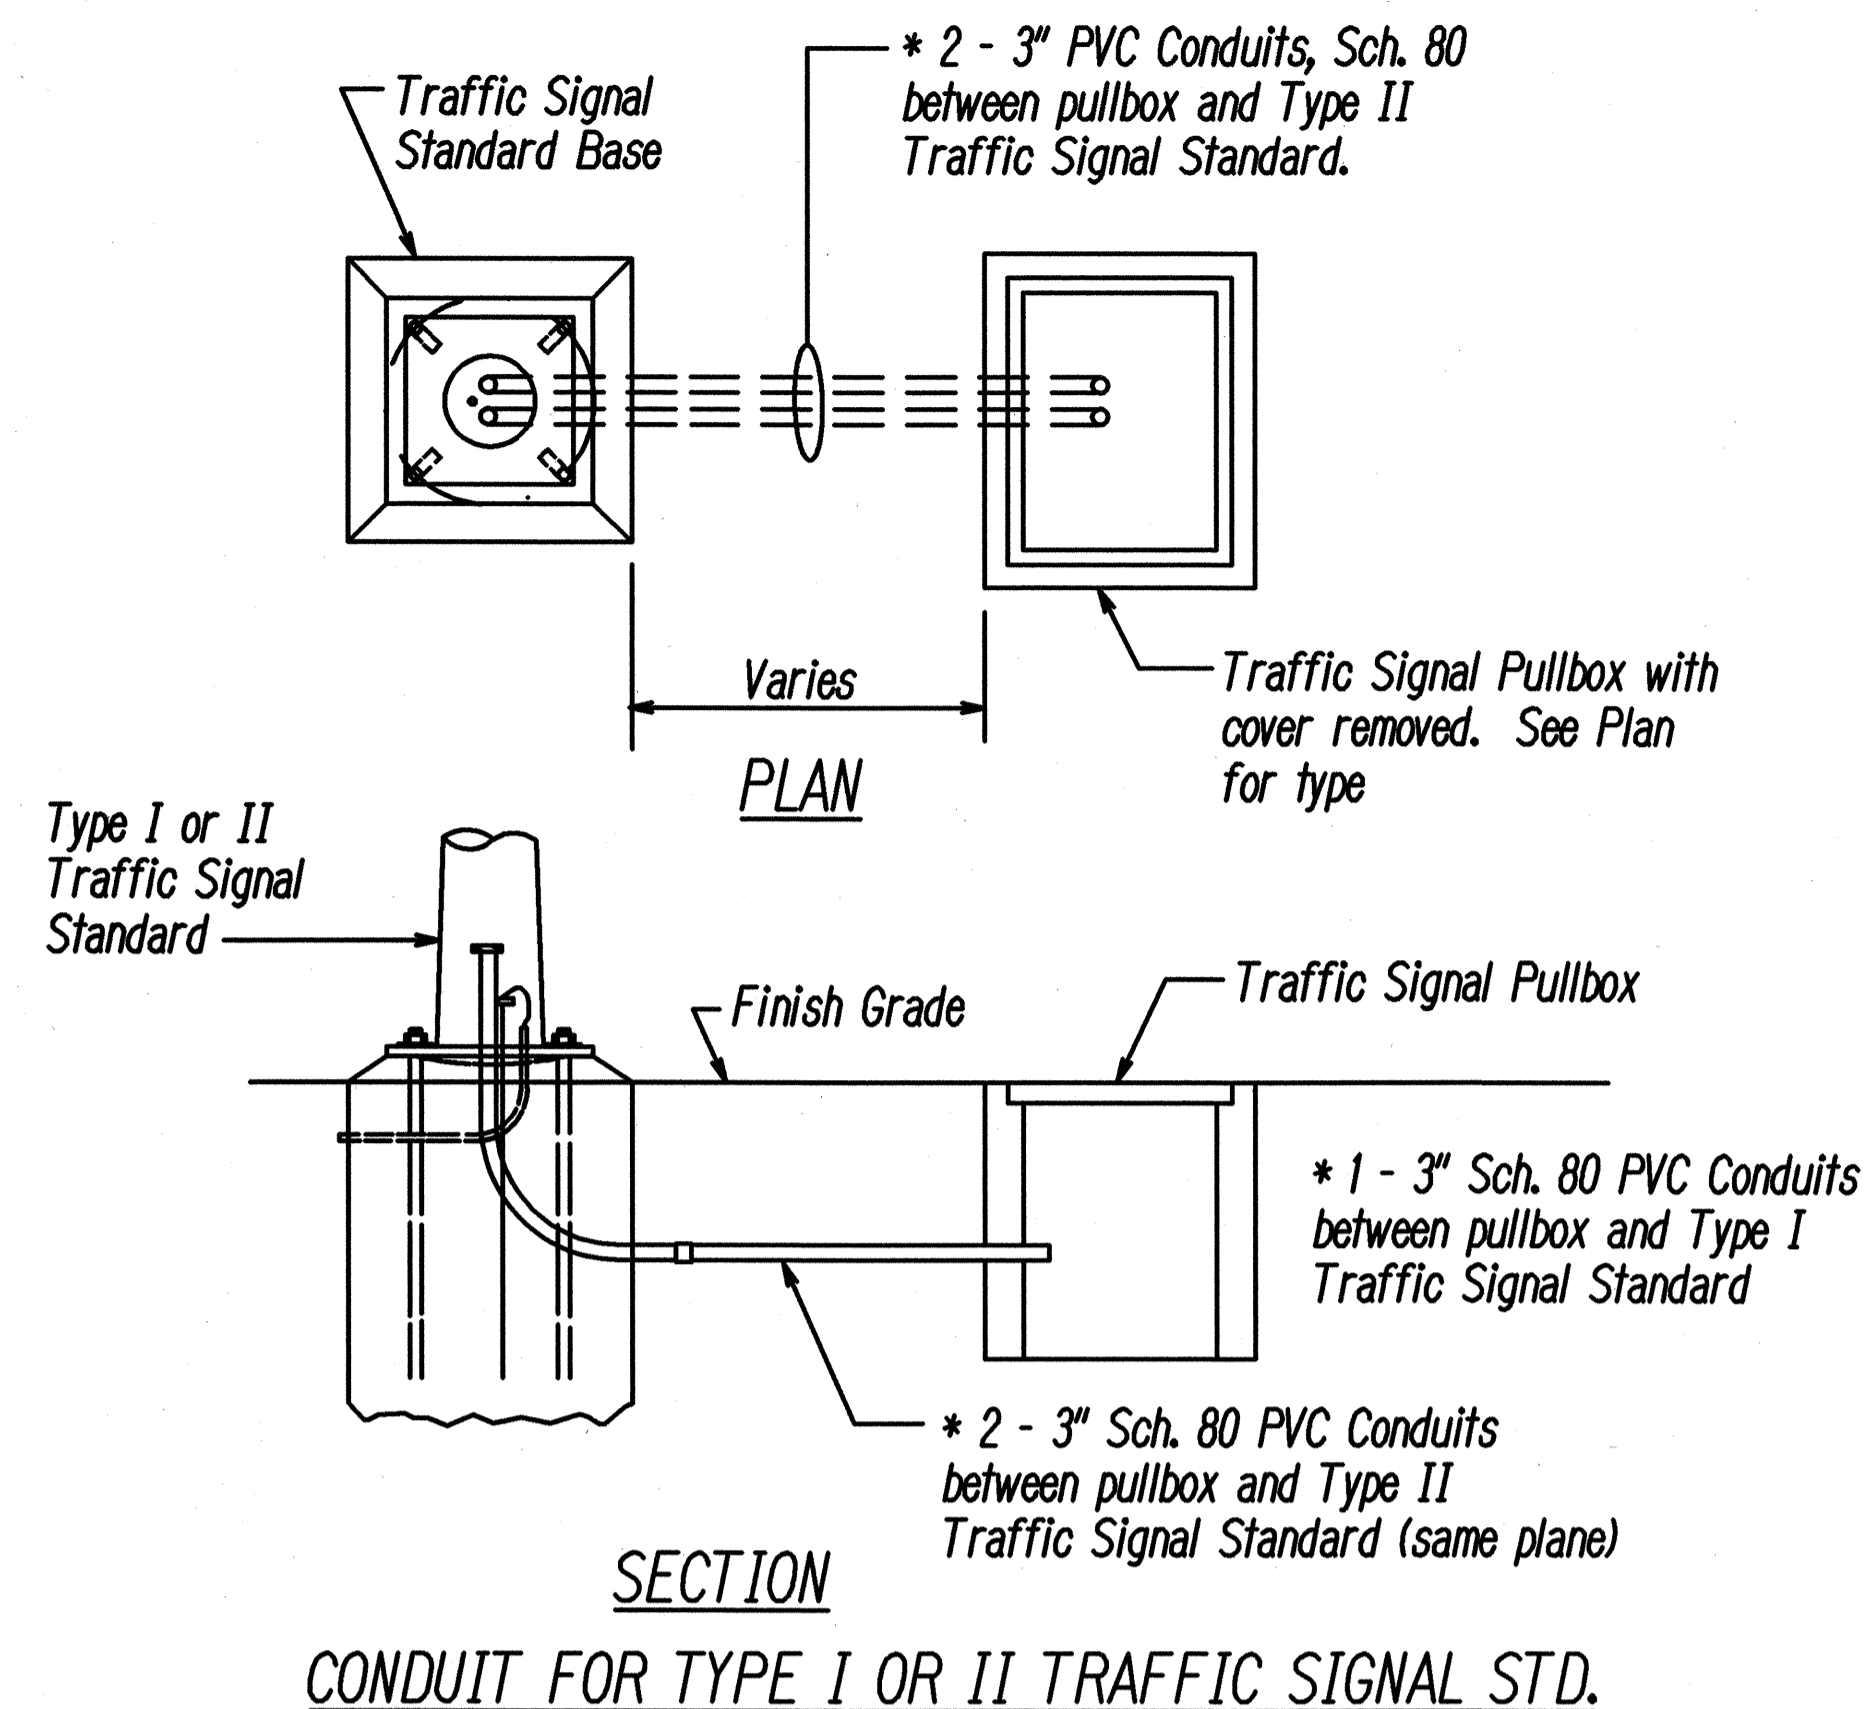


A
E-12
CONDUIT DETAILS FOR TRAFFIC SIGNAL/HWY. LIGHTING STANDARD
N.T.S.

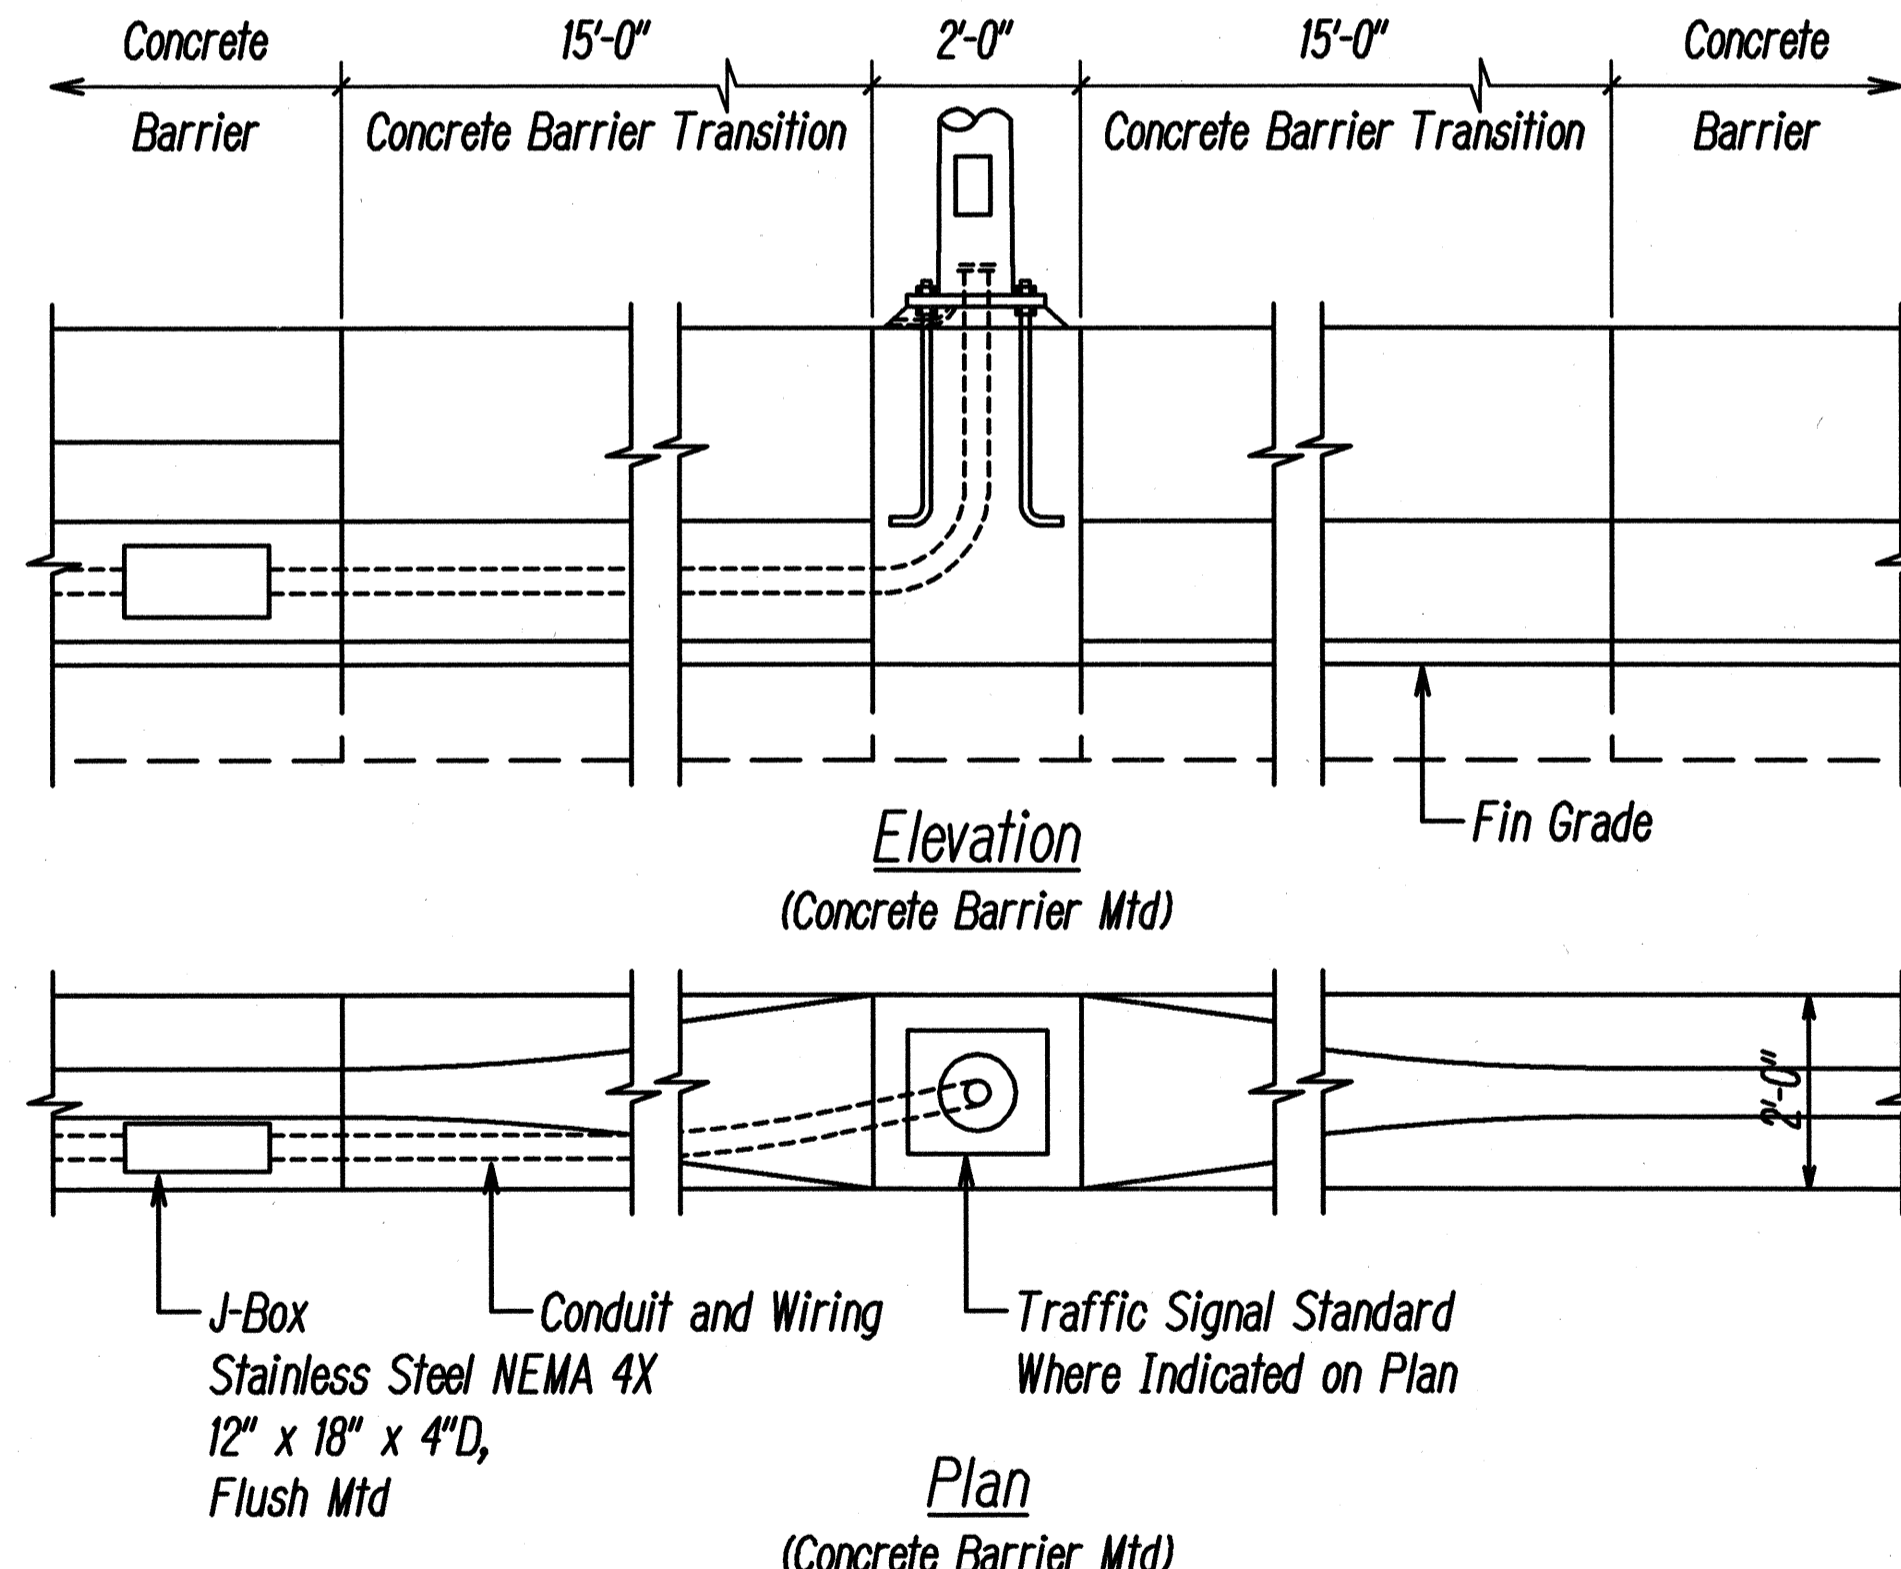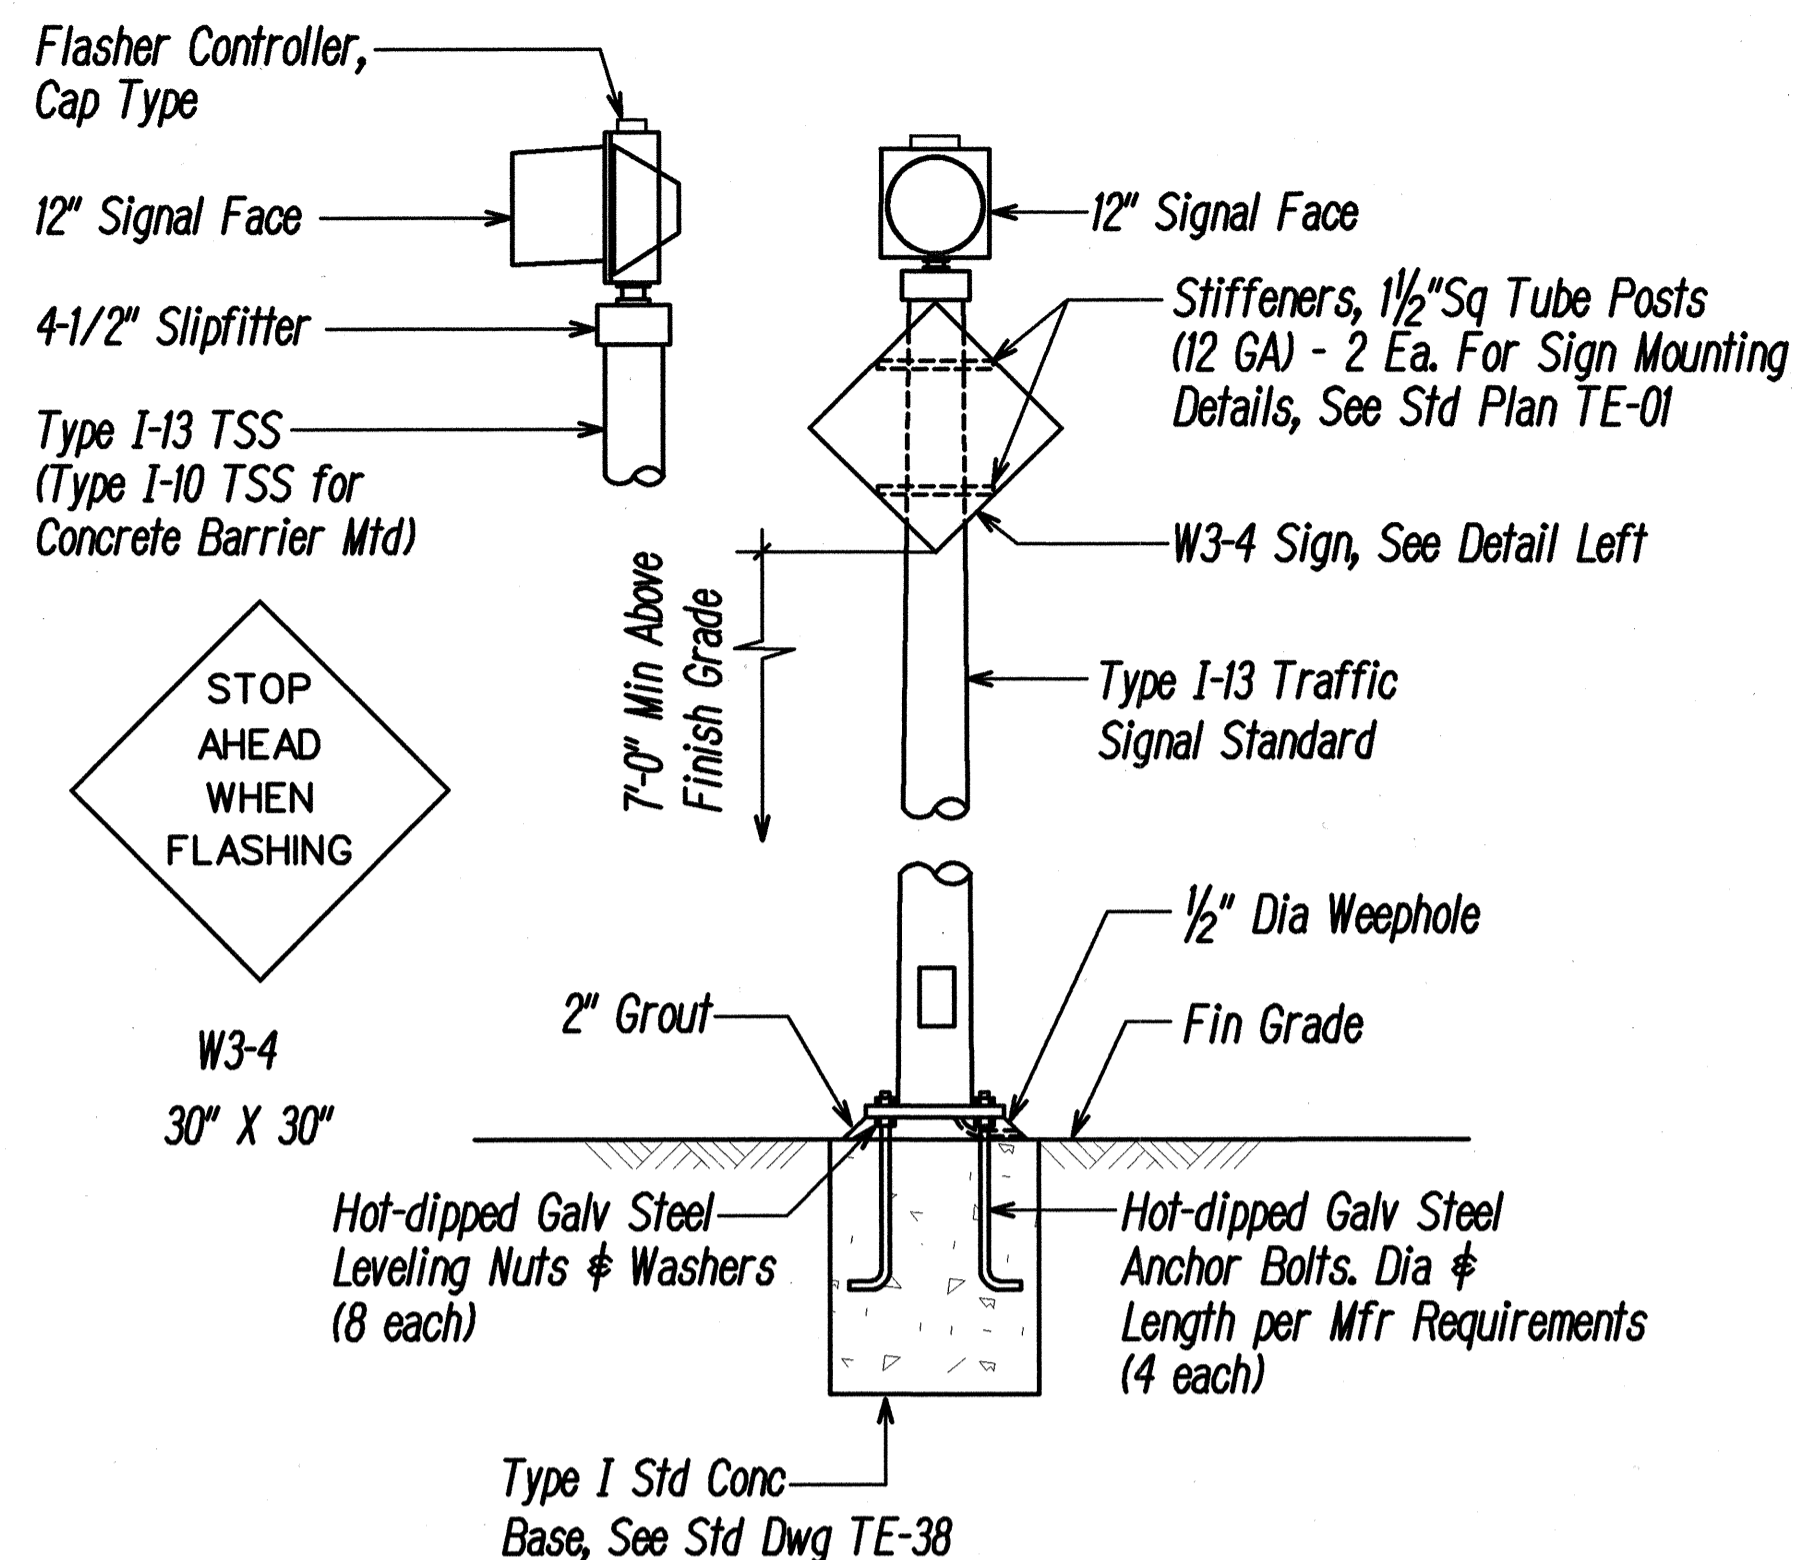


- Notes:
- J-Box and Standard shall be located Min 5'-0" From Expansion and Construction Joints.
 - Provide Expansion Couplings at Expansion Joints

B
E-12
STOP AHEAD WARNING FLASHER
Not To Scale

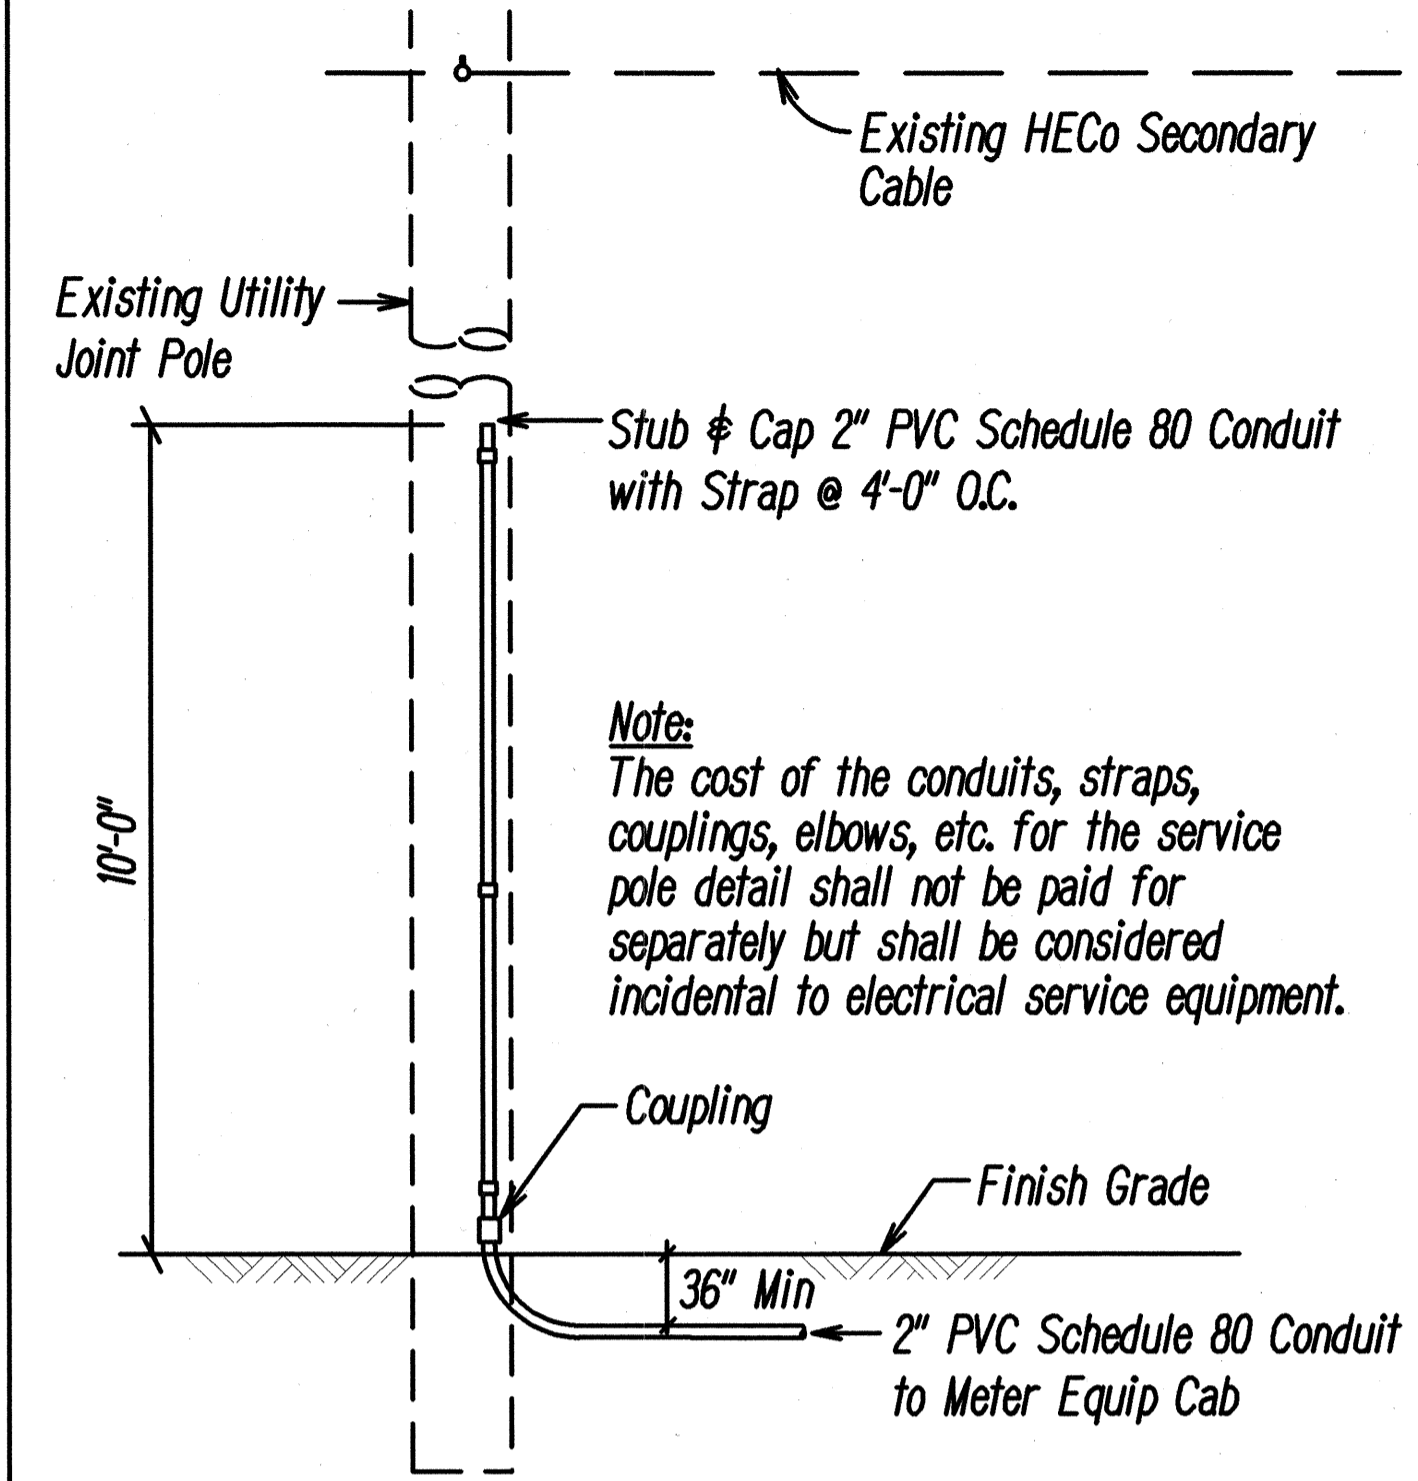

C
E-12
RISER POLE DETAIL
N.T.S.

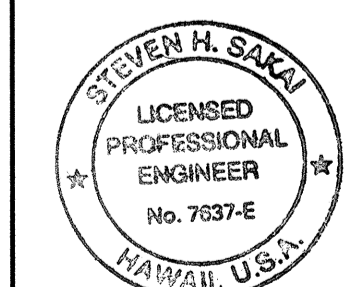

THIS WORK WAS PREPARED BY ME OR UNDER MY SUPERVISION
Steven H. Sakai


STATE OF HAWAII
DEPARTMENT OF TRANSPORTATION
HIGHWAYS DIVISION

TRAFFIC SIGNAL DETAILS

FARRINGTON HIGHWAY
Intersection Improvements at Waiomea Street
Project No. 93A-06-98
Scale: None Date: AUGUST 2000

SHEET No. E-12 OF 30 SHEETS



FED. ROAD DIST. NO.	STATE	PROJ. NO.	FISCAL YEAR	SHEET NO.	TOTAL SHEETS
HAWAII	HAW.	93A-06-98	2001	51	68

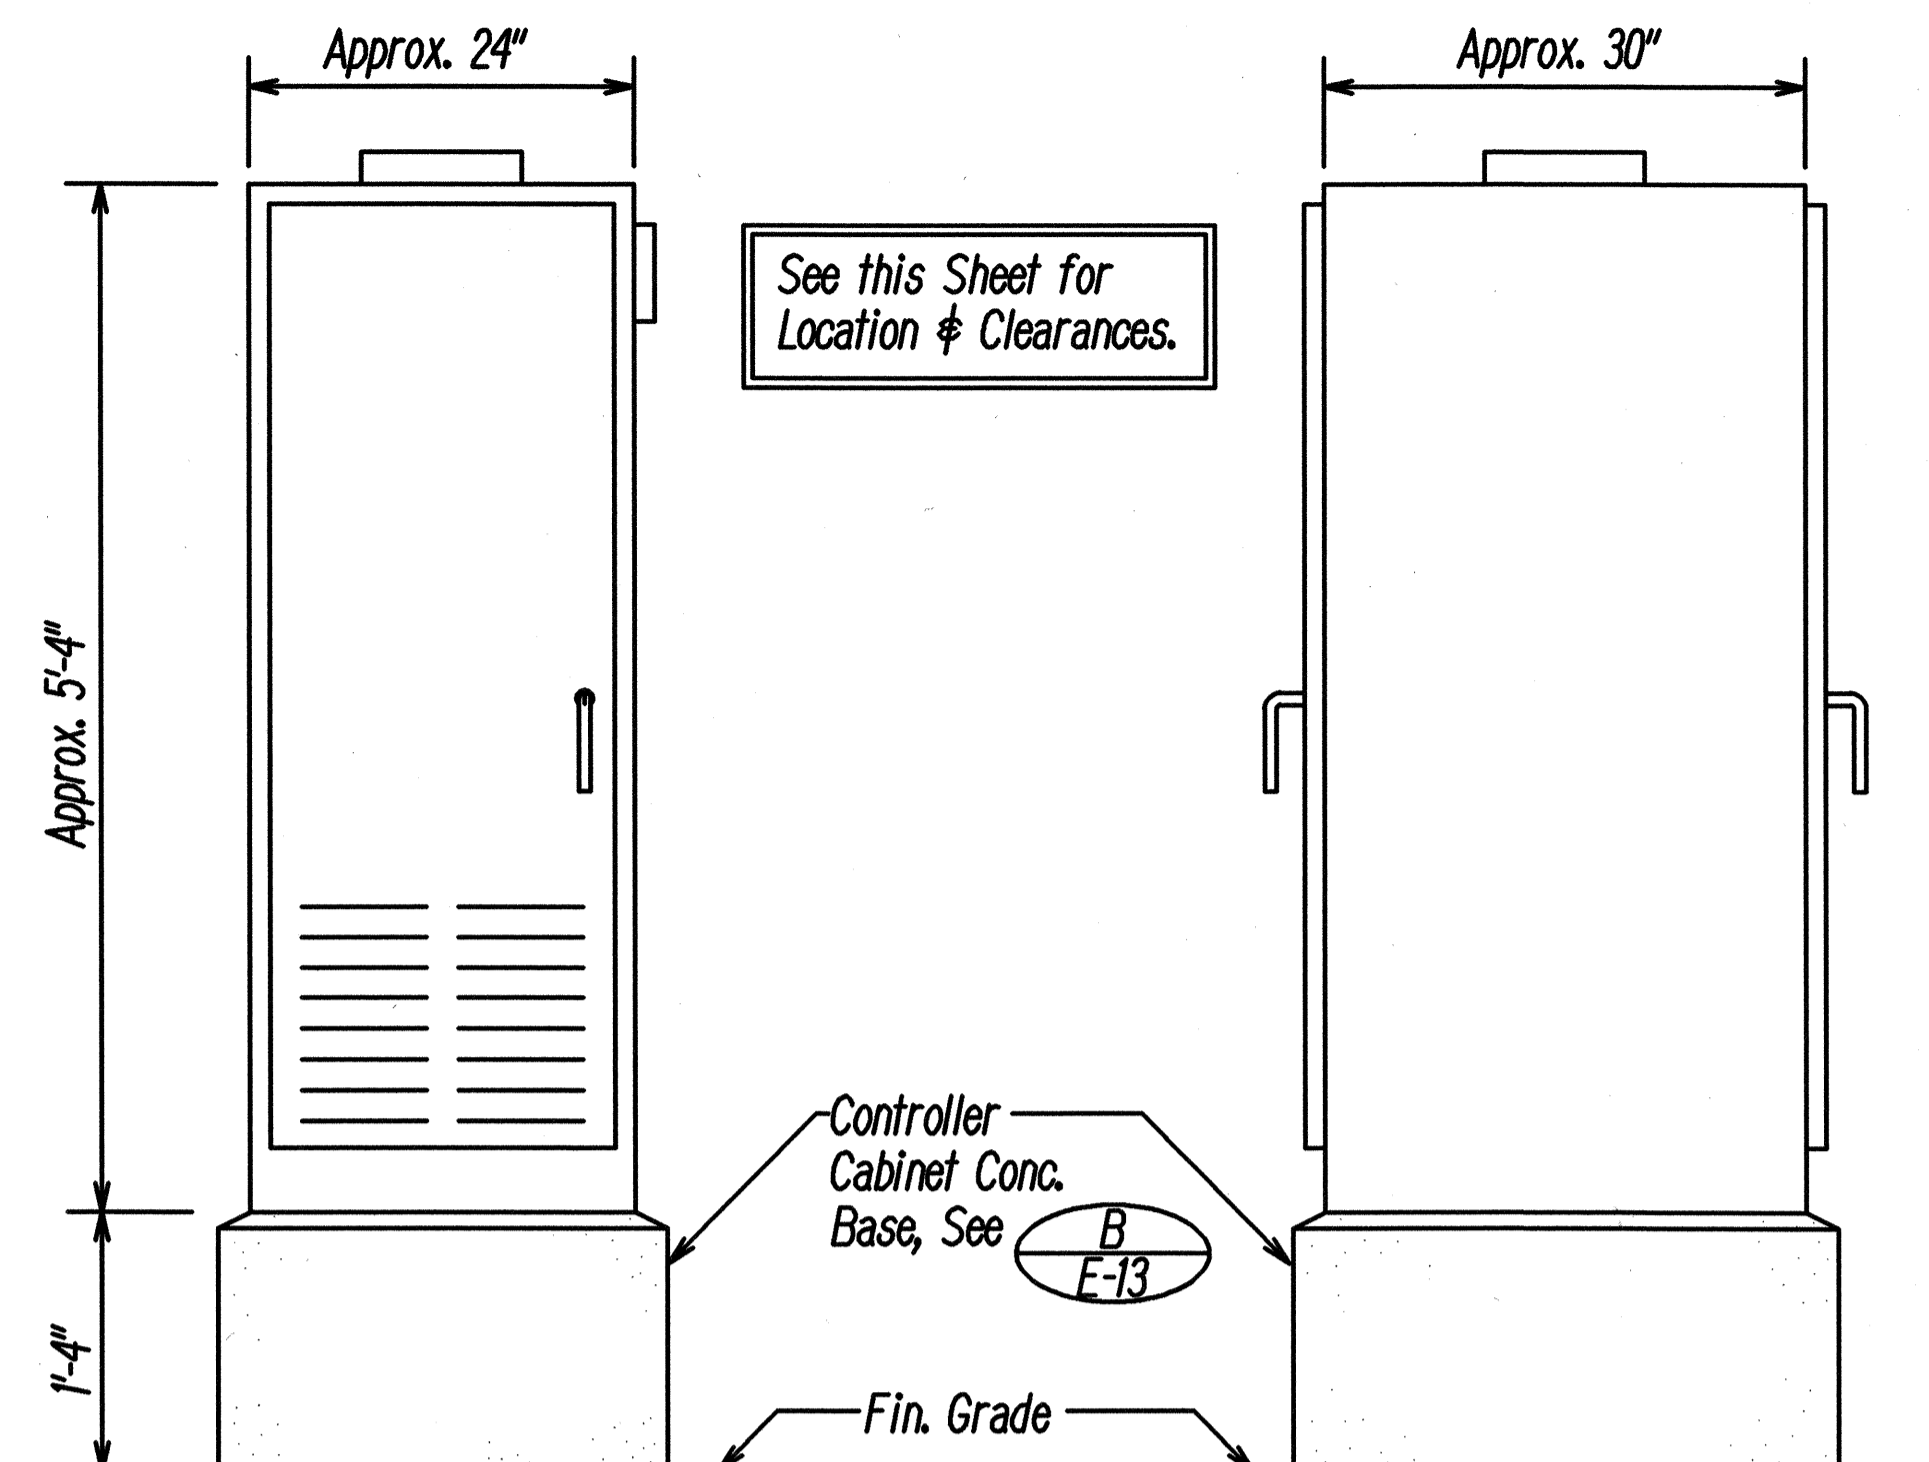

FRONT VIEW

SIDE VIEW

A
E-13 TYPE 332A TRAFFIC SIGNAL CONTROLLER CABINET
DETAIL
N.T.S.

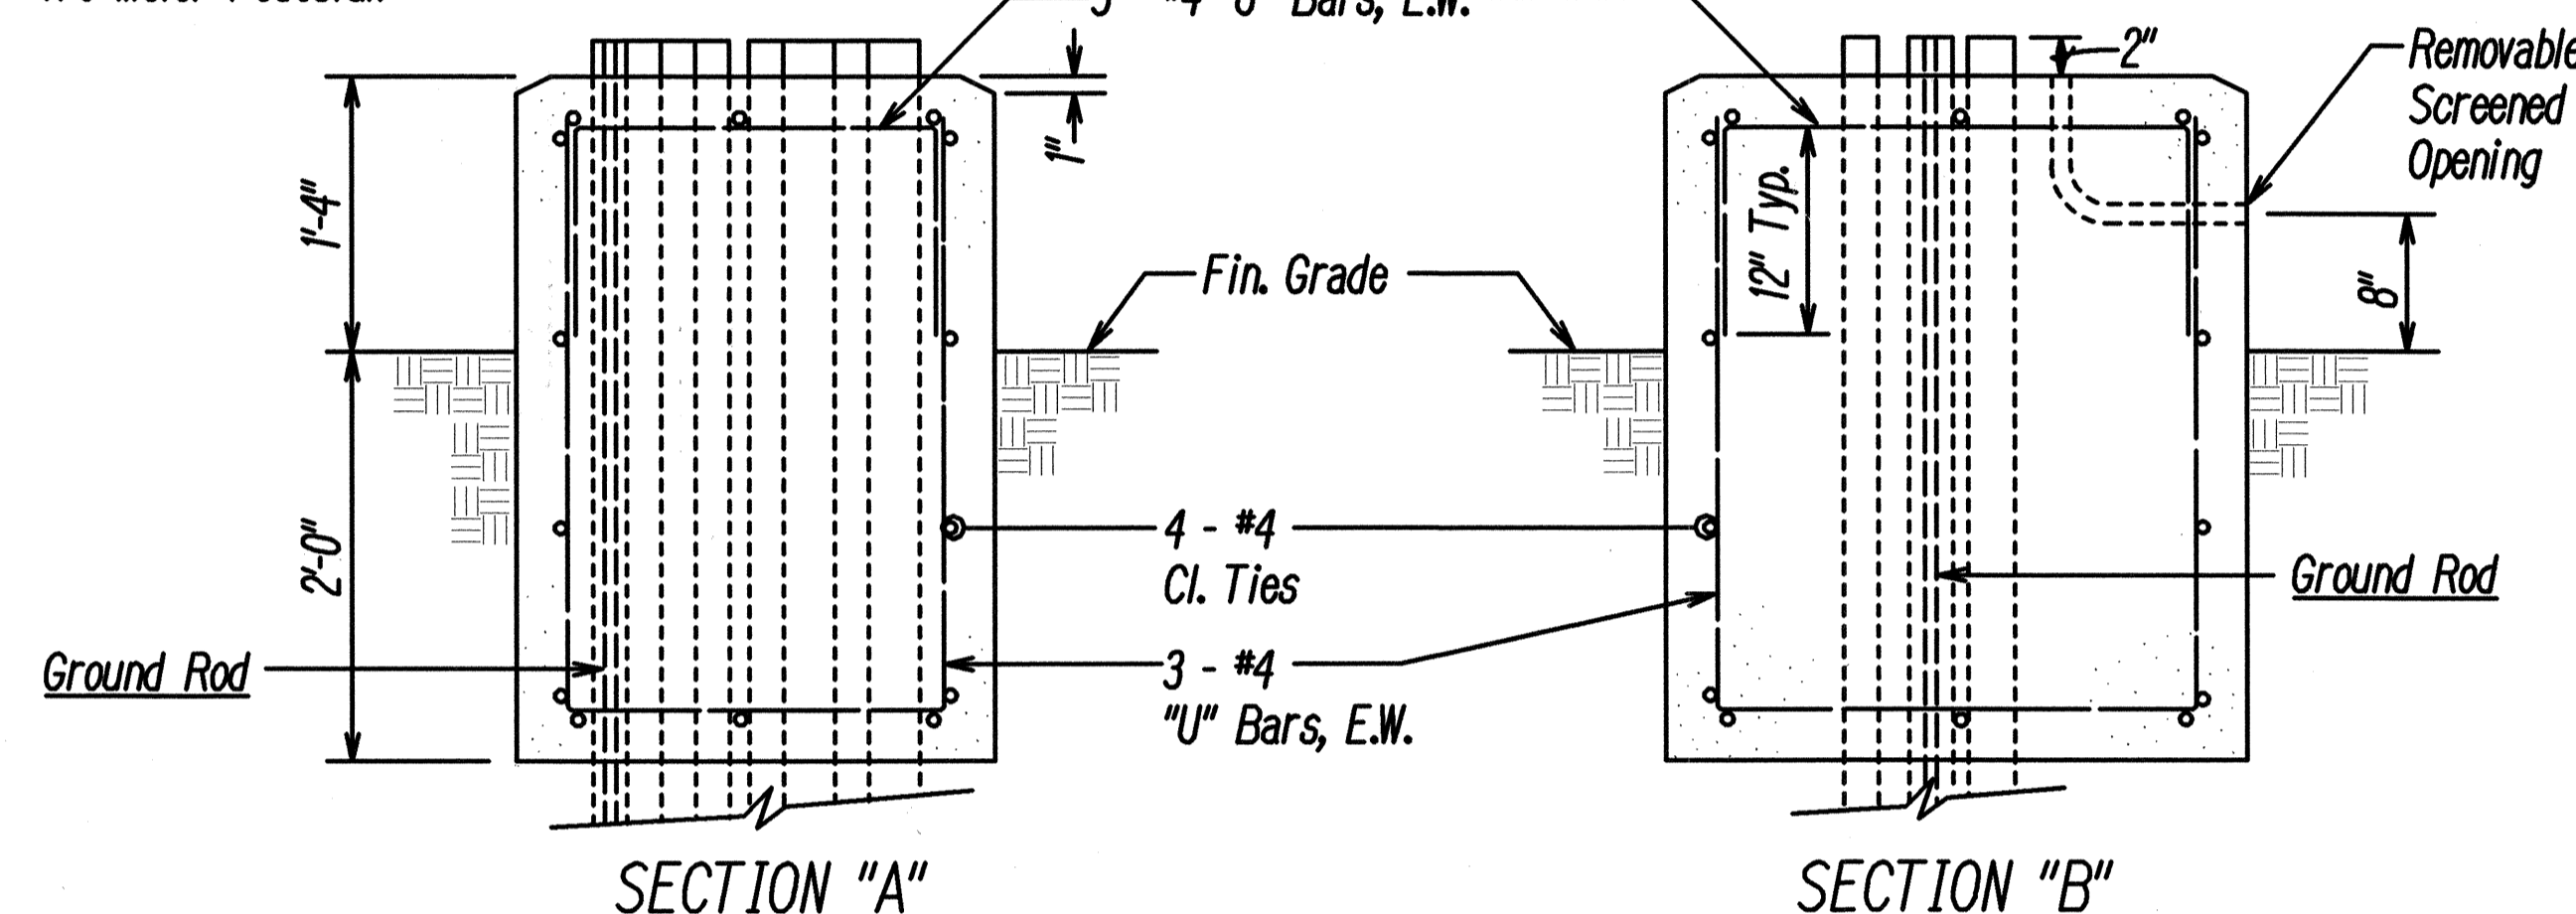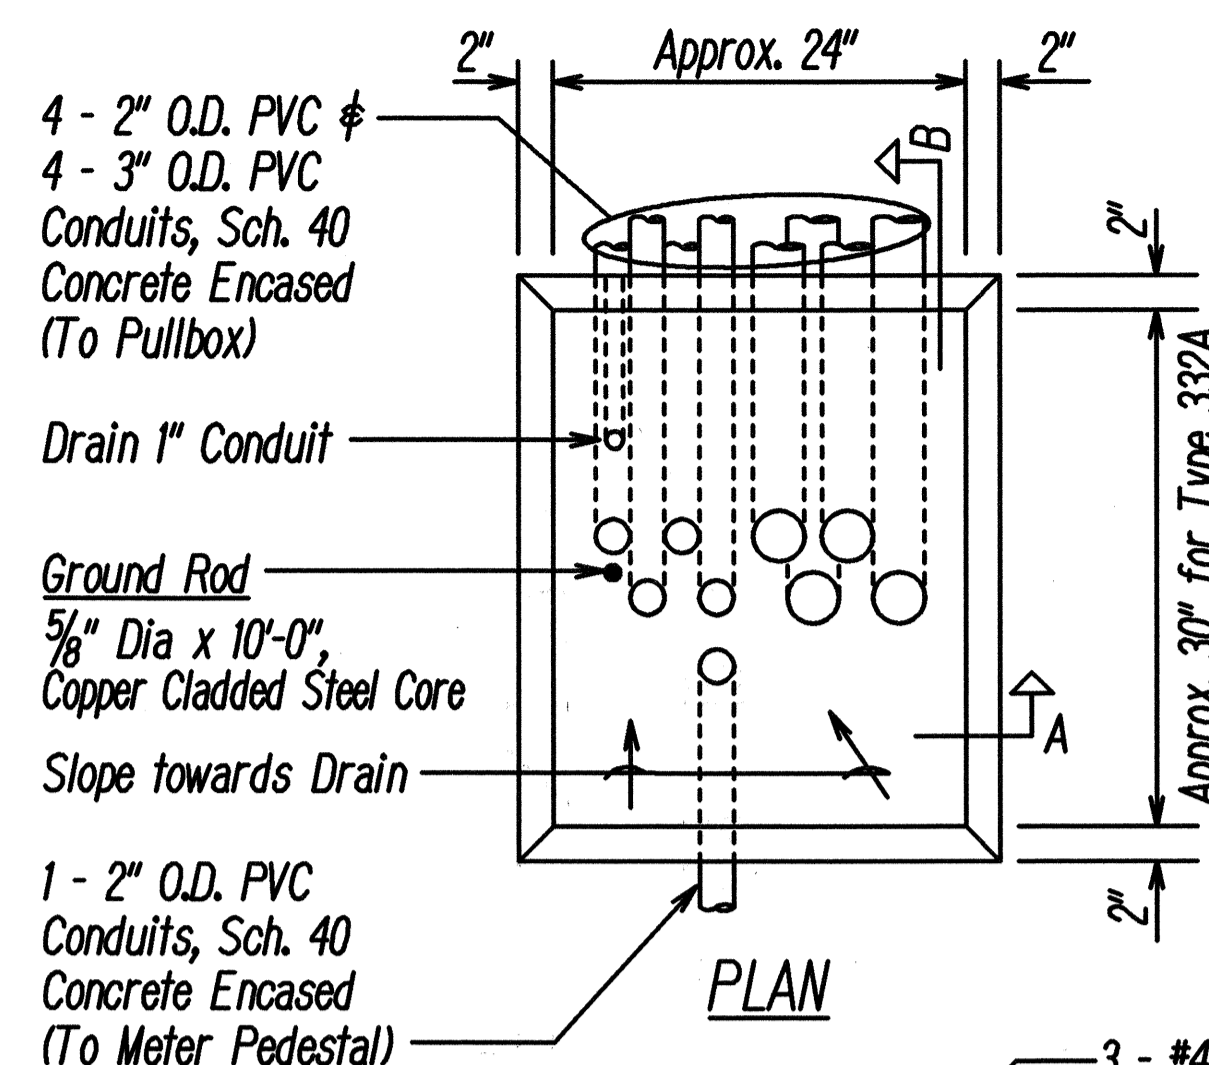


SECTION "A"

SECTION "B"

B
E-13 CONTROLLER CABINET CONCRETE BASE
N.T.S.

NOTES:


- Concrete shall be class "B".
- Dimensions shall be altered to suit controller cabinet actually furnished.
- Conduits bends and drain are incidental to concrete base
- Refer to Cabinet Manufacturer's Specifications for details of anchor bolts and base setting.
- All exposed surfaces of concrete base shall be given a class 2, rubbed finish.

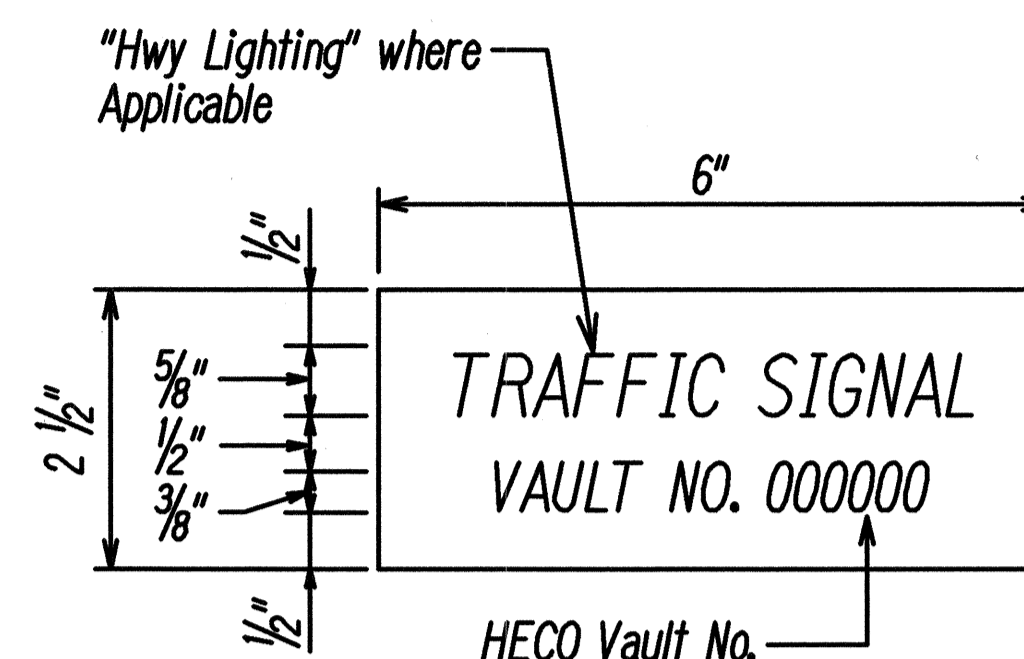

NOTES:

- Use 3-ply laminated flexible plastic, black-white-black thickness: black cap sheet - 0.010", white base sheet - 0.052", black base sheet - 0.010".
- Attach to Meter Socket using Scotch 3M Brand very high bond (VHB) double coated acrylic foam tape or equivalent.
- Letters/Numbers shall be 1/16" stroke, (white in color).
- Letters/Numbers area inscribed by cutting through "black cap sheet" to expose white letters/numbers.

C
E-13 METER I.D. TAG DETAIL
N.T.S.

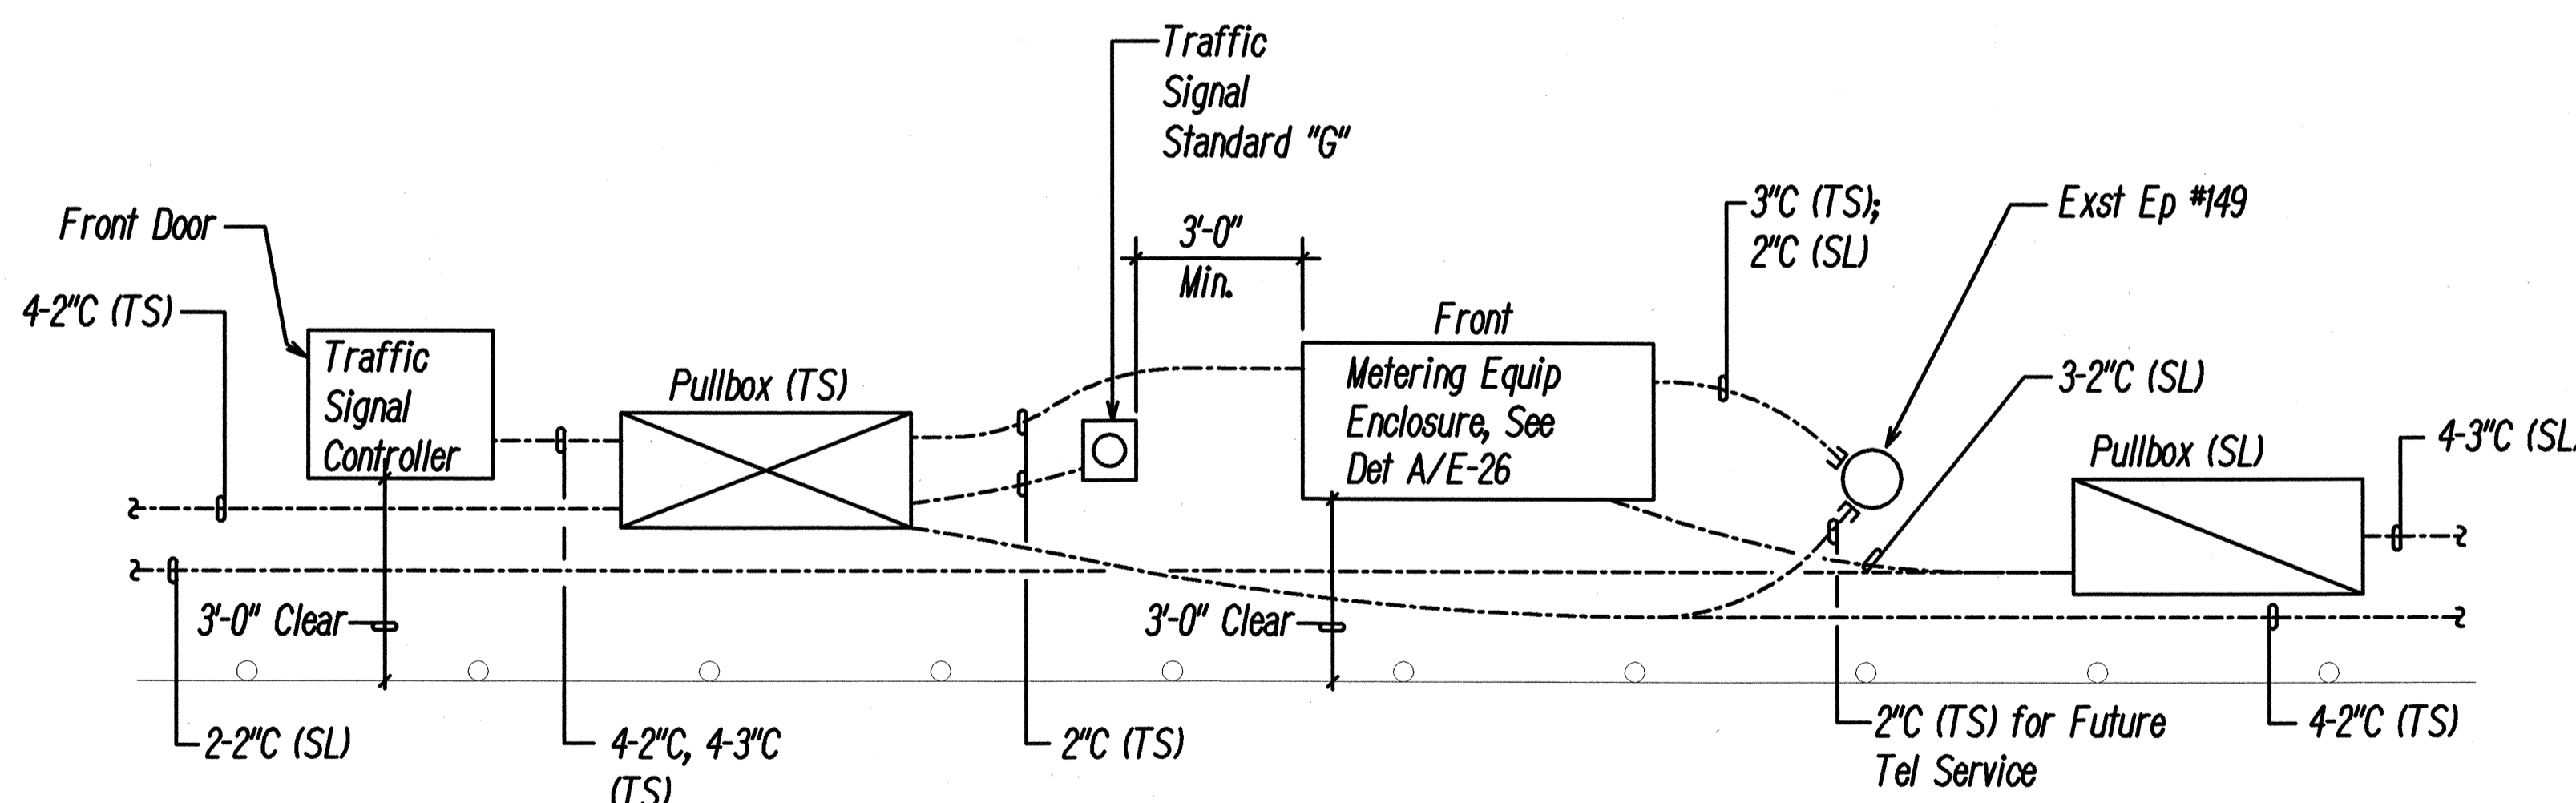


Notes:

- Controller & Meter Equipment Enclosure shall be 36" Clear from Guardrail
- See Plans for Wiring Requirements
- See Sht E-24 for One-Line Diagram

D
E-13 ENLARGED EQUIPMENT PLAN
N.T.S.

DESIGNED BY	DATE
CHECKED BY	
NOTED BY	
QUANTITIES BY	
REVISIONS	

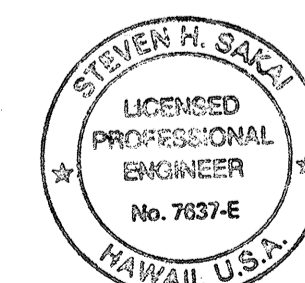

THIS WORK WAS PREPARED BY ME
OR UNDER MY SUPERVISION
Steven H. Sakai

STATE OF HAWAII
DEPARTMENT OF TRANSPORTATION
HIGHWAYS DIVISION



TRAFFIC SIGNAL DETAILS

FARRINGTON HIGHWAY
Intersection Improvements at Waiomea Street
Project No. 93A-06-98


Scale: Shown Date: AUGUST 2000

SHEET No. E-13 OF 30 SHEETS

FED. ROAD DIST. NO.	STATE	PROJ. NO.	FISCAL YEAR	SHEET NO.	TOTAL SHEETS
HAWAII	HAW.	93A-06-98	2001	52	68

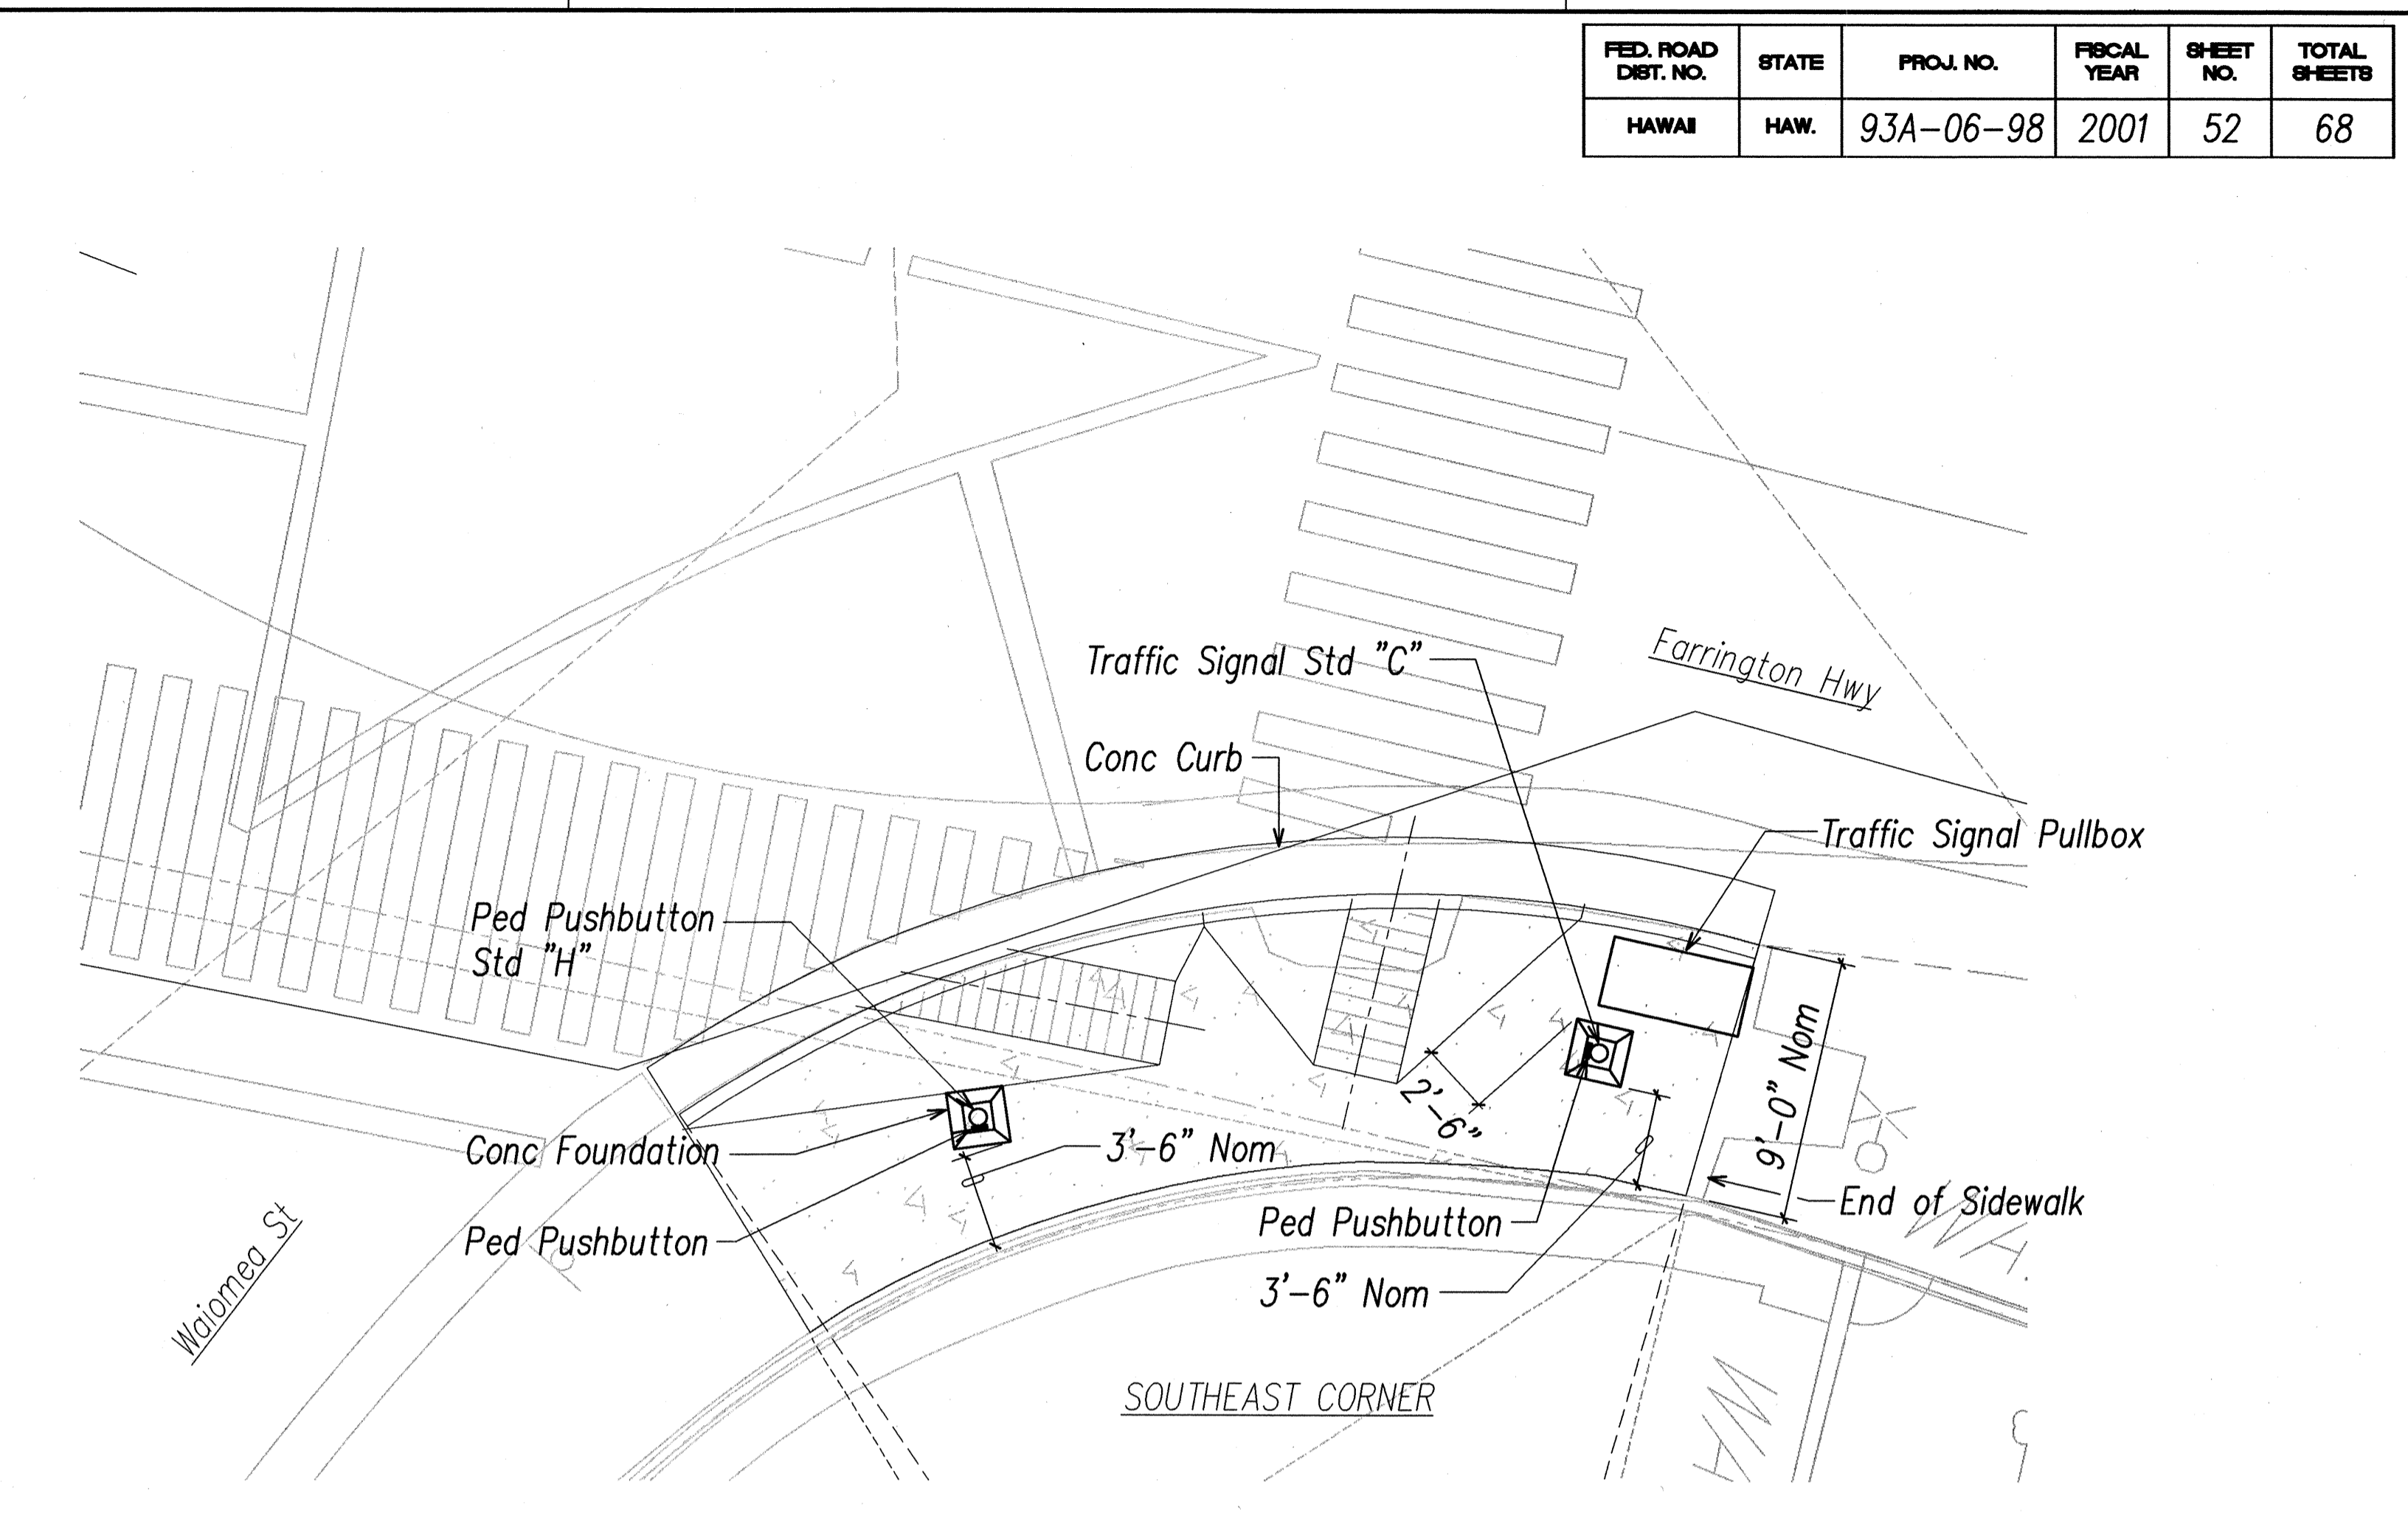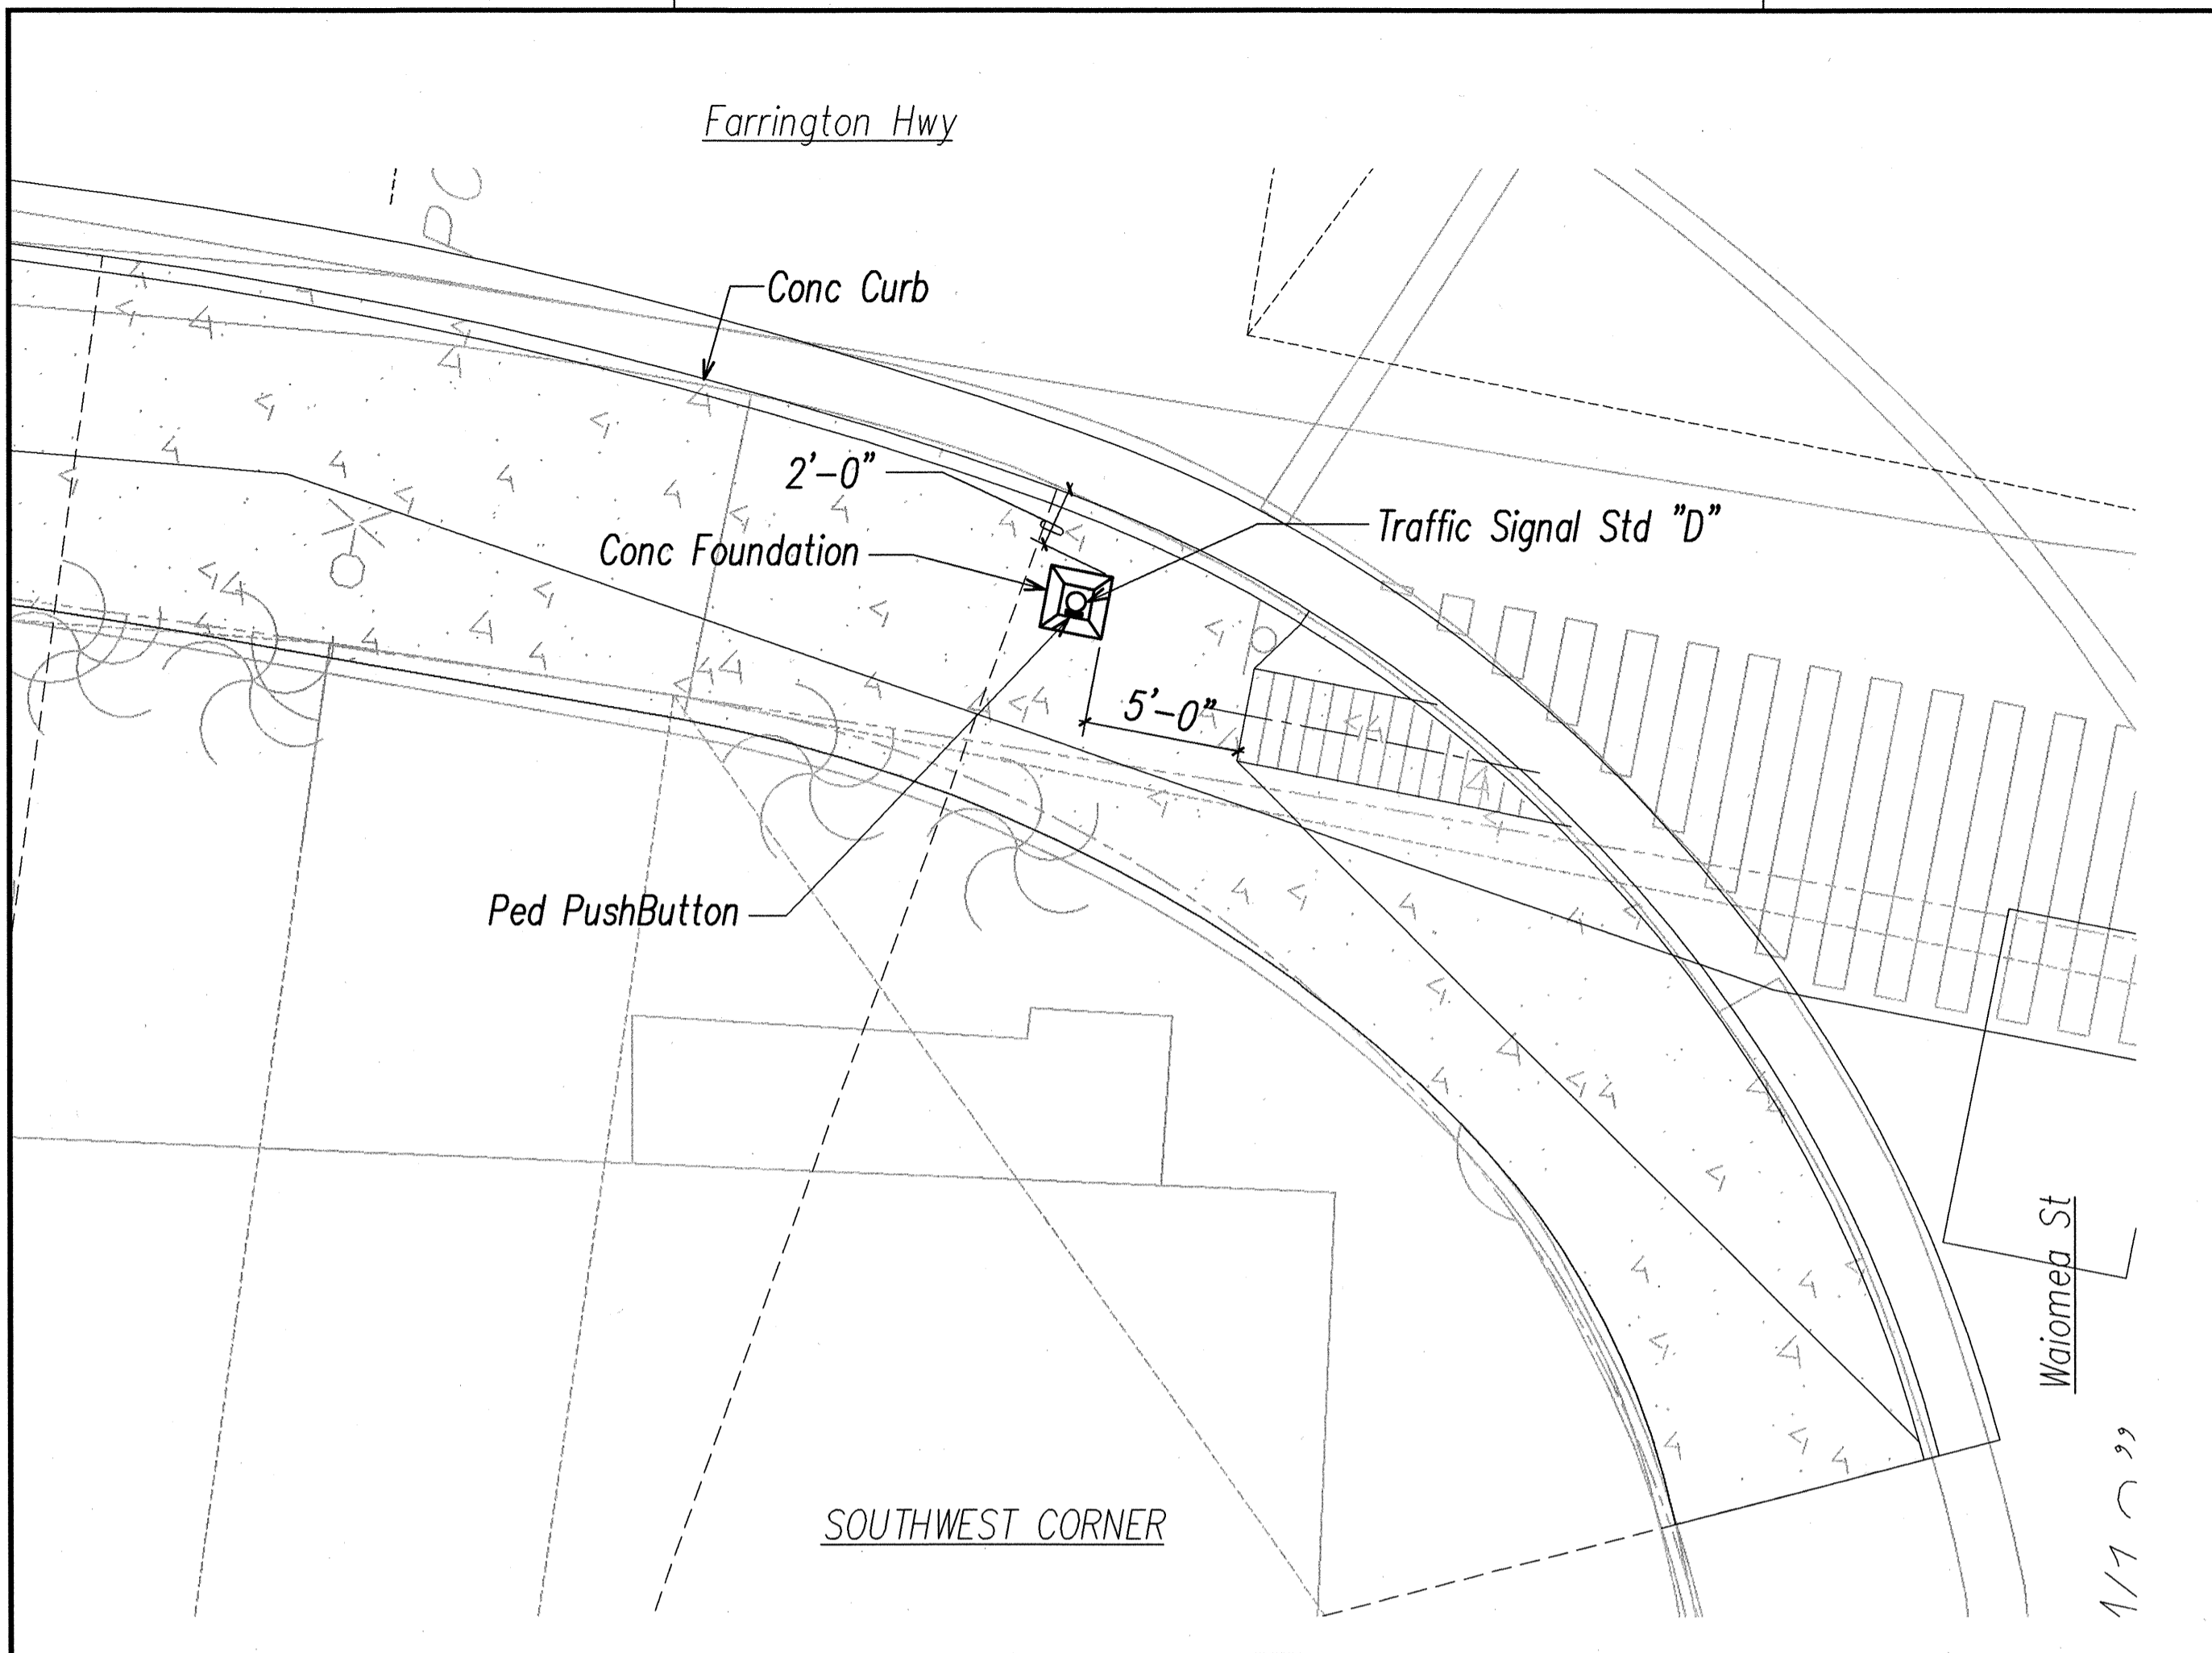


PEDESTRIAN PUSHBUTTON ORIENTATION DETAILS
NOT TO SCALE

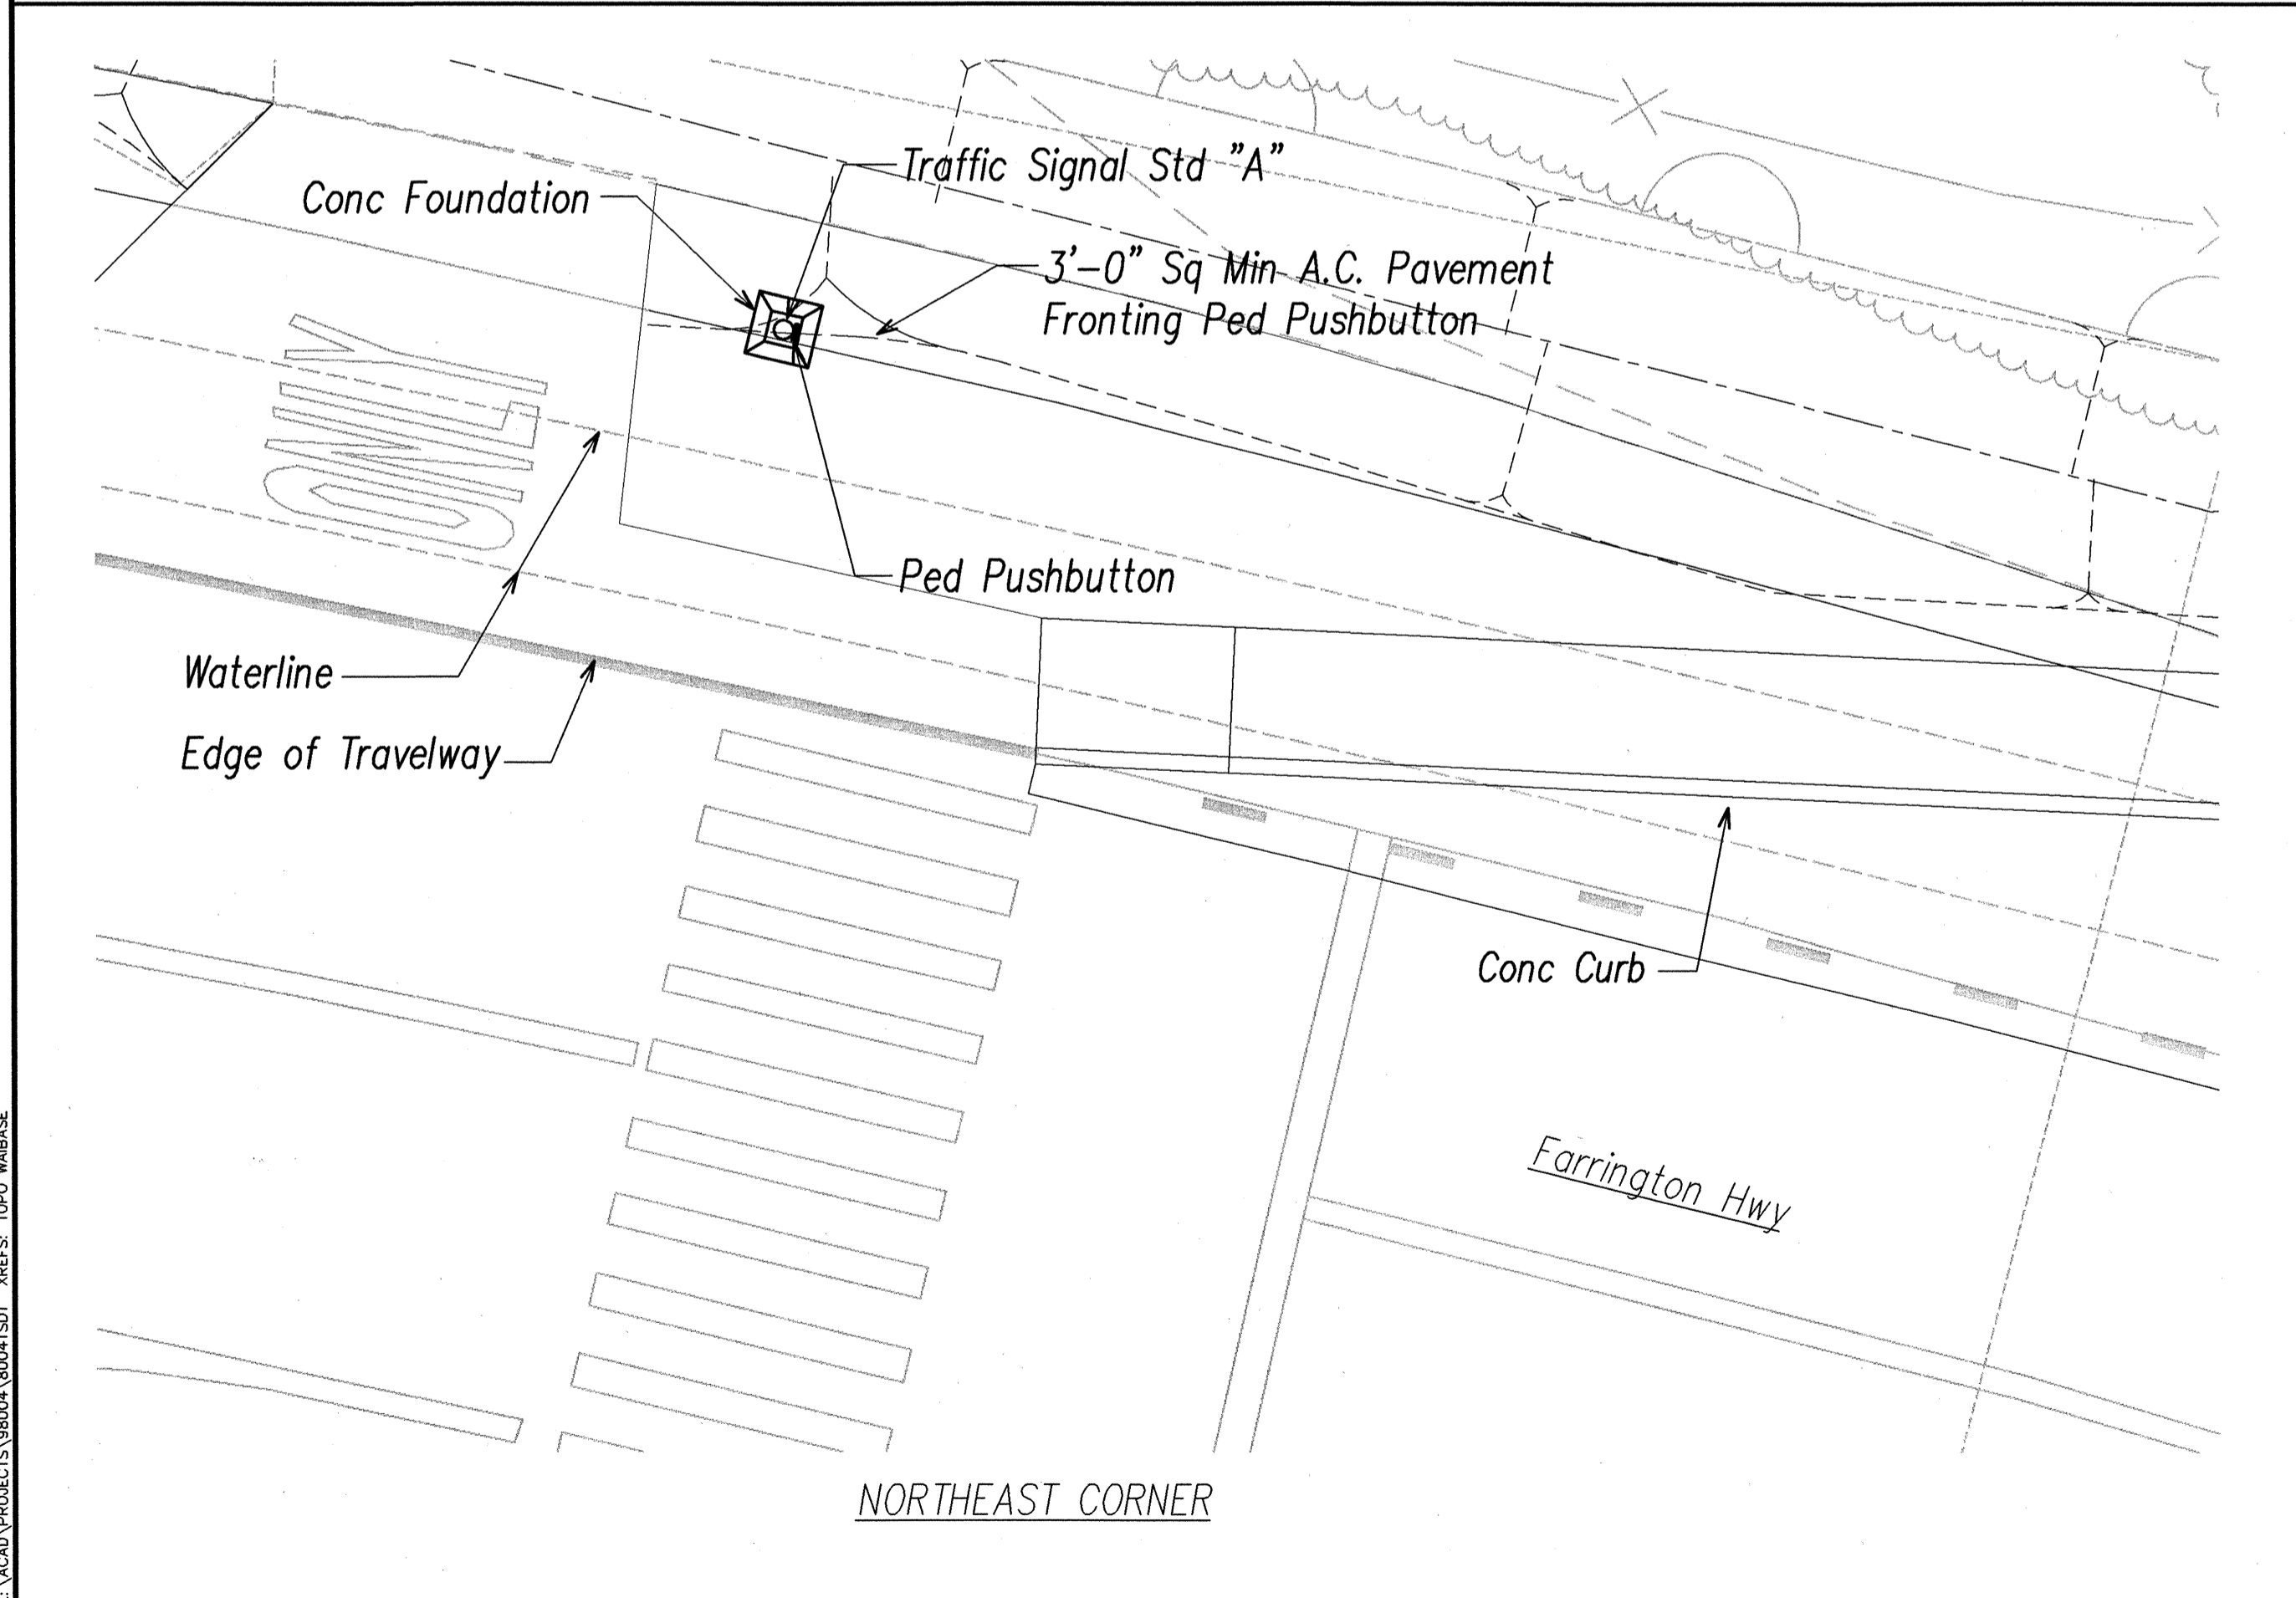

ORIGINAL PLAN	SURVEY PLOTTED BY	DATE
NOTE BOOK	DRAWN BY	
	TRACED BY	
	DESIGNED BY	
	QUANTITIES BY	
	CHECKED BY	
No.		

LAST SAVE: 08/09/00 @ 08:37:49 BY: TE PLOT SC 1-15
Z:\ACAD\PROJECTS\9300A\9304TSD1.DWG: TPO WABASE

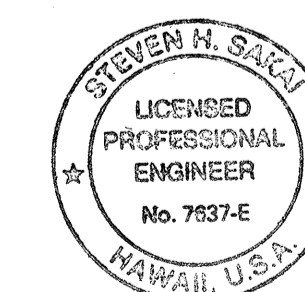


THIS WORK WAS PREPARED BY ME
OR UNDER MY SUPERVISION
Steven H. Saka

STATE OF HAWAII
DEPARTMENT OF TRANSPORTATION
HIGHWAYS DIVISION
TRAFFIC SIGNAL DETAILS

FARRINGTON HIGHWAY
Intersection Improvements at Waiomea Street
Project No. 93A-06-98
Scale: None Date: AUGUST 2000
SHEET No. E-14 OF 30 SHEETS

52

FED. ROAD DIST. NO.	STATE	PROJ. NO.	FISCAL YEAR	SHEET NO.	TOTAL SHEETS
HAWAII	HAW.	93A-06-98	2001	53	68

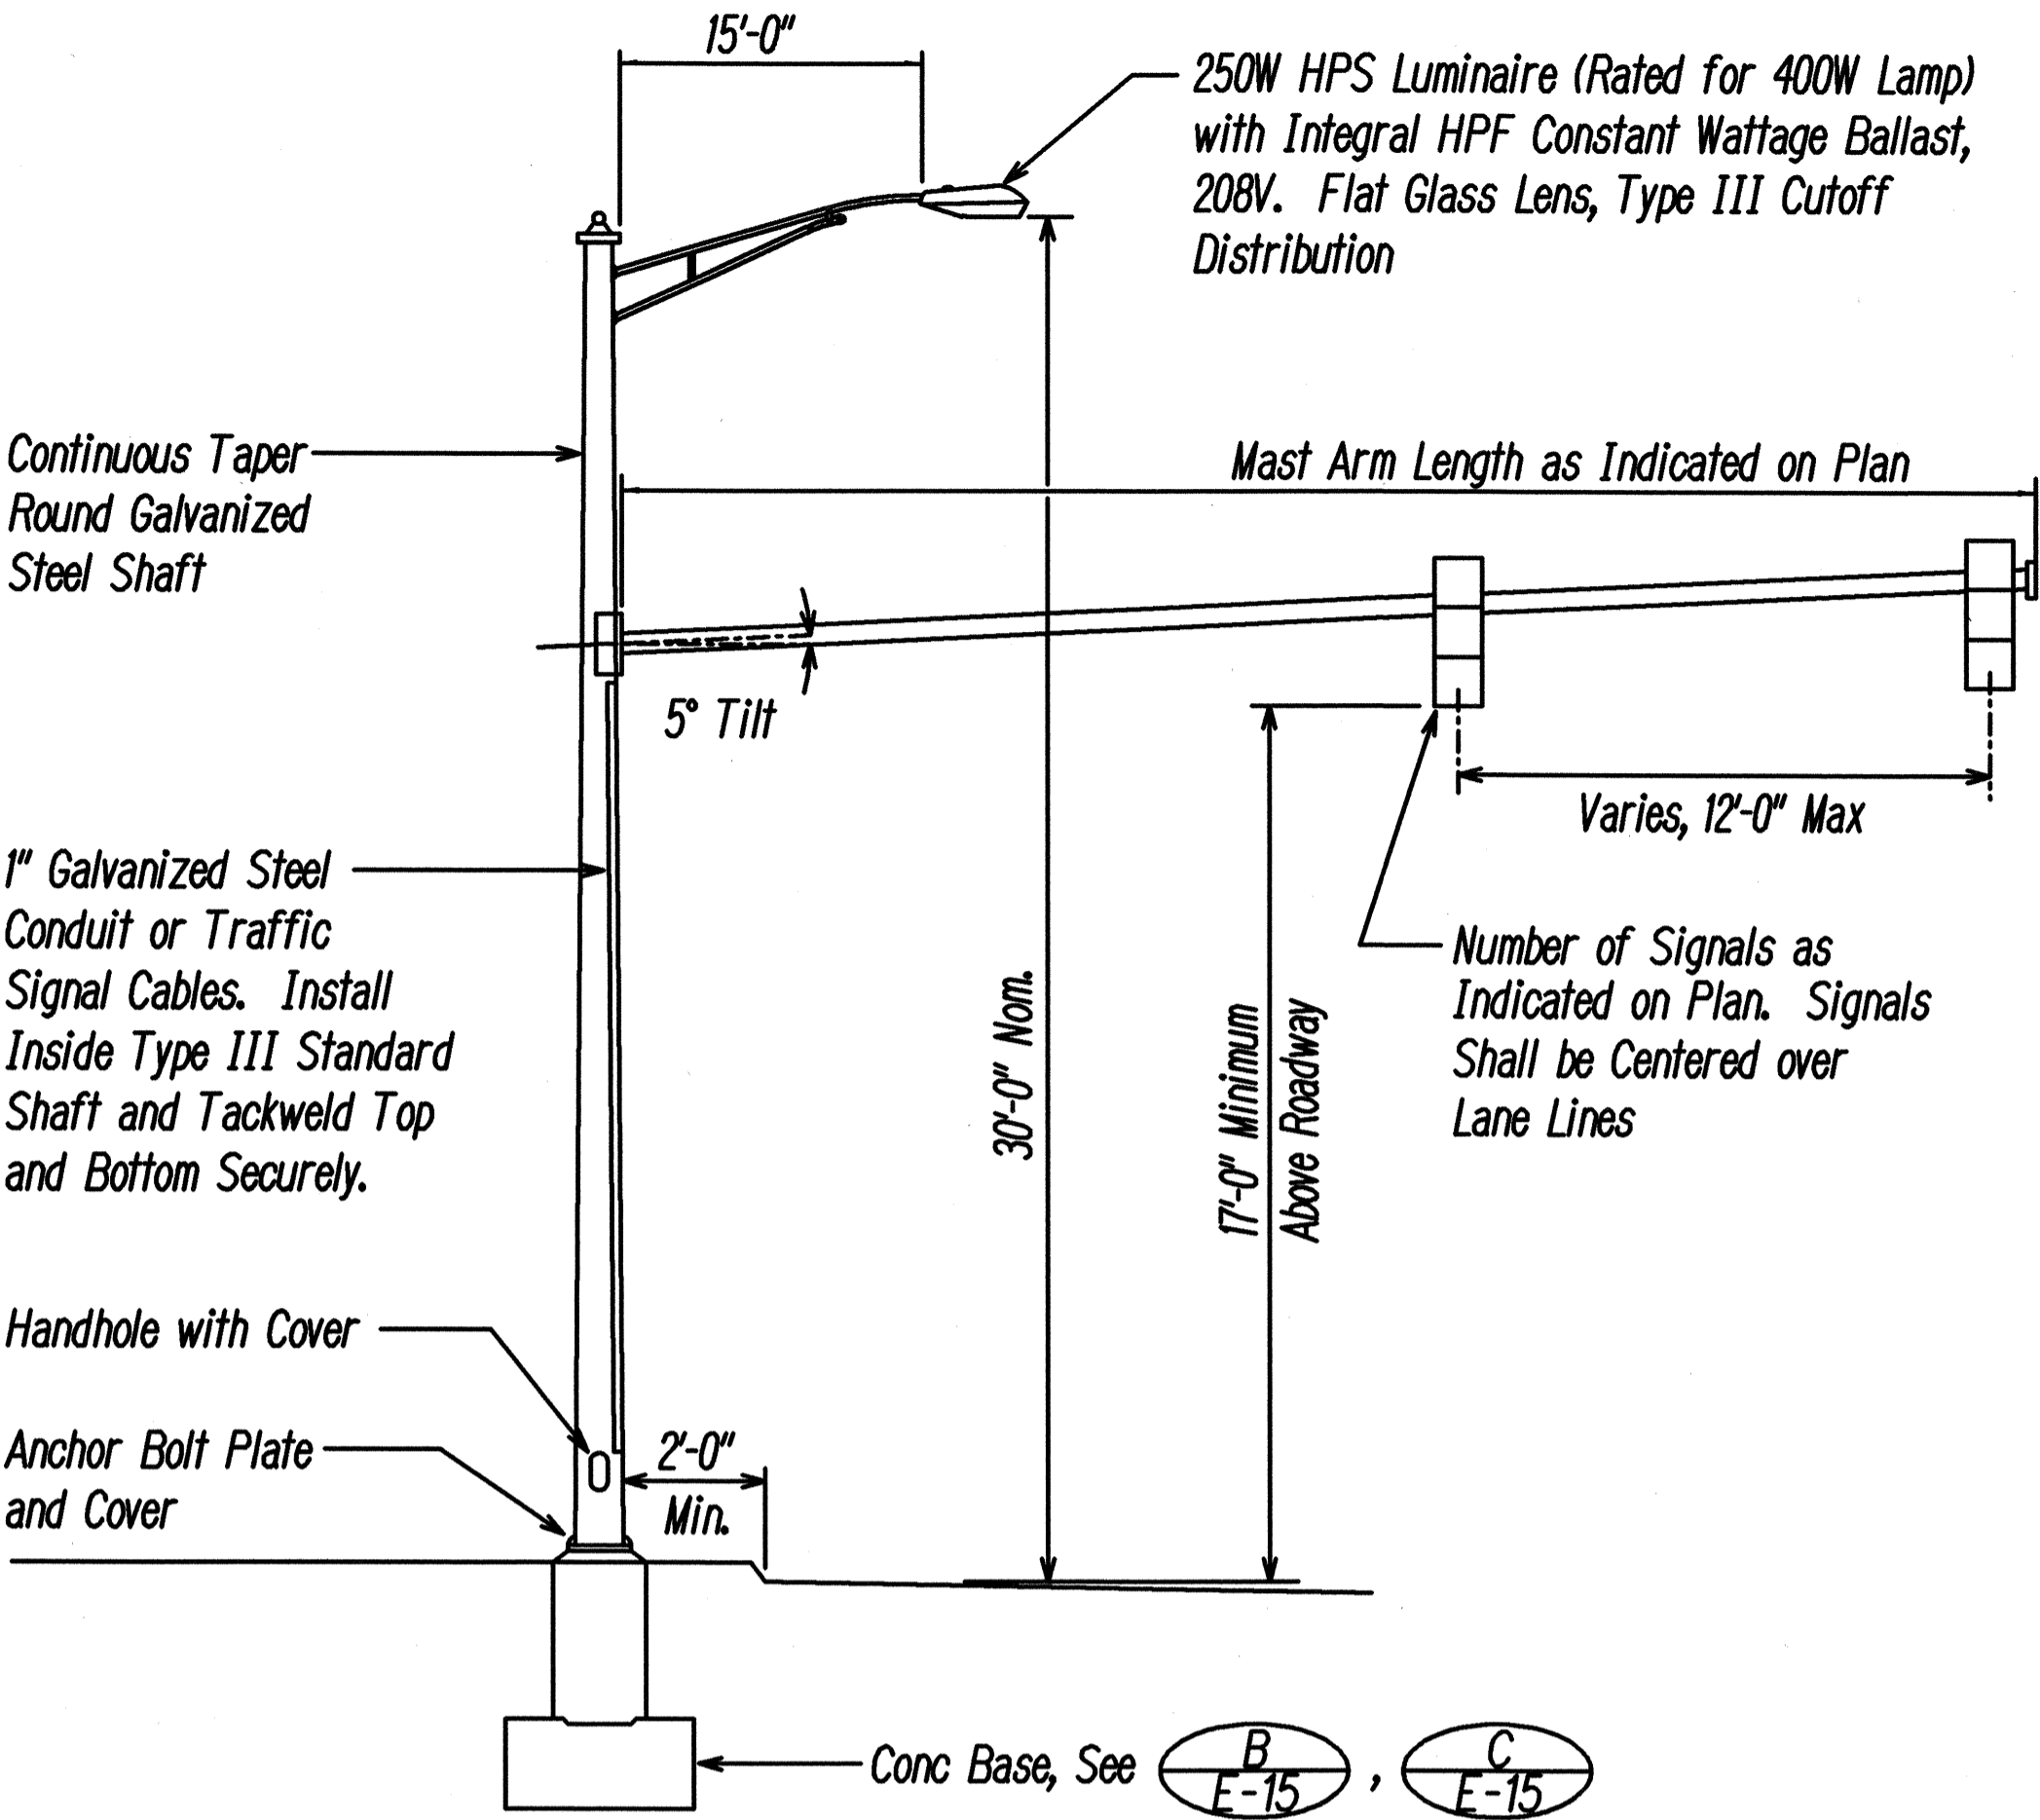

ELEVATION


Notes:

- Item for Type III Traffic Signal Standard with Mast Arm and Foundation includes Highway Lighting Bracket Arm.
- Highway Lighting Luminaire to be Paid for Under Respective Items in Section 622.
- For Additional Details See Standard Plan TE-38.
- Size, Length and Diameter of Anchor Bolts shall be as Recommended by the Manufacturer. Contractor shall Submit Catalog Cuts to the Engineer for Approval.
- Handhole shall be Opposite of Traffic Flow.


A
E-15
TRAFFIC SIGNAL TYPE III STANDARD
NOT TO SCALE

Note:

Key may be Omitted
If Entire Conc Base
Poured Monolithically

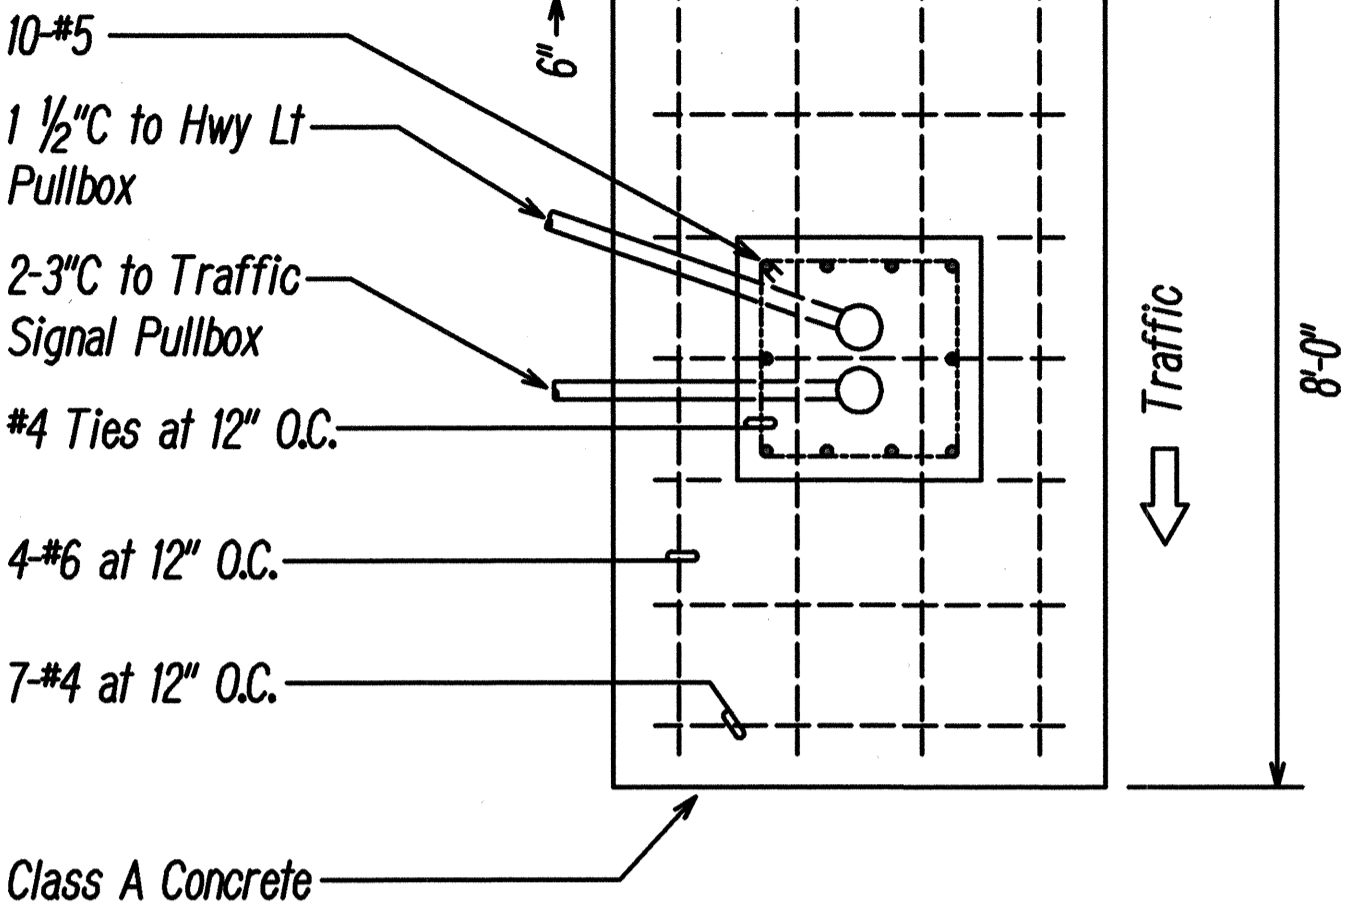


B
E-15
CONCRETE BASE PLAN
NOT TO SCALE

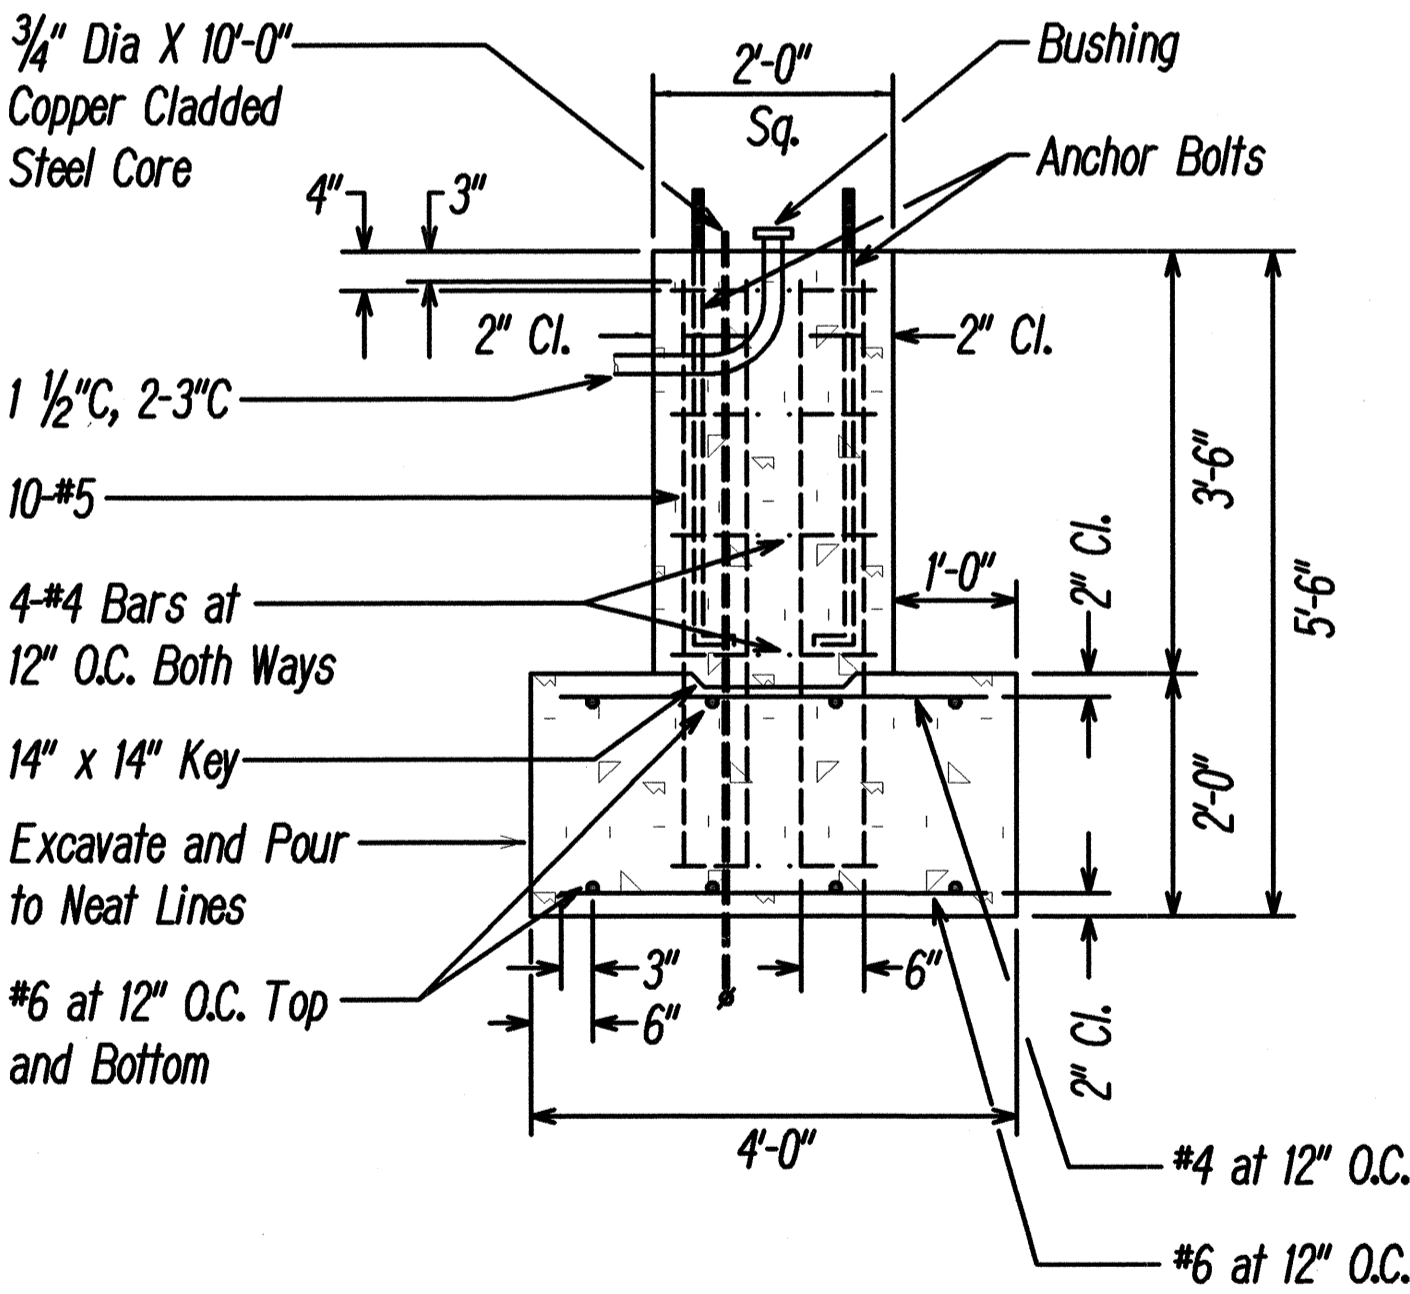

Note: See Details B
E-15

C
E-15
CONCRETE BASE ELEVATION
NOT TO SCALE

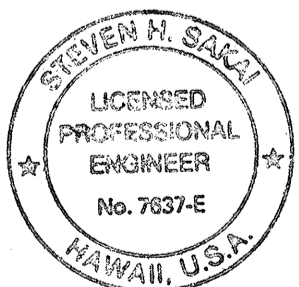

THIS WORK WAS PREPARED BY ME
OR UNDER MY SUPERVISION
Steven H. Saki

STATE OF HAWAII
DEPARTMENT OF TRANSPORTATION
HIGHWAYS DIVISION


TRAFFIC SIGNAL DETAILS

FARRINGTON HIGHWAY
Intersection Improvements at Waiomea Street
Project No. 93A-06-98

Scale: None Date: AUGUST 2000


SHEET No. E-15 OF 30 SHEETS

FED. ROAD DIST. NO.	STATE	PROJ. NO.	FISCAL YEAR	SHEET NO.	TOTAL SHEETS
HAWAII	HAW.	93A-06-98	2001	54	68

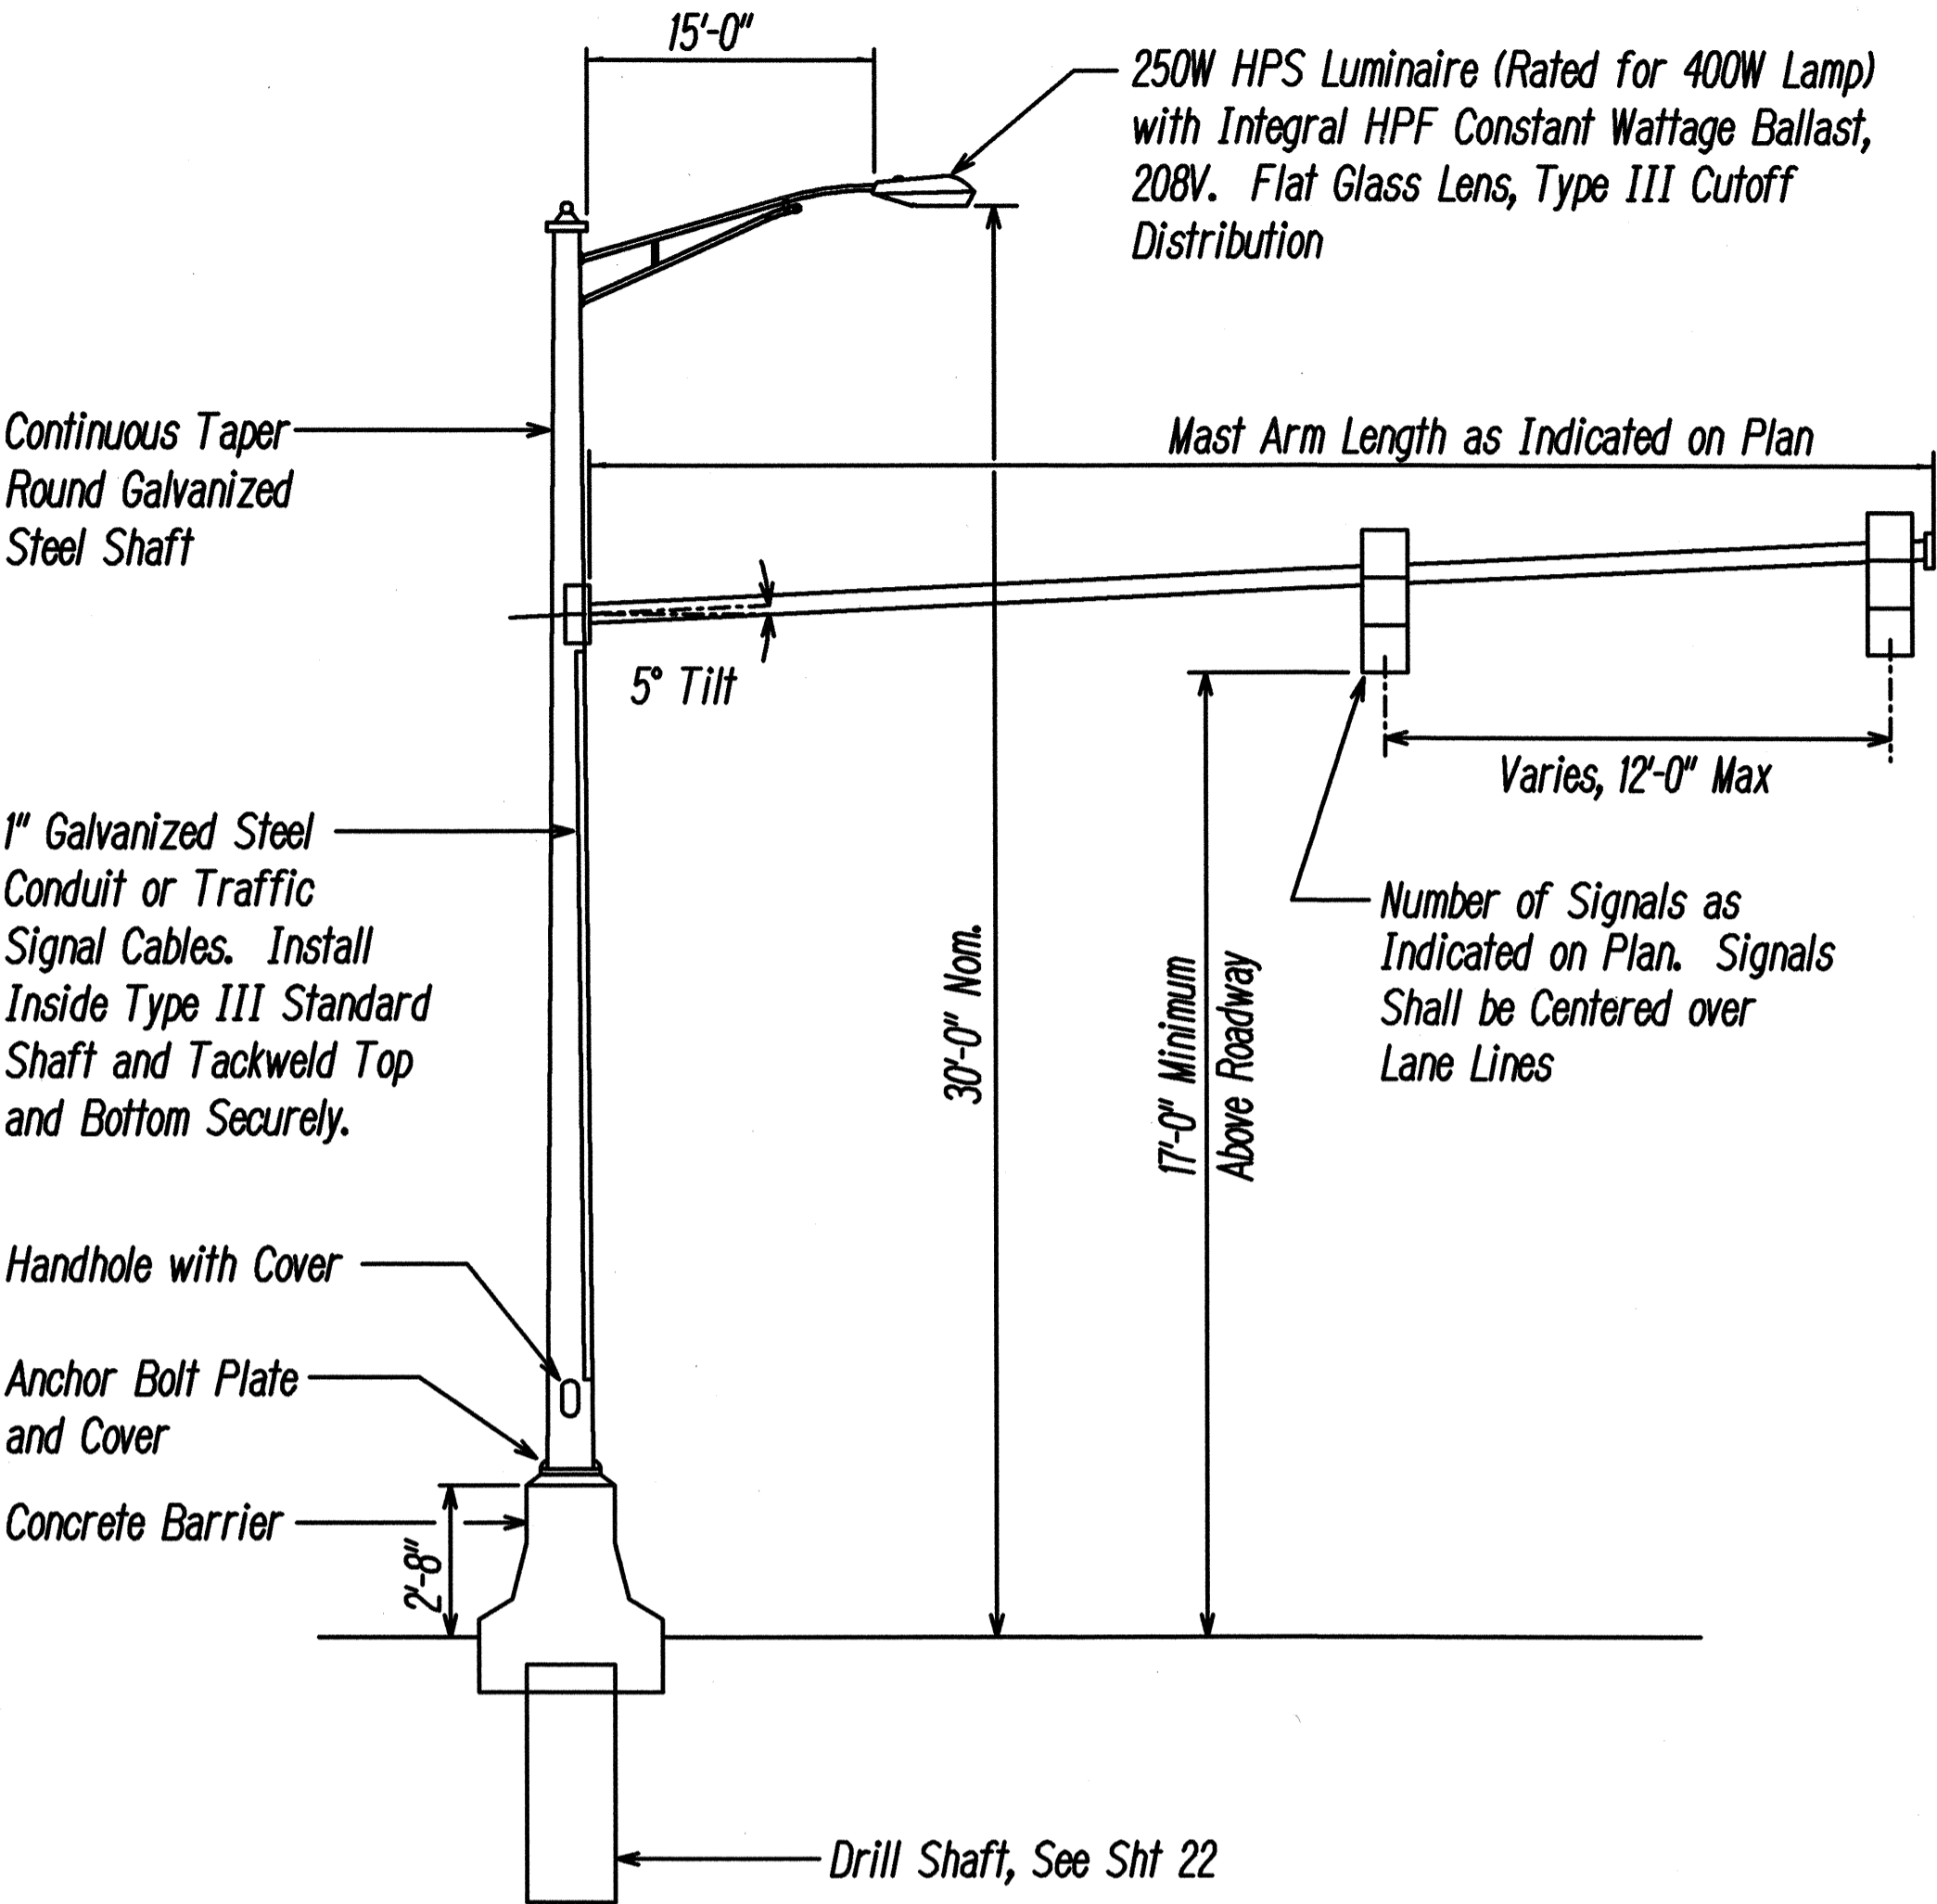

ELEVATION


- Notes:
- Item for Type III Traffic Signal Standard with Mast Arm and Foundation includes Highway Lighting Bracket Arm.
 - Highway Lighting Luminaire to be Paid for Under Respective Items in Section 622.
 - For Additional Details See Standard Plan TE-38.
 - Size, Length and Diameter of Anchor Bolts shall be as Recommended by the Manufacturer. Contractor shall Submit Catalog Cuts to the Engineer for Approval.
 - Handhole shall Face Travelway.

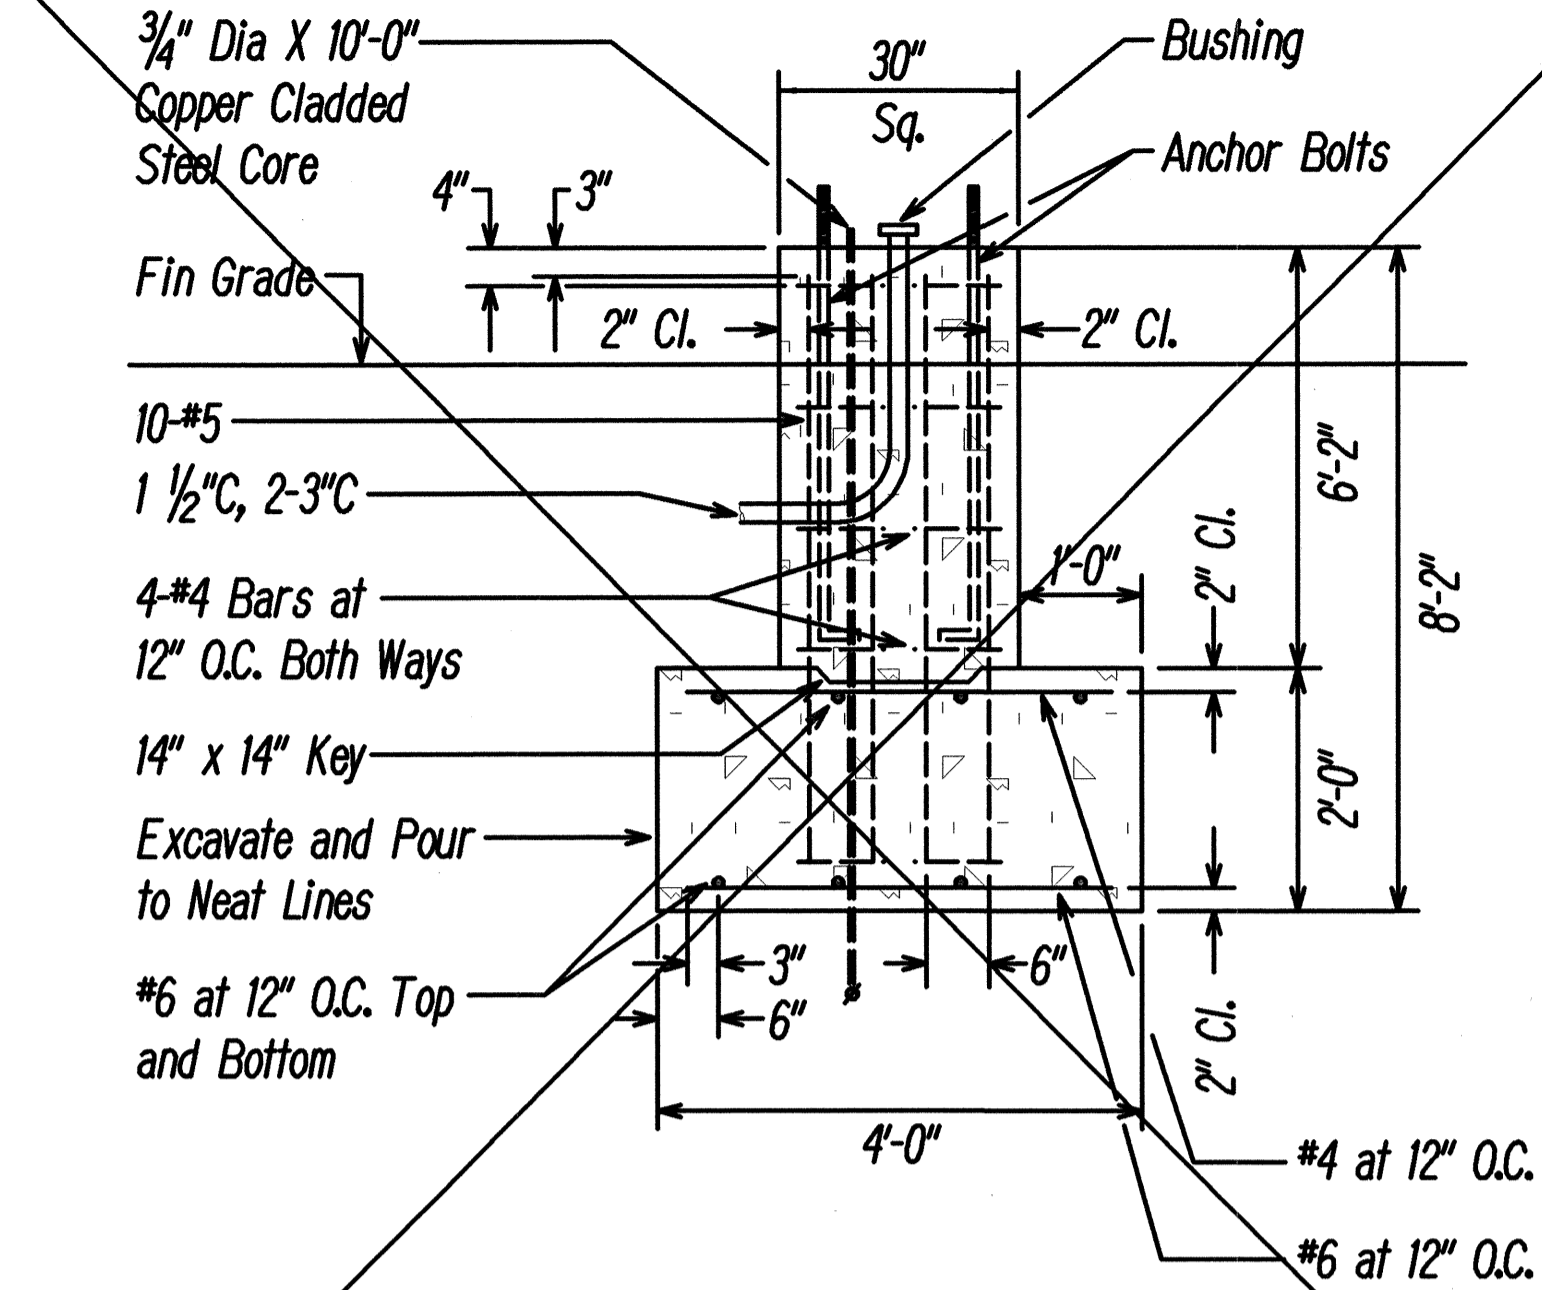


Note: See Details (C E-16)

(B E-16) CONCRETE BASE ELEVATION NOT TO SCALE

Note:
Key may be Omitted
If Entire Conc. Base
Poured Monolithically

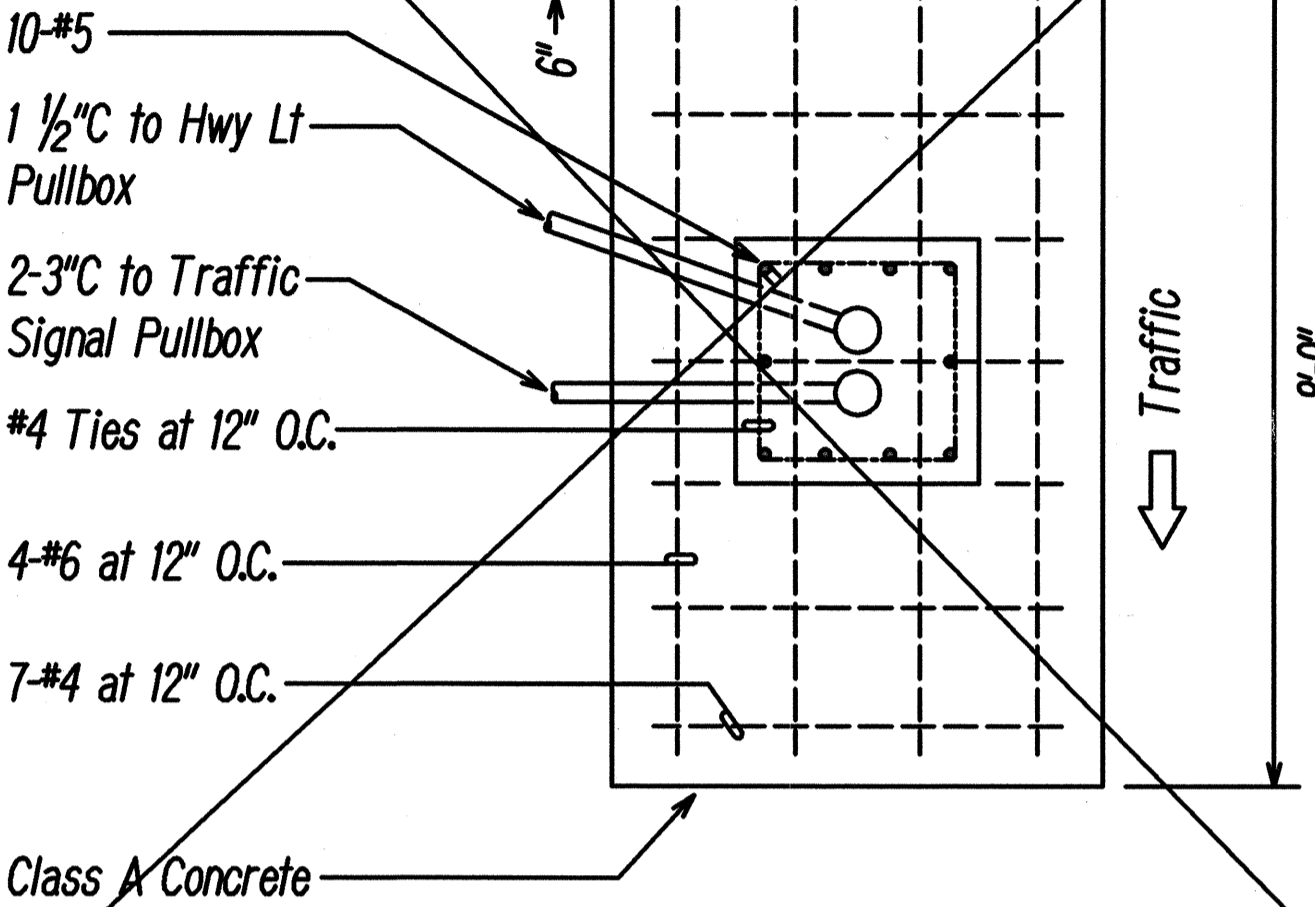


(C E-16) CONCRETE BASE PLAN NOT TO SCALE

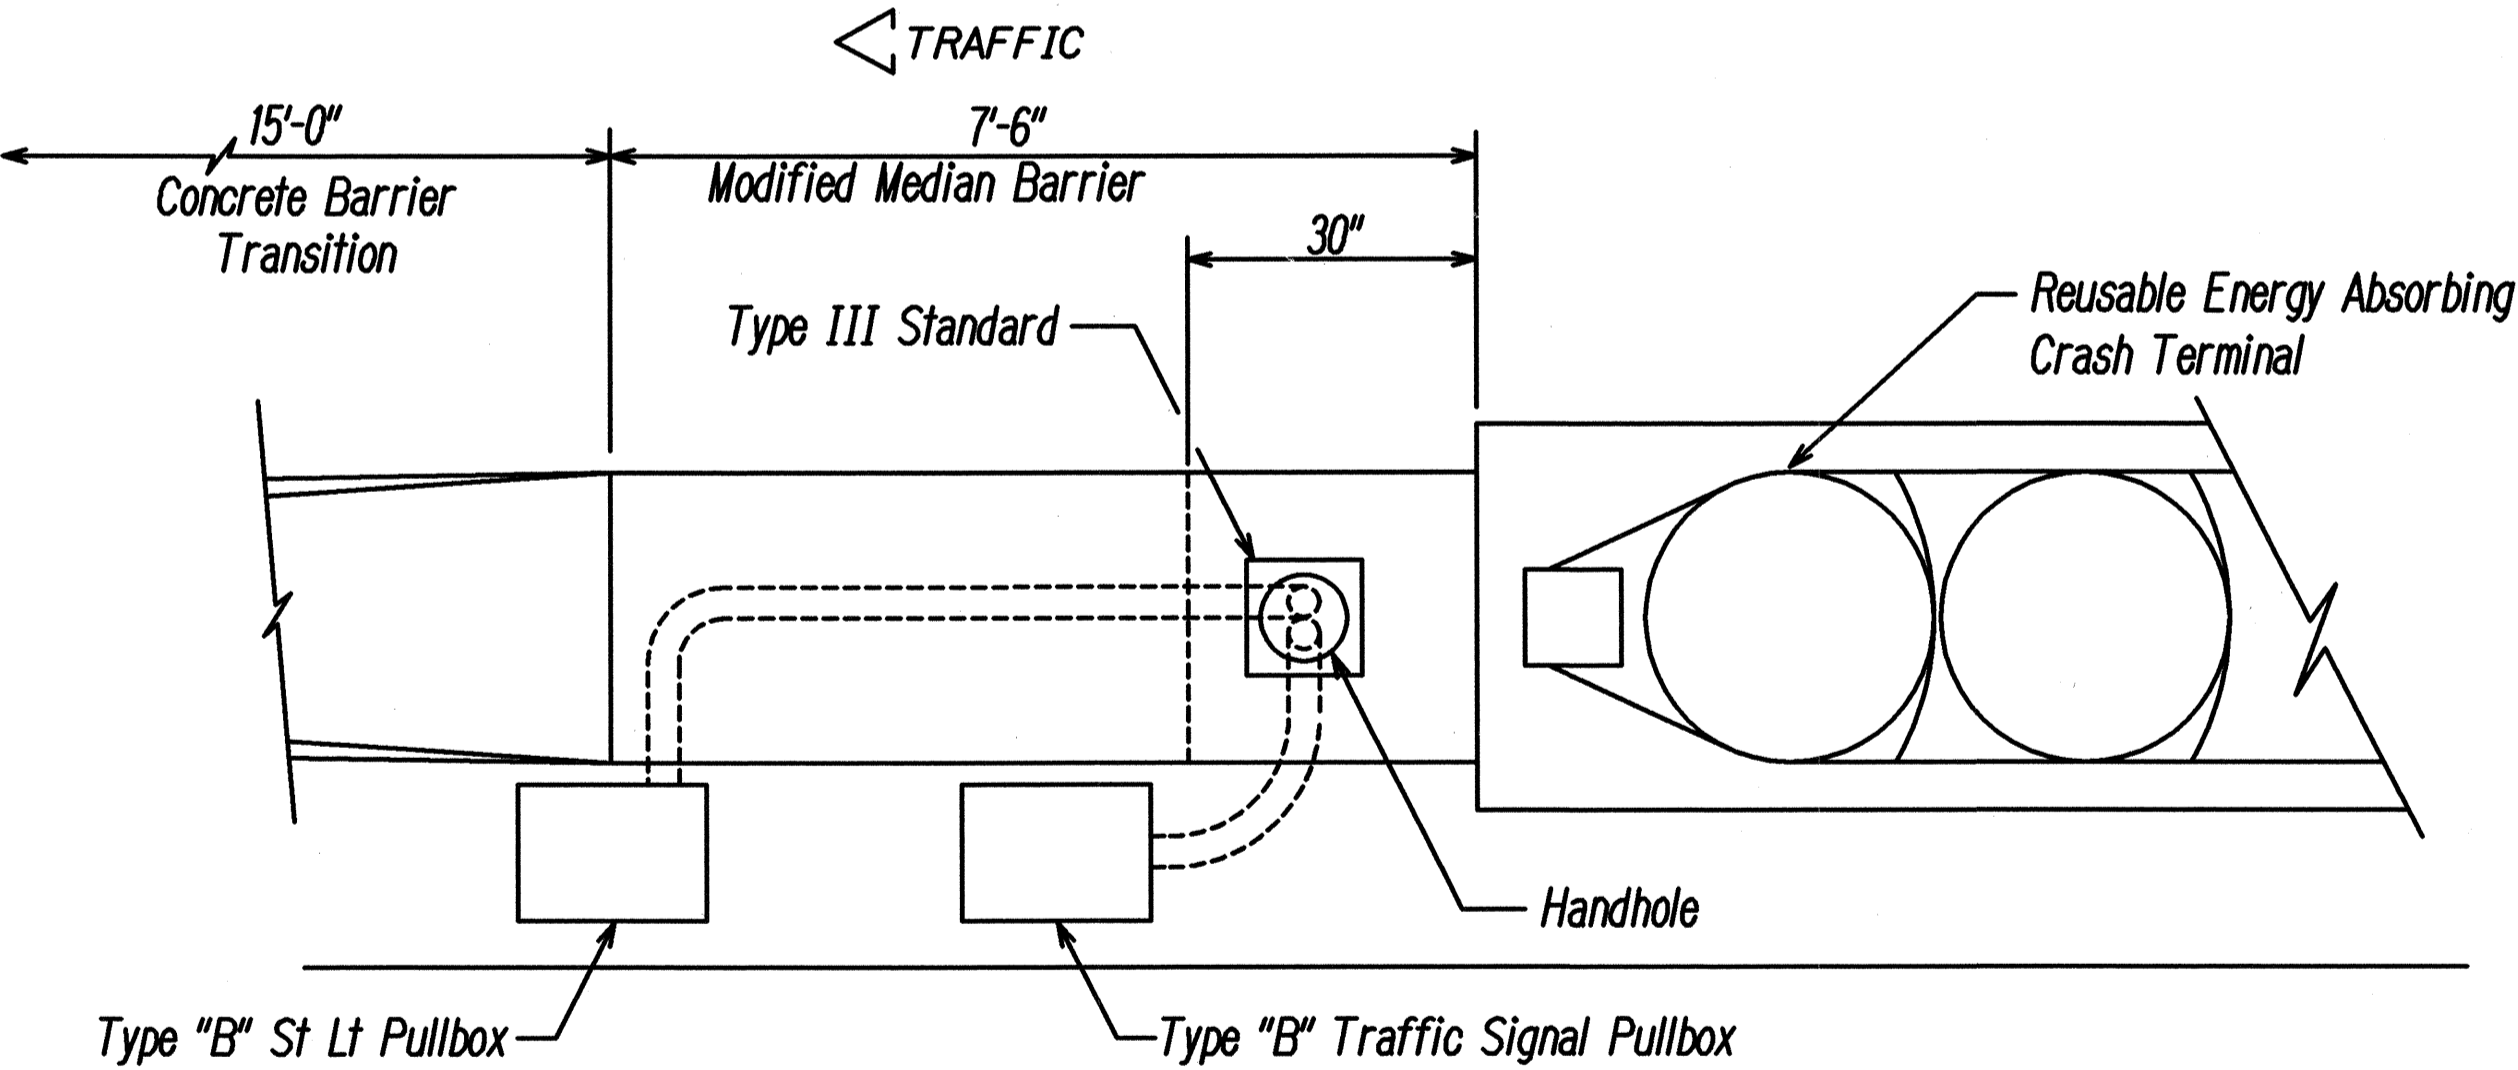

PLAN VIEW





(A E-16) TRAFFIC SIGNAL TYPE III STANDARD ON CONCRETE BARRIER NOT TO SCALE

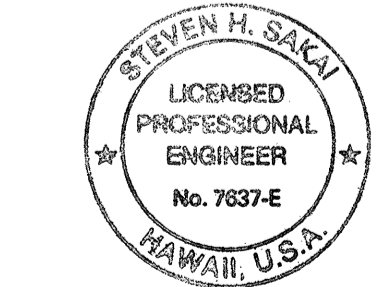

THIS WORK WAS PREPARED BY ME
OR UNDER MY SUPERVISION
DATE: 10/9/00

10/9/00	Clarified TS Std Foundation
DATE	DESCRIPTION
STATE OF HAWAII DEPARTMENT OF TRANSPORTATION HIGHWAYS DIVISION	
TRAFFIC SIGNAL DETAILS	
FARRINGTON HIGHWAY Intersection Improvements at Waiomea Street Project No. 93A-06-98	
Scale: None	Date: AUGUST 2000
SHEET No. E-16 OF 30 SHEETS	

FED. ROAD DIST. NO.	STATE	PROJ. NO.	FISCAL YEAR	SHEET NO.	TOTAL SHEETS
HAWAII	HAW.	93A-06-98	2001	C.O. 54 S-1	68

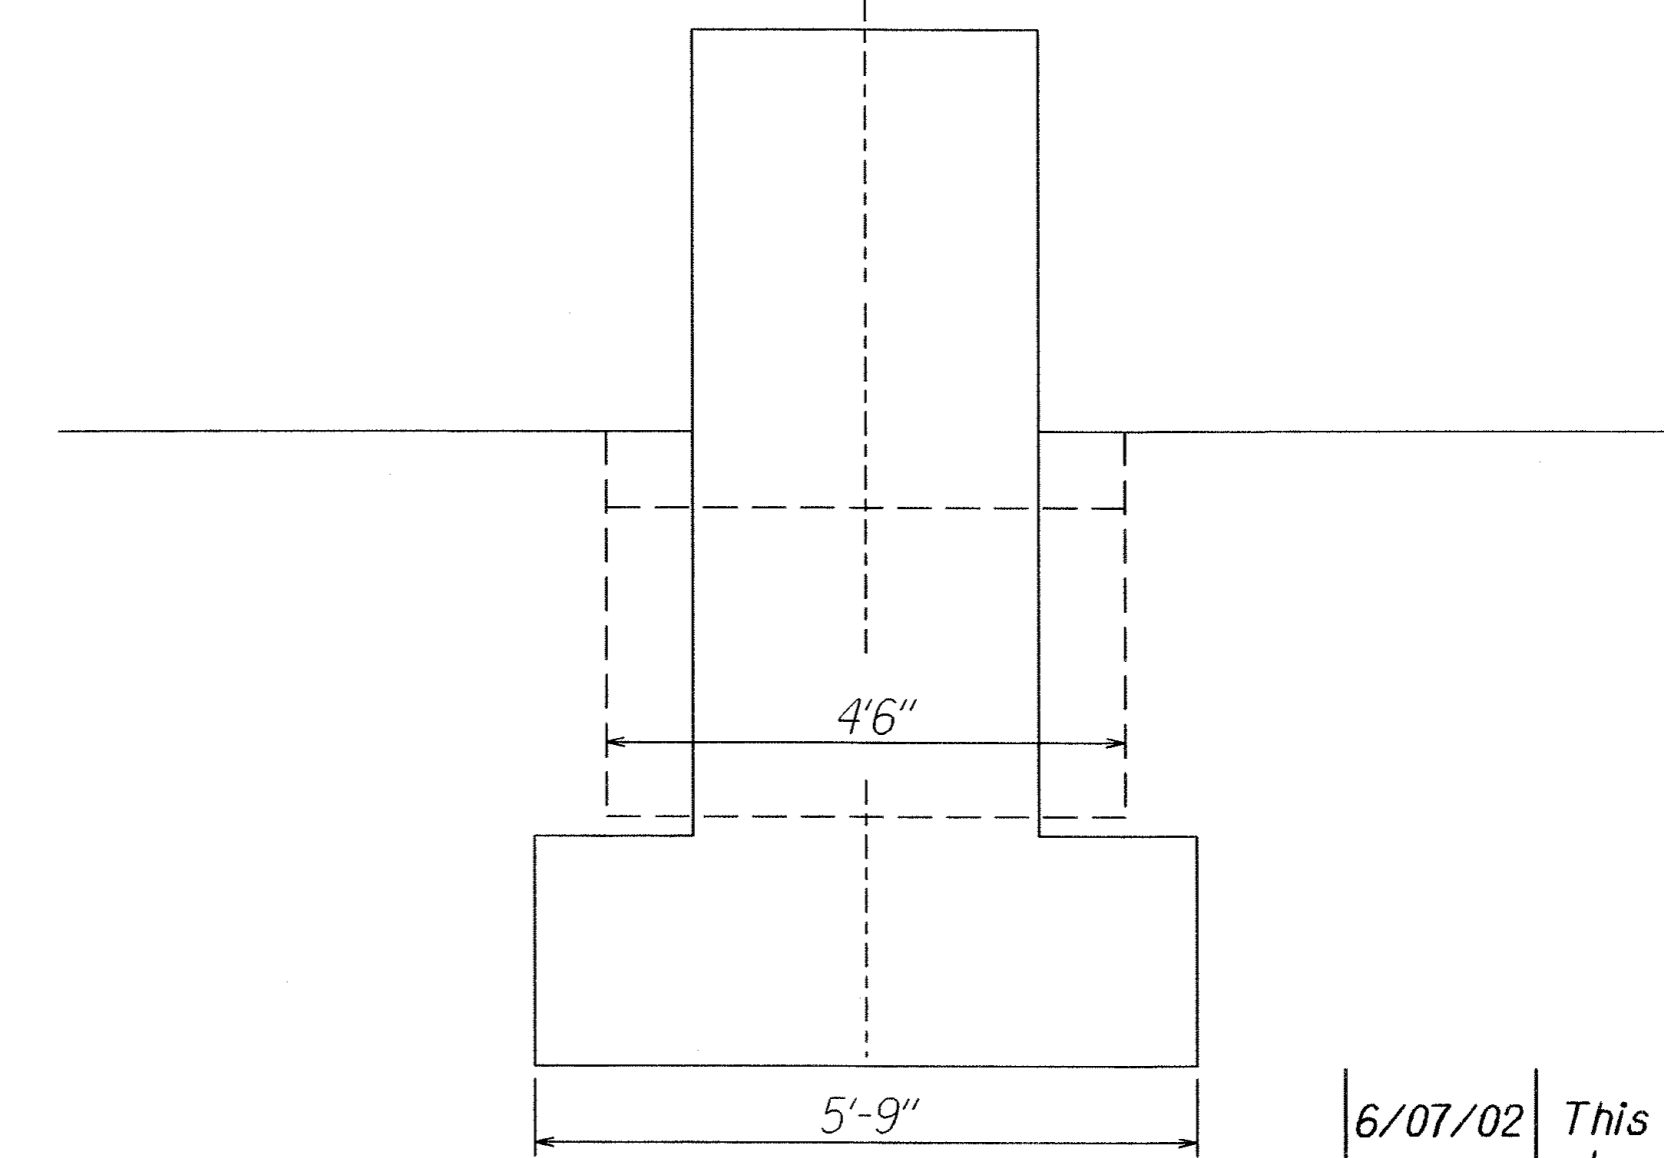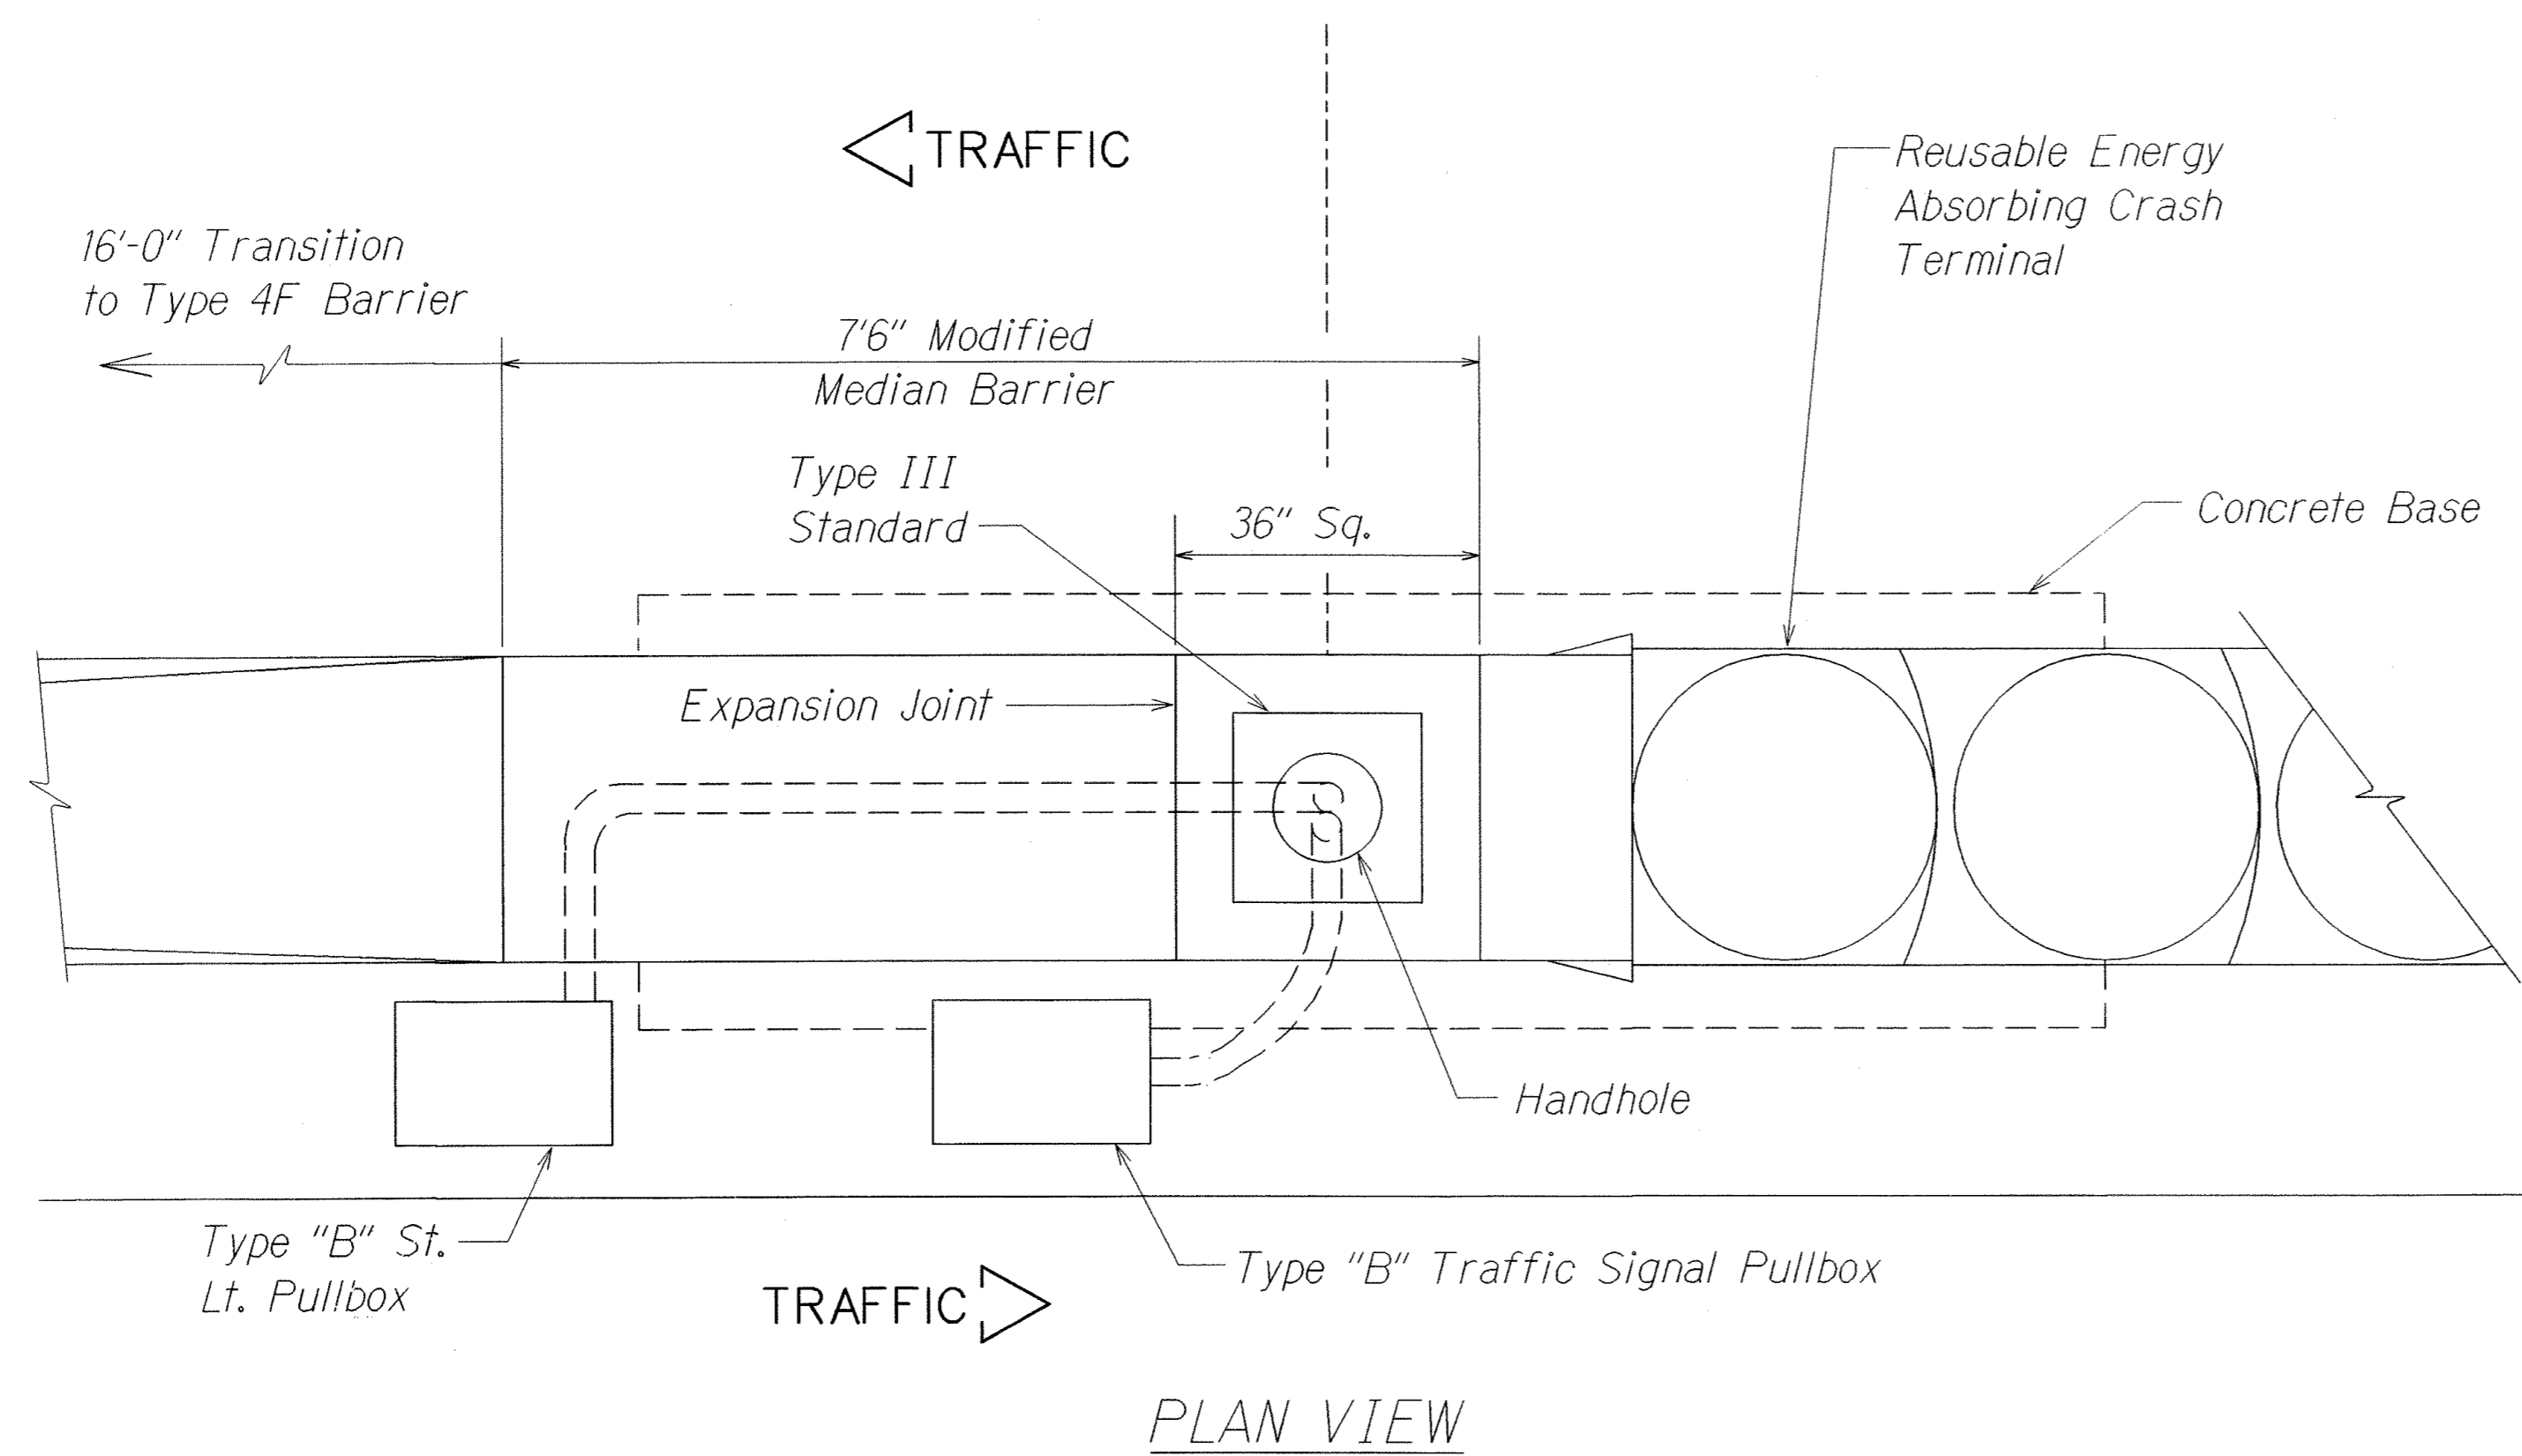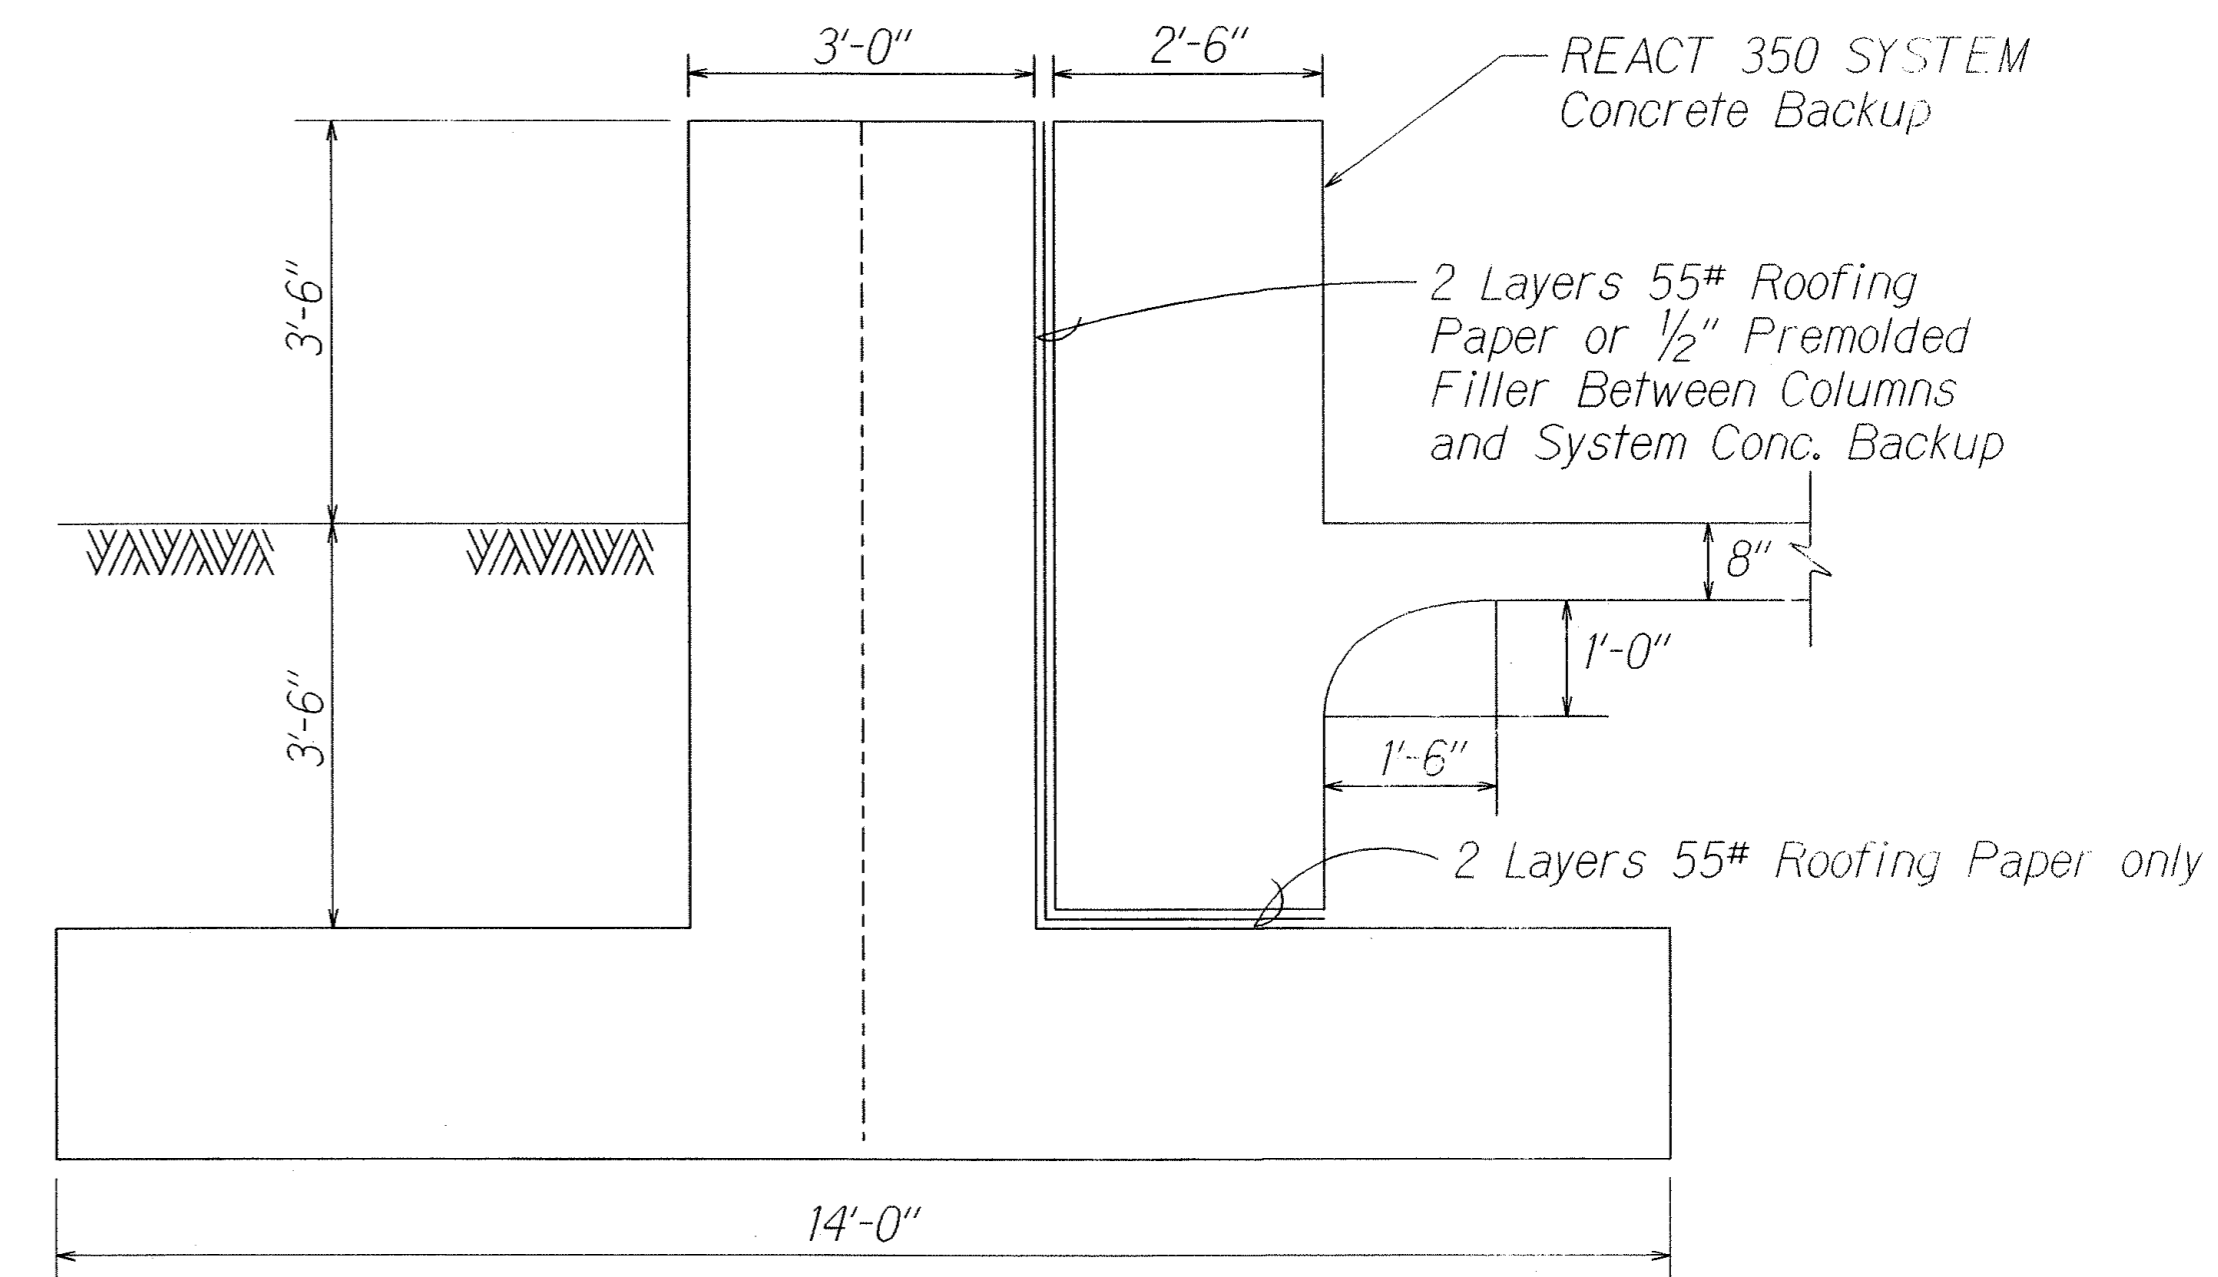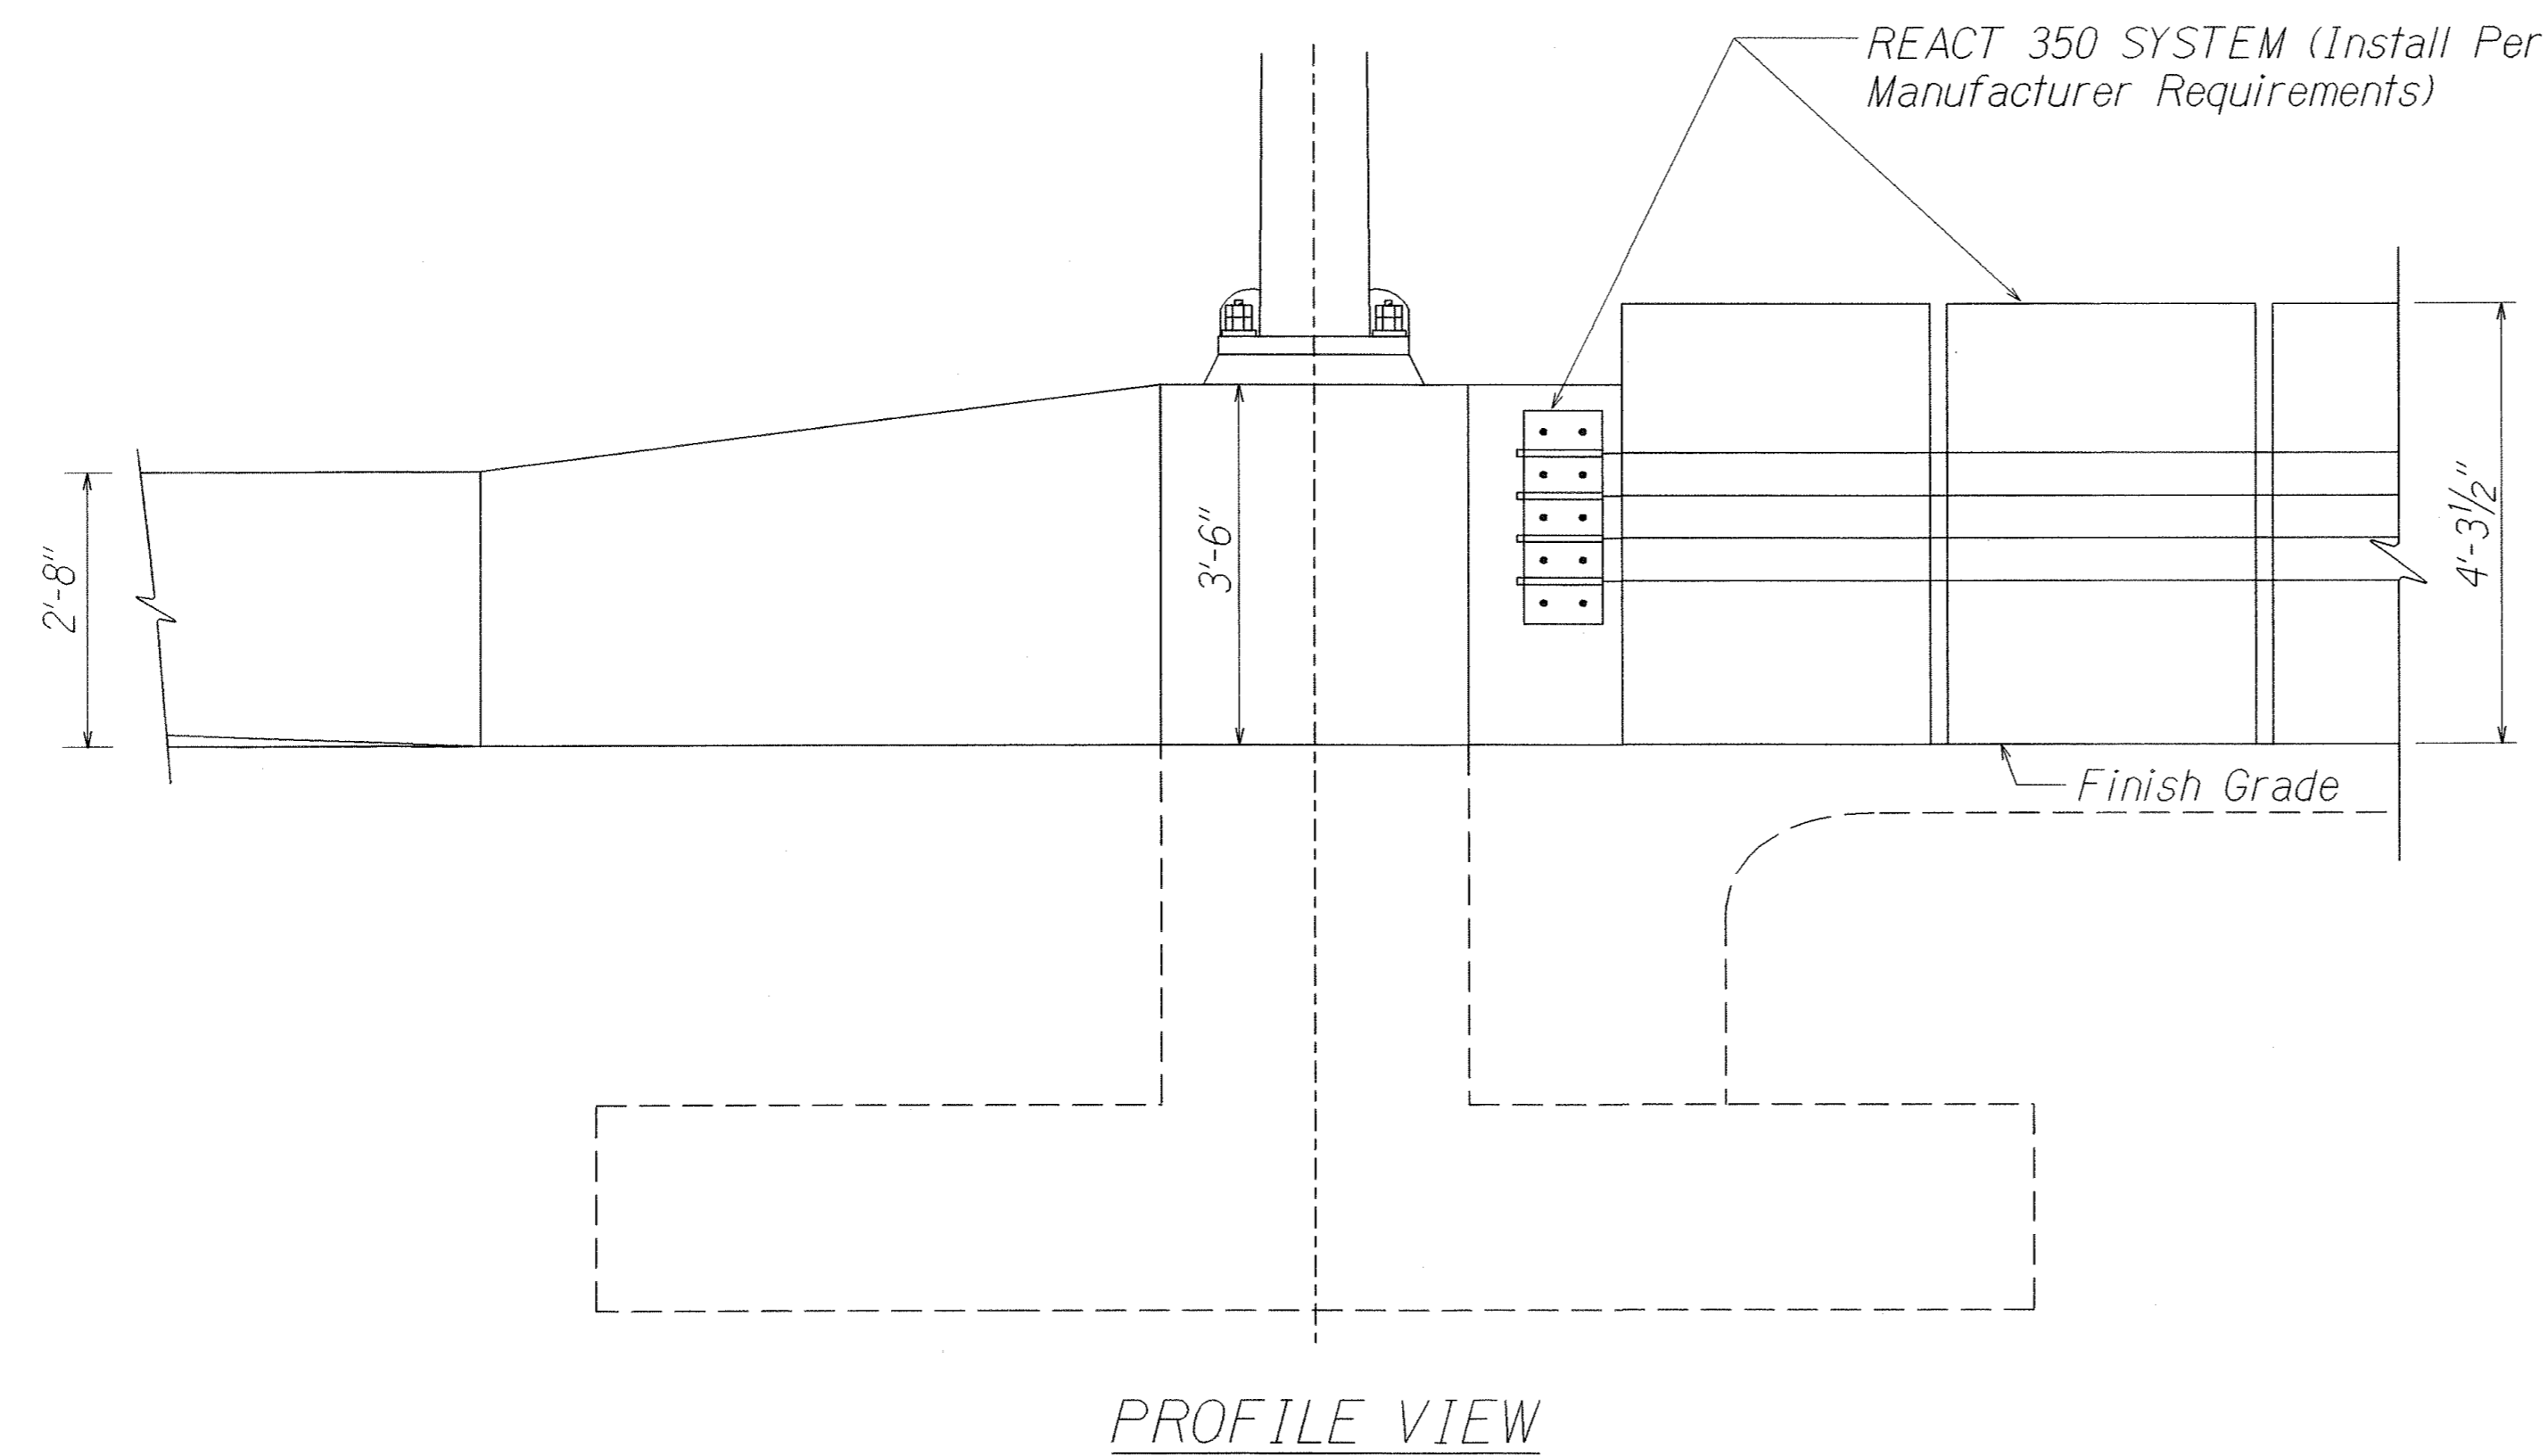


DESIGNED BY	DATE
DRAWN BY	6/10/02
CHECKED BY	
NOTED BY	
QUANTITIES BY	
REVISIONS	

TRAFFIC SIGNAL TYPE III STANDARD ON CONCRETE BARRIER
 Not to Scale

6/07/02	This sheet added to original contract plans.
DATE	REVISION
STATE OF HAWAII DEPARTMENT OF TRANSPORTATION HIGHWAYS DIVISION TRAFFIC SIGNAL DETAILS FARRINGTON HIGHWAY Intersection Improvements at Waiomea Street Project No. 93A-06-98 Not to Scale Date: August 2000	
SHEET No. E-16 OF 30 SHEETS	


FED. ROAD DIST. NO.	STATE	PROJ. NO.	FISCAL YEAR	SHEET NO.	TOTAL SHEETS
HAWAII	HAW.	93A-06-98	2001	55	68

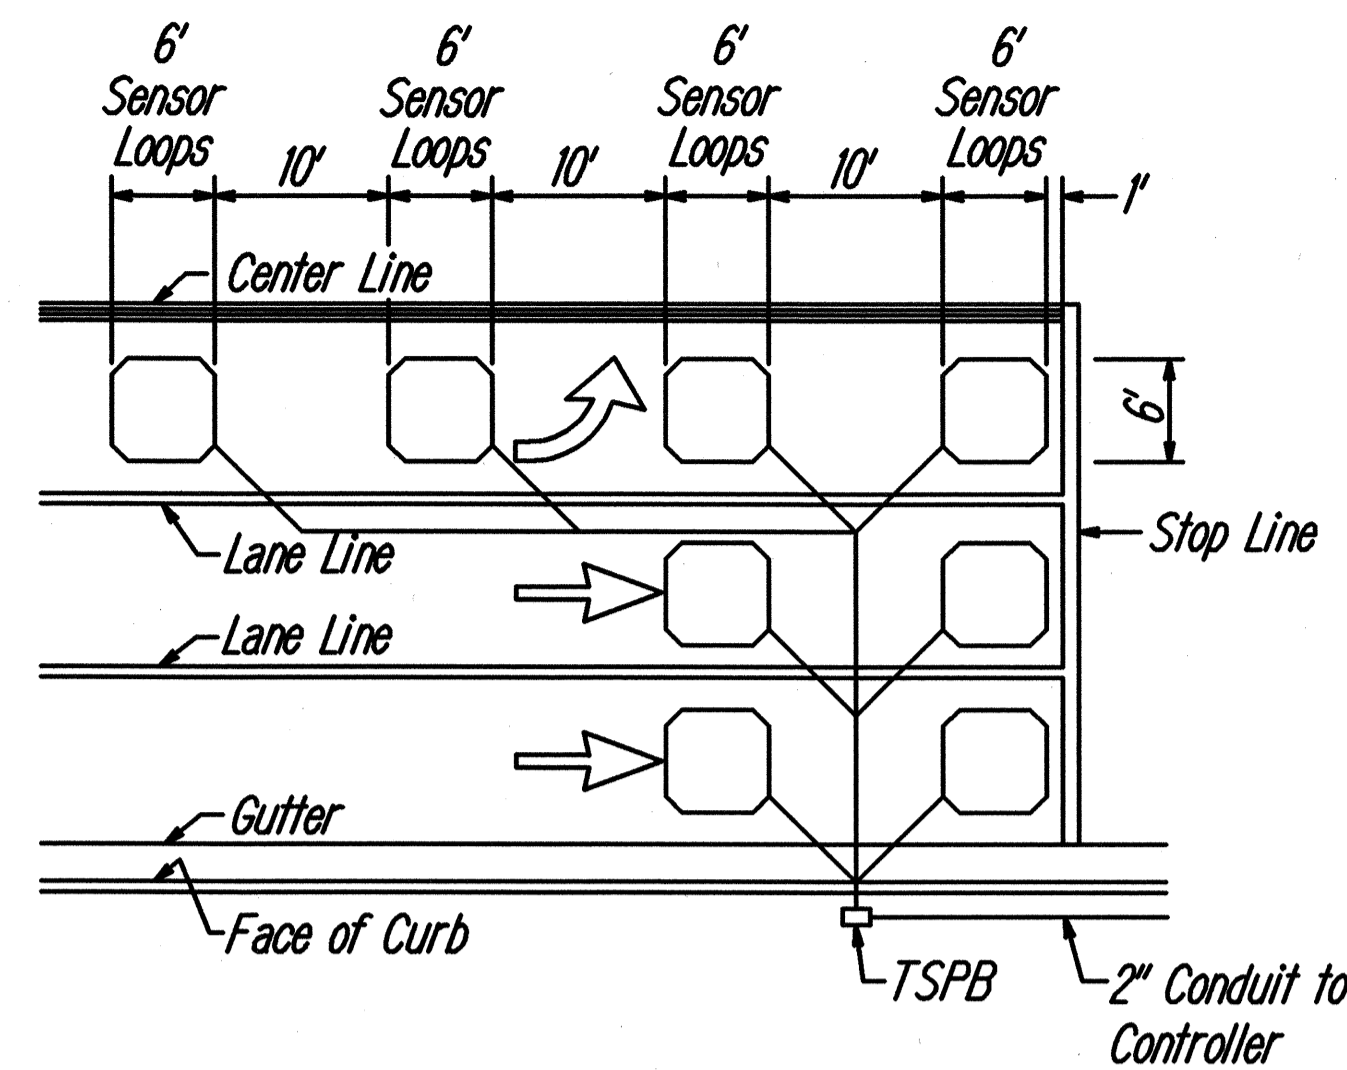

NOTES:

1. Center sensor loops in lanes.
2. Collector cables shall be twisted 2 turns per foot.
3. Number of loops and locations vary. See project plans.
4. Number and locations of collector sawcuts may be varied in the field to suit.



A
E-17
TYPICAL SENSOR LOOP LAYOUT
N.T.S.

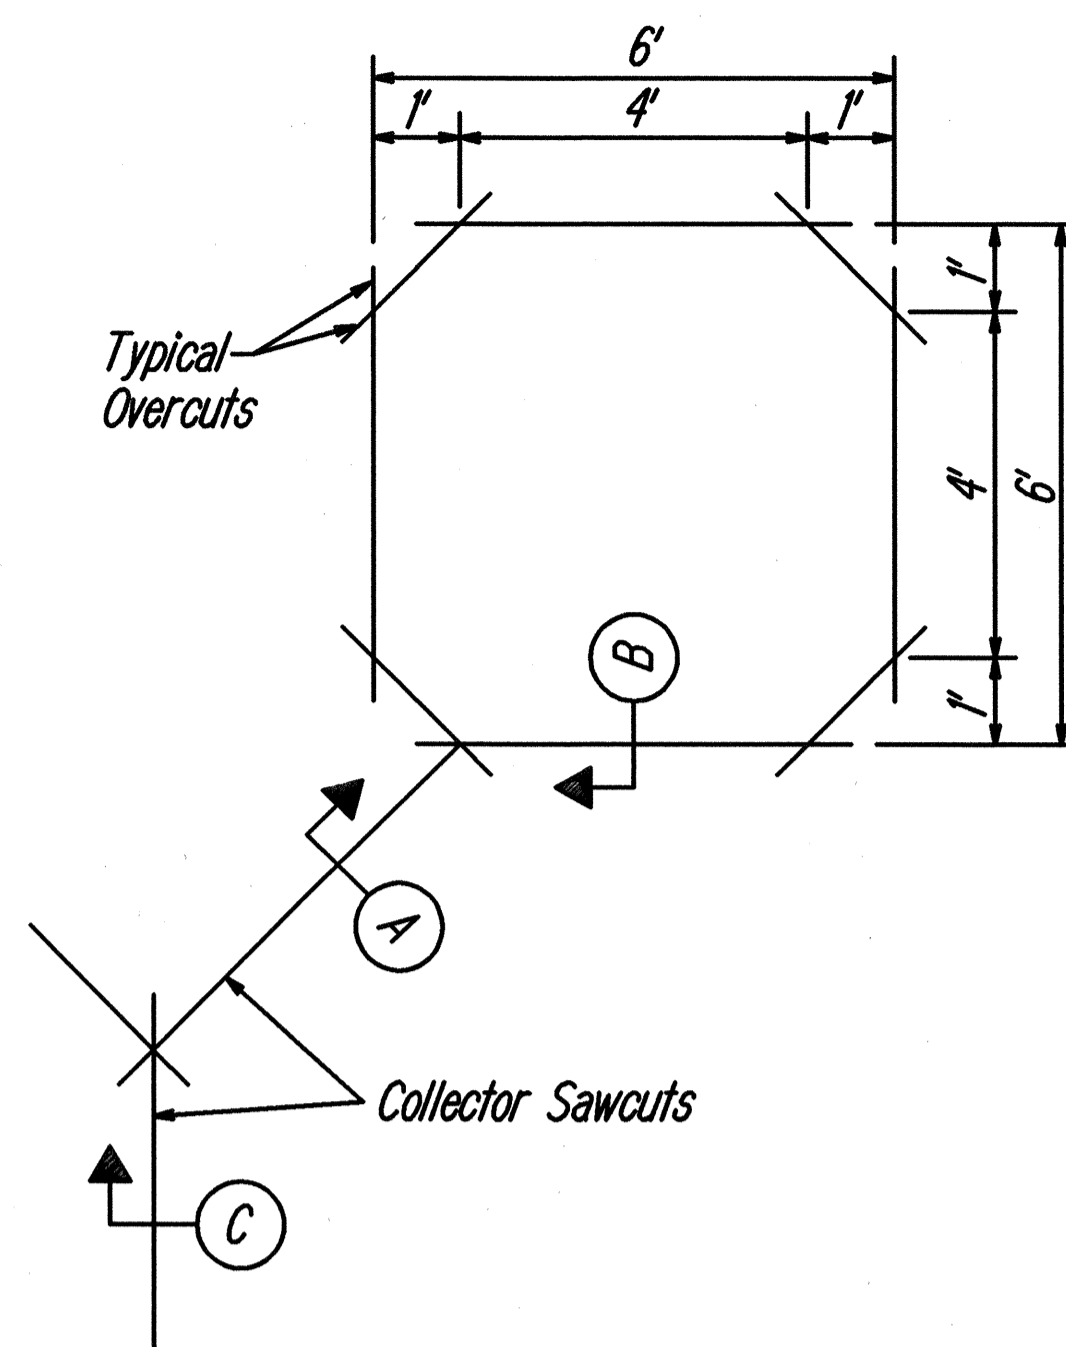

NOTE:

Length of overcuts shall be kept to a minimum.
All overcuts shall be back filled with hot tar.


B
E-17
TYPICAL SENSOR LOOP SAWCUT DETAIL
N.T.S.

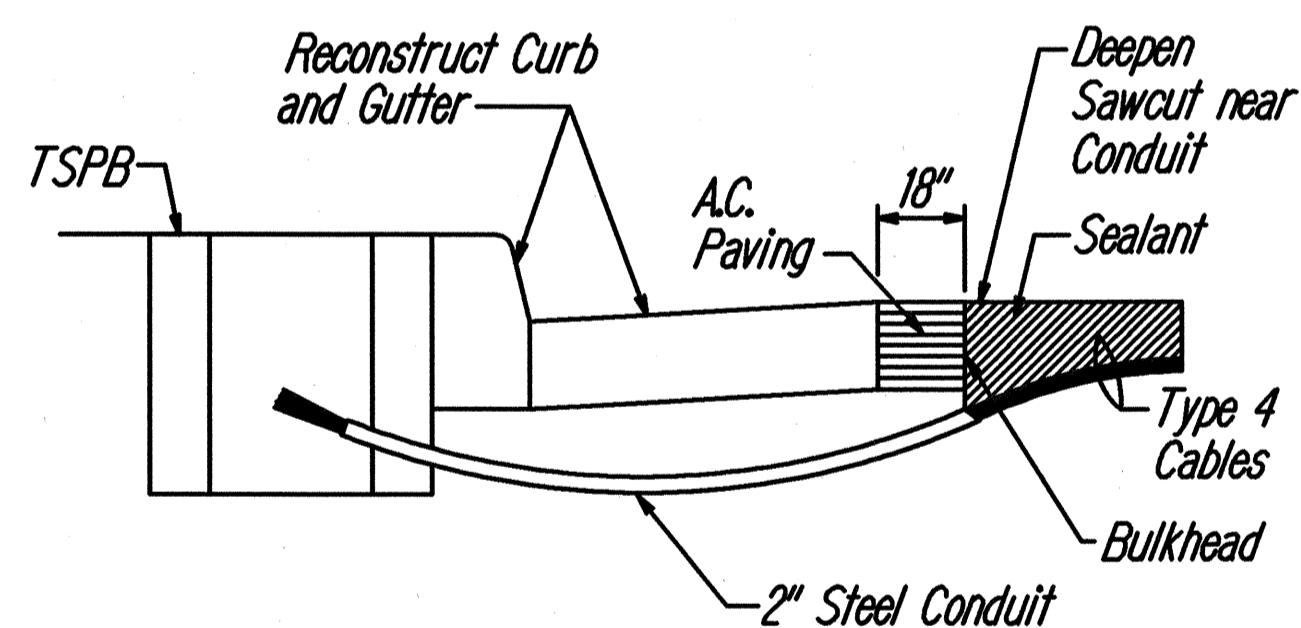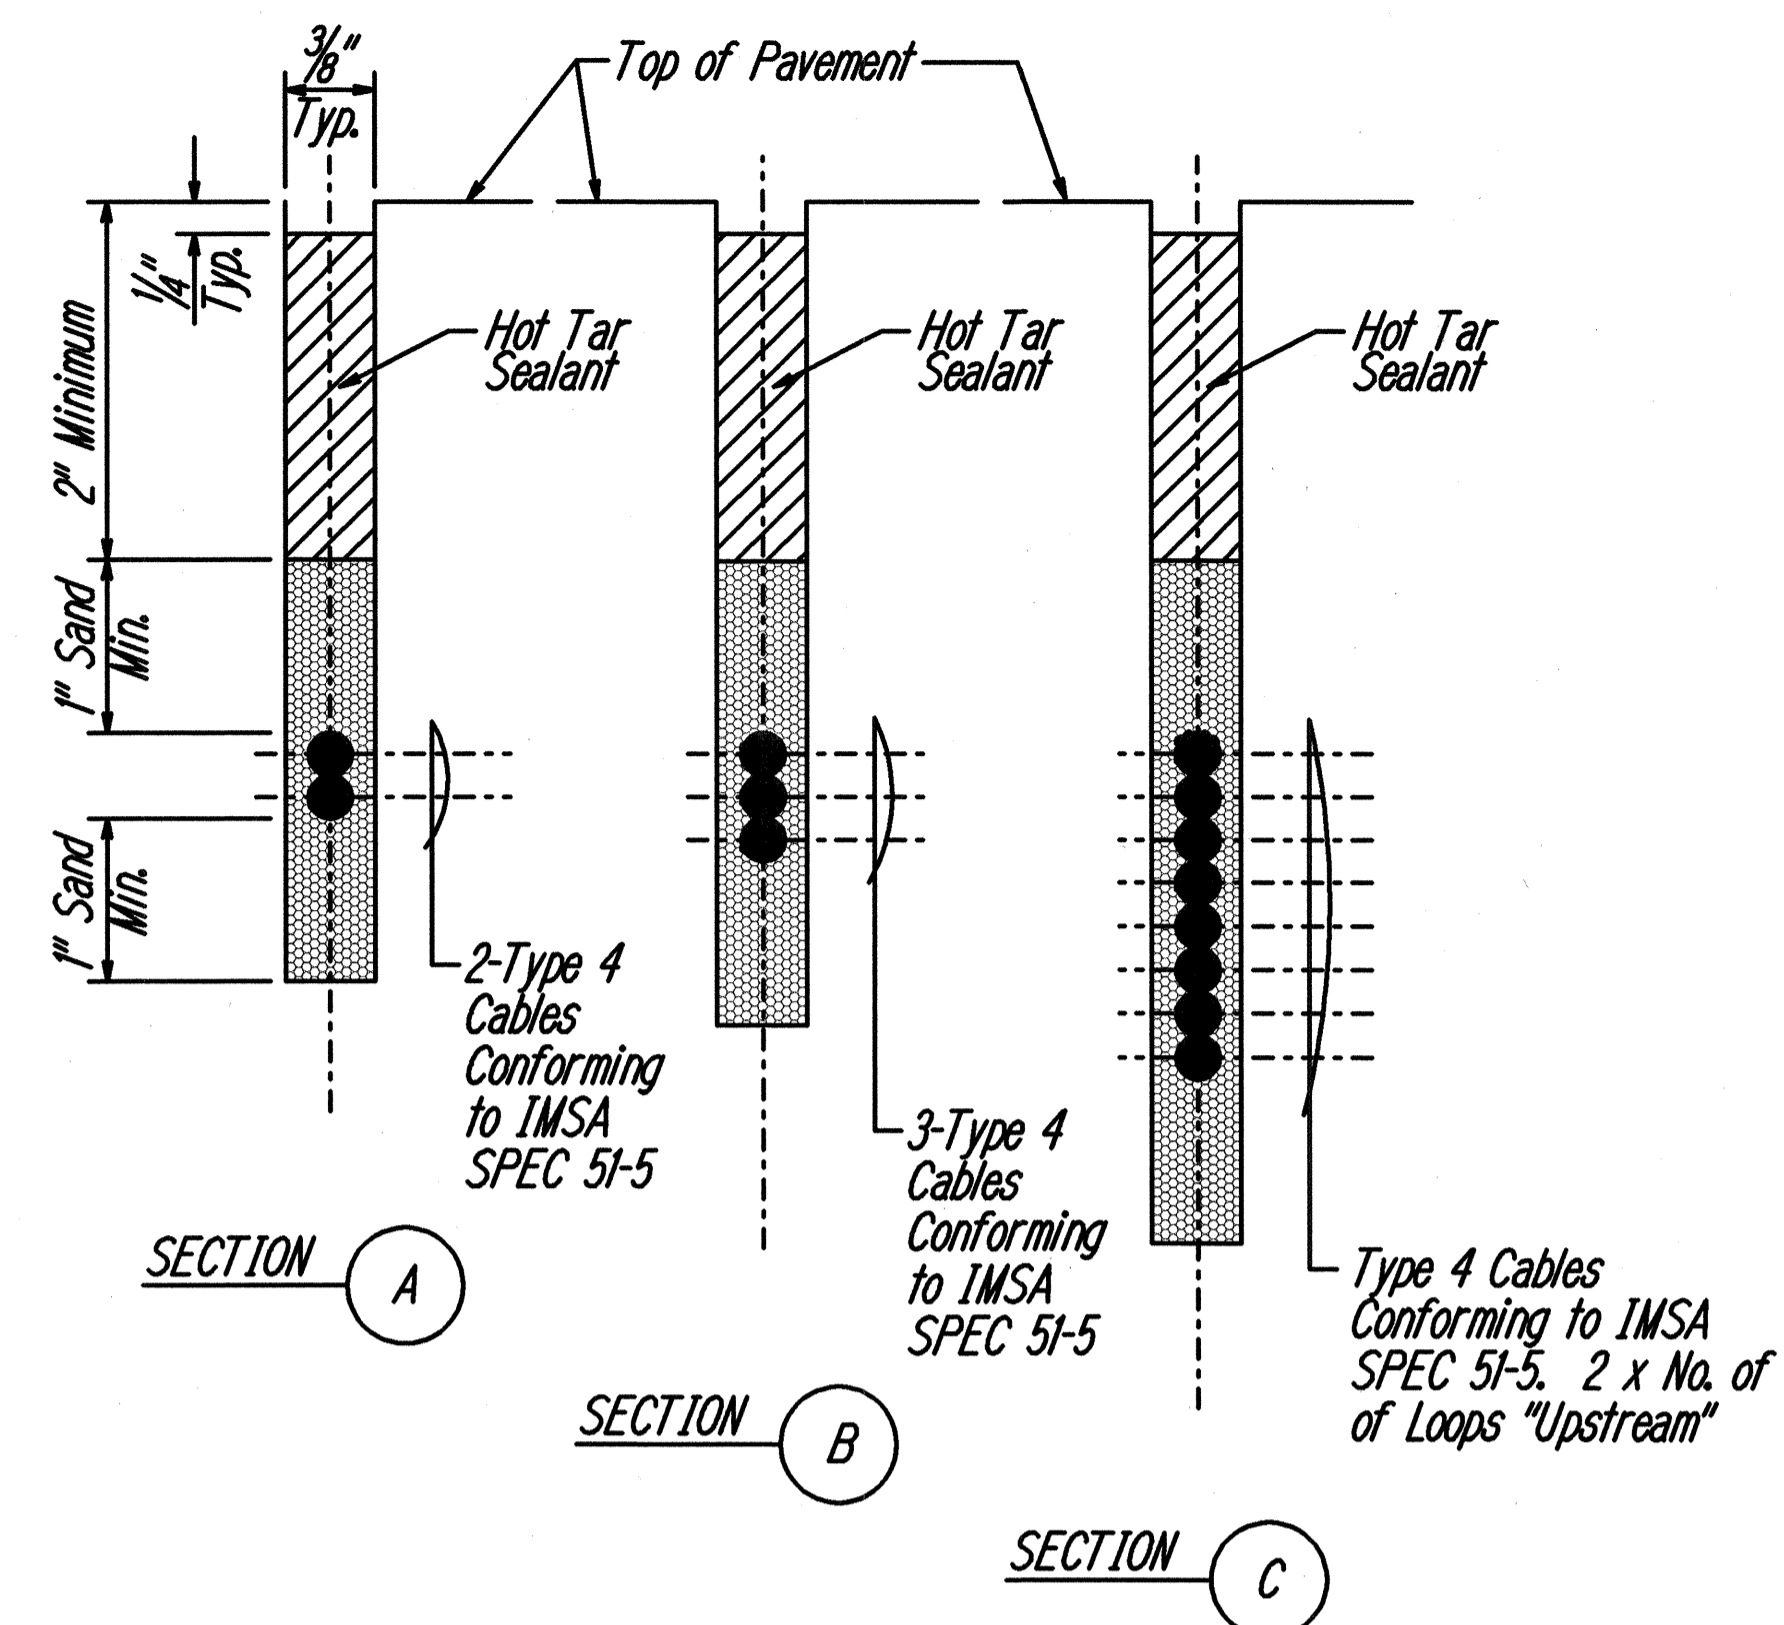


NOTES ON CONSTRUCTION AT END OF SAWCUT

1. Seal roadway end of conduit after installation of conductors.
2. Install bulkhead across conduit trench.
3. Place hot tar in sawcut.
4. Backfill over conduit with new A.C.
5. Reconstruct curb and gutter as required.

C
E-17
DETAIL OF SENSOR LOOP INSTALLATION
AT EDGE OF ROADWAY
N.T.S.

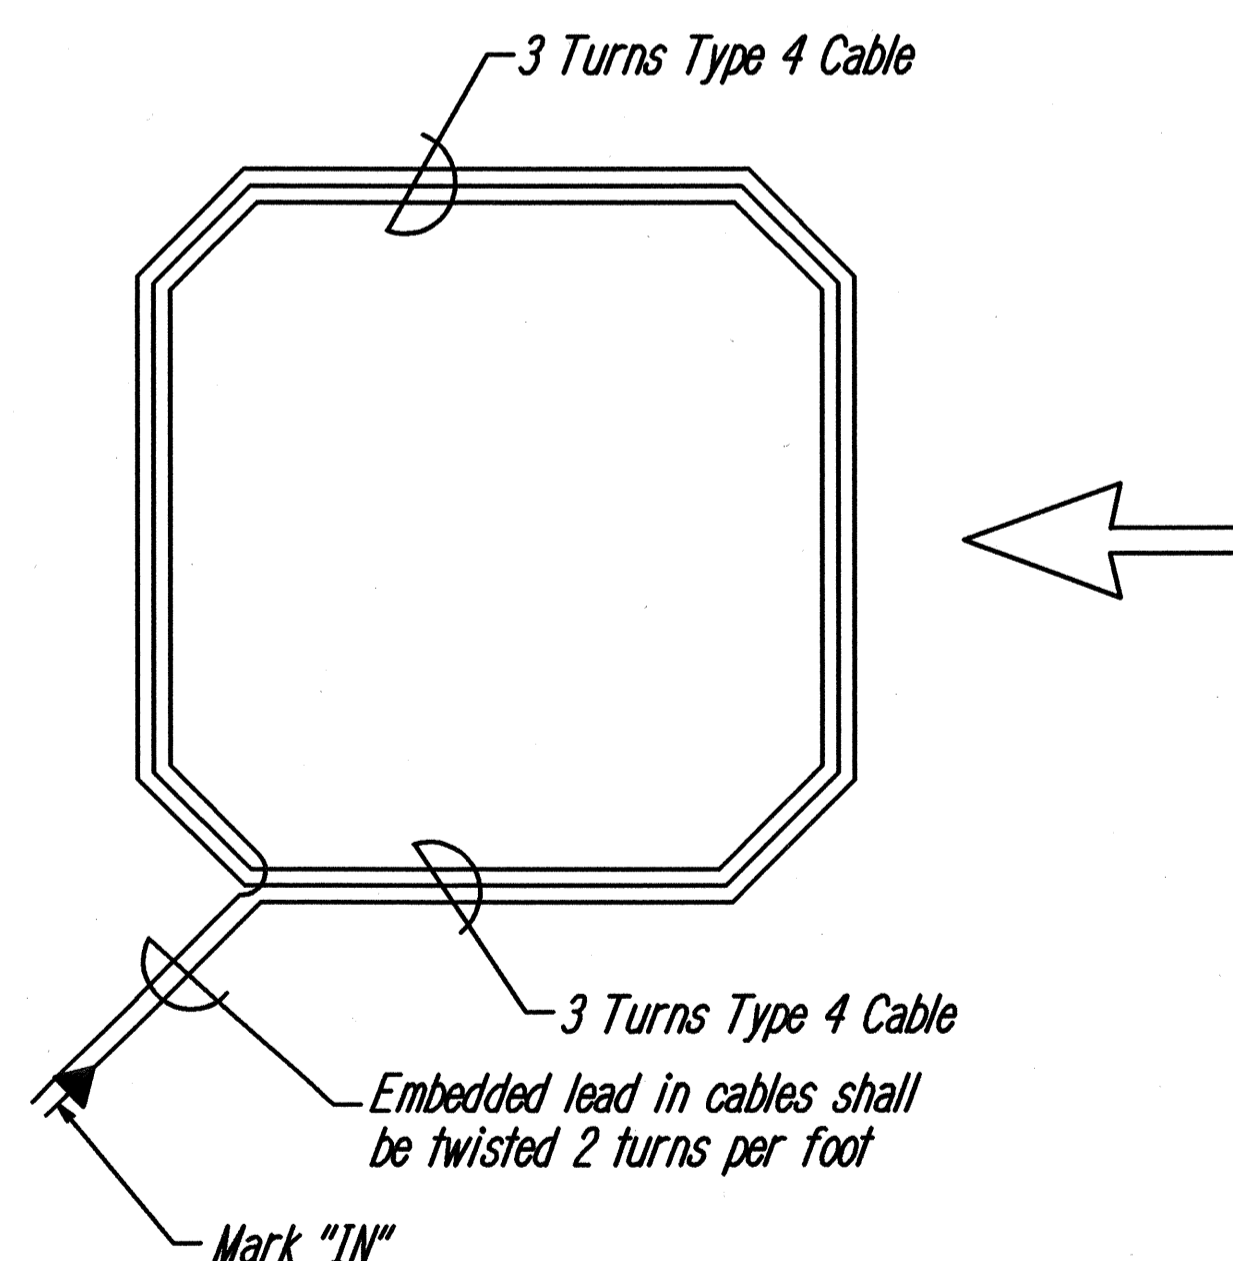

D
E-17
TYPICAL SENSOR LOOP WIRING DIAGRAM
N.T.S.

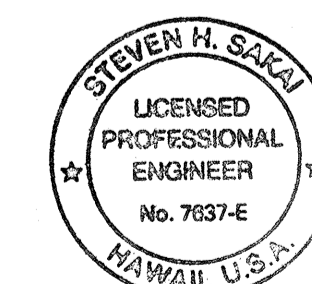

THIS WORK WAS PREPARED BY ME
OR UNDER MY SUPERVISION
Steven H. Sakai

STATE OF HAWAII
DEPARTMENT OF TRANSPORTATION
HIGHWAYS DIVISION

LOOP DETECTOR DETAILS


FARRINGTON HIGHWAY
Intersection Improvements at Waiomea Street
Project No. 93A-06-98
Scale: None Date: AUGUST 2000

SHEET No. E-17 OF 30 SHEETS

FED. ROAD DIST. NO.	STATE	PROJ. NO.	FISCAL YEAR	SHEET NO.	TOTAL SHEETS
HAWAII	HAW.	93A-06-98	2001	56	68


GENERAL NOTES

1. Provide a minimum of one 16 dia. x 2.5m Copperweld Ground Rod in each pullbox. When directed by the Traffic Signal Inspector/Engineer, install additional Ground Rods. Cost of Ground Rods shall be incidental to the pullboxes.
2. All pre-cast concrete pullboxes shall be manufactured in two pieces.
3. The pullbox with cover shall be capable of supporting an MS 18 Loading.
4. The maximum weight of the pullbox cover shall not exceed 27 kilograms.
5. The openings for the conduits on all pullboxes shall be pre-cast concrete knockouts.
6. After installing the conduits in the openings of the pullboxes, the Contractor shall fill the excess opening in the pre-cast knockouts with concrete mortar.
7. Prior to installing the pullboxes, the Contractor shall level the bottom of the trench and achieve a minimum of 95% relative compaction of the bottom of the trench.
8. All concrete shall be Class A (25MPa, min.)
9. Rebars shall be Grade 300 and all lapped splices shall be 360mm minimum.
10. The #57 or #67 size aggregate shall conform to latest version of AASHTO M43 (ASTM D 448).
11. Type "C" Pullbox shall be installed in a location protected from vehicular traffic (i.e. raised sidewalk, behind A.C. curbs, traffic signal standard or pipe guards).

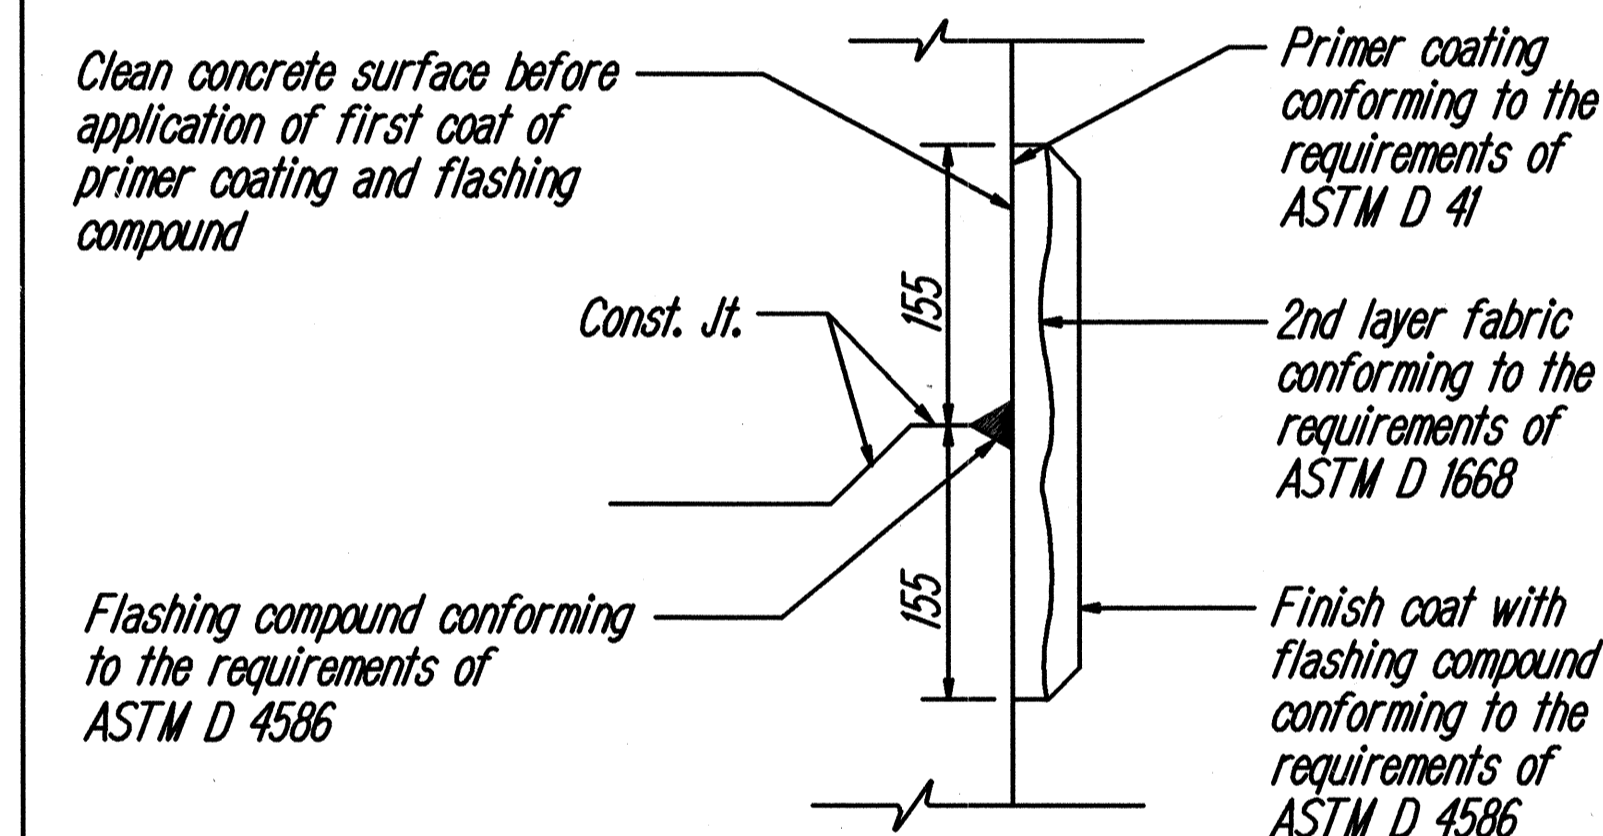

D
E-18
TYPICAL FLASHING COMPOUND WATERPROOFING DETAILS
N.T.S.

All Dimensions are in Millimeters unless otherwise shown



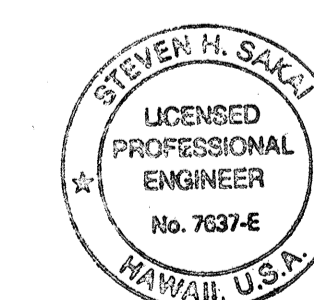


STATE OF HAWAII
DEPARTMENT OF TRANSPORTATION
HIGHWAYS DIVISION




PULLBOX & COVER DETAILS

FARRINGTON HIGHWAY
Intersection Improvements at Waiomea Street
Project No. 93A-06-98
Scale: None Date: AUGUST 2000




SHEET No. E-18 OF 30 SHEETS

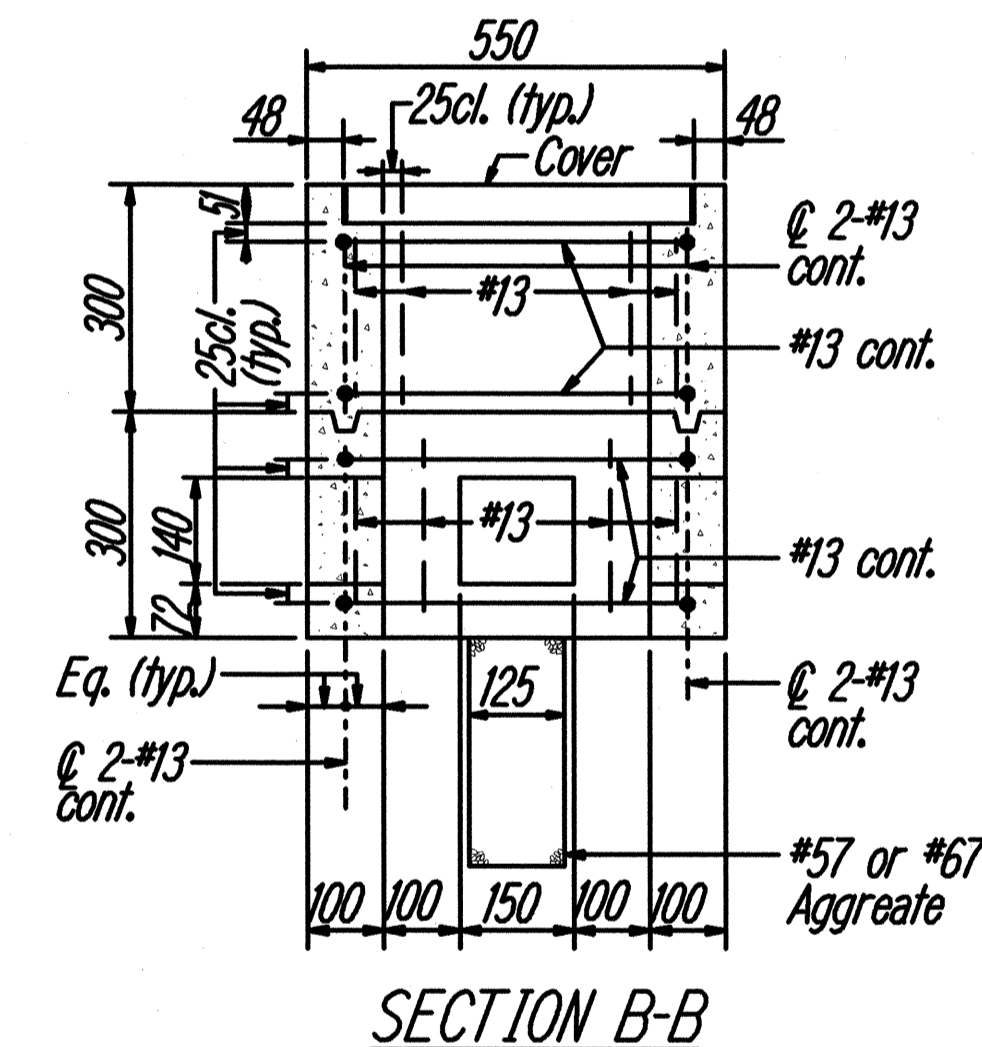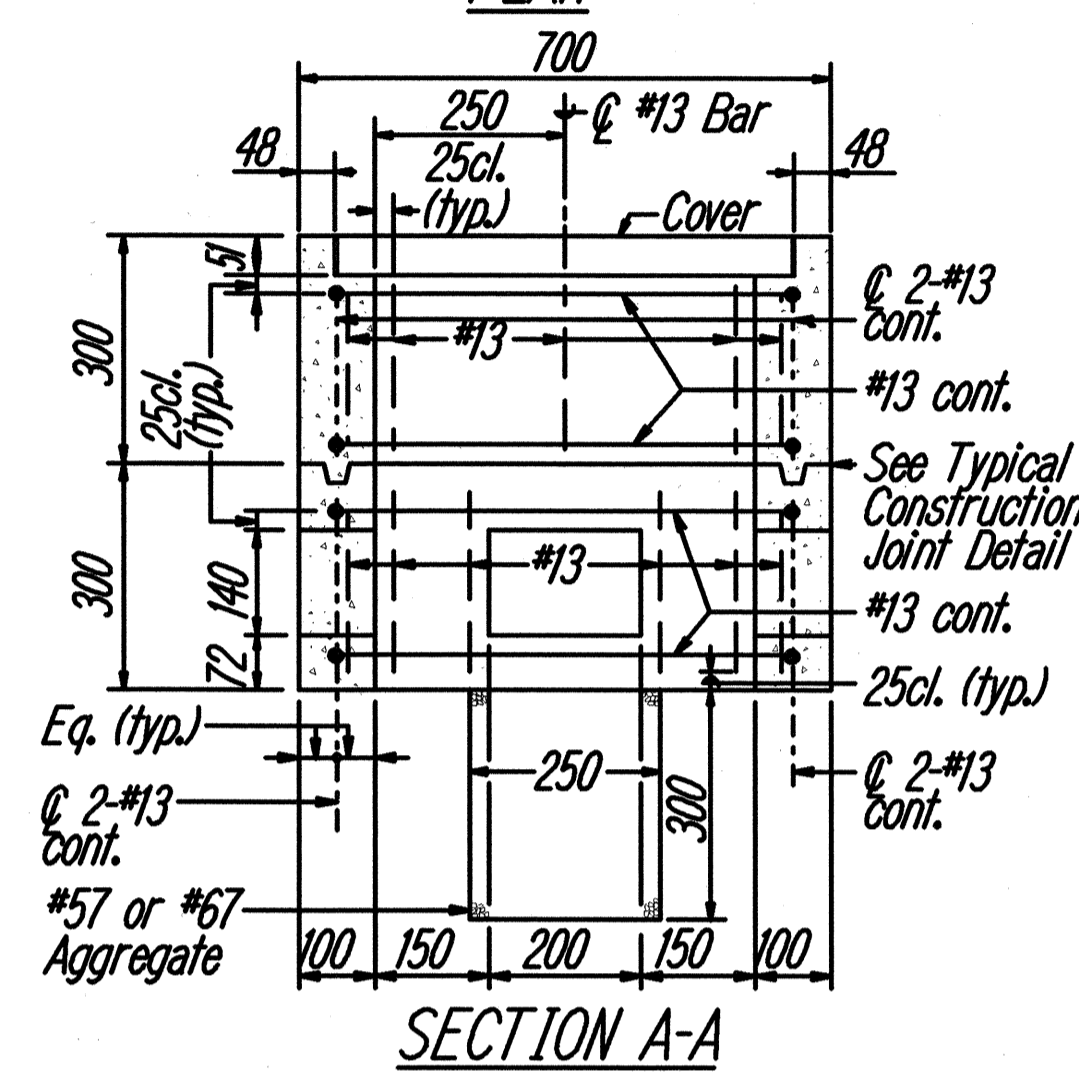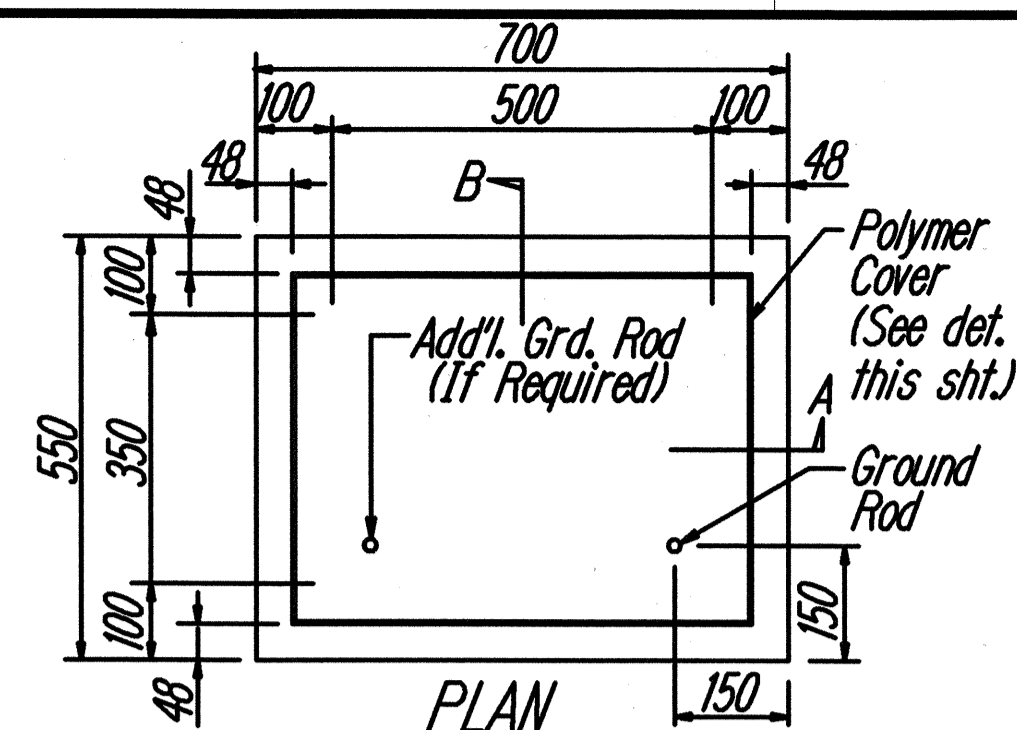


A
E-18
TYPE "A" PULLBOX (Old Type "B")
N.T.S.

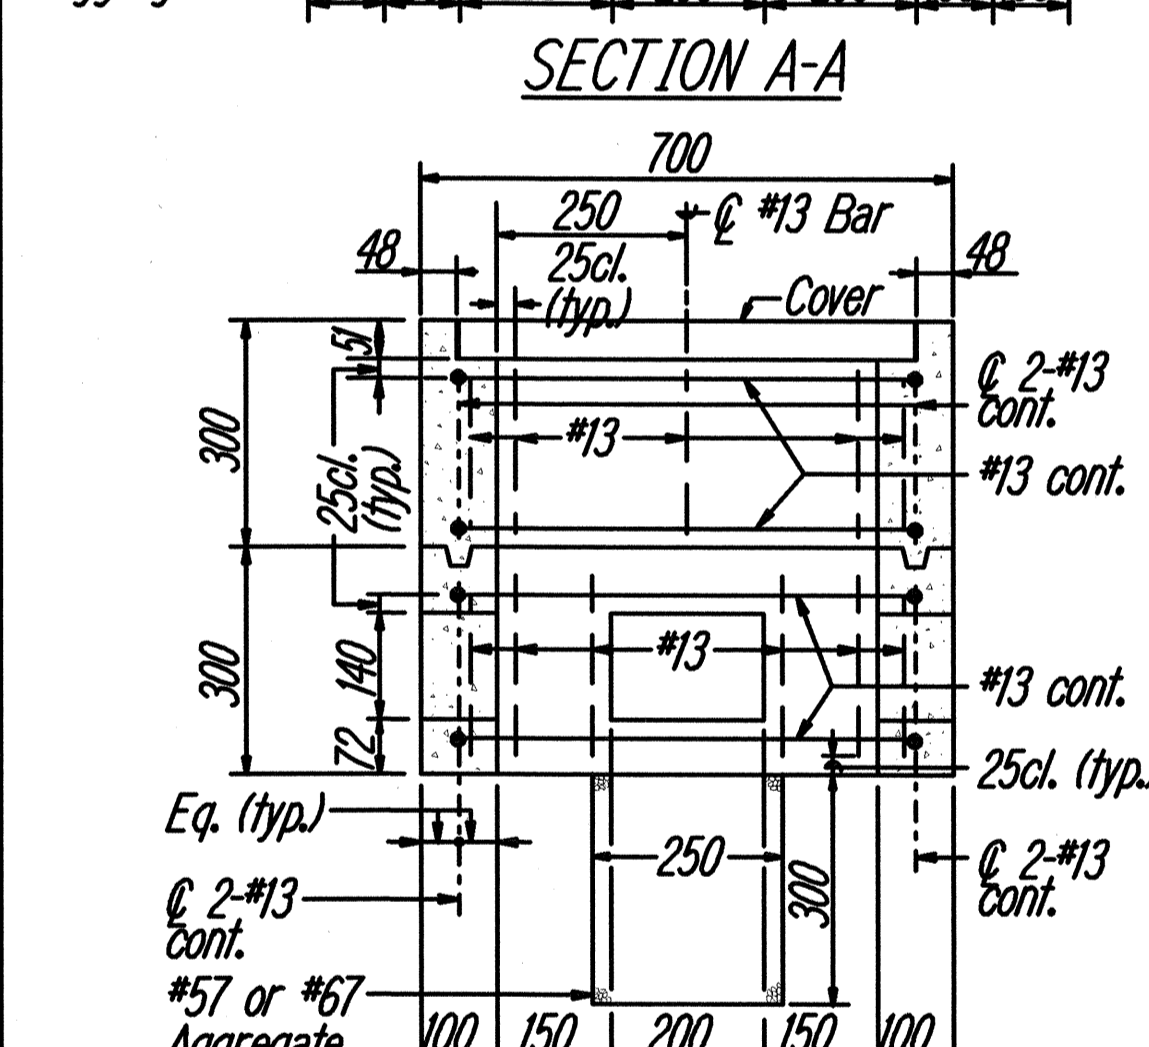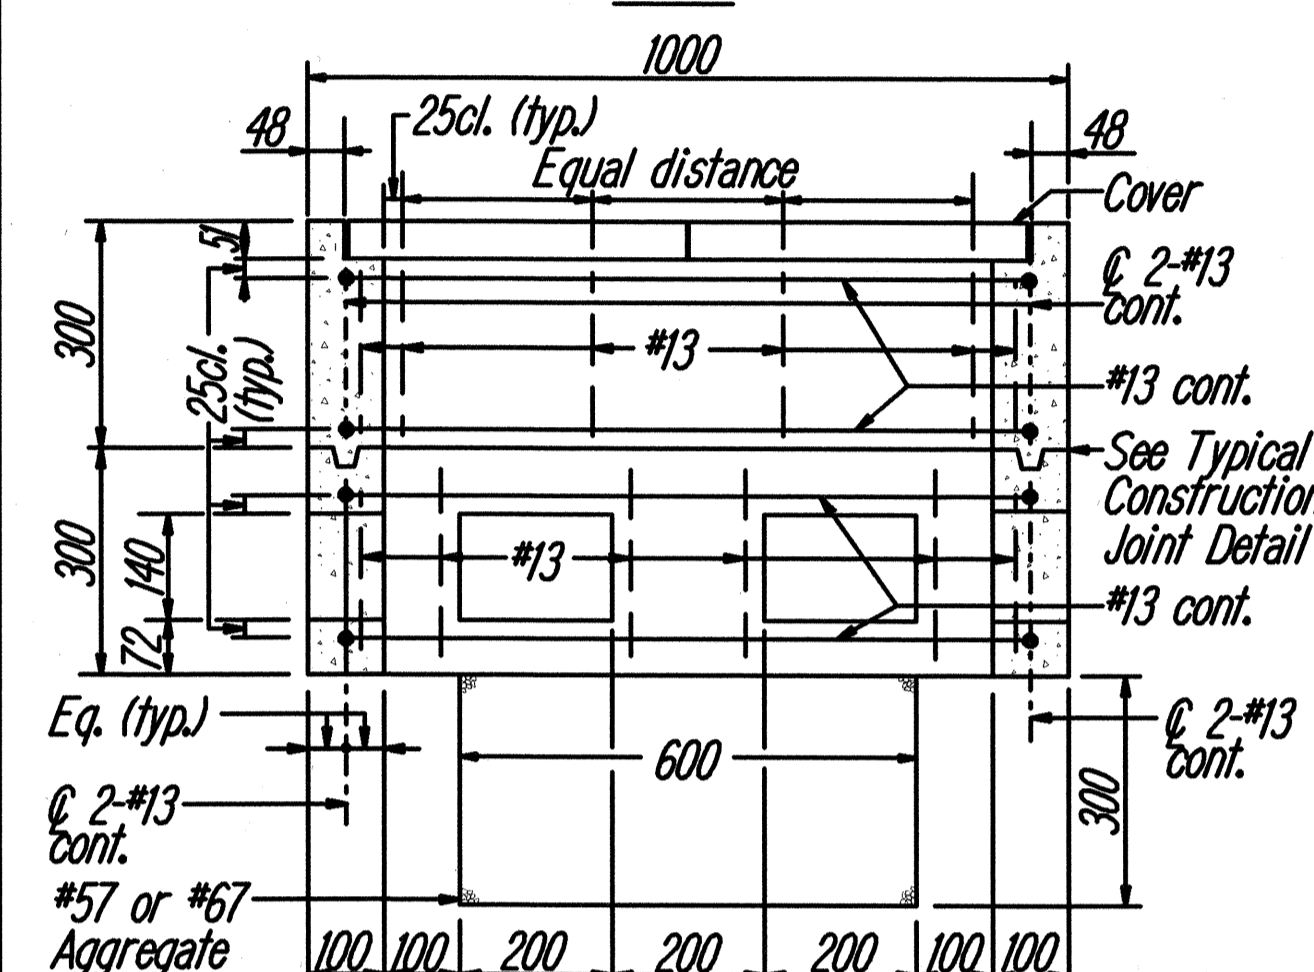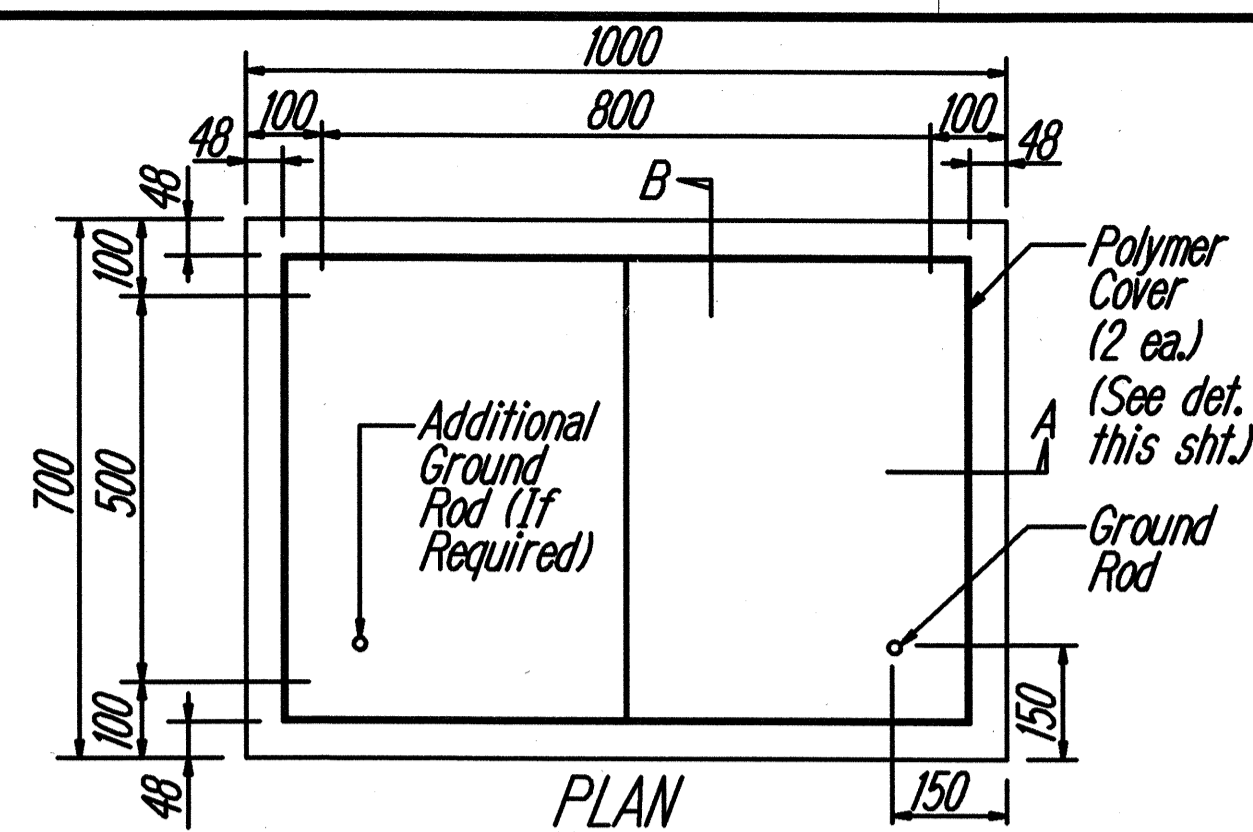


B
E-18
TYPE "B" PULLBOX (Old Type "C")
N.T.S.

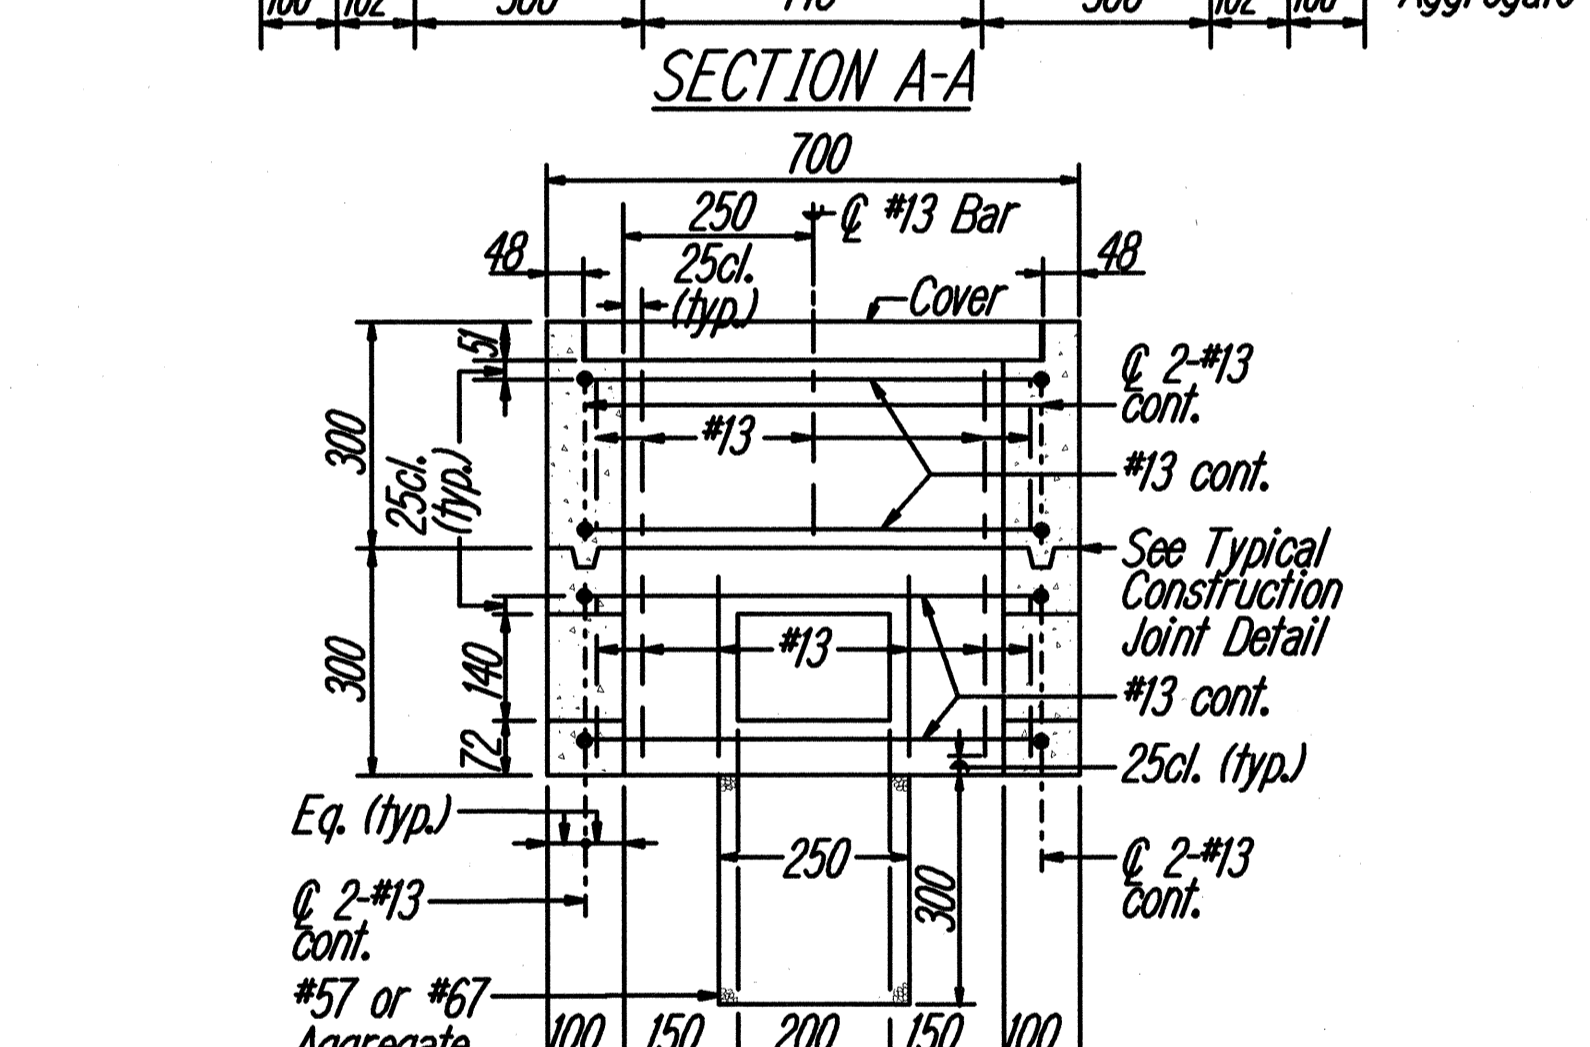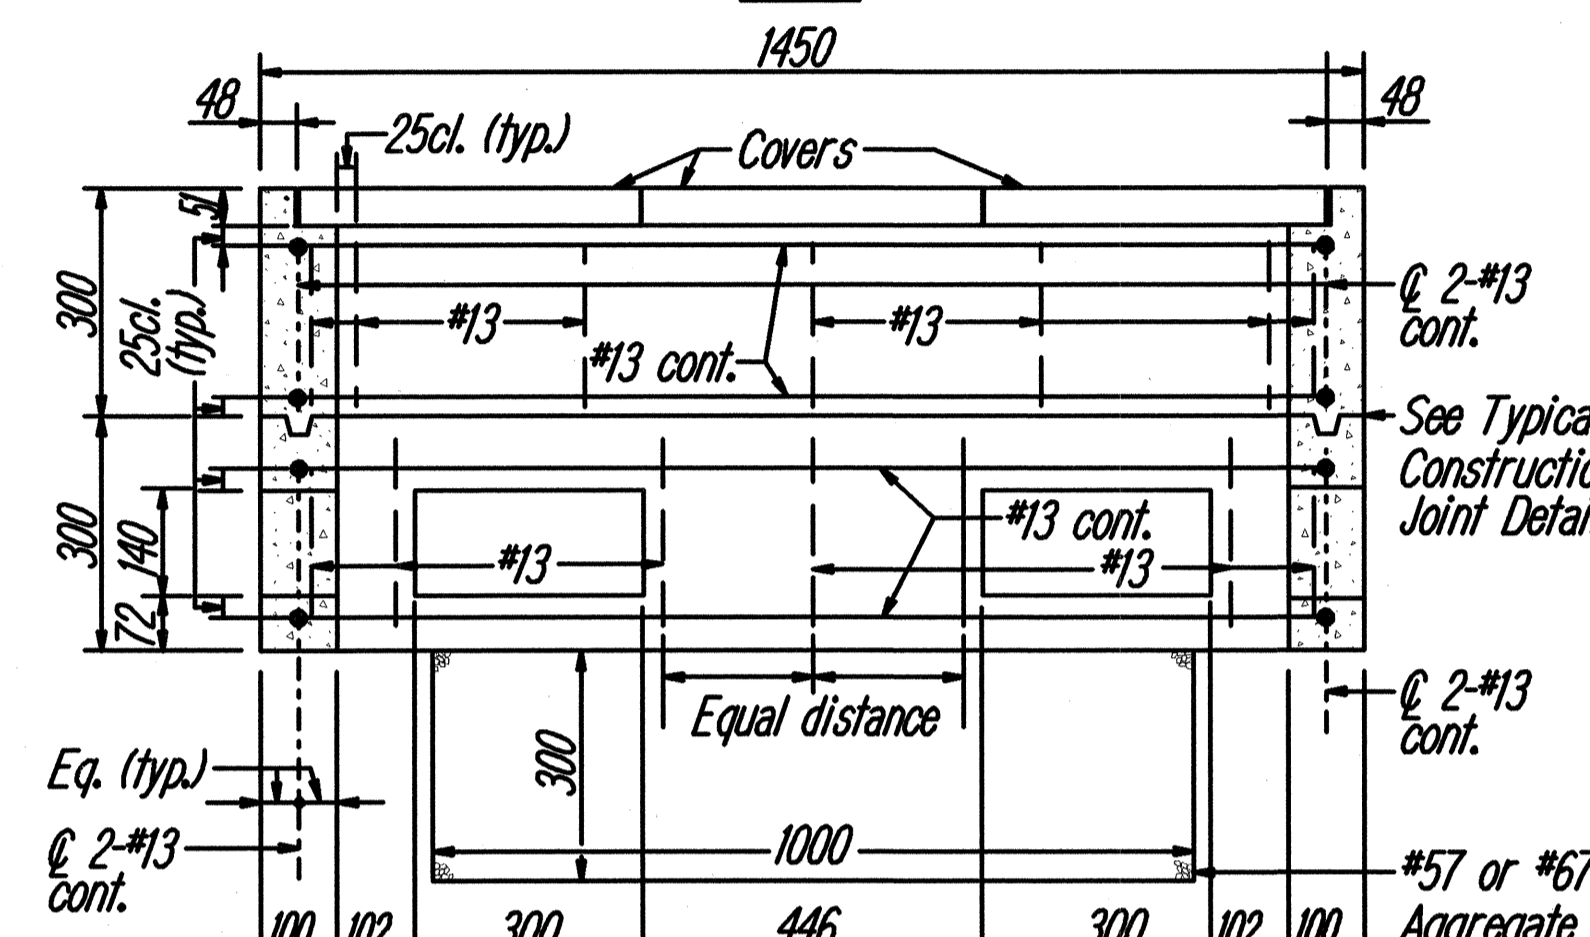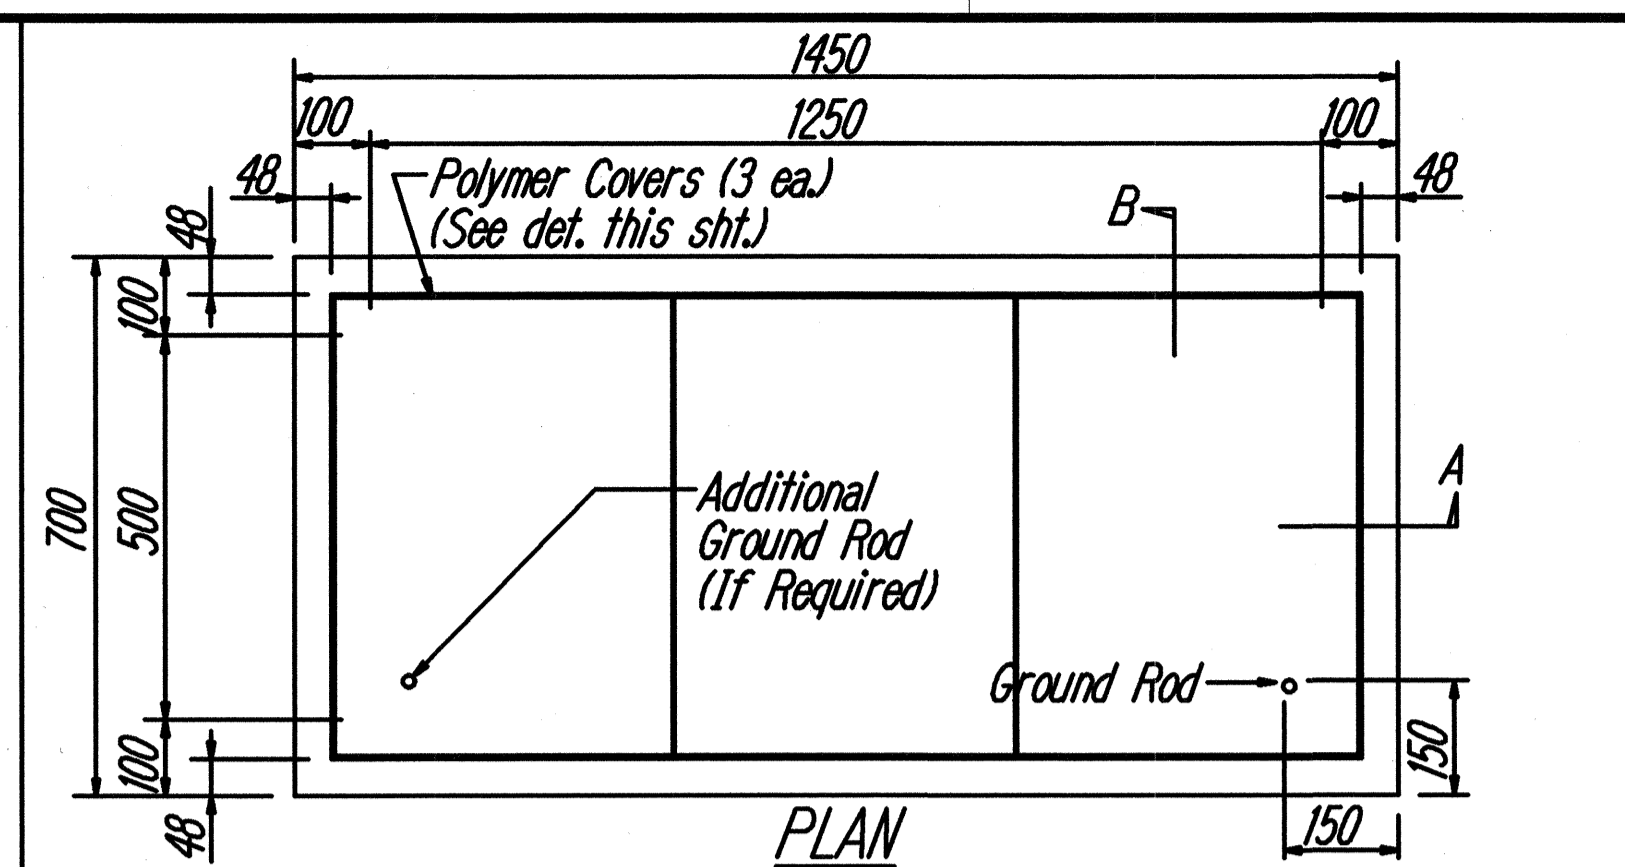


C
E-18
TYPE "C" PULLBOX (Old Type "D")
N.T.S.

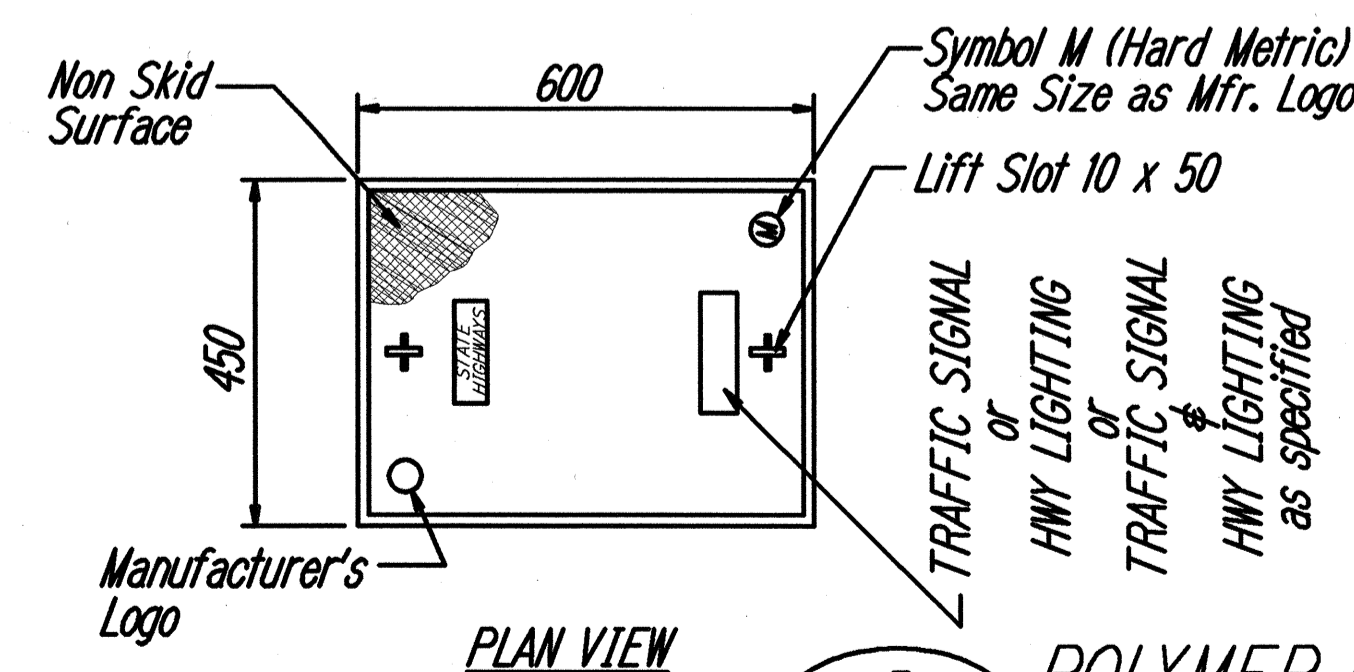

E
E-18
POLYMER CONCRETE COVER
N.T.S.

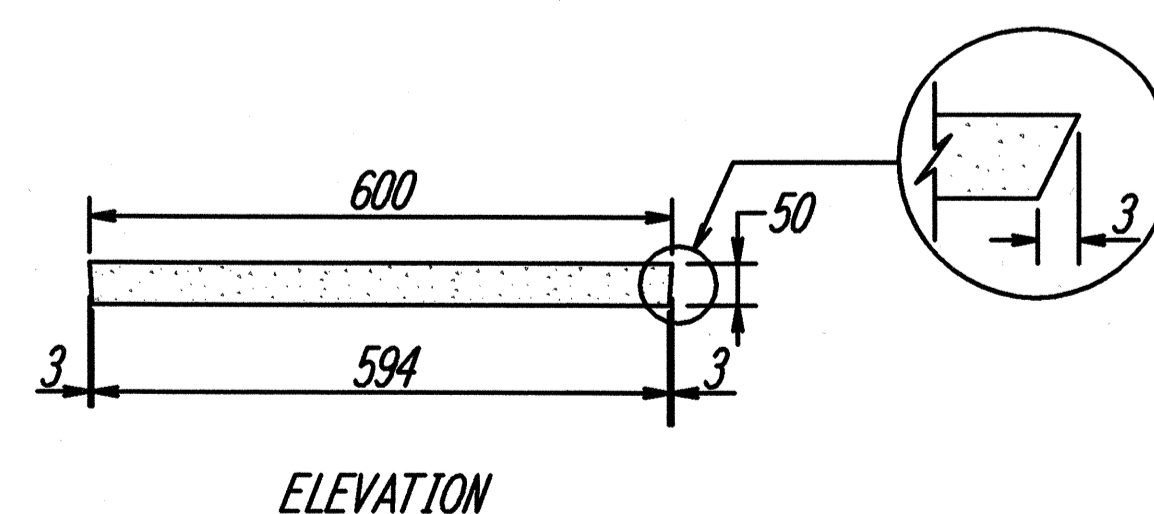

ELEVATION

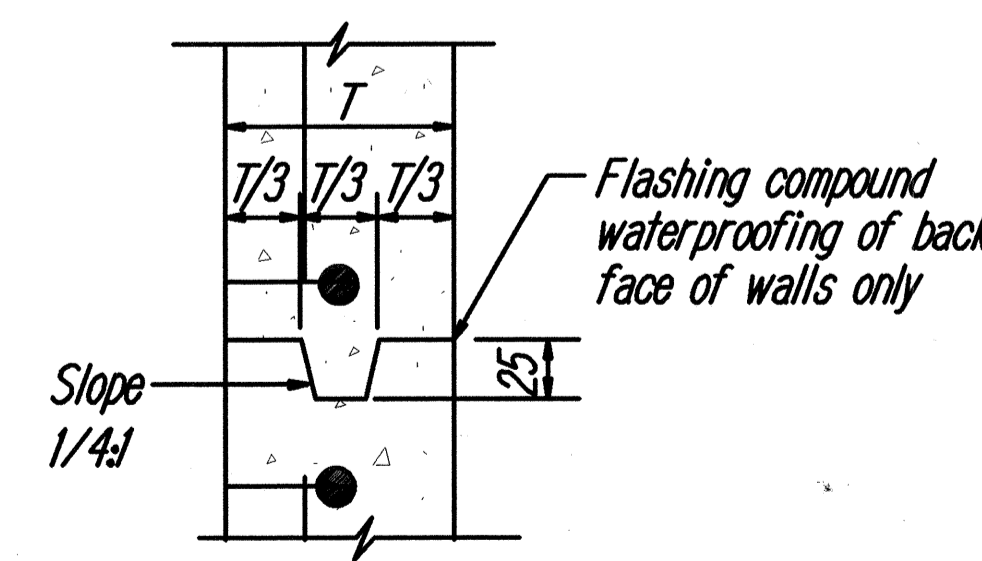

F
E-18
TYPICAL CONSTRUCTION JOINT DETAIL
N.T.S.

ORIGINAL PLAN	DATE
DRAWN BY	
CHECKED BY	
NOTED BY	
QUANTITIES BY	
CHECKED BY	


09 AUG 100 06:52:03 LA 22:woodhollowcollects@9004d04d00408.d08.com

 Trench Backfill Material "A" Beach Sand, Earth, or Earth and Gravel if Earth and Gravel used, the maximum shall contain not more than 50% by volume of rock particles. Maximum 8" loose fill per lift. Obtain 95% compaction for each lift.


NOTE: Base Course & Sub-Base Course per 1994 State Standard Specifications for Highway Construction.

1. If trench is located on unpaired area, the Contractor shall replace 10" A.C. Base Course and 4" A.C. Pavement with Type "A" backfill material.
2. The Metal Detectable Red Plastic Warning Tape shall be a minimum 5 mils thick and 4" wide with a continuous metallic backing and corrosion resistant 1 mil thick foil core. The tape shall read, "CAUTION - STATE TRAFFIC SIGNAL AND/OR HWY LIGHTING BURIED BELOW," utilizing 3 inch series "C" lettering. The message will be repeated with a 12-inch spacing between the end and beginning of repeated message.
3. The Contractor may begin backfilling the conduit trench when the concrete reaches 3000 psi compressive strength after 3 days.
4. Maximum four (4) Conduits per Row for multiple conduit duct section.
5. For direct buried duct sections, the concrete jacket required at the conduit by-pass for various utilities, shall not be paid for separately but considered incidental to the direct buried conduits.
6. After installing all the traffic signal cables, the Contractor shall duct seal all conduits in the pullboxes, traffic signal standards and traffic signal controller cabinet concrete base. The duct seal material shall be approved by the Traffic Signal Inspector/Engineer and shall not be paid for separately but considered incidental to the direct buried and/or concrete encased conduits.

	<i>Clearance</i>
<i>Water</i>	<i>See BWS Note 3, Sht 6</i>
<i>Sewer</i>	<i>24" Min or Provide 6" Thick Reinforced Conc Jacket</i>
<i>Drain</i>	<i>12" Min</i>
<i>HECO/HTCO/ CATV</i>	<i>3" Min</i>
<i>AT≠T</i>	<i>12" Min</i>
<i>Traffic Signal/ Street Light</i>	<i>0"</i>

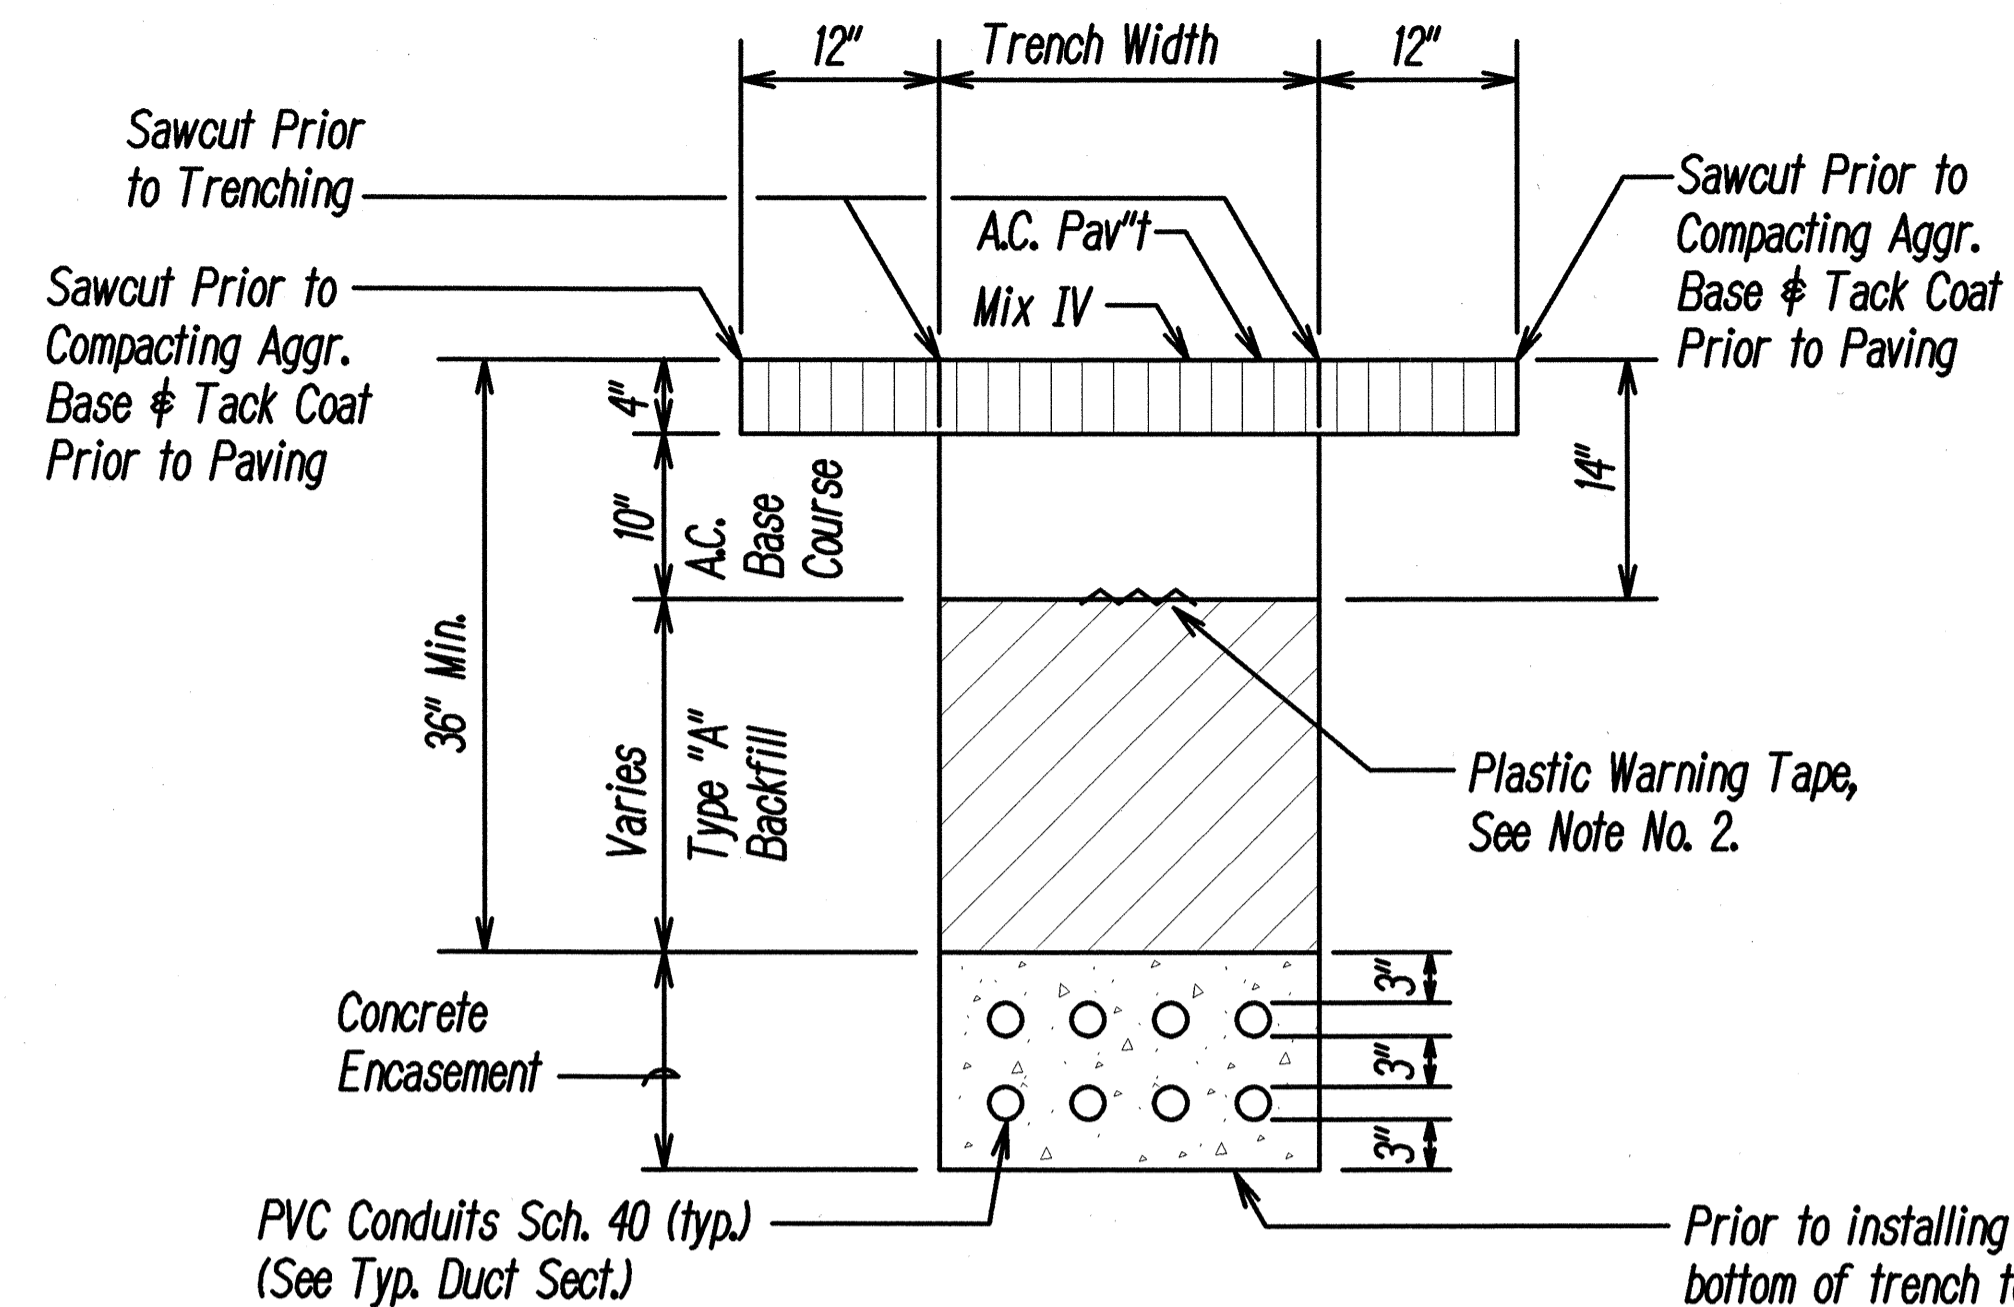



 TYPICAL BACKFILL SECTION WITH
CONCRETE ENCASED DUCTS
N.T.S.

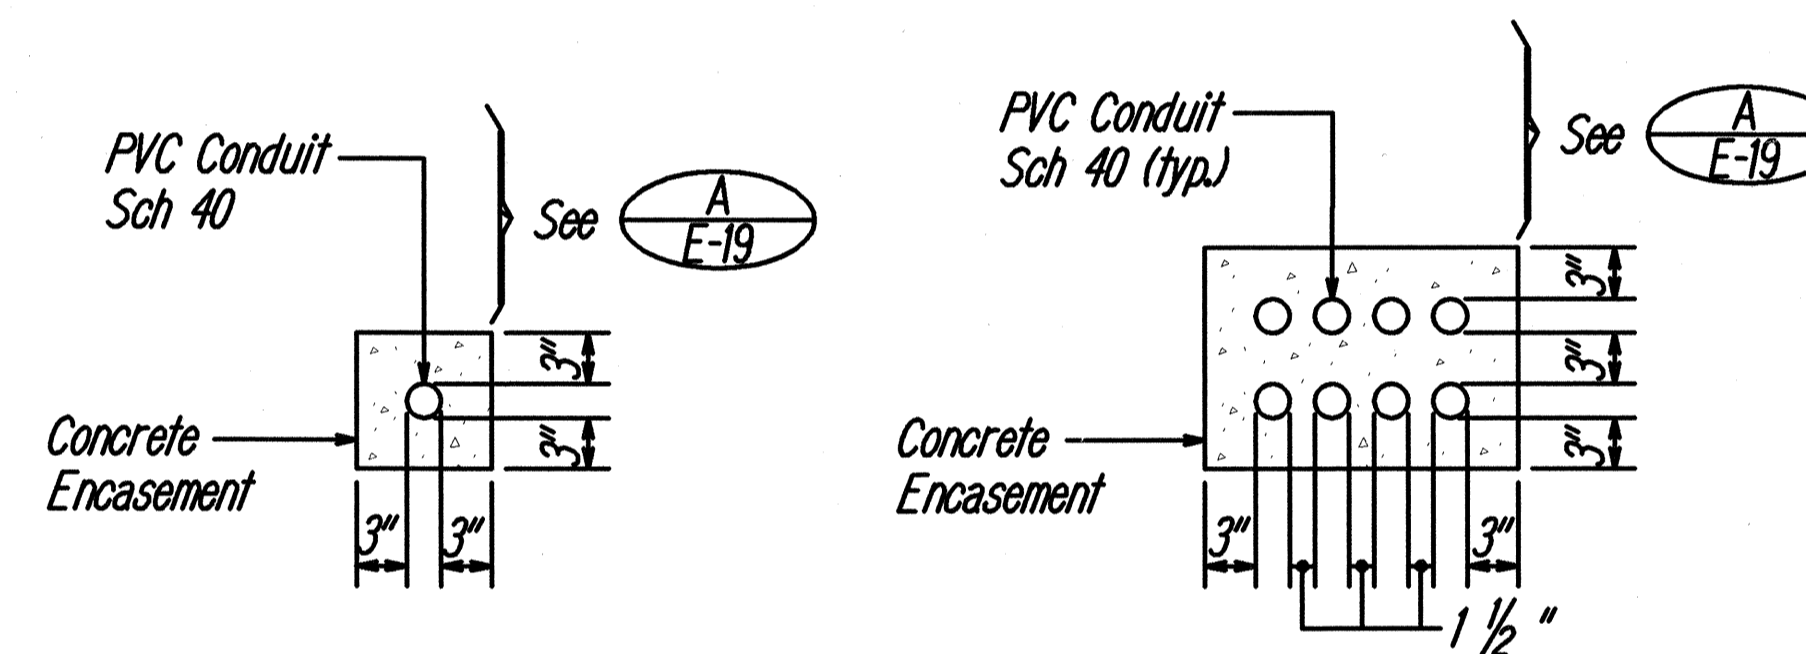




TYPICAL DUCT SECTIONS - CONC. ENCASED
 N.T.S.

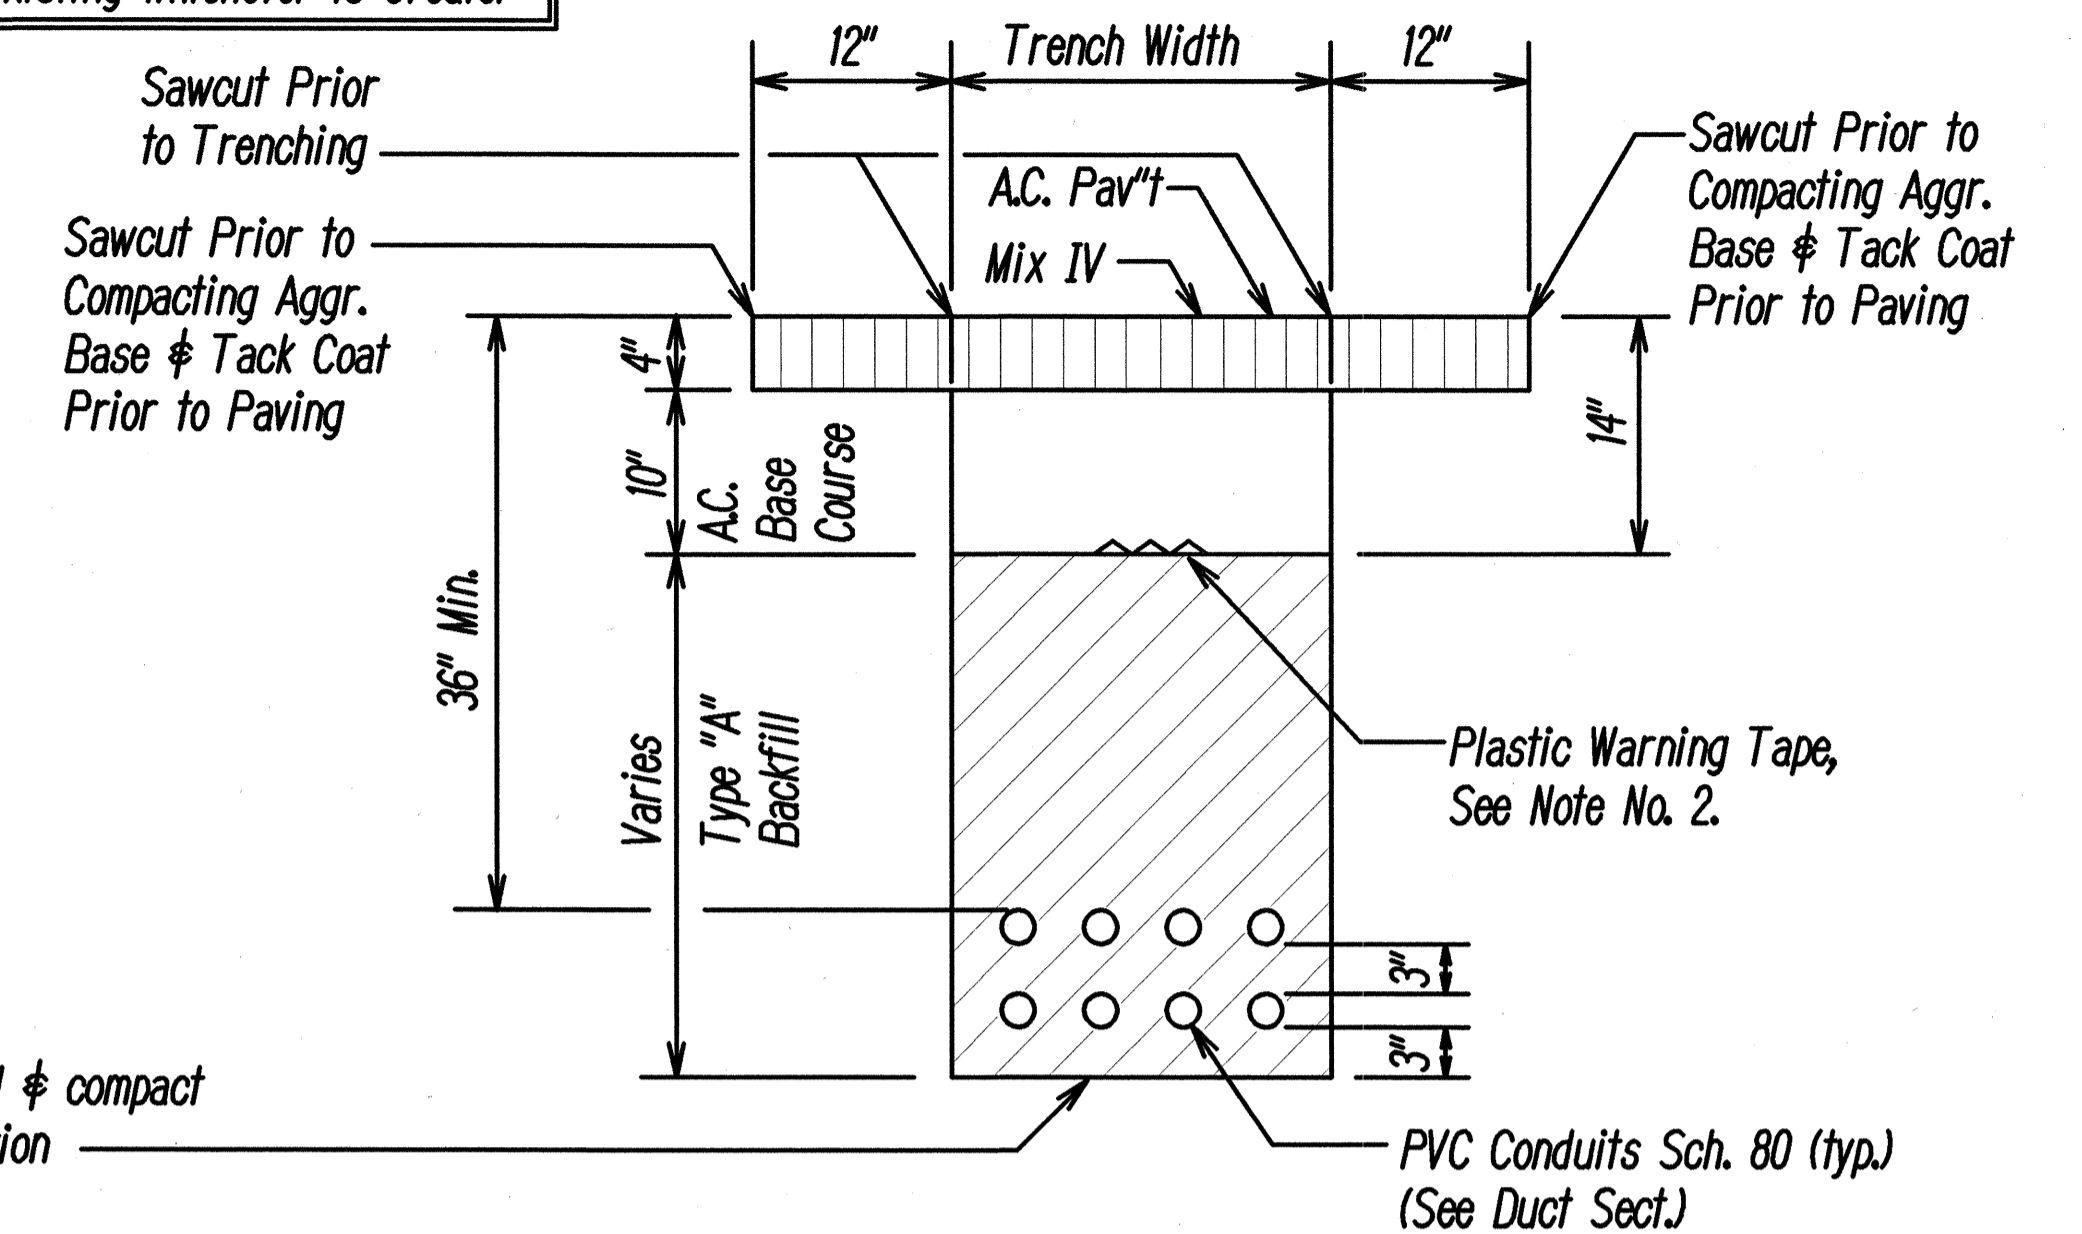


 TYPICAL BACKFILL SECTION
DIRECT BURIED DUCTS
N.T.S.

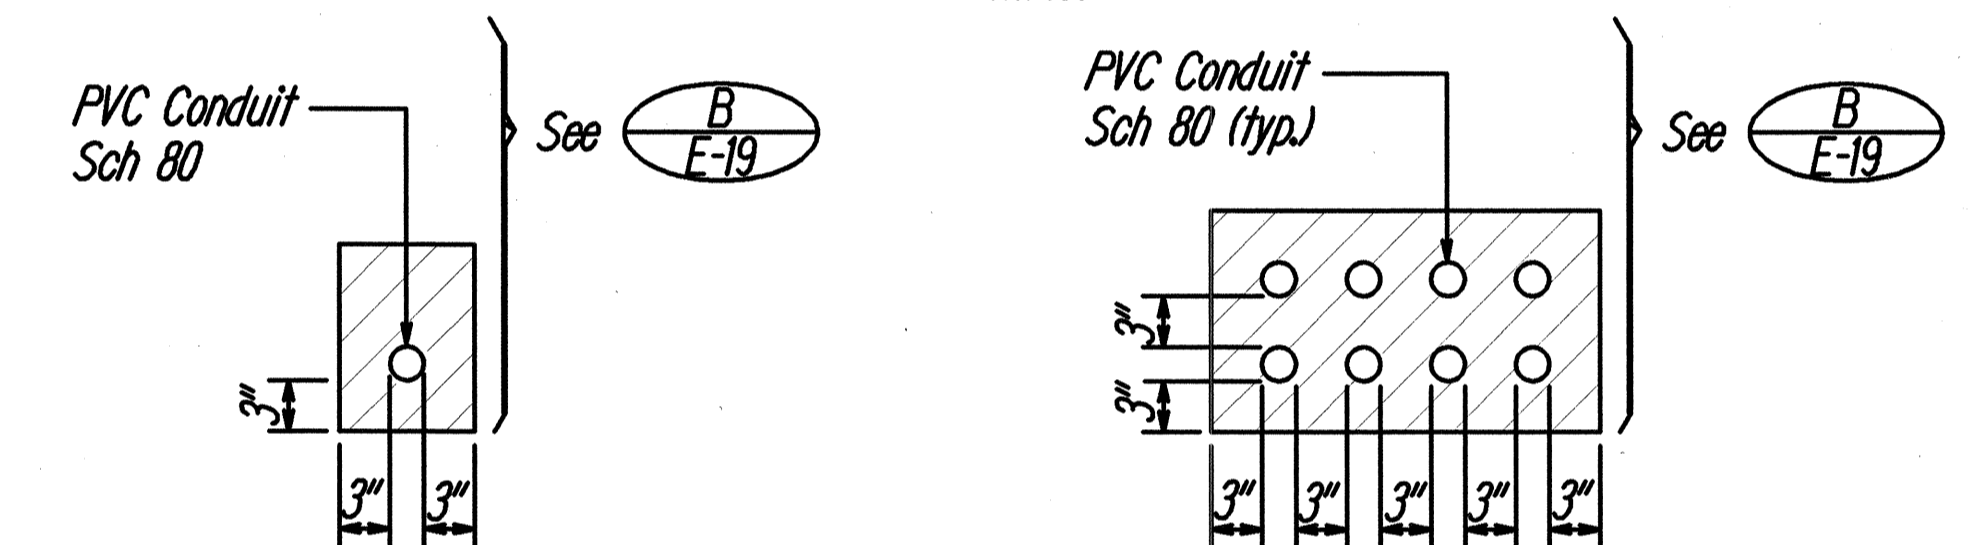




<u>SINGLE CONDUIT</u>	<u>MULTIPLE CONDUIT</u>
<u>TYPICAL DUCT SECTIONS - DIRECT BURIED</u>	
N.T.S.	

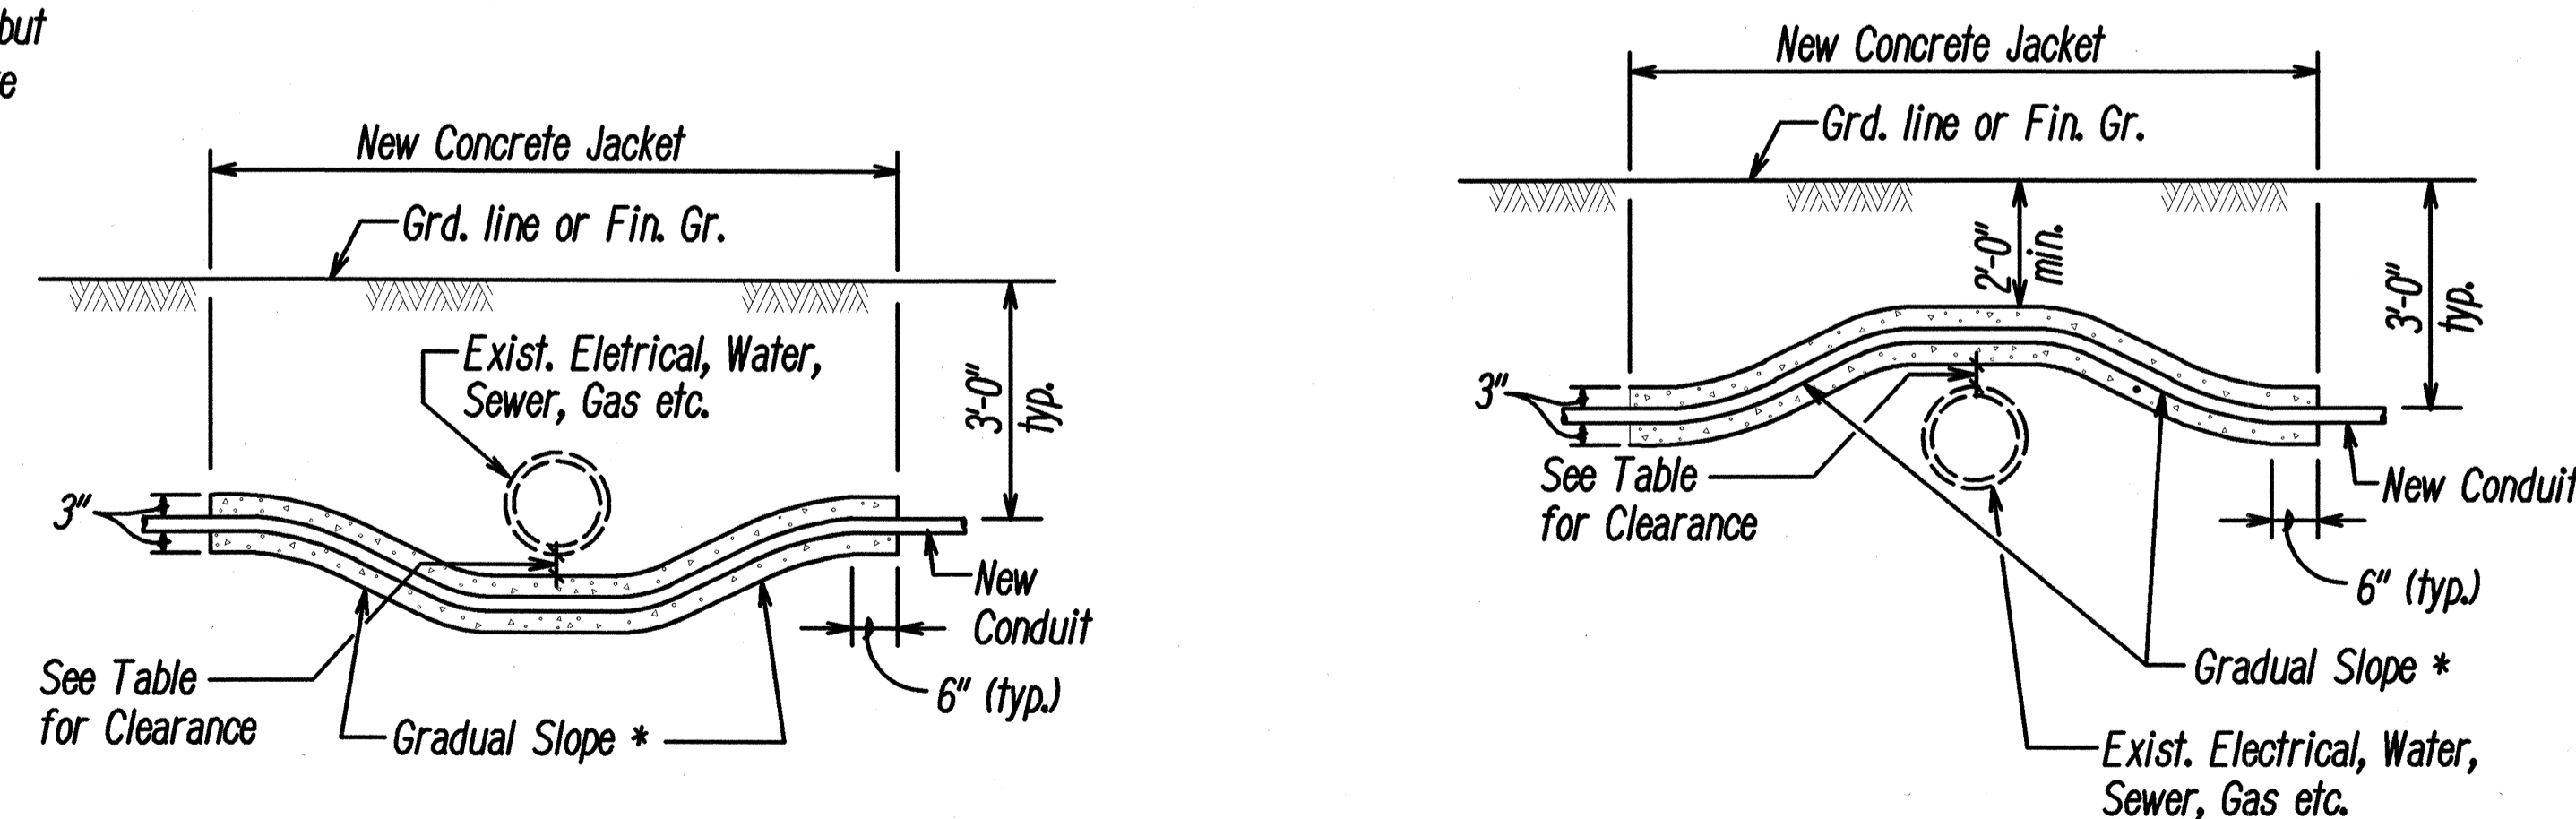

* To be determined by County Electrical Inspector/Engineer


 CONDUIT BY-PASS DETAIL AT VARIOUS UTILITIES

N.T.S.

Note:
Pavement Structure as Shown or
Match Existing Whichever is Greater

See Plan for
Quantity &
Diameter of
Conduits

APPROVED: Catharine Dungea 3/20/01
for CHIEF, PLANNING & ENGINEERING, BWS ^{WD} DATE

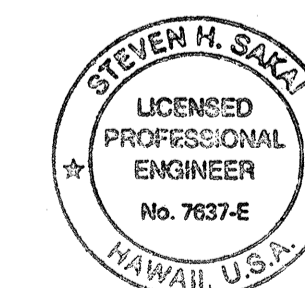

THIS WORK WAS PREPARED BY ME
OR UNDER MY SUPERVISION.

Robert F. Baker

FED. ROAD DIST. NO.	STATE	PROJ. NO.	FISCAL YEAR	SHEET NO.	TOTAL SHEETS
HAWAII	HAW.	93A-06-98	2001	57	68

STATE OF HAWAII
DEPARTMENT OF TRANSPORTATION
HIGHWAYS DIVISION

TYPICAL BACKFILL SECTION DETAILS

FARRINGTON HIGHWAY
Intersection Improvements at Waiomea Street
Project No. 93A-06-98

Scale: None Date: AUGUST 2000

CONDUIT & WIRE SCHEDULE


SYMBOL	DESCRIPTION
△	2"C, 2#6, #6 Gnd
△	Remove Exst Wiring; Provide 4#6, #6 Gnd
△	Not Used
△	2"C, 6#6, #6 Gnd
△	Remove Exst Wiring; Provide 6#6, #6 Gnd

See Typ Duct Section "C", Sht E-19 Unless Indicated Otherwise

NOTES:

- 1 Sawcut Exst A.C. Pavement Prior to Trenching & Repaving. Repair to Match Exst. See Det A/E-19. Sawcutting & Repaving shall not be Paid for Separately, but shall be Considered Incidental to the Various Street Light & Traffic Signal Ductline Items.
- 2 Penetrate Exst Pullbox for Conduit Entry. Route Conduit(s) to Pullbox. Repair to Match Exst.
- 3 Remove Exst St Lt Std & Foundation. Cap Exst Conduit & Abandon-in-place.
- 4 Splice Exst Wiring to New Wiring.
- 5 Deenergize Ckts A1 & A2 from Exst Pnl Located @ Sta 77+60 & Disconnect Exst Wiring to Exst St Lt Std on Koio Dr. Tape Ends of Exst Wiring & Neatly Coil in Pullbox. Splice Exst Wiring to New Wiring
- 6 Deenergize Ckts A1 & A2 from Exst Pnl Located @ Sta 77+60 & Disconnect Exst Wiring to Exst St Lt Std on Farrington Hwy. Tape Ends of Exst Wiring & Neatly Coil in Pullbox

FED. ROAD DIST. NO.	STATE	PROJ. NO.	FISCAL YEAR	SHEET NO.	TOTAL SHEETS
HAWAII	HAW.	93A-06-98	2001	59	68

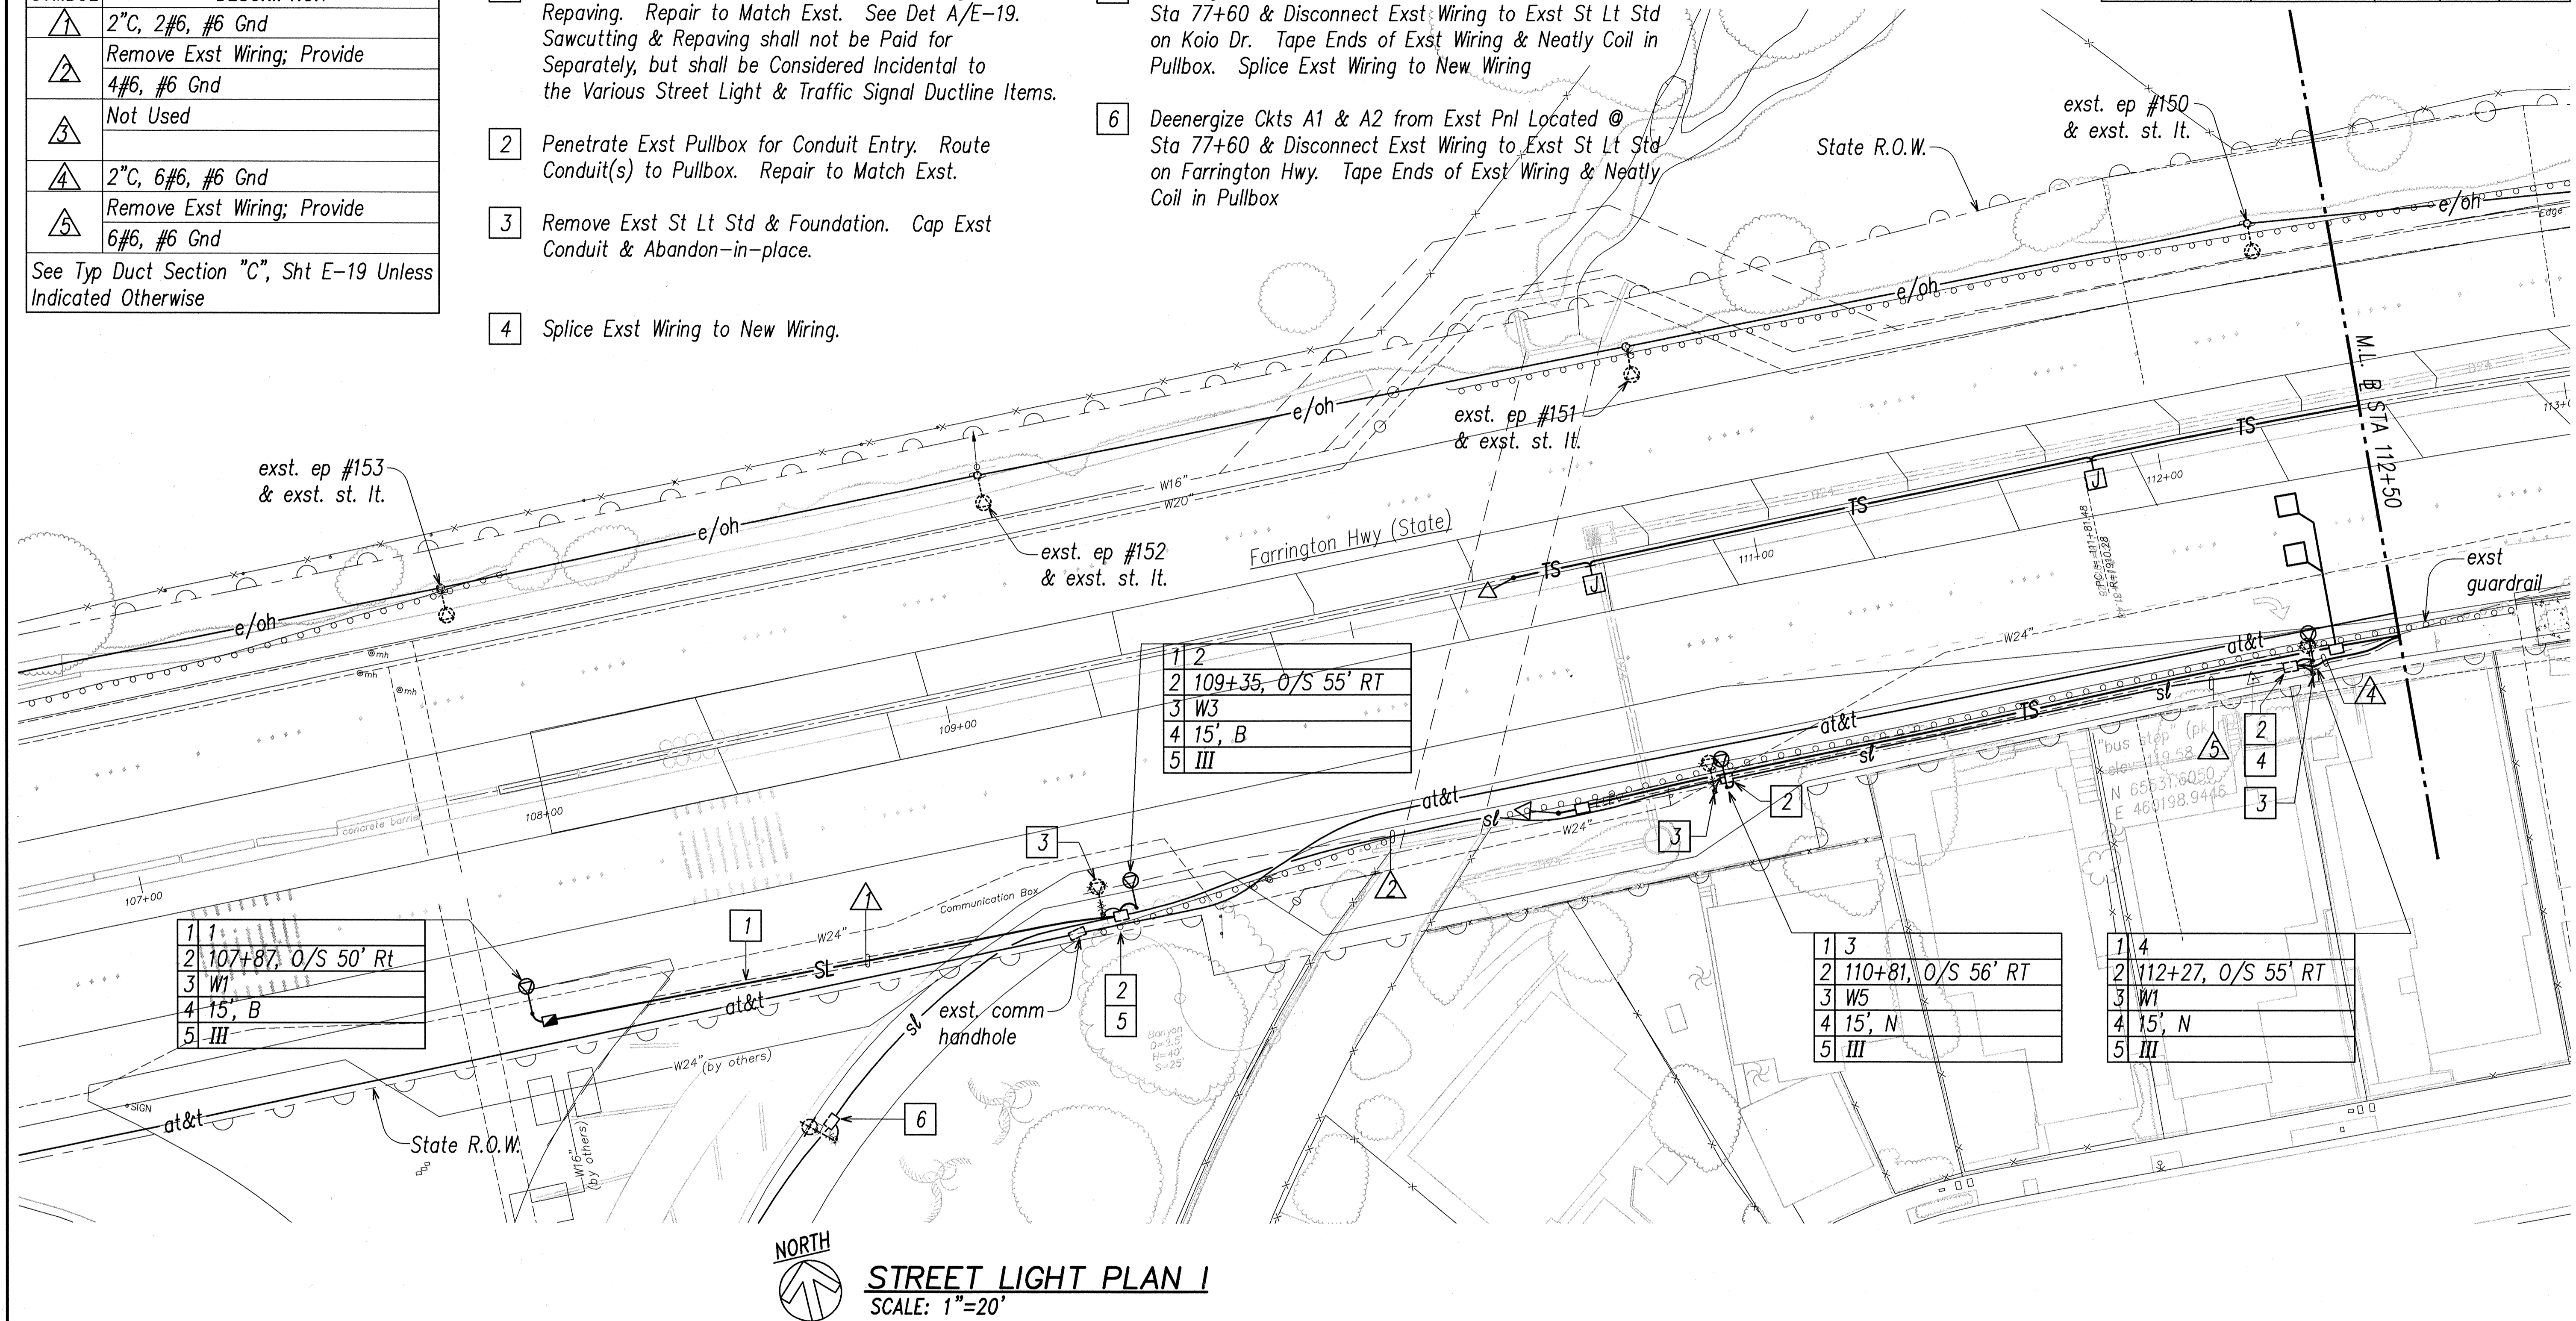

1	1
2	107+87, O/S 50' Rt
3	W1
4	15', B
5	III

1	2
2	109+35, O/S 55' RT
3	W3
4	15', B
5	III

1	3
2	110+81, O/S 56' RT
3	W5
4	15', N
5	III

1	4
2	112+27, O/S 55' RT
3	W1
4	15', N
5	III




STREET LIGHT PLAN I
SCALE: 1"=20'

DATE	
SURVEY PLOTTED BY	
PLAN	
DESIGNED BY	
NOTE BOOK	
QUANTITIES BY	
CHECKED BY	
No.	

LAST SAVE: 08/09/00 @ 07:16:03 BY: TE PLOT SC 1-20
2: VARIOUS PROJECTS (ROAD, RAILROAD, SEWER, WATER, TPO)

APPROVED: *Catharine Dunca* 3/20/01
CHIEF, PLANNING & ENGINEERING, ENS MD DATE
20' 10' 0 20' 40' 60'
SCALE: 1"=20'
GRAPHIC SCALE

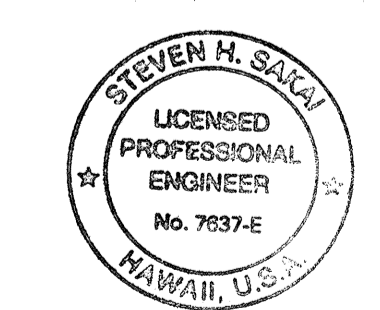

THIS WORK WAS PREPARED BY ME
OR UNDER MY SUPERVISION.
Karen H. Hagan

STATE OF HAWAII
DEPARTMENT OF TRANSPORTATION
HIGHWAYS DIVISION


STREET LIGHT PLAN I

FARRINGTON HIGHWAY
Intersection Improvements at Waiomea Street
Project No. 93A-06-98

Scale: AS NOTED Date: AUGUST 2000

SHEET No. E-21 OF 30 SHEETS

FED. ROAD DIST. NO.	STATE	PROJ. NO.	FISCAL YEAR	SHEET NO.	TOTAL SHEETS
HAWAII	HAW.	93A-06-98	2001	60	68

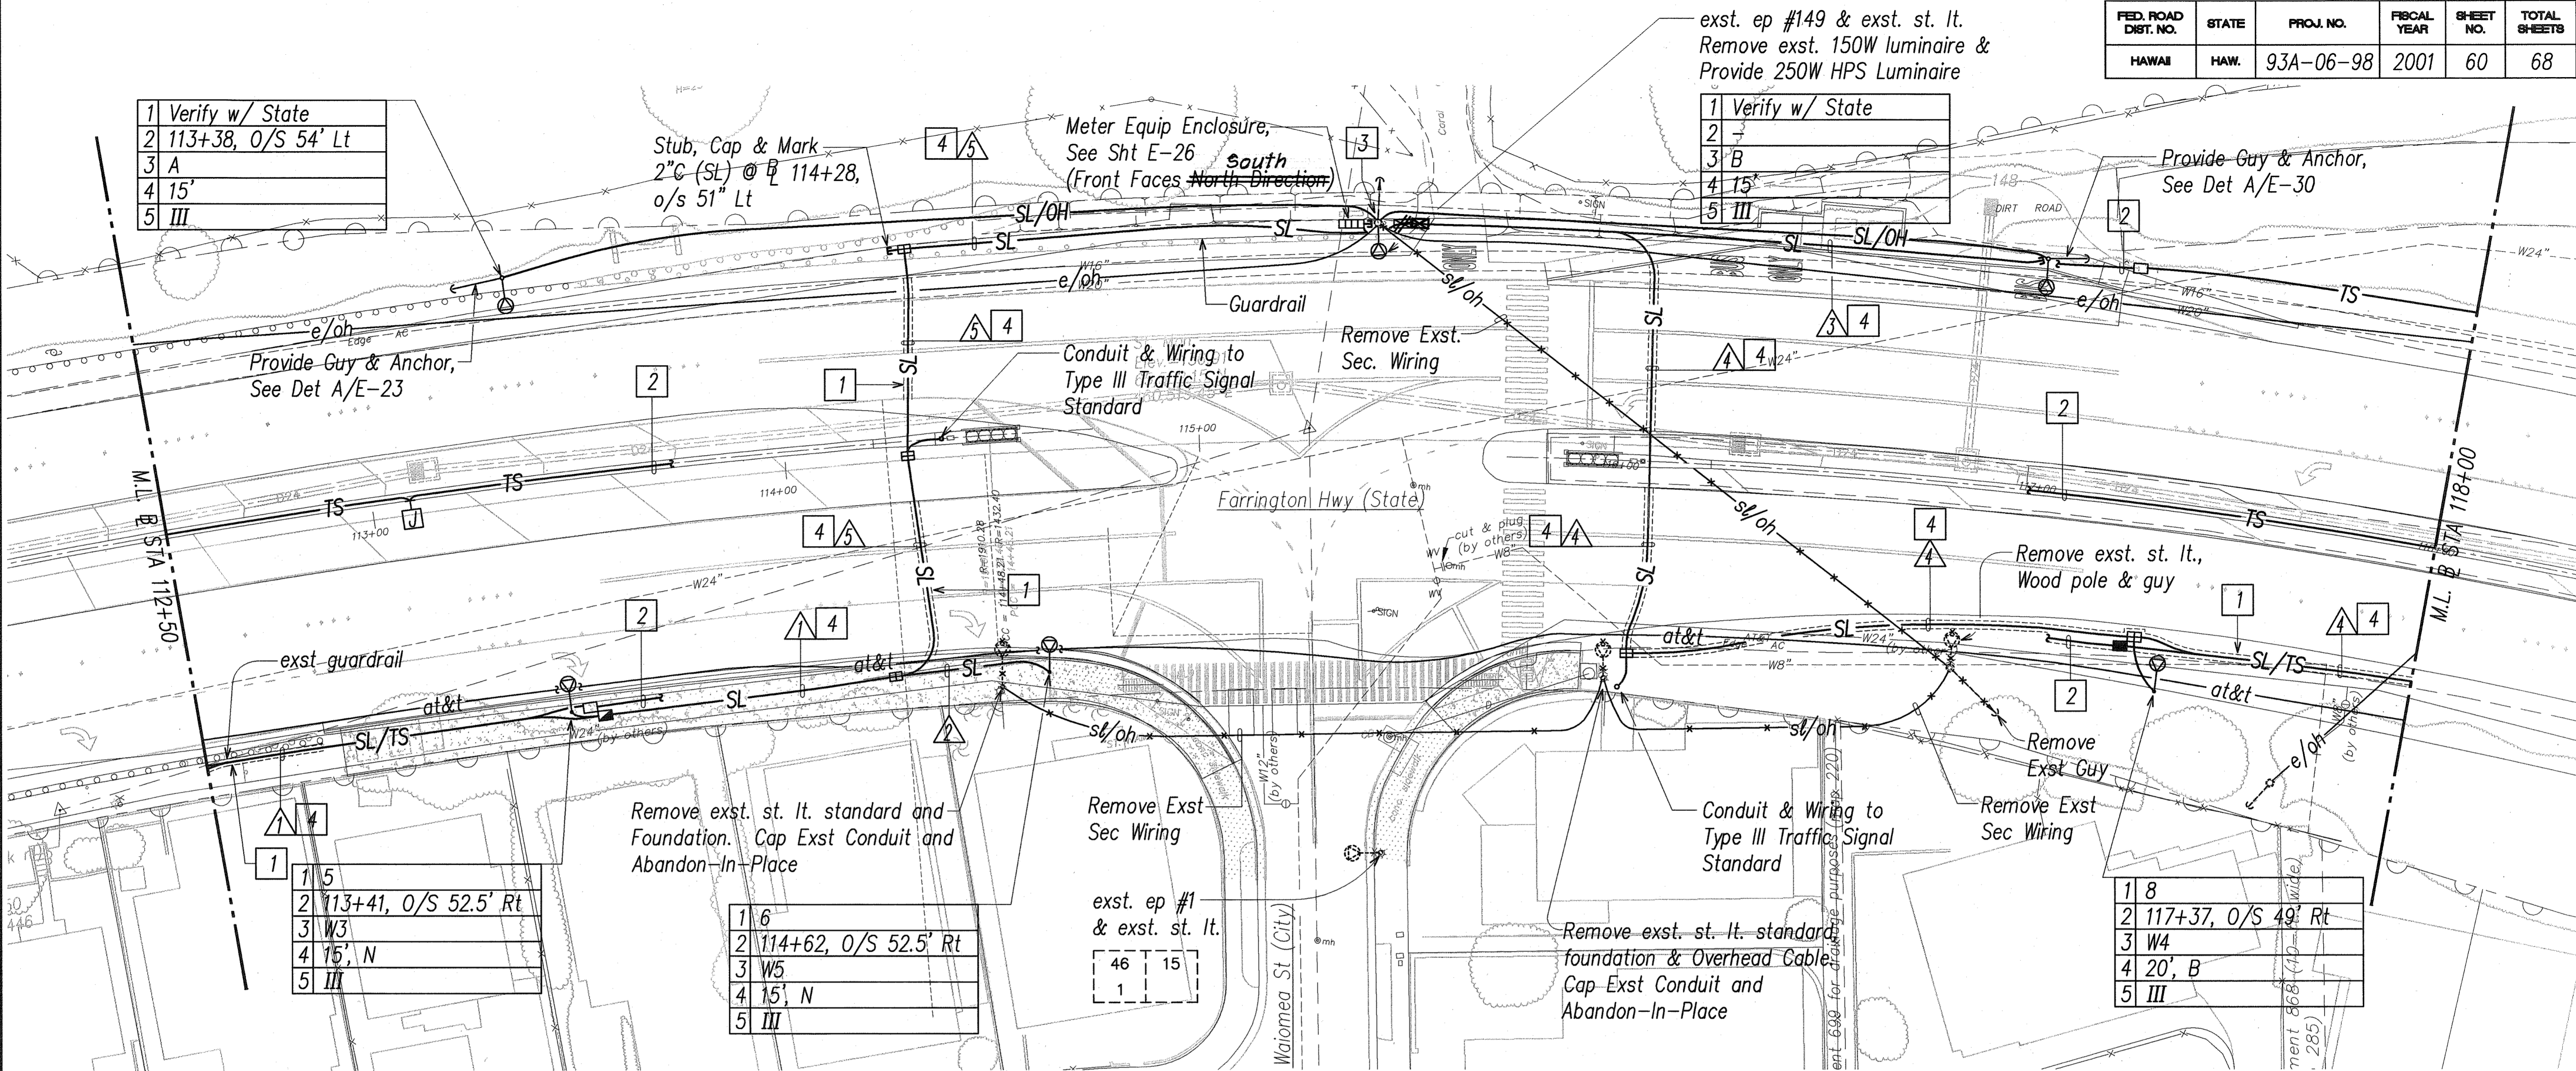

CONDUIT & WIRE SCHEDULE

SYMBOL	DESCRIPTION
1	2"C, 6#6, #6 Gnd
2	1 1/2"C, 2#8, #8 Gnd
3	2-3"C, Pullwire in Each
4	3"C, 6#1/0, #2 Gnd
5	3"C, Pullwire
6	2"C, 6#6, #6 Gnd
7	2"C, Pullwire

See Typ Duct Section "C", Sht E-19
Unless Indicated Otherwise



STREET LIGHT PLAN II

SCALE: 1"=20'

NOTES:


- 1 Sawcut Exst A.C. Pavement Prior to Trenching & Repaving. Repair to Match Exst. See Det A/E-19. Sawcutting & Repaving Exst A.C. Pavement shall not be Paid for Separately, but shall be Considered Incidental to the Various Street Light & Traffic Signal Ductline Items.
- 2 See Traffic Signal Plan II for Continuation
- 3 Prior to Trench & Excavation Near Exst Pole, Contractor shall Coordinate Temporary Pole Bracing w/ HEC, See HEC Note 6, Sht 5.
- 4 Route Street Light Ductline w/ Traffic Signal Ductline, See Sht E-4. Street Lighting Ductline shall be Paid Under Traffic Signal/Street Light Ductline in Section 623.

APPROVED:

Catherine Drunaga 3/20/01
for CHIEF, PLANNING & ENGINEERING, EHS

20' 10' 0 20' 40' 60'
SCALE: 1"=20'

GRAPHIC SCALE

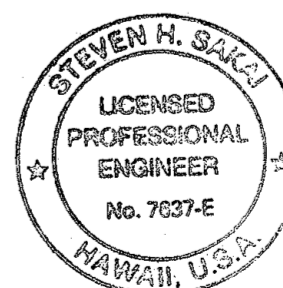

THIS WORK WAS PREPARED BY ME
OR UNDER MY SUPERVISION
[Signature]

STATE OF HAWAII
DEPARTMENT OF TRANSPORTATION
HIGHWAYS DIVISION

STREET LIGHT PLAN II


FARRINGTON HIGHWAY
Intersection Improvements at Waimea Street
Project No. 93A-06-98

Scale: As Noted Date: AUGUST 2000

SHEET No. E-22 OF 30 SHEETS

"AS-BUILT"

FED. ROAD DIST. NO.	STATE	PROJ. NO.	FISCAL YEAR	SHEET NO.	TOTAL SHEETS
HAWAII	HAW.	93A-06-98	2001	61	68

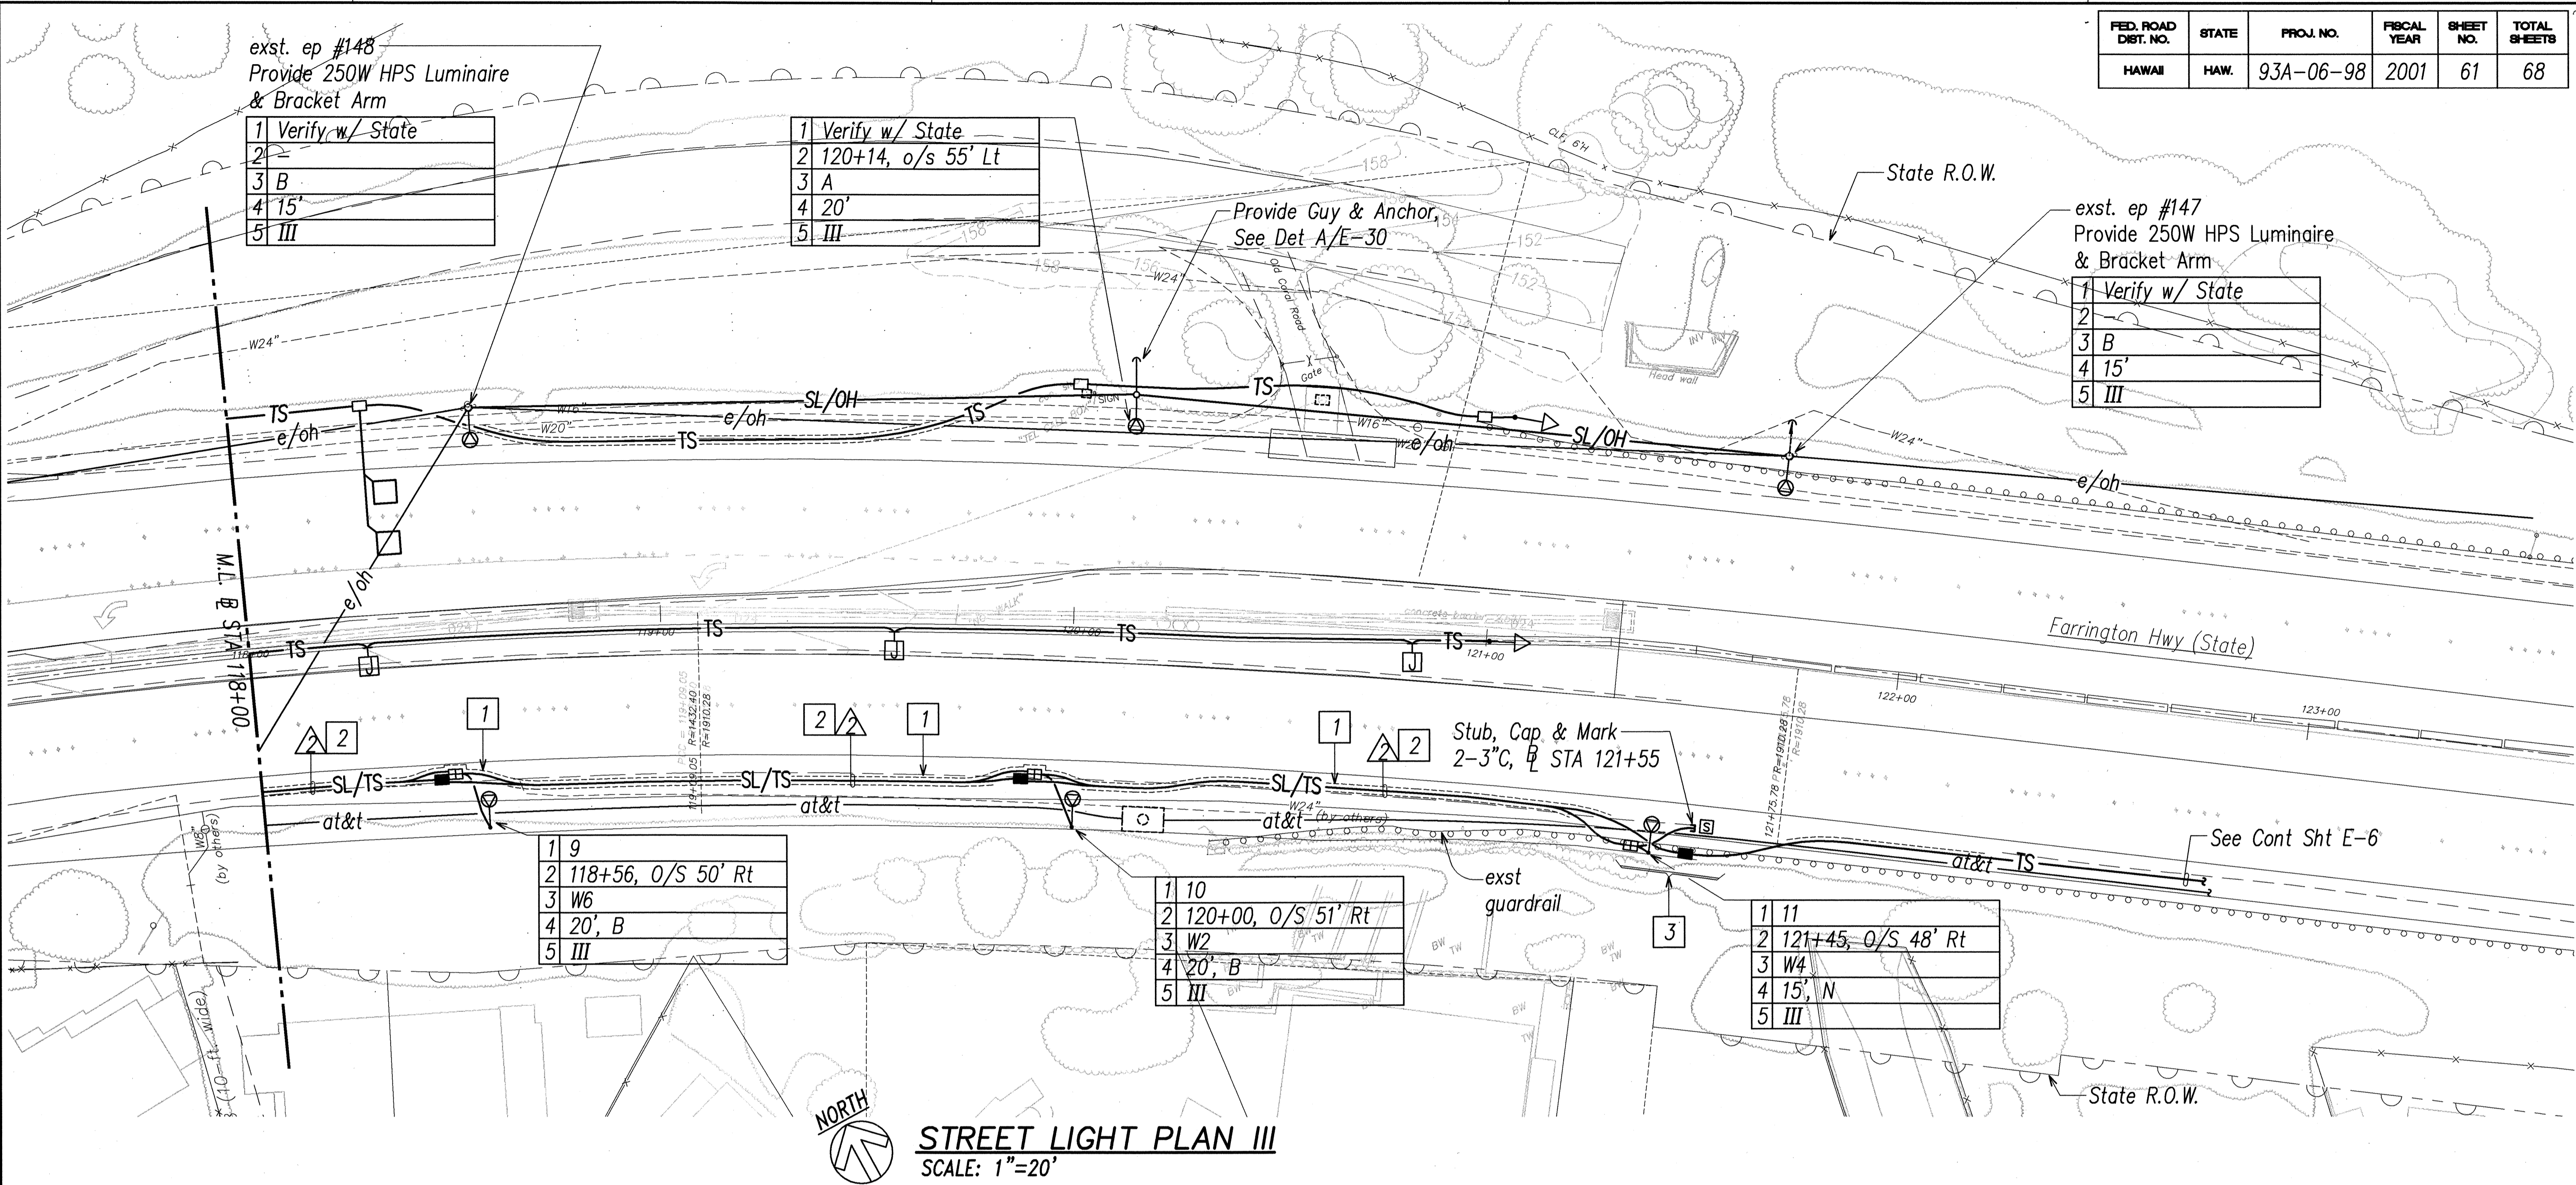

STREET LIGHT PLAN III
SCALE: 1"=20'

CONDUIT & WIRE SCHEDULE



SYMBOL	DESCRIPTION
△1	Not Used
△2	3"C, 6#1/0, #2 Gnd 3"C, Pullwire

See Typ Duct Section "C", Sht E-19 Unless Indicated Otherwise

NOTES:

- 1 Sawcut Exst A.C. Pavement Prior to Trenching & Repaving. Repair to Match Exst. See Det A/E-19. Sawcutting & Repaving shall not be Paid for Separately, but shall be Considered Incidental to the Various Street Light & Traffic Signal Ductline Items.
- 2 Route Street Light Ductline w/ Traffic Signal Ductline, See Sht E-5. Street Light Ductline shall be Paid Under Traffic Signal/Street Light Ductline in Section 623.
- 3 Remove Exst Guardrail as Required to Install Ductline. Reinstall per State Std Details. Removal & Installation of Exst Guardrail shall not be Paid for Separately, but Considered Incidental to the Various Street Light & Traffic Signal Ductline Items.

APPROVED:
Cedric Dungea 3/20/01
CHIEF, PLANNING & ENGINEERING, BWS DATE

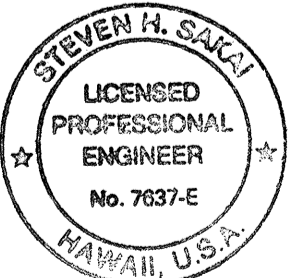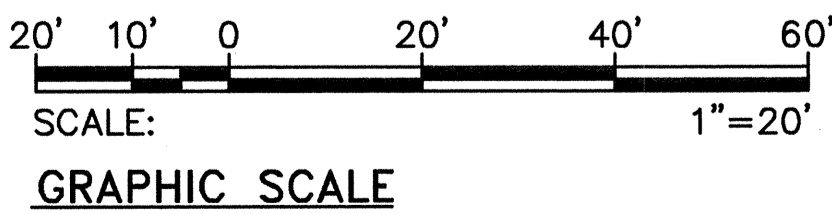

THIS WORK WAS PREPARED BY ME
OR UNDER MY SUPERVISION
Steven H. Saito

STATE OF HAWAII
DEPARTMENT OF TRANSPORTATION
HIGHWAYS DIVISION

STREET LIGHT PLAN III


FARRINGTON HIGHWAY
Intersection Improvements at Waiomea Street
Project No. 93A-06-98
Scale: As Noted Date: AUGUST 2000

SHEET No. E-23 OF 30 SHEETS


DATE	
SURVEY PLOTTED BY	
PLAN	
TRACED BY	
DESIGNED BY	
QUANTITIES BY	
CHECKED BY	
ORIGINAL PLAN	
NOTE BOOK	
No.	

LAST SAVE: 08/09/00 @ 07:08:57 BY: TE PLT SC 1:20
2: VCD PROJECTS\BWS\ROADS\A\93A\93A06\98\9806061.DWG

FED. ROAD DIST. NO.	STATE	PROJ. NO.	FISCAL YEAR	SHEET NO.	TOTAL SHEETS
HAWAII	HAW.	93A-06-98	2001	66	68

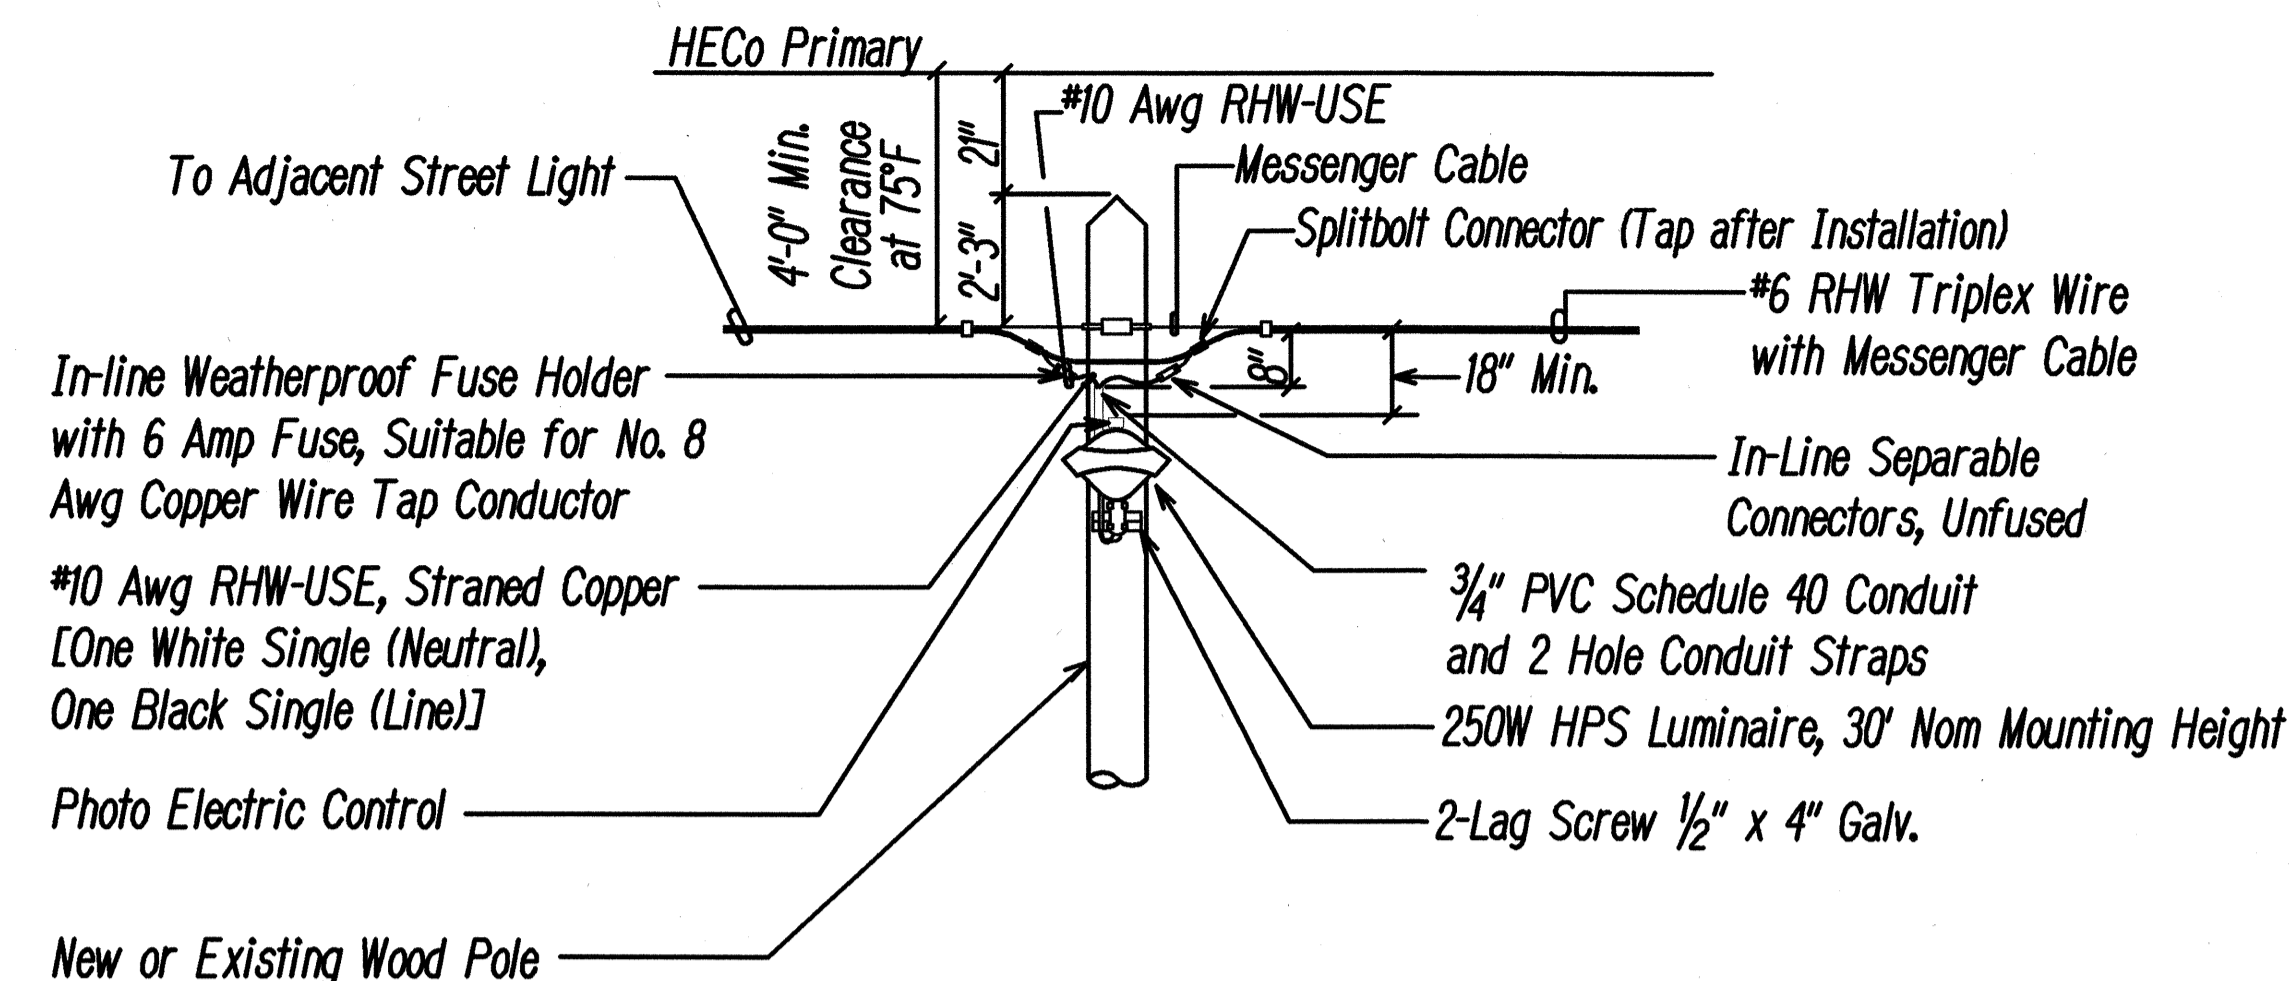


TANGENT INSTALLATION

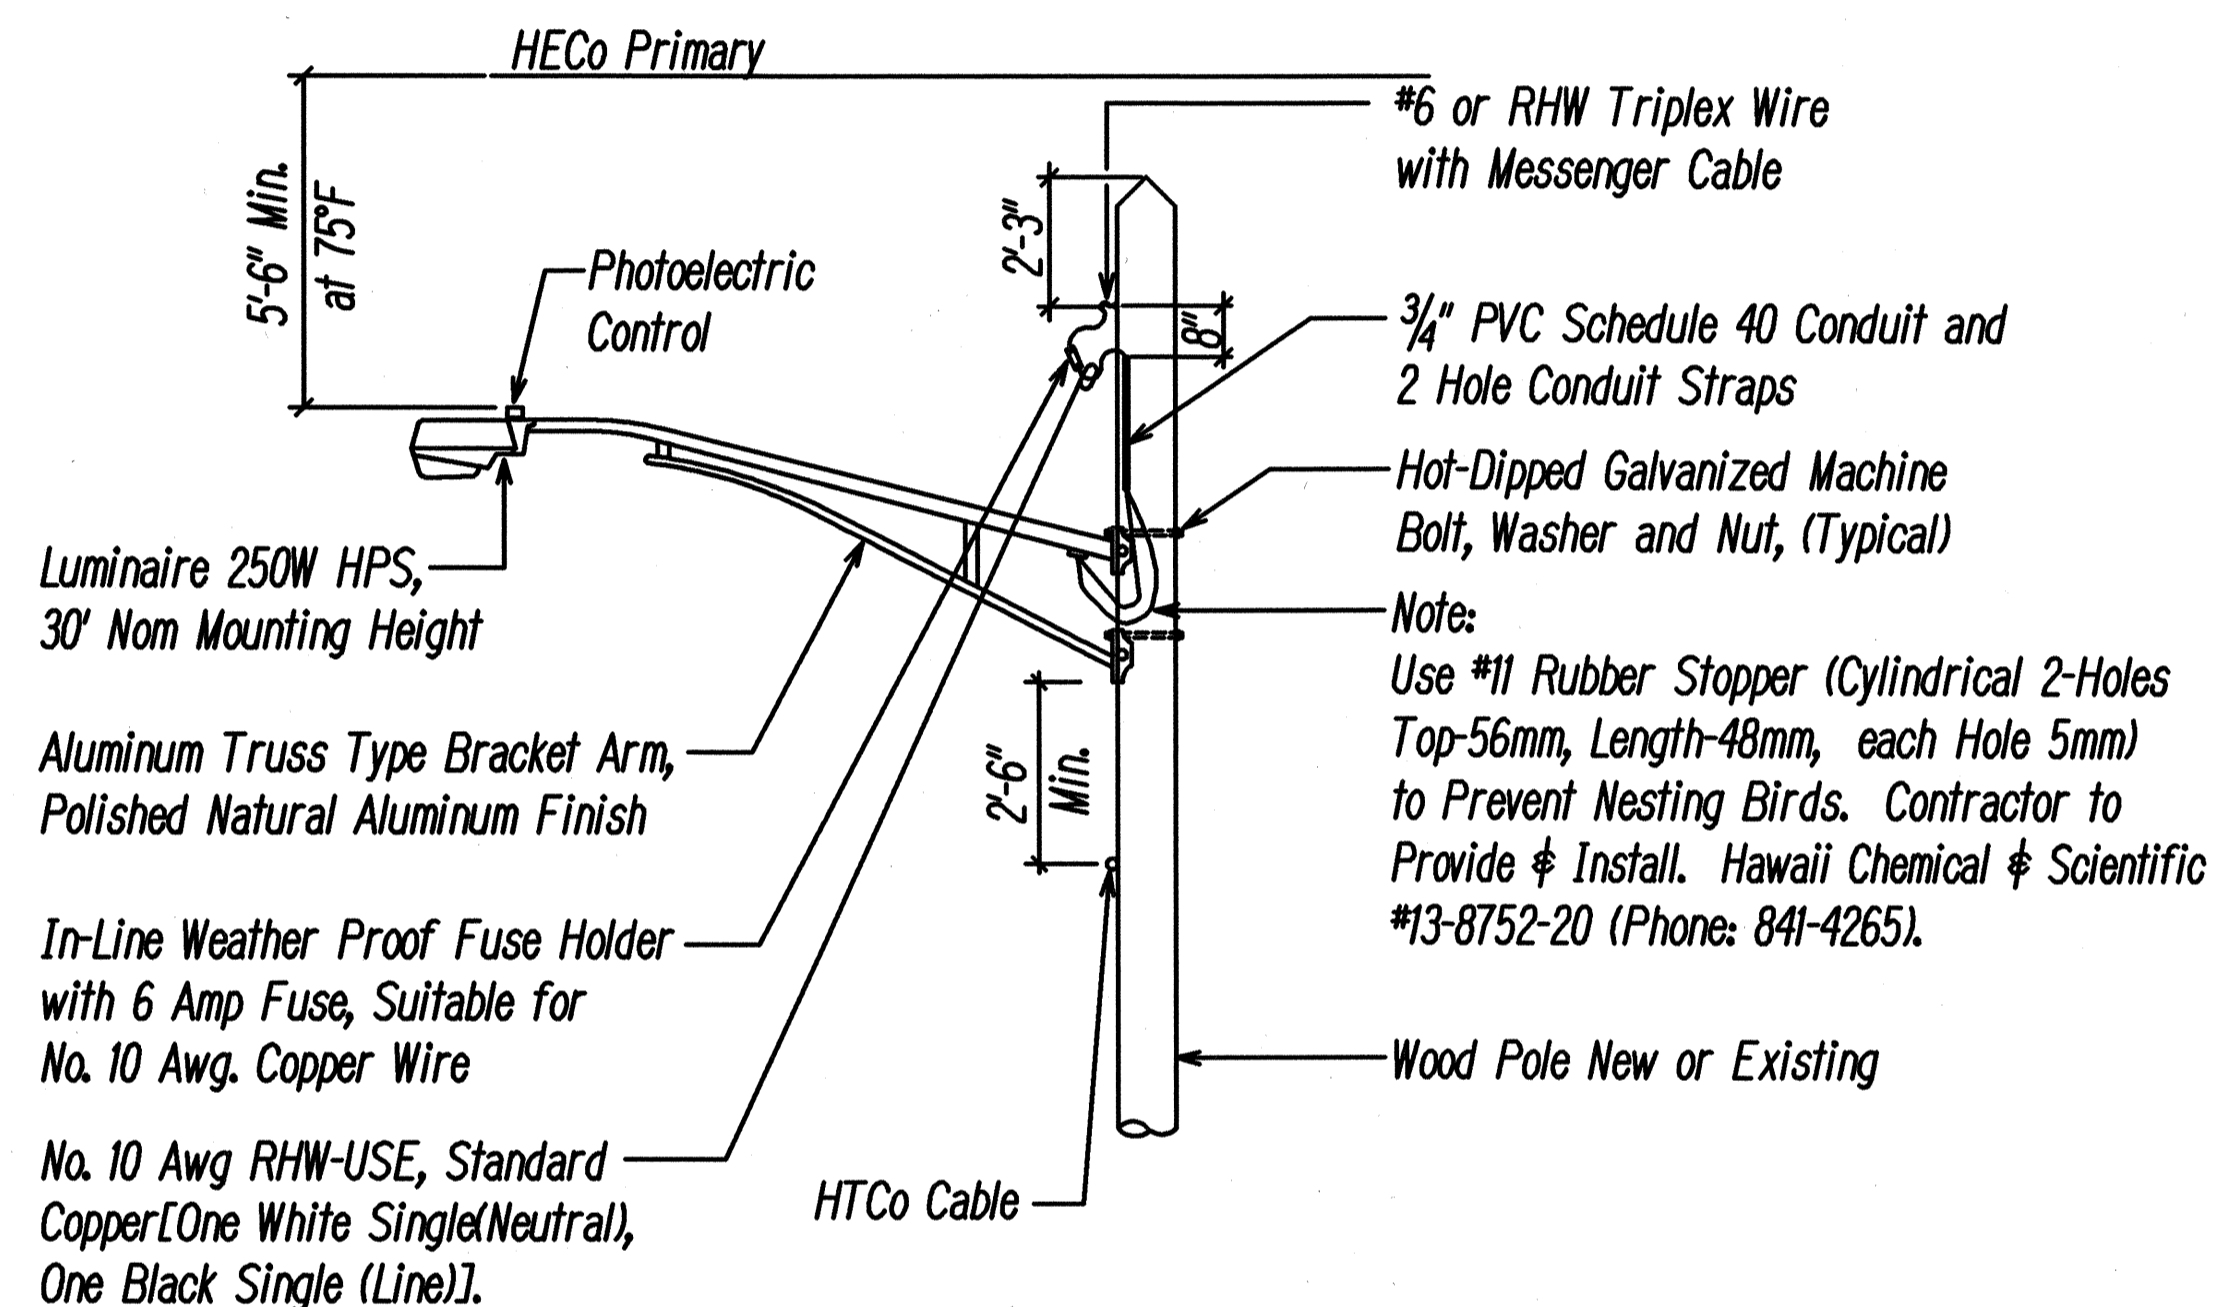

NOTES: Mount I.D. Tag +6'-0" Above Finish Grade.

DEAD-END INSTALLATION


A OVERHEAD STREET LIGHT MOUNTING
E-28 N.T.S.

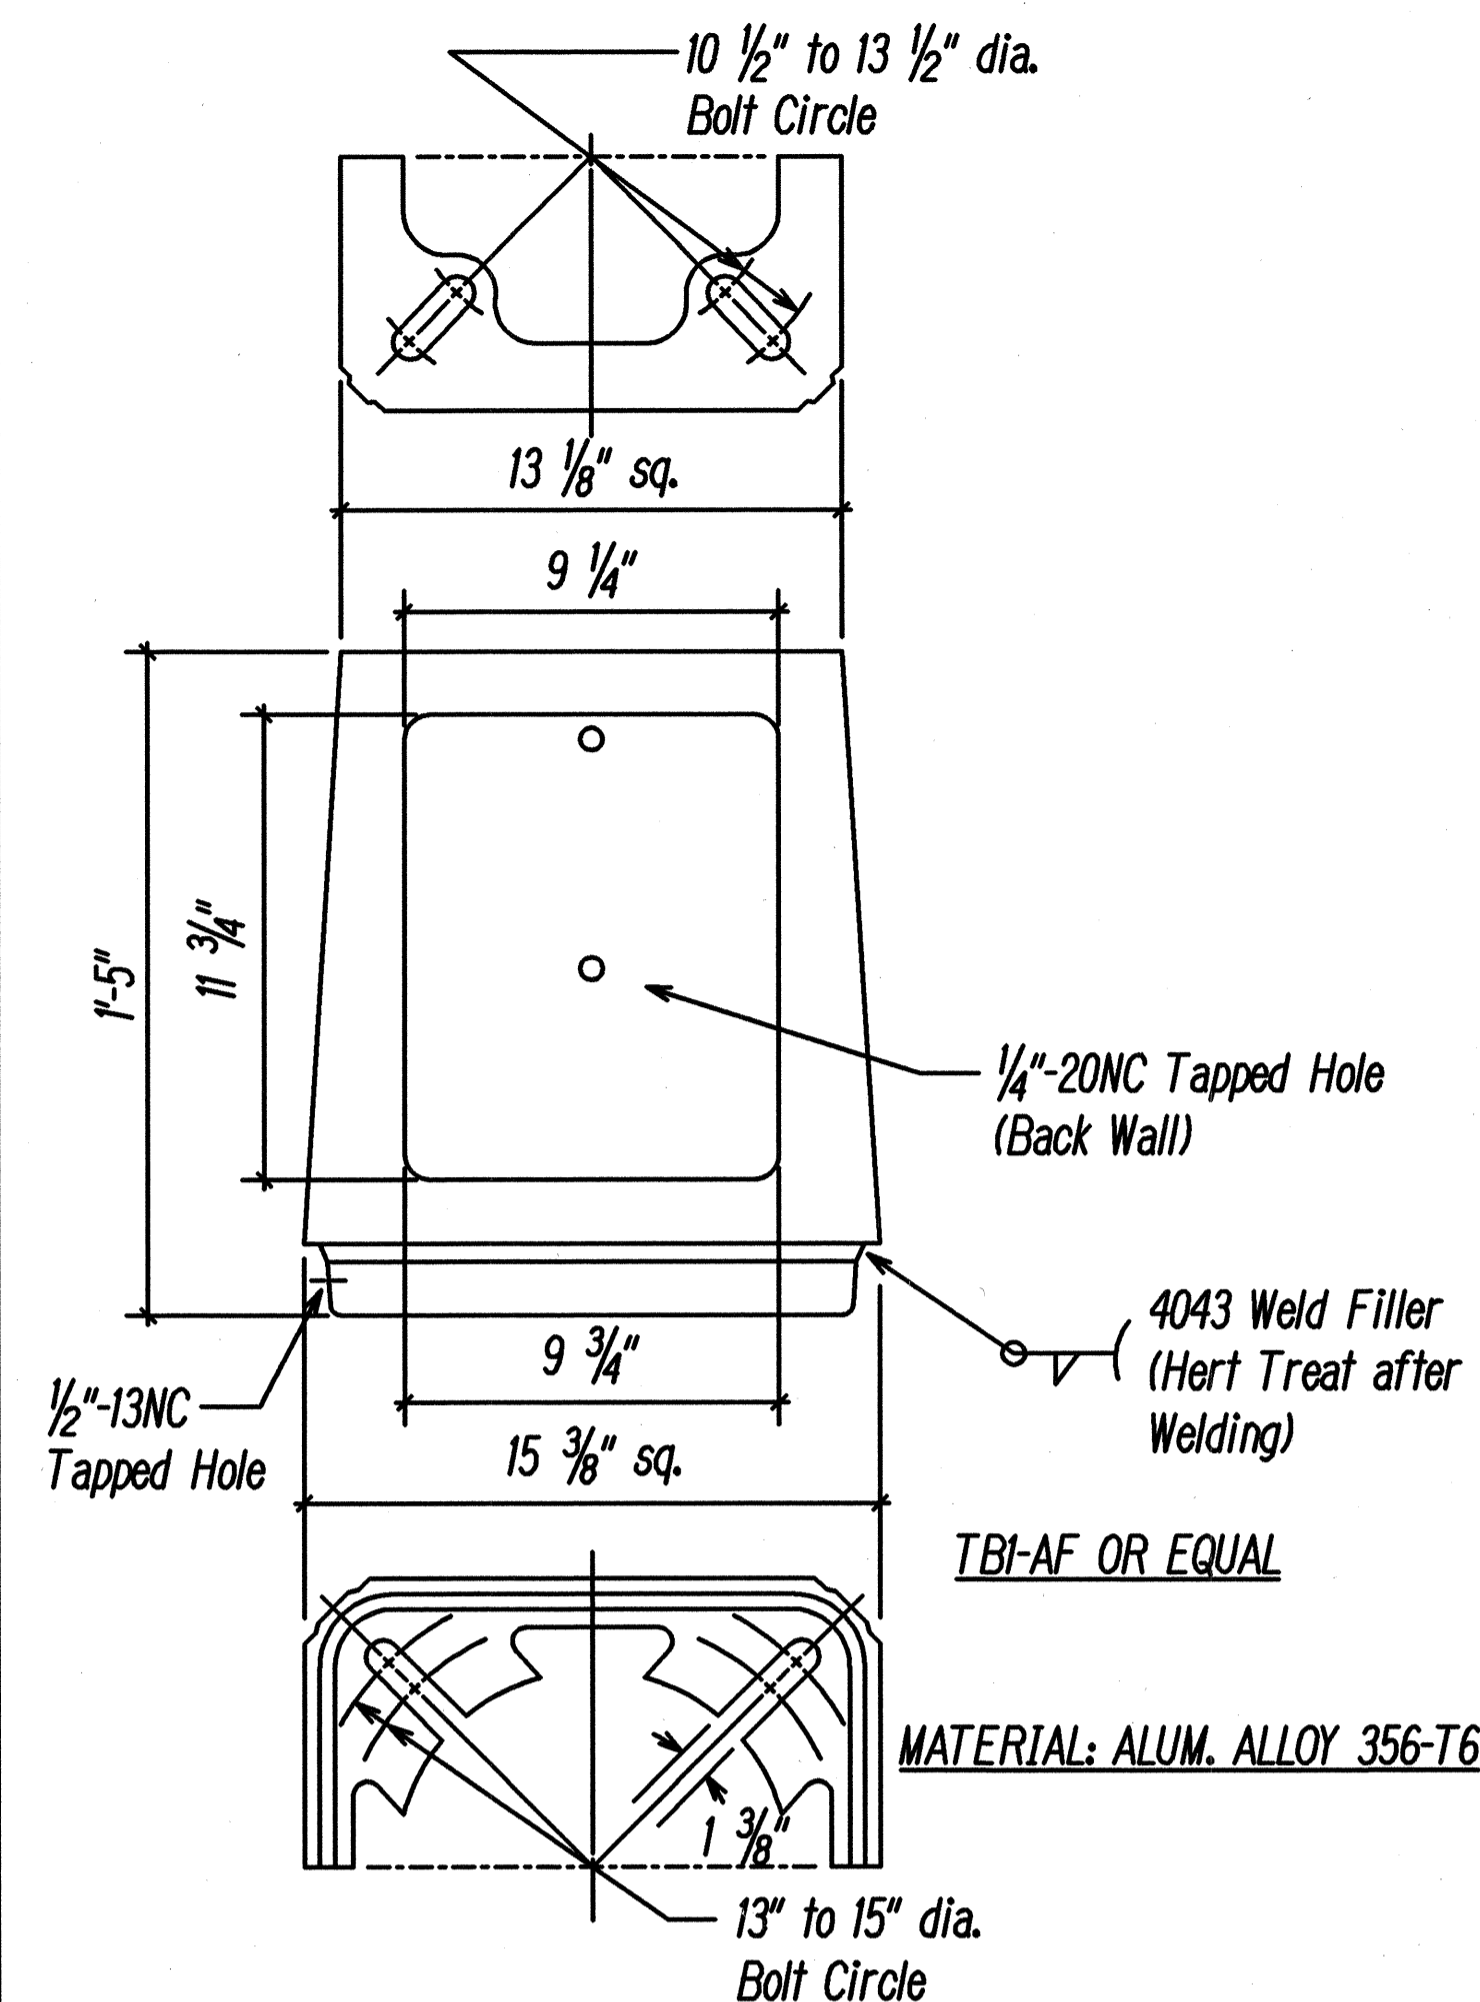

BASE SUPPLIED WITH:

1. Door and 1/4"-20NC S.S. Screw
2. Eight 1" Washers 1/2" Thick x 2 3/4" O.D. (Washers Mechanical Galvanized per ASTM B454)
3. Four 1"-8NC x 3 3/4" Long Galvanized Steel Hex. Hd. Bolts
4. Four 1"-8NC Galvanized Steel Hex. Nuts
5. Four 1" Galvanized Steel Lock Washers
6. Four 1" x 2" O.D. Galvanized Steel Flatwashers
7. Transformer Base shall be Breakaway Type for Areas Without Curb or Guardrail


B TRANSFORMER BASE DETAIL
E-28 N.T.S.

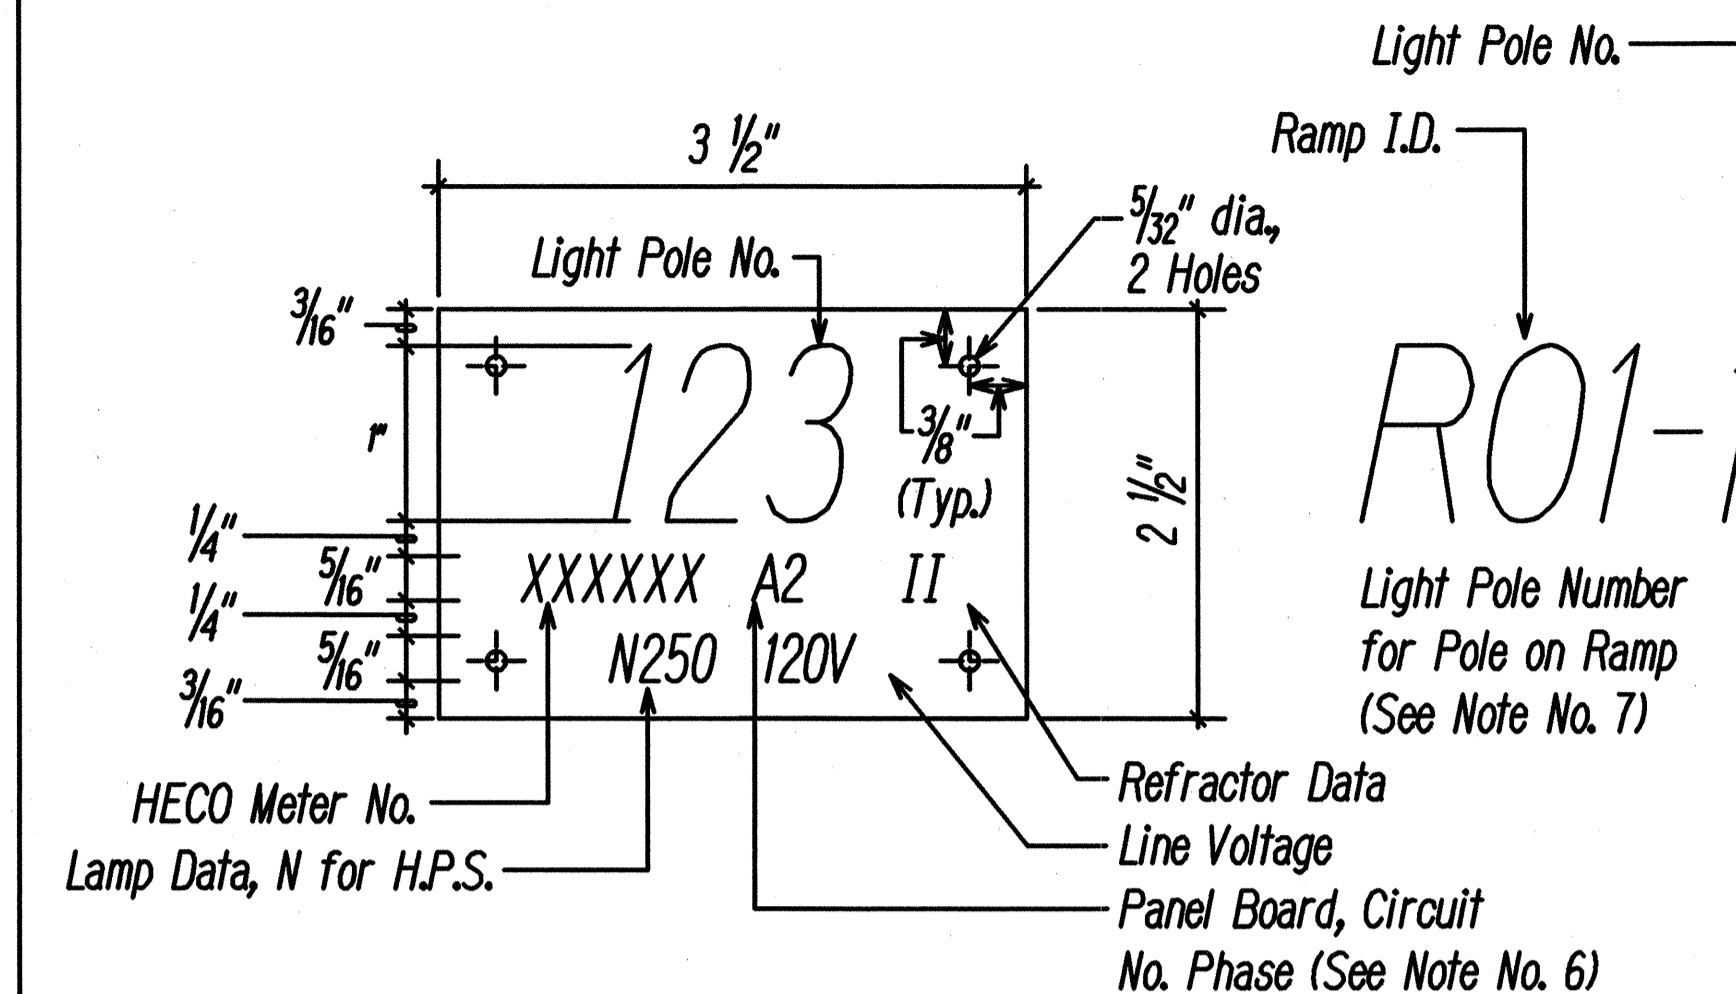

NOTES:

1. Use 3 Ply Laminated Flexible Plastic Black-White-Black Thickness: Black Cap Sheet-0.010", White Base Sheet-0.052", Black Base Sheet-0.010".
2. Light Pole Number Size shall be 1" High and Engraved 1/8" Wide, White in Color (Number as Required).
3. Nomenclature Size Shall be 5/16" High and Engraved 1/32" Wide, White in Color (Meter Number, Circuit Number, Line Voltage, Lamp Data and Refractor Data as Required).
4. Attach to Aluminum and Steel Poles with No. 8 Stainless Steel, 1/2" Long Drive Screw in 1/8" Drill Hole. Attach to Wood Poles with 4D Aluminum Nails.
5. Numbers are Inscribed by Cutting through "Black Cap Sheet" to Expose "White Letters".
6. Nomenclature Required for Systems with Two or more Circuits. First Letter Indicates Panel Board, Number Indicates Circuit.
7. For Light Poles Installed on Ramp, Assign Numbers to Include Ramp I.D. and Pole Number. Legend may be less than One (1) Inch in Height.

C STREET LIGHT I.D. TAG DETAIL
E-28 N.T.S. (208Y/120V METERED SYSTEM)

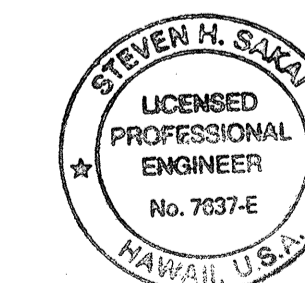

THIS WORK WAS PREPARED BY ME OR UNDER MY SUPERVISION.
Signature: [Handwritten Signature]

STATE OF HAWAII
DEPARTMENT OF TRANSPORTATION
HIGHWAYS DIVISION
STREET LIGHT DETAILS

FARRINGTON HIGHWAY
Intersection Improvements at Waiomea Street
Project No. 93A-06-98
Scale: None Date: AUGUST 2000
SHEET No. E-28 OF 30 SHEETS

66

1. *Connection To The HECO Secondary Circuits Shall Be Made By HECO And Paid For By The Electrical Contractor.*
2. *Contractor Shall Be Responsible For Coordinating And Informing HECO, HTCO and CATV Of Street Light Locations On Joint Poles Prior To The Installation Of Street Lights And Street Light Secondary Cables On Joint Poles.*
3. *Contractor Shall Stencil Date Of Installation On Bottom Of Photocell.*
4. *Contractor To Energize Street Lights A Minimum Of Six (6) Hours For Final Inspection And Acceptance. Contractor To Assume Costs.*
5. *Contractor Shall Have One Set Of Approved Plans At The Job Site At All Times During The Construction Work.*
6. *All Neutral Conductors Shall Have Solid White Insulation. Any Other Method Of Identification Is Unacceptable.*
7. *Contractor Shall Not Backfill Trenches Until Work Is Approved By The Engineer.*
8. *The Contractor Shall Inform The Inspector Of All Concrete Pours At Least Two (2) Working Days In Advance. Concrete Shall Not Be Poured Until Approval Is Granted By The Inspector.*
9. *Luminaire And Pole Count*

Contractor Shall Verify Counts.

-
- 40'-0"
- 34'-0"
- 15° Roofed
- I.D. Tag, See Detail C/E-29
- +6'-0" to Finish Grade
- See Plan for Clearance
- Finish Grade
- 6'-0"
- Roadway Asphalt
- Termite Barrier, See A
E-20

Photo-Cell Contacts Rated for 120/240V Operation

2-#10 RHW-USE, 600V

Waterproof Cable Connector Kit with 6A Fuse

2-#8 600V RHW-USE

Luminaire: High Pressure Sodium Lamp with Integral HPF, Constant Wattage Ballast, 120V

In-Line Separate Connector, Unfused

Final Connection by HECO, Typ

HECO Secondary Cables

240V

120V

120V

Ckt "a"

Ckt "b"

Neutral

B
E-29 STREET LIGHT CONNECTION DIAGRAM
(120/240V UNMETERED SYSTEM)

Diagram of a 123 504 II lamp with dimensions and labels:

- Contract No.
- 3 1/2"
- Refractor Data
- 5/32" Dia., 2 Holes
- 3/16"
- 5/16"
- 1/4"
- 1"
- 504 II
- 3/8" (TYP.)
- 2 1/2"
- 1/4"
- 5/16"
- 3/16"
- N250
- 120V
- Line Voltage
- Lamp Data, N for H.P.S.
- Light No. (See Note 6)

1. Use 3 Ply Laminated Flexible Plastic Black-White-Black Thickness: Black Cap Sheet-0.010", White Base Sheet-0.052", Black Base Sheet-0.010".
2. Light Pole Number Size shall be 1" High and Engraved $\frac{1}{8}$ " Wide, White in Color (Number as Required).
3. Nomenclature Size shall be $\frac{5}{16}$ " High and Engraved $\frac{1}{32}$ " Wide, White in Color (Contract Number, Line Voltage, Lamp Data and Refractor Data as Required).
4. Attach to Aluminum and Steel Poles with No. 8 Stainless Steel, $\frac{1}{2}$ " Long Drive Screws in $\frac{1}{8}$ " Drill Hole. Attach to Wood Poles with 4D Aluminum Nails.
5. Numbers are Inscribed by Cutting Through "Black Cap Sheet" to Expose "White Letters".
6. Contract Number & Light Number shall be Obtained from the State. Use an Alphabet Suffix to Designate Lights.
7. For Light Poles Installed on Ramp, Assign Numbers to Include Ramp I.D. and Light Number. Legend may be less than One (1) Inch in Height.

2-#8 600V RHW-USE

HECO Secondary Cables

240V

120V

120V

Final Connection by HECO, Typ

Ckt "a"

Ckt "b"

Neutral

THIS WORK WAS PREPARED BY ME
OR UNDER MY SUPERVISION.

Steven A. Saba

FARRINGTON HIGHWAY
Intersection Improvements at Waiomea Street
Project No. 93A-06-98
Scale: None Date: AUGUST 2000

SHEET No. E-29 OF 30 SHEETS

