


FILE: K:\Civil\19969 Makaha Bridges\Eng\Construction Dwg\ADD.25 Geometric Plan - 1.dwg saved December 8, 2020








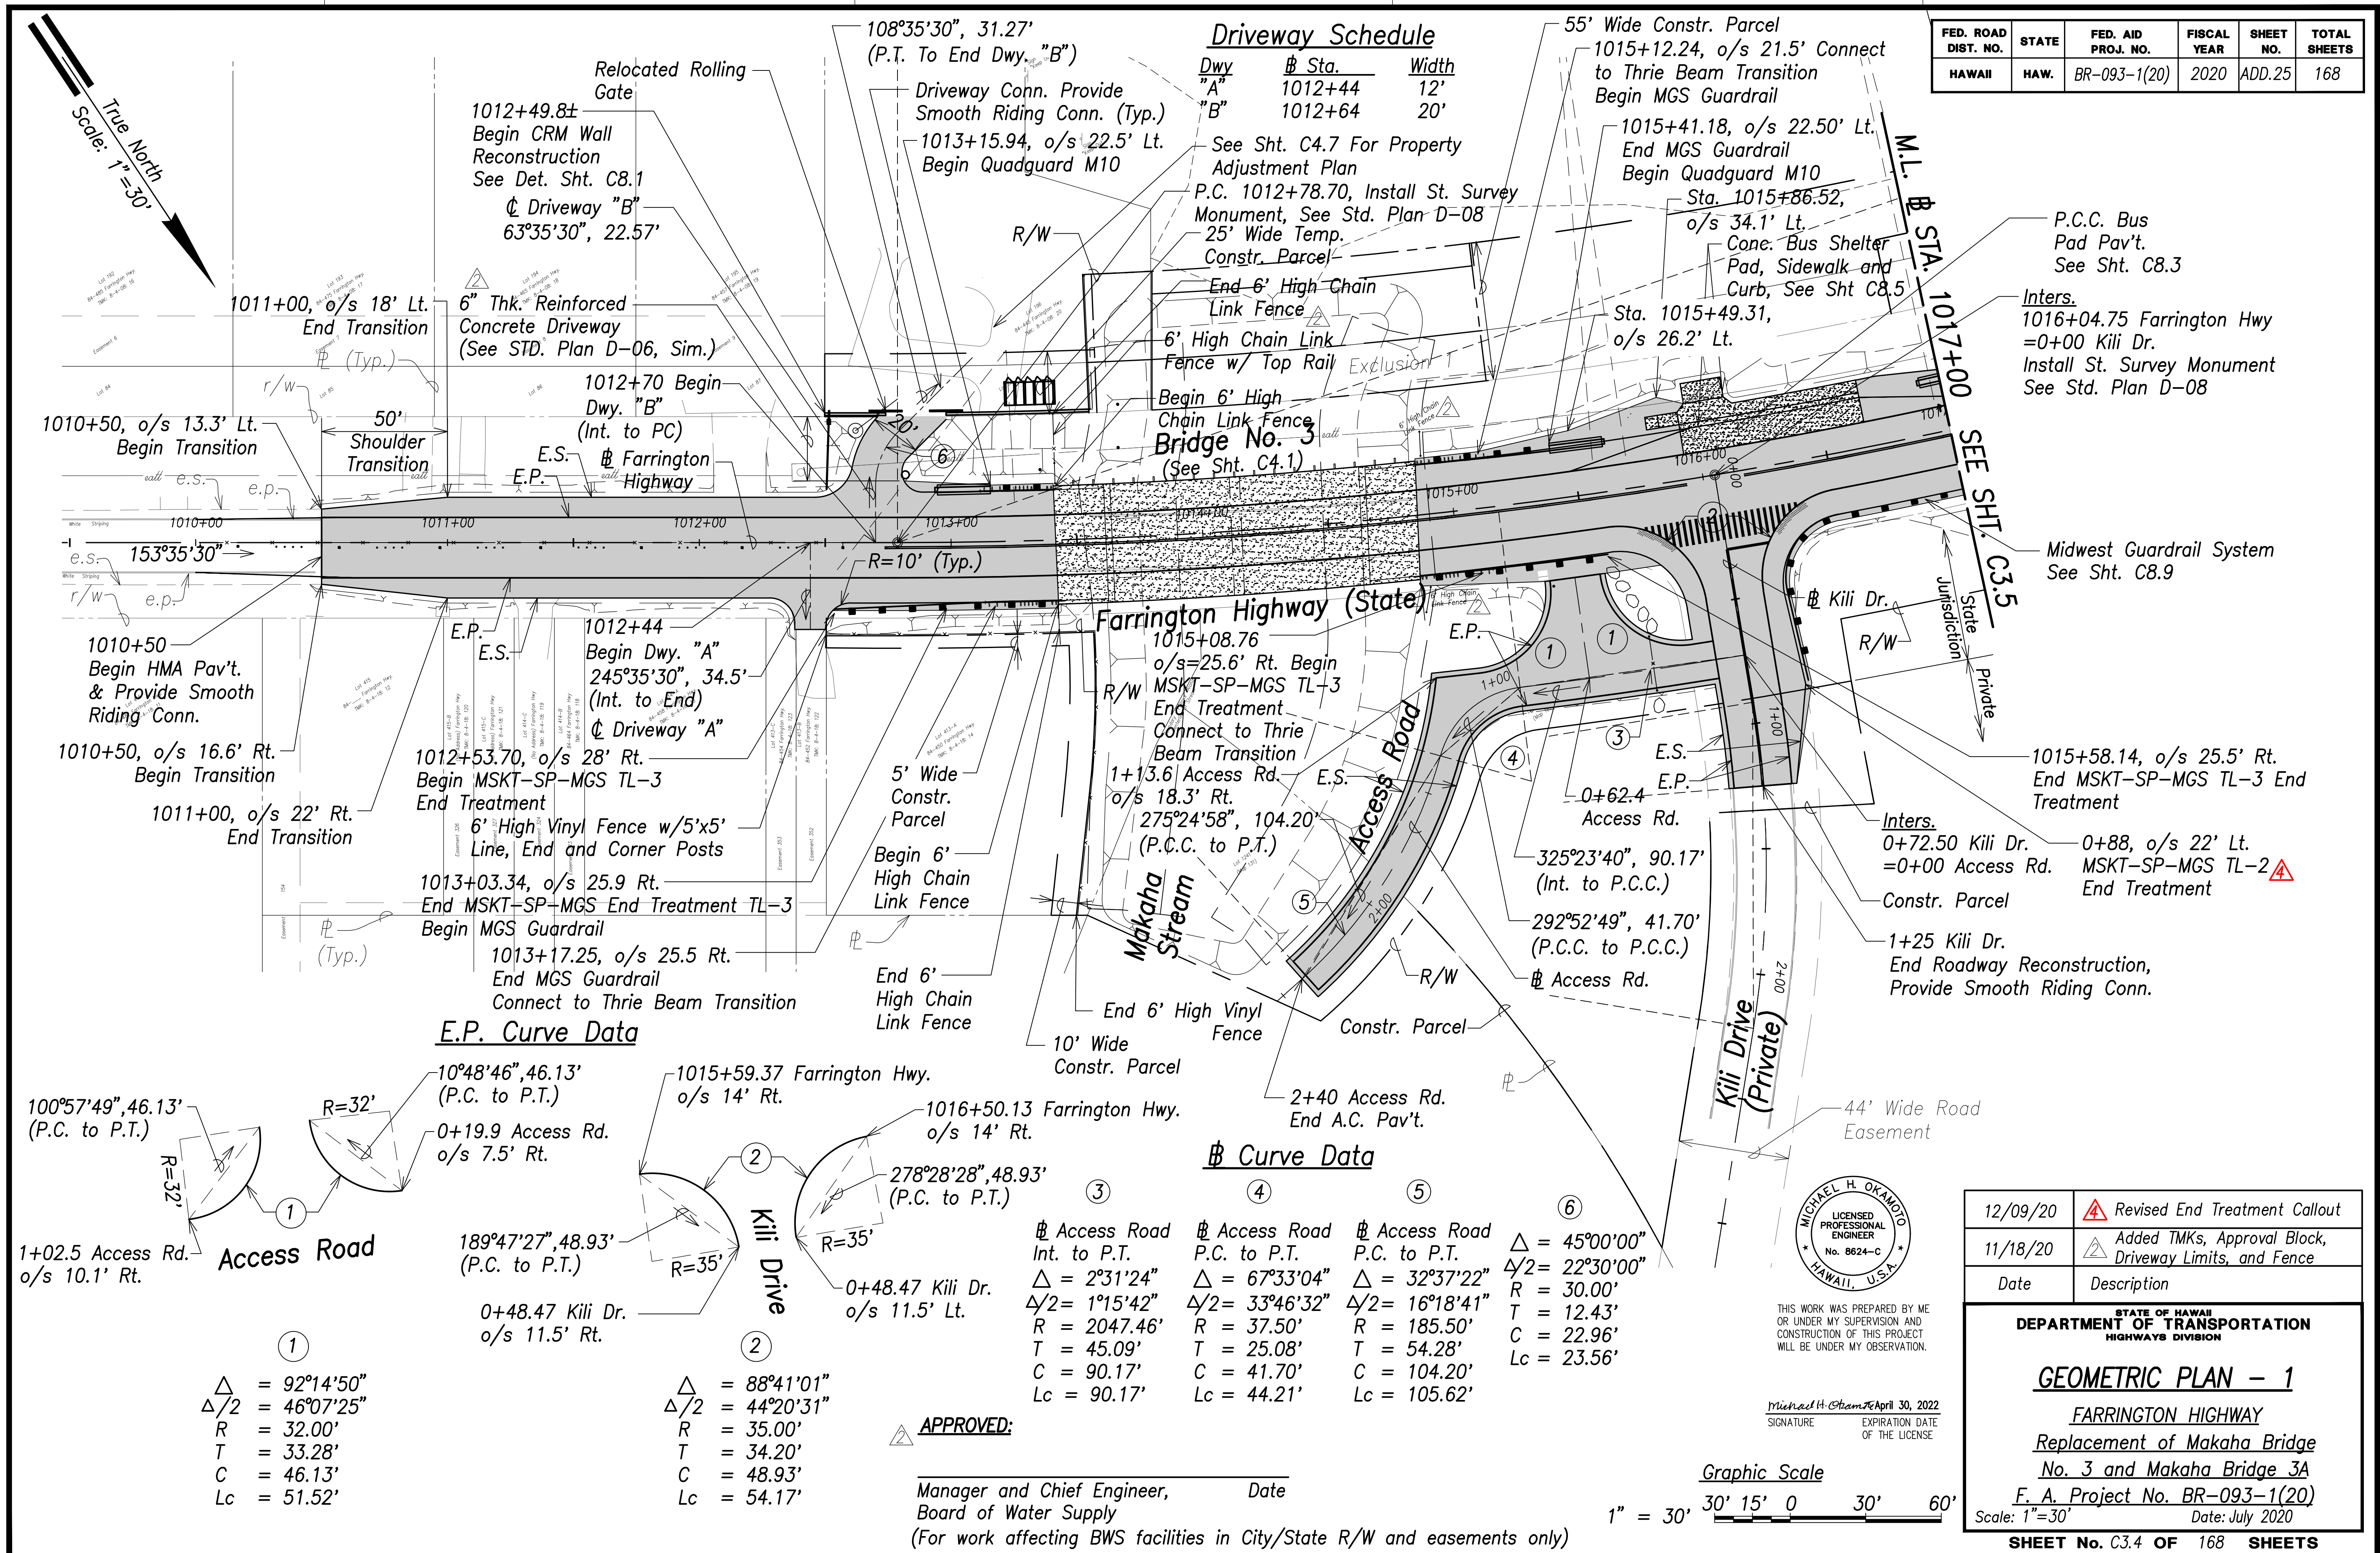


FED. ROAD DIST. NO.	STATE	FED. AID PROJ. NO.	FISCAL YEAR	SHEET NO.	TOTAL SHEETS
HAWAII	HAW.	BR-093-1(20)	2020	ADD.46	168

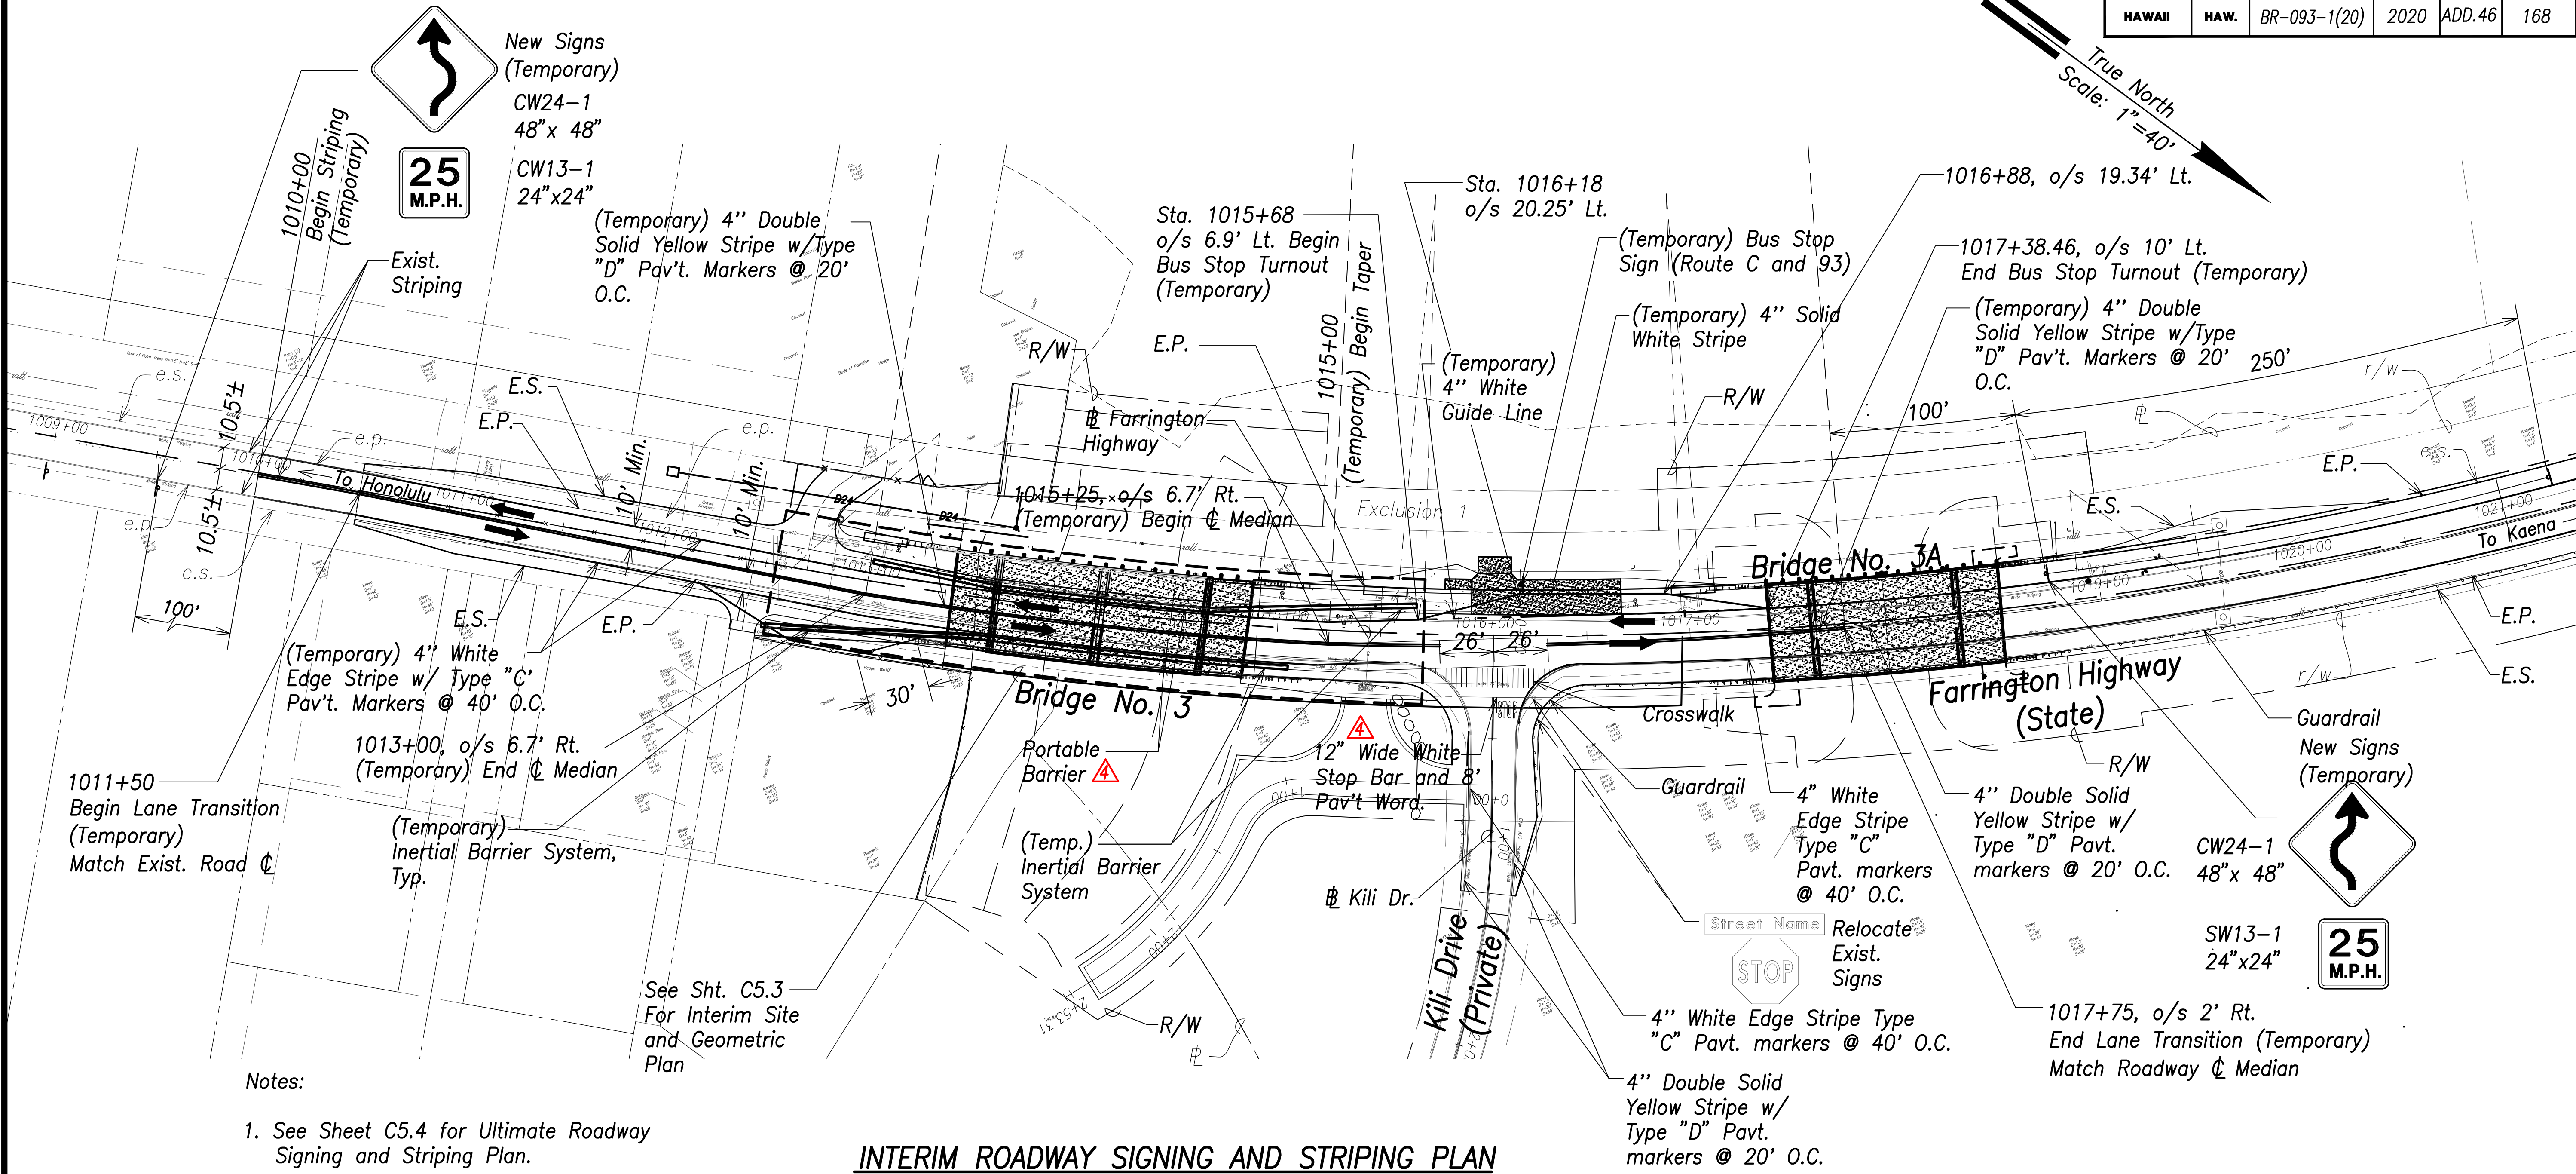

- Notes:
- See Sheet C5.4 for Ultimate Roadway Signing and Striping Plan.
  - All Temporary Striping shall be Paint.

**INTERIM ROADWAY SIGNING AND STRIPING PLAN**  
Scale: 1"=40'

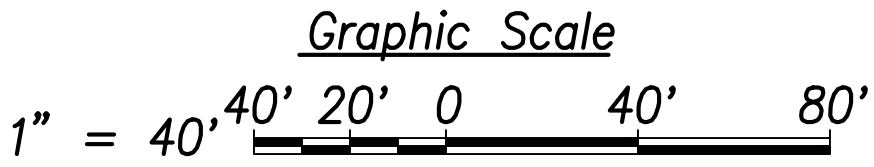

12/09/20	Revised Callouts and Added Pav't Word.
Date	Description
<b>DEPARTMENT OF TRANSPORTATION HIGHWAYS DIVISION</b> <b>INTERIM ROADWAY SIGNING AND STRIPING PLAN</b> <b>FARRINGTON HIGHWAY</b> Replacement of Makaha Bridge No. 3 and Makaha Bridge 3A F. A. Project No. BR-093-1(20) Scale: 1"=40' Date: July 2020	
<b>SHEET No. C5.2 OF 168 SHEETS</b>	



THIS WORK WAS PREPARED BY ME  
OR UNDER MY SUPERVISION AND  
CONSTRUCTION OF THIS PROJECT  
WILL BE UNDER MY OBSERVATION.

Michael H. Okamoto April 30, 2022  
SIGNATURE EXPIRATION DATE  
OF THE LICENSE

SURVEY PLOTTED BY	DATE
DRAWN BY	
DESIGNED BY	
QUANTITIES BY	
CHECKED BY	
ORIGINAL PLAN	
NOTE BOOK	
No.	



