


| FED. ROAD DIST. NO. | STATE | FED. AID PROJ. NO. | FISCAL YEAR | SHEET NO. | TOTAL SHEETS |
|---------------------|-------|--------------------|-------------|-----------|--------------|
| HAWAII | HAW. | BR-093-1(20) | 2020 | ADD.46 | 168 |



| | |
|-------------------|------|
| SURVEY PLOTTED BY | DATE |
| DRAWN BY | |
| TRACED BY | |
| QUANTITIES BY | |
| CHECKED BY | |
| ORIGINAL PLAN | |
| NOTE BOOK | |
| No. | |

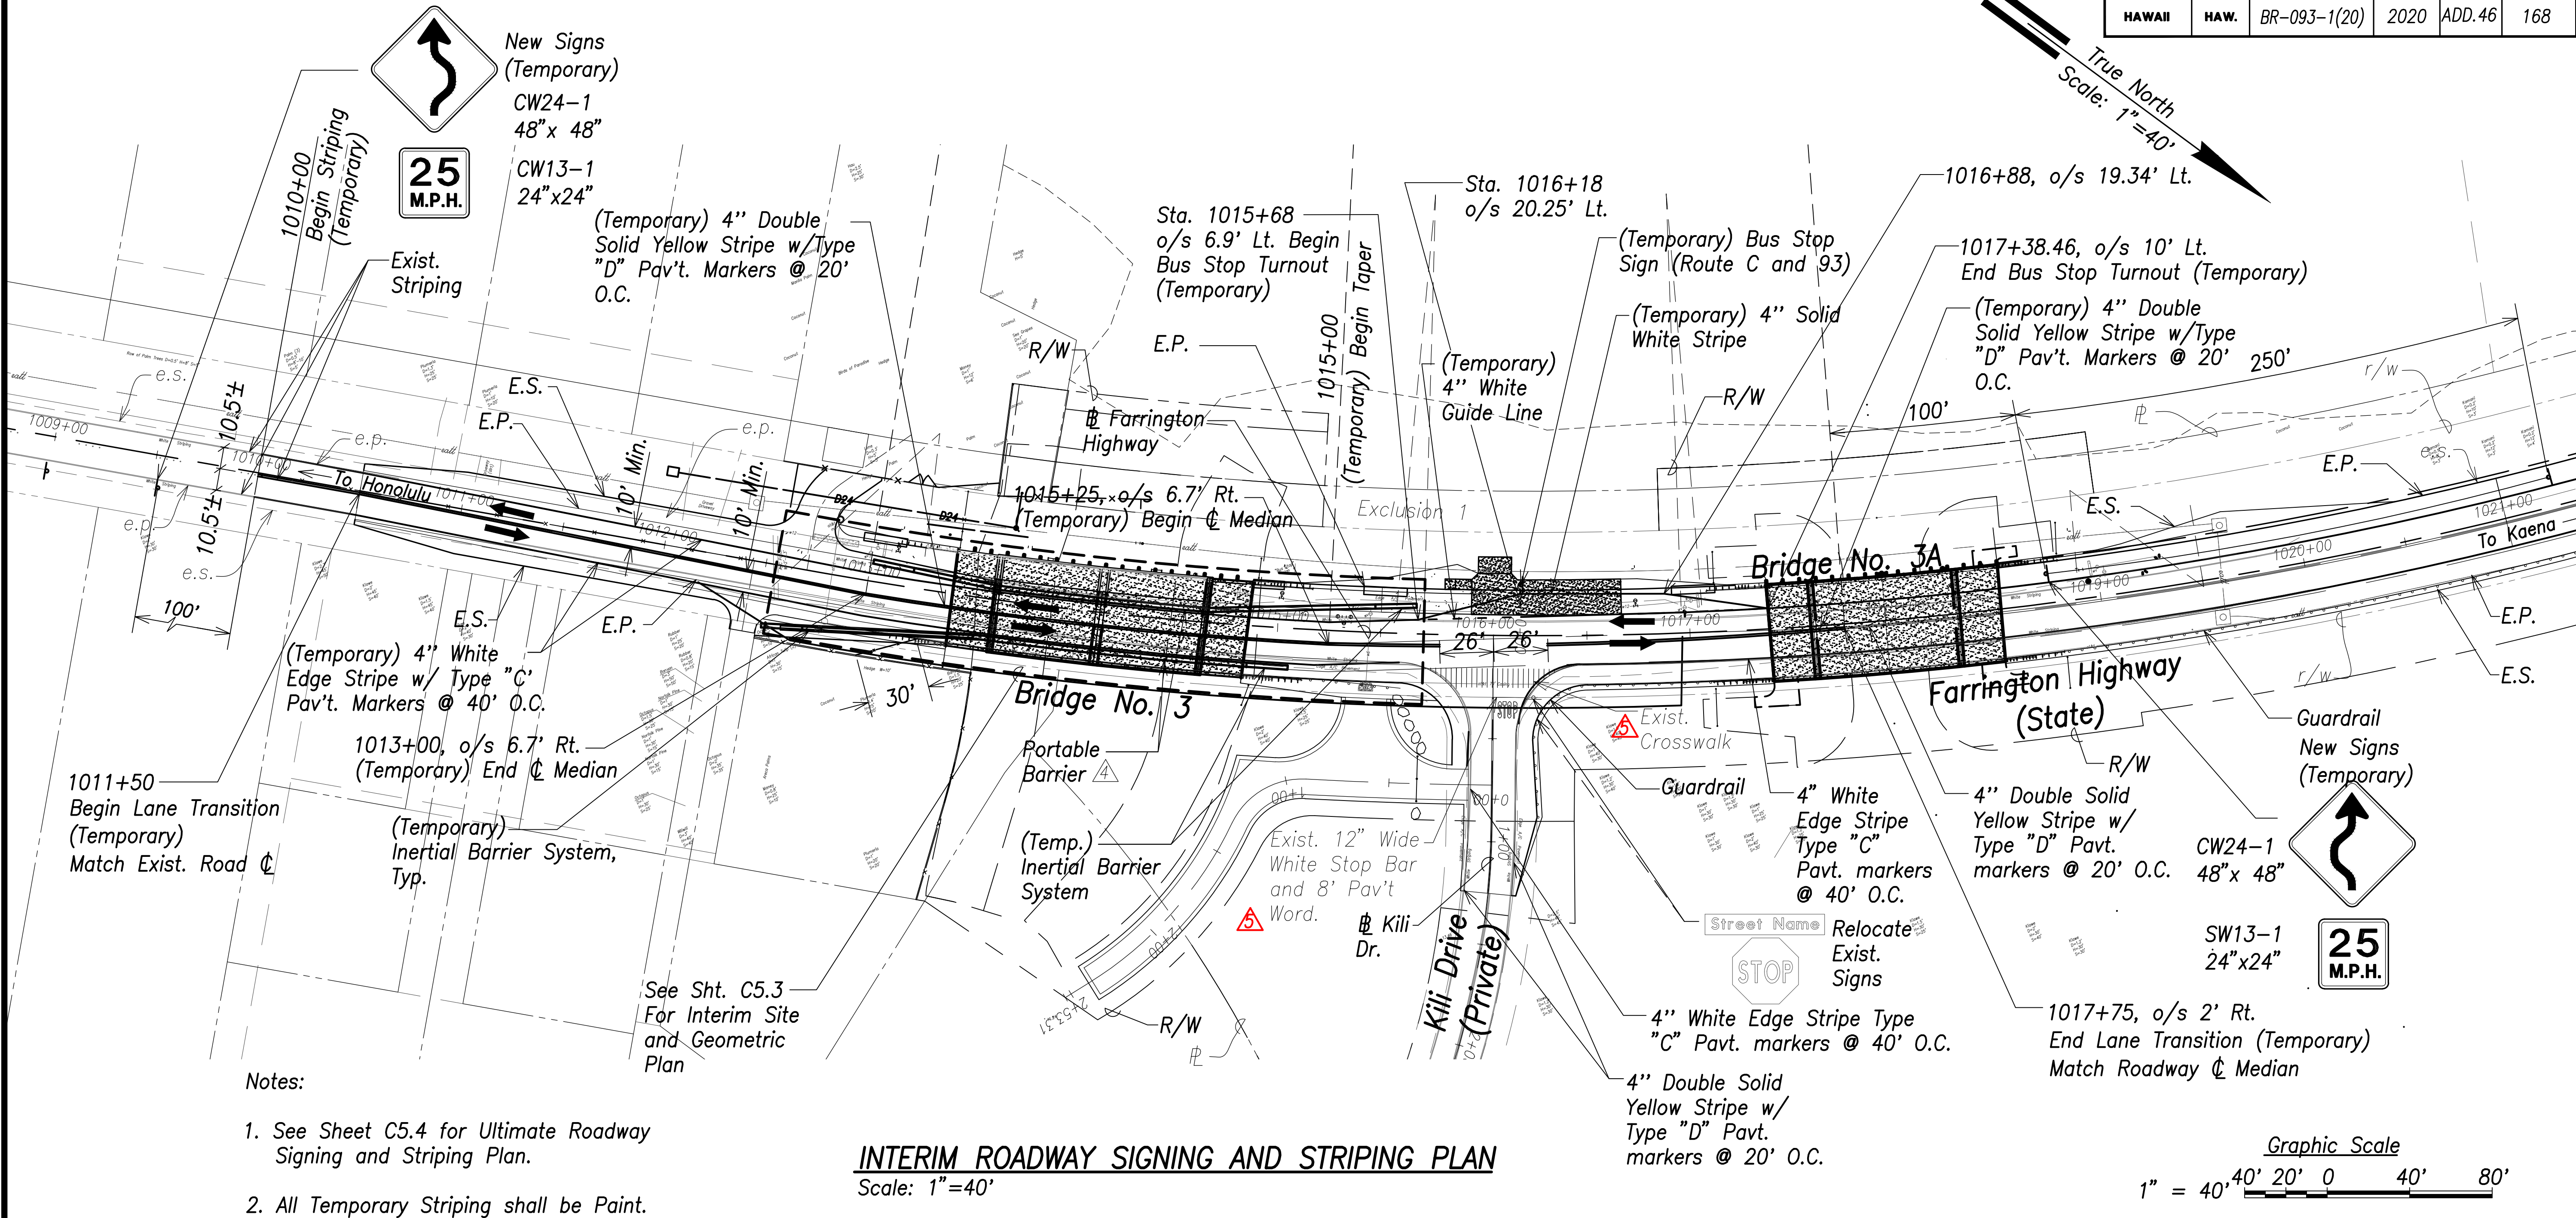

THIS WORK WAS PREPARED BY ME OR UNDER MY SUPERVISION AND CONSTRUCTION OF THIS PROJECT WILL BE UNDER MY OBSERVATION.

Michael H. Okamoto
SIGNATURE
EXPIRATION DATE OF THE LICENSE

| | |
|----------|--|
| 12/09/20 | Revised Callouts to Show as Existing |
| 12/09/20 | Revised Callouts and Added Pav't Word. |
| Date | Description |

| |
|--|
| STATE OF HAWAII DEPARTMENT OF TRANSPORTATION HIGHWAYS DIVISION |
| INTERIM ROADWAY SIGNING AND STRIPING PLAN |
| FARRINGTON HIGHWAY |
| Replacement of Makaha Bridge No. 3 and Makaha Bridge 3A |
| F. A. Project No. BR-093-1(20) |
| Scale: 1"=40' Date: July 2020 |

SHEET No. C5.2 OF 168 SHEETS