



LEGEND

- Proposed Right-of-Way
- Centerline or Baseline
- Limit-of-Slope Line
- Control-of-Access Line (Special conditions are noted on Map)
- Original Boundary--District Grant L.C. Aw. Ld. Ct. Appl.etc.
Also property line when coincident.
- Property Lines--File plans Subdivisions Existing R/W.
- Easement Lines
- Wire fence
- Other fence
- Guard rail
- Stone wall
- Tile wall
- Hedge
- Edge of cultivated area
- Palm trees
- Trees
- Stream
- Building
- Bridge culvert
- Triangulation station
- Natural slope
- Cut slope
- Railroad
- Sand
- Existing roadway
- Street monument
- Fire hydrant
- Water main
- Contour lines
- Concrete
- Boundary pipe boundary monument telephone pole
electric pole power pole sewer manhole telephone
manhole water manhole water valve as noted.
- Marsh swamp
- Highwater mark
- Right of way parcel designation

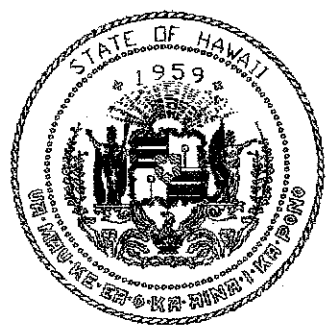

STATE OF HAWAII



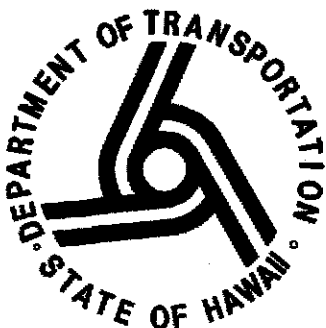


DEPARTMENT OF TRANSPORTATION
HIGHWAYS DIVISION
HONOLULU HAWAII



RIGHT OF WAY MAPS FOR
MAKAHA BRIDGES

FARRINGTON HIGHWAY
FEDERAL AID PROJECT NO. BR-093-1(20)
DISTRICT OF WAIANAE
ISLAND OF OAHU

PROJECT LOCATION
F.A.P. NO. BR-093-1(20)

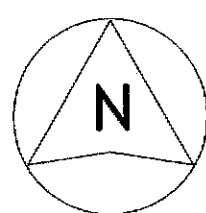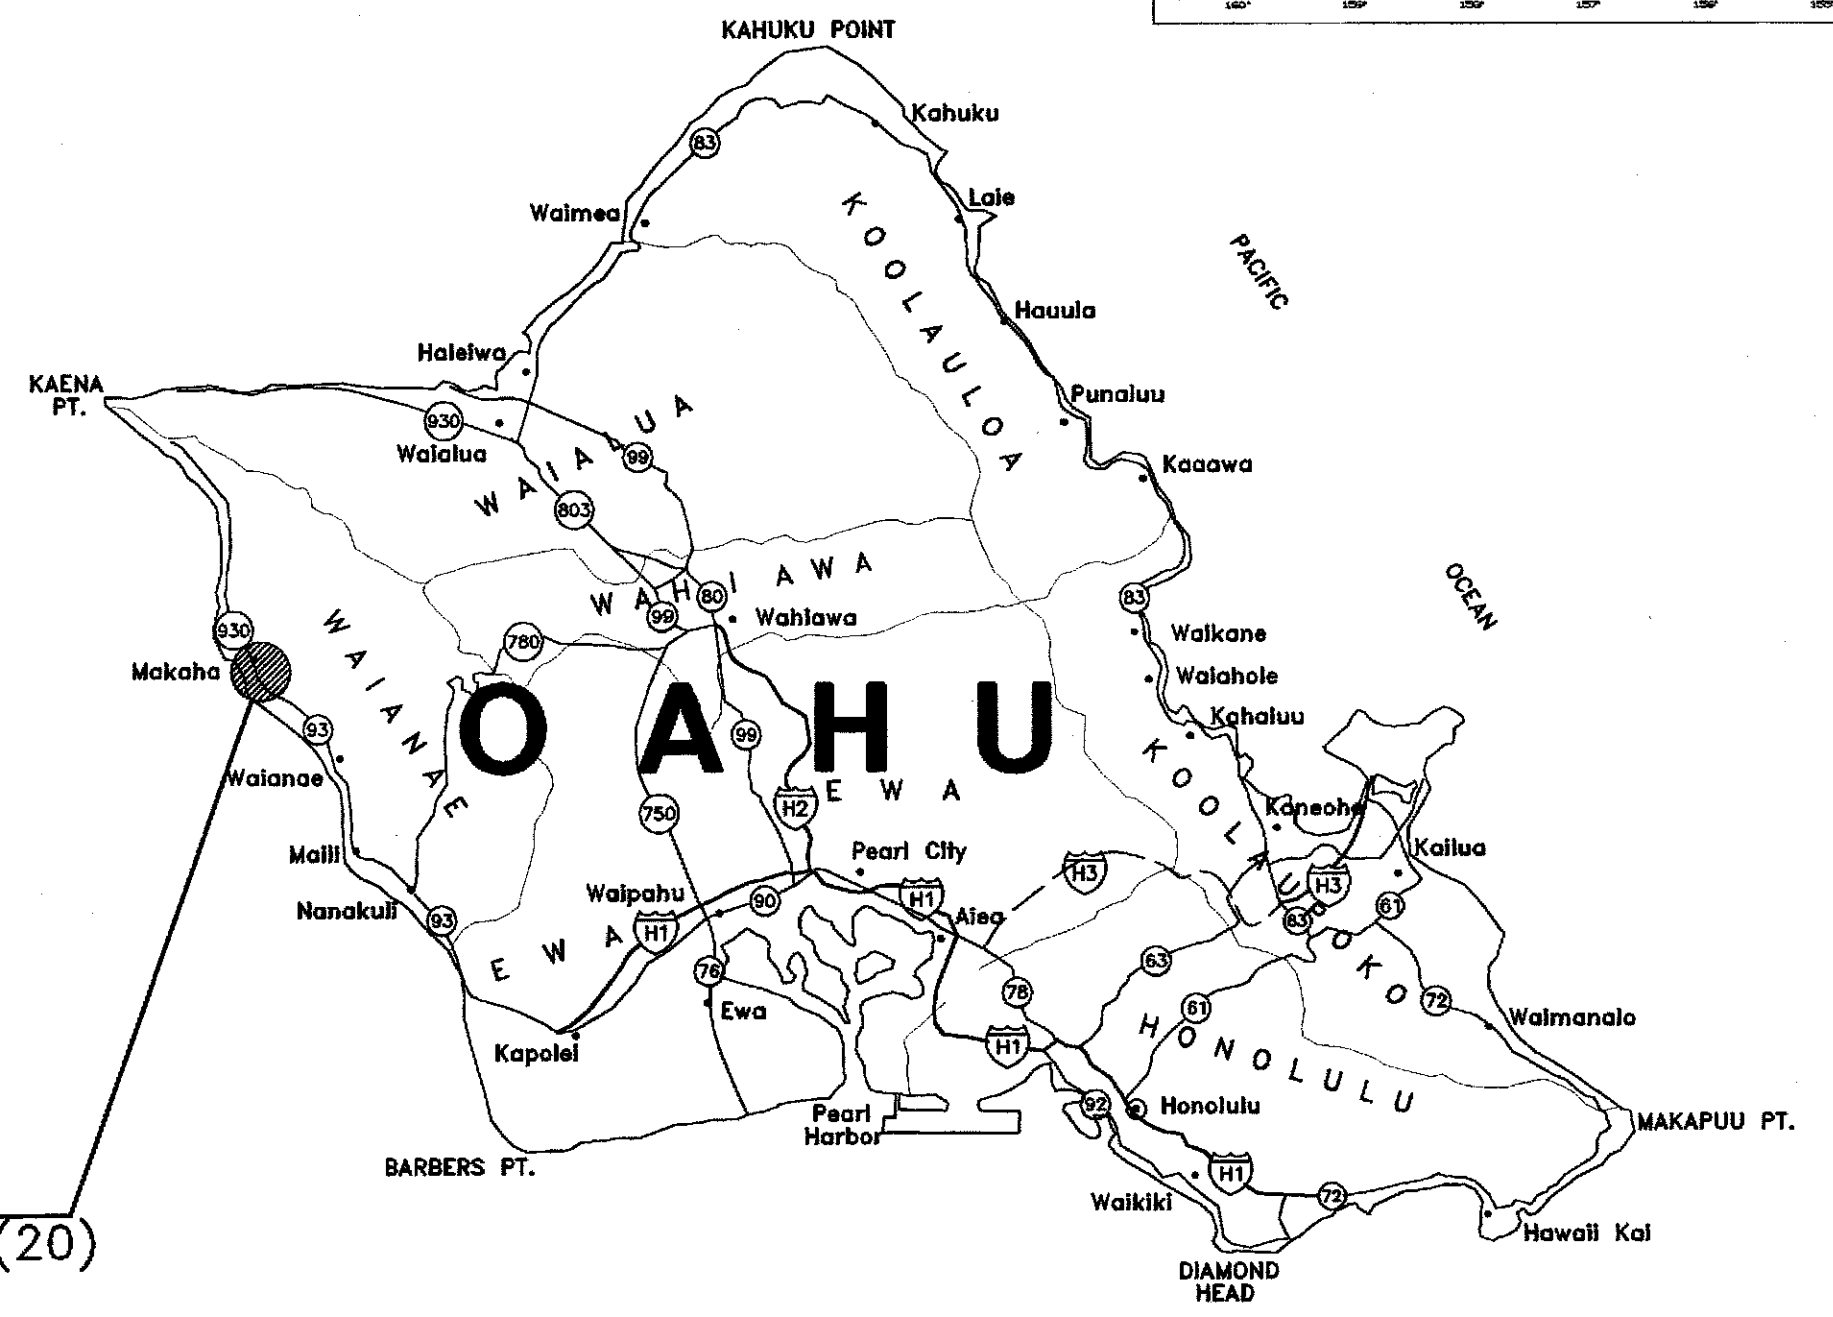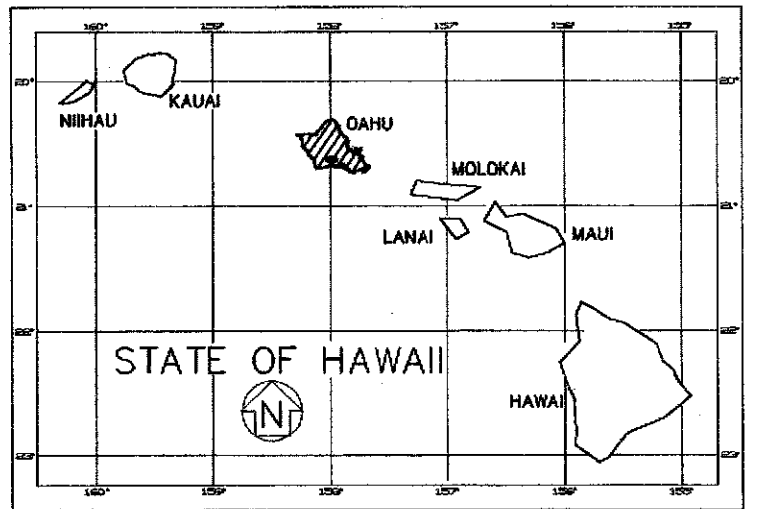


5 0 5 10
SCALE IN MILES

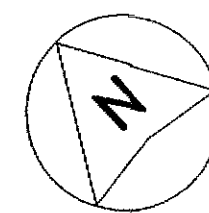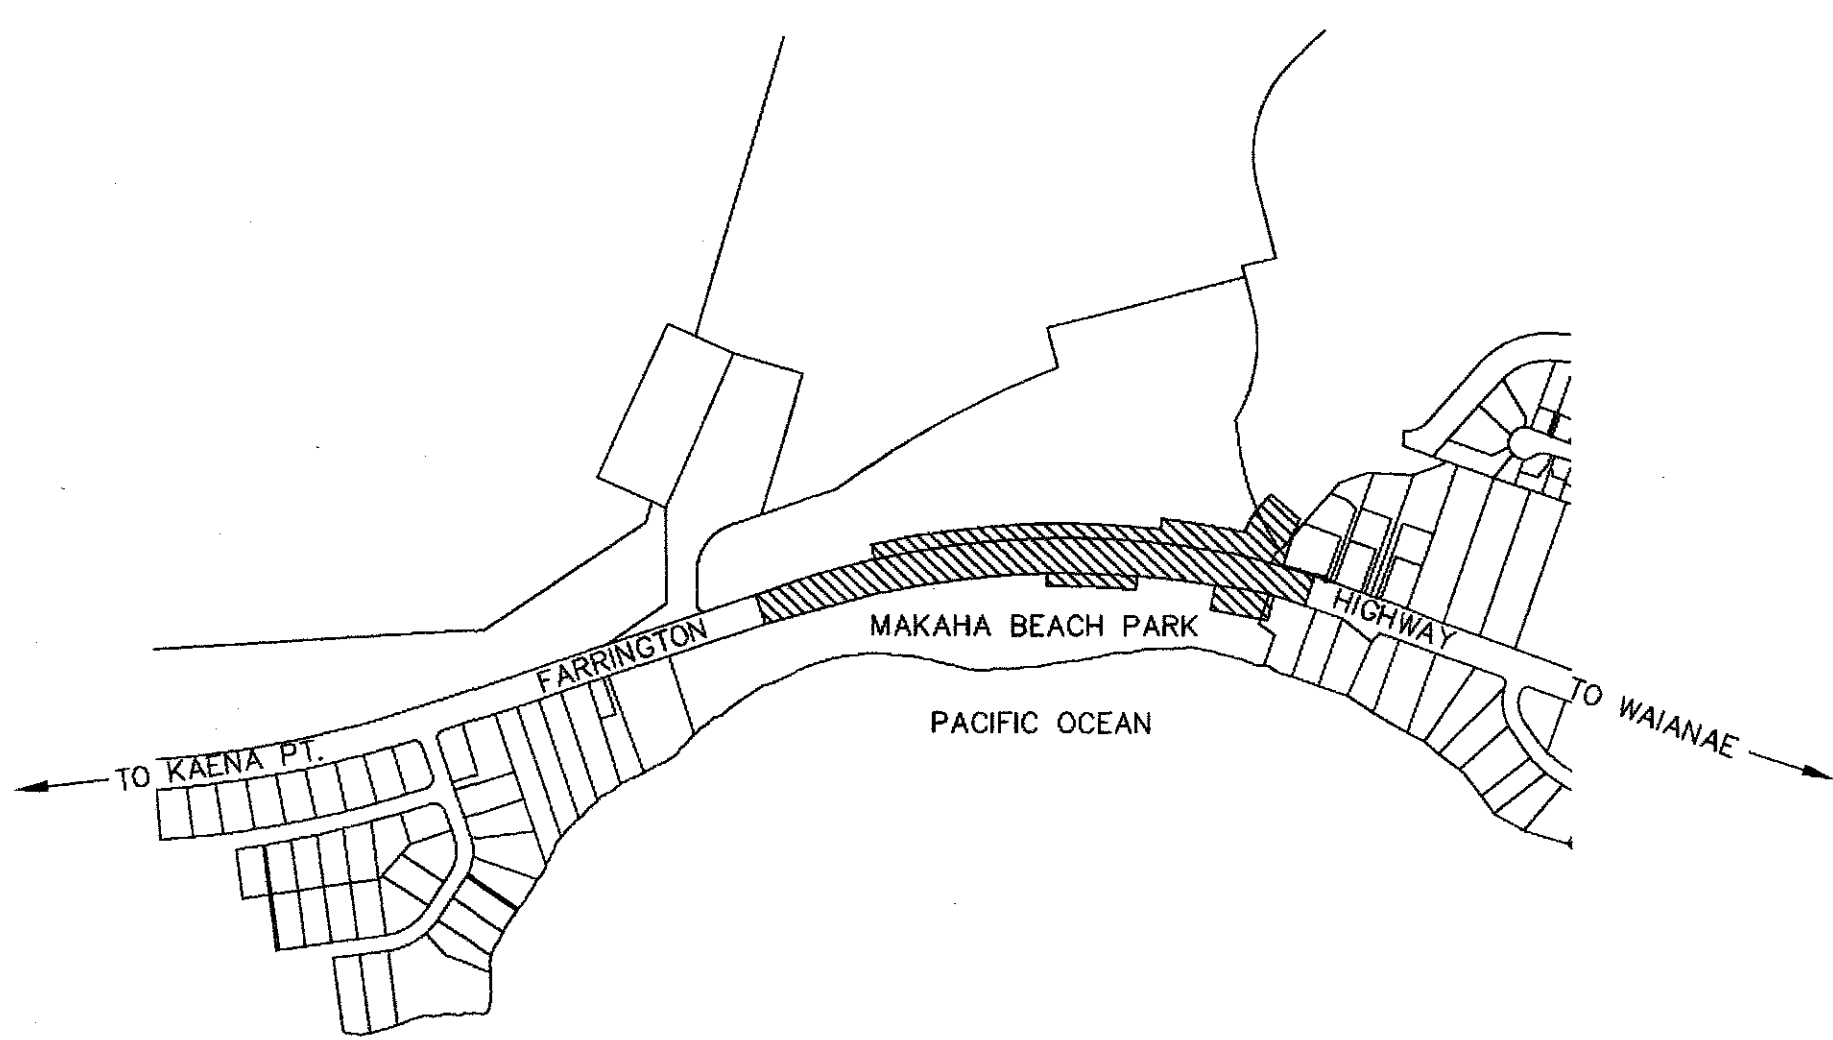

LOCATION PLAN
NOT TO SCALE

DEPARTMENT OF TRANSPORTATION
STATE OF HAWAII
APPROVED: DATE: SEPT. 11, 2008
FOR ADMINISTRATOR HIGHWAYS DIVISION
SHEET NO. 1 OF 3 SHEETS

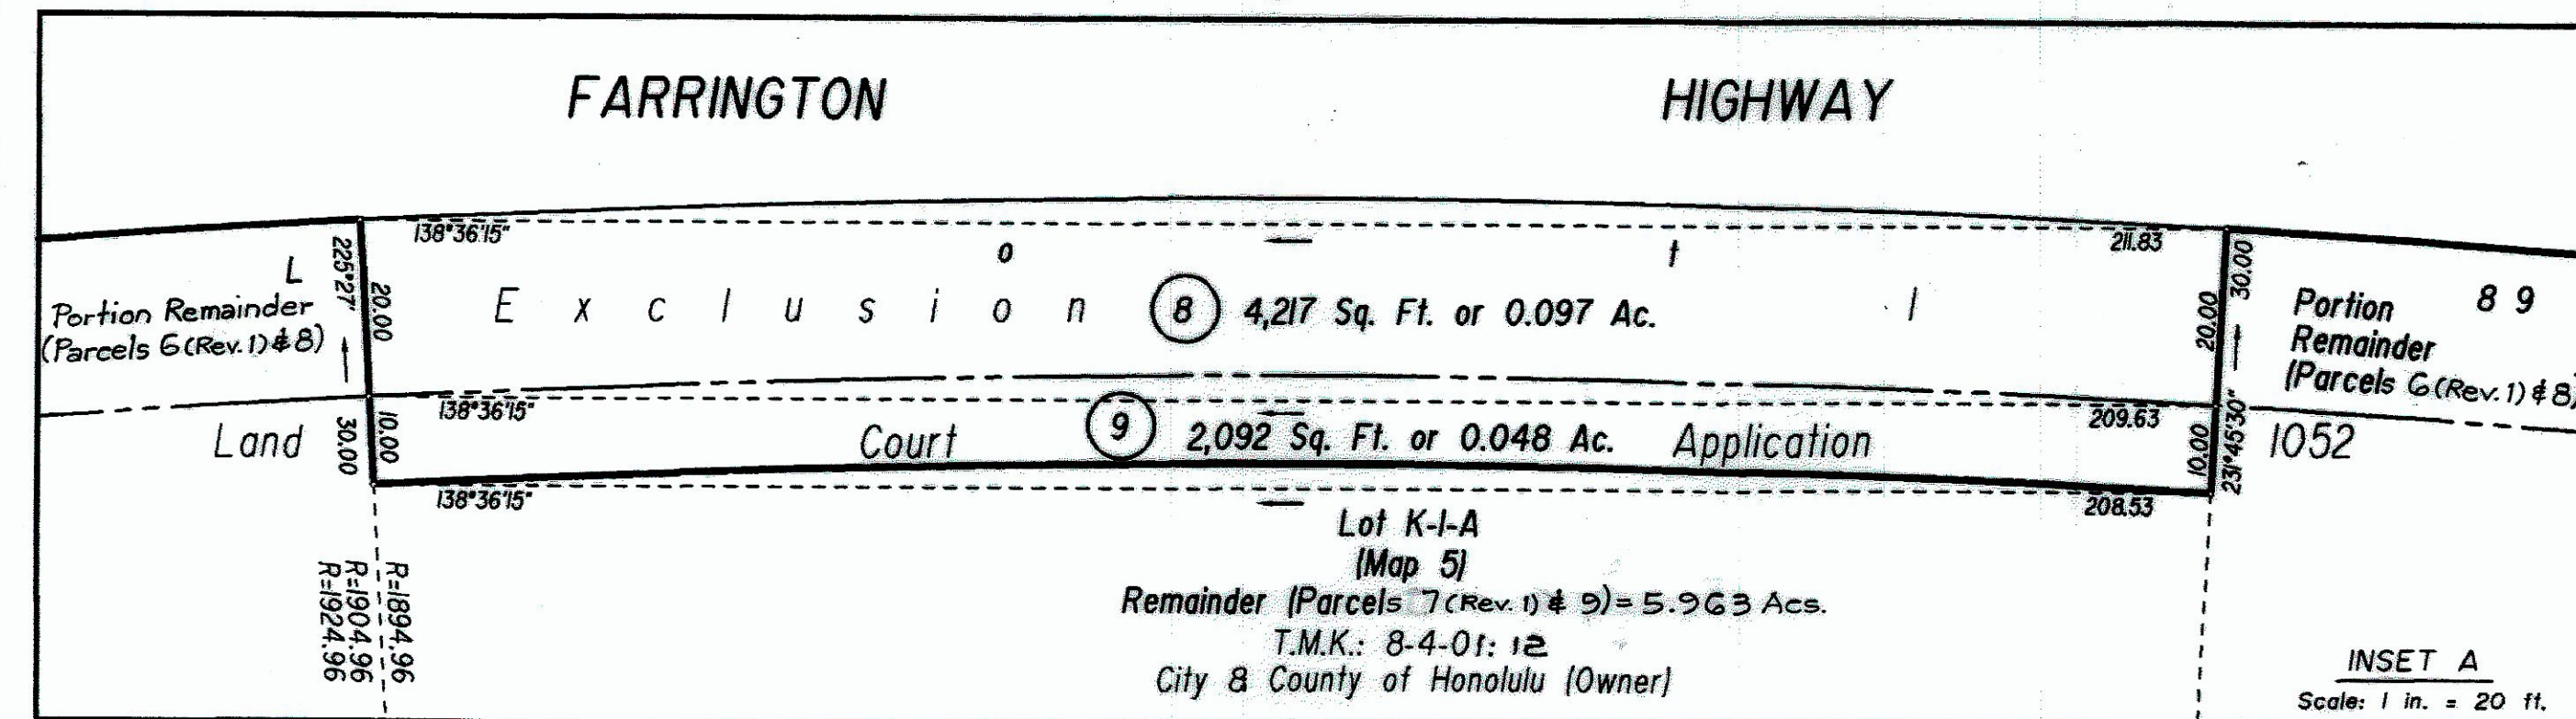

INSET A

Lot 1627
(Map 280)
Remainder (Parcel 1 (Rev. 1)) = 12.367 Acs.
T.M.K.: 8-4-02: 47
City & County of Honolulu (Owner)

Lot K-1-A
(Map 5)
Remainder (Parcels 7 (Rev. 1) & 9) = 5.963 Acs.
T.M.K.: 8-4-01: 12
City & County of Honolulu (Owner)

Lot 1241
(Map 131)
Remainder (Parcel 2 (Rev. 1)) = 22.054 Acs.
T.M.K.: 8-4-02: 45
HRT Ltd. (Owner)

Parcel 2 (Rev. 1)
8,734 Sq. Ft.
or 0.201 Ac.

Parcel 3 (Rev. 1)
4,211 Sq. Ft.
or 0.097 Ac.


STATE OF HAWAII
DEPARTMENT OF TRANSPORTATION
HIGHWAYS DIVISION
RIGHT OF WAY MAP
FARRINGTON HIGHWAY
REPLACEMENT OF MAKAHA BRIDGE NO. 3
AND MAKAHA BRIDGE NO. 3A
FEDERAL AID PROJECT NO. BR-093-1(20)
MAKAHA, WAIANAE, OAHU, HAWAII

HONOLULU, HAWAII
Sept. 11, 2008

APPROVED:
FOR: ADMINISTRATOR HIGHWAYS DIVISION

SHEET NO. 2 OF 3 SHEETS

NO.	REVISION	APPROVED	DATE
3	Parcels 1, 2, 6 and 7 revised per HWY-DS memo dated 1/2/13.	mm	2-21-13
2	Parcel 3 revised per HWY-DS memo dated 9/25/10.	ES	4/9/10
1	Parcel 10 deleted.	SU	5/13/09

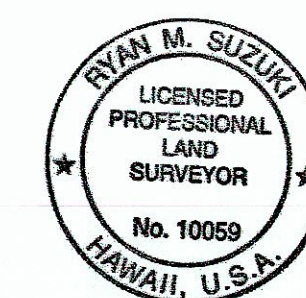




This work was prepared by me
or under my direct supervision

Ryan M. Suzuki
4/30/10
Ryan M. Suzuki
Expiration Date
Licensed Professional Land Surveyor
Certificate Number 10059


Notes:
Origin of Azimuth: "MAKAHA" Δ
Coordinates Referred to: "MAKAHA" Δ

Tax Map Key: 8-4-01: 12
Tax Map Key: 8-4-02: 45 & 47
Tax Map Key: 8-4-08: 20
Tax Map Key: 8-4-19: 14

Project Engineer: _____
Field Engineer: _____
Checker: _____
Draftsman: _____
Checked By: _____
Data Entry: _____
Field Notes: _____
Calculation: _____
M. S. No.: _____
Cart. Editor: _____
LUS-2 (del) / ghuu / tw / Oahu / Farrington / 804-a.dgn

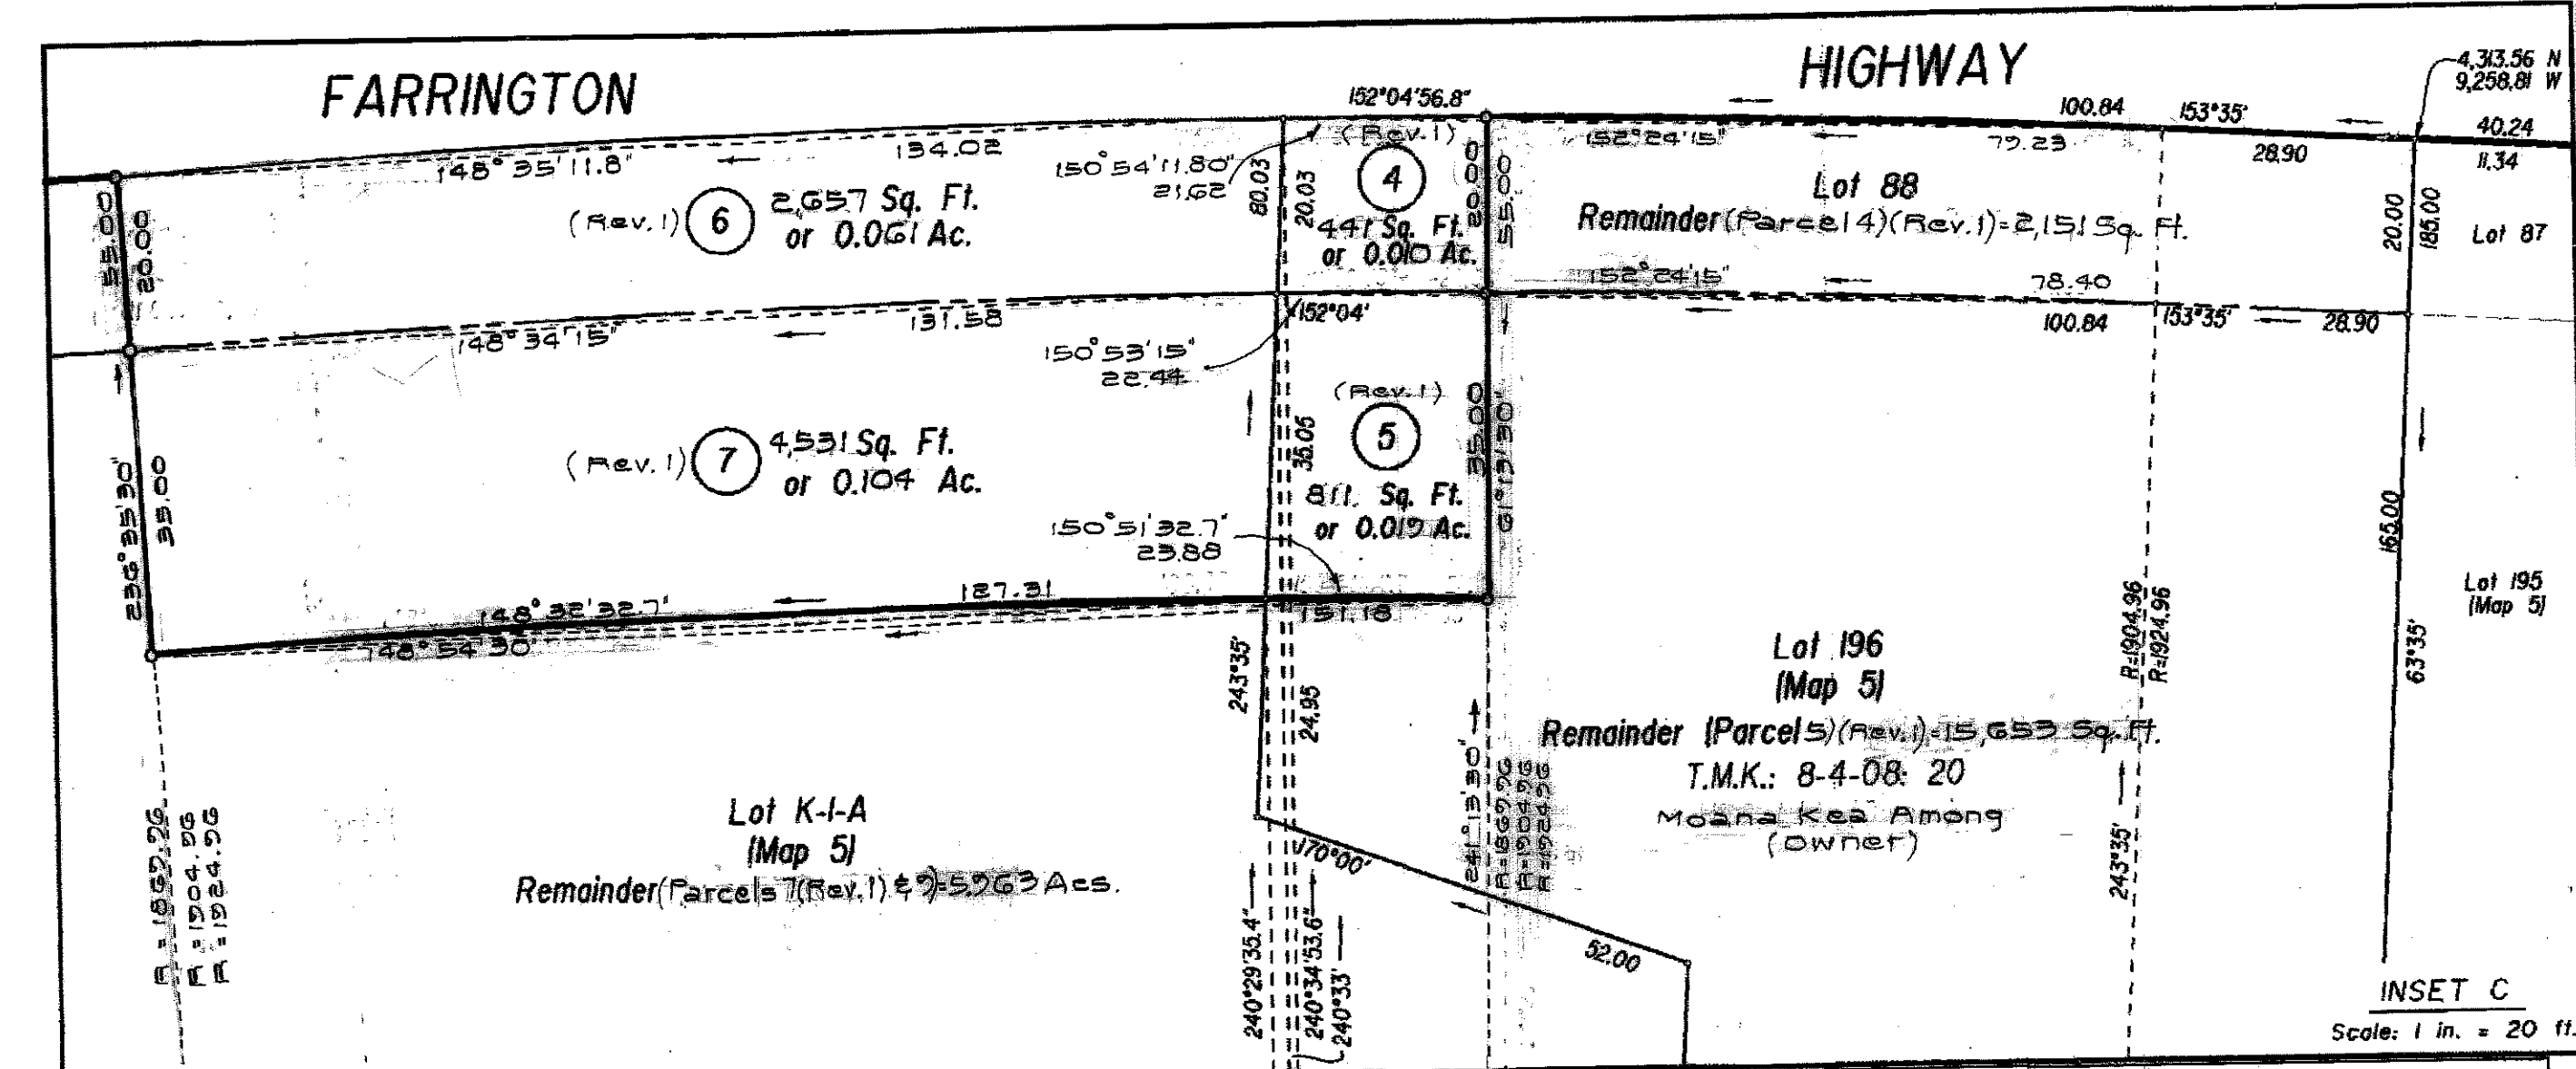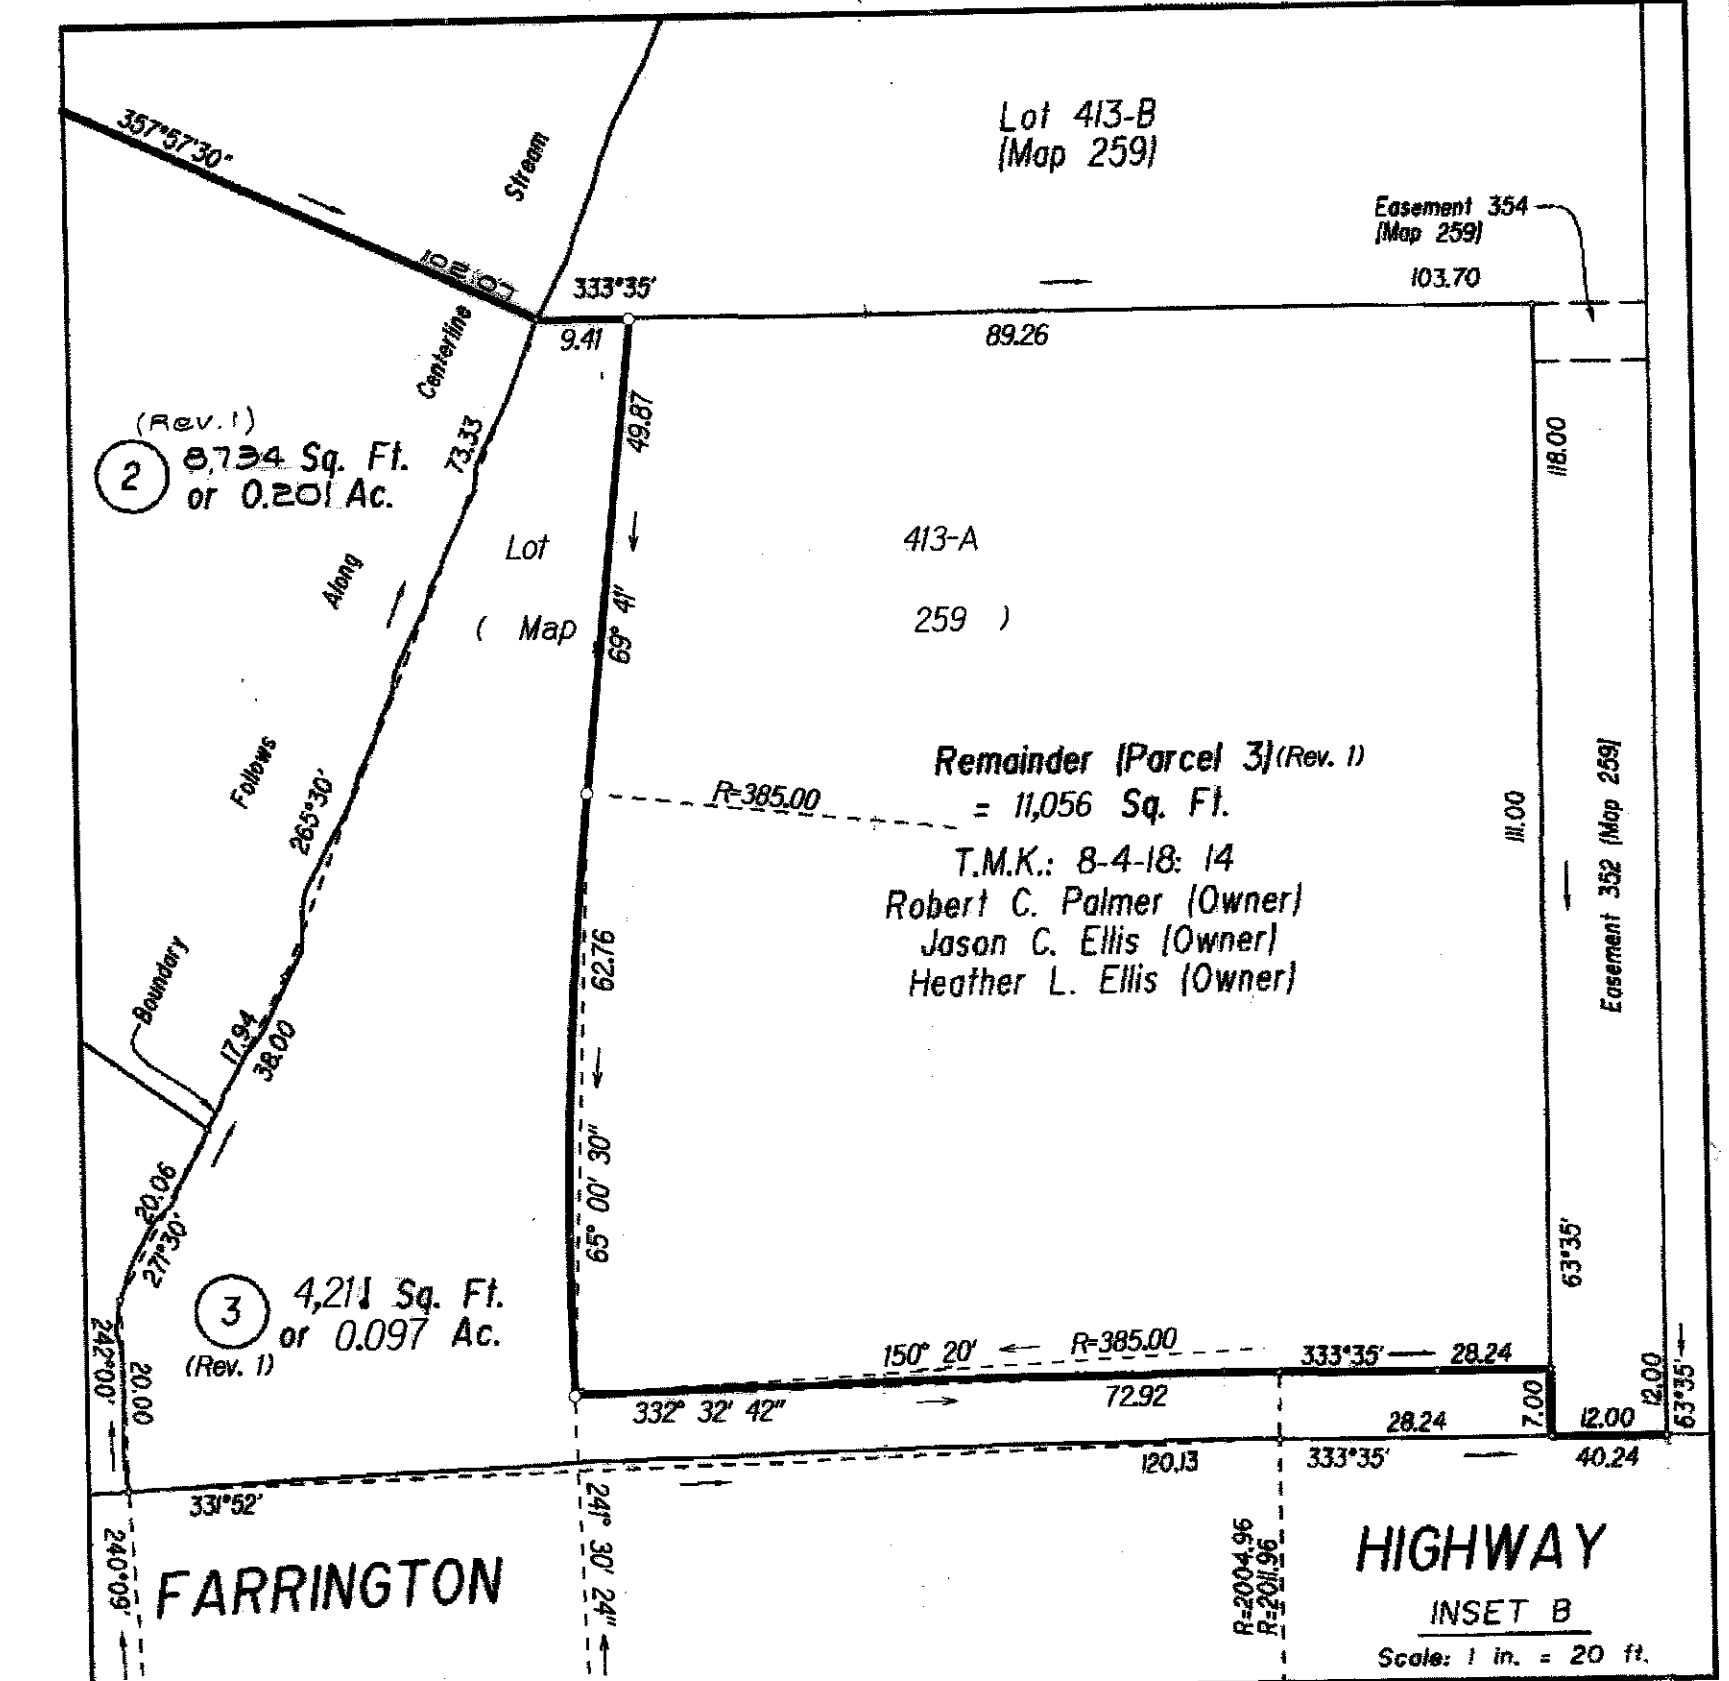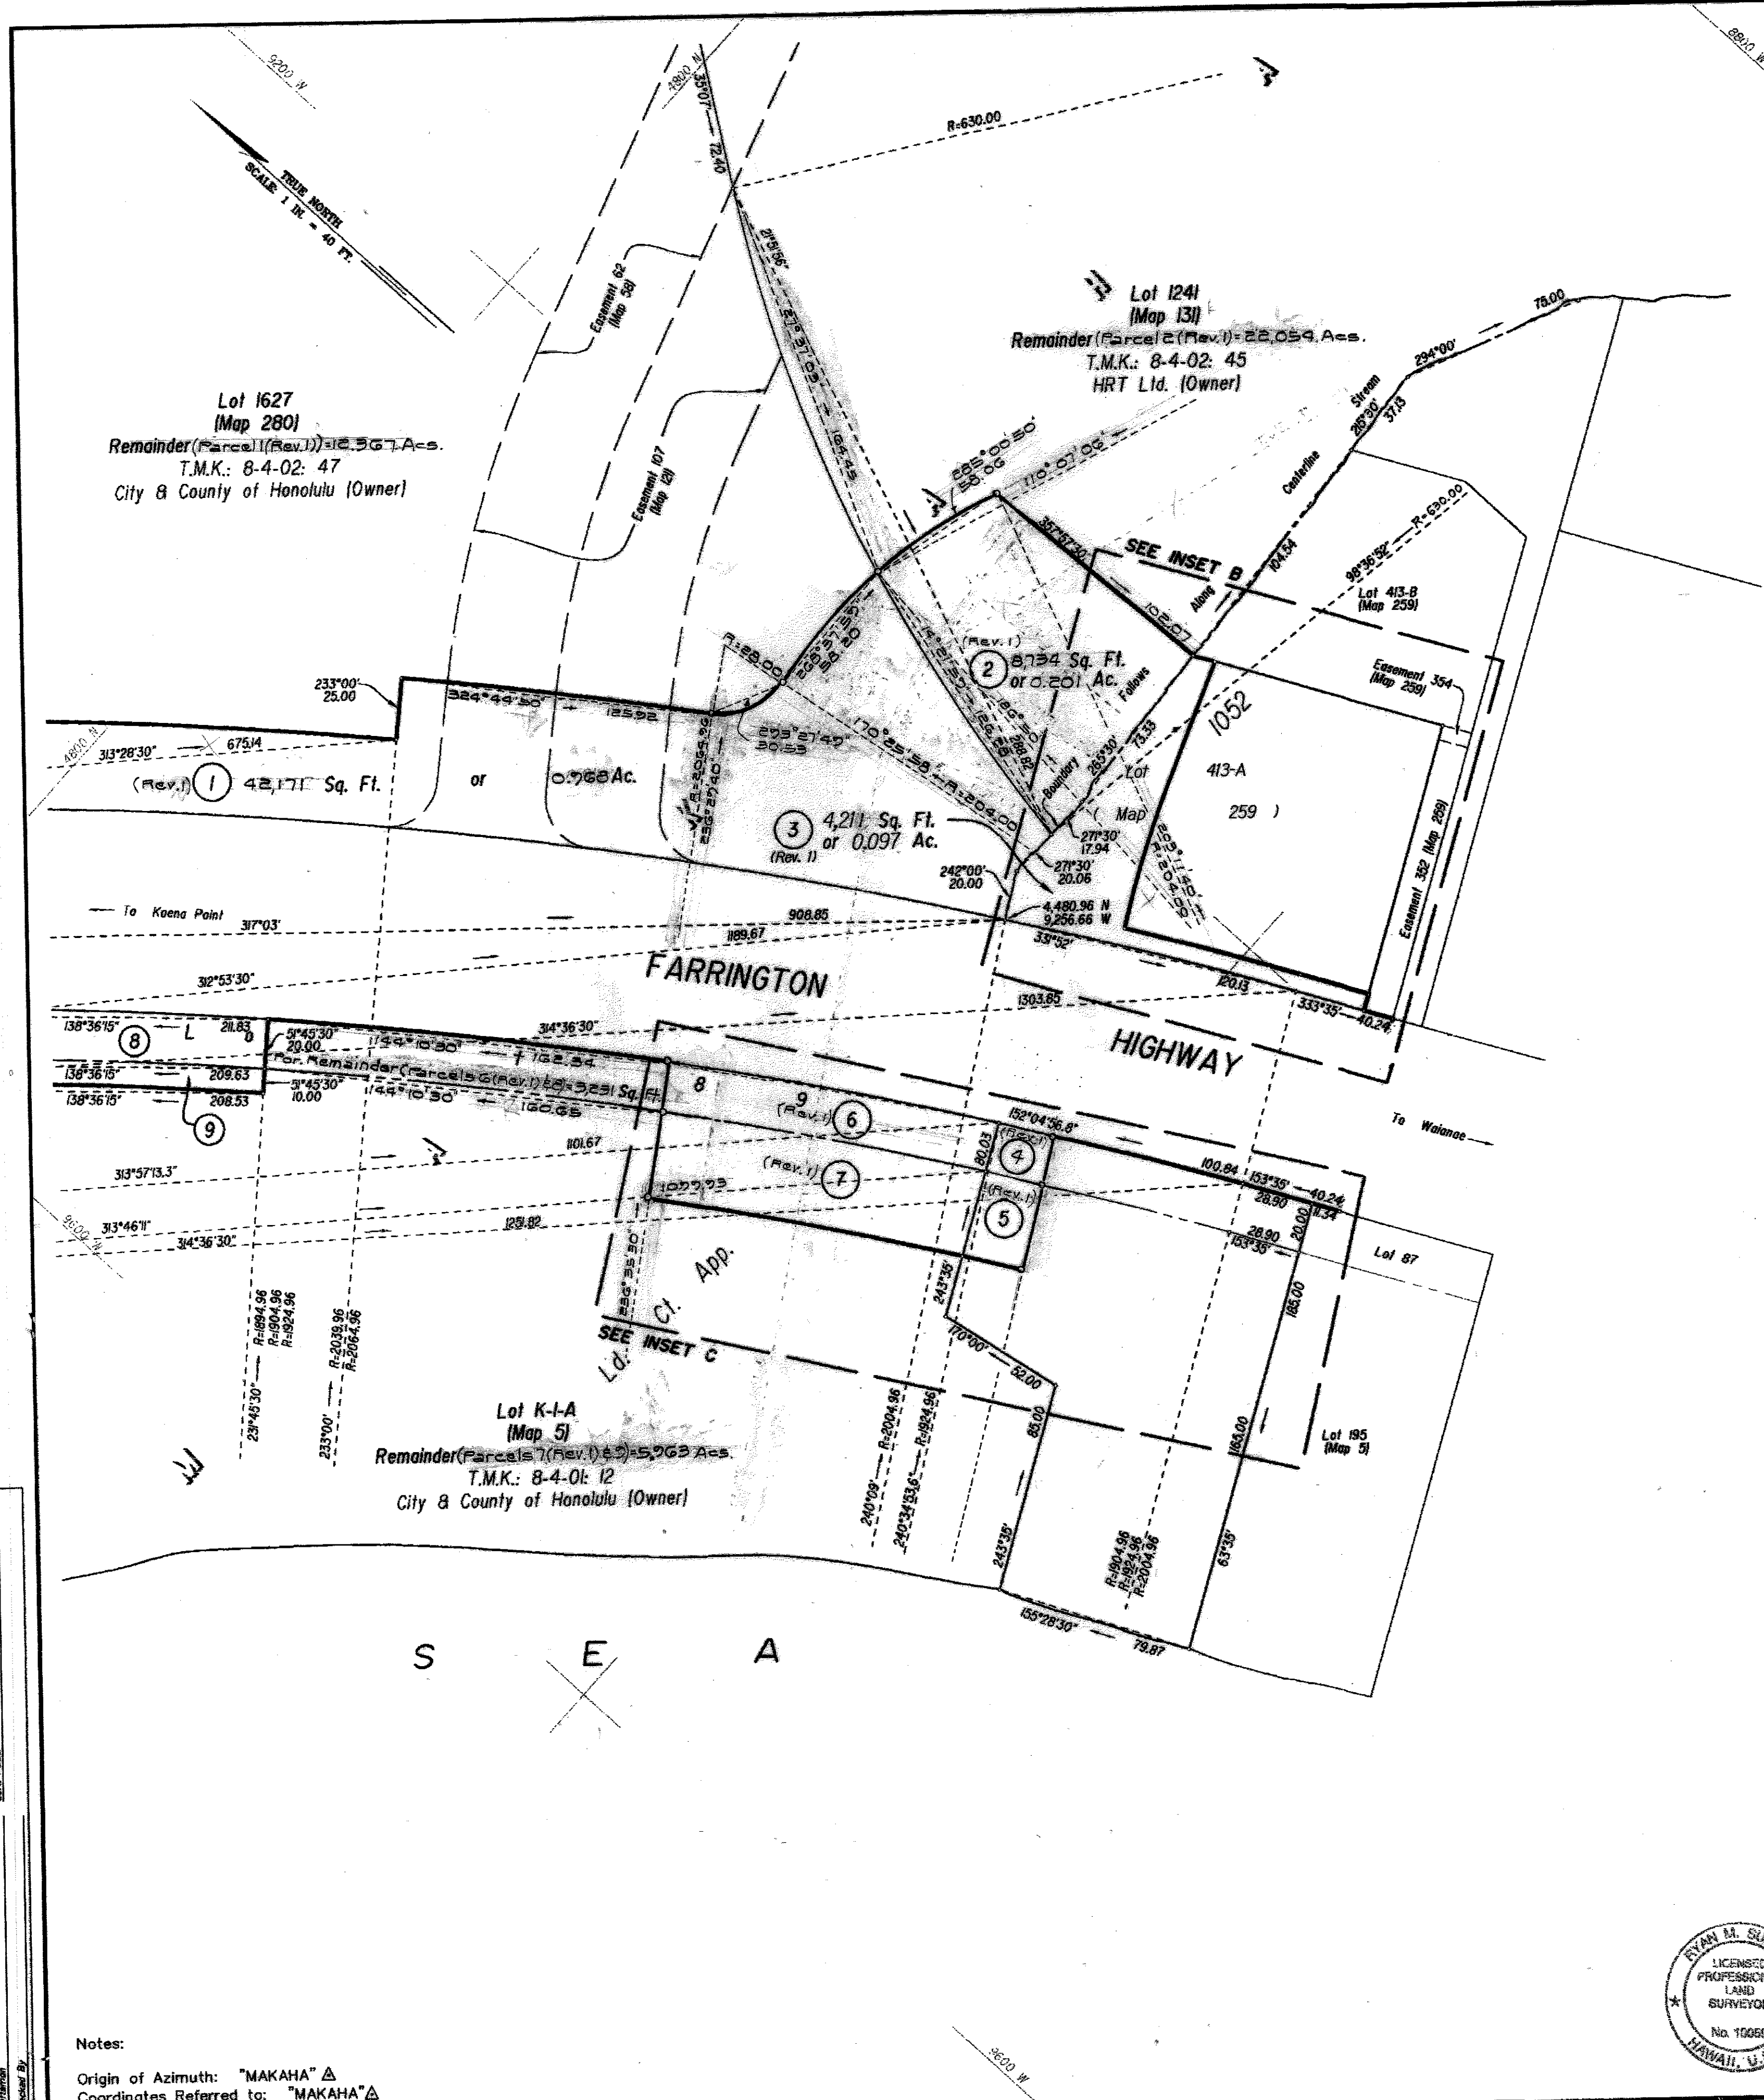

Project Engineer	David F. Fisher
Field Engineer	Paul Bishop
Cartographer	Colleen Fisher
Checker	M. S. No.
Drawn By	Carl Fisher

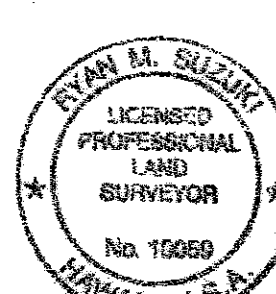

This work was prepared by me or under my direct supervision

Ryan M. Suzuki 4/30/10
Ryan M. Suzuki
Licensed Professional Land Surveyor
Certificate Number 10059

NO.	REVISION	APPROVED	DATE
5	Lot 196 Owner corrected per Hwy. R.	mm	3-12-13
4	Parcels 1, 2, 6 and 7 revised per HWY-DS memo dated 1/2/13.	mm	2-21-13
3	Parcels 4 and 5 revised per HWY-RL 7/01.	mm	3-29-12
2	Parcel 3 revised per HWY-DS memo dated 3/25/2010.	ES	4/9/10
1	Parcel 10 deleted.	SL	5/13/09

STATE OF HAWAII
DEPARTMENT OF TRANSPORTATION
HIGHWAYS DIVISION
RIGHT OF WAY MAP
FARRINGTON HIGHWAY
REPLACEMENT OF MAKAHA BRIDGE NO. 3
AND MAKAHA BRIDGE NO. 3A
FEDERAL AID PROJECT NO. BR-093-1(20)
MAKAHA, WAIANAE, OAHU, HAWAII

HONOLULU, HAWAII
Sept. 11, 2008

APPROVED: *[Signature]*
FOR: ADMINISTRATOR HIGHWAYS DIVISION

SHEET NO. 3 OF 3 SHEETS

22' X 36" = 5.50 Sq. Ft.

Notes:
Origin of Azimuth: "MAKAHA" Δ
Coordinates Referred to: "MAKAHA" Δ

Tax Map Key 8-4-01: 12
Tax Map Key 8-4-08: 20