


FILE: K:\Civil\19969 Makaha Bridge\Orig\Construction Dwg\ADD.25 Geometric Plan - 1.dwg saved December 8, 2020



FED. ROAD DIST. NO.	STATE	FED. AID PROJ. NO.	FISCAL YEAR	SHEET NO.	TOTAL SHEETS
HAWAII	HAW.	BR-093-1(20)	2020	ADD.25	168

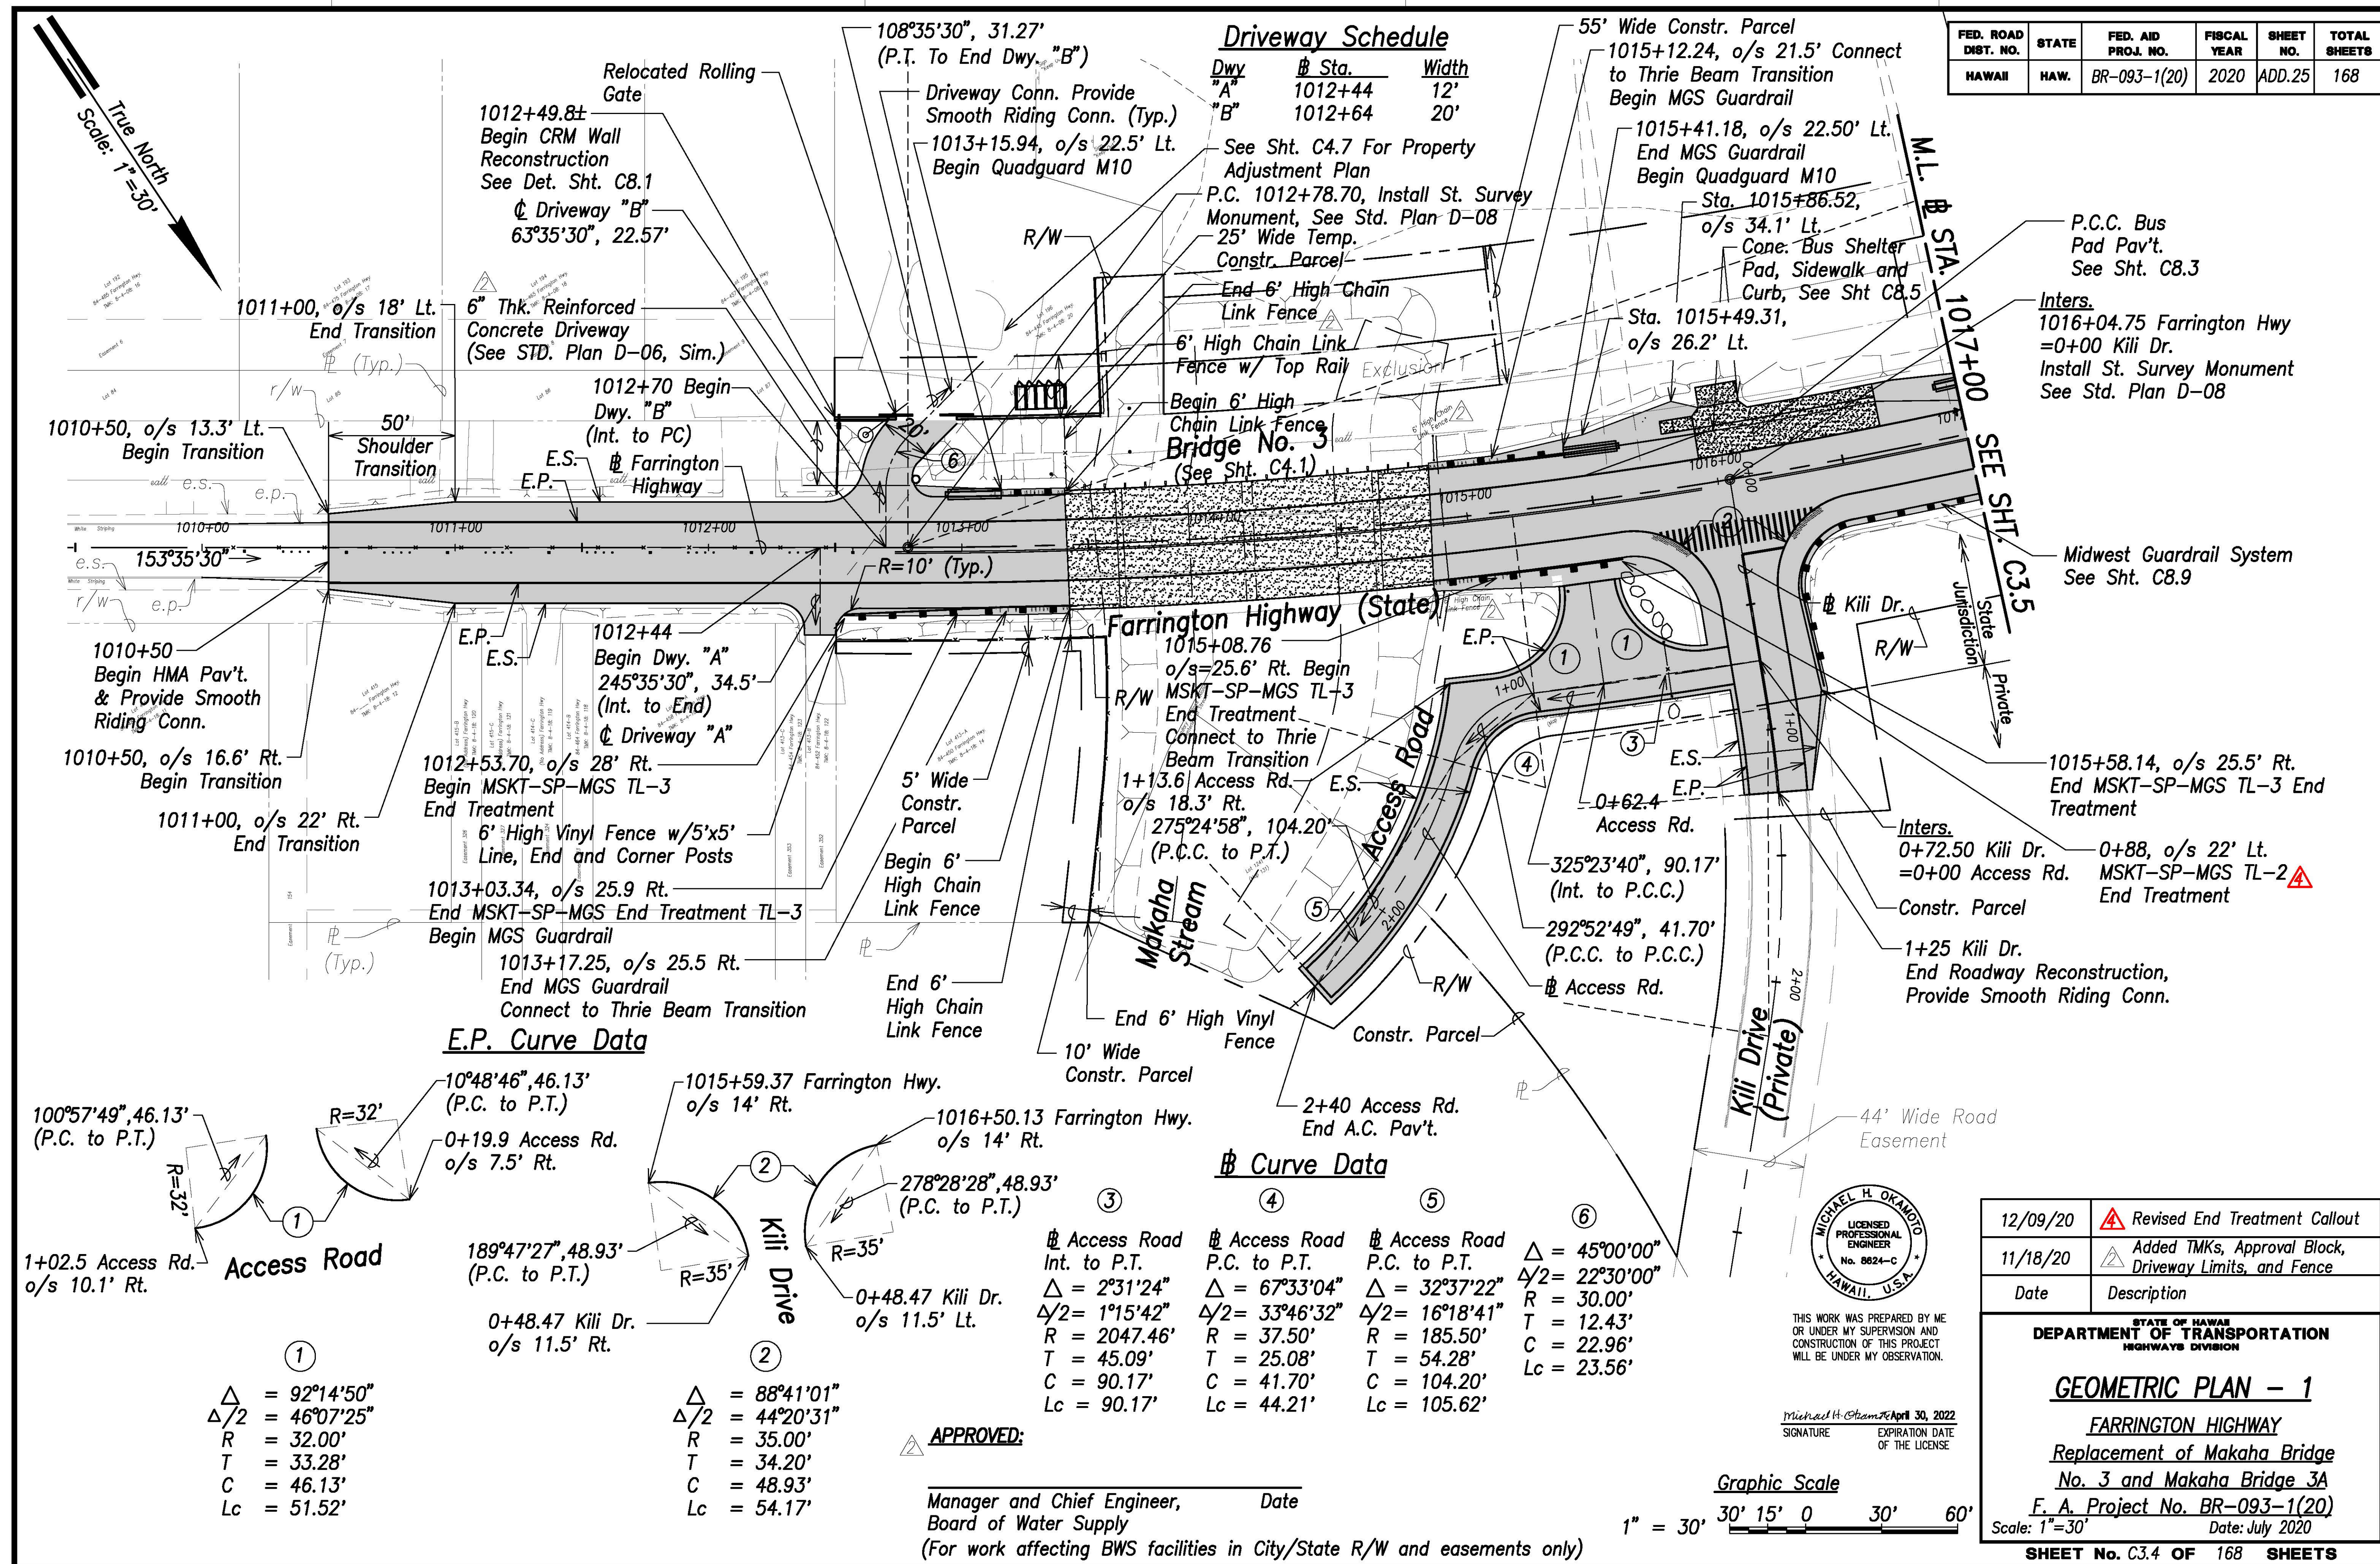

THIS WORK WAS PREPARED BY ME OR UNDER MY SUPERVISION AND CONSTRUCTION OF THIS PROJECT WILL BE UNDER MY OBSERVATION.

Michael H. Okamoto
SIGNATURE
EXPIRATION DATE OF THE LICENSE

12/09/20	Revised End Treatment Callout
11/18/20	Added TMKs, Approval Block, Driveway Limits, and Fence
Date	Description


STATE OF HAWAII
DEPARTMENT OF TRANSPORTATION
HIGHWAYS DIVISION

GEOMETRIC PLAN - 1
FARRINGTON HIGHWAY
Replacement of Makaha Bridge No. 3 and Makaha Bridge 3A
F. A. Project No. BR-093-1(20)
Scale: 1"=30' Date: July 2020

SHEET No. C3.4 OF 168 SHEETS

FED. ROAD DIST. NO.	STATE	FED. AID PROJ. NO.	FISCAL YEAR	SHEET NO.	TOTAL SHEETS
HAWAII	HAW.	BR-093-1(20)	2020	ADD.26	168

True North
Scale: 1"=30'

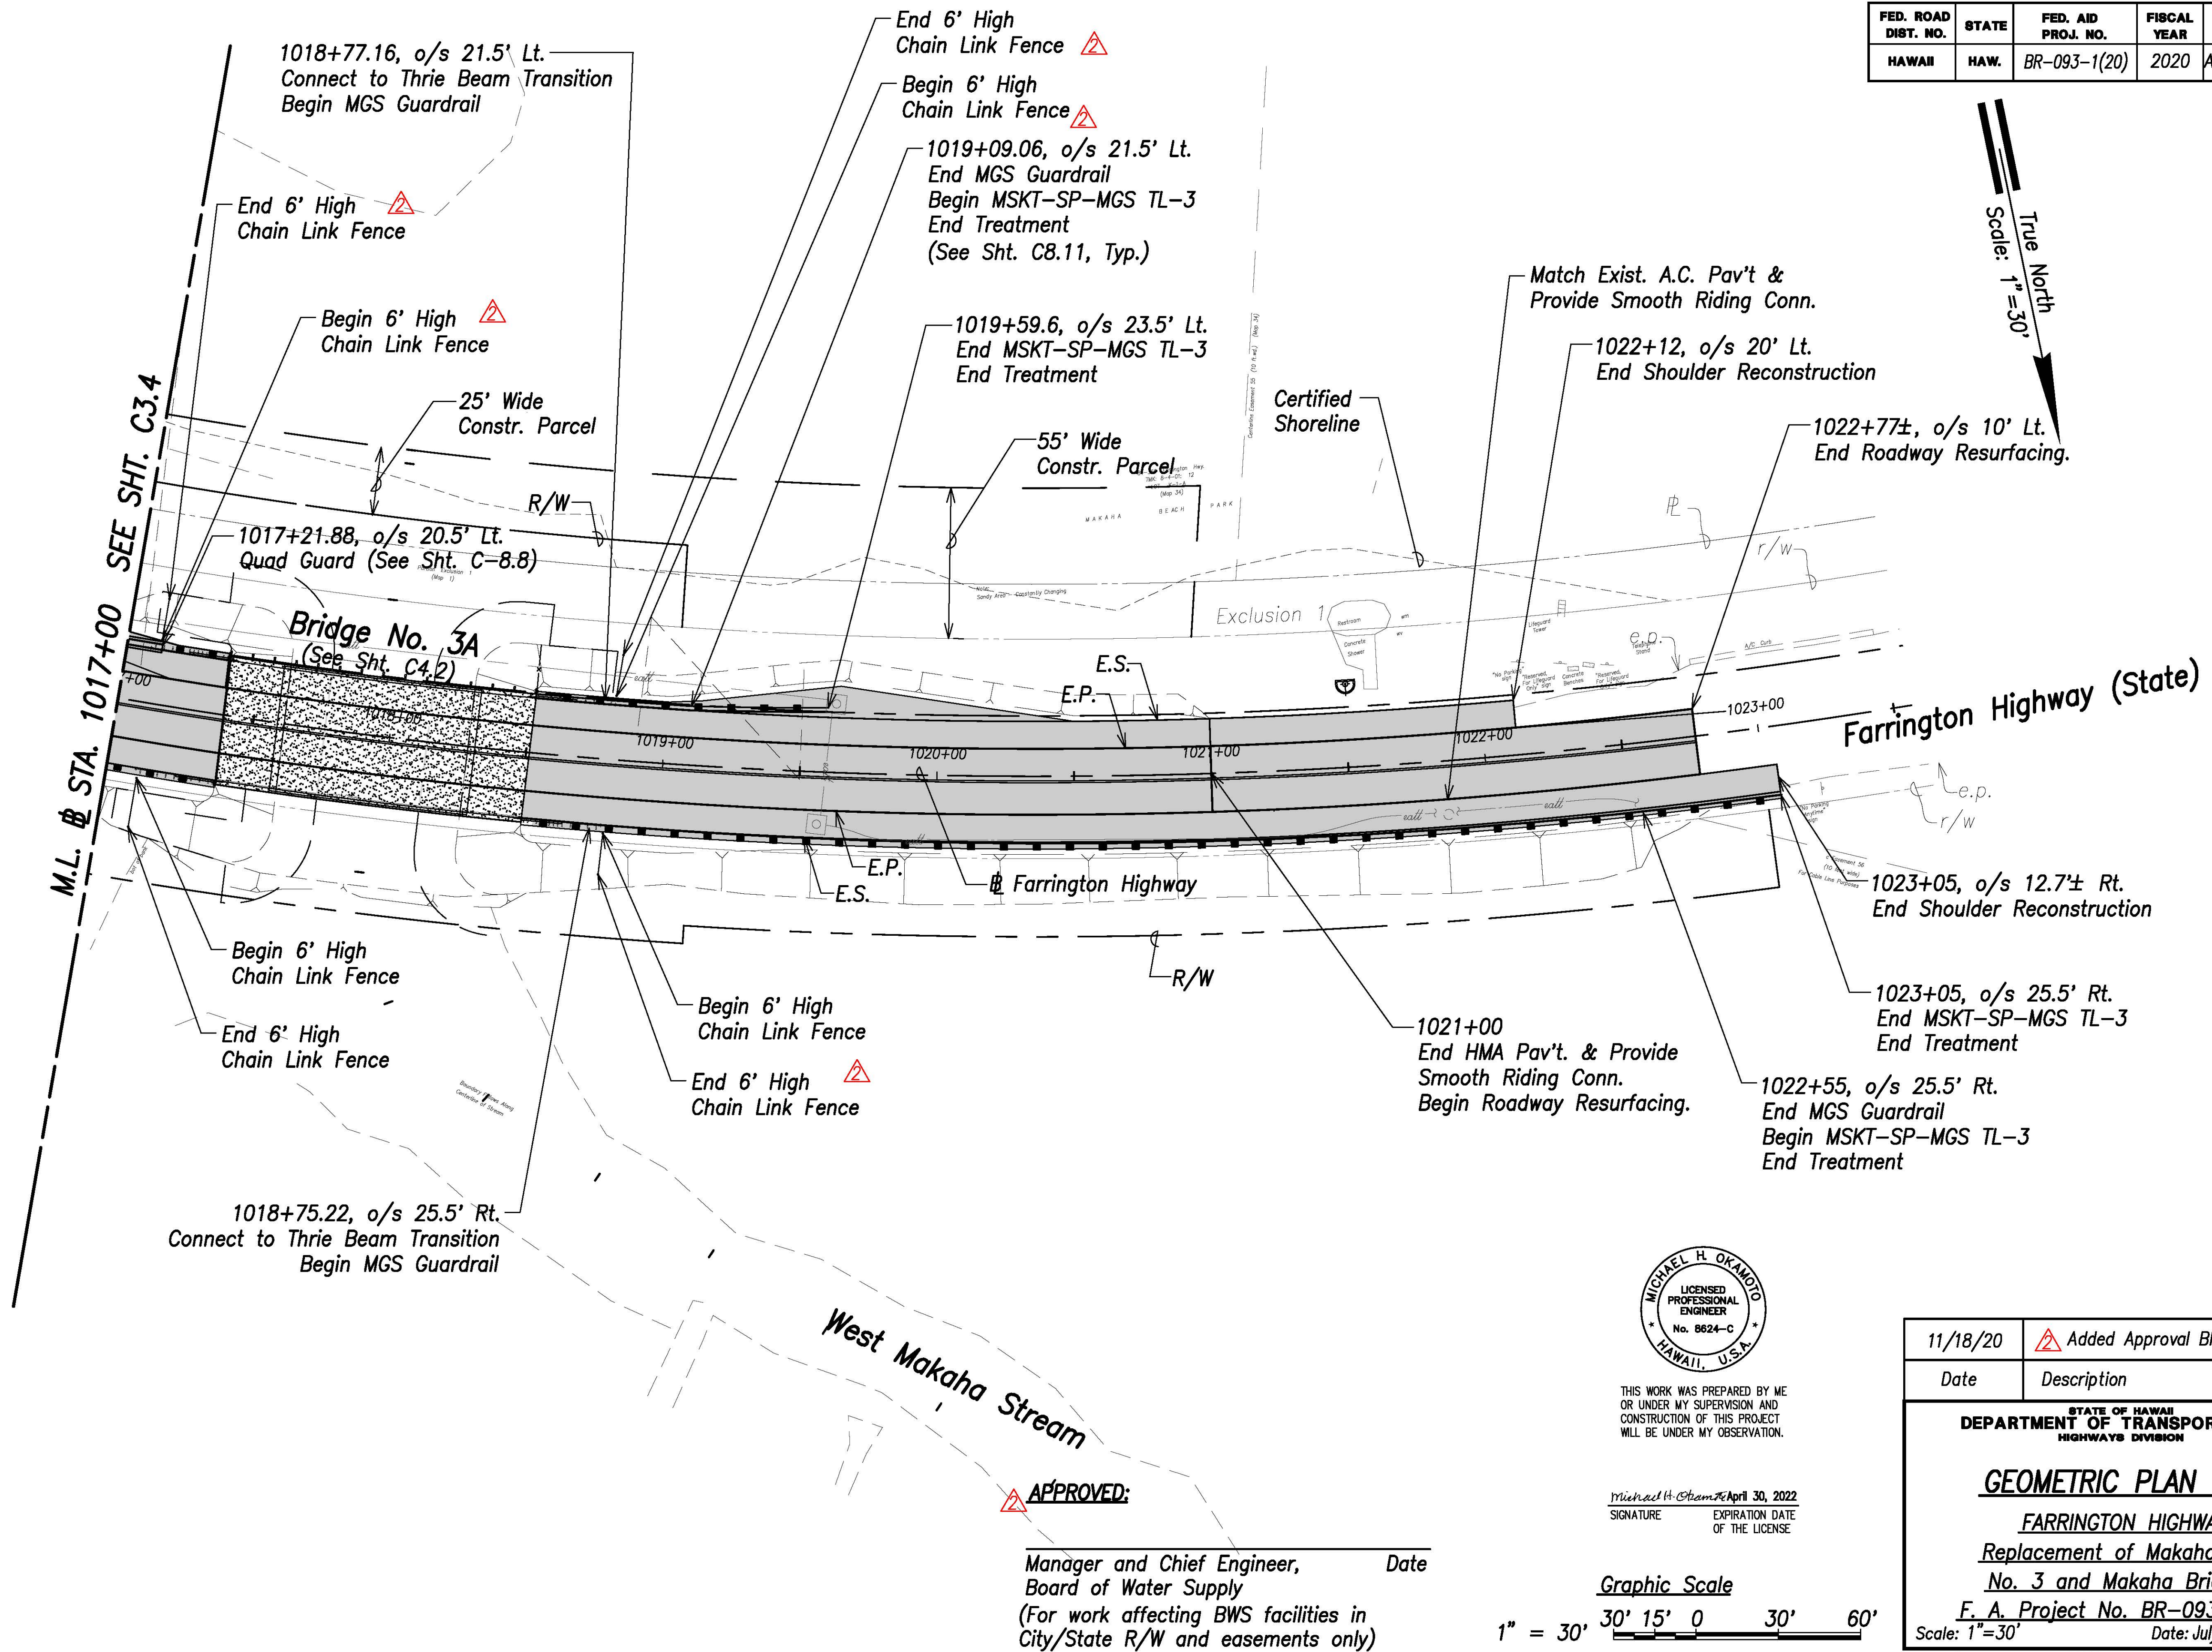

11/18/20	Added Approval Block and Fence
Date	Description
STATE OF HAWAII DEPARTMENT OF TRANSPORTATION HIGHWAYS DIVISION	
GEOMETRIC PLAN - 2	
FARRINGTON HIGHWAY	
Replacement of Makaha Bridge	
No. 3 and Makaha Bridge 3A	
F. A. Project No. BR-093-1(20)	
Scale: 1"=30'	Date: July 2020
SHEET No. C3.5 OF 168 SHEETS	