



FED. ROAD DIST. NO.	STATE	FED. AID PROJ. NO.	FISCAL YEAR	SHEET NO.	TOTAL SHEETS
HAWAII	HAW.	BR-093-1(20)	2020	37	168

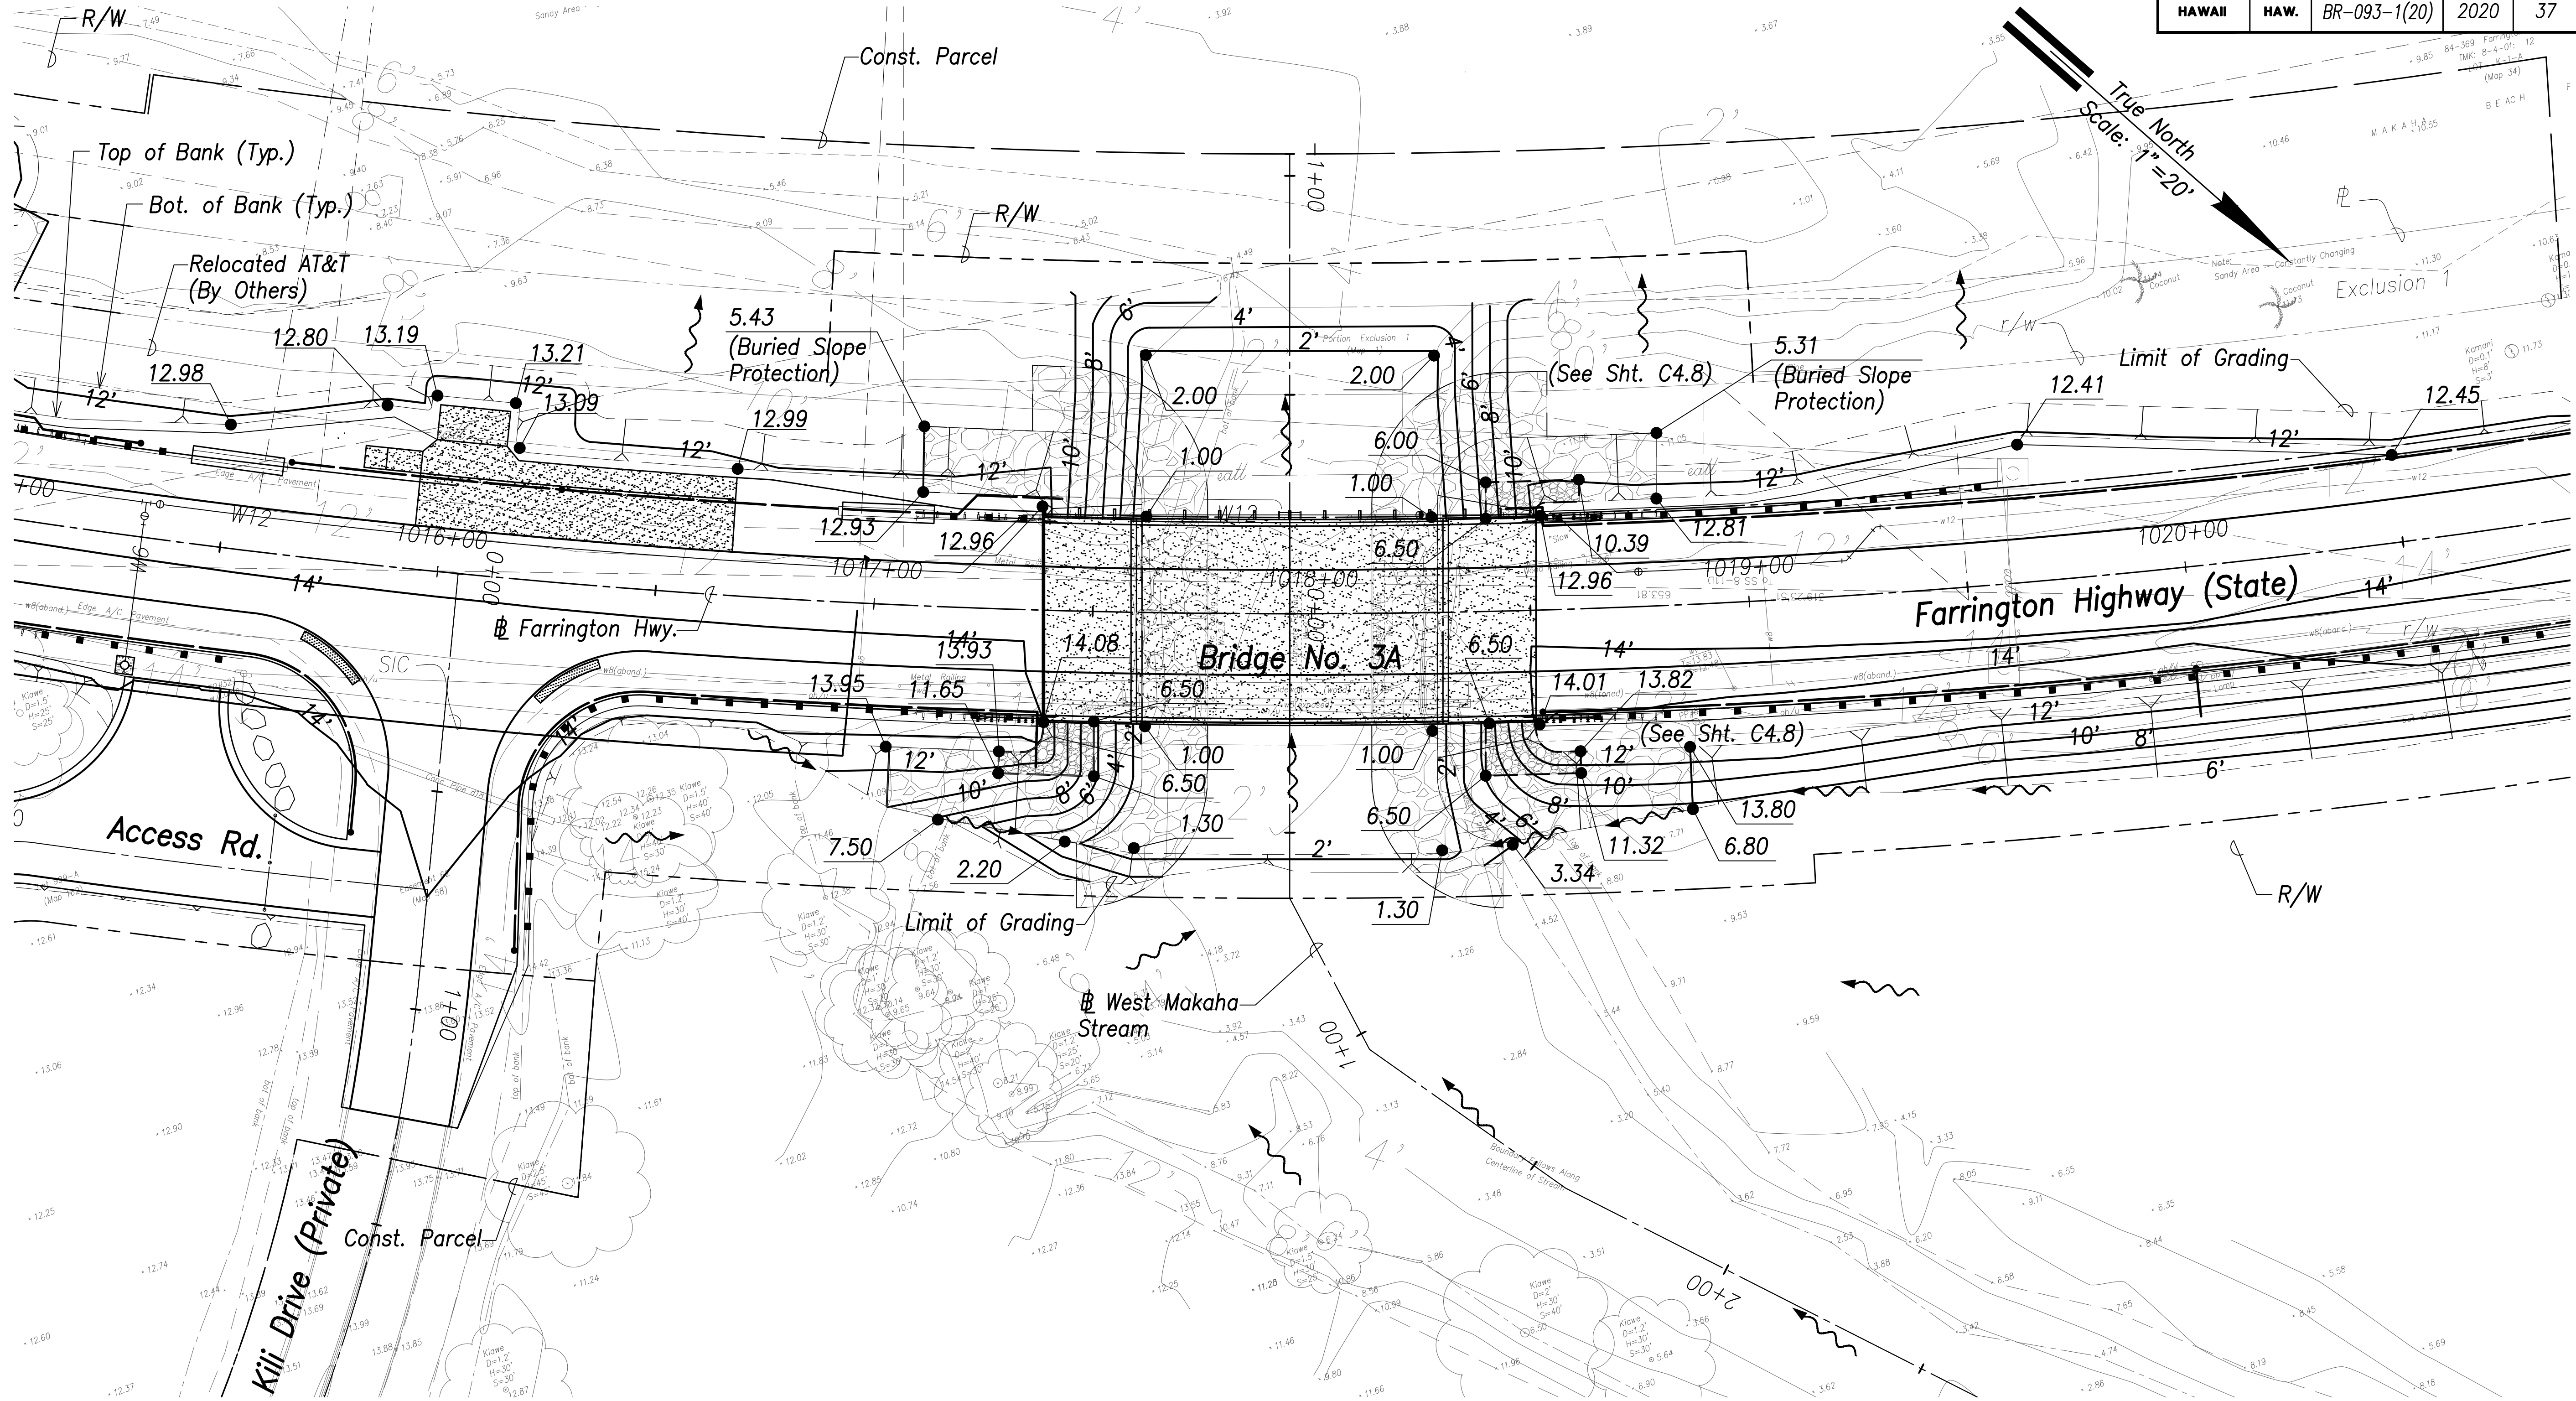

ORIGINAL PLAN	SURVEY PLOTTED BY	DATE
	DRAWN BY	
	CHECKED BY	
	NOTED BY	
NOTE BOOK	QUANTITIES BY	
	CHECKED BY	
No.		

WEST MAKAHA GRADING AND DRAINAGE PLAN
Scale: 1"=20'

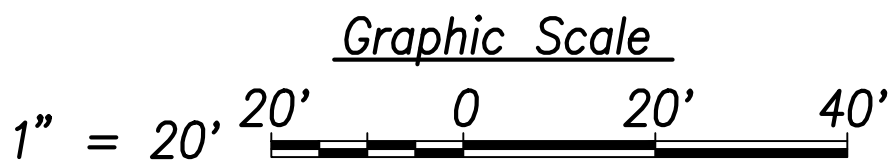

THIS WORK WAS PREPARED BY ME
OR UNDER MY SUPERVISION AND
CONSTRUCTION OF THIS PROJECT
WILL BE UNDER MY OBSERVATION.

Michael H. Okamoto April 30, 2022
SIGNATURE EXPIRATION DATE
OF THE LICENSE

STATE OF HAWAII
DEPARTMENT OF TRANSPORTATION
HIGHWAYS DIVISION
**WEST MAKAHA GRADING
AND DRAINAGE PLAN**
FARRINGTON HIGHWAY
Replacement of Makaha Bridge
No. 3 and Makaha Bridge 3A
F. A. Project No. BR-093-1(20)
Scale: 1"=20' Date: July 2020
SHEET No. C4.6 OF 168 SHEETS