


FED. ROAD DIST. NO.	STATE	FED. AID PROJ. NO.	FISCAL YEAR	SHEET NO.	TOTAL SHEETS
HAWAII	HAW.	BR-093-1(20)	2020	ADD.38	168

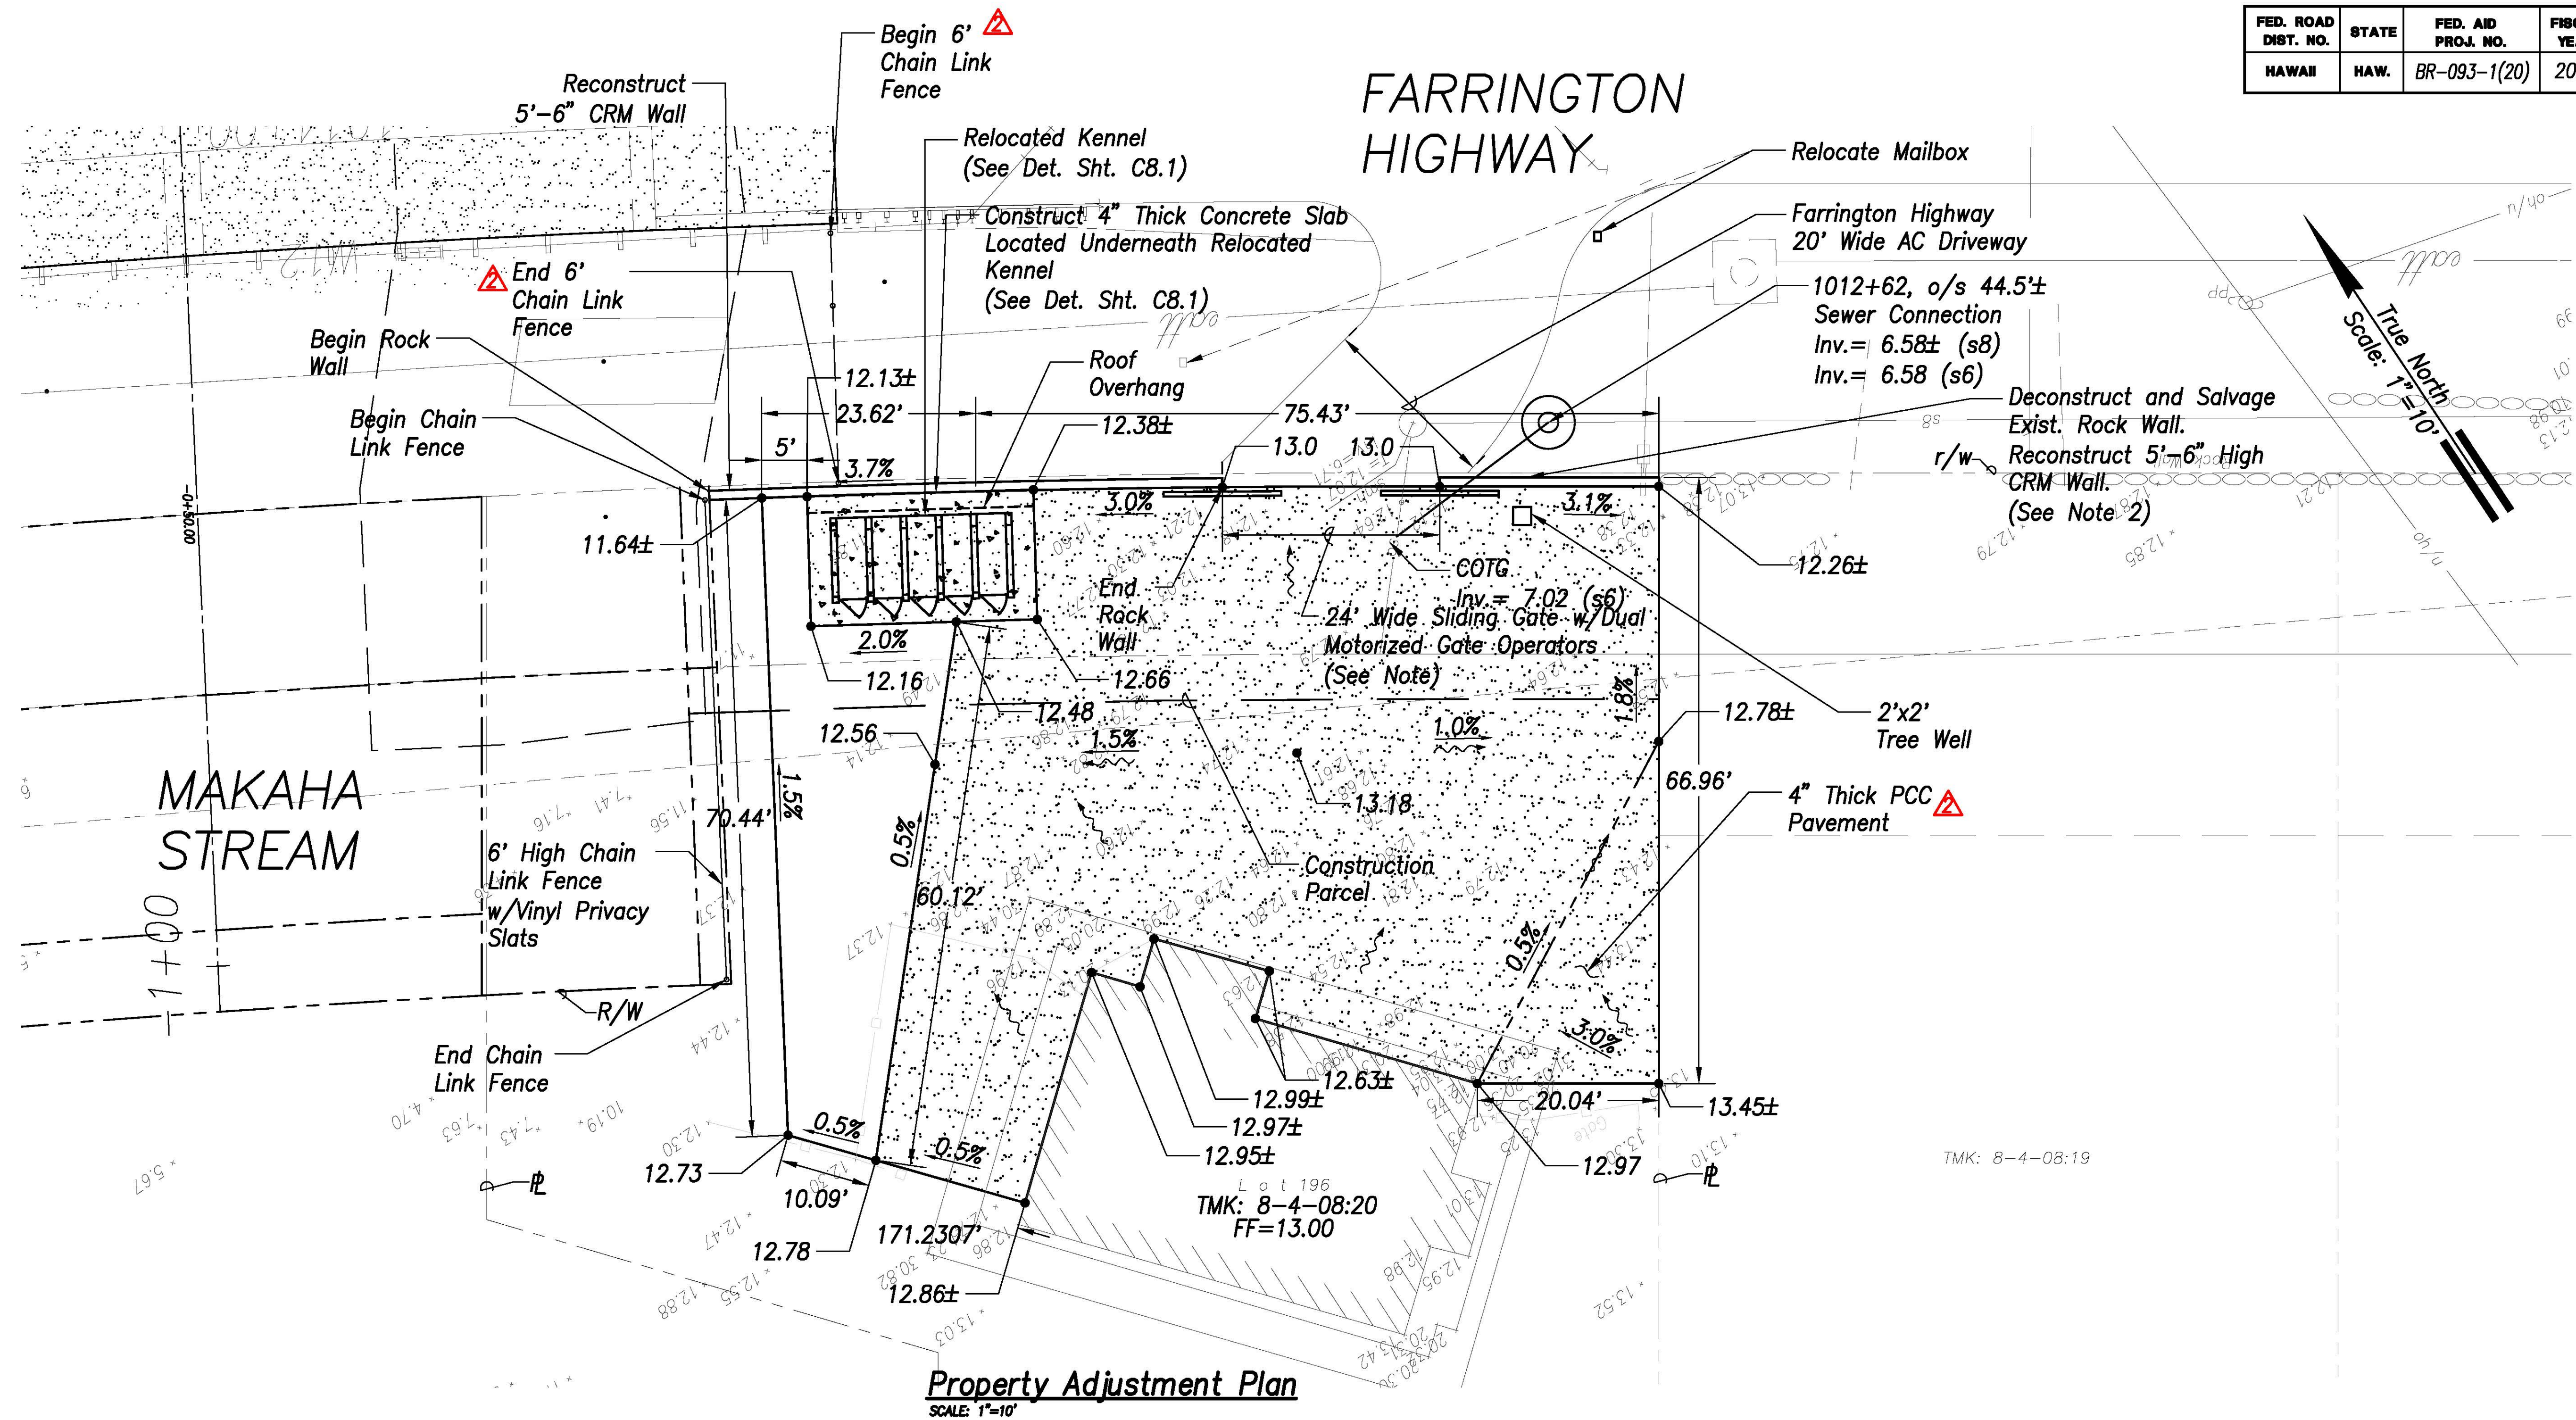

Note:

- Sliding Gate Operator Shall be Gear Driven, Wireless Gate Opening/Closing Operation, Manual Disconnect for Manual Opening of Gate, Pressure Sensitive Gate Stop/Reverse, Smart Technology MyQ Compatible Homelink Compatible, 120VAC, Single Phase, UV Resistant Cover and Corrosion Resistant Chassis, 7 Year Residential Warranty.
- Contractor Shall Exercise Care When Deconstructing Existing Rock Wall. Existing Stone Shall be Secured, Stored, and Used in the Reconstruction of The Proposed CRM Wall.

APPROVED:

Manager and Chief Engineer, Board of Water Supply
(For work affecting BWS facilities in City/State R/W and easements only)

Graphic Scale:
1" = 10' 10' 5' 0' 10' 20'



THIS WORK WAS PREPARED BY ME OR UNDER MY SUPERVISION AND CONSTRUCTION OF THIS PROJECT WILL BE UNDER MY OBSERVATION.

Signature: Michael H. Okamoto
Date: April 30, 2022
Expiration Date of the License:

11/18/20	Added PCC Pav't Thickness and Approval Block; Revised Fence and Notes
Date	Description

STATE OF HAWAII DEPARTMENT OF TRANSPORTATION HIGHWAYS DIVISION
PROPERTY ADJUSTMENT
FARRINGTON HIGHWAY
Replacement of Makaha Bridge No. 3 and Makaha Bridge 3A
F. A. Project No. BR-093-1(20)
Scale: Date: July 2020
SHEET No. C4.7 OF 168 SHEETS