

FED. ROAD DIST. NO.	STATE	FED. AID PROJ. NO.	FISCAL YEAR	SHEET NO.	TOTAL SHEETS
HAWAII	HAW.	STP-093-1(22)	2013	169	230

INDEX TO STRUCTURAL DRAWINGS


SHEET NO.	DESCRIPTION
S0.1	INDEX TO STRUCTURAL DRAWINGS
S0.2	STRUCTURAL GENERAL NOTES
S0.3	STRUCTURAL GENERAL NOTES
S0.4	SYMBOLS AND ABBREVIATIONS
S0.5	TYPICAL DETAILS
S0.6	TYPICAL DETAILS
S1.1	RETAINING WALL B ELEVATION STA. 140+43.2 TO STA. 142+35
S1.2	RETAINING WALL B ELEVATION STA. 142+35 TO STA. 144+35
S1.3	RETAINING WALL B ELEVATION STA. 144+35 TO STA. 146+35
S1.4	RETAINING WALL B ELEVATION STA. 146+35 TO STA. 148+35
S1.5	RETAINING WALL B ELEVATION STA. 148+35 TO STA. 149+42.22
S1.6	RETAINING WALL A ELEVATION STA. 140+43.2
S1.7	TYPICAL WALL SECTIONS
S1.8	TYPICAL WALL SECTIONS
S1.9	SECTION
S1.10	SECTIONS
S2.1	EXISTING BOX CULVERT AND CHANNEL DEMOLITION - PLAN
S2.2	EXISTING BOX CULVERT AND CHANNEL DEMOLITION - SECTIONS
S2.3	EXISTING BOX CULVERT AND CHANNEL DEMOLITION - SECTIONS
S2.4	EXISTING CHANNEL DEMOLITION DETAILS
S3.1	BOX CULVERT EXTENSION - PLAN
S3.2	SECTION AND ELEVATION
S3.3	SECTIONS
S3.4	SECTIONS
S3.5	CONSTRUCTION SEQUENCE BOX CULVERT EXTENSION - PLAN
S4.1	TYPICAL CONN. OF 24" DIA. PIPE TO EXIST. BOX CULVERT - PLAN & SECTION
S4.2	SECTIONS
S4.3	SECTIONS

INDEX TO STRUCTURAL DRAWINGS

SHEET NO.	DESCRIPTION
S5.1	FRP PEDESTRIAN RAILING ELEVATIONS
S5.2	FRP PEDESTRIAN RAILING ELEVATION
S5.3	FRP PEDESTRIAN RAILING ELEVATIONS AND SECTION
S6.1	TYPICAL TRAFFIC SIGNAL POLE FOUNDATION

ORIGINAL PLAN	SURVEY PLOTTED BY	DATE
NOTE BOOK	DESIGNED BY	
No.	CHECKED BY	

DRAWING NAME: Z:\00 ONGOING\12-026-FARRINGTON HWY NAKAKULI TO HALEAKALA-ULEHAWA\CAD\07-17-13 FINAL 100%\FHU-S001.DWG PLOT TIME: 07-16-13, 4:04 PM

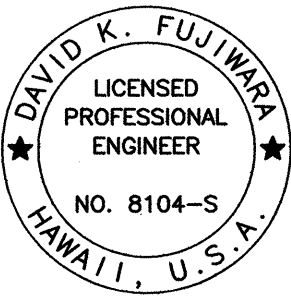

THIS WORK WAS PREPARED BY ME
OR UNDER MY SUPERVISION.
David K. Fujiwara
KSF, INC. APRIL 30, 2014
LIC. EXP. DATE

STATE OF HAWAII
DEPARTMENT OF TRANSPORTATION
HIGHWAYS DIVISION

INDEX TO STRUCTURAL DRAWINGS

FARRINGTON HIGHWAY INTERSECTION IMPROVEMENTS
AT NAKAKULI AVENUE AND HALEAKALA AVENUE
Federal-Aid Project No. STP-093-1(22)

Scale: None Date: April 2013

SHEET No. S01 OF 6 SHEETS

STRUCTURAL GENERAL NOTES

FED. ROAD DIST. NO.	STATE	FED. AID PROJ. NO.	FISCAL YEAR	SHEET NO.	TOTAL SHEETS
HAWAII	HAW.	STP-093-1(22)	2013	ADD. 170	230

1. General Specifications: Hawaii Department of Transportation, Standard Specifications for Road and Bridge and Public Works Construction, 2005, together with Special Provisions prepared for this contract.

2. Design Specifications:

- (A) AASHTO 2012 LRFD Bridge Design Specifications (Sixth Edition) including subsequent interim specifications with interim supplements and modifications by the Highways Division, Department of Transportation, State of Hawaii.
- (B) HDOT Memorandum dated October 20, 2010 with subject title "Design Criteria for Bridges and Structures".
- (C) AASHTO Standard Specifications for Structural Supports for Highway Signs, Luminaires and Traffic Signals, 5th Edition (2009) including subsequent interim revisions and additions.

3. Loads:

- (A) Live Load: Pedestrian Loading - 85 psf
- (B) Wind Load: 105 mph. Value is a 3 second gust speed at 32.8 ft above ground for Exposure C category and is associated with an annual probability of 0.02 (50 year mean recurrence interval).
- (C) Utility Load: An allowance of 150 PLF on each side of the bridge for utility loads has been provided for in the design.
- (D) Seismic Load: Acceleration Coefficient - 0.17g
- (E) Ballast Rock = 160 pcf

4. Materials:

- (A) All concrete strengths shall be as noted below:

Item No.	Structural Parts	Specified Compressive Strength, f'c (28 Days)	Maximum Cement Content (lbs./Cu. Yd.)
(1)	Culvert Extension and Culvert Return Walls (See Notes 4(B) & 4(C))	SBD (See Standard Specifications & Special Provisions Section 601)	750
(2)	Concrete Railing (See Notes 4(B) & 4(C))	Lightweight Concrete (See Standard Specifications & Special Provisions Section 601)	799
1 (3)	Drilled Shaft for Type II Traffic Signal Standard (including Pedestal)	4500 psi	670
(4)	Retaining Wall (See Notes 4(B) & 4(C))	5000 psi	625
(5)	Drainline Connection at Existing Culvert (See Notes 4(B) & 4(C))	5000 psi	625
(6)	Except as noted otherwise, all others	4000 psi	625

All concrete with a 28 day compressive strength of 4,000 psi or greater shall have a maximum W/C Ratio of 0.45.

4. Materials (Cont.):

- (B) A shrinkage reducing admixture (SRA), Tetraguard AS20 by BASF or Eclipse by W.R. Grace & Co., or approved equal, shall be added to the concrete mix for Items (1), (2), (5) and (6). The minimum dosage requirement shall be 128 ounces per cubic yard of concrete.
- (C) A migrating corrosion inhibitor amine carboxylate water-based admixture shall be added to the concrete mix for Items (1), (2), (5) and (6). The minimum dosage shall be 24 ounces per cubic yard of concrete. The admixture shall not affect the set time of the concrete.
- (D) All reinforcing steel shall be ASTM A615 Grade 60 deformed bars unless otherwise noted.
- (E) Reinforcing steel shall be ASTM A934 where epoxy-coated reinforcing bars are specified.
- (F) Glass Fiber Reinforced Polymer Bar
- (1) Glass Fiber Reinforced Polymer (GFRP) rebar shall have a minimum tensile strength of 110 ksi for #4 bar and smaller. All others shall have a minimum tensile strength of 95 ksi.
- (2) The modulus of elasticity of the GFRP bar shall be a minimum of 5,900,000 psi.
- (3) Minimum concrete cover for the GFRP bars shall be 1" unless otherwise noted.
- (4) Minimum lap splice lengths for the GFRP bars shall be 42 bar diameters unless otherwise noted.
- (5) All GFRP bars shall be securely tied in place. Tie wire shall be either Alloy 302 or 304 Stainless Steel or non-metallic.
- (6) The GFRP bars may be cut in the field with a masonry or diamond blade.
- (7) All work including materials and bends shall follow manufacturer's recommendations.
- (G) Expanded Polystyrene (EPS) : EPS 15 ASTM D 6817 (Type 1 per ASTM C578).
- (H) Non-shrink grout shall be Portland Cement base, prepackaged, non-metallic, non-gaseous ready to use grout mix and shall be applied as recommended by the manufacturer. Non-shrink grout shall have a minimum 28-day compressive strength of 8,900 psi. A migrating corrosion inhibitor amine carboxylate water-based admixture shall be added to the non-shrink grout. The minimum dosage shall be 10 grams per 0.4 to 0.5 cubic feet of non-shrink grout.

5. Reinforcement:


- (A) The minimum covering measured from the surface of the concrete to the face of any reinforcing bars shall be 3" except for GFRP bars, the minimum cover shall be 1" unless otherwise noted.
- (B) Reinforcing bars shall be detailed in accordance with the latest edition of the design specification in Note 2 unless otherwise noted.
- (C) Minimum clear spacing between parallel bars shall be 1 1/2 times the diameter of bars (for non bundled bars). In no case shall the clear distance between the bars be less than 1 1/2 times the maximum size of the coarse aggregate or 1 1/2".

5. Reinforcement (Cont.):

- (D) All dimensions relating to reinforcing bars are to centers of bars unless otherwise noted.
- (E) Reinforcing bars shall be securely tied at all intersections and lap splices except where the spacing of intersections is less than one foot in each direction, in which case alternate intersections shall be tied.

6. Construction Notes:

- (A) See Standard Specifications and Special Provisions.
- (B) Except as otherwise noted, all vertical dimensions are measured plumb.
- (C) The Contractor shall verify all site conditions and not rely upon these plans since conditions may differ from those shown.
- (D) The Contractor shall be solely responsible for the protection of adjacent properties, utilities and existing and new structures from damage due to construction. Repairing any damage shall be at the Contractor's own expense, to the satisfaction of the Engineer.
- (E) The Contractor shall verify the location of all utility lines and notify the respective owners before commencing with excavation, and any temporary piling or sheeting.
- (F) The Contractor shall verify all dimensions and site conditions and shall report any discrepancies in writing to the Engineer before commencing work or ordering materials.
- (G) For concrete finish see Standard Specifications and Special Provisions.
- (H) Construction joints may be relocated or additional ones added subject to the approval of the Engineer.
- (J) Unless otherwise noted, all exposed concrete edges shall be chamfered 3/4"x3/4".
- (K) Contractor shall verify elevations before fabricating wall reinforcing.
- (L) Immediately prior to pouring concrete onto construction joints, the joints shall be coated with Duralprep A.C., which is a water based epoxy modified portland cement bonding agent and anti-corrosion coating, or approved equal. The coating shall be applied in accordance with the manufacturer's recommendations.

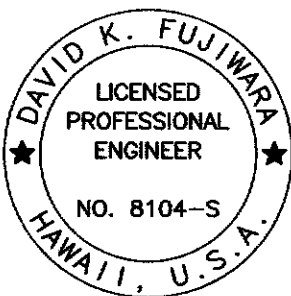

THIS WORK WAS PREPARED BY ME OR UNDER MY SUPERVISION.
David K. Fujiwara
KSF, INC. APRIL 30, 2014
LIC. EXP. DATE

DESIGNED BY	DATE
TRACED BY	
NOTED BY	
QUANTITIES BY	
CHECKED BY	

DRAWING NAME: 2. \00. ONGONG\12-025-FARRINGTON HWY NANAKULI TO HALEAKALA-ULEHAWA\CAD\11-08-13 ADD\PHU-5002 ADD\DWG PLOT TIME: 11-04-13, 4:55 PM

11/08/13	1 Add. 1 - Modified 4.(A) Materials
DATE	REVISION

STATE OF HAWAII DEPARTMENT OF TRANSPORTATION HIGHWAYS DIVISION	
STRUCTURAL GENERAL NOTES	
FARRINGTON HIGHWAY INTERSECTION IMPROVEMENTS	
AT NANAKULI AVENUE AND HALEAKALA AVENUE	
Federal-Aid Project No. STP-093-1(22)	
Scale: None	Date: April 2013
SHEET No. 502 OF 6 SHEETS	

STRUCTURAL GENERAL NOTES

FED. ROAD DIST. NO.	STATE	FED. AID PROJ. NO.	FISCAL YEAR	SHEET NO.	TOTAL SHEETS
HAWAII	HAW.	STP-093-1(22)	2013	171	230

6. Construction Notes (Cont.):

- (L) Falsework for the box culvert extension shall be supported by the existing box culvert or U-channel. However, all parts of this falsework shall be above elevation 8.0.
- (M) During construction, netting, filter cloth, or similar materials shall be suspended below the work area to capture any falling debris, including liquids, and prevent contamination of the stream area below.
- (N) No falsework hardware shall be left in the existing concrete. Holes and defects in the existing concrete created by the removal of falsework hardware shall be repaired with a bonding agent having a corrosion inhibitor. The patching concrete material shall also contain a corrosion inhibitor and shall be a non-shrink concrete or grout.
- (O) All repair work shall be in accordance with the manufacturer's recommendations.
- (P) For removal of concrete structures, refer to Special Provisions Section 202.

7. Foundation:


For boring logs and other geotechnical information by Geolabs, see geotechnical engineering exploration report entitled, "Geotechnical Engineering Exploration Farrington Highway Intersection Improvements Nanakuli and Haleakala Intersections Nanakuli, Oahu, Hawaii" dated August 10, 2010.

Footings are embedded min. 2'-0" below finish grade.

- (A) Allowable bearing value = 3,000 psf for service limit state
= 5,500 psf for strength limit state
= 9,000 psf for extreme event limit state
- (B) Coefficient of friction = 0.36 for strength limit state
= 0.46 extreme event limit state
- (C) Passive earth pressure = 180 pcf for strength limit state
= 360 pcf for extreme event limit state
- (D) Active earth pressure = 40 pcf for Level Backfill
- (E) Internal friction angle = 30 degrees
- (F) Dynamic Lateral Earth Pressure = $6.9 H^2$ plf

ORIGINAL PLAN	SURVEY PLOTTED BY	DATE
NOTE BOOK	DRAWN BY	"
No.	DESIGNED BY	"
	QUANTITIES BY	"
	CHECKED BY	"

DRAWING NAME: Z:\00 ONCONG\12-026-FARRINGTON HWY NAKAKULI TO HALEAKALA-ULEHAWA\CAD\07-17-13 FINAL 100% FHU-S002.DWG PLOT TIME: 07-16-13, 4:08 PM

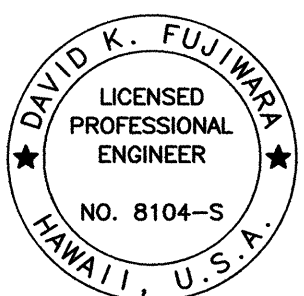

THIS WORK WAS PREPARED BY ME
OR UNDER MY SUPERVISION.

David K. Fujiwara
KSF, INC. APRIL 30, 2014
LIC. EXP. DATE

STATE OF HAWAII DEPARTMENT OF TRANSPORTATION HIGHWAYS DIVISION	
<u>STRUCTURAL GENERAL NOTES</u>	
FARRINGTON HIGHWAY INTERSECTION IMPROVEMENTS AT NAKAKULI AVENUE AND HALEAKALA AVENUE Federal-Aid Project No. STP-093-1(22)	
Scale: None	Date: April 2013
SHEET No. 503 OF 6 SHEETS	

SYMBOLS AND ABBREVIATIONS

FED. ROAD DIST. NO.	STATE	FED. AID PROJ. NO.	FISCAL YEAR	SHEET NO.	TOTAL SHEETS
HAWAII	HAW.	STP-093-1(22)	2013	172	230

¢ And
@ At
B Baseline
C Centerline
ø Diameter
≥ Greater Than or Equal to
≤ Less Than or Equal to
Number
± Plus or Minus

AB Anchor Bolt
Abut. Abutment
AC Asphaltic Concrete
Add. Additional, Added
Alt. Alternate
Approx. Approximate
Az. Azimuth

B, Bot., Bott. Bottom
Bal. Balance
Bet. Between
BF Both Faces, Back Face
BFE Bottom of Footing Elevation
Bk. Back
Blt. Bolt
Bm. Beam
BOF Bottom of Footing
Br. Bridge
Brg., Brgs. Bearing, Bearings
BVC Beginning of Vertical Curve
BW Both Ways

Cant. Cantilever
CBW Concrete Barrier Wall
cc Center to Center
CF Cubic Feet
CFCW Continuous Flashing Compound

CG Center of Gravity
cgs Center to Gravity of Strands
CIP Cast-in-Place
CJ Control Joint
Cl. Class
Clr. Clearance
CLSM Controlled Low Strength

CO Clean Out
Col. Column
Conc. Concrete
Conn. Connection
Const. Construction
Const. Jt. Construction Joint
Cont. Continuous
CSL Cross Hole Sonic Loggin
CY, Cu. Yd. Cubic Yard

Dbl. Double
Det. Detail
DI Drain Inlet, Ductile Iron
Dia. Diameter
Diaph. Diaphragm
Dim. Dimension
Dist. Distance
Dn. Down
DO Ditto
DS Drilled Shaft
Dwg., Dwgs. Drawing, Drawings
Dwls. Dowels

E East
(E), Exp. Expansion
EA, Ea., ea. Each
EF Each Face
EFH Each Face Horizontal
EFV Each Face Vertical
EJ Expansion Joint
El., Elev. Elevation
Elec. Electrical
EMH Electrical Manhole
Emb. Embankment
Embed. Embedded, Embedment
EP Edge of Pavement
EPS Expanded Polystyrene
Eq. Equal
Est. Estimated
EVC End of Vertical Curve
EW Each Way
Ex., Exist. Existing
Exc. Excavation
Excl. Excluding
Ext. Exterior

(F) Fixed
FA Force Account
FB Flat Bar
F'c Specified Strength of Concrete
F'ci Strength of Concrete at Time of Initial Prestress
FF Far Face, Front Face
Fig. Figure
Fin. Gr. Finish Grade
FRP Fiber Reinforced Plastic
Ft. Feet, Foot
Ftg. Footing

Ga. Gage, Gauge
Galv. Galvanized
GFRP Glass Fiber Reinforced Polymer
Gr. Grade
Grd. Ground
GRP Grouted Rubble Pavement

(H) Hinge
HECO Hawaiian Electric Company
Horiz., H Horizontal
HS High strength
Ht. Height

IB Inbound
ID Inside Diameter
I.F. Inside Face
In. Inch
Int. Interior
Inv. Invert

Jt. Joint

K Kips
KF Kip Foot
KLF Kips Per Linear Foot
KSF Kips Per Square Foot
KSI Kips Per Square Inch

L Length
lb., lbs., LBS. Pound, Pounds
LF, Lin. Ft. Linear Feet/Foot
Longit. Longitudinal
LS Lump Sum
Ltg. Std. Lighting Standard

M Modified
Max. Maximum
Mech. Mechanical
MH Manhole
Min. Minimum
Misc. Miscellaneous
MPH Miles Per Hour

N North
NF Near Face
NIC Not in Contract
No. Number
NTS Not to Scale

OB Outbound
oc On Center
OD Outside Diameter
O.F. Outside Face
OG Outside Girder, Outbound
Girder
Opn'g Opening
O/S Offset

PB Pull Box
P(e) Effective Prestressing Force
PC Point of Curvature
PCC Portland Cement Concrete
PCF Pounds per Cubic Foot

Perf. Perforated
PI Point of Intersection of Tangents
PIVC Point of Intersection of Vertical Curve

PL Plate
PLF Pounds per Linear Foot
PP Precast Plank
PRC Point of Reverse Curvature
Prestr. Prestressed
P/S Prestressed Strands
PSF Pounds per Square Foot
PSI Pounds per Square Inch
Pt., Pts. Point, Points
PT Point of Tangency, Post Tensioned
PVC Polyvinyl Chloride

Q Flow Rate

R, Rad. Radius
Rdwy. Roadway
Rebar Reinforcing Bar
Ref. Reference
Reinf. Reinforced, Reinforcing, Reinforcement

Req'd. Required
Ret. Retaining
RF Rear Face
R/W, ROW Right of Way

S South
SDMH Sewer Drain Manhole
SE Super Elevation
Sect. Section
SF Square Feet
Sht. Sheet
Sim. Similar
Sl. Slope
Spc., Spg. Spaces, Spacing
Spec. Specification
Sprd. Spread
SS Stainless Steel
Sta. Station
Stagg. Staggered
Std. Standard
Stiff. Stiffener
Stirr. Stirrup
Stl. Steel
Str. Straight
Struct. Structure
SY Square Yard
Symm. Symmetrical

T Top
Tan. Tangent
T&B Top and Bottom
Temp. Temporary
Thk. Thick
TFE Top of Footing Elevation
TOD Top of Deck
TOF Top of Footing
Tot. Total
TOW Top of Wall Elevation
Transv. Transverse
TS Structural Tubing
Typ. Typical

Undergrd. Underground
UNO Unless Noted Otherwise


V, Vert. Vertical
Var. Varies
VC Vertical Curve

W West
w/ With
W/C Water/Cement Ratio
WP Work Point, Working Point
WS Water Surface
WW Wing Wall
WWR Welded Wire Reinforcing

Yr. Year

DATE	_____
SYMBOLS	_____
PLAN	_____
NOTE	_____
BOOK	_____
DESIGNED BY	_____
QUANTITIES BY	_____
CHECKED BY	_____
No.	_____

DRAWING NAME: Z:\00 ONCONG\12-026-FARRINGTON HWY NAKAKULI TO HALEAKALA-UEHAWA\CAD\07-17-13 FINAL 100% FHU-S004.DWG PLOT TIME: 07-16-13, 4:09 PM

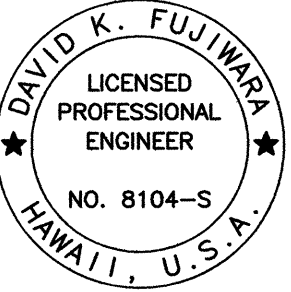

THIS WORK WAS PREPARED BY ME OR UNDER MY SUPERVISION.
David K. Fujiwara
KSF, INC. APRIL 30, 2014
LIC. EXP. DATE


STATE OF HAWAII
DEPARTMENT OF TRANSPORTATION
HIGHWAYS DIVISION

SYMBOLS AND ABBREVIATIONS

FARRINGTON HIGHWAY INTERSECTION IMPROVEMENTS
AT NAKAKULI AVENUE AND HALEAKALA AVENUE
Federal-Aid Project No. STP-093-1(22)
Scale: None Date: April 2013



SHEET No. S04 OF 6 SHEETS

FED. ROAD DIST. NO.	STATE	FED. AID PROJ. NO.	FISCAL YEAR	SHEET NO.	TOTAL SHEETS
HAWAII	HAW.	STP-093-1(22)	2013	173	230

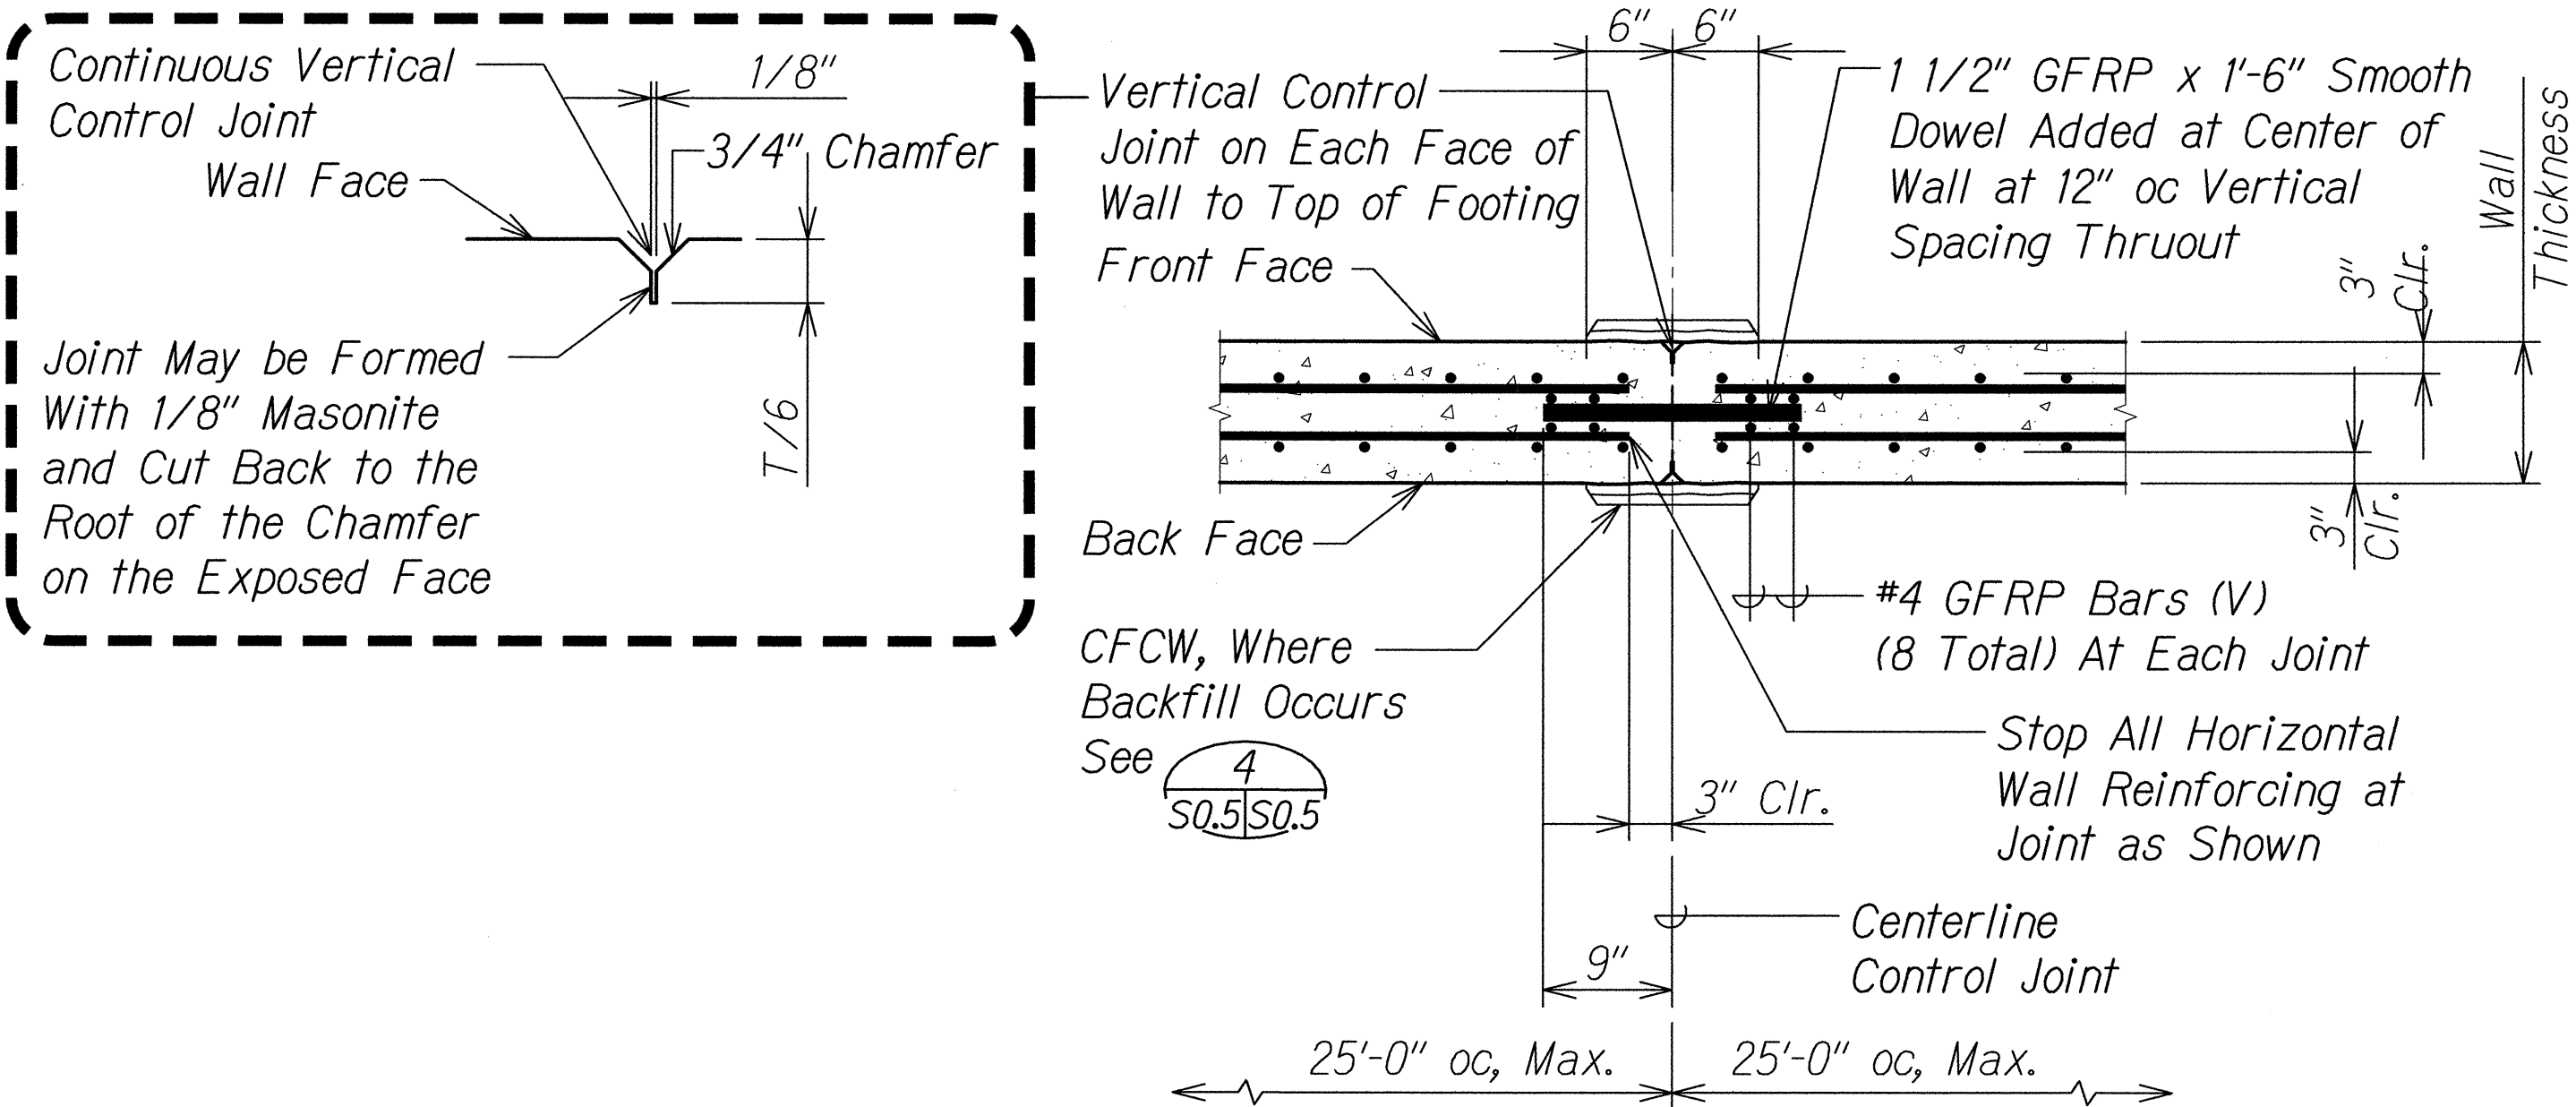


TYPICAL WALL VERTICAL CONTROL OR CONSTRUCTION JOINT AT CONTROL JOINT LOCATION DETAIL 1
 Not to Scale S0.5 | S0.5
S1.9


TYPICAL WALL VERTICAL CONSTRUCTION JOINT DETAIL 2
 Not to Scale S0.5 | S0.5

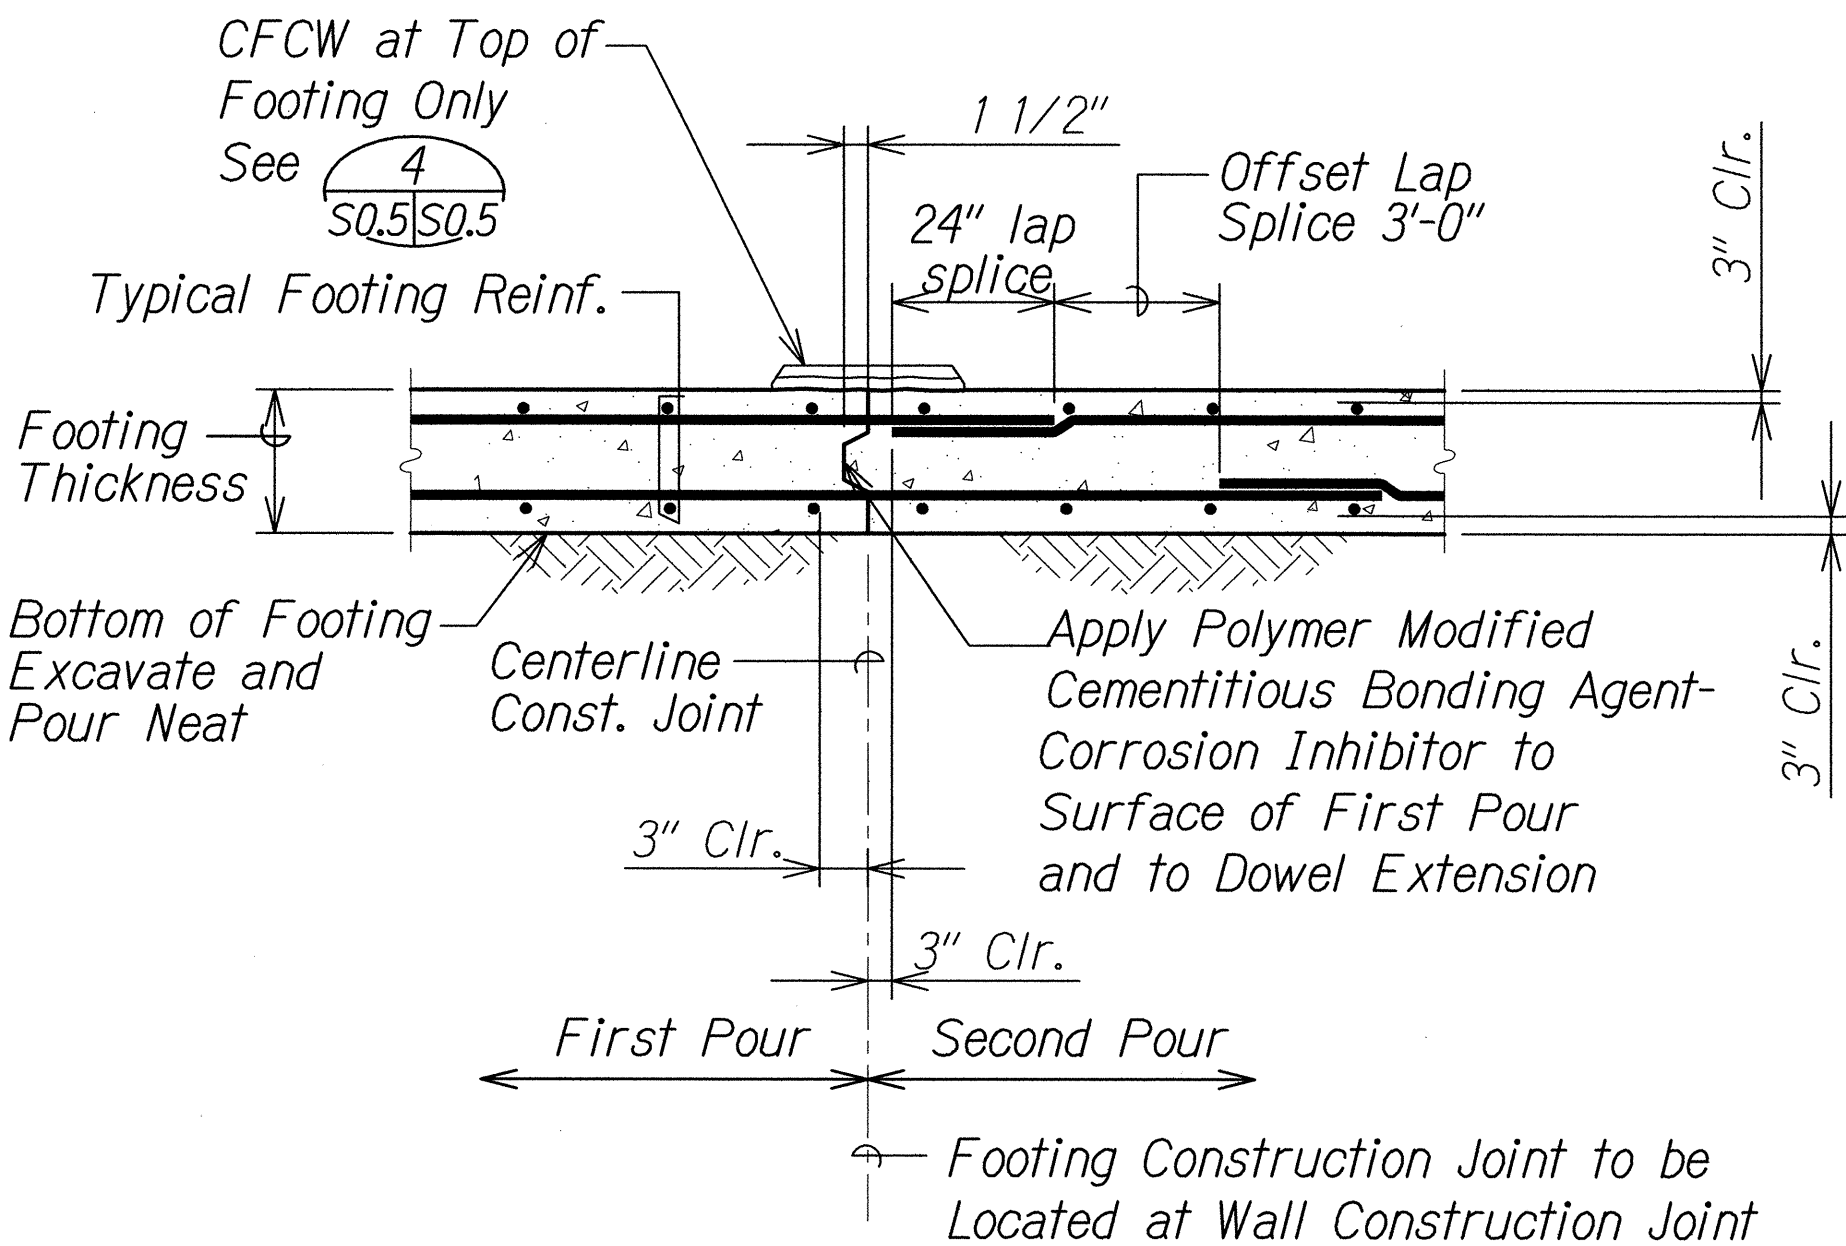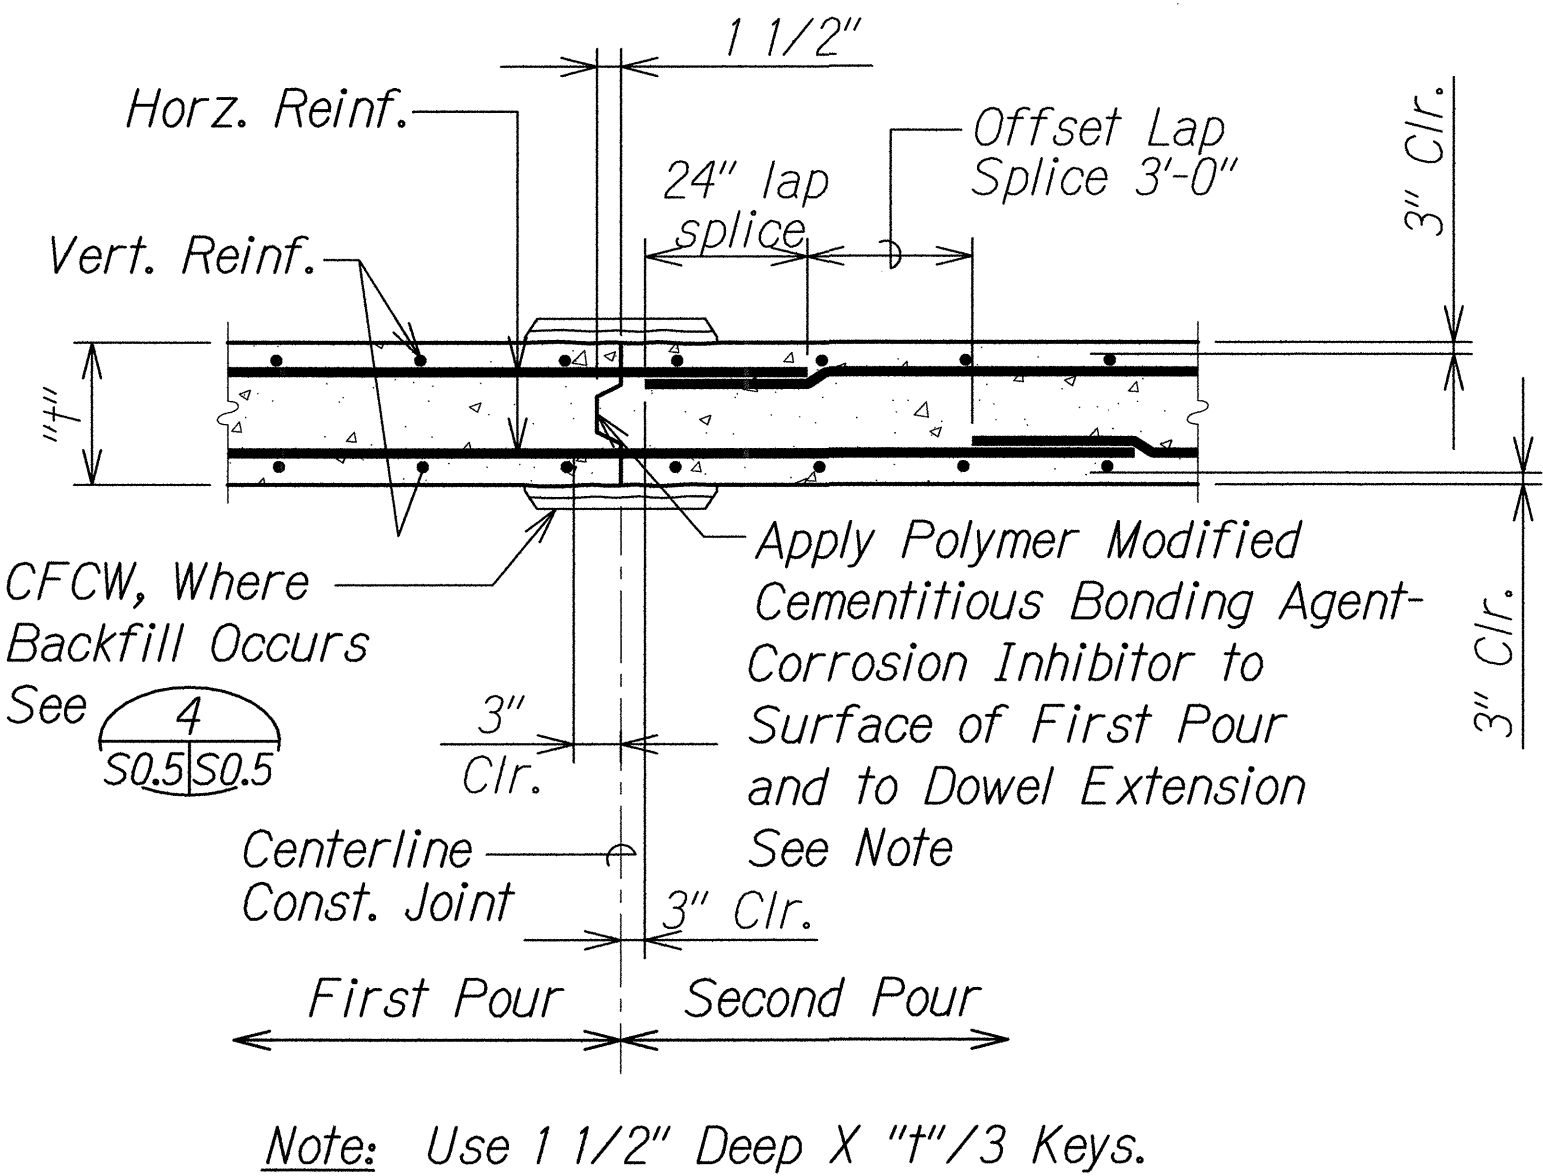

TYPICAL FOOTING CONSTRUCTION JOINT DETAIL 3
 Not to Scale S0.5 | S0.5

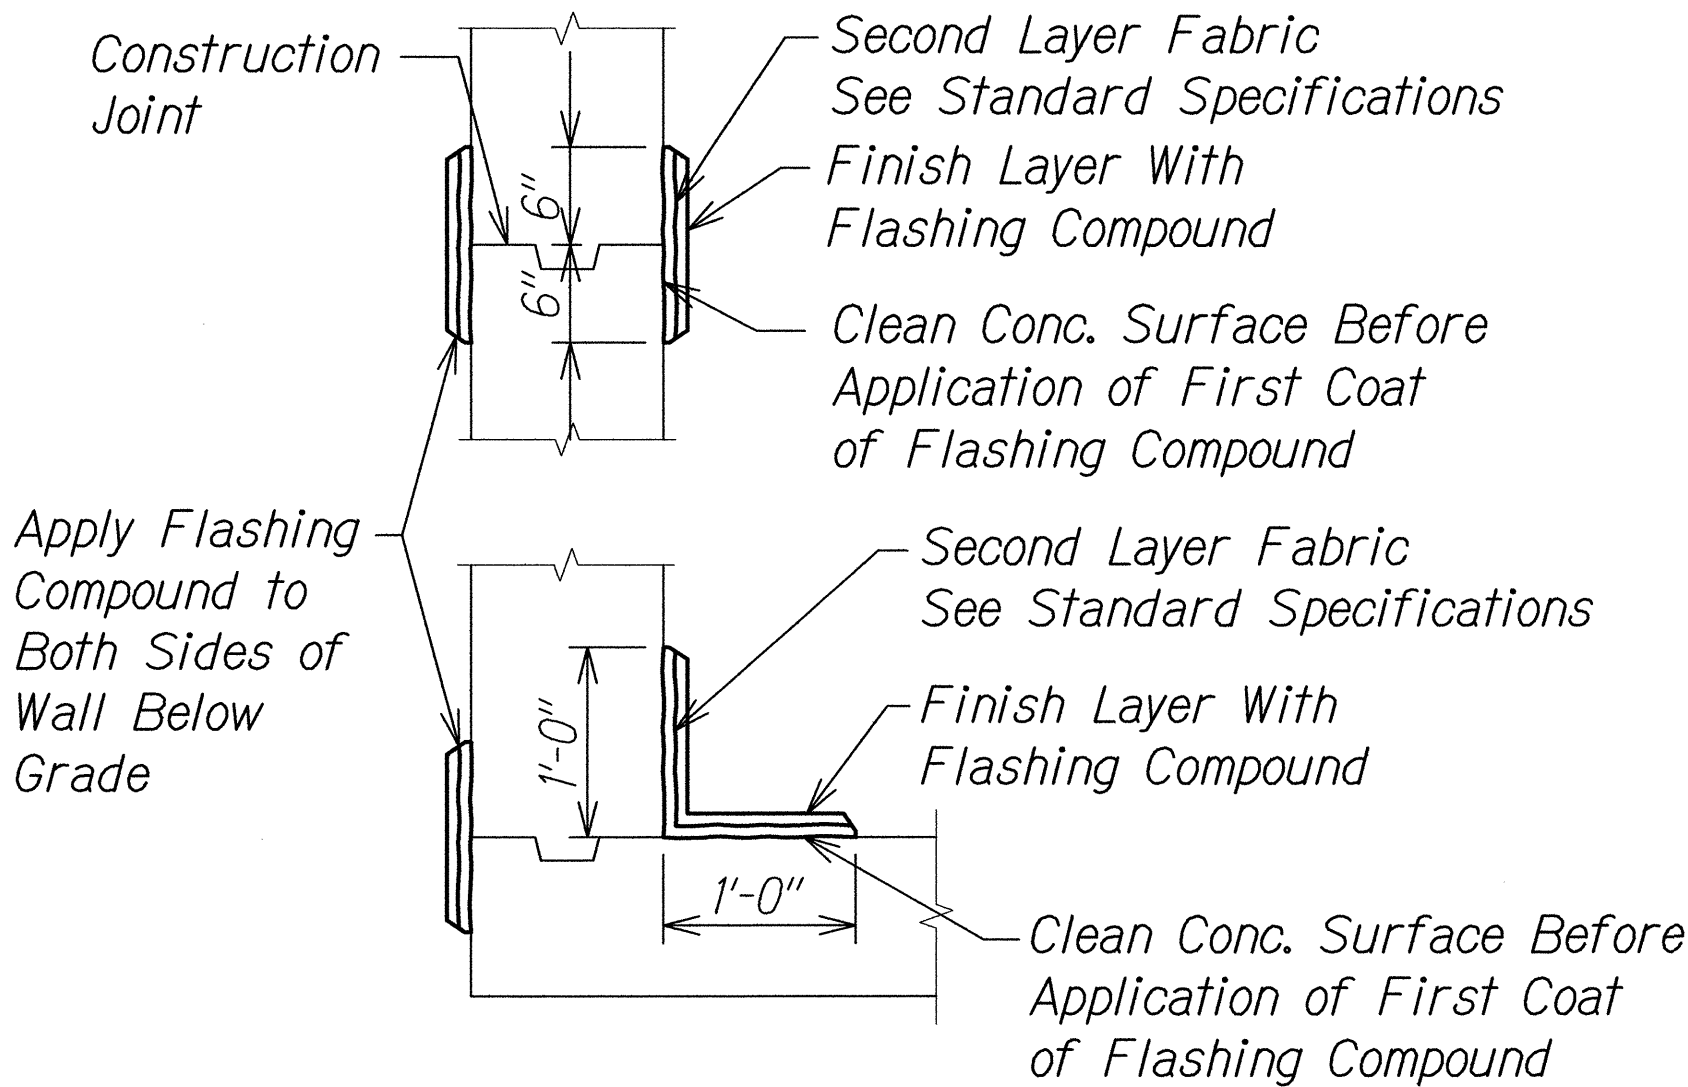


TYP. CONTINUOUS FLASHING COMPOUND WATERPROOFING (CFCW) DETAILS 4
 Not to Scale S0.5 | S0.5
S0.6

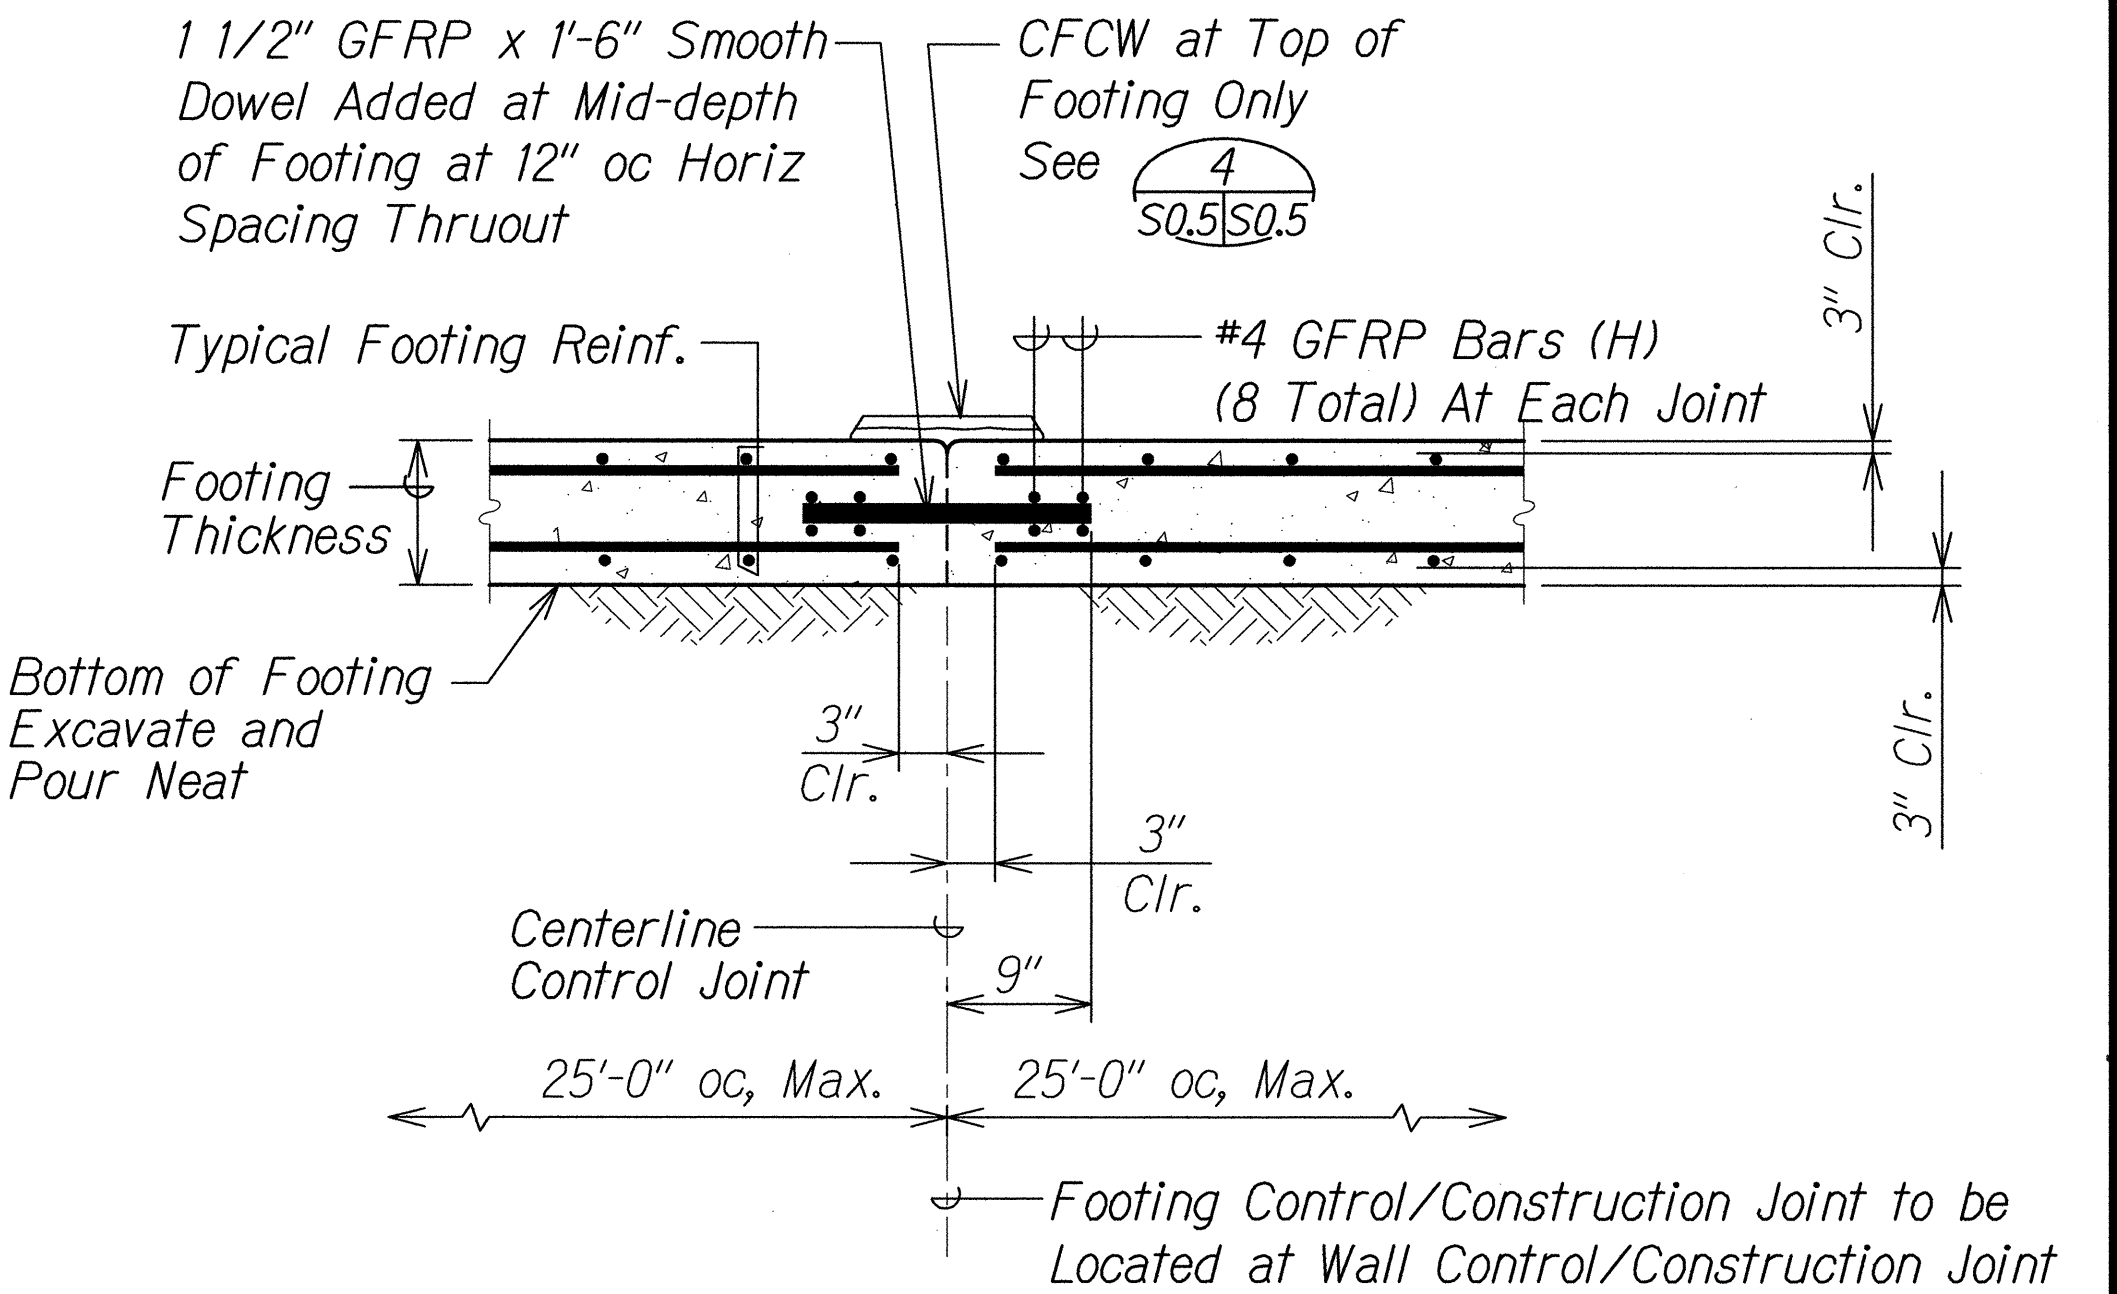

TYP. FOOTING CONTROL OR CONSTRUCTION JOINT AT CONTROL JOINT LOCATION DETAIL 5
 Not to Scale S0.5 | S0.5

ORIGINAL PLAN	DATE
SURVEY PLOTTED BY	DESIGNED BY
TRACED BY	CHECKED BY
NOTE BOOK	QUANTITIES BY
No. 10/10/10	

DRAWING NAME: Z:\00 ONGOING\12-026-FARRINGTON HWY NAKULI TO HALEAKALA-LEHAWA\CAD\07-17-13 FINAL 100% FHU-S0.5.DWG PLOT TIME: 07-18-13, 4:09 PM

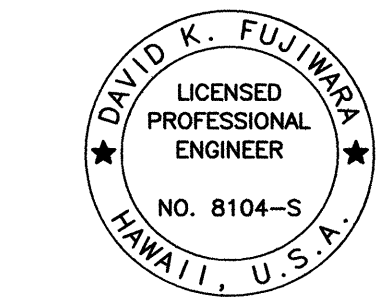

THIS WORK WAS PREPARED BY ME
 OR UNDER MY SUPERVISION.
 David K. Fujiwara
 KSF, INC. APRIL 30, 2014
 LIC. EXP. DATE


STATE OF HAWAII
DEPARTMENT OF TRANSPORTATION
HIGHWAYS DIVISION

TYPICAL DETAILS

FARRINGTON HIGHWAY INTERSECTION IMPROVEMENTS
AT NAKULI AVENUE AND HALEAKALA AVENUE
Federal-Aid Project No. STP-093-1(22)
Scale: As Shown Date: April 2013
SHEET No. S0.5 OF 6 SHEETS


173

FED. ROAD DIST. NO.	STATE	FED. AID PROJ. NO.	FISCAL YEAR	SHEET NO.	TOTAL SHEETS
HAWAII	HAW.	STP-093-1(22)	2013	174	230

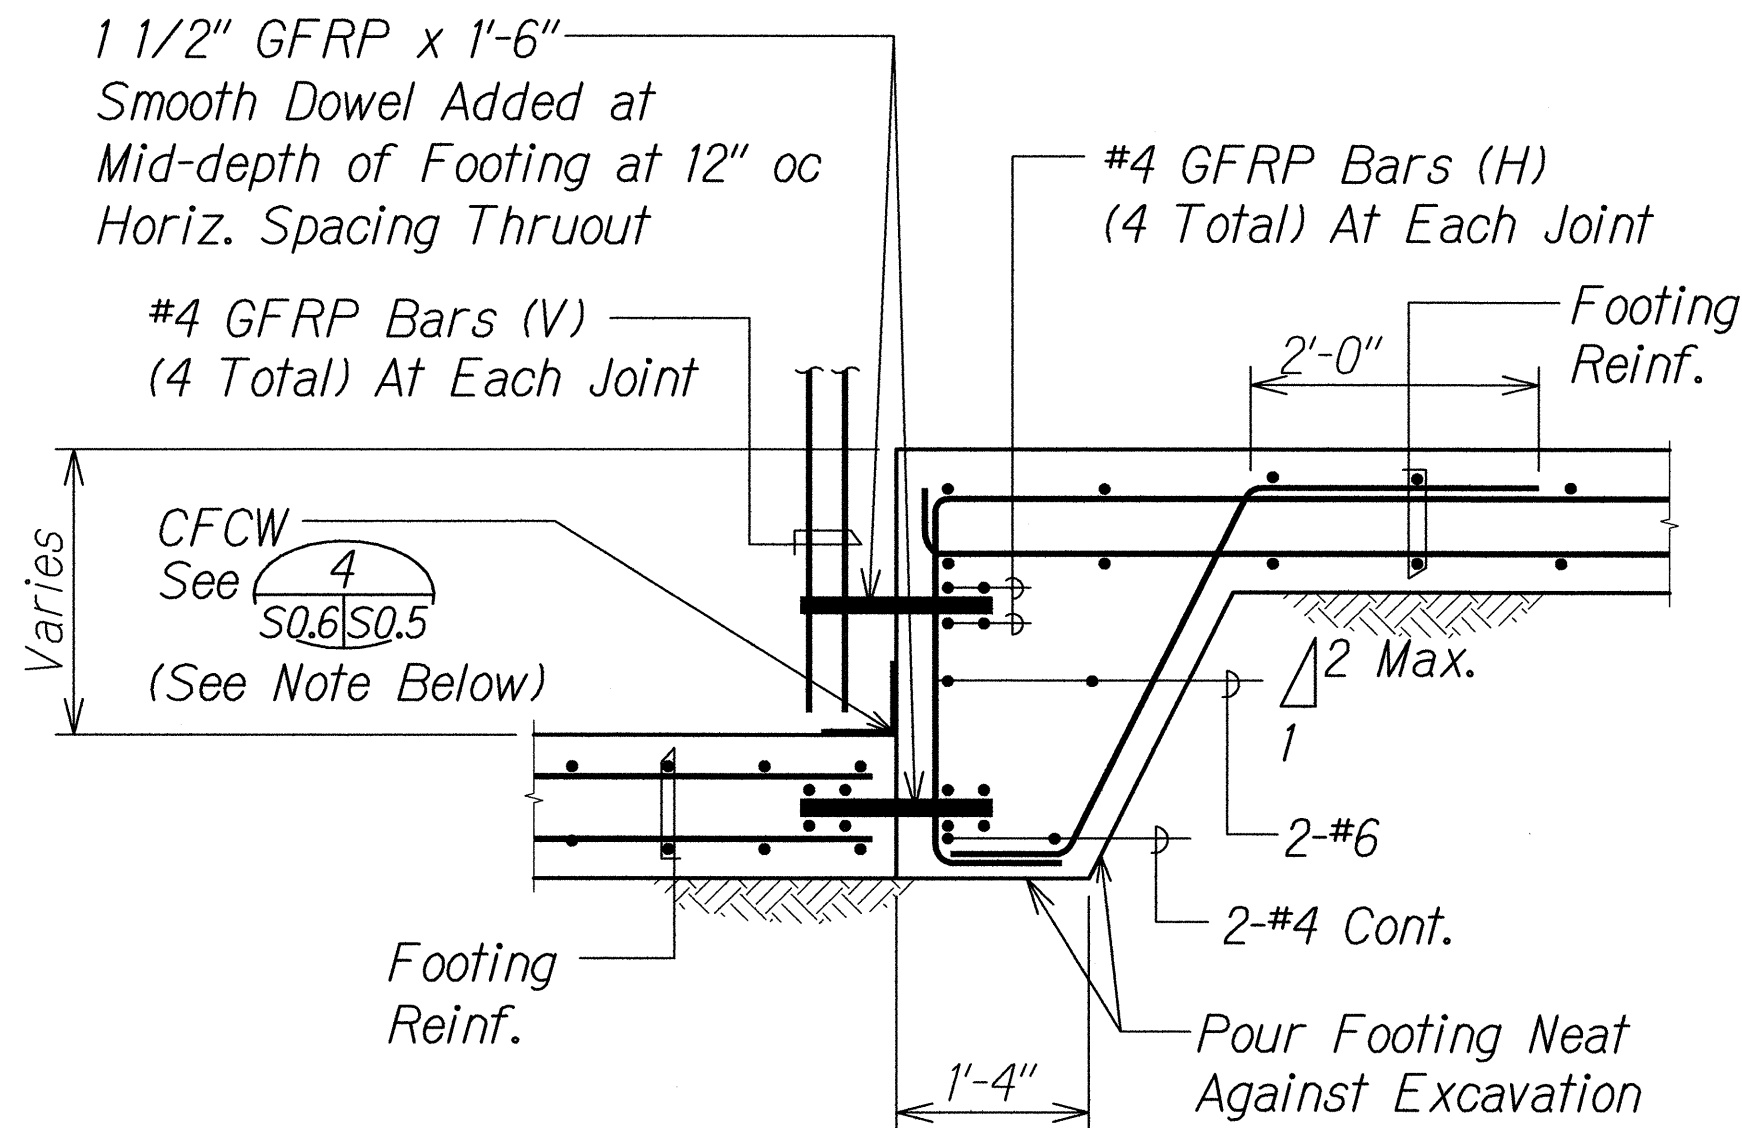


Note:
CFCW Shall not be placed on the footing and the footing step where they connect to the vertical stem of retaining wall.

TYPICAL
FOOTING STEP DETAIL
Scale: 3/4" = 1'-0"
SI.4, SI.6, SI.10

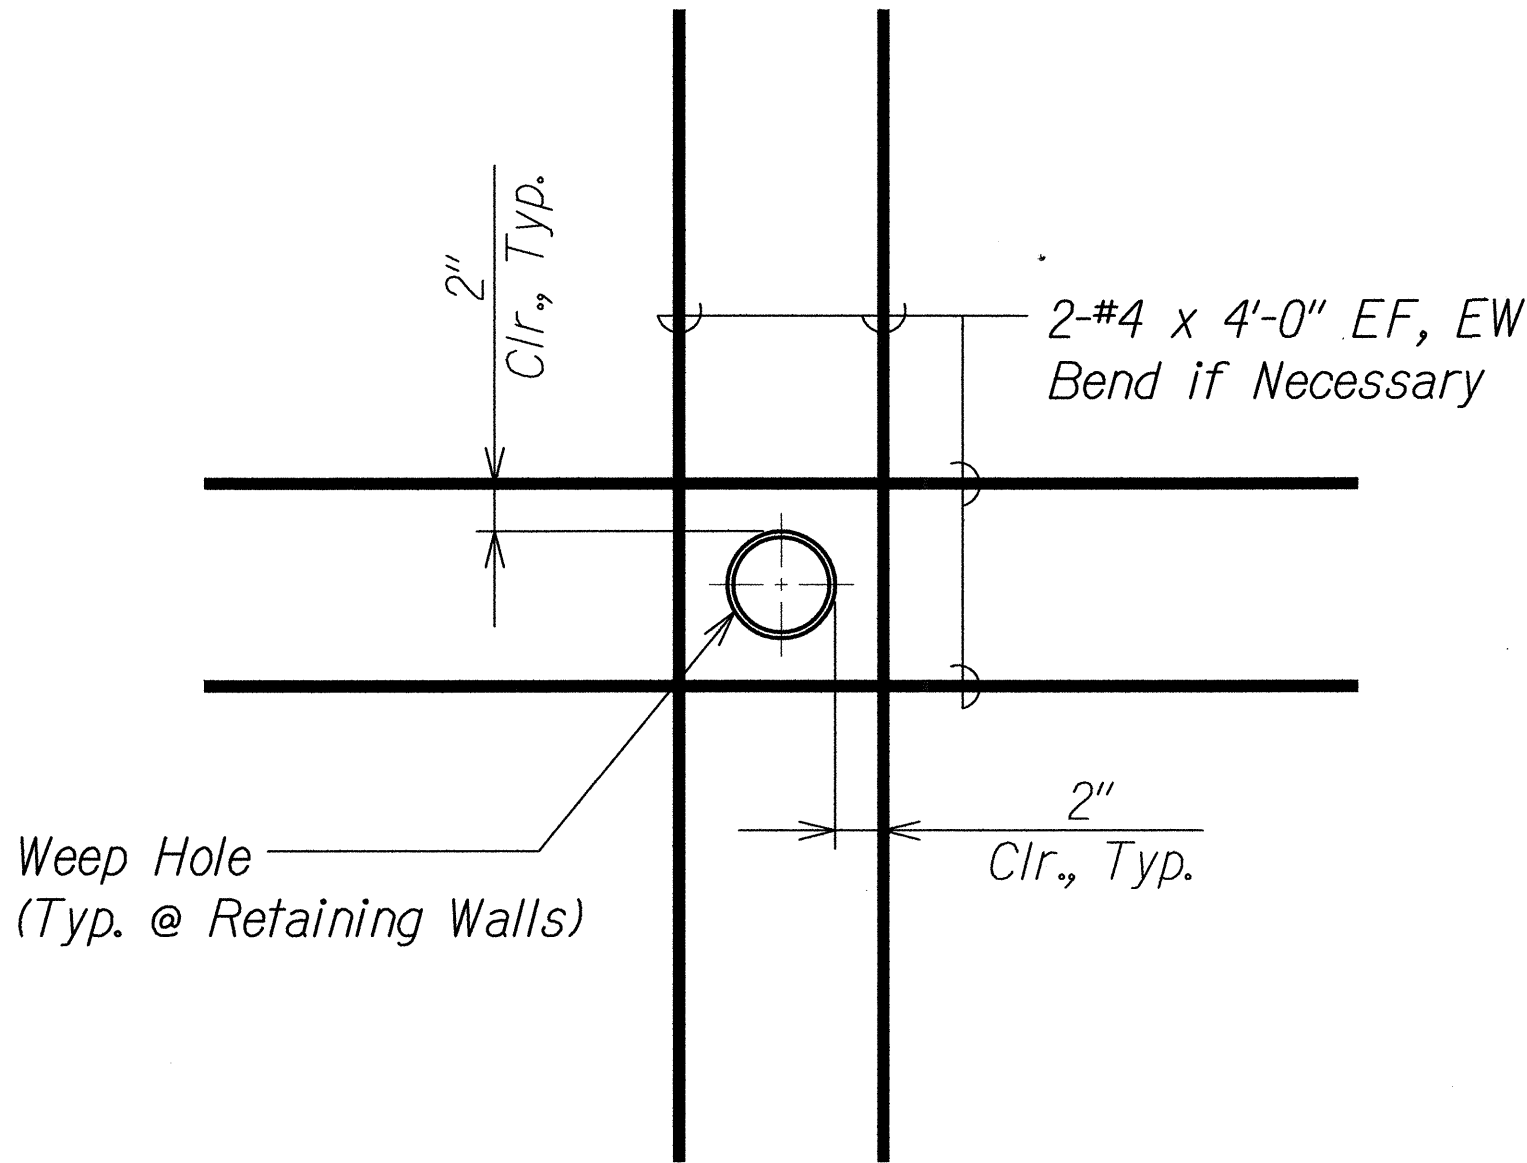

ADDED REINFORCING AT
WEEP HOLES
Scale: 1 1/2" = 1'-0"
SI.1 to SI.6

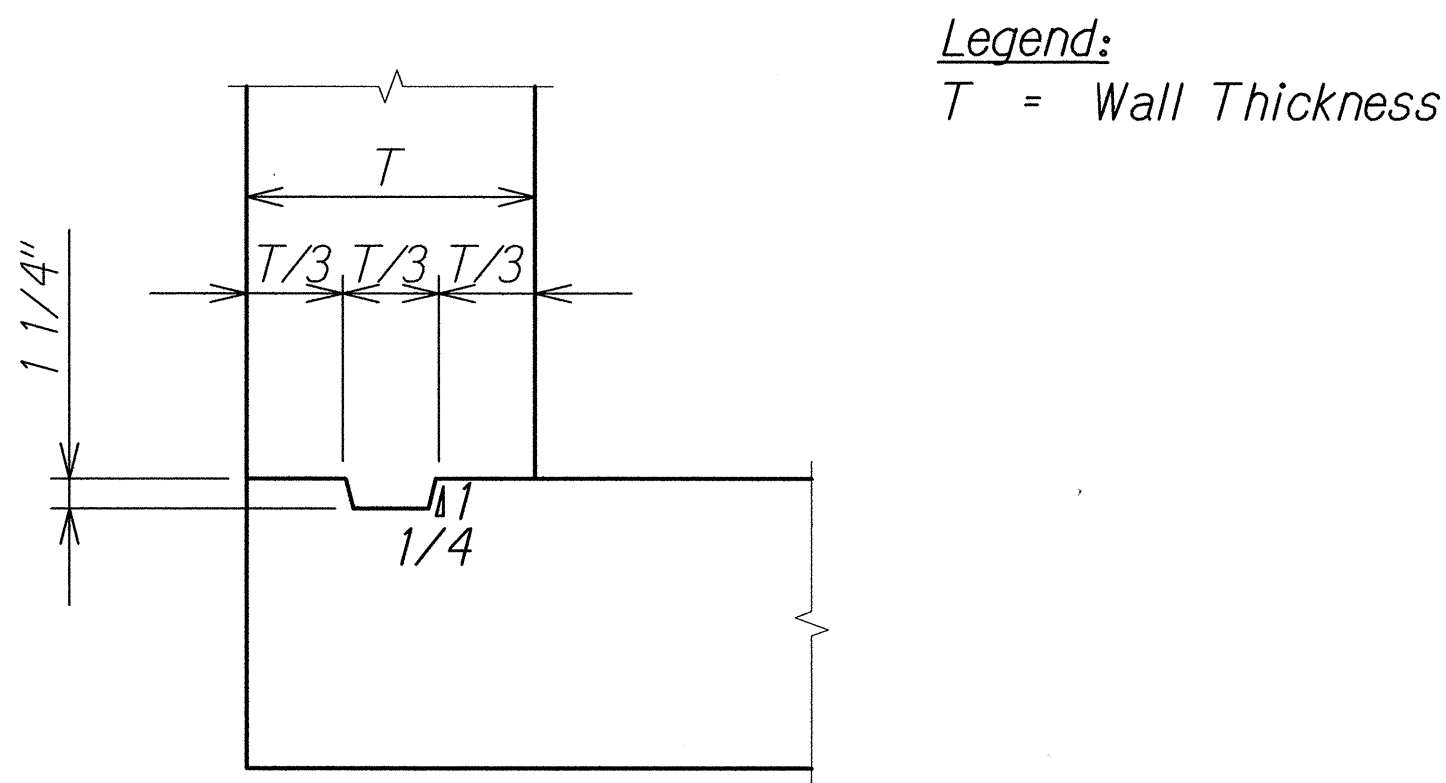


Legend:
T = Wall Thickness

TYPICAL KEY DIMENSIONS
AT BOTTOM OF WALL
Scale: 1 1/2" = 1'-0"
SI.4

ORIGINAL PLAN	SURVEY PLOTTED BY	DATE
NOTE BOOK	DRAWN BY	
DESIGNED BY	TRACED BY	
QUANTITIES BY	CHECKED BY	
No.		

DRAWING NAME: Z:\00 ONGOING\12-026-FARRINGTON HWY NANAKULI TO HALEAKALA-UEHAWA\CAD\07-17-13 FINAL 100%\FHU-S006.DWG PLOT TIME: 07-16-13, 4:10 PM

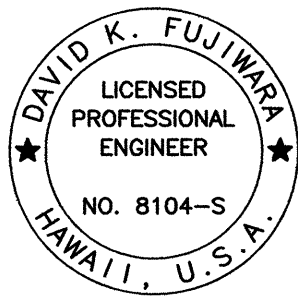

THIS WORK WAS PREPARED BY ME
OR UNDER MY SUPERVISION.
David K. Fujiwara
KSF, INC. APRIL 30, 2014
LIC. EXP. DATE


STATE OF HAWAII
DEPARTMENT OF TRANSPORTATION
HIGHWAYS DIVISION

TYPICAL DETAILS

FARRINGTON HIGHWAY INTERSECTION IMPROVEMENTS
AT NANAKULI AVENUE AND HALEAKALA AVENUE
Federal-Aid Project No. STP-093-1(22)
Scale: As Shown Date: April 2013

SHEET No. S06 OF 6 SHEETS


FED. ROAD DIST. NO.	STATE	FED. AID PROJ. NO.	FISCAL YEAR	SHEET NO.	TOTAL SHEETS
HAWAII	HAW.	STP-093-1(22)	2013	175	230

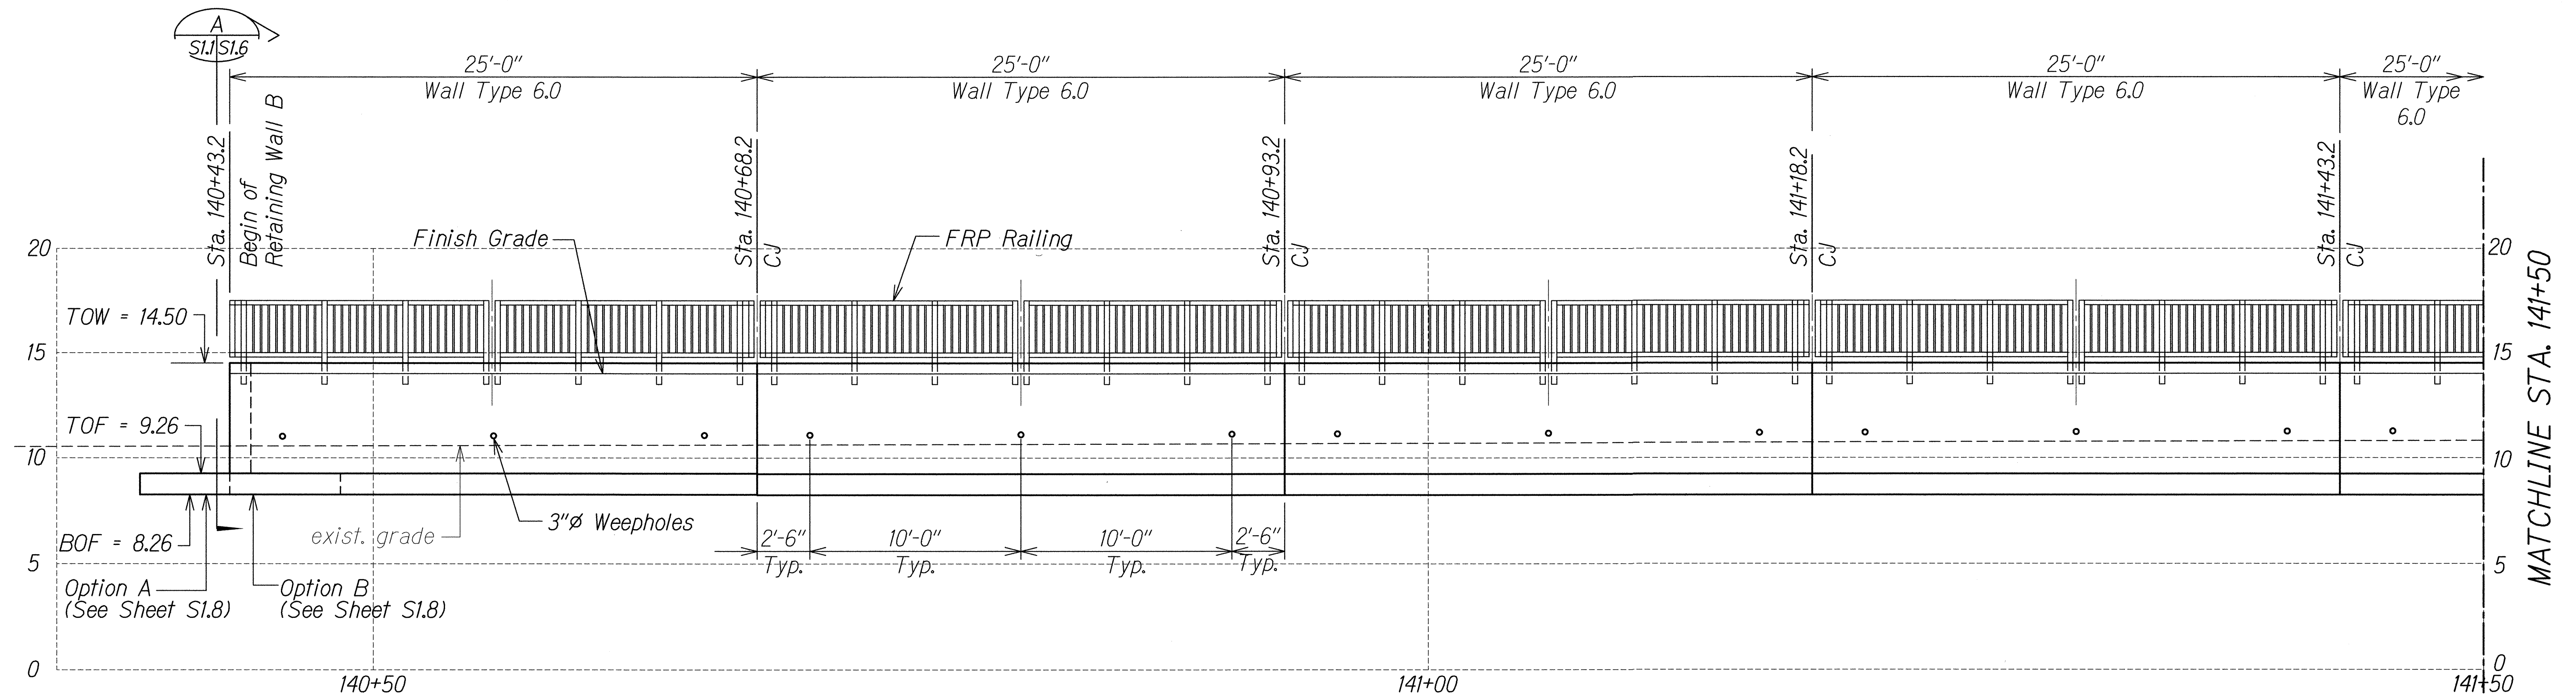


ELEVATION - STA. 140+43.2 TO 141+50
Scale: 1/4" = 1'-0"

- LEGEND:
- CJ Control Joint in Wall and Footing
 - TOF Top of Footing Elevation
 - BOF Bottom of Footing Elevation
 - TOW Top of Wall Elevation

- NOTES:
- For finish grade elevation road side of wall, see Civil drawings.
 - See 2/S0.6 for added reinforcing at weep holes.
 - For FRP Railing, see Sheets S5.1 and S5.3.

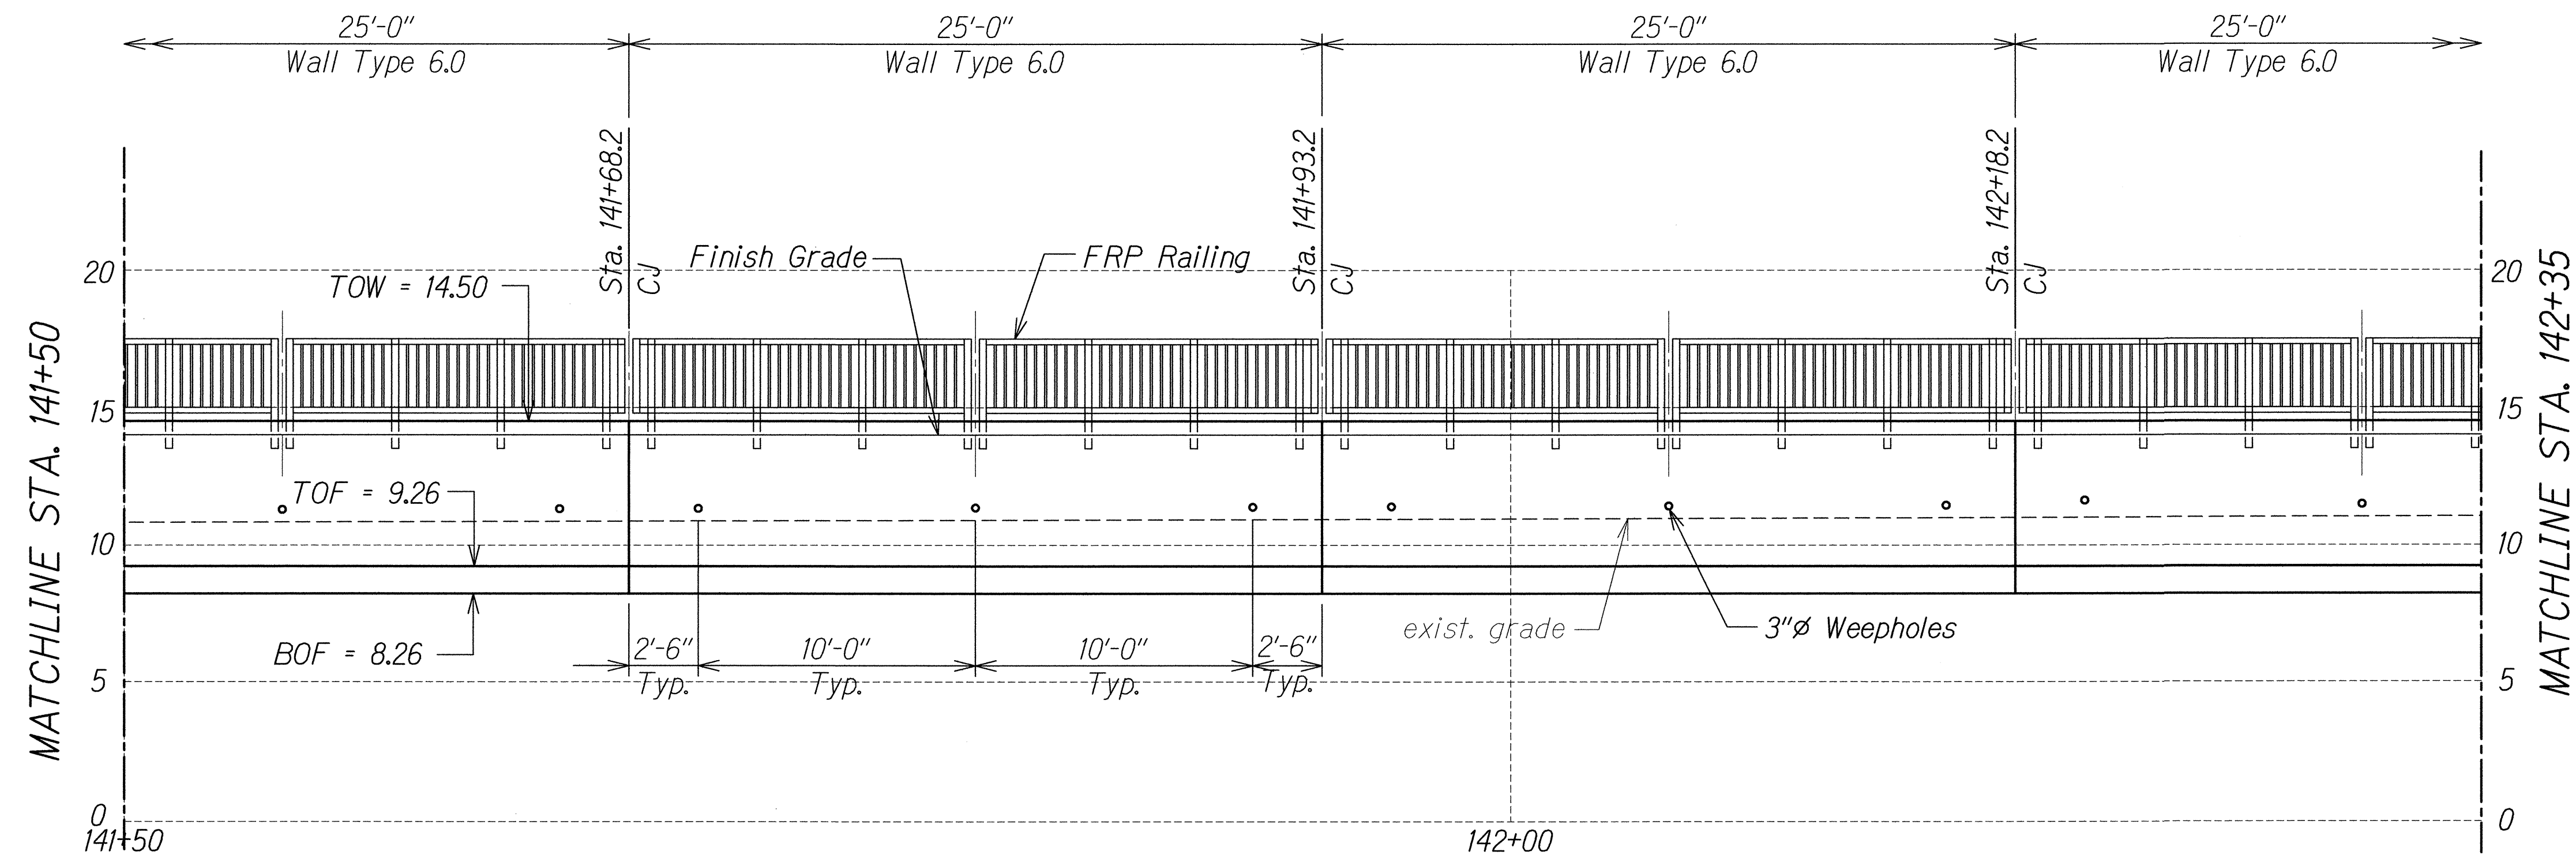


ELEVATION - STA. 141+50 TO 142+35
Scale: 1/4" = 1'-0"

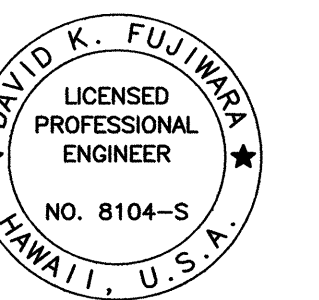

THIS WORK WAS PREPARED BY ME
OR UNDER MY SUPERVISION.
David K. Fujiwara
KSF, INC. APRIL 30, 2014
LIC. EXP. DATE

STATE OF HAWAII
DEPARTMENT OF TRANSPORTATION
HIGHWAYS DIVISION
RETAINING WALL B ELEVATION
STA. 140+43.2 TO STA. 142+35
FARRINGTON HIGHWAY INTERSECTION IMPROVEMENTS
AT NANAKULI AVENUE AND HALEAKALA AVENUE
Federal-Aid Project No. STP-093-1(22)
Scale: As Shown Date: April 2013
SHEET No. *SI.1* OF 10 SHEETS


FED. ROAD DIST. NO.	STATE	FED. AID PROJ. NO.	FISCAL YEAR	SHEET NO.	TOTAL SHEETS
HAWAII	HAW.	STP-093-1(22)	2013	176	230

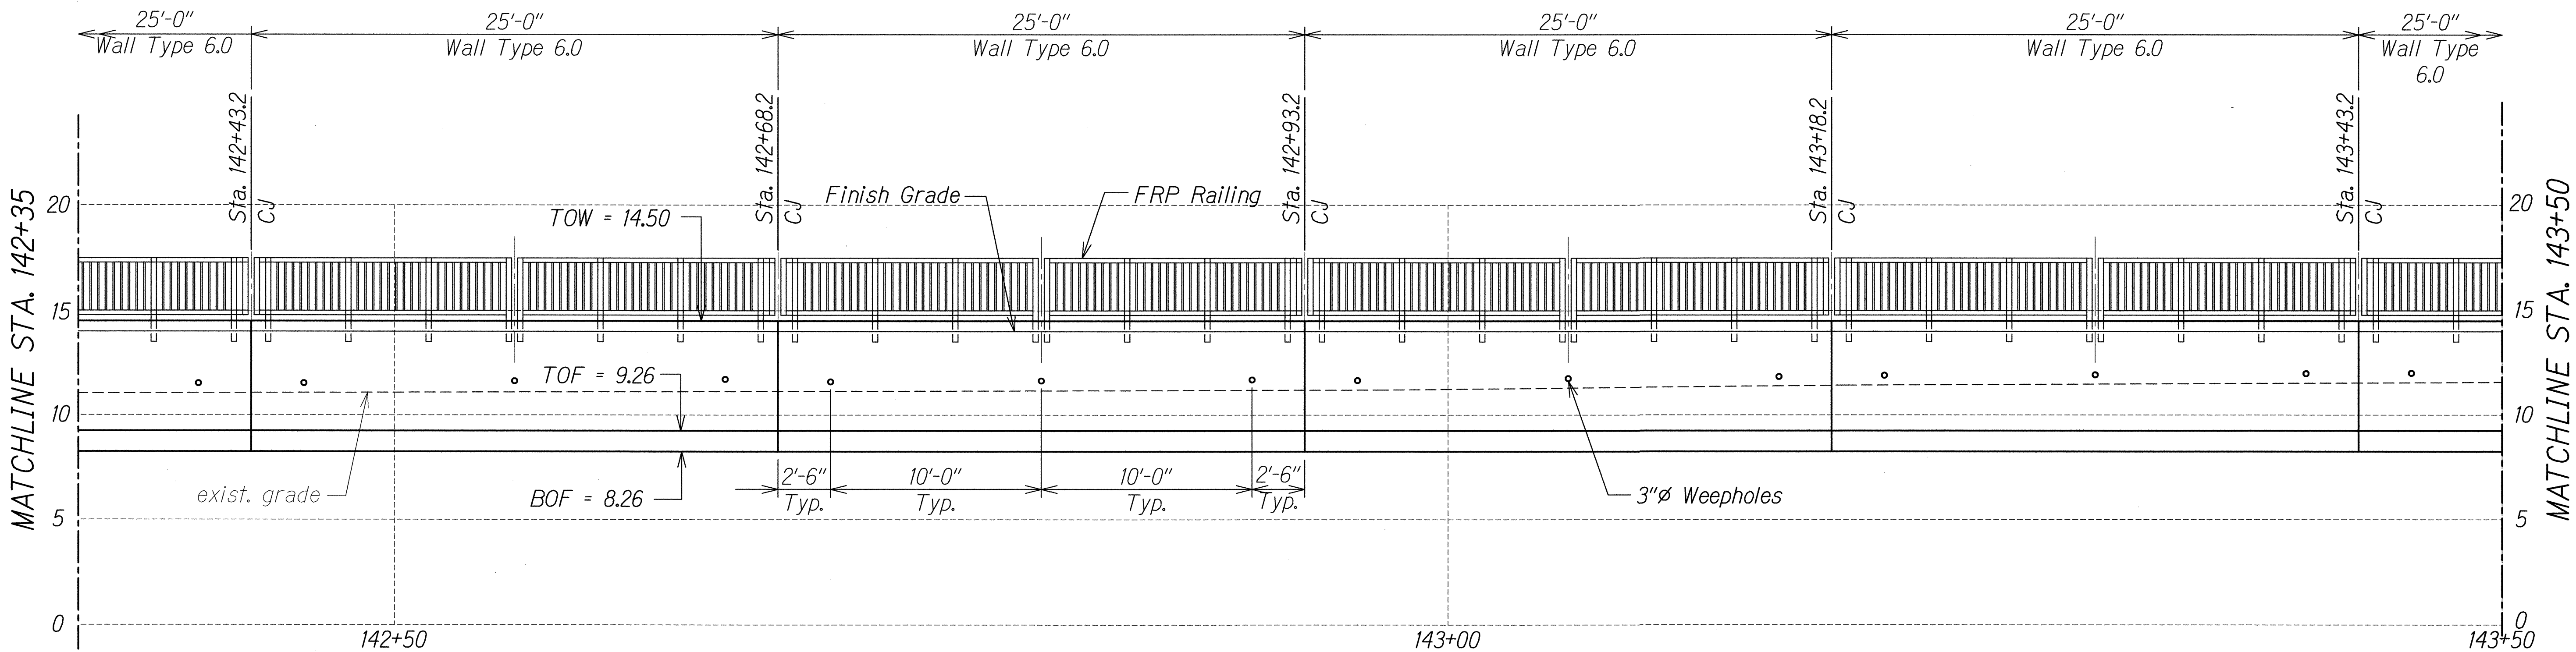

ELEVATION - STA. 142+35 TO 143+50
Scale: 1/4" = 1'-0"

LEGEND:
CJ Control Joint in Wall and Footing
TOF Top of Footing Elevation
BOF Bottom of Footing Elevation
TOW Top of Wall Elevation

NOTES:
1. For finish grade elevation road side of wall, see Civil drawings.
2. See 2/S0.6 for added reinforcing at weep holes.
3. For FRP Railing, see Sheets S5.1 and S5.3.

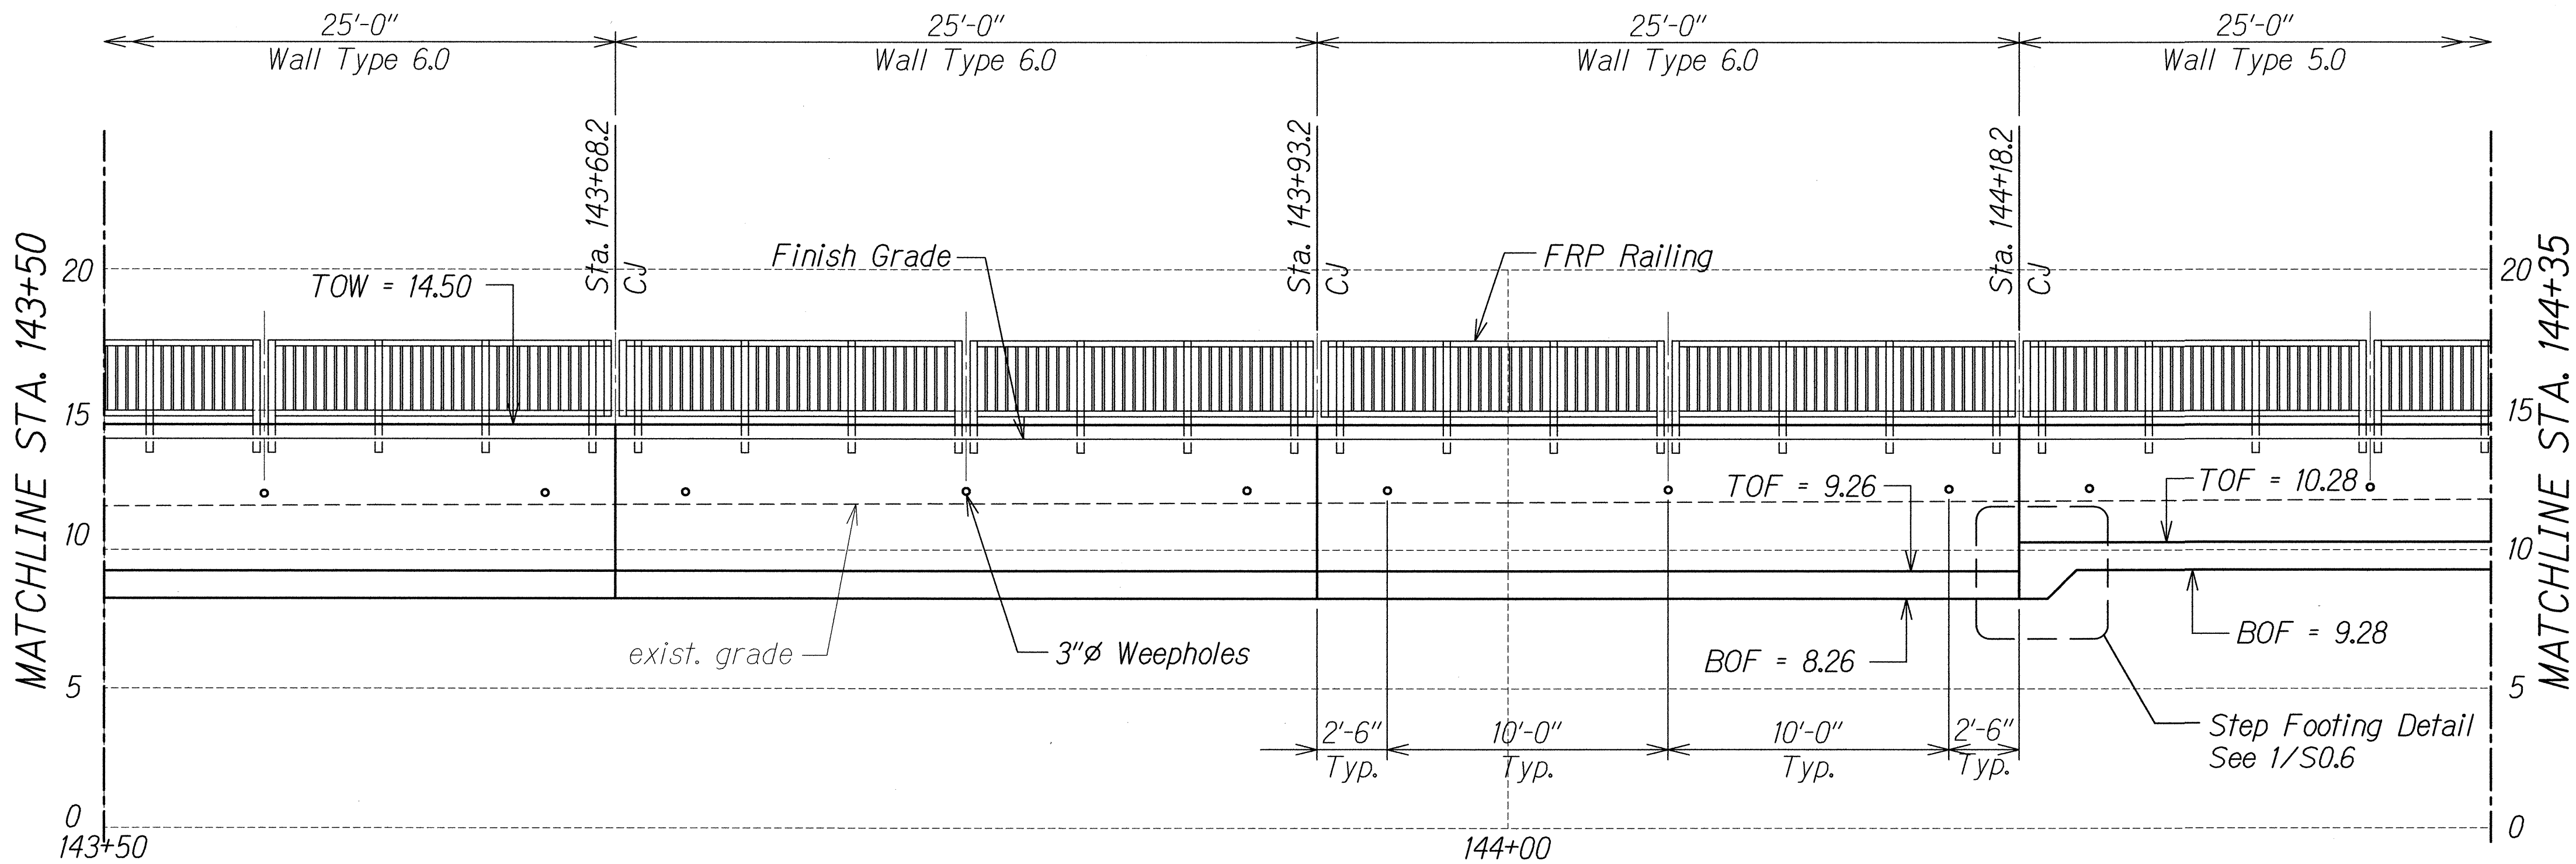

ELEVATION - STA. 143+50 TO 144+35
Scale: 1/4" = 1'-0"




THIS WORK WAS PREPARED BY ME
OR UNDER MY SUPERVISION.
David K. Fujimori
KSF, INC. APRIL 30, 2014
LIC. EXP. DATE

STATE OF HAWAII
DEPARTMENT OF TRANSPORTATION
HIGHWAYS DIVISION
RETAINING WALL B ELEVATION
STA. 142+35 TO STA. 144+35
FARRINGTON HIGHWAY INTERSECTION IMPROVEMENTS
AT NANAKULI AVENUE AND HALEAKALA AVENUE
Federal Aid Project No. STP-093-1(22)
Scale: As Shown Date: April 2013
SHEET No. S1.2 OF 10 SHEETS

ORIGINAL PLAN	DATE
DESIGNED BY	DATE
QUANTITIES BY	DATE
CHECKED BY	DATE

DRAWING NAME: Z:\00 ONCOMING\12-026-FARRINGTON HWY NANAKULI TO HALEAKALA-JULEHAWA.CAD 07-17-13 FINAL 100% FUL-SIDELING PLOT TIME: 07-16-13, 4:10 PM


FED. ROAD DIST. NO.	STATE	FED. AID PROJ. NO.	FISCAL YEAR	SHEET NO.	TOTAL SHEETS
HAWAII	HAW.	STP-093-1(22)	2013	177	230

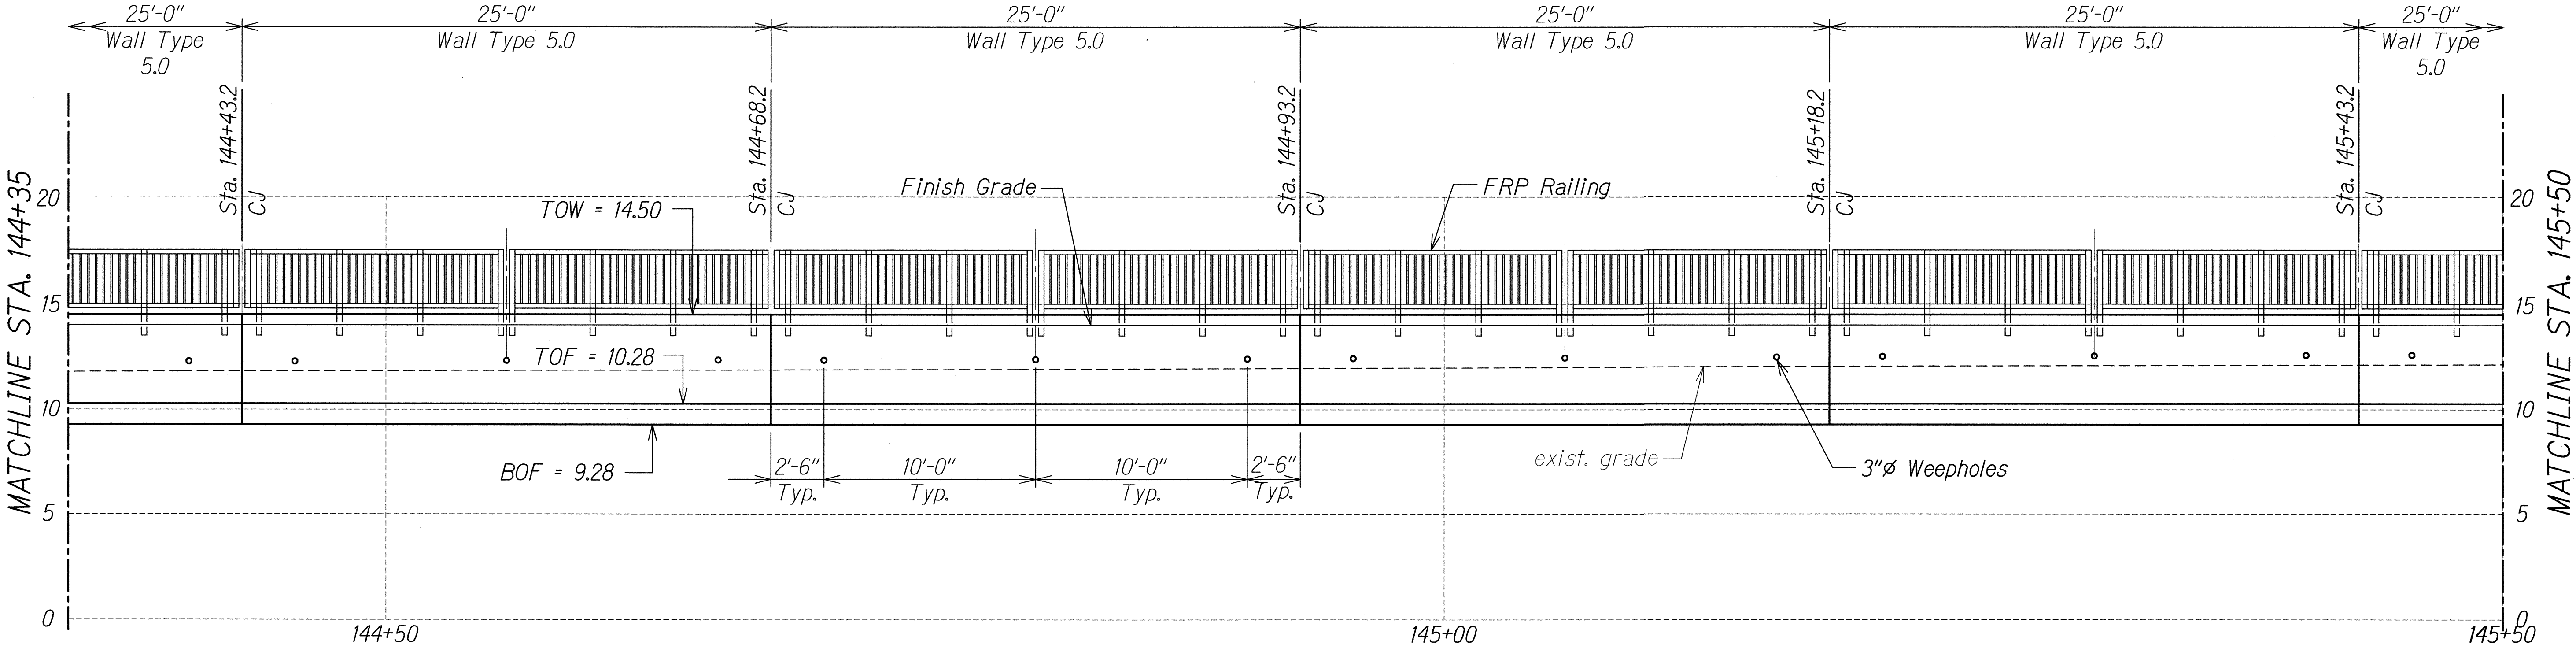


ELEVATION - STA. 144+35 TO 145+50
Scale: 1/4" = 1'-0"

- LEGEND:**
- CJ Control Joint in Wall and Footing
 - TOF Top of Footing Elevation
 - BOF Bottom of Footing Elevation
 - TOW Top of Wall Elevation

- NOTES:**
- For finish grade elevation road side of wall, see Civil drawings.
 - See 2/S0.6 for added reinforcing at weep holes.
 - For FRP Railing, see Sheets S5.1 and S5.3.

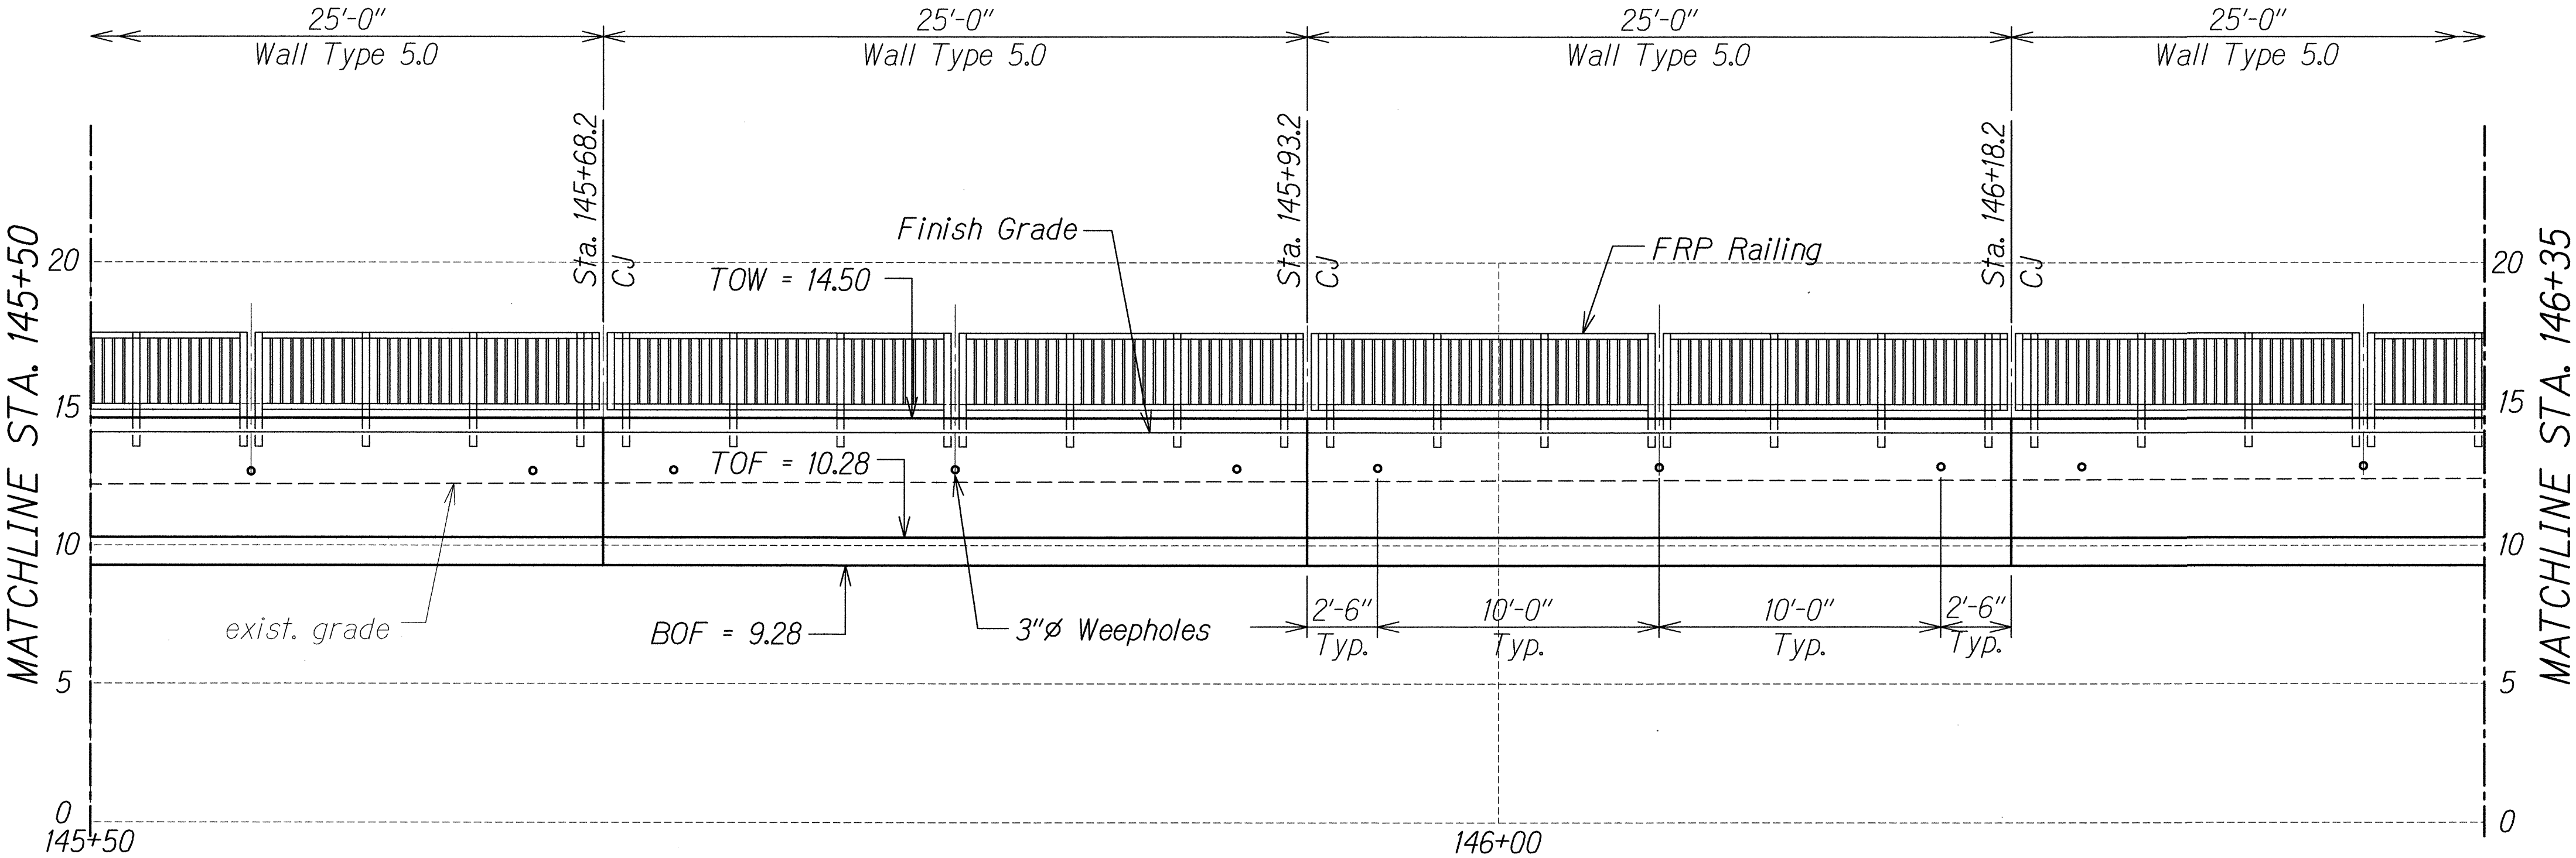

ELEVATION - STA. 145+50 TO 146+35
Scale: 1/4" = 1'-0"

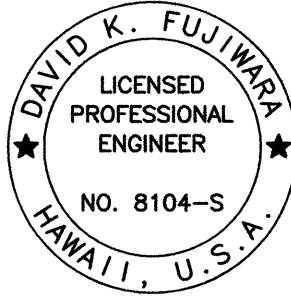


THIS WORK WAS PREPARED BY ME
OR UNDER MY SUPERVISION.
David K. Fujiwara
KSF, INC. APRIL 30, 2014
LIC. EXP. DATE

STATE OF HAWAII
DEPARTMENT OF TRANSPORTATION
HIGHWAYS DIVISION
RETAINING WALL B ELEVATION
STA. 144+35 TO STA. 146+35
FARRINGTON HIGHWAY INTERSECTION IMPROVEMENTS
AT NANAKULI AVENUE AND HALEAKALA AVENUE
Federal-Aid Project No. STP-093-1(22)
Scale: As Shown Date: April 2013
SHEET No. **S1.3** OF 10 SHEETS

177

FED. ROAD DIST. NO.	STATE	FED. AID PROJ. NO.	FISCAL YEAR	SHEET NO.	TOTAL SHEETS
HAWAII	HAW.	STP-093-1(22)	2013	178	230

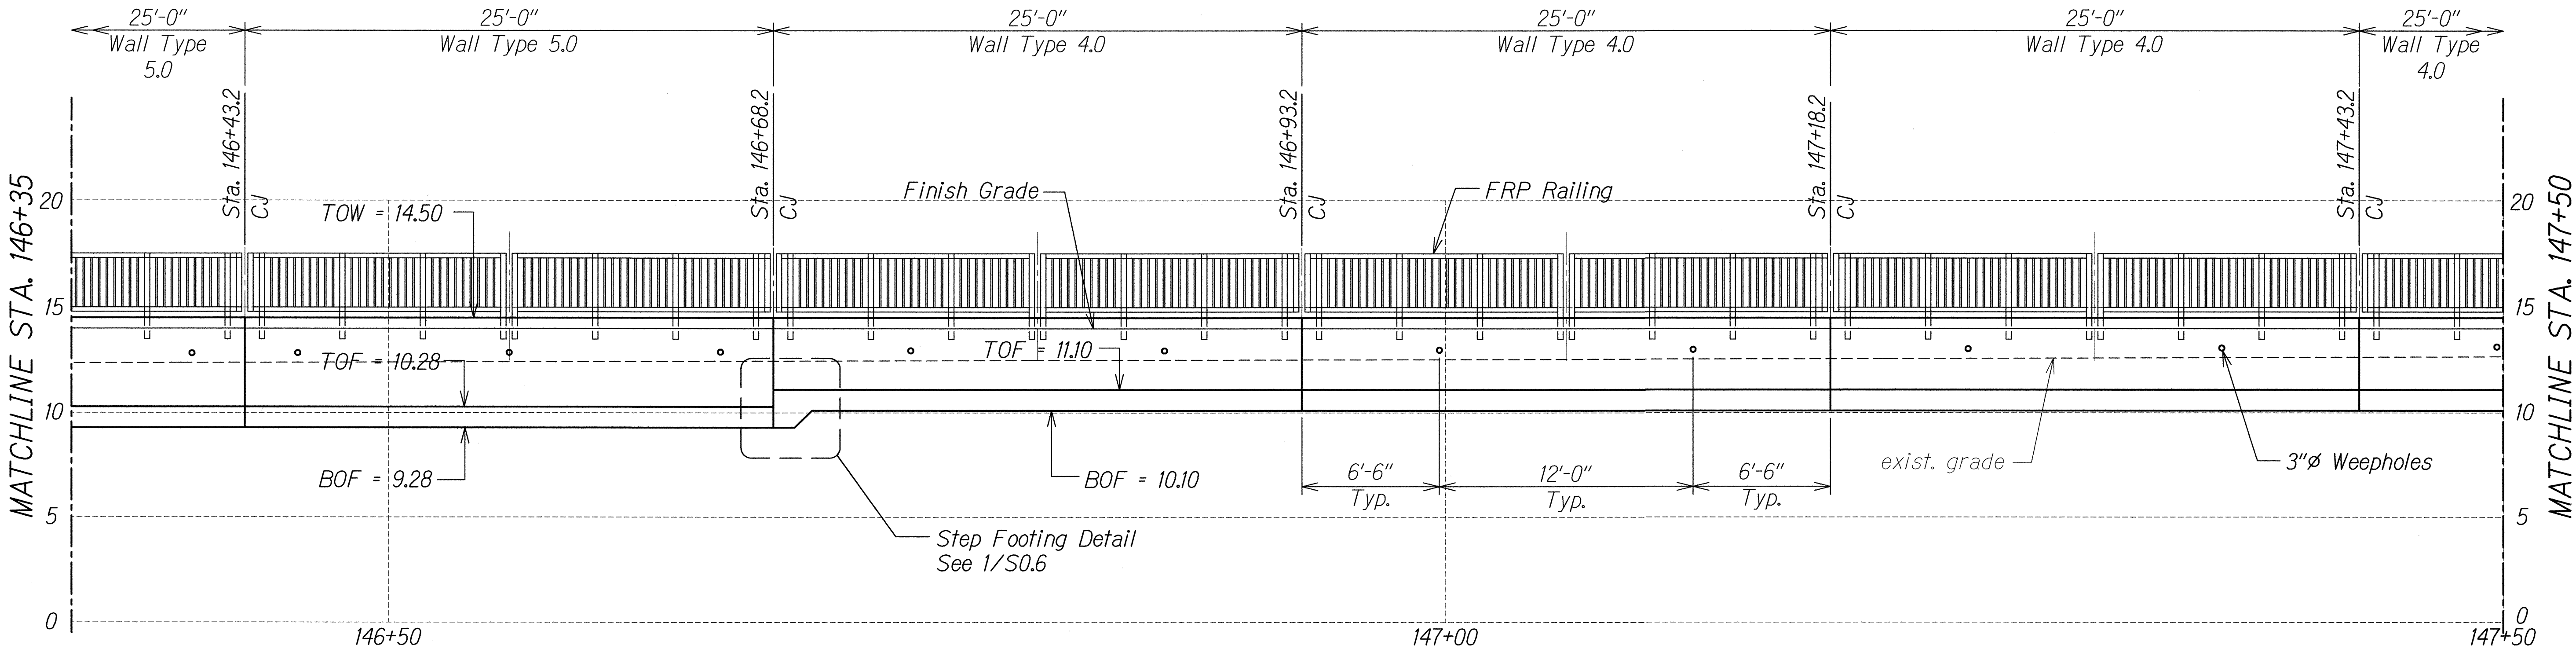


ELEVATION - STA. 146+35 TO 147+50
Scale: 1/4" = 1'-0"

A
S1.4 S1.4


- LEGEND:**
- CJ Control Joint in Wall and Footing
 - TOF Top of Footing Elevation
 - BOF Bottom of Footing Elevation
 - TOW Top of Wall Elevation

- NOTES:**
- For finish grade elevation road side of wall, see Civil drawings.
 - See 2/S0.6 for added reinforcing at weep holes.
 - For FRP Railing, see Sheets S5.1 and S5.3.

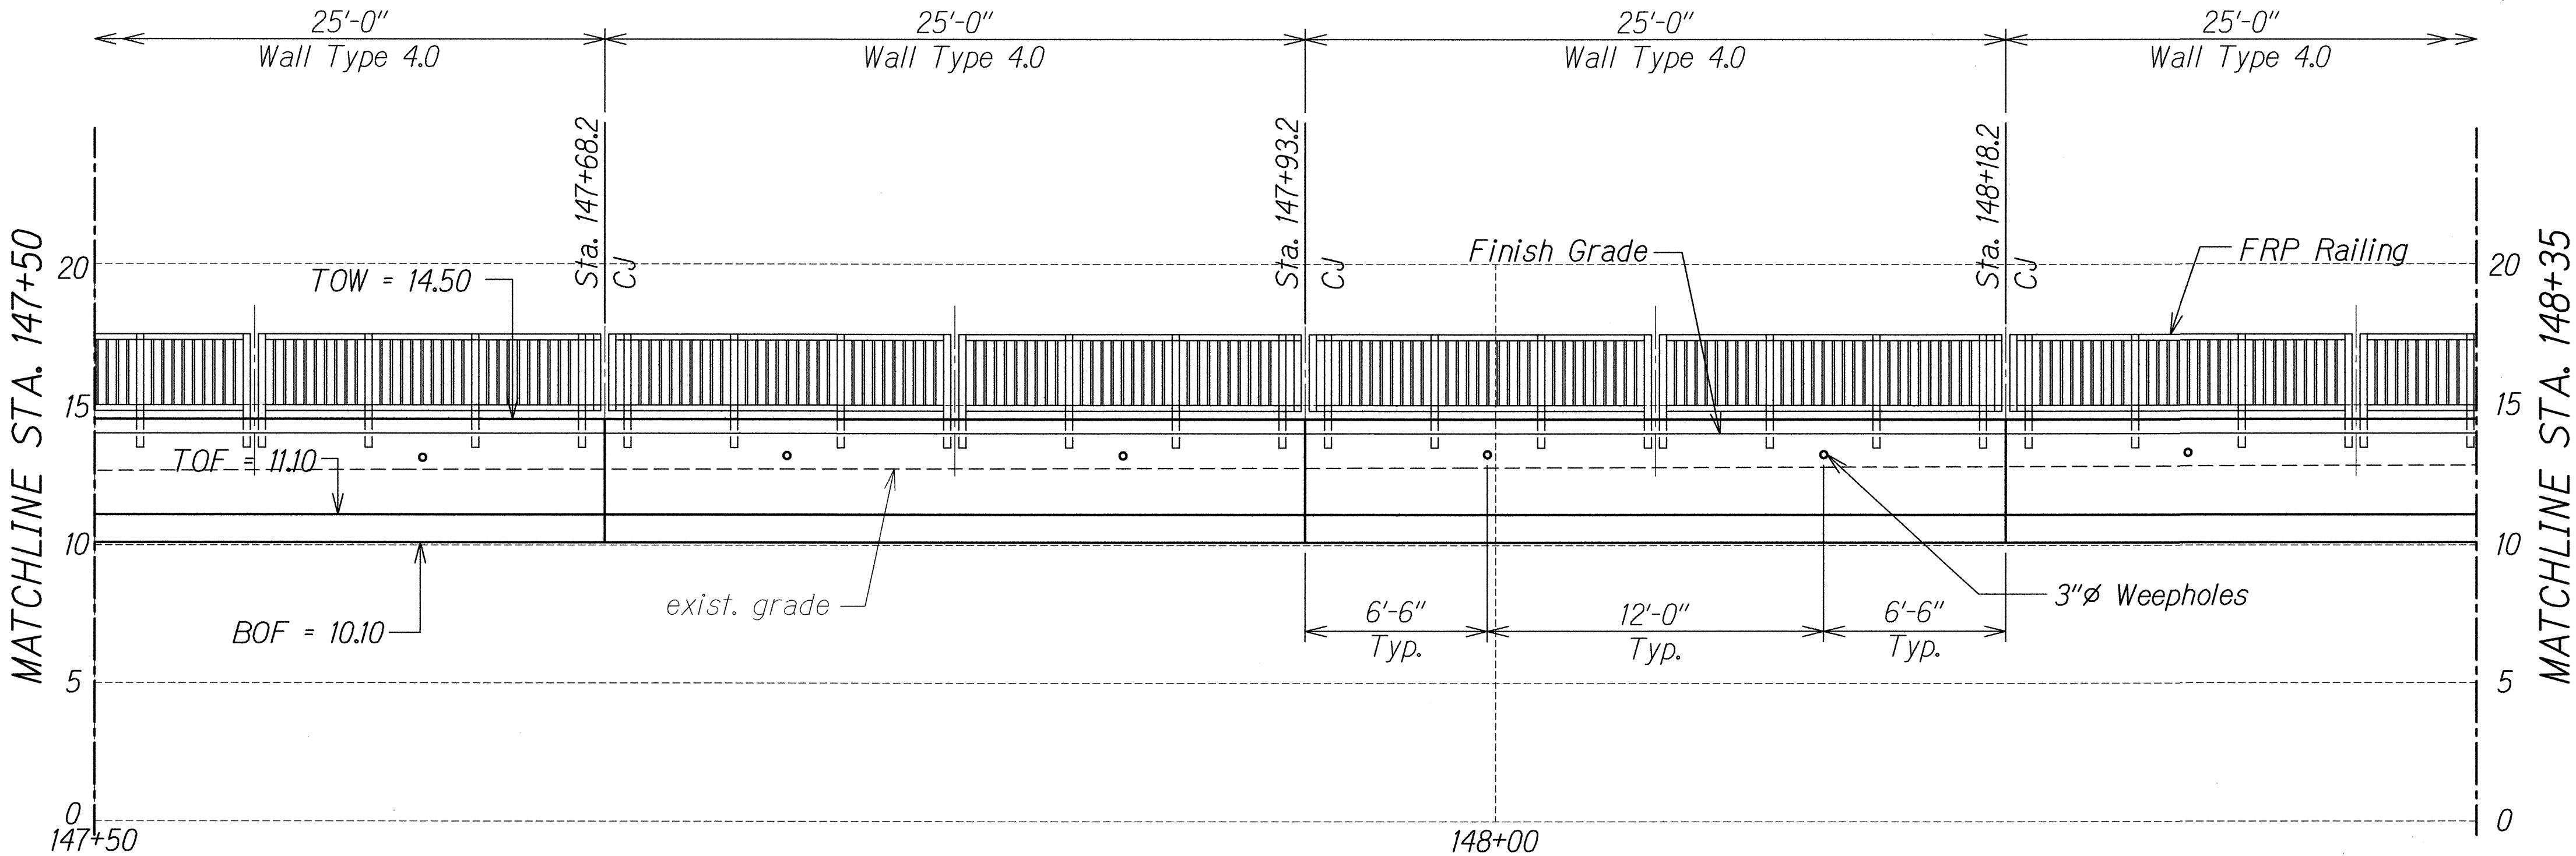

ELEVATION - STA. 147+50 TO 148+35
Scale: 1/4" = 1'-0"

B
S1.4 S1.4

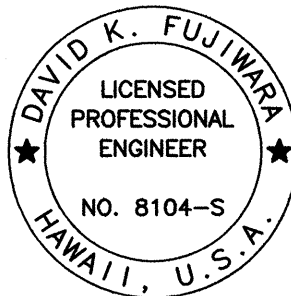


THIS WORK WAS PREPARED BY ME
OR UNDER MY SUPERVISION.
David K. Fujimura
KSF, INC. APRIL 30, 2014
LIC. EXP. DATE

STATE OF HAWAII
DEPARTMENT OF TRANSPORTATION
HIGHWAYS DIVISION
RETAINING WALL B ELEVATION
STA. 146+35 TO STA. 148+35
FARRINGTON HIGHWAY INTERSECTION IMPROVEMENTS
AT NANAKULI AVENUE AND HALEAKALA AVENUE
Federal-Aid Project No. STP-093-1(22)
Scale: As Shown Date: April 2013
SHEET No. S1.4 OF 10 SHEETS

178

FED. ROAD DIST. NO.	STATE	FED. AID PROJ. NO.	FISCAL YEAR	SHEET NO.	TOTAL SHEETS
HAWAII	HAW.	STP-093-1(22)	2013	179	230

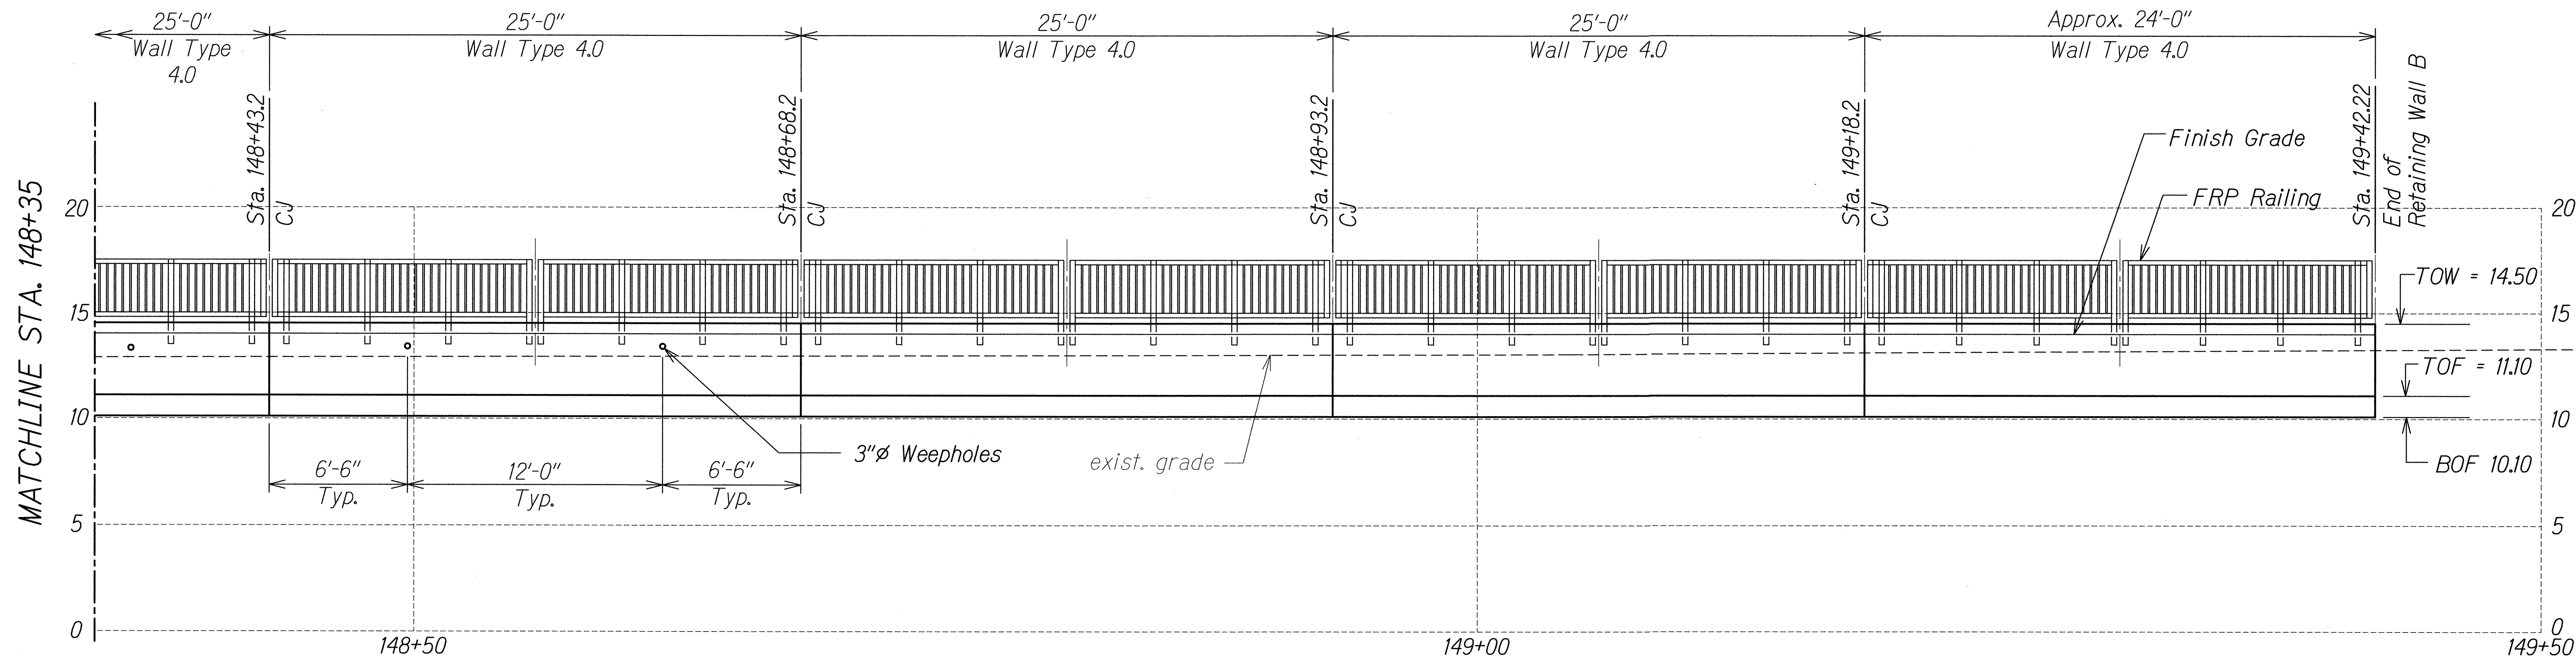

ELEVATION - STA. 148+35 TO 149+42.22

Scale: 1/4" = 1'-0"

A

S1.5 S1.5

LEGEND:

CJ Control Joint in Wall and Footing


TOF Top of Footing Elevation

BOF Bottom of Footing Elevation

TOW Top of Wall Elevation

NOTES:

- For finish grade elevation road side of wall, see Civil drawings.
- See 2/S0.6 for added reinforcing at weep holes.
- For FRP Railing, see Sheets S5.1 and S5.3.

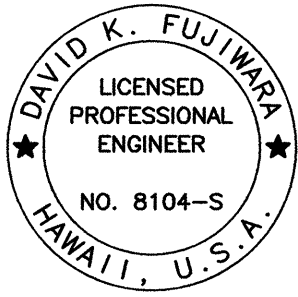

THIS WORK WAS PREPARED BY ME
OR UNDER MY SUPERVISION.

David K. Fujiwara

KSF, INC.


APRIL 30, 2014

LIC. EXP. DATE

STATE OF HAWAII
DEPARTMENT OF TRANSPORTATION
HIGHWAYS DIVISION
RETAINING WALL B ELEVATION
STA. 148+35 TO STA. 149+42.22
FARRINGTON HIGHWAY INTERSECTION IMPROVEMENTS
AT NAKAKULI AVENUE AND HALEAKALA AVENUE
Federal-Aid Project No. STP-093-1(22)
Scale: As Shown Date: April 2013

SHEET No. S1.5 OF 10 SHEETS

FED. ROAD DIST. NO.	STATE	FED. AID PROJ. NO.	FISCAL YEAR	SHEET NO.	TOTAL SHEETS
HAWAII	HAW.	STP-093-1(22)	2013	180	230

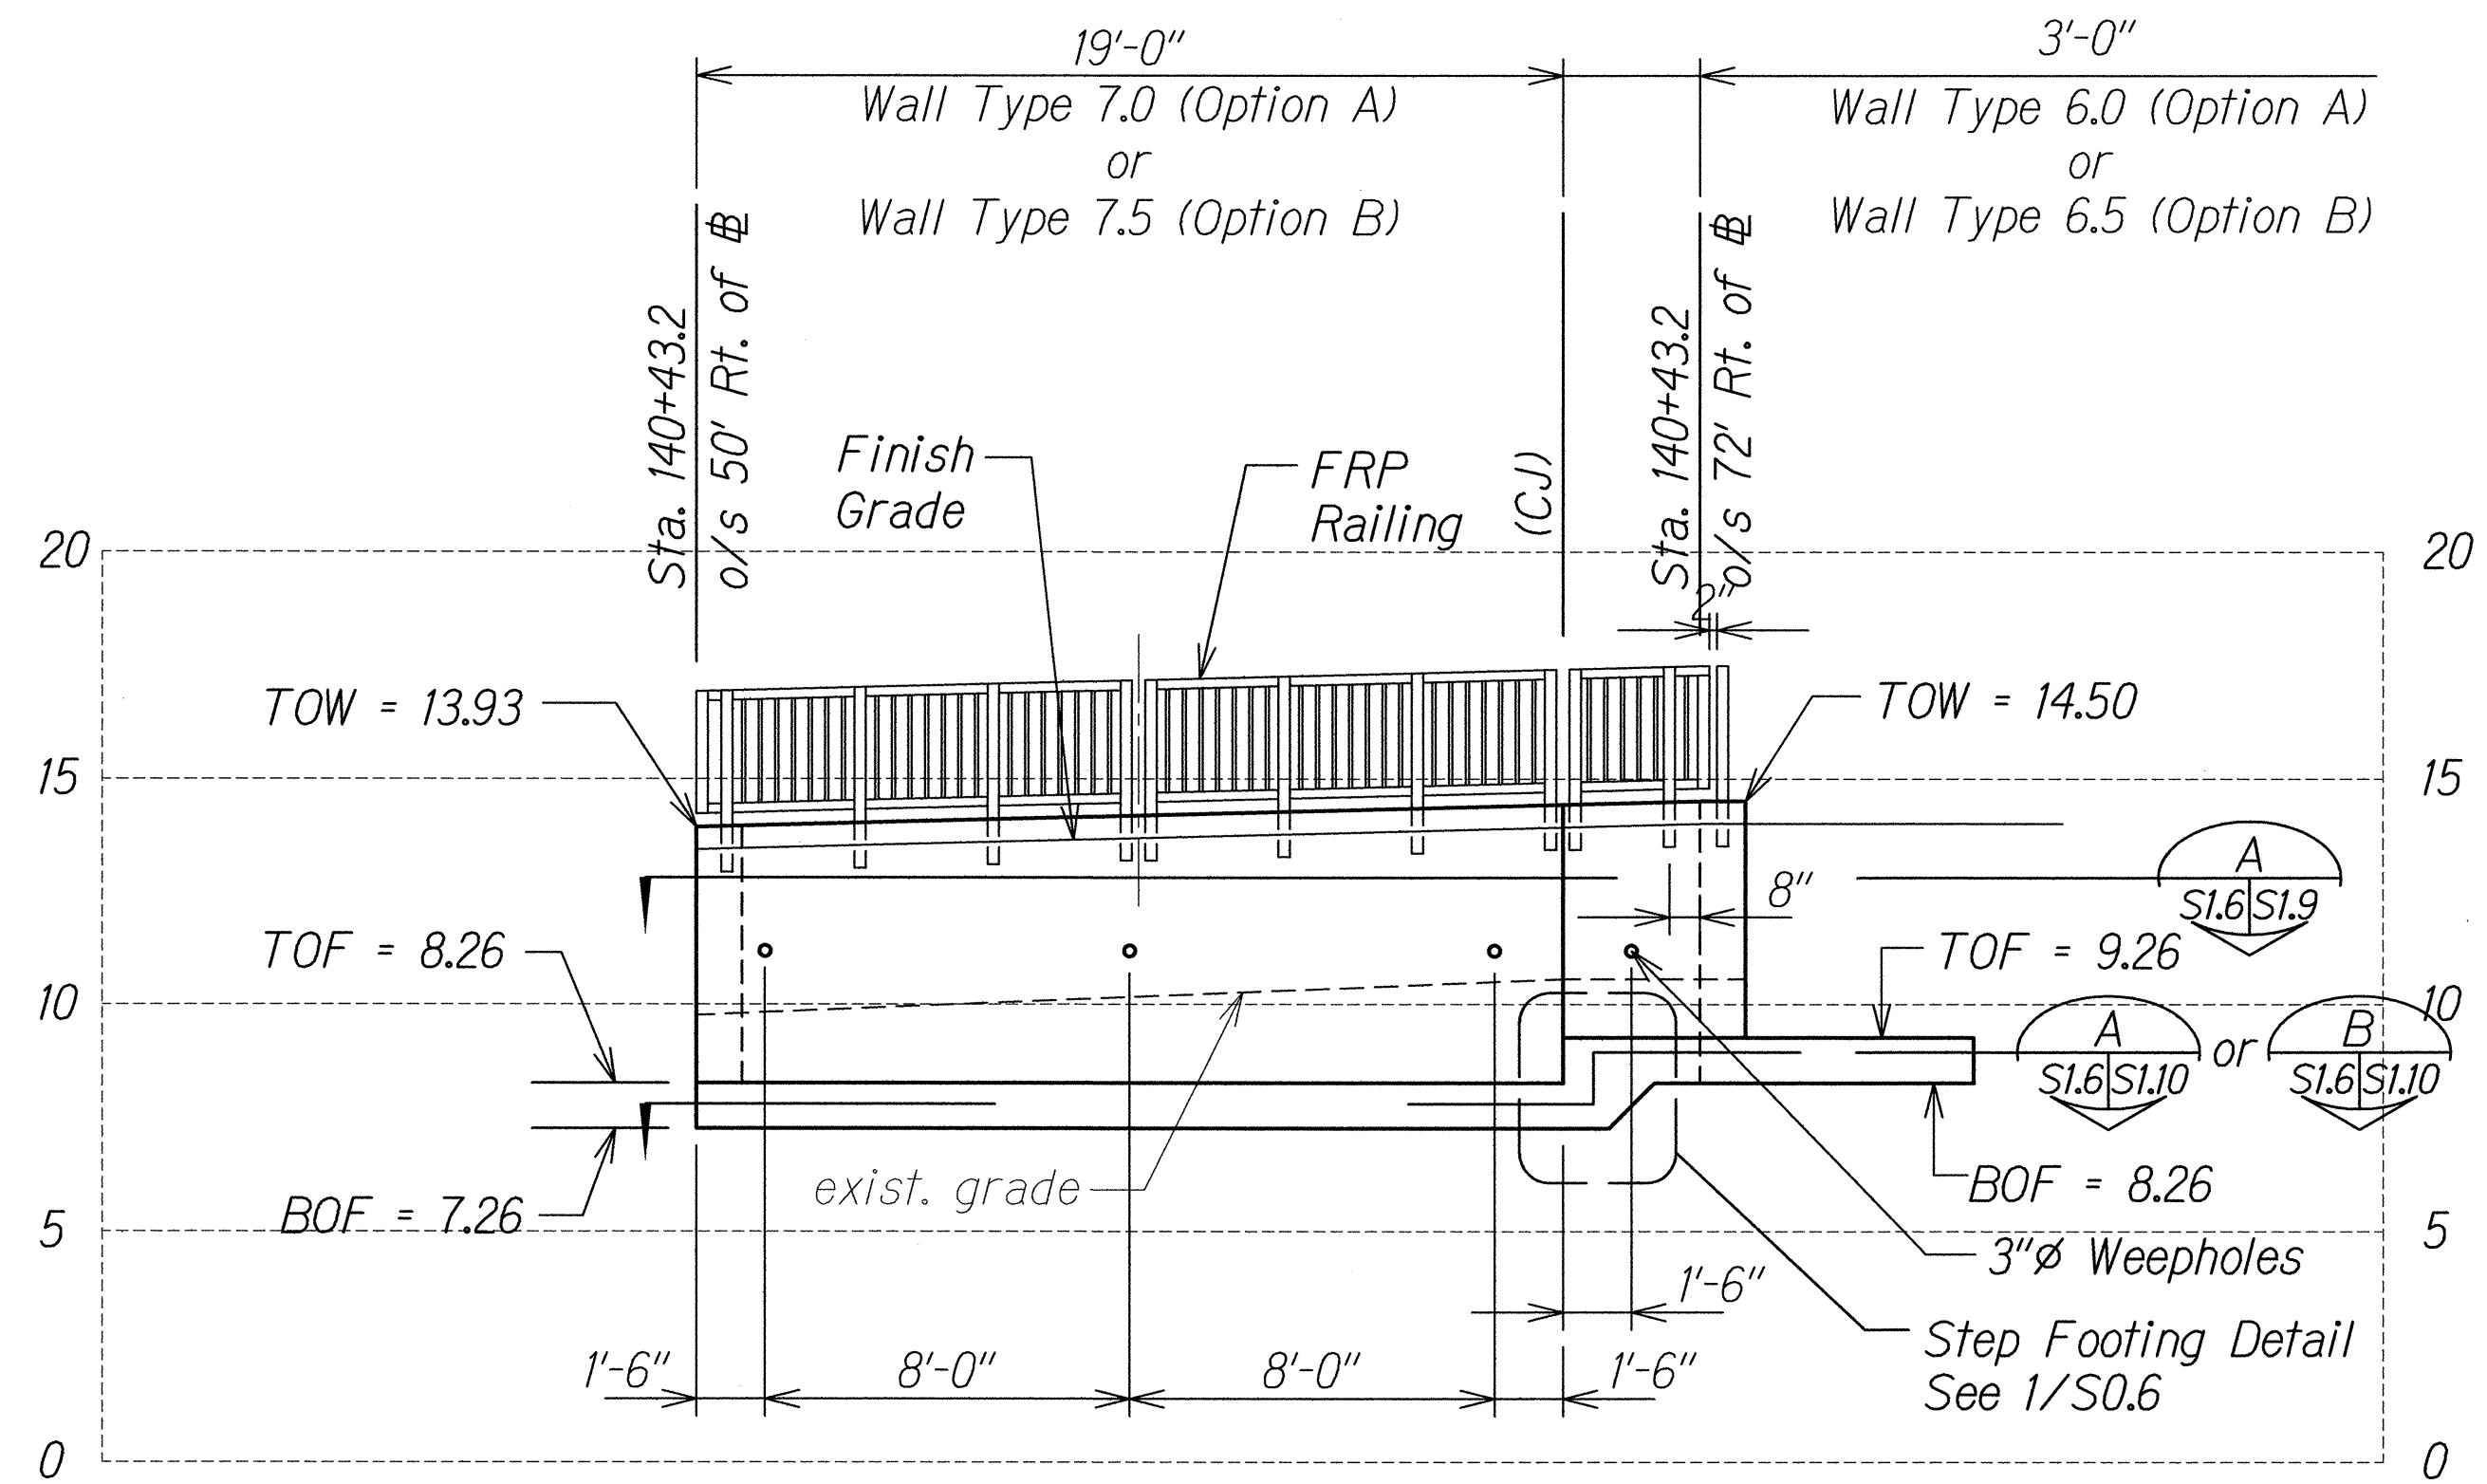


- LEGEND:**
CJ Control Joint in Wall and Footing
TOF Top of Footing Elevation
BOF Bottom of Footing Elevation
TOW Top of Wall Elevation
- NOTES:**
1. For finish grade elevation road side of wall, see Civil drawings.
2. See 2/S0.6 for added reinforcing at weep holes.
3. If the existing wall footing interferes with the footing of Wall Type 6.0 and 7.0 (Option A) refer to Wall Type 6.5 and 7.5 (Option B).

ELEVATION - STA. 140+43.2
Scale: 1/4" = 1'-0"

ORIGINAL PLAN	SURVEY PLOTTED BY	DATE
NOTE BOOK	DRAWN BY	
No.	TRACED BY	
	DESIGNED BY	
	CHECKED BY	

DRAWING NAME: Z:\00 ONCONG\12-026-FARRINGTON HWY NAKAKULI TO HALEAKALA\12-026-FARRINGTON HWY NAKAKULI TO HALEAKALA\CAD\07-17-13 FINAL 100% FHU-S101.DWG PLOT TIME: 07-16-13, 4:11 PM

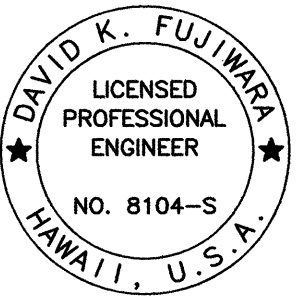


THIS WORK WAS PREPARED BY ME
OR UNDER MY SUPERVISION.
David K. Fujiwara
KSF, INC. APRIL 30, 2014
LIC. EXP. DATE

STATE OF HAWAII
DEPARTMENT OF TRANSPORTATION
HIGHWAYS DIVISION
RETAINING WALL A ELEVATION
STA. 140+43.2
FARRINGTON HIGHWAY INTERSECTION IMPROVEMENTS
AT NAKAKULI AVENUE AND HALEAKALA AVENUE
Federal-Aid Project No. STP-093-1(22)
Scale: As Shown Date: April 2013
SHEET No. S1.6 OF 10 SHEETS

FED. ROAD DIST. NO.	STATE	FED. AID PROJ. NO.	FISCAL YEAR	SHEET NO.	TOTAL SHEETS
HAWAII	HAW.	STP-093-1(22)	2013	181	230


Note:
Provide bracing for existing wall during excavation.
See Special Provisions Section 205 and Sheet S0.2 for additional requirements.

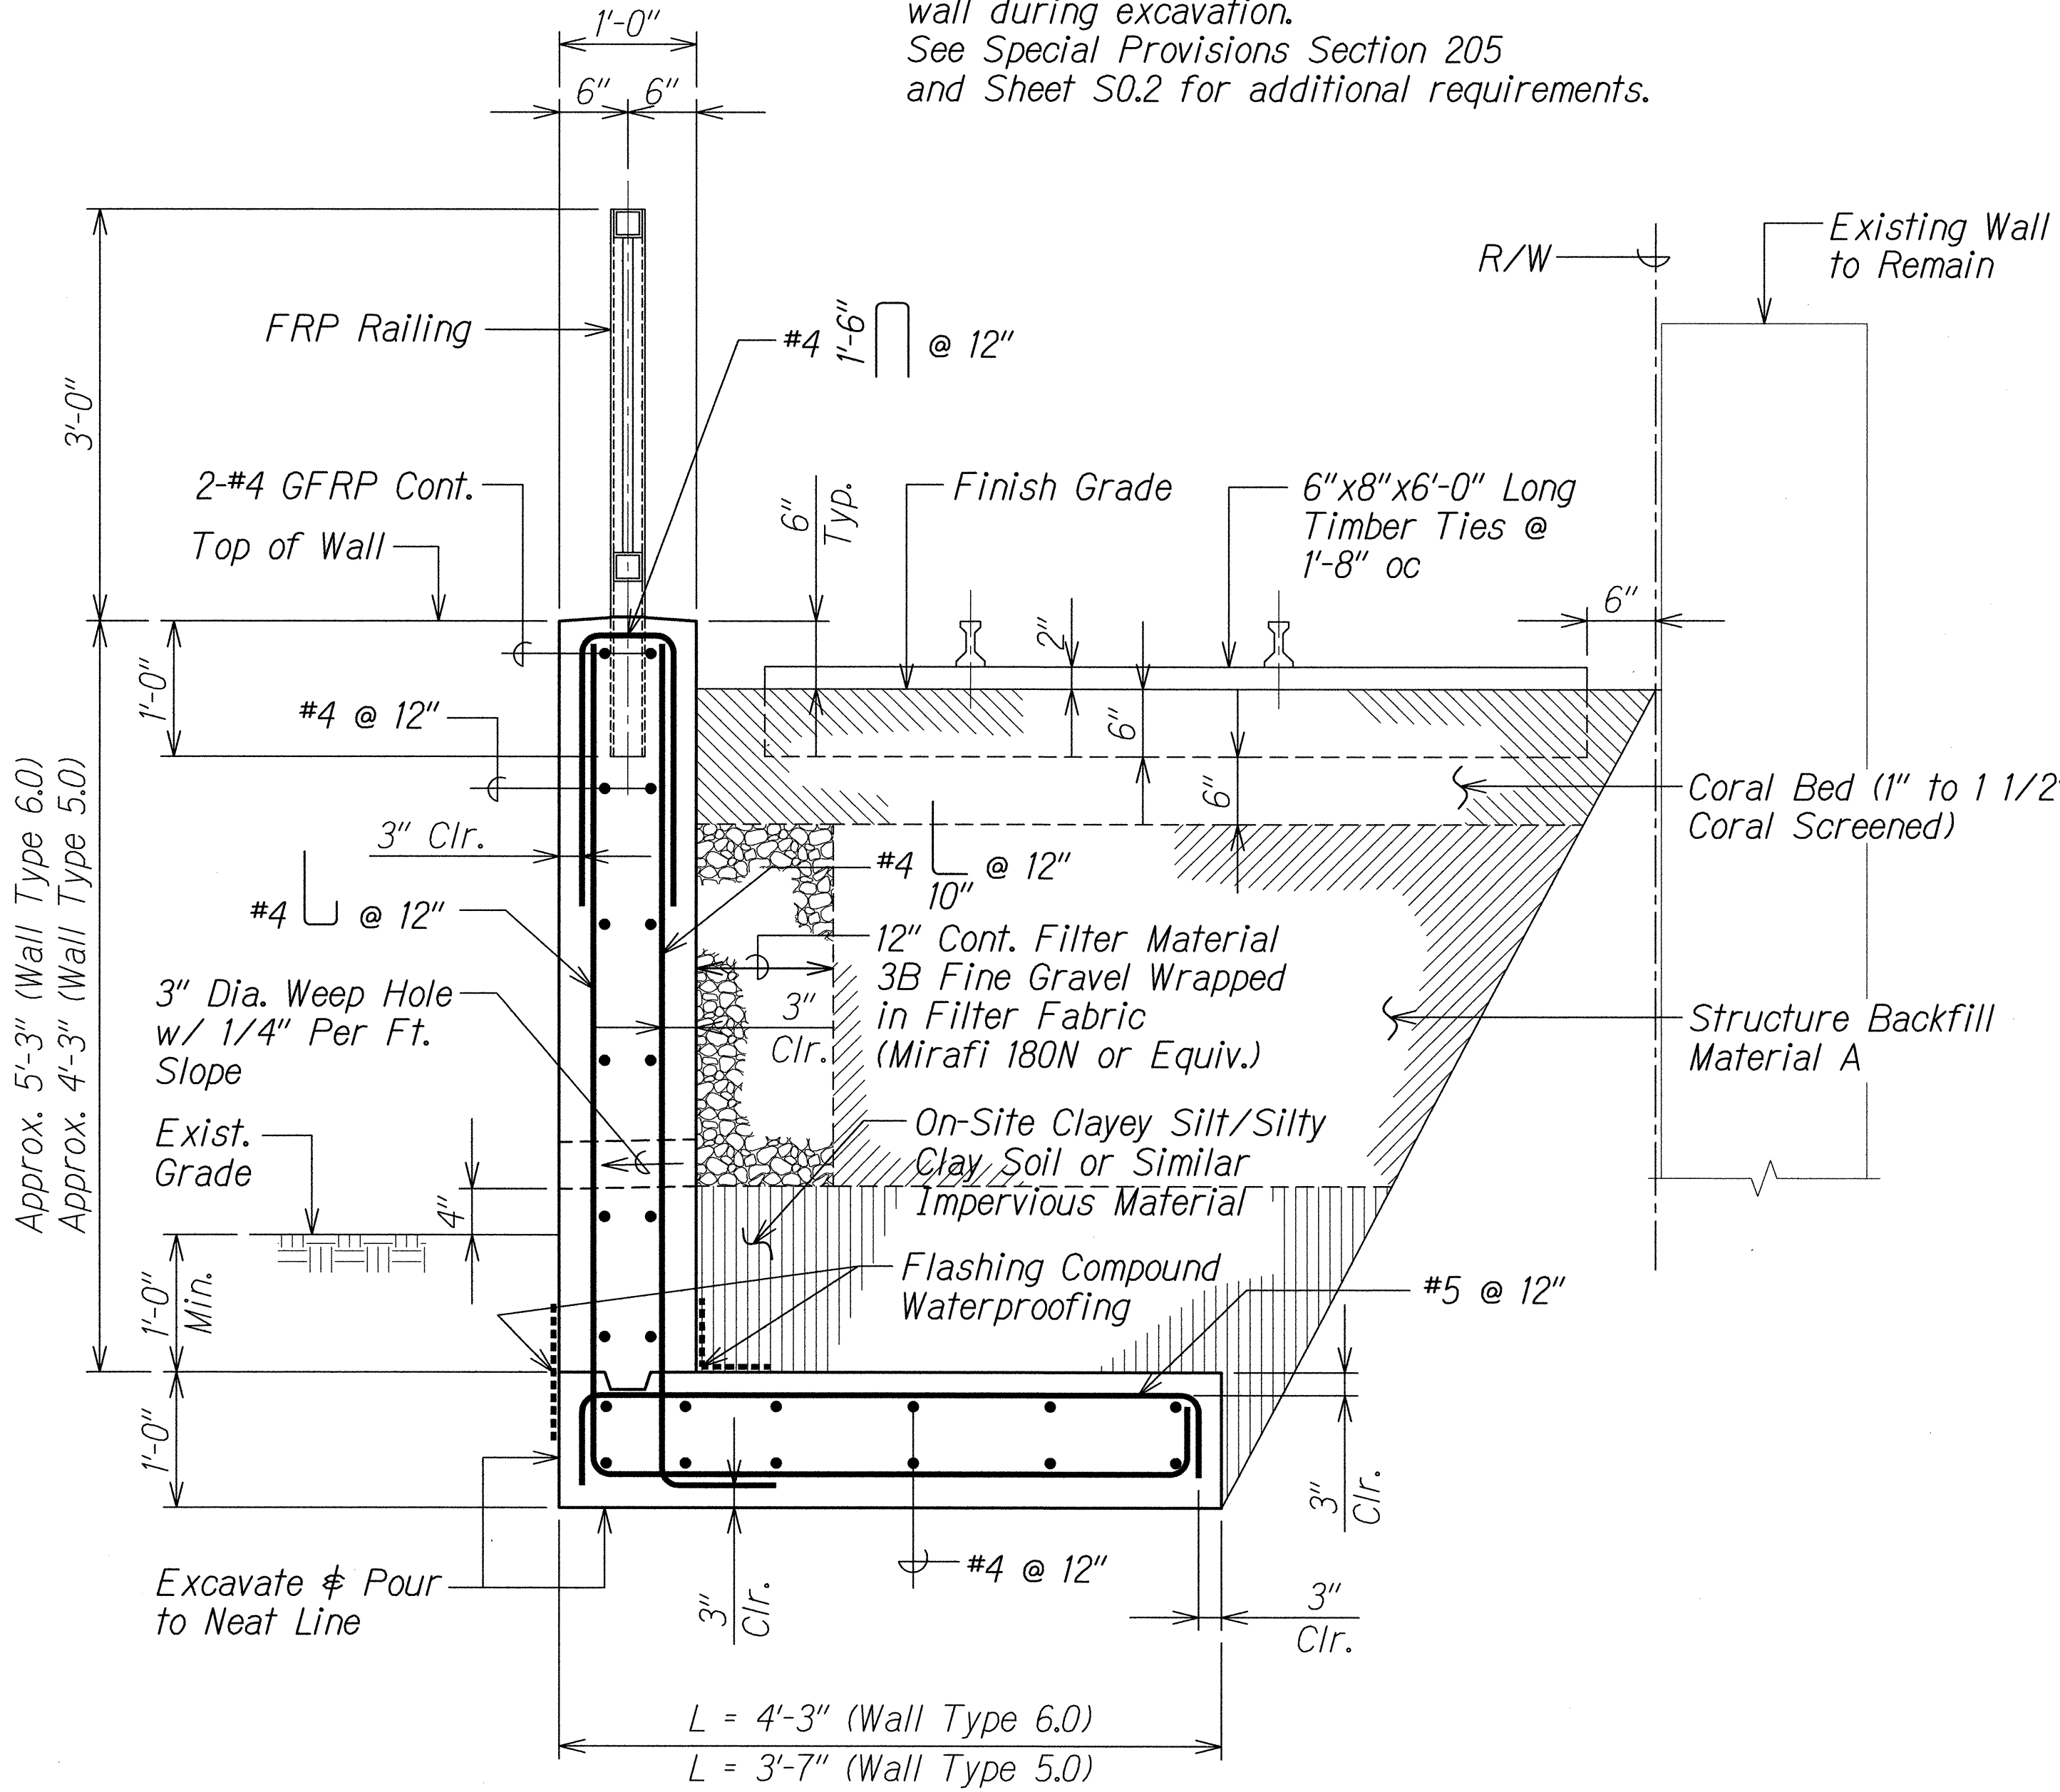

TYPICAL RET. WALL B SECTION A

Scale: 1" = 1'-0"


SI.10

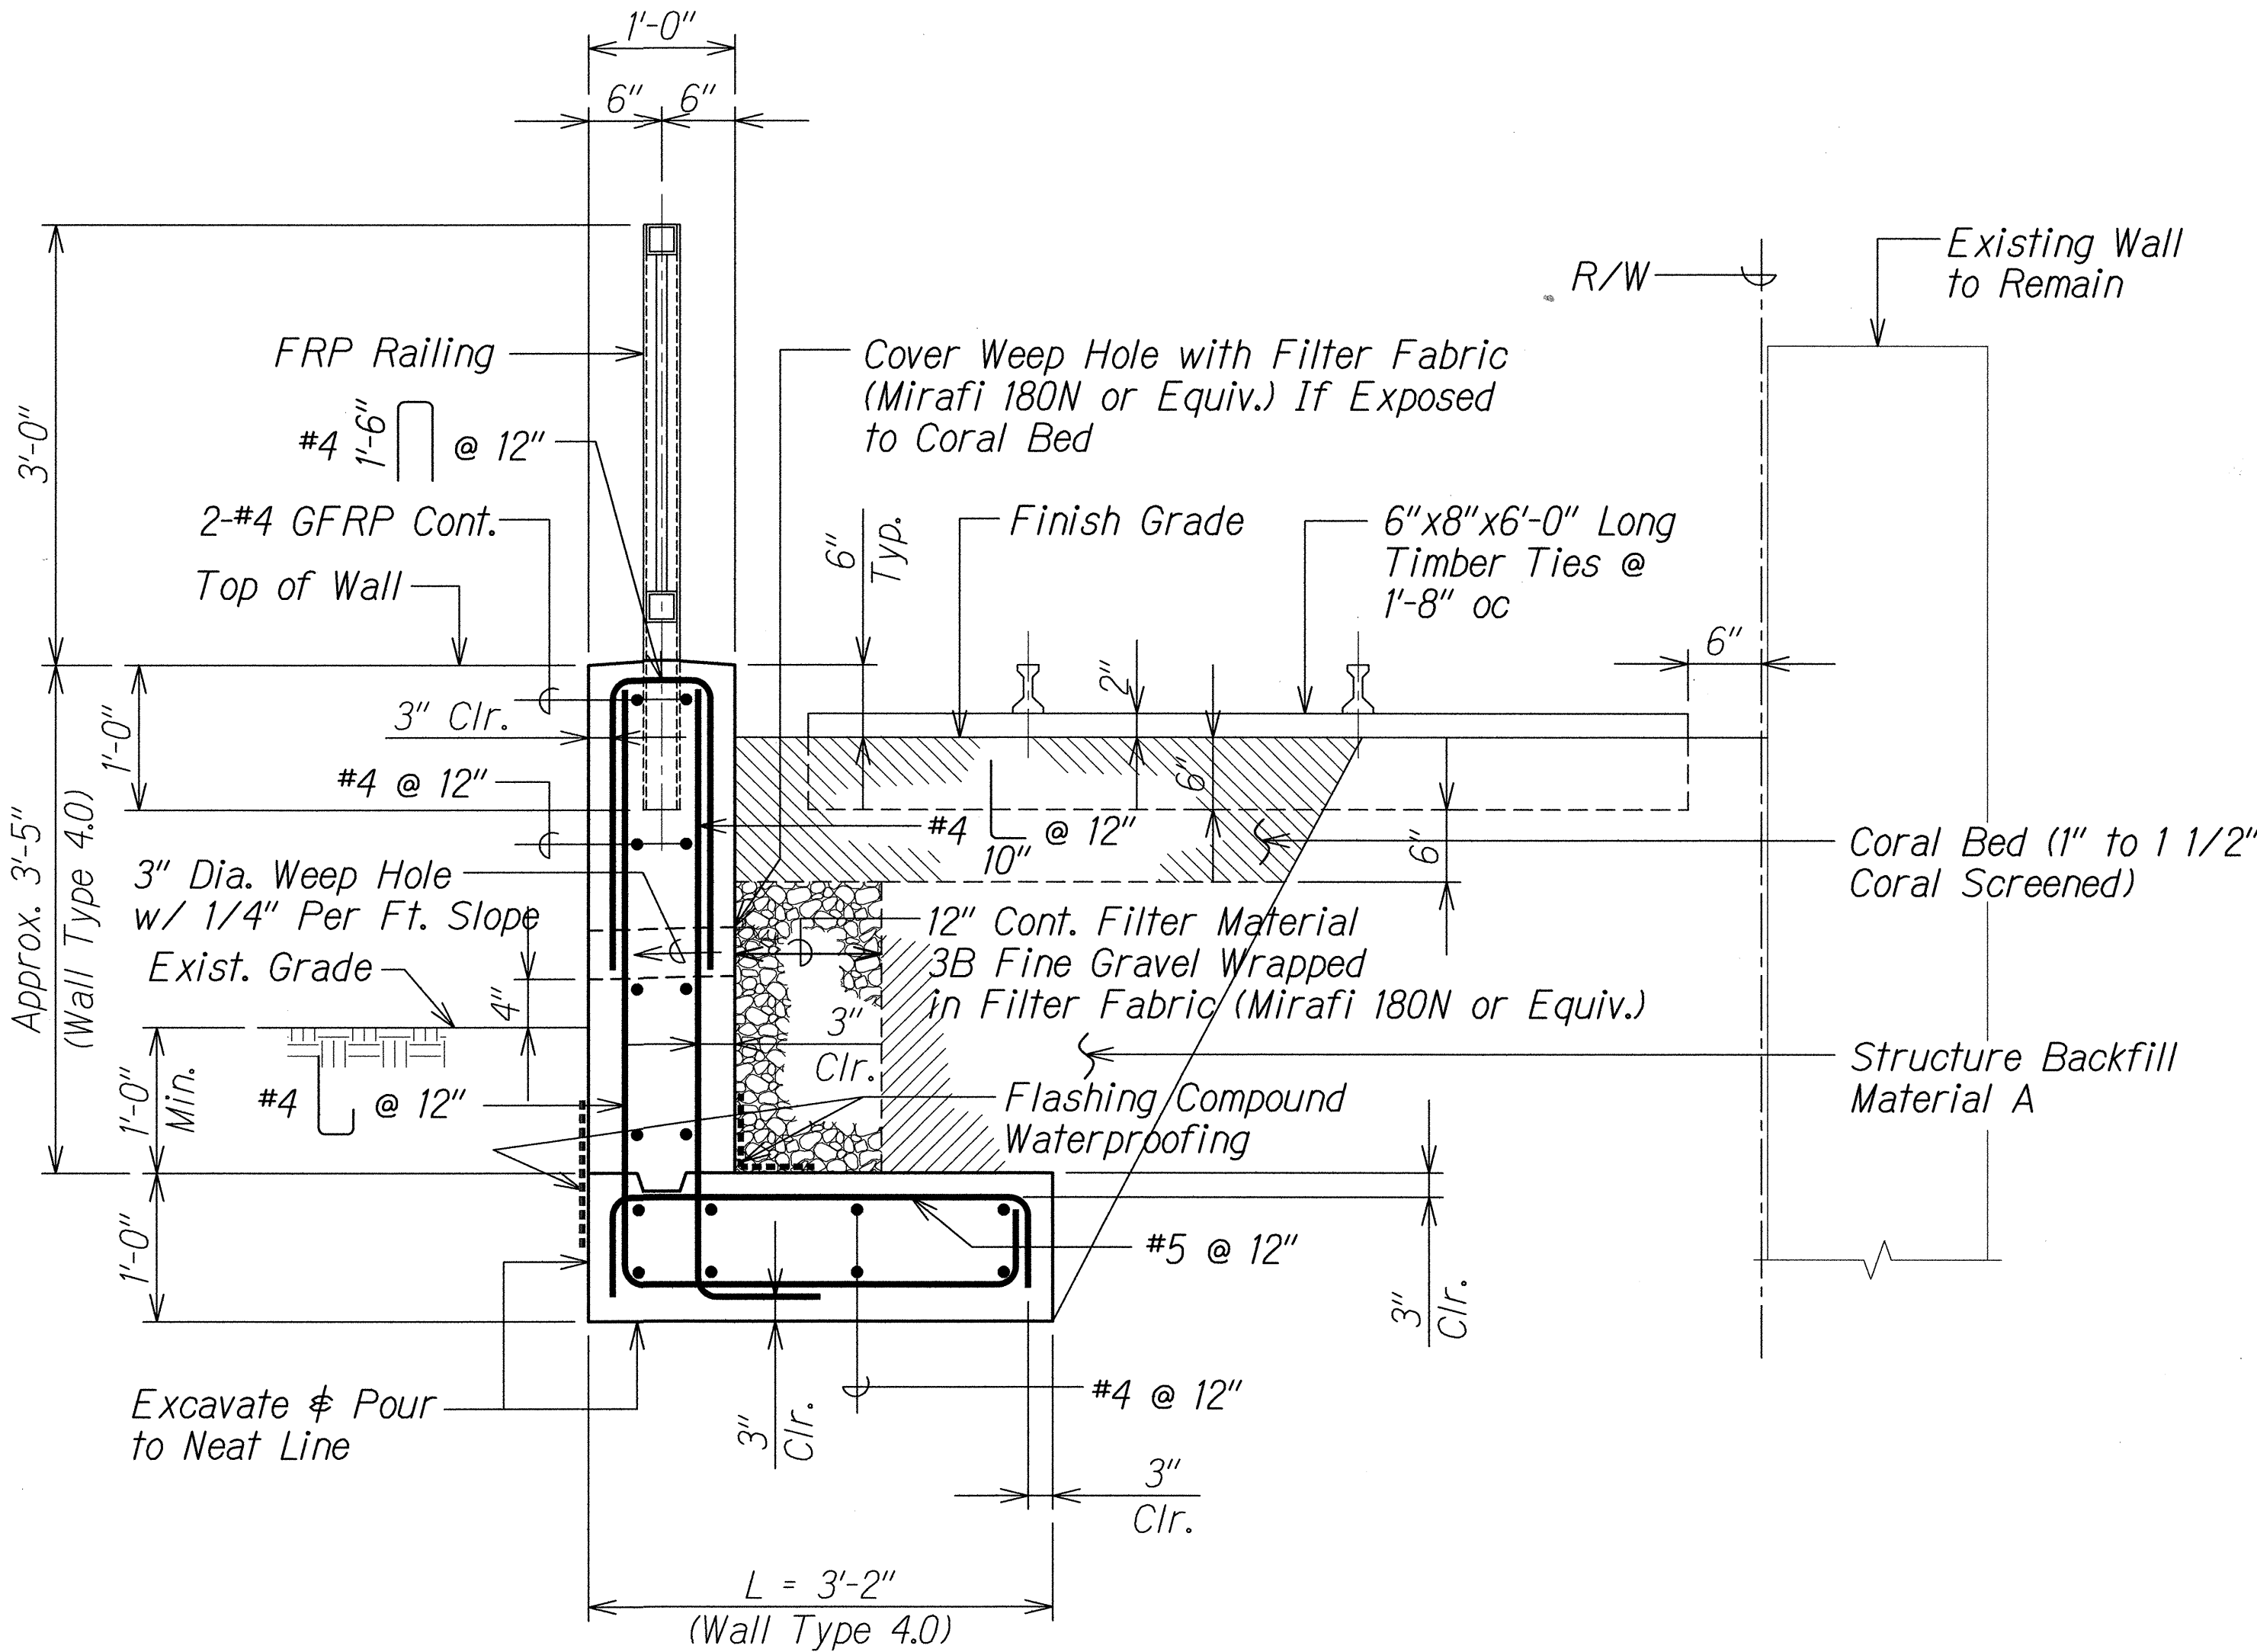

TYPICAL RET. WALL B SECTION B

Scale: 1" = 1'-0"

SI.7 SI.7

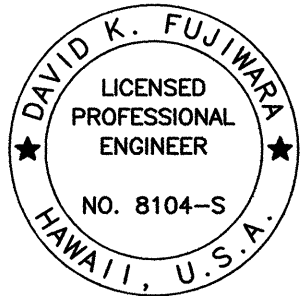

THIS WORK WAS PREPARED BY ME
OR UNDER MY SUPERVISION.
David K. Fujimura
KSF, INC. APRIL 30, 2014
LIC. EXP. DATE

STATE OF HAWAII
DEPARTMENT OF TRANSPORTATION
HIGHWAYS DIVISION

TYPICAL WALL SECTIONS


FARRINGTON HIGHWAY INTERSECTION IMPROVEMENTS
AT NANAKULI AVENUE AND HALEAKALA AVENUE
Federal-Aid Project No. STP-093-1(22)
Scale: As Shown Date: April 2013

SHEET No. SI.7 OF 10 SHEETS

DESIGNED BY	DATE
CHECKED BY	
NOTED BY	
QUANTITIES BY	
NO.	


DRAWING NAME: Z:\00 ONCONG\12-026-FARRINGTON HWY NANAKULI TO HALEAKALA-UEHAWA\CAD\07-17-13 FINAL 100% FHU-SI07.DWG PLOT TIME: 07-16-13, 4:11 PM

FED. ROAD DIST. NO.	STATE	FED. AID PROJ. NO.	FISCAL YEAR	SHEET NO.	TOTAL SHEETS
HAWAII	HAW.	STP-093-1(22)	2013	183	230

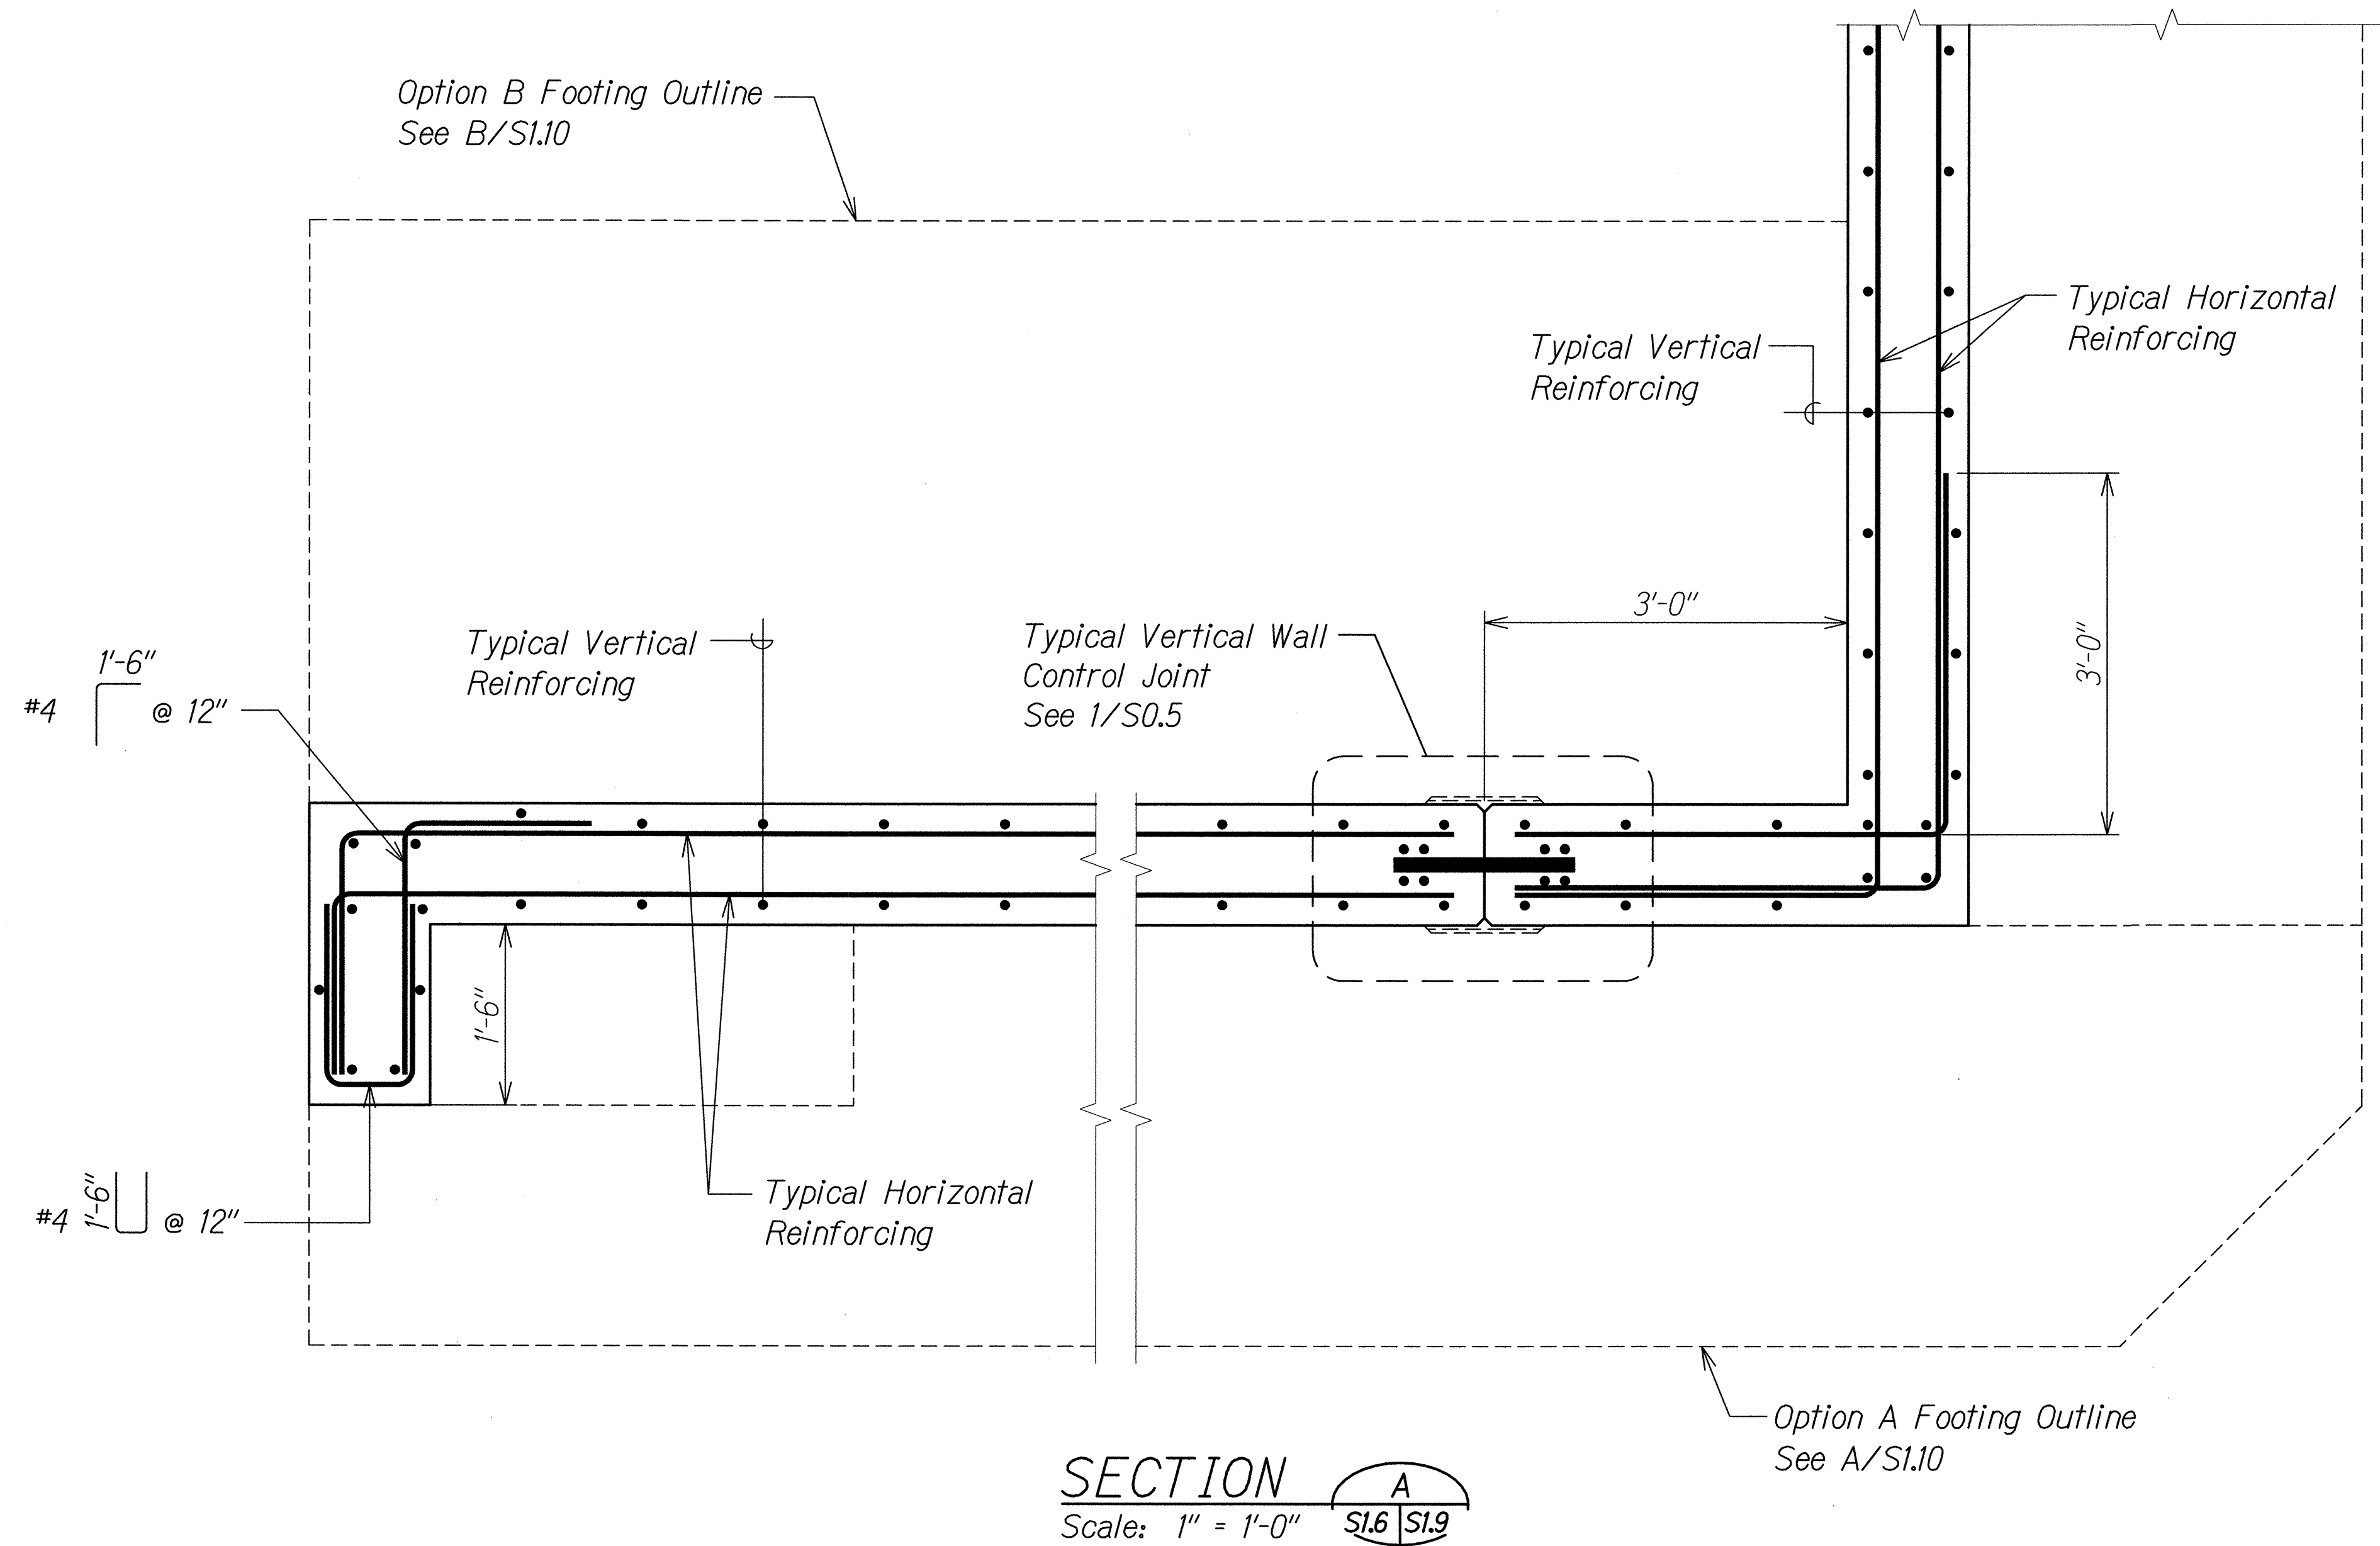

ORIGINAL PLAN	SURVEY PLOTTED BY	DATE
NOTE BOOK	DRAWN BY	" "
	TRACED BY	" "
	DESIGNED BY	" "
	QUANTITIES BY	" "
	CHECKED BY	" "

DRAWING NAME: Z:\00 ONGOING\12-026-FARRINGTON HWY NAKAKULI TO HALEAKALA-JULEHAWA.CAD\07-17-13 FINAL 100% FHU-S107.DWG PLOT TIME: 07-16-13, 4:11 PM

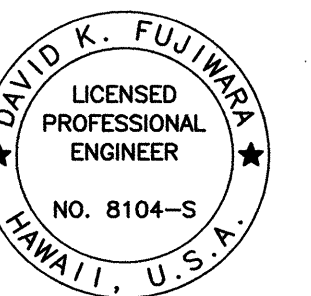

THIS WORK WAS PREPARED BY ME
OR UNDER MY SUPERVISION.
David K. Fujiwara
KSF, INC. APRIL 30, 2014
LIC. EXP. DATE

STATE OF HAWAII
DEPARTMENT OF TRANSPORTATION
HIGHWAYS DIVISION

SECTION


**FARRINGTON HIGHWAY INTERSECTION IMPROVEMENTS
AT NAKAKULI AVENUE AND HALEAKALA AVENUE
Federal-Aid Project No. STP-093-1(22)**

Scale: As Shown Date: April 2013


SHEET No. **S1.9** OF 10 SHEETS

FED. ROAD DIST. NO.	STATE	FED. AID PROJ. NO.	FISCAL YEAR	SHEET NO.	TOTAL SHEETS
HAWAII	HAW.	STP-093-1(22)	2013	184	230

Note:
If existing wall footing interferes with footing of Option A, refer to Option B.

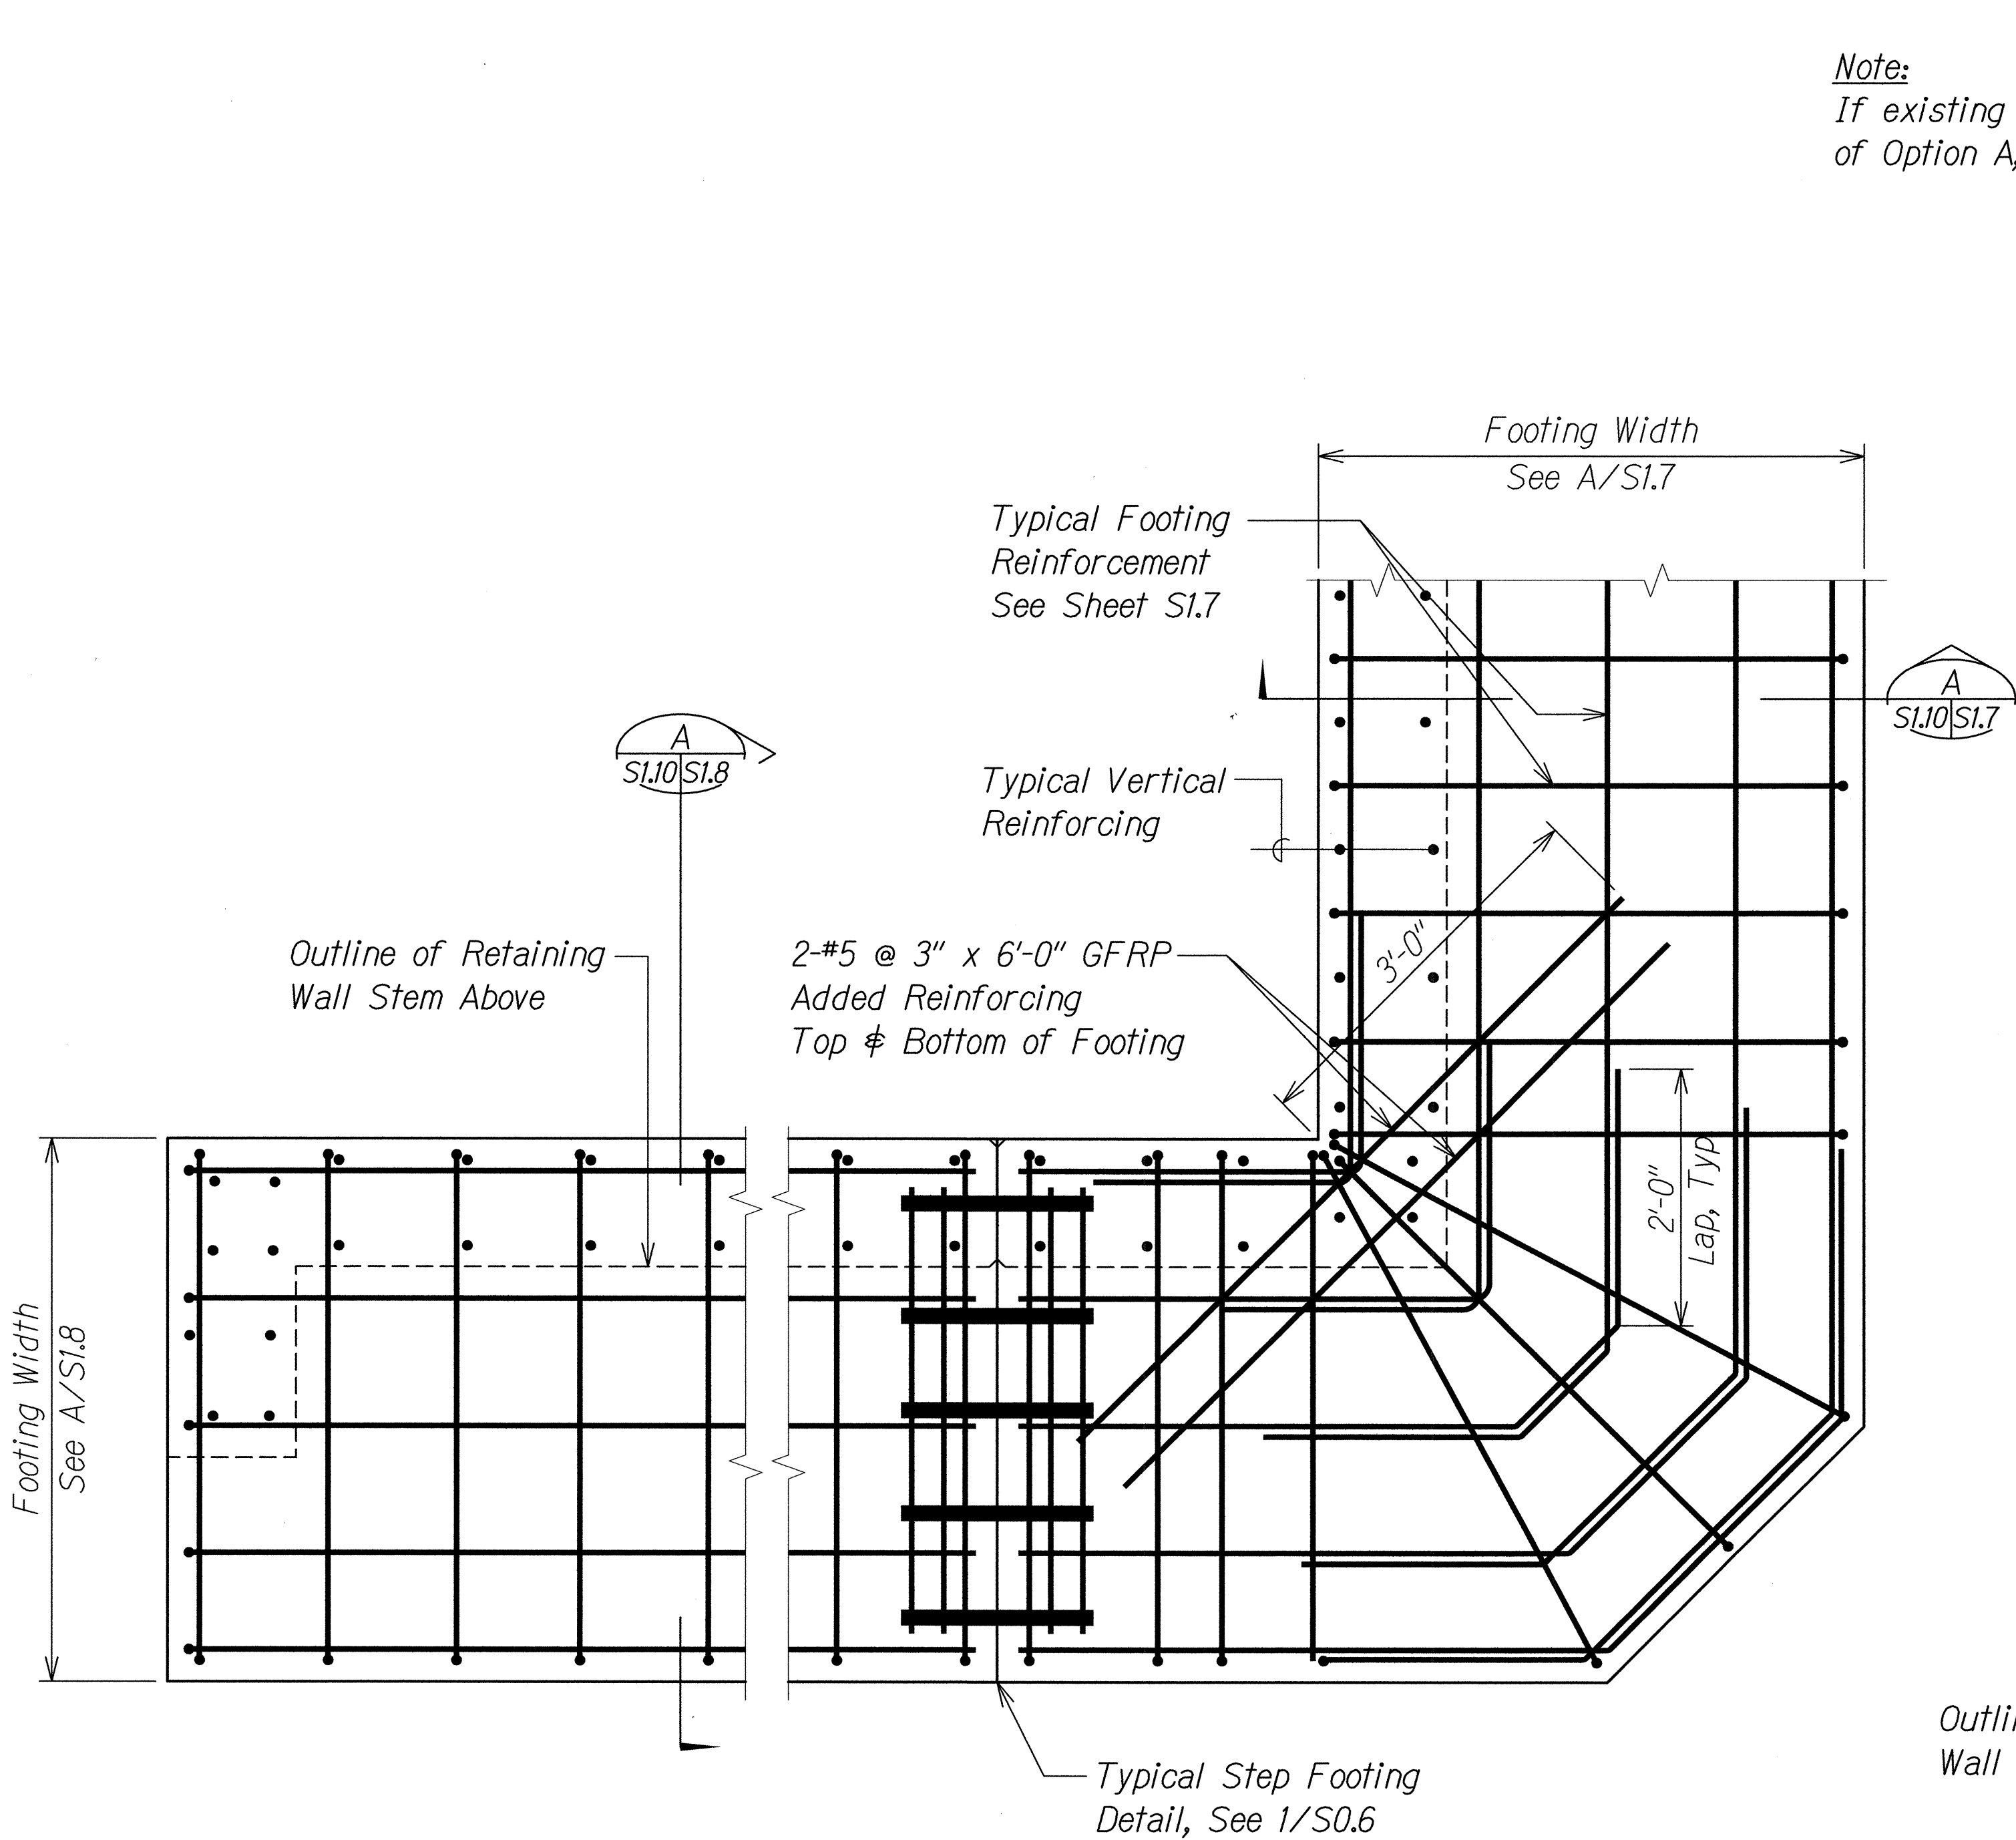


SECTION - OPTION A
Scale: 1" = 1'-0"
S1.9

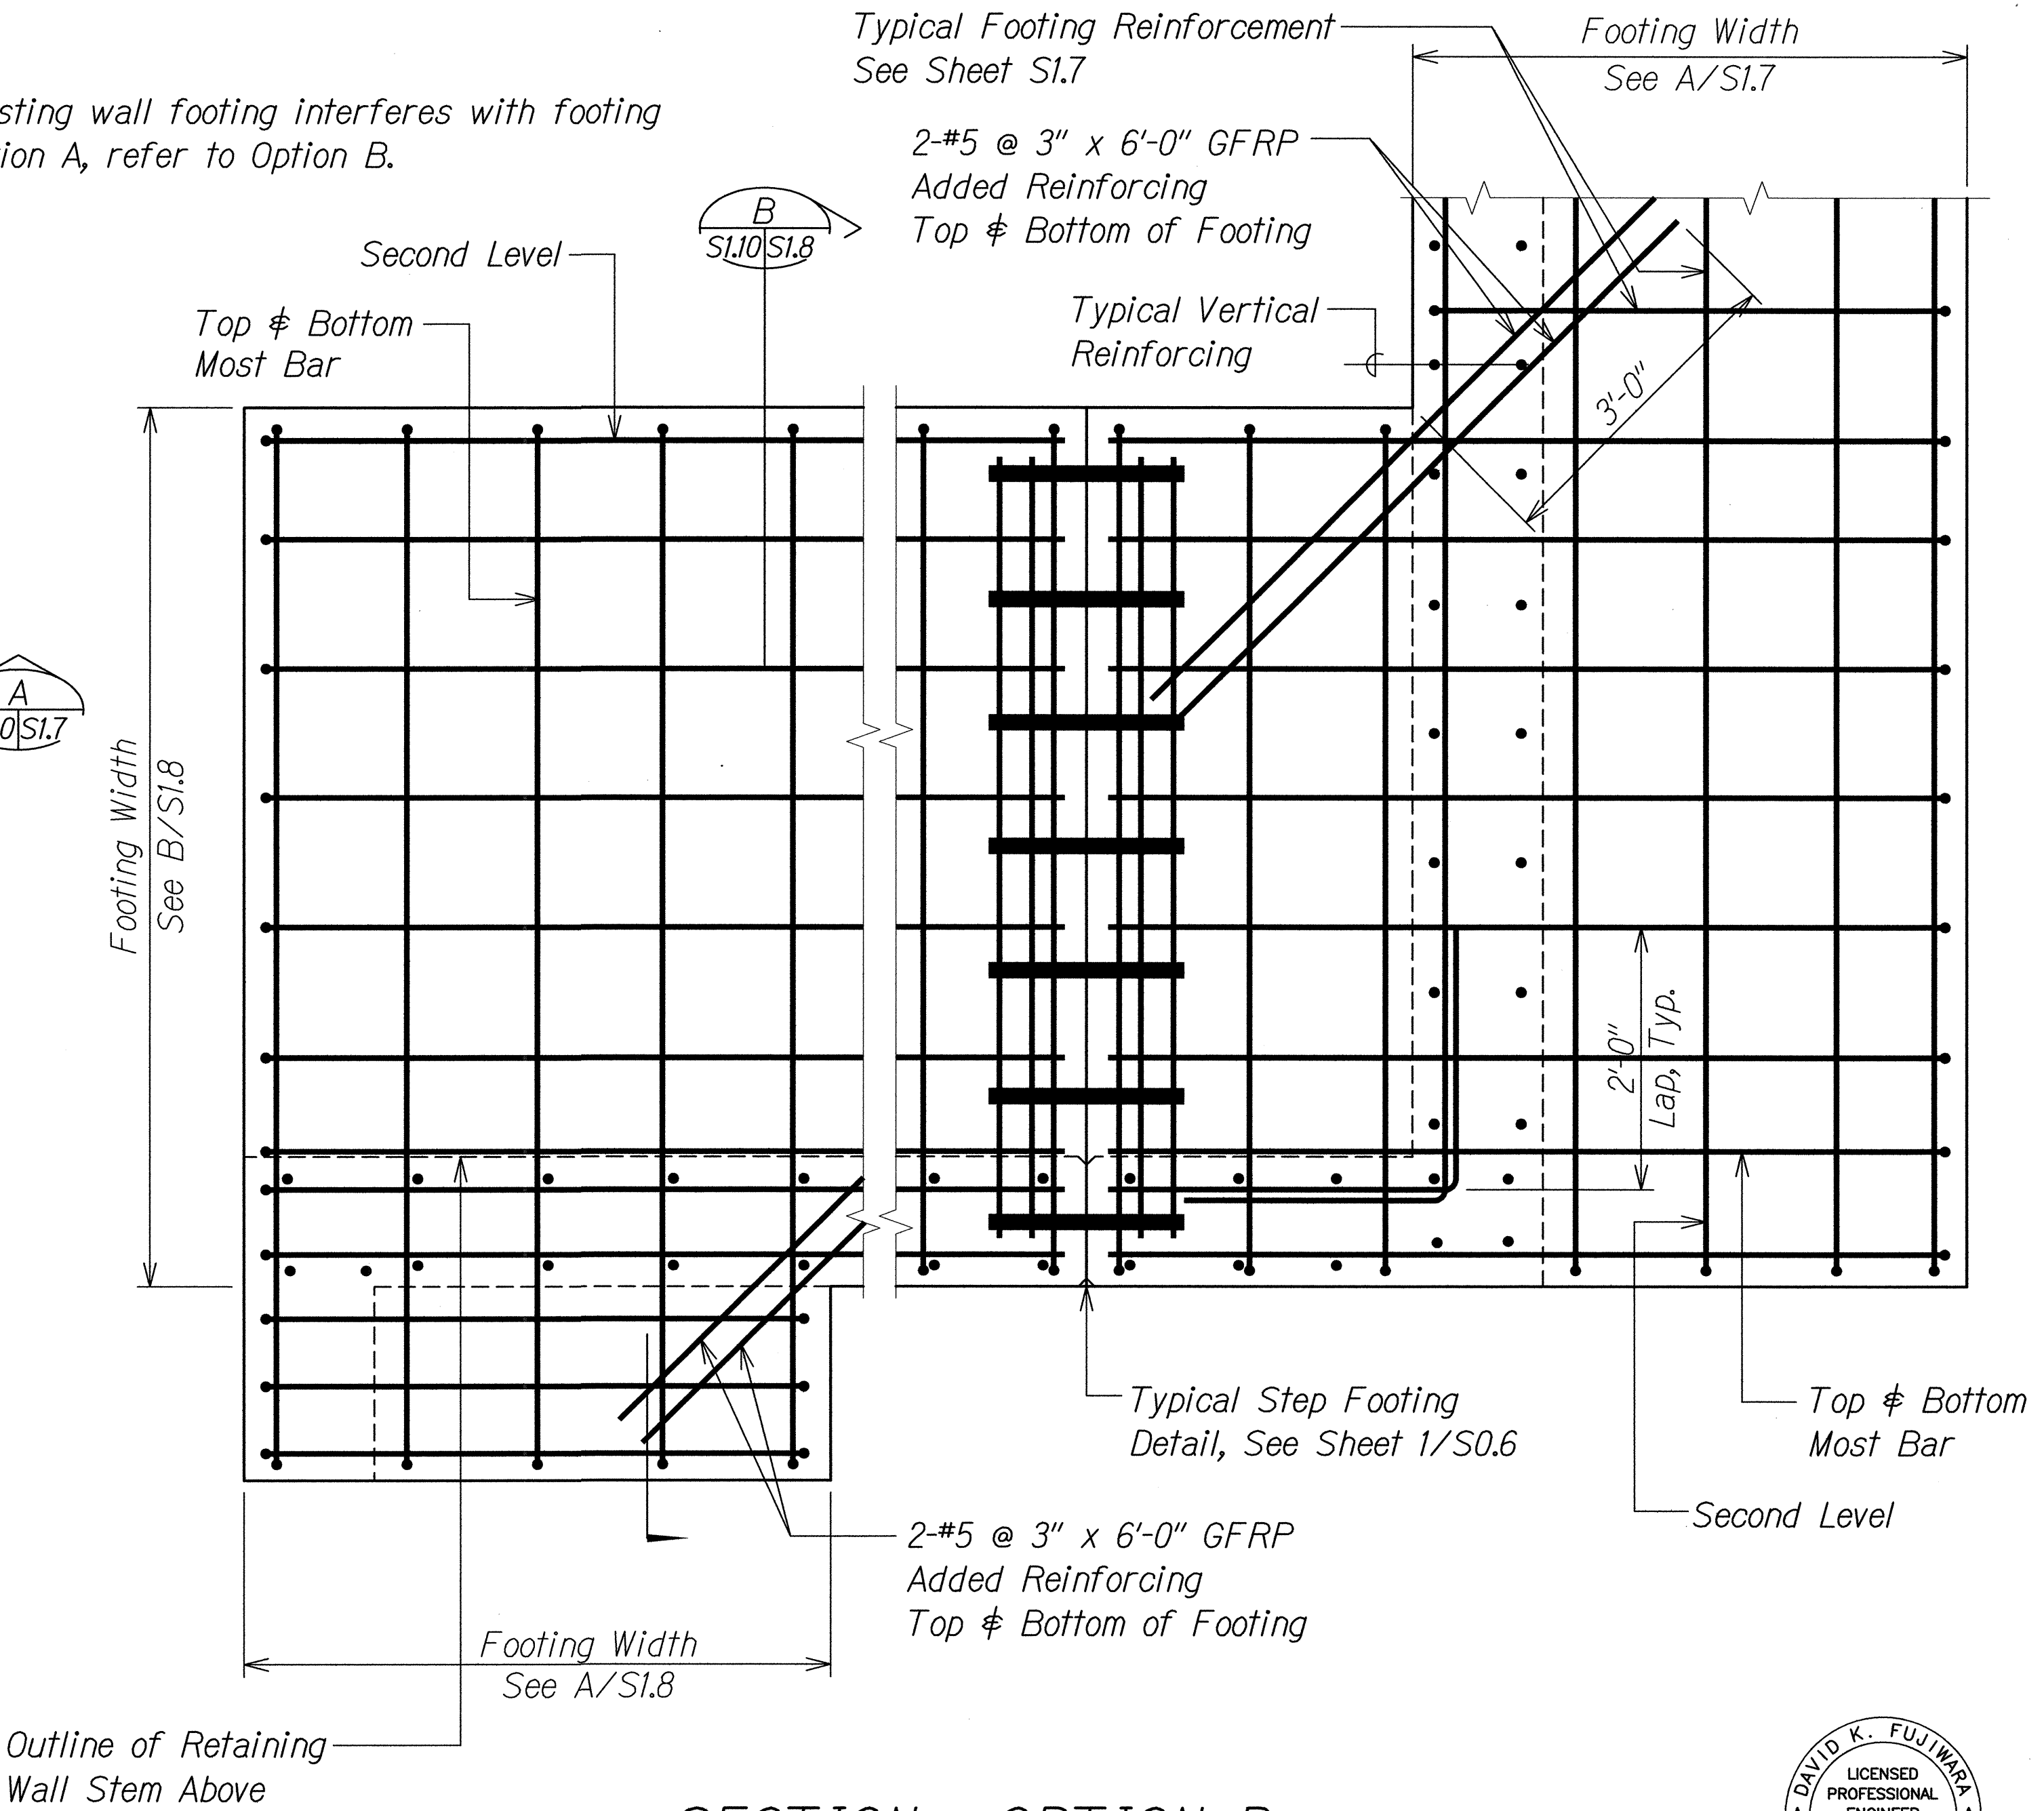

SECTION - OPTION B
Scale: 1" = 1'-0"
S1.9

ORIGINAL PLAN	DATE
NOTE BOOK	
DESIGNED BY	
CHECKED BY	
QUANTITIES BY	
NO.	

DRAWING NAME: Z:\00 ONGOING\12-026-FARRINGTON HWY NAKAKULI TO HALEAKALA-UEHAWA\CAD\07-17-13 FINAL 100% FHU-S107.DWG PLOT TIME: 07-16-13, 4:12 PM

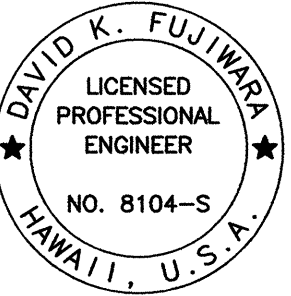

THIS WORK WAS PREPARED BY ME
OR UNDER MY SUPERVISION.
David K. Fujiwara
KSF, INC. APRIL 30, 2014
LIC. EXP. DATE

STATE OF HAWAII
DEPARTMENT OF TRANSPORTATION
HIGHWAYS DIVISION


SECTIONS

FARRINGTON HIGHWAY INTERSECTION IMPROVEMENTS
AT NAKAKULI AVENUE AND HALEAKALA AVENUE
Federal-Aid Project No. STP-093-1(22)
Scale: As Shown Date: April 2013
SHEET No. S1.10 OF 10 SHEETS

FED. ROAD DIST. NO.	STATE	FED. AID PROJ. NO.	FISCAL YEAR	SHEET NO.	TOTAL SHEETS
HAWAII	HAW.	STP-093-I(22)	2013	185	230


DRAWING NAME: Z:\00 ONGOING\12-026-FARRINGTON HWY NANAKULI TO HALEAKALA-UEHAWA\CAD\07-17-13 FINAL 100% FHU-S201.DWG PLOT TIME: 07-18-13, 4:12 PM

ORIGINAL PLAN	SURVEY PLOTTED BY	DATE
NOTE BOOK	DESIGNED BY	
	QUANTITIES BY	
	CHECKED BY	

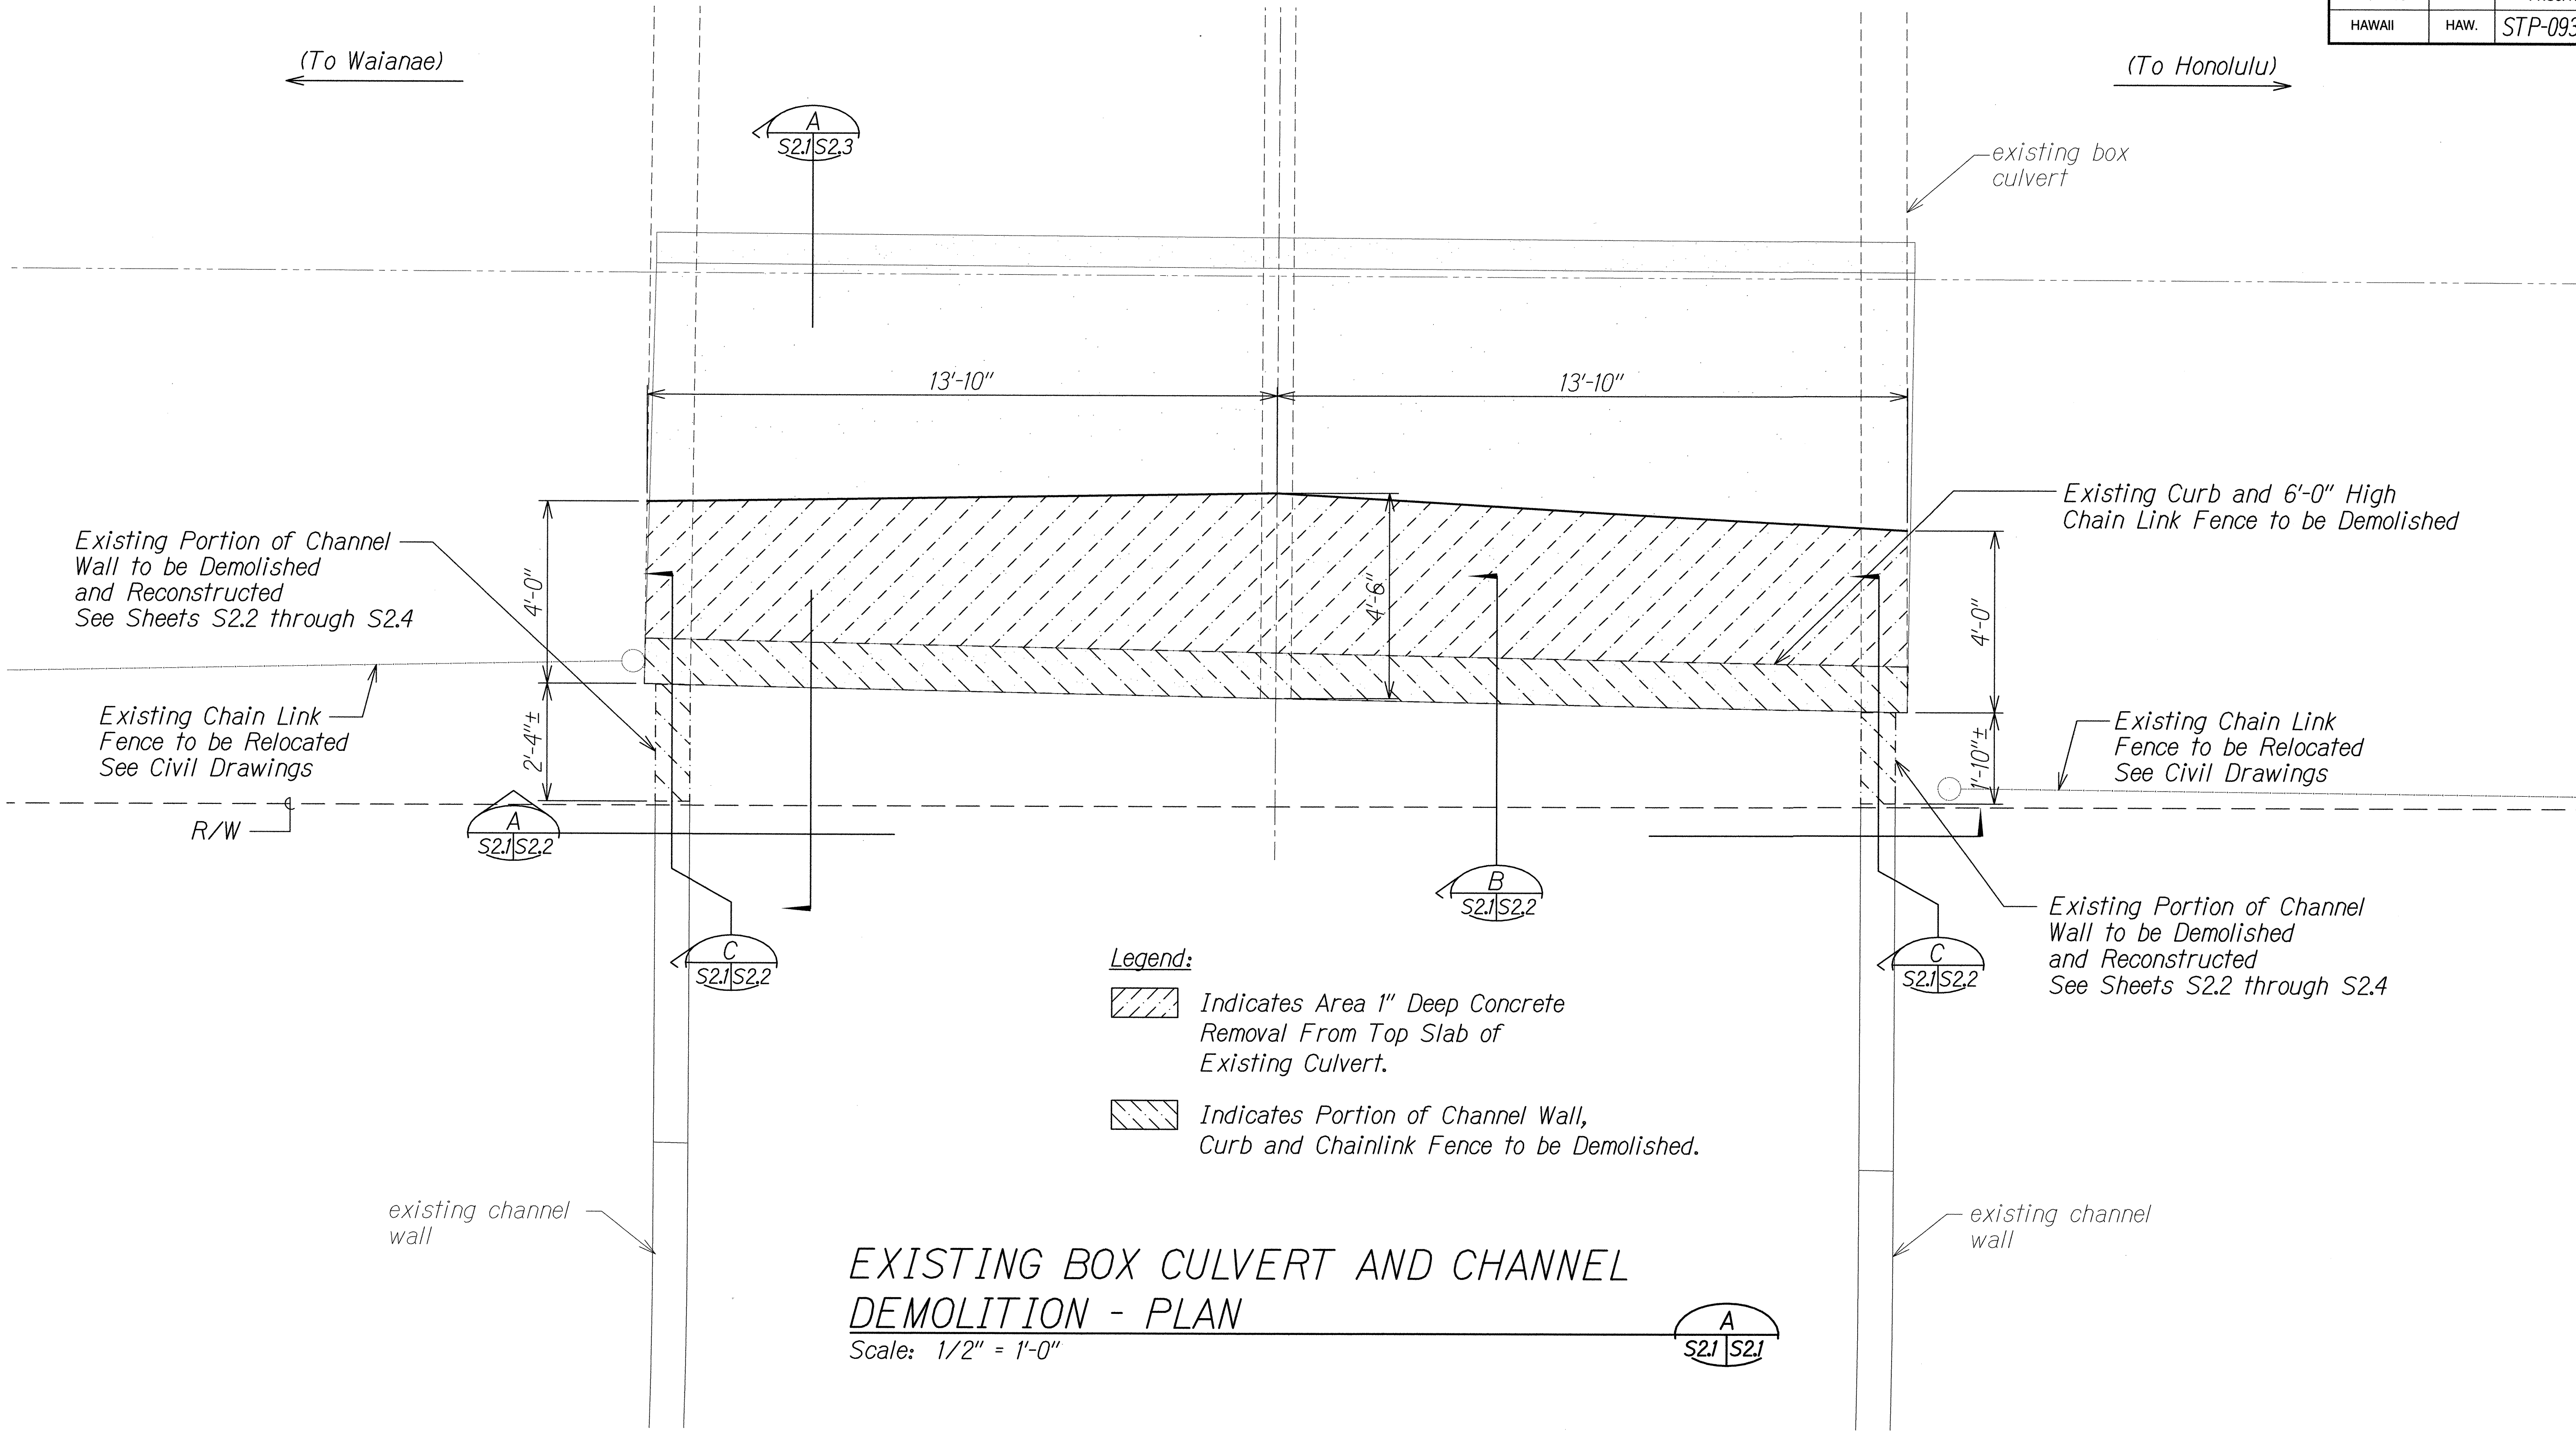

EXISTING BOX CULVERT AND CHANNEL DEMOLITION - PLAN

Scale: 1/2" = 1'-0"

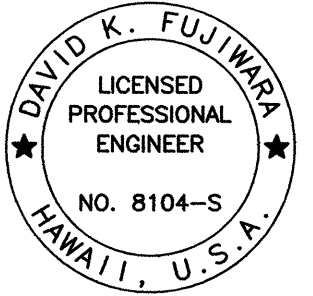

THIS WORK WAS PREPARED BY ME
OR UNDER MY SUPERVISION.
David K. Fujiwara
KSF, INC. APRIL 30, 2014
LIC. EXP. DATE

STATE OF HAWAII
DEPARTMENT OF TRANSPORTATION
HIGHWAYS DIVISION

EXISTING BOX CULVERT AND CHANNEL
DEMOLITION - PLAN


FARRINGTON HIGHWAY INTERSECTION IMPROVEMENTS
AT NANAKULI AVENUE AND HALEAKALA AVENUE
Federal-Aid Project No. STP-093-I(22)
Scale: As Shown Date: April 2013

SHEET No. S21 OF 4 SHEETS

FED. ROAD DIST. NO.	STATE	FED. AID PROJ. NO.	FISCAL YEAR	SHEET NO.	TOTAL SHEETS
HAWAII	HAW.	STP-093-1(22)	2013	186	230

To Waianae


To Honolulu

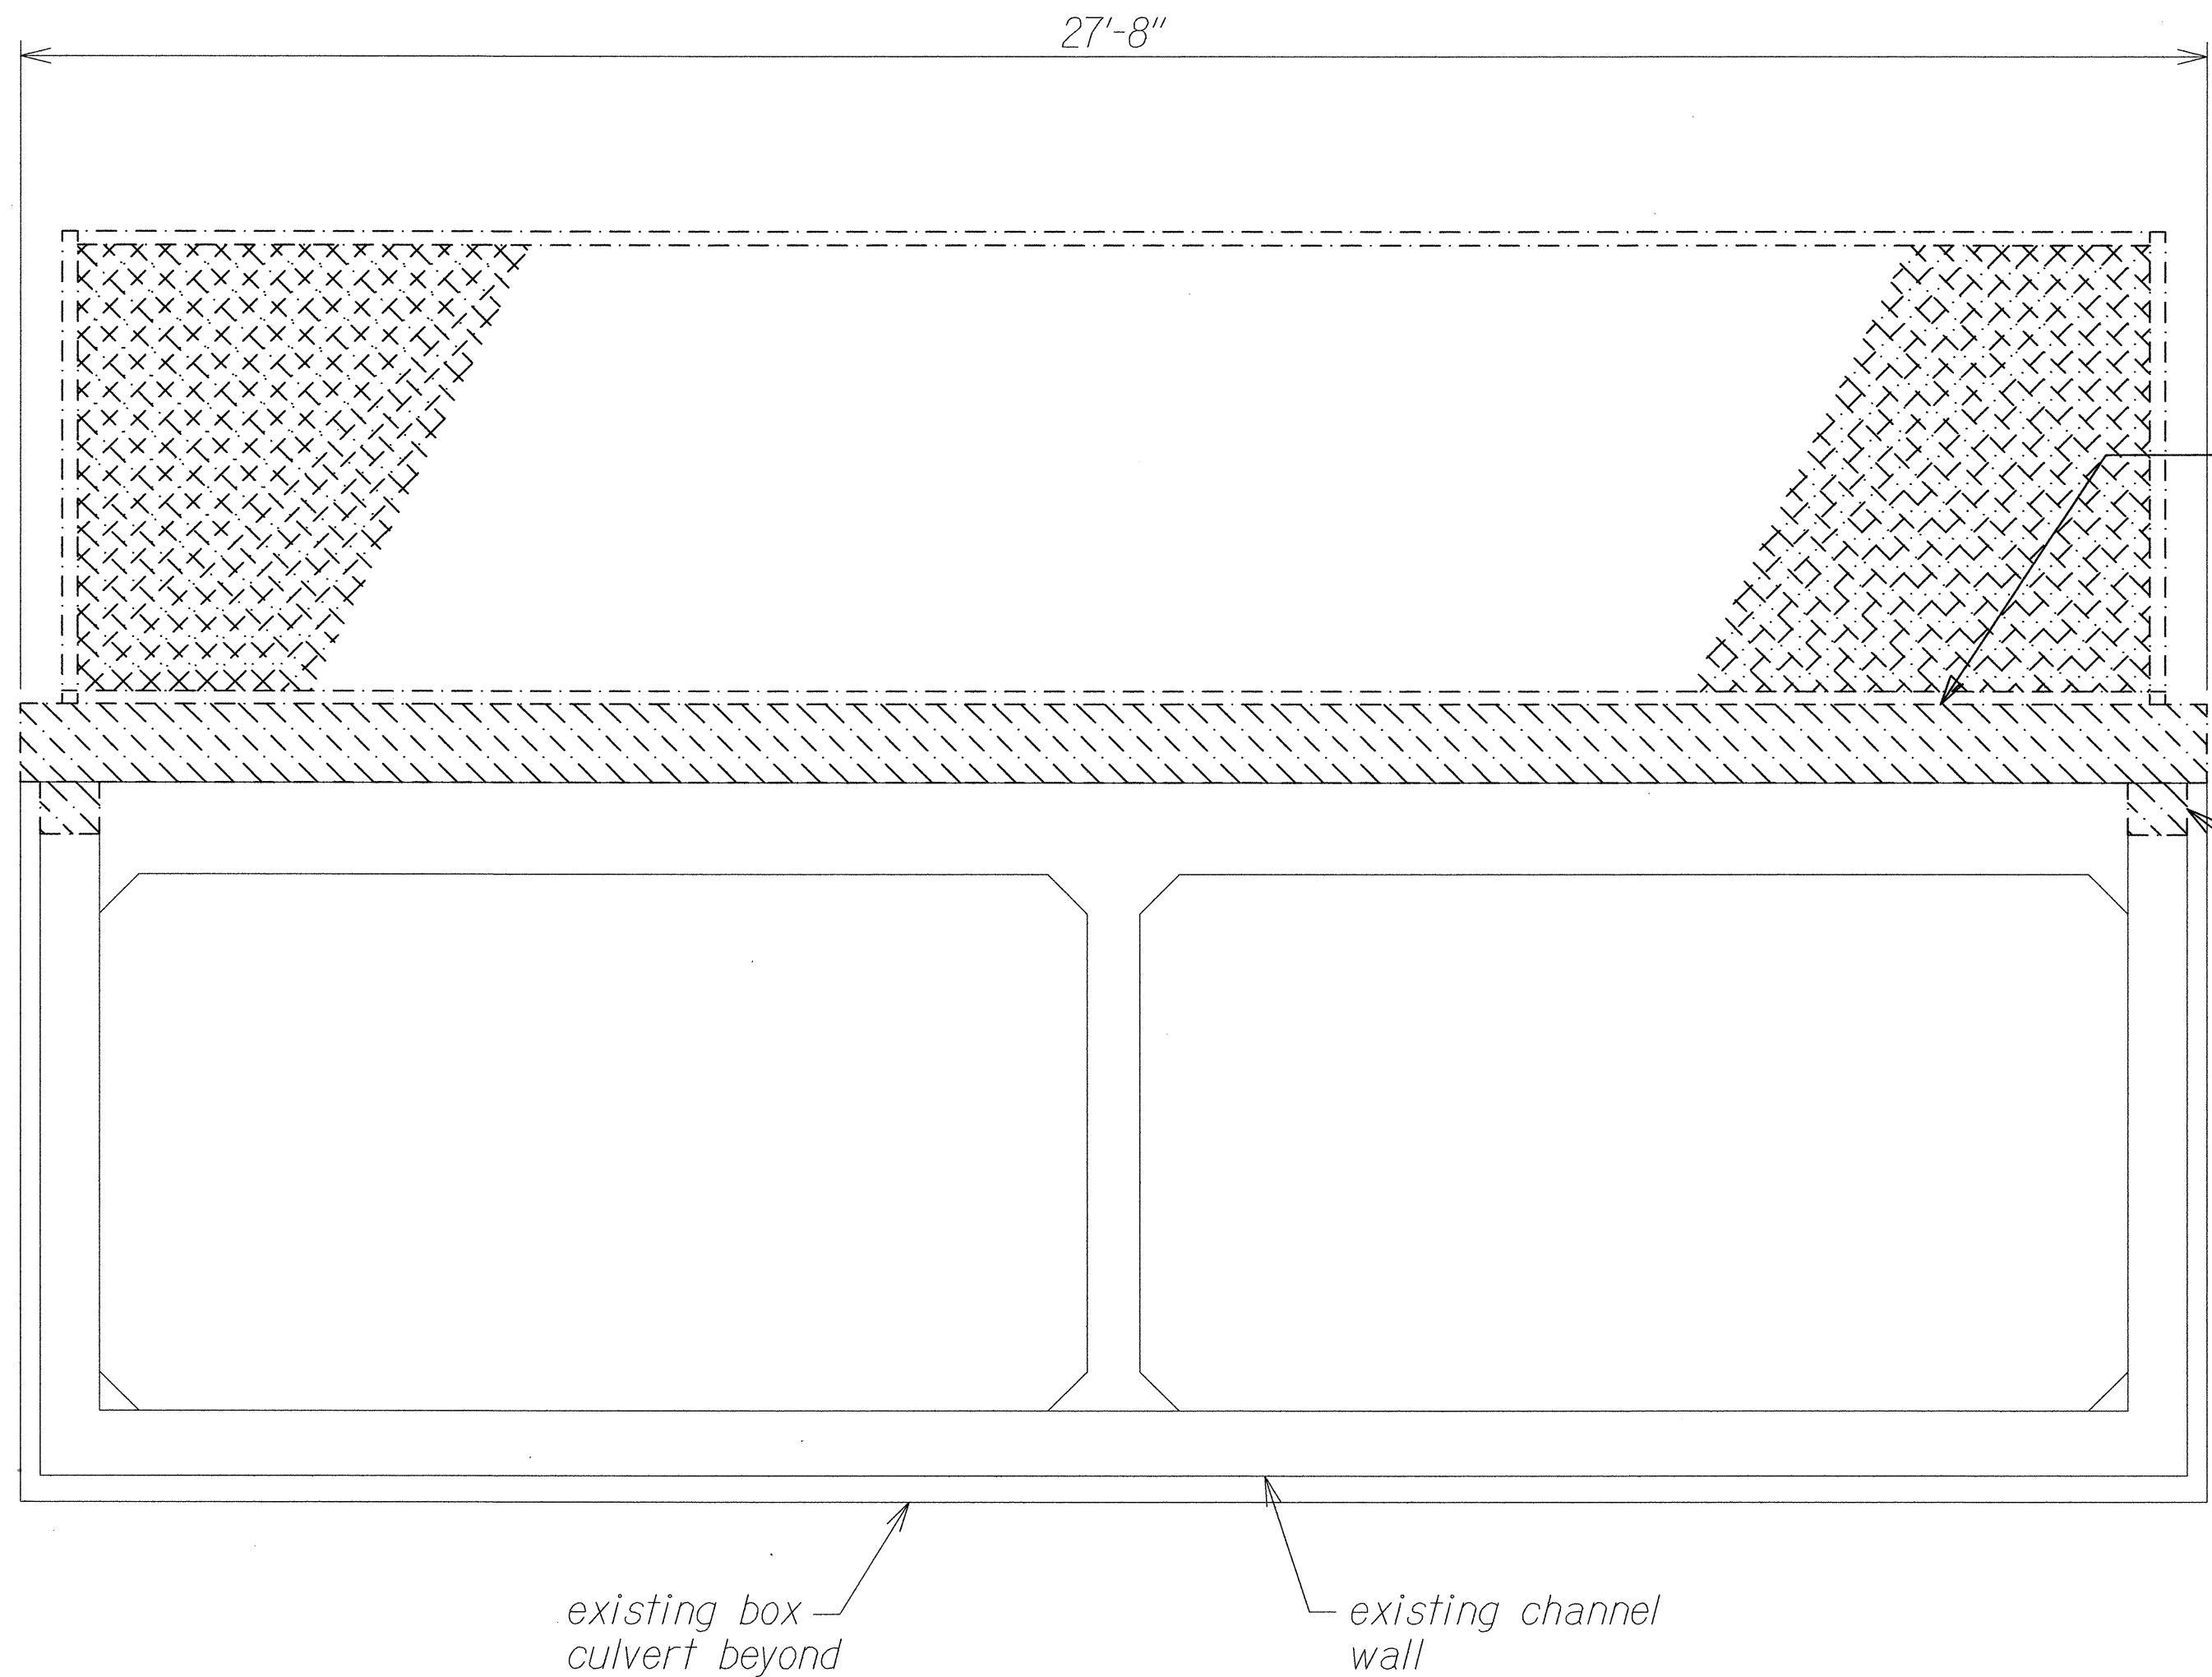


Existing Curb and 6'-0" High Chain Link Fence to be Demolished See B S2.2 S2.2

Existing Portion of Channel Wall to be Demolished and Reconstructed See Sheets S2.3 and S2.4

BOX CULVERT DEMOLITION - ELEVATION A S2.1 S2.2 Scale: 1/2" = 1'-0"

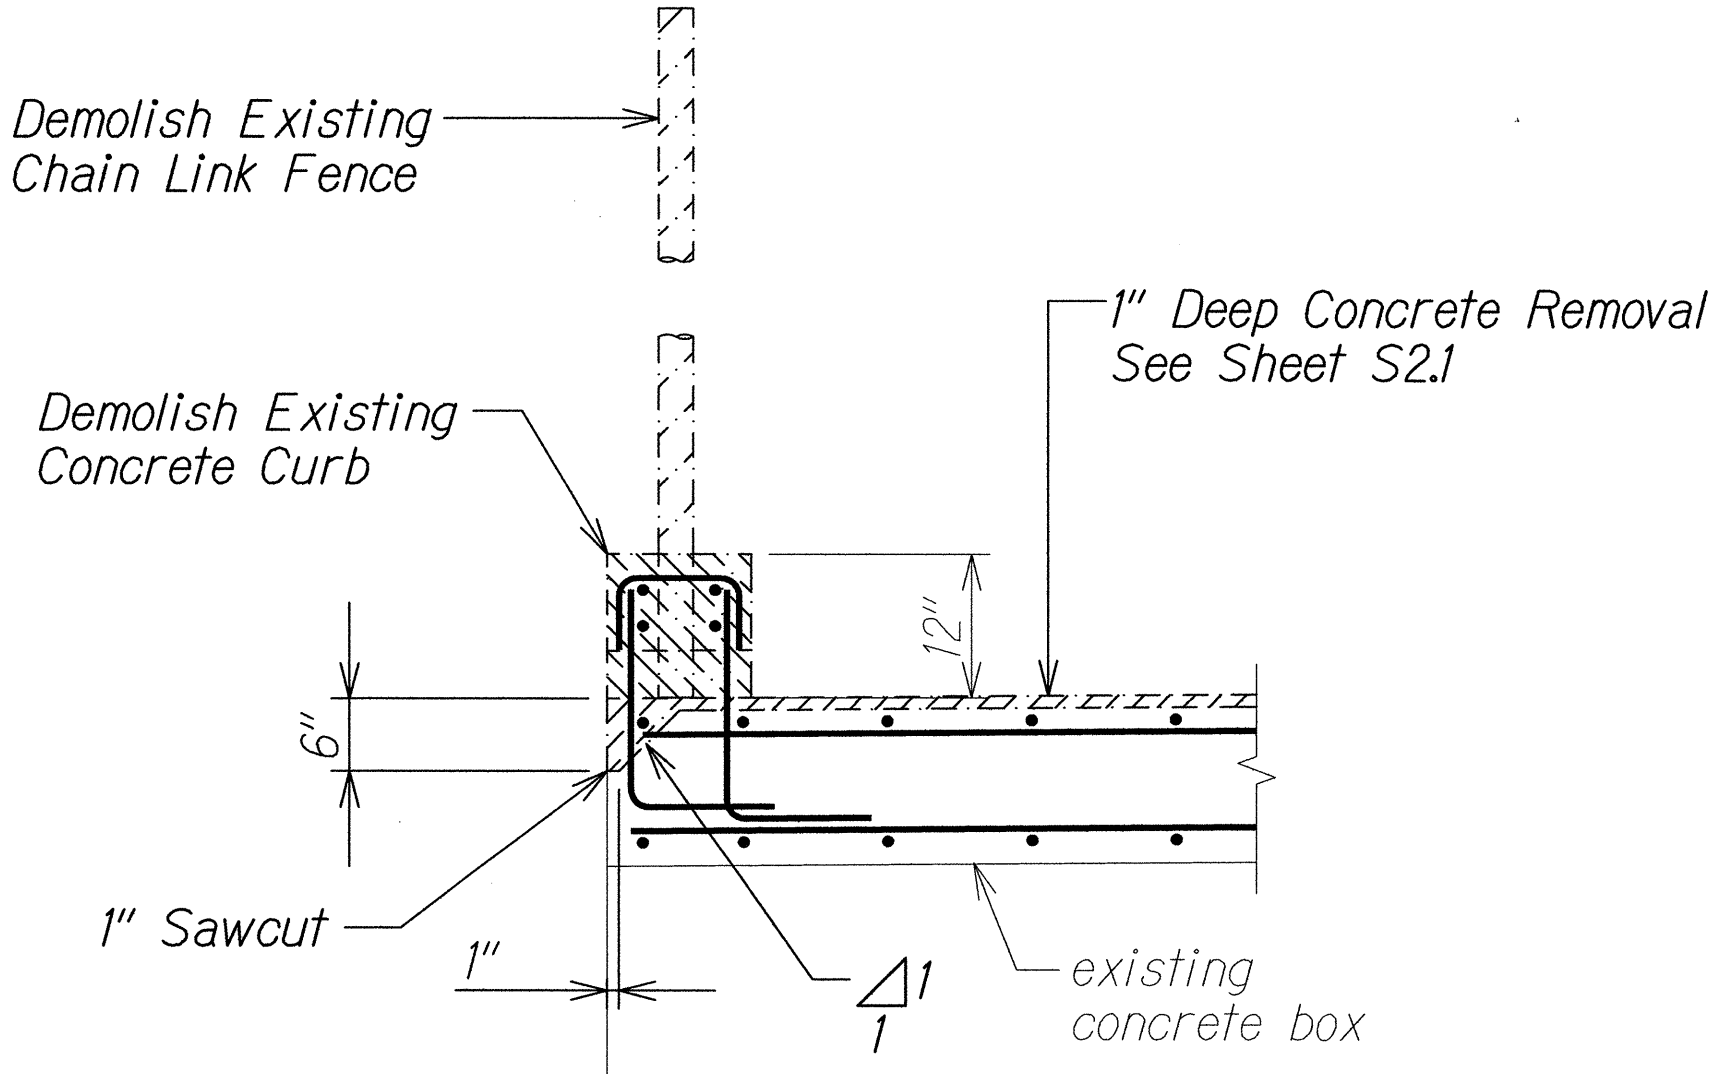

SECTION B B S2.1 S2.2 Scale: 3/4" = 1'-0" S2.2

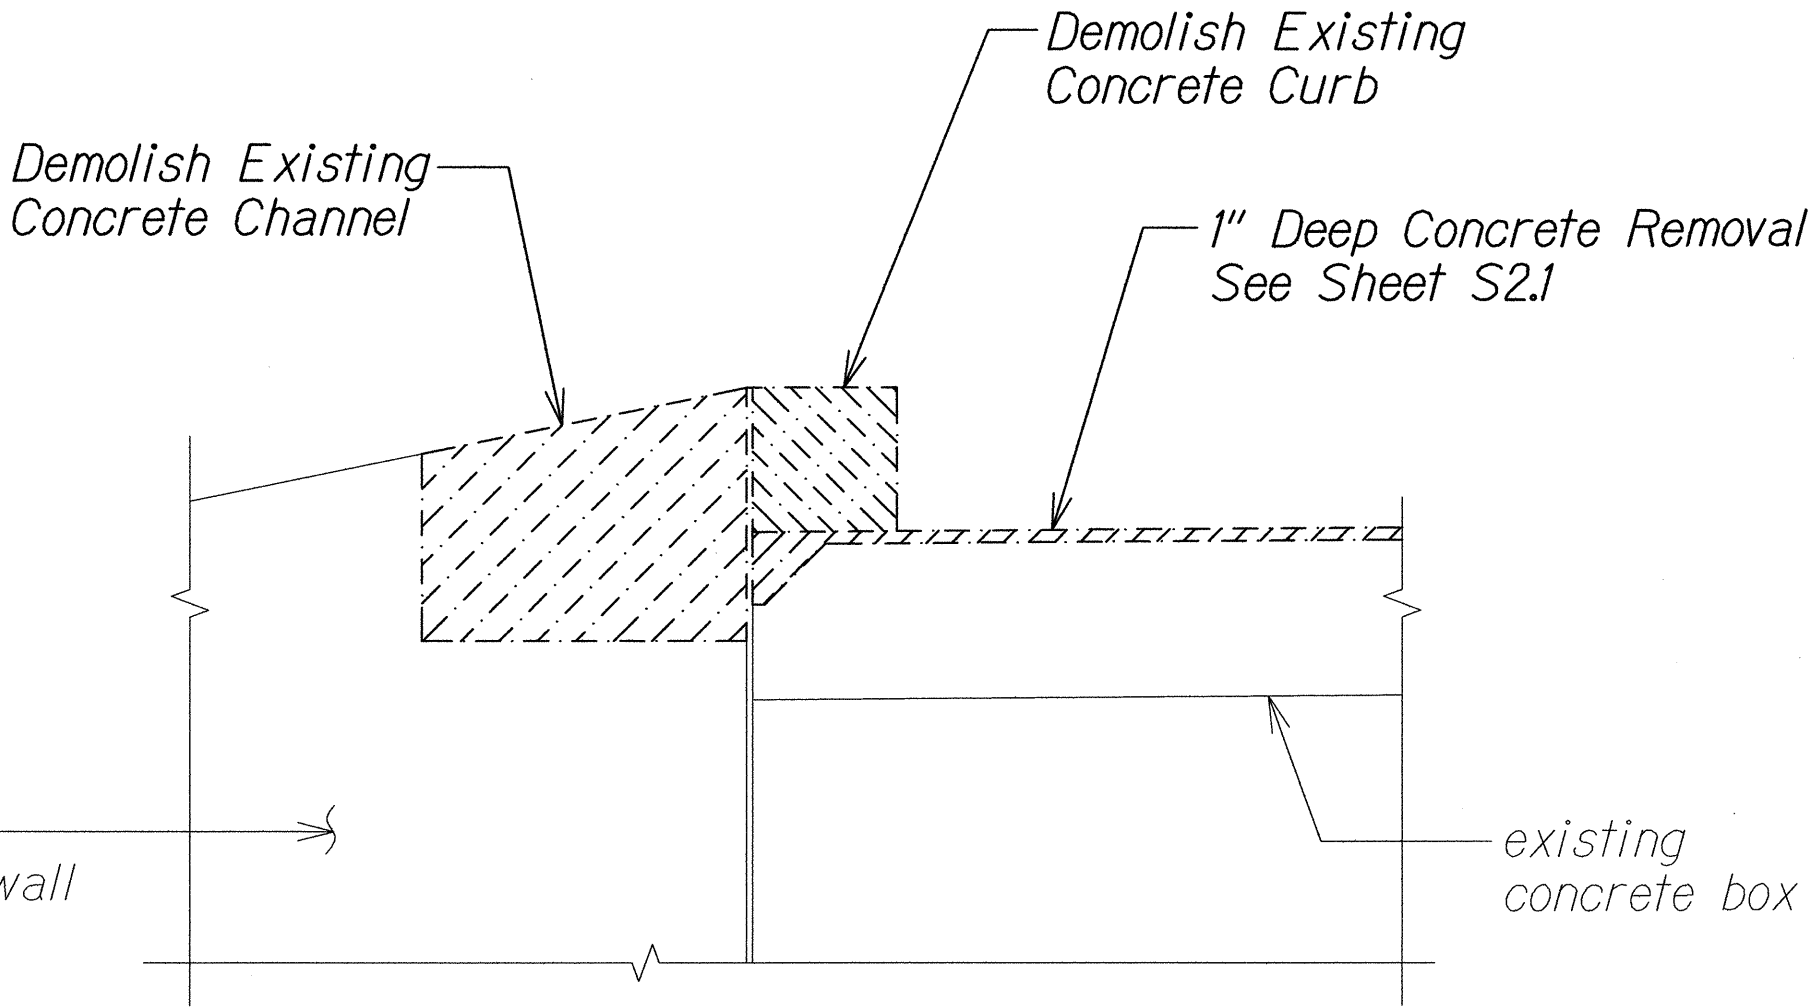

SECTION C C S2.2 S2.2 Scale: 3/4" = 1'-0"

ORIGINAL PLAN	SURVEY DATED BY	DATE
NOTE BOOK	DRAWN BY	
No.	DESIGNED BY	
	QUANTITIES BY	
	CHECKED BY	

DRAWING NAME: Z:\00 ONCONG\12-026-FARRINGTON HWY NAKAKULI TO HALEAKALA-UEHAWA\CAD\07-17-13 FINAL 100% FHU-S201.DWG PLOT TIME: 07-16-13, 4:12 PM




THIS WORK WAS PREPARED BY ME OR UNDER MY SUPERVISION.
David K. Fujiwara
 KSF, INC. APRIL 30, 2014
 LIC. EXP. DATE


STATE OF HAWAII
DEPARTMENT OF TRANSPORTATION
HIGHWAYS DIVISION
EXISTING BOX CULVERT AND CHANNEL DEMOLITION - SECTIONS
FARRINGTON HIGHWAY INTERSECTION IMPROVEMENTS
AT NAKAKULI AVENUE AND HALEAKALA AVENUE
Federal-Aid Project No. STP-093-1(22)
Scale: As Shown Date: April 2013
SHEET No. S22 OF 4 SHEETS

186

FED. ROAD DIST. NO.	STATE	FED. AID PROJ. NO.	FISCAL YEAR	SHEET NO.	TOTAL SHEETS
HAWAII	HAW.	STP-093-1(22)	2013	188	230

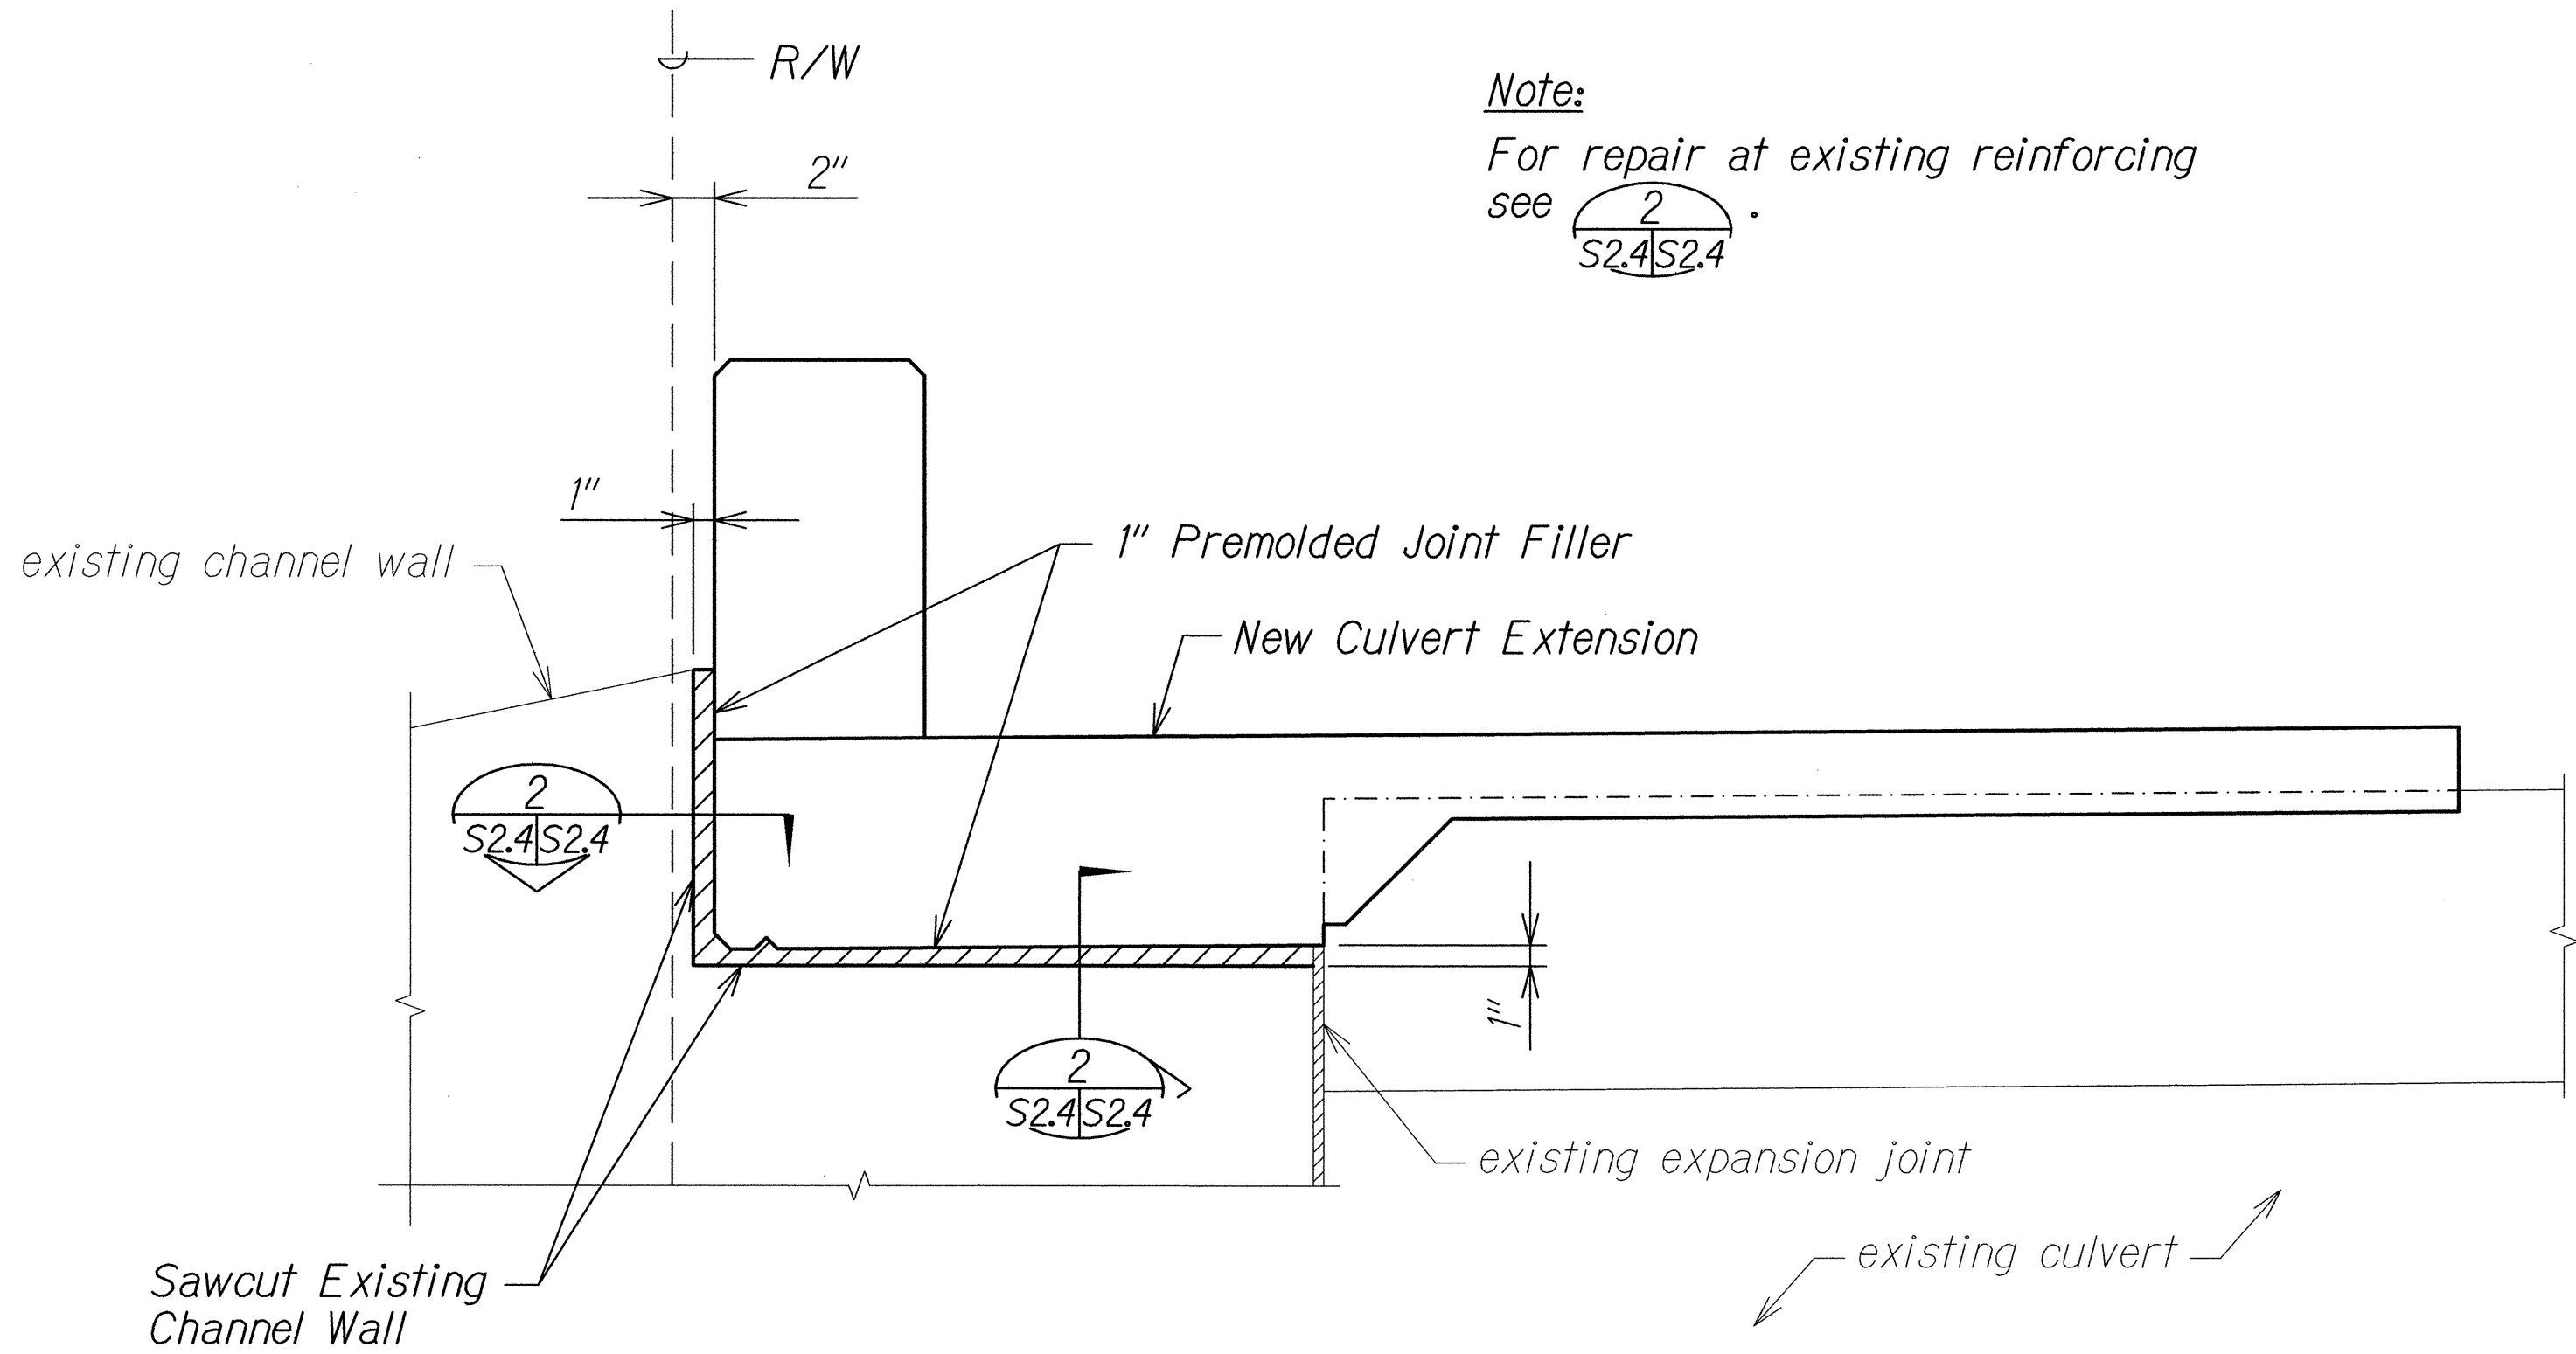


EXISTING CHANNEL DEMOLITION $\frac{1}{S2.3|S2.4}$
Scale: 1 1/2" = 1'-0"

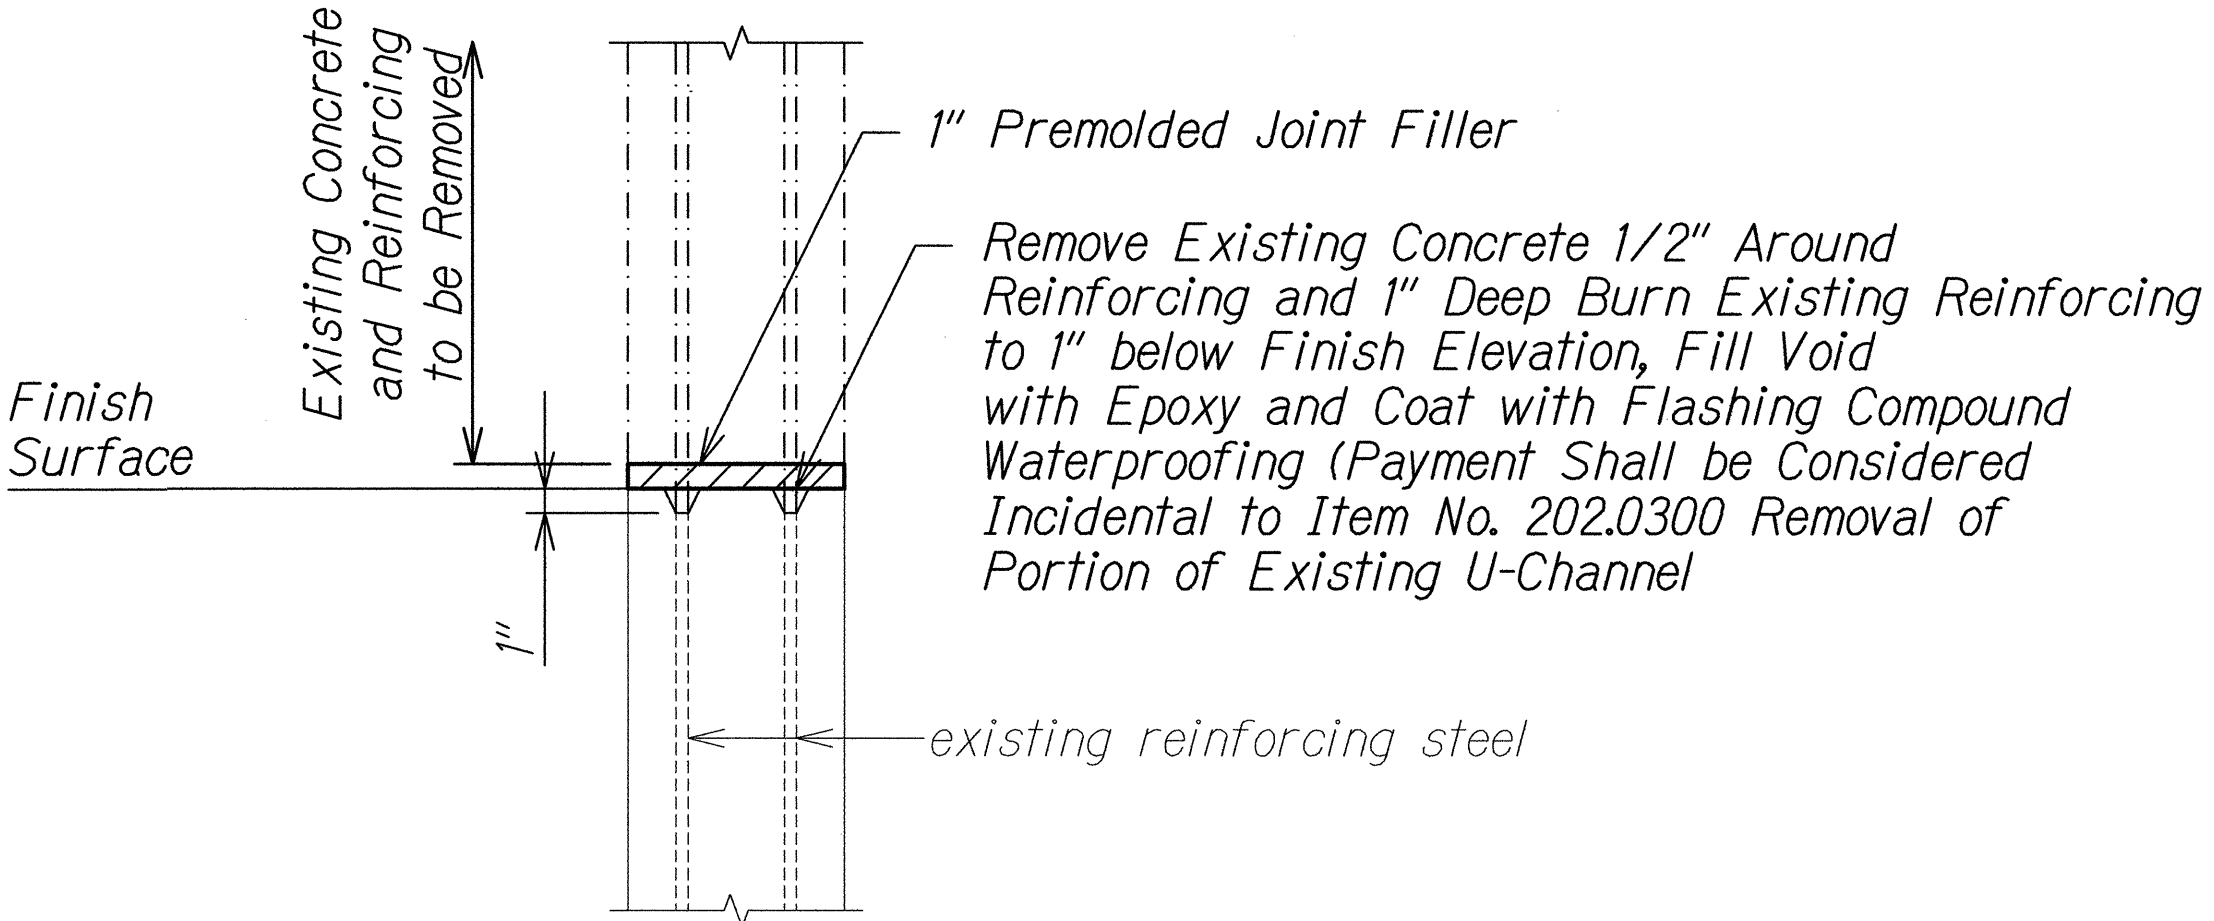

EXISTING CHANNEL DEMOLITION - DETAIL $\frac{2}{S2.4|S2.4}$
Scale: 1 1/2" = 1'-0"

ORIGINAL PLAN	DATE
NOTE BOOK	DESIGNED BY
No.	QUANTITIES BY
	CHECKED BY


DRAWING NAME: Z:\00 ONGOING\12-026-FARRINGTON HWY NAKKULI TO HALEAKALA-JLEHWA\CAD\07-17-13 FINAL 100% (FHL-S201.DWG) PLOT TIME: 07-16-13, 4:12 PM)

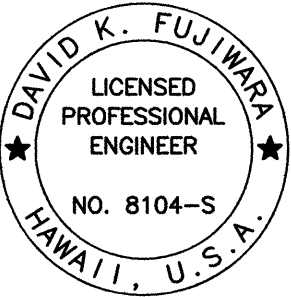

THIS WORK WAS PREPARED BY ME
OR UNDER MY SUPERVISION.
David K. Fujimura
KSF, INC. APRIL 30, 2014
LIC. EXP. DATE

STATE OF HAWAII
DEPARTMENT OF TRANSPORTATION
HIGHWAYS DIVISION
EXISTING CHANNEL DEMOLITION
DETAILS
FARRINGTON HIGHWAY INTERSECTION IMPROVEMENTS
AT NAKAKULI AVENUE AND HALEAKALA AVENUE
Federal-Aid Project No. STP-093-1(22)
Scale: As Shown Date: April 2013
SHEET No. S24 OF 4 SHEETS

FED. ROAD DIST. NO.	STATE	FED. AID PROJ. NO.	FISCAL YEAR	SHEET NO.	TOTAL SHEETS
HAWAII	HAW.	STP-093-1(22)	2013	189	230

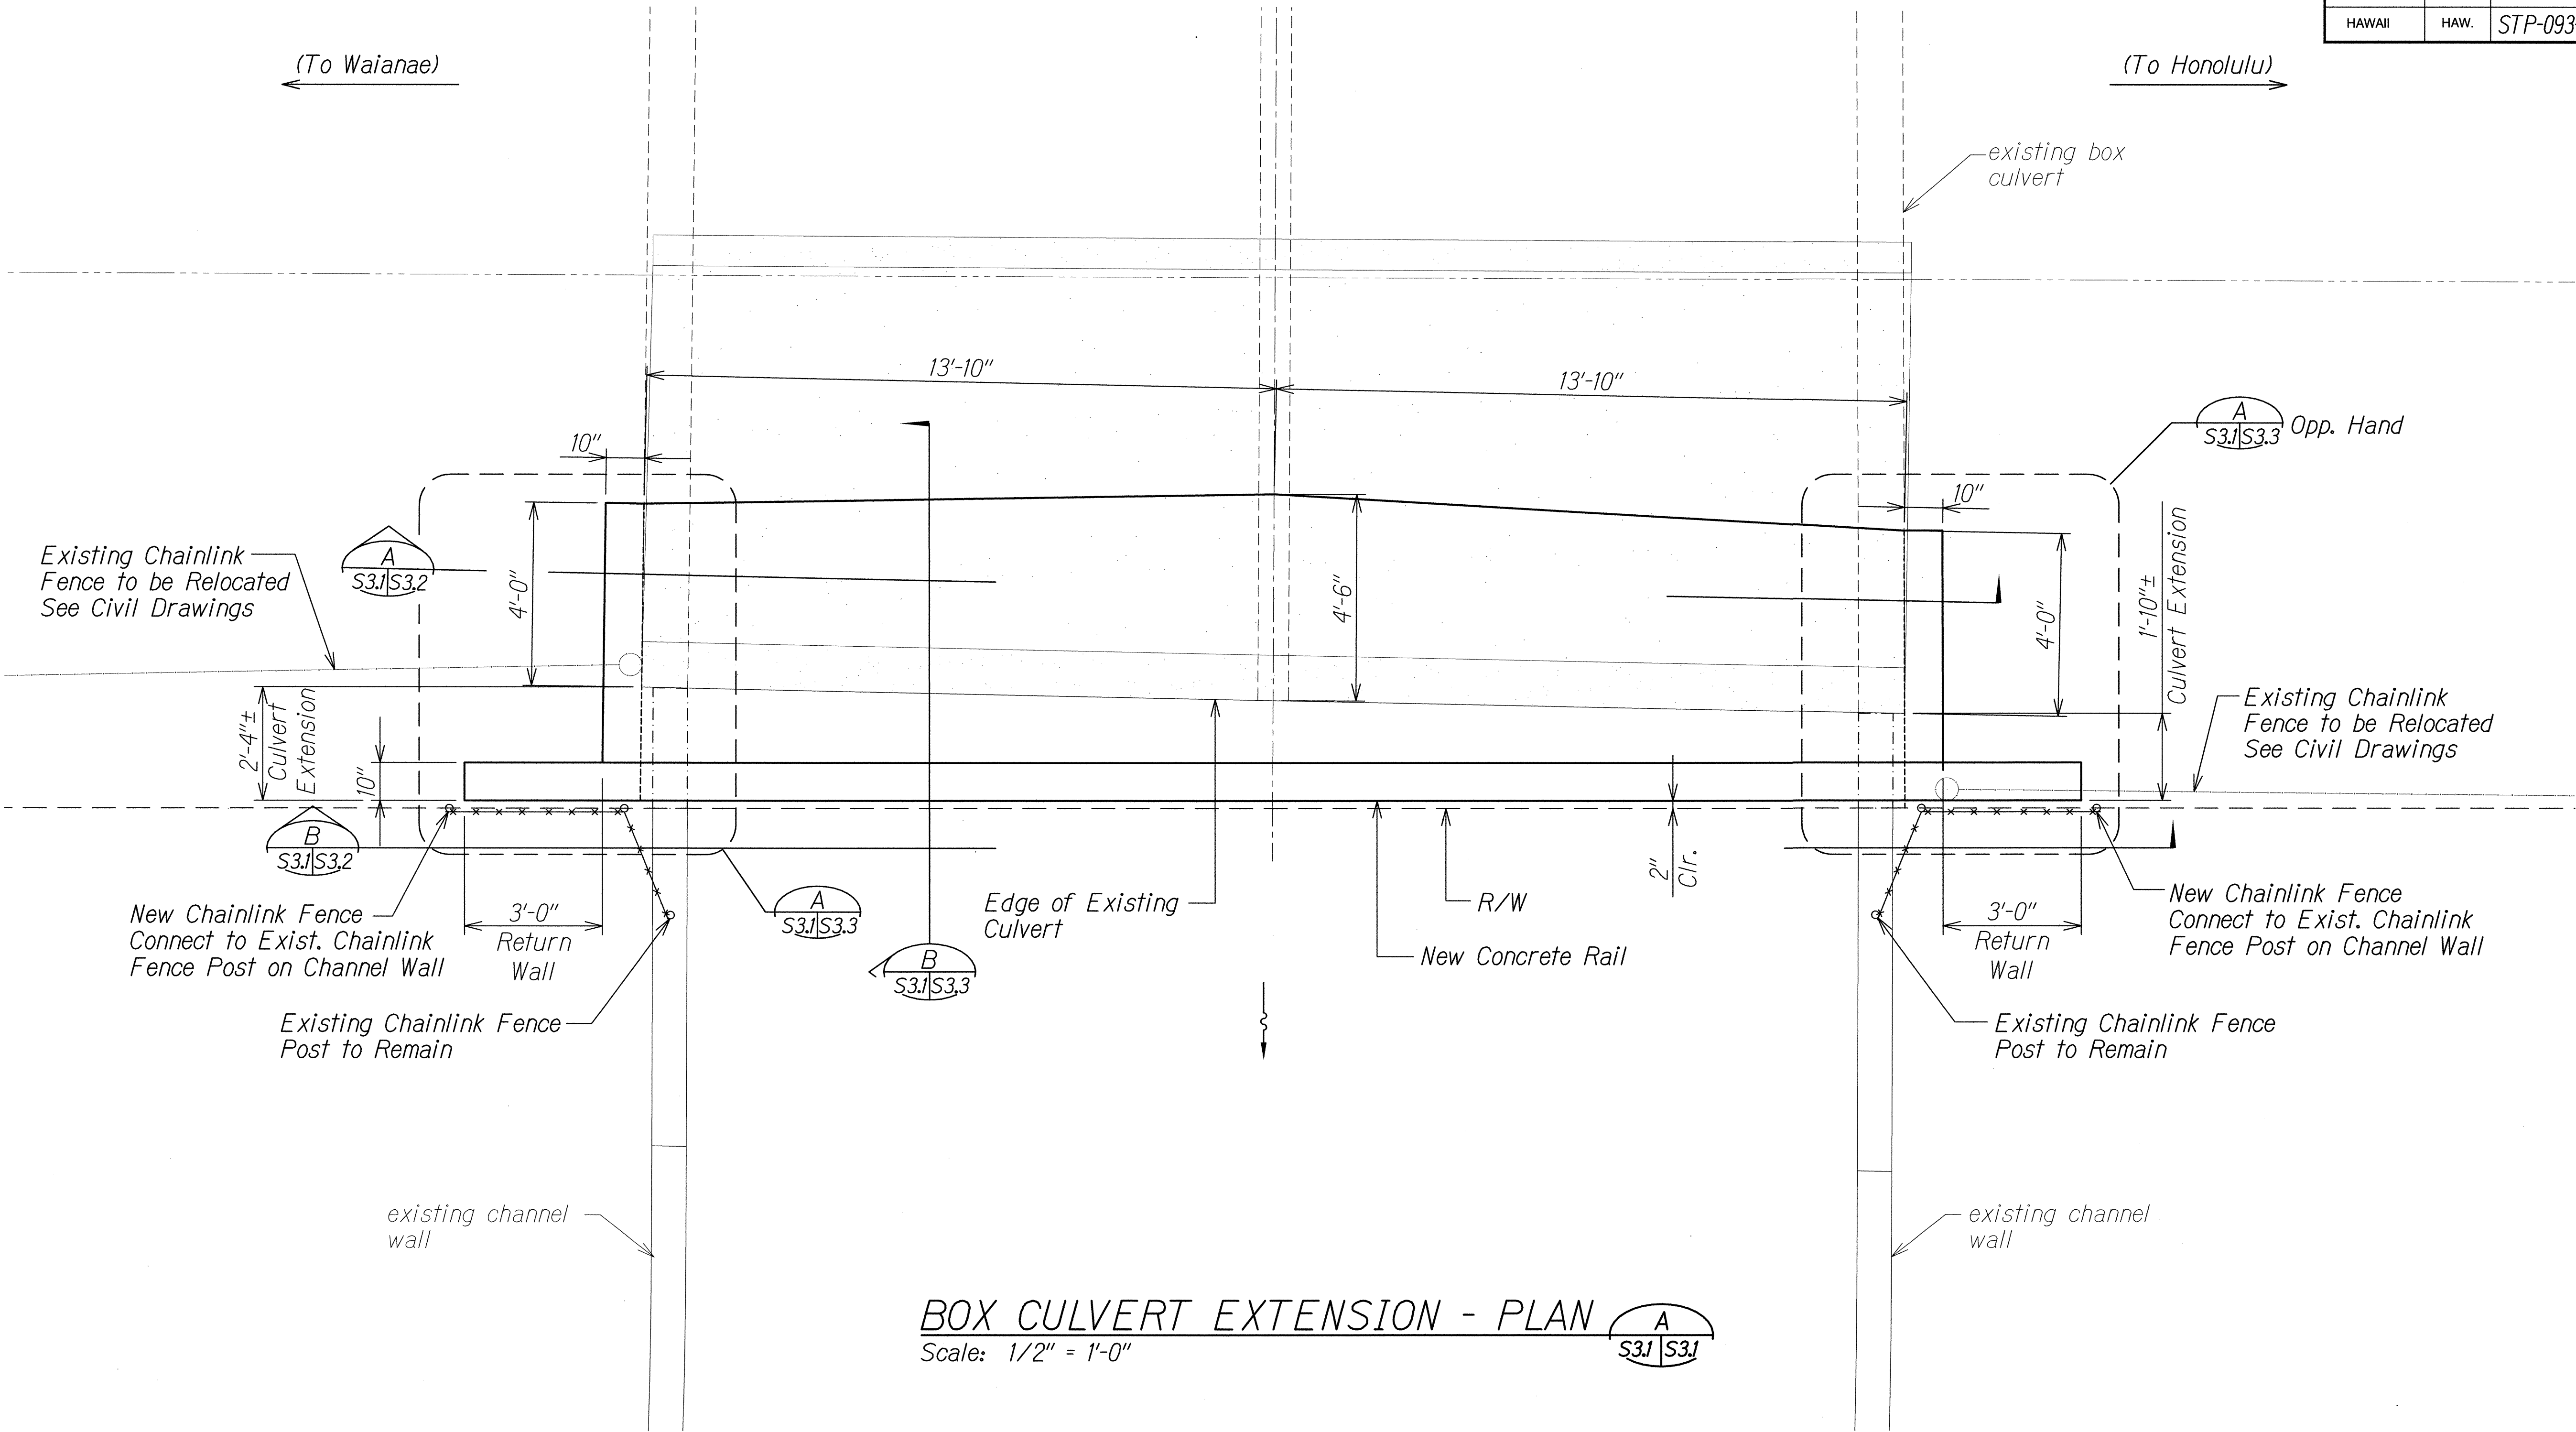

BOX CULVERT EXTENSION - PLAN
 Scale: 1/2" = 1'-0"

ORIGINAL PLAN	DATE
DESIGNED BY	
CHECKED BY	
NOTED BY	
QUANTITIES BY	
NO.	

DRAWING NAME: Z:\00 ONCONG\12-026-FARRINGTON HWY NAKAKULI TO HALEAKALA-UEHAWA\CAD\07-17-13 FINAL 100% FUU-S301.DWG PLOT TIME: 07-16-13, 4:13 PM




THIS WORK WAS PREPARED BY ME
 OR UNDER MY SUPERVISION.
David K. Fujiwara
 KSF, INC. APRIL 30, 2014
 LIC. EXP. DATE

STATE OF HAWAII
DEPARTMENT OF TRANSPORTATION
HIGHWAYS DIVISION


BOX CULVERT EXTENSION - PLAN

FARRINGTON HIGHWAY INTERSECTION IMPROVEMENTS
AT NAKAKULI AVENUE AND HALEAKALA AVENUE
Federal-Aid Project No. STP-093-1(22)
Scale: As Shown Date: April 2013
SHEET No. S31 OF 5 SHEETS

FED. ROAD DIST. NO.	STATE	FED. AID PROJ. NO.	FISCAL YEAR	SHEET NO.	TOTAL SHEETS
HAWAII	HAW.	STP-093-1(22)	2013	190	230

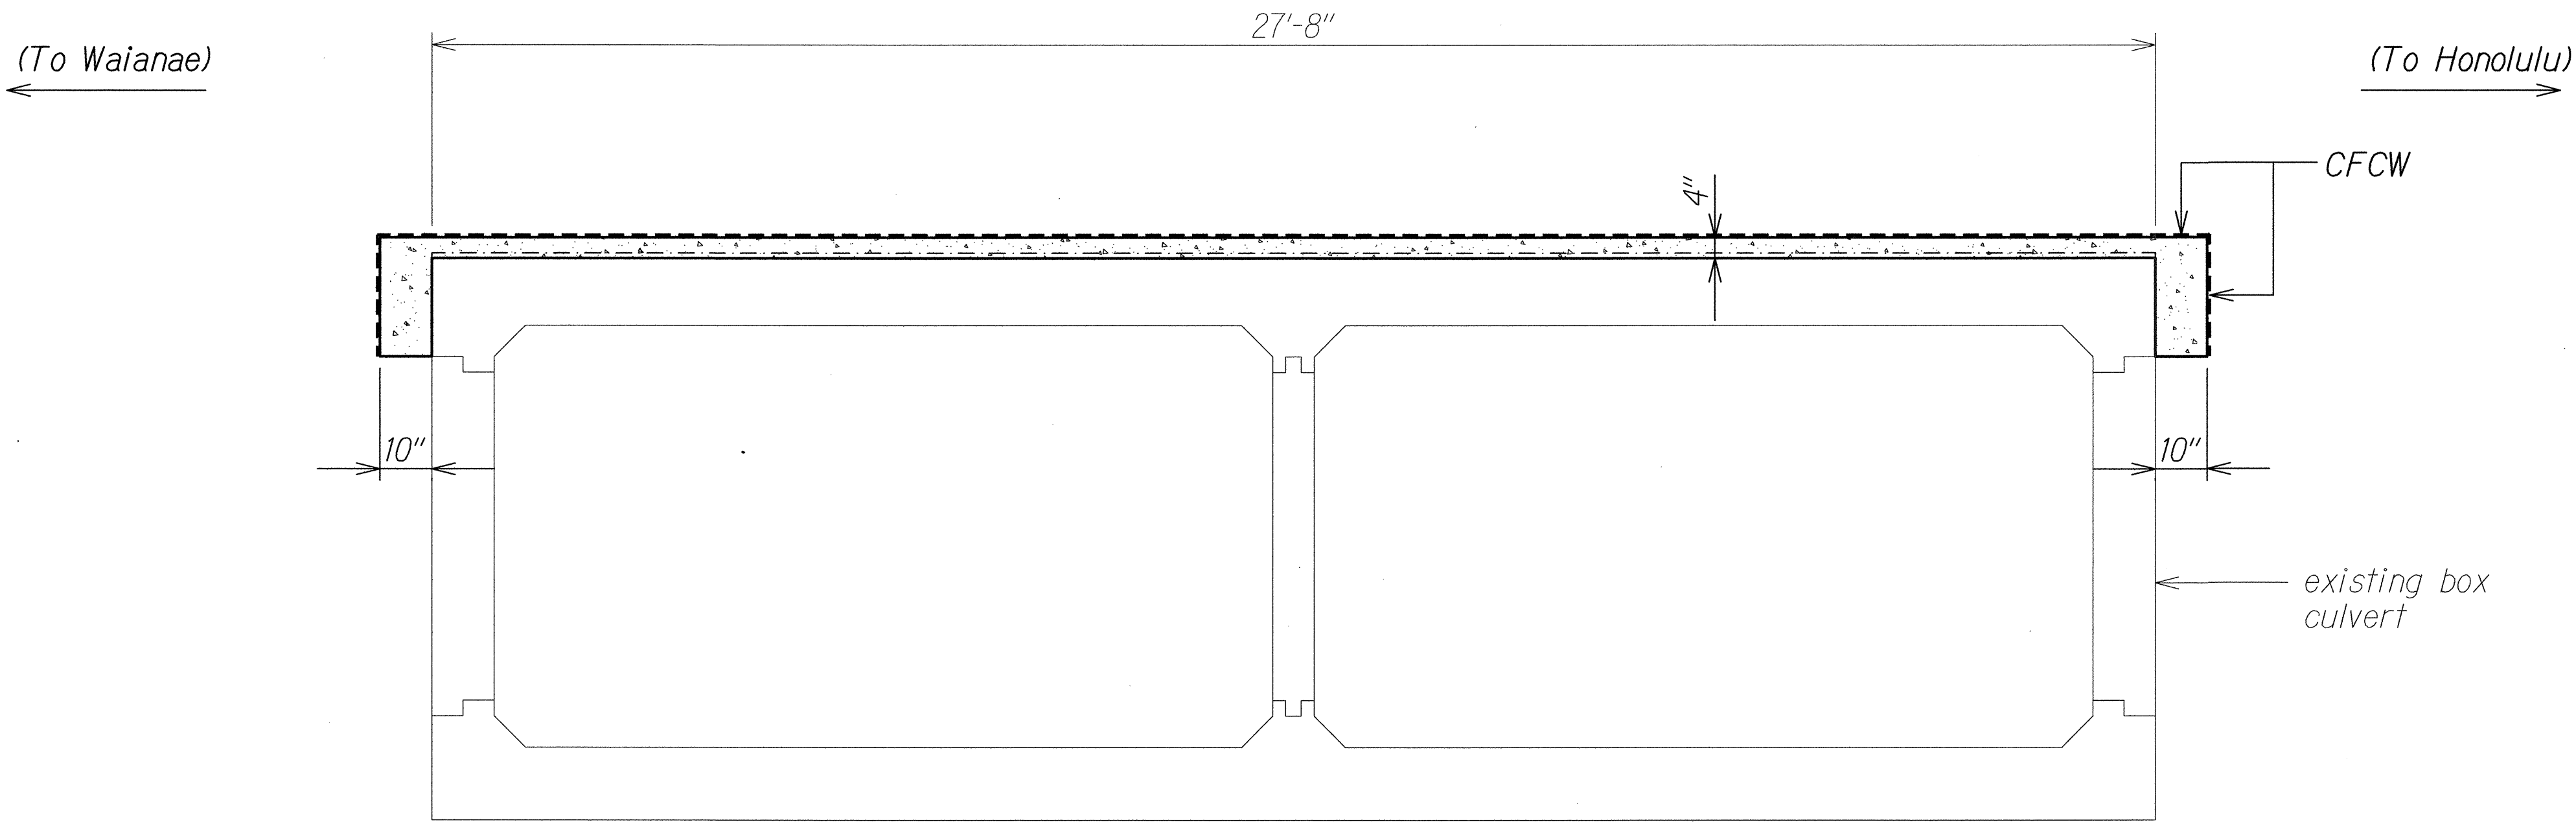


BOX CULVERT - SECTION A
Scale: 1/2" = 1'-0"

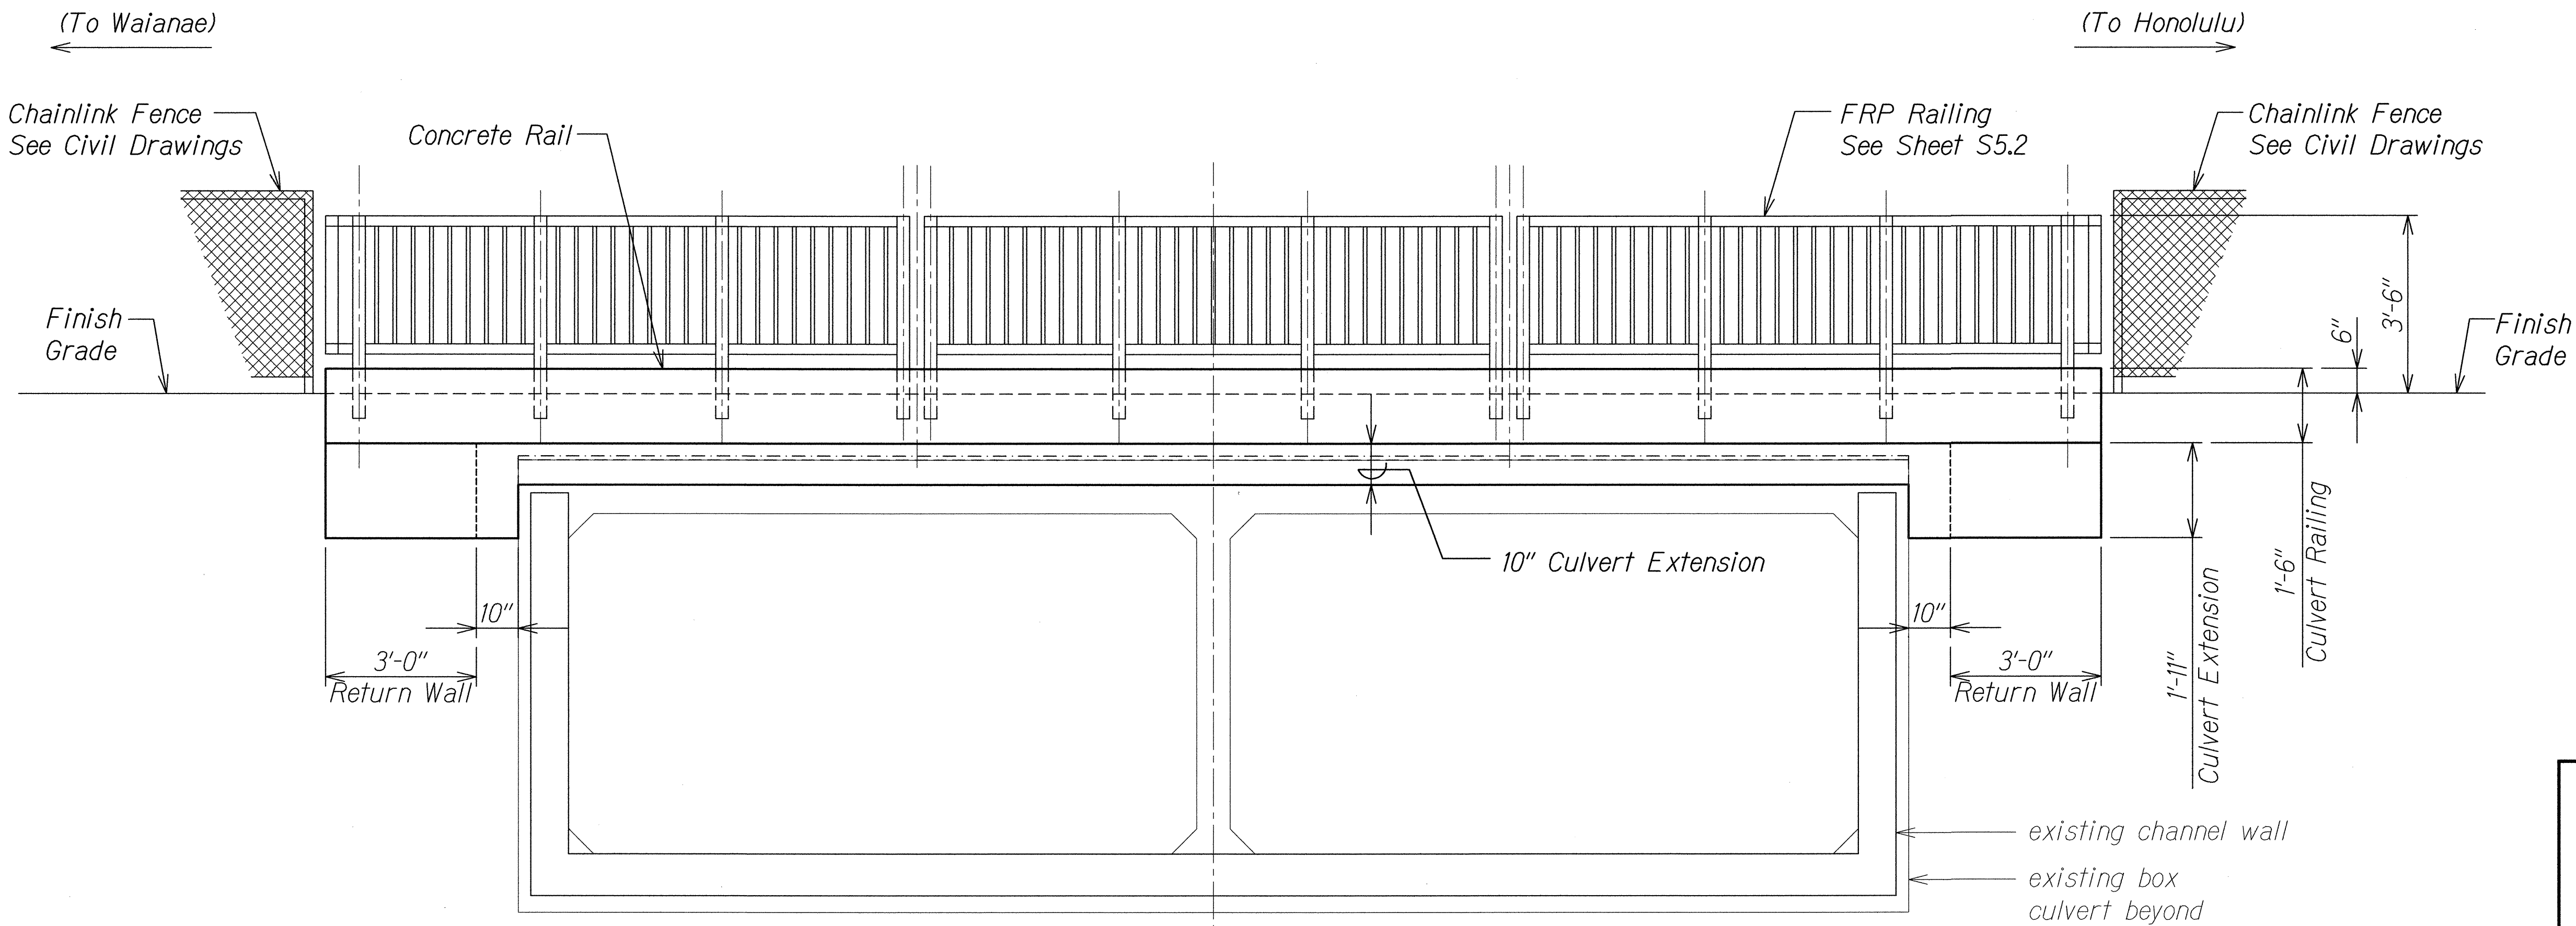

BOX CULVERT - ELEVATION B
Scale: 1/2" = 1'-0"

DESIGNED BY	DATE
TRACED BY	
NOTE BOOK	
QUANTITIES BY	
CHECKED BY	

DRAWING NAME: Z:\00 ONCONG\12-026-FARRINGTON HWY NAKAKULI TO HALEAKALA-UEHAWA\CAD\07-17-13 FINAL 100% FUIU-S301.DWG PLOT TIME: 07-16-13, 4:13 PM

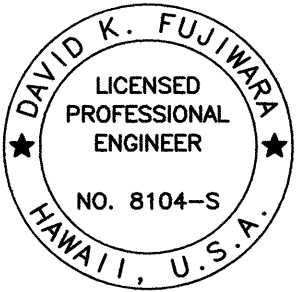

THIS WORK WAS PREPARED BY ME
OR UNDER MY SUPERVISION.
David K. Fujiwara
KSF, INC. APRIL 30, 2014
LIC. EXP. DATE

STATE OF HAWAII
DEPARTMENT OF TRANSPORTATION
HIGHWAYS DIVISION


SECTION AND ELEVATION

FARRINGTON HIGHWAY INTERSECTION IMPROVEMENTS
AT NAKAKULI AVENUE AND HALEAKALA AVENUE
Federal-Aid Project No. STP-093-1(22)
Scale: As Shown Date: April 2013
SHEET No. S32 OF 5 SHEETS


FED. ROAD DIST. NO.	STATE	FED. AID PROJ. NO.	FISCAL YEAR	SHEET NO.	TOTAL SHEETS
HAWAII	HAW.	STP-093-1(22)	2013	ADD. 191	230

DRAWING NAME: Z:\00 ONCONG\12-026-FARRINGTON HWY NAIKULI TO HALEAKALA-UEHAWA CAD\11-08-13 ADD\PHU-S301 ADD.DWG PLOT TIME: 11-04-13, 4:57 PM

SURVEY PLOTTED BY	DATE
DRAWN BY	
DESIGNED BY	
QUANTITIES BY	
CHECKED BY	
ORIGINAL PLAN	
NOTE BOOK	
No.	

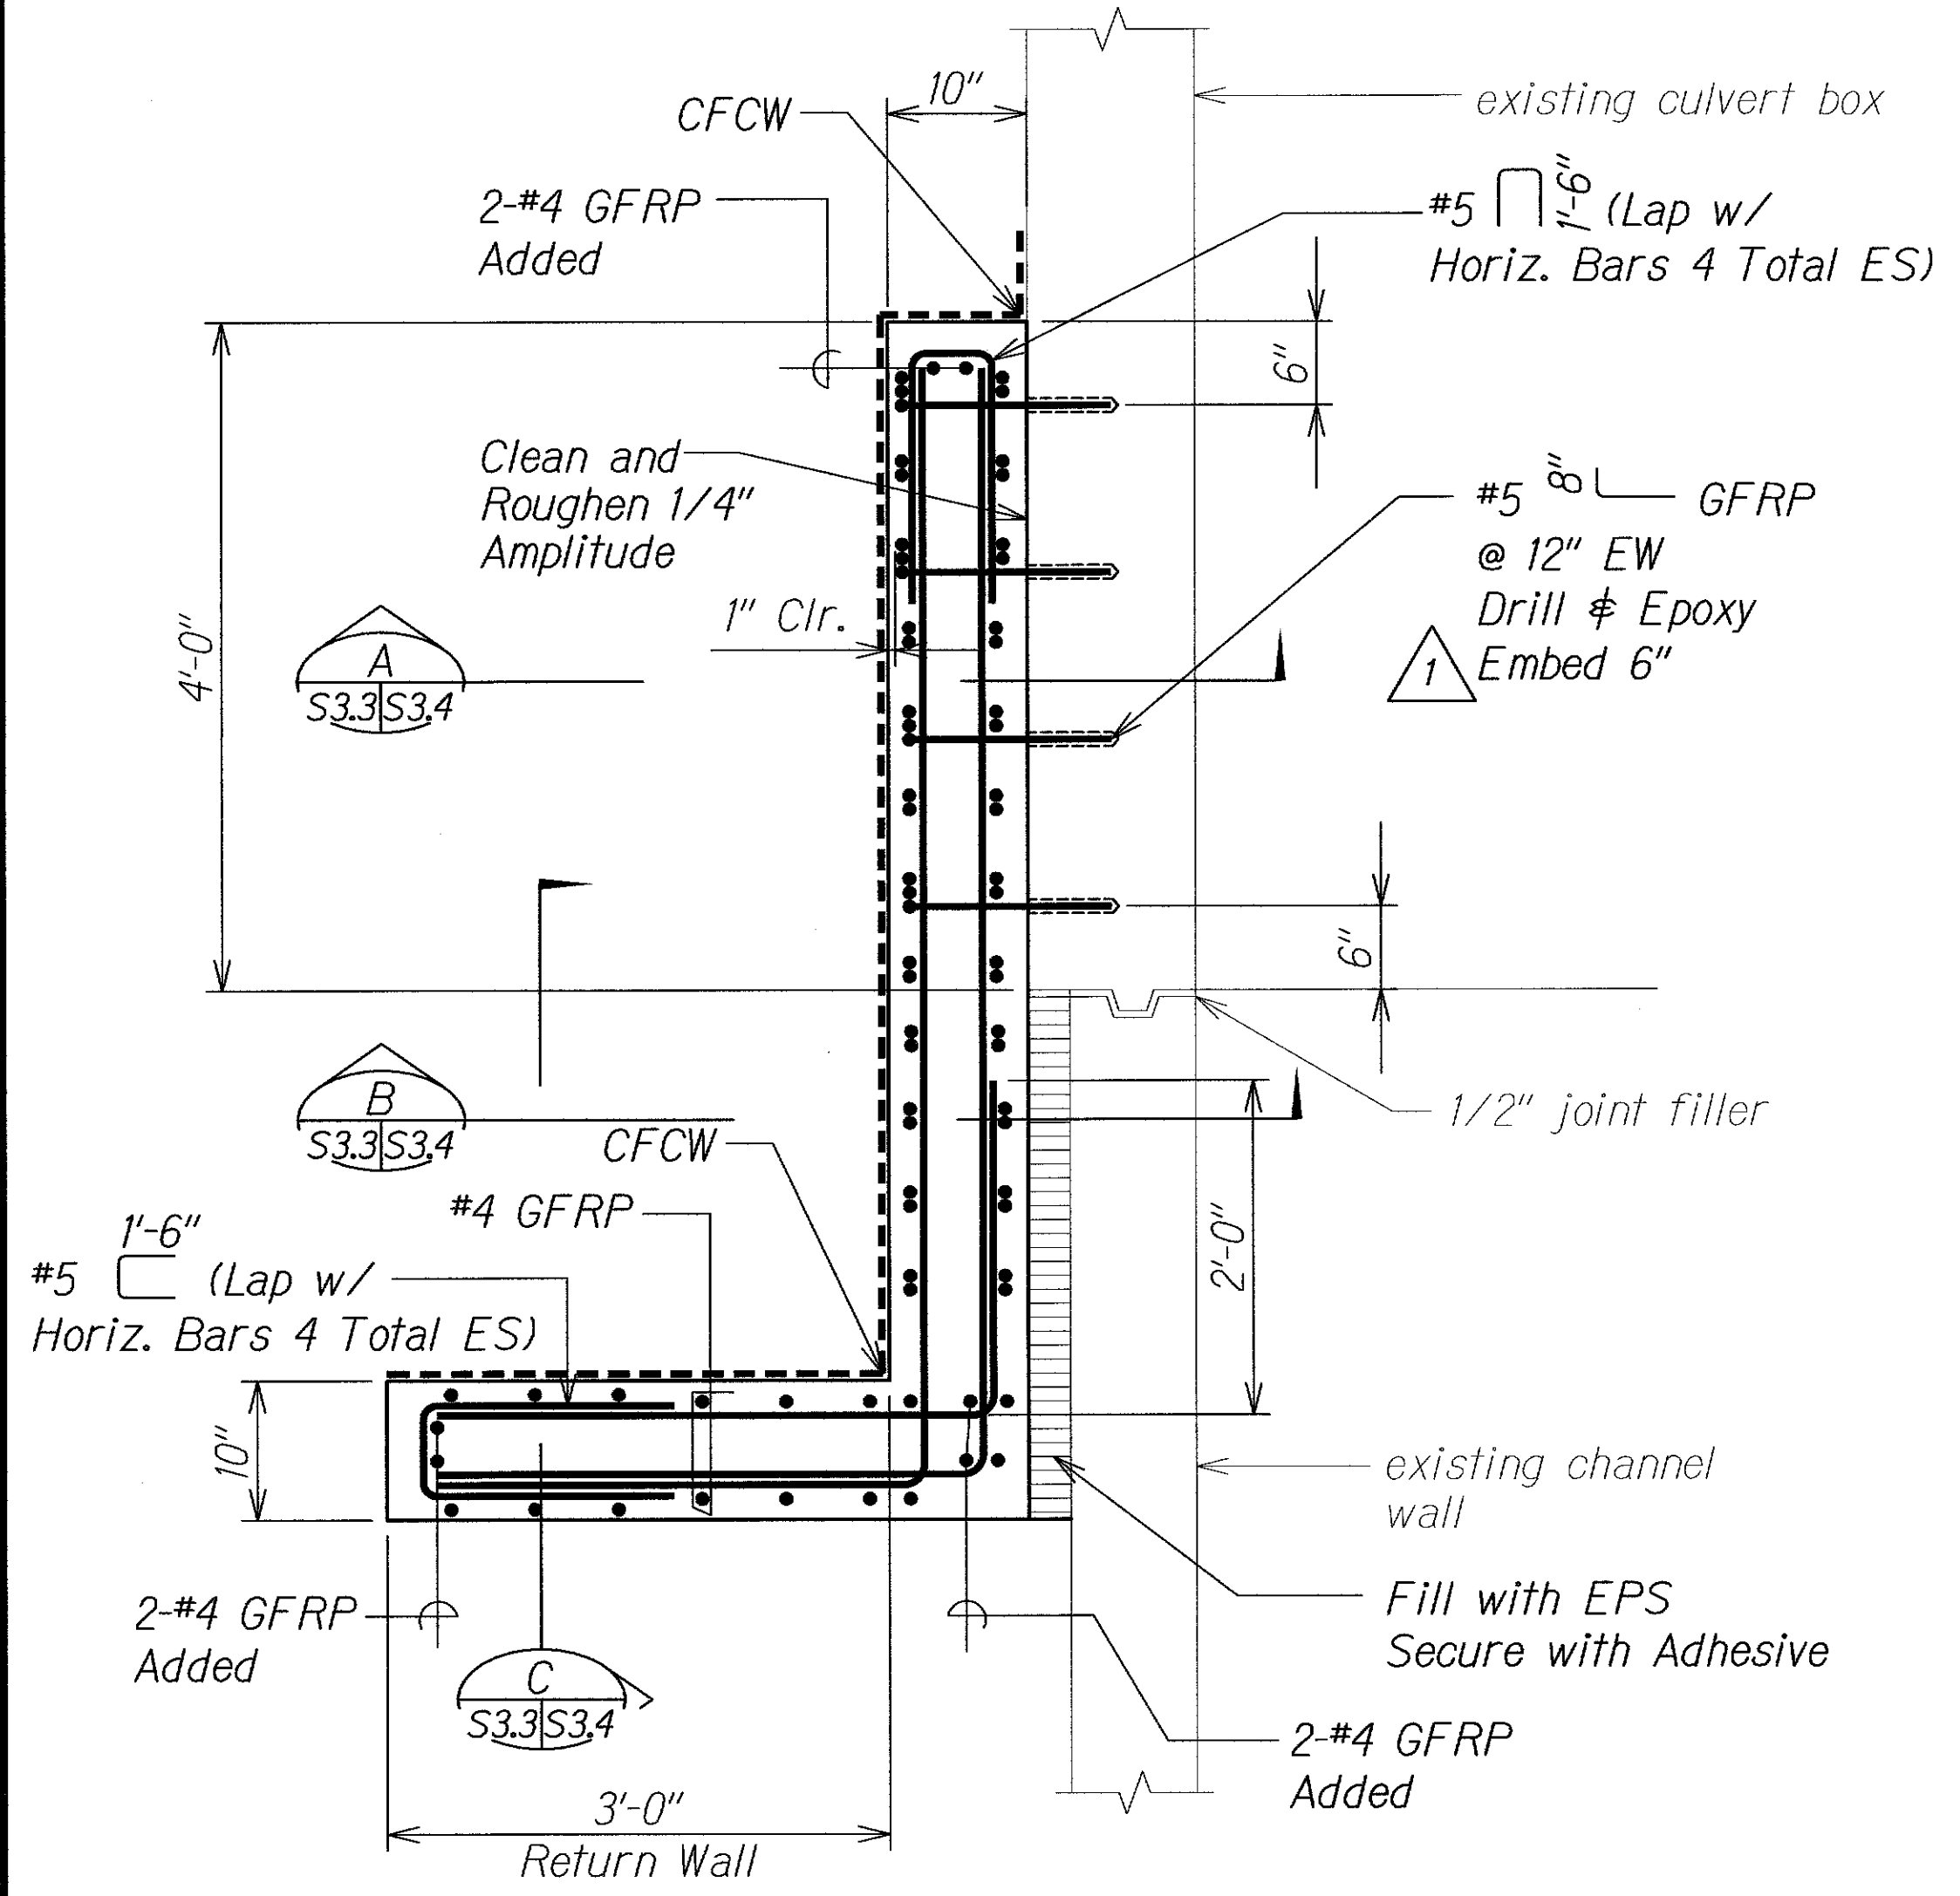


SECTION A
Scale: 1" = 1'-0"
S3.1 | S3.3

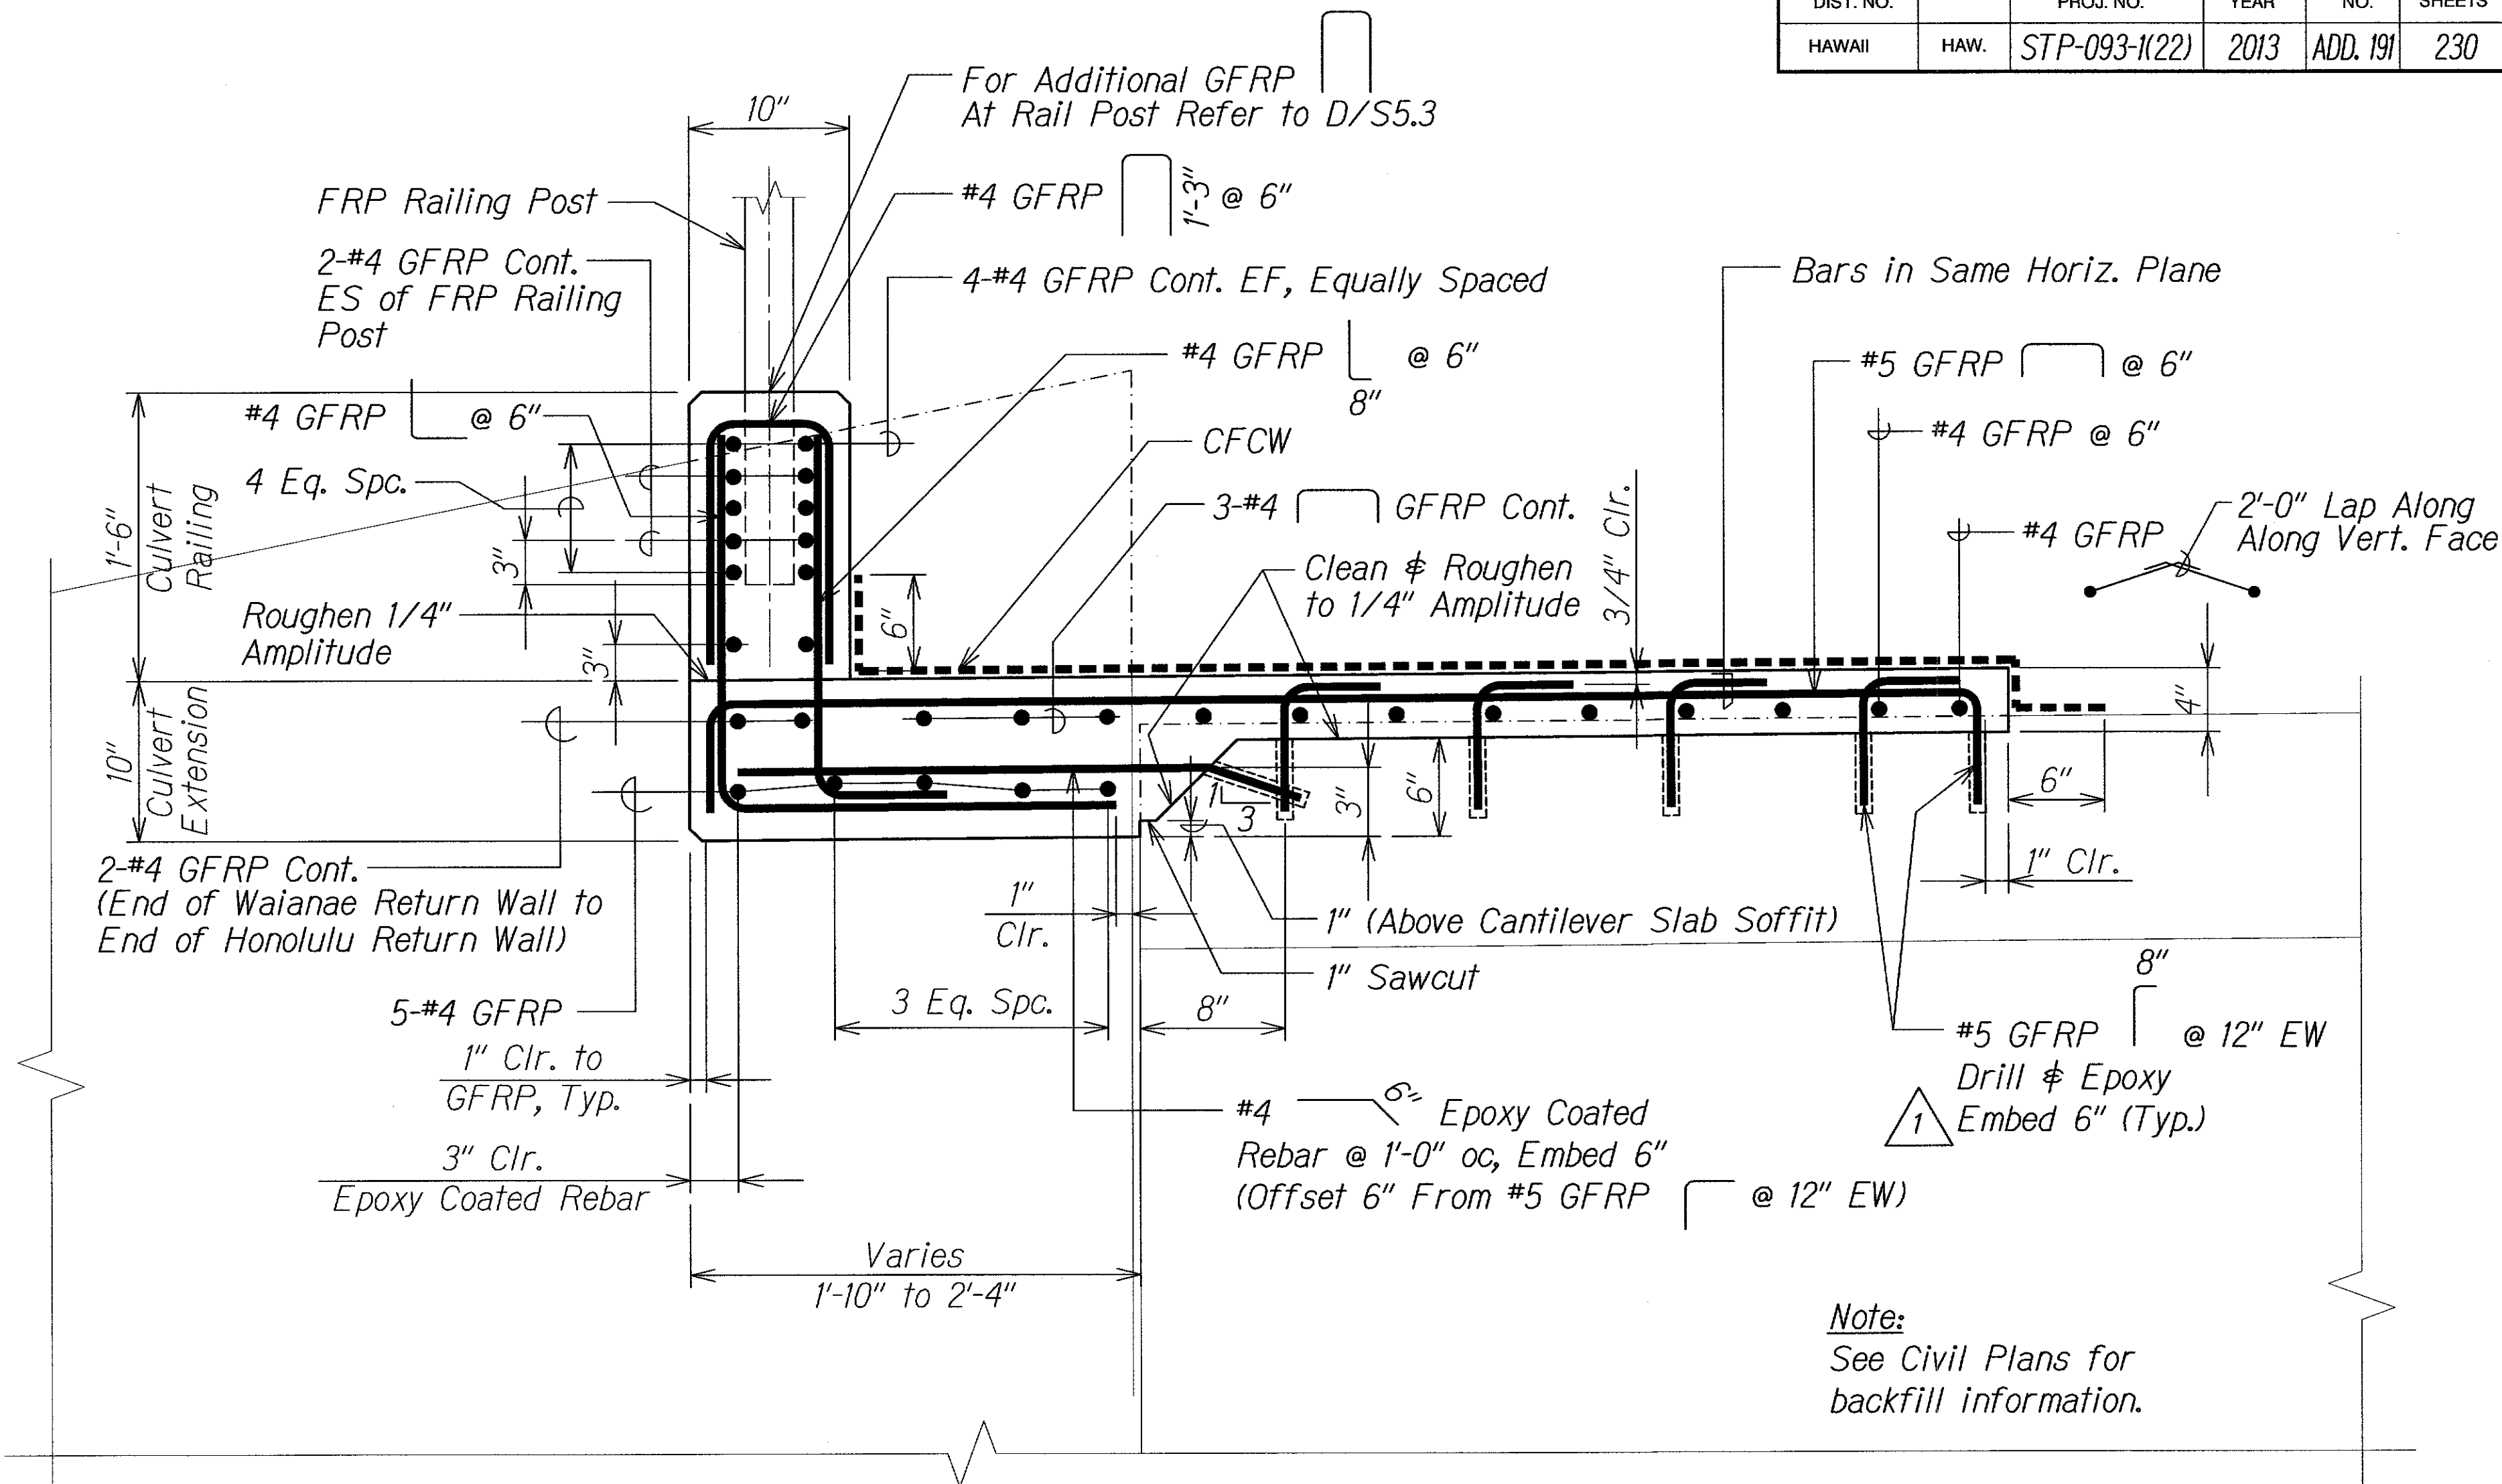

SECTION B
Scale: 1 1/2" = 1'-0"
S3.1 | S3.3
S5.2

Note:
See Civil Plans for
backfill information.

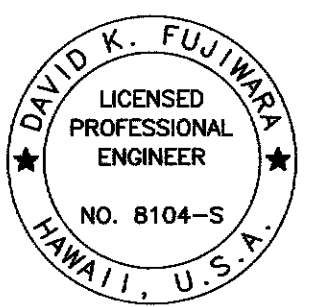

THIS WORK WAS PREPARED BY ME
OR UNDER MY SUPERVISION.
David K. Fujimura
KSF, INC. APRIL 30, 2014
LIC. EXP. DATE


STATE OF HAWAII
DEPARTMENT OF TRANSPORTATION
HIGHWAYS DIVISION
SECTIONS
FARRINGTON HIGHWAY INTERSECTION IMPROVEMENTS
AT NAIKULI AVENUE AND HALEAKALA AVENUE
Federal-Aid Project No. STP-093-1(22)
Scale: As Shown Date: April 2013
SHEET No. S3.3 OF 5 SHEETS

11/08/13
DATE


1
REVISION

Add. 1 - Modified Embedment


FED. ROAD DIST. NO.	STATE	FED. AID PROJ. NO.	FISCAL YEAR	SHEET NO.	TOTAL SHEETS
HAWAII	HAW.	STP-093-1(22)	2013	ADD. 192	230

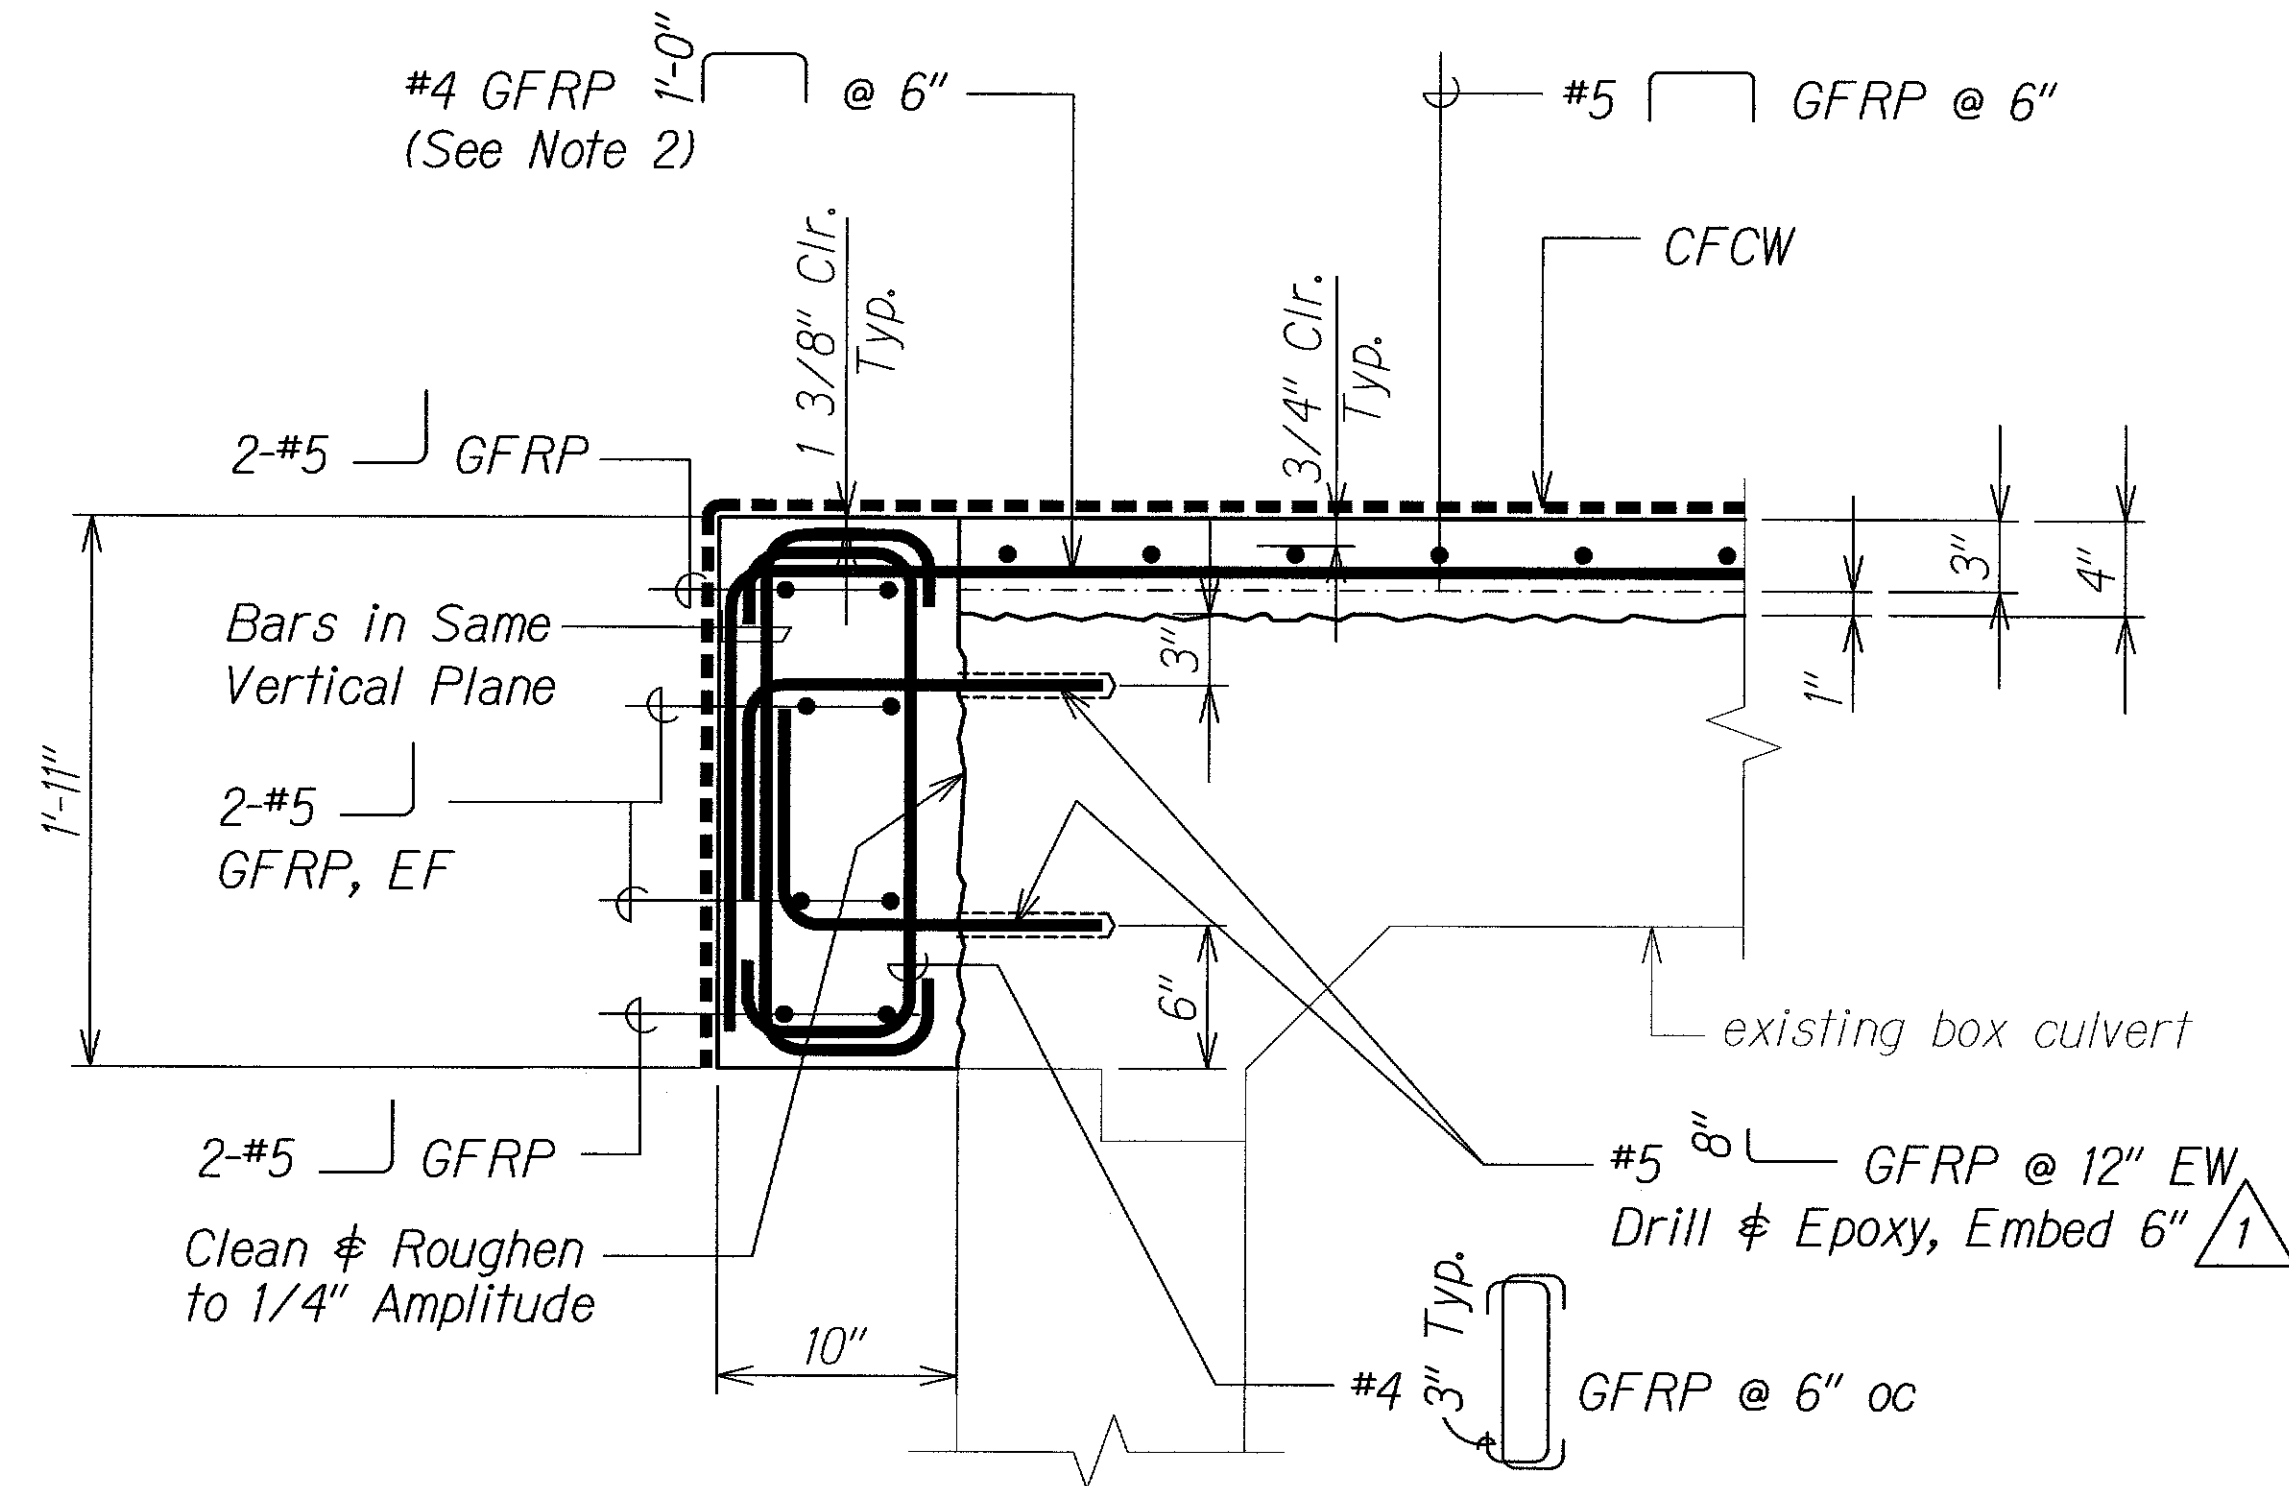

SECTION A
Scale: 1 1/2" = 1'-0" S3.3 S3.4

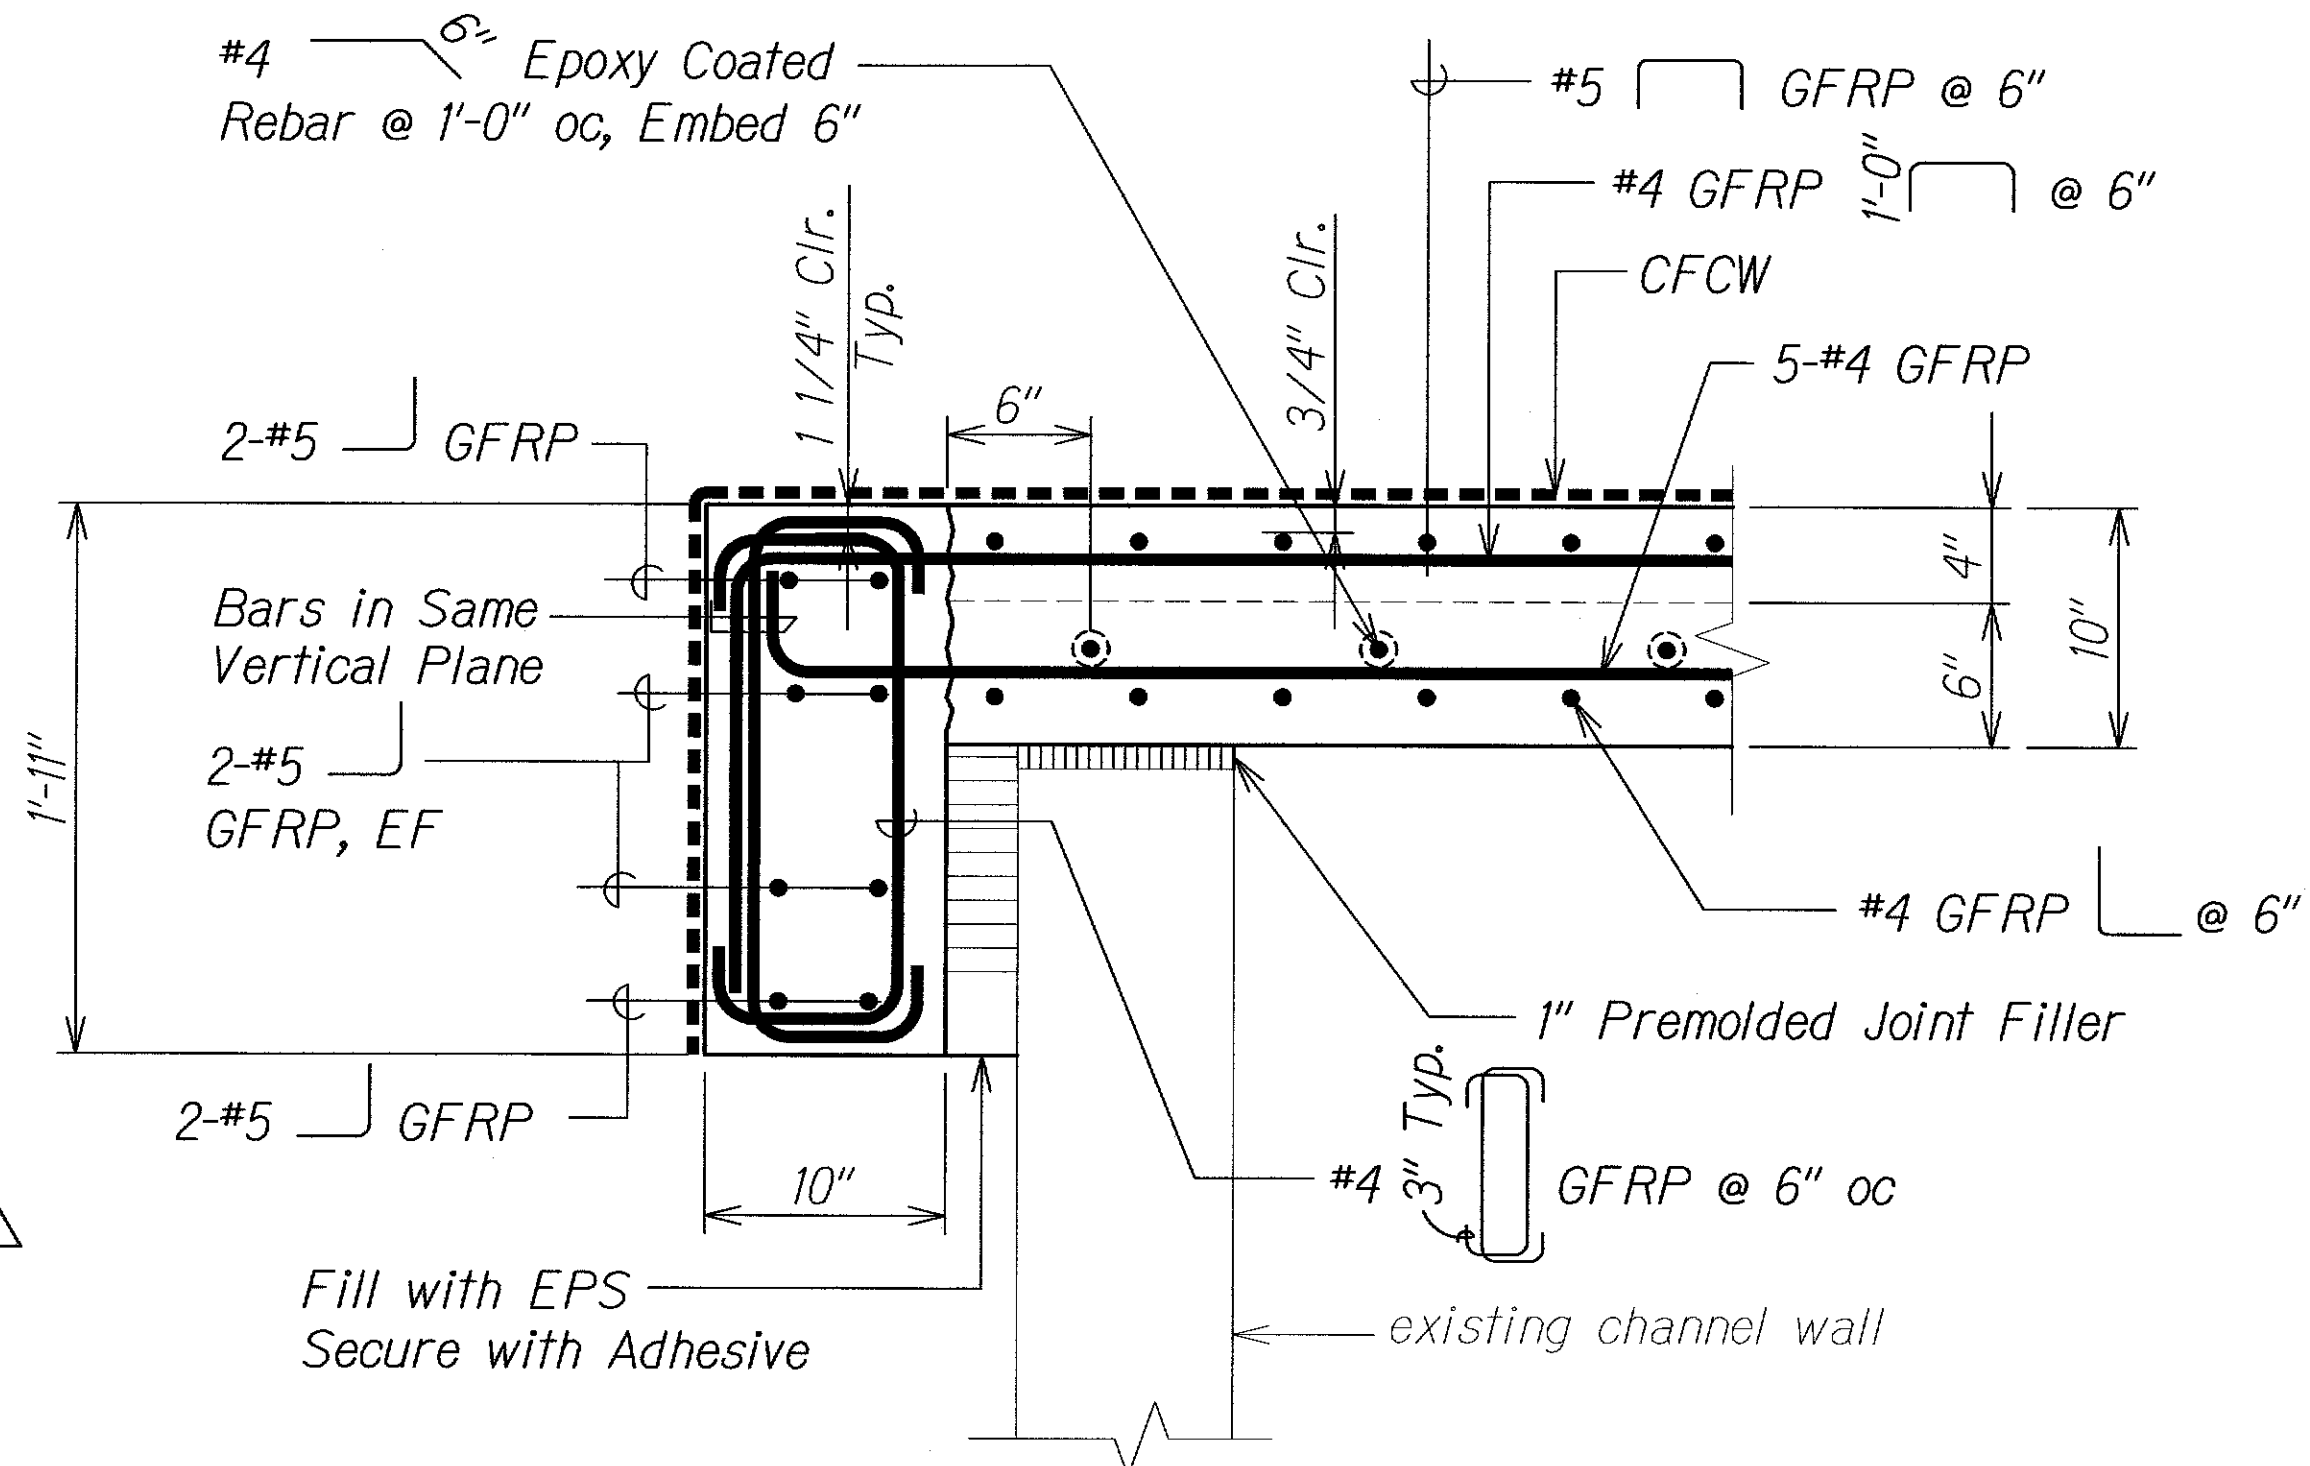

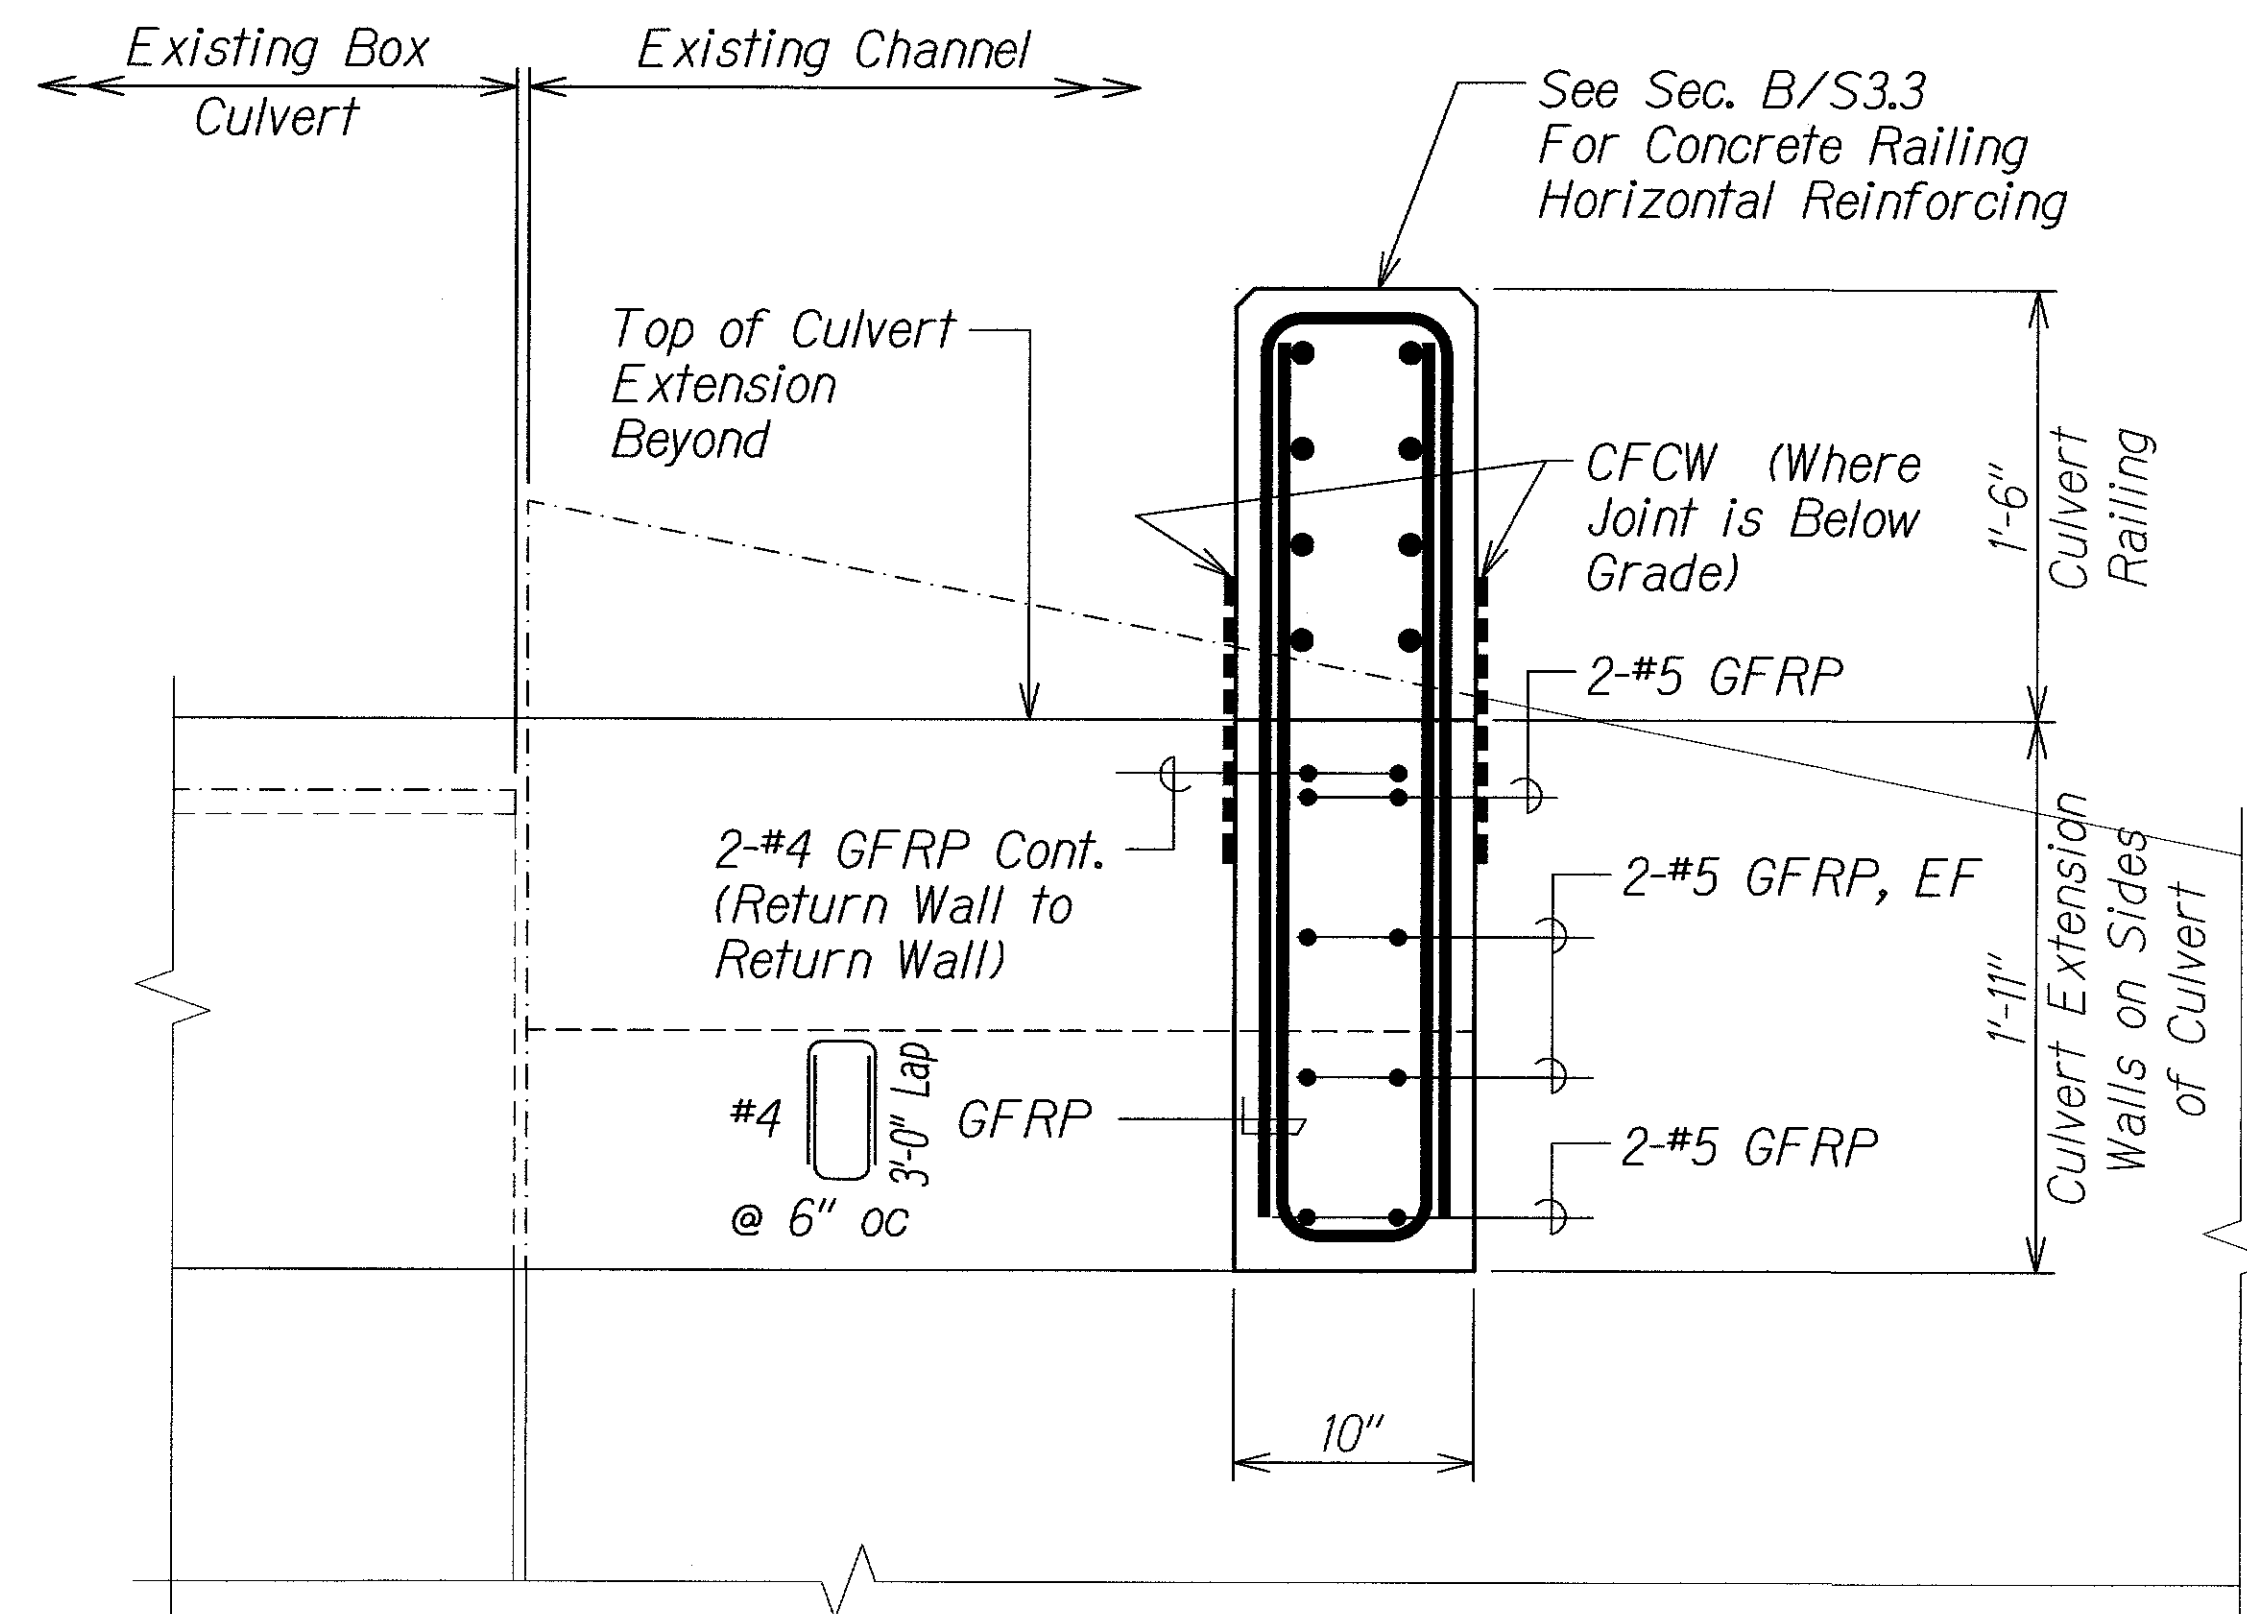


SECTION B
Scale: 1 1/2" = 1'-0" S3.3 S3.4



SECTION C
Scale: 1 1/2" = 1'-0" S3.3 S3.4

Notes:

- For FRP Railing, see Sheets S5.2 and S5.3.
- Offset #4 GFRP  or #4 GFRP  such that there is a maximum bundle of three (3) bars. Offset shall be 1" minimum.

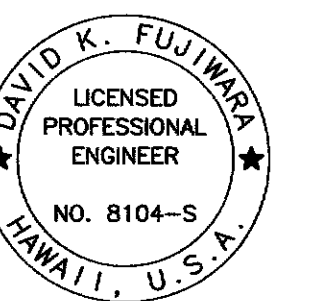

THIS WORK WAS PREPARED BY ME
OR UNDER MY SUPERVISION.
David K. Fujiwara
KSF, INC. APRIL 30, 2014
LIC. EXP. DATE

STATE OF HAWAII DEPARTMENT OF TRANSPORTATION HIGHWAYS DIVISION	
SECTIONS	
FARRINGTON HIGHWAY INTERSECTION IMPROVEMENTS AT NANAKULI AVENUE AND HALEAKALA AVENUE Federal-Aid Project No. STP-093-1(22)	
Scale: As Shown	Date: April 2013
SHEET No. S34 OF 5 SHEETS	


11/08/13	1 Add. 1 - Modified Embedment
DATE	REVISION

FED. ROAD DIST. NO.	STATE	FED. AID PROJ. NO.	FISCAL YEAR	SHEET NO.	TOTAL SHEETS
HAWAII	HAW.	STP-093-1(22)	2013	193	230

CONSTRUCTION SEQUENCE:


- 1 Demolish Portion of Existing Structures Shown on Sheets S2.1 to S2.4 (Refer to Special Provisions Section 202)
- 2 Relocate Chainlink Fence As Necessary
- 3 Remove 1" Deep Concrete from Top Slab of Existing Culvert
- 4 Drill and Epoxy Dowels in Existing Culvert
- 5 Construct Culvert Extension Walls on Culvert Return Walls
- 6 Construct Culvert Extension
- 7 Remove Falsework a Minimum of 14 Days after Concrete in Stage 6 has been Cast. Then, Construct Concrete Railing and FRP Railing
- 8 Install CFCW a Minimum of 28 Days after Concrete in 7 has been Cast. Refer to A/S3.3, B/S3.3, and A/S3.2.
- 9 Backfill

- Legend:
- Indicates Area 1" Deep Concrete Removal From Top Slab of Existing Culvert.
 - Indicates Portion of Channel Wall, Curb and Chainlink Fence to be Demolished.

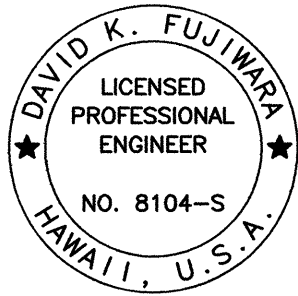

THIS WORK WAS PREPARED BY ME
OR UNDER MY SUPERVISION.
David K. Fujiwara
KSF, INC. APRIL 30, 2014
LIC. EXP. DATE

STATE OF HAWAII
DEPARTMENT OF TRANSPORTATION
HIGHWAYS DIVISION
CONSTRUCTION SEQUENCE
BOX CULVERT EXTENSION - PLAN
FARRINGTON HIGHWAY INTERSECTION IMPROVEMENTS
AT NANAKULI AVENUE AND HALEAKALA AVENUE
Federal-Aid Project No. STP-093-1(22)
Scale: As Shown Date: April 2013
SHEET No. S35 OF 5 SHEETS

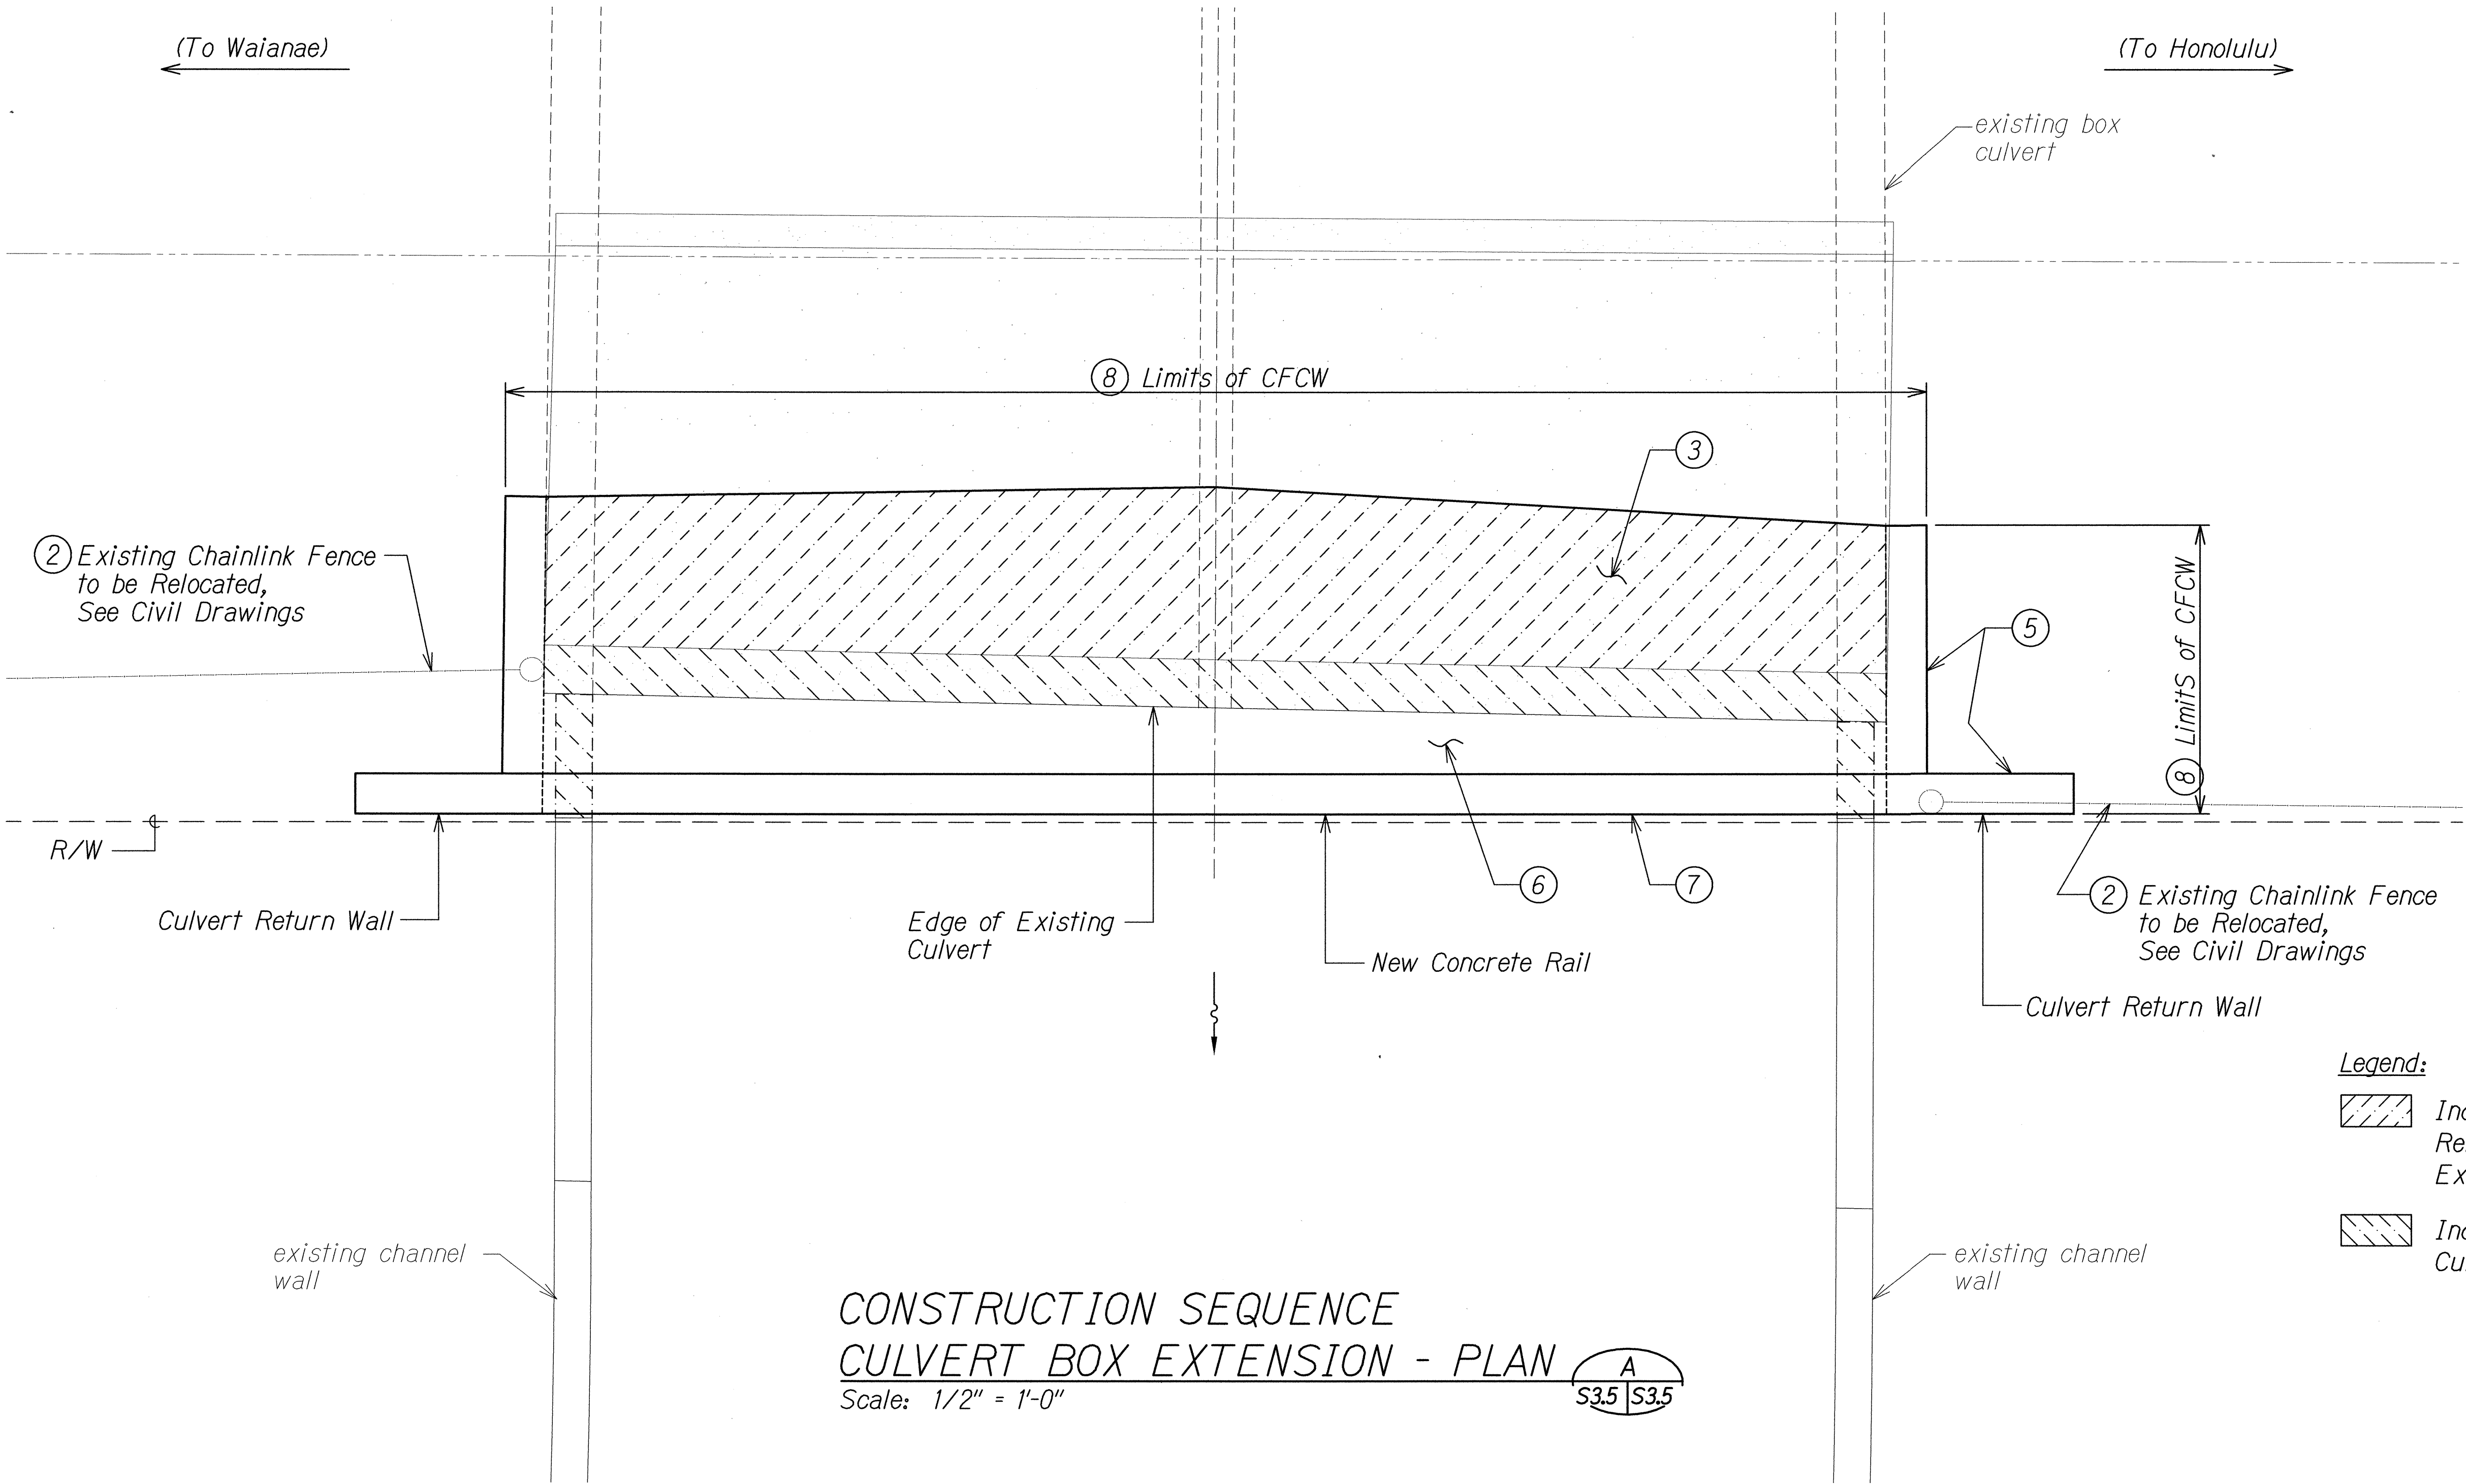

CONSTRUCTION SEQUENCE
CULVERT BOX EXTENSION - PLAN
Scale: 1/2" = 1'-0"


A
S3.5 S3.5

ORIGINAL PLAN	DATE
NOTED BY	
DESIGNED BY	
CHECKED BY	
NO.	

DRAWING NAME: Z:\00 ONCONG\12-026-FARRINGTON HWY NANAKULI TO HALEAKALA-LEHAWA\CAD\07-17-13 FINAL 100% FHU-S305.DWG PLOT TIME: 07-18-13, 4:14 PM

SURVEY PLOTTED BY	DATE
DRAWN BY	
DESIGNED BY	
QUANTITIES BY	
CHECKED BY	
ORIGINAL PLAN	
NOTE BOOK	
No.	


DRAWING NAME: 2:100 ONGOING 12-026-FARRINGTON HWY. NANAKULI TO HALEAKALA-UEHAWA (CAD) 11-08-13 ADDY\FHU-S401 ADD1.DWG PLOT TIME: 11-04-13 4:58 PM

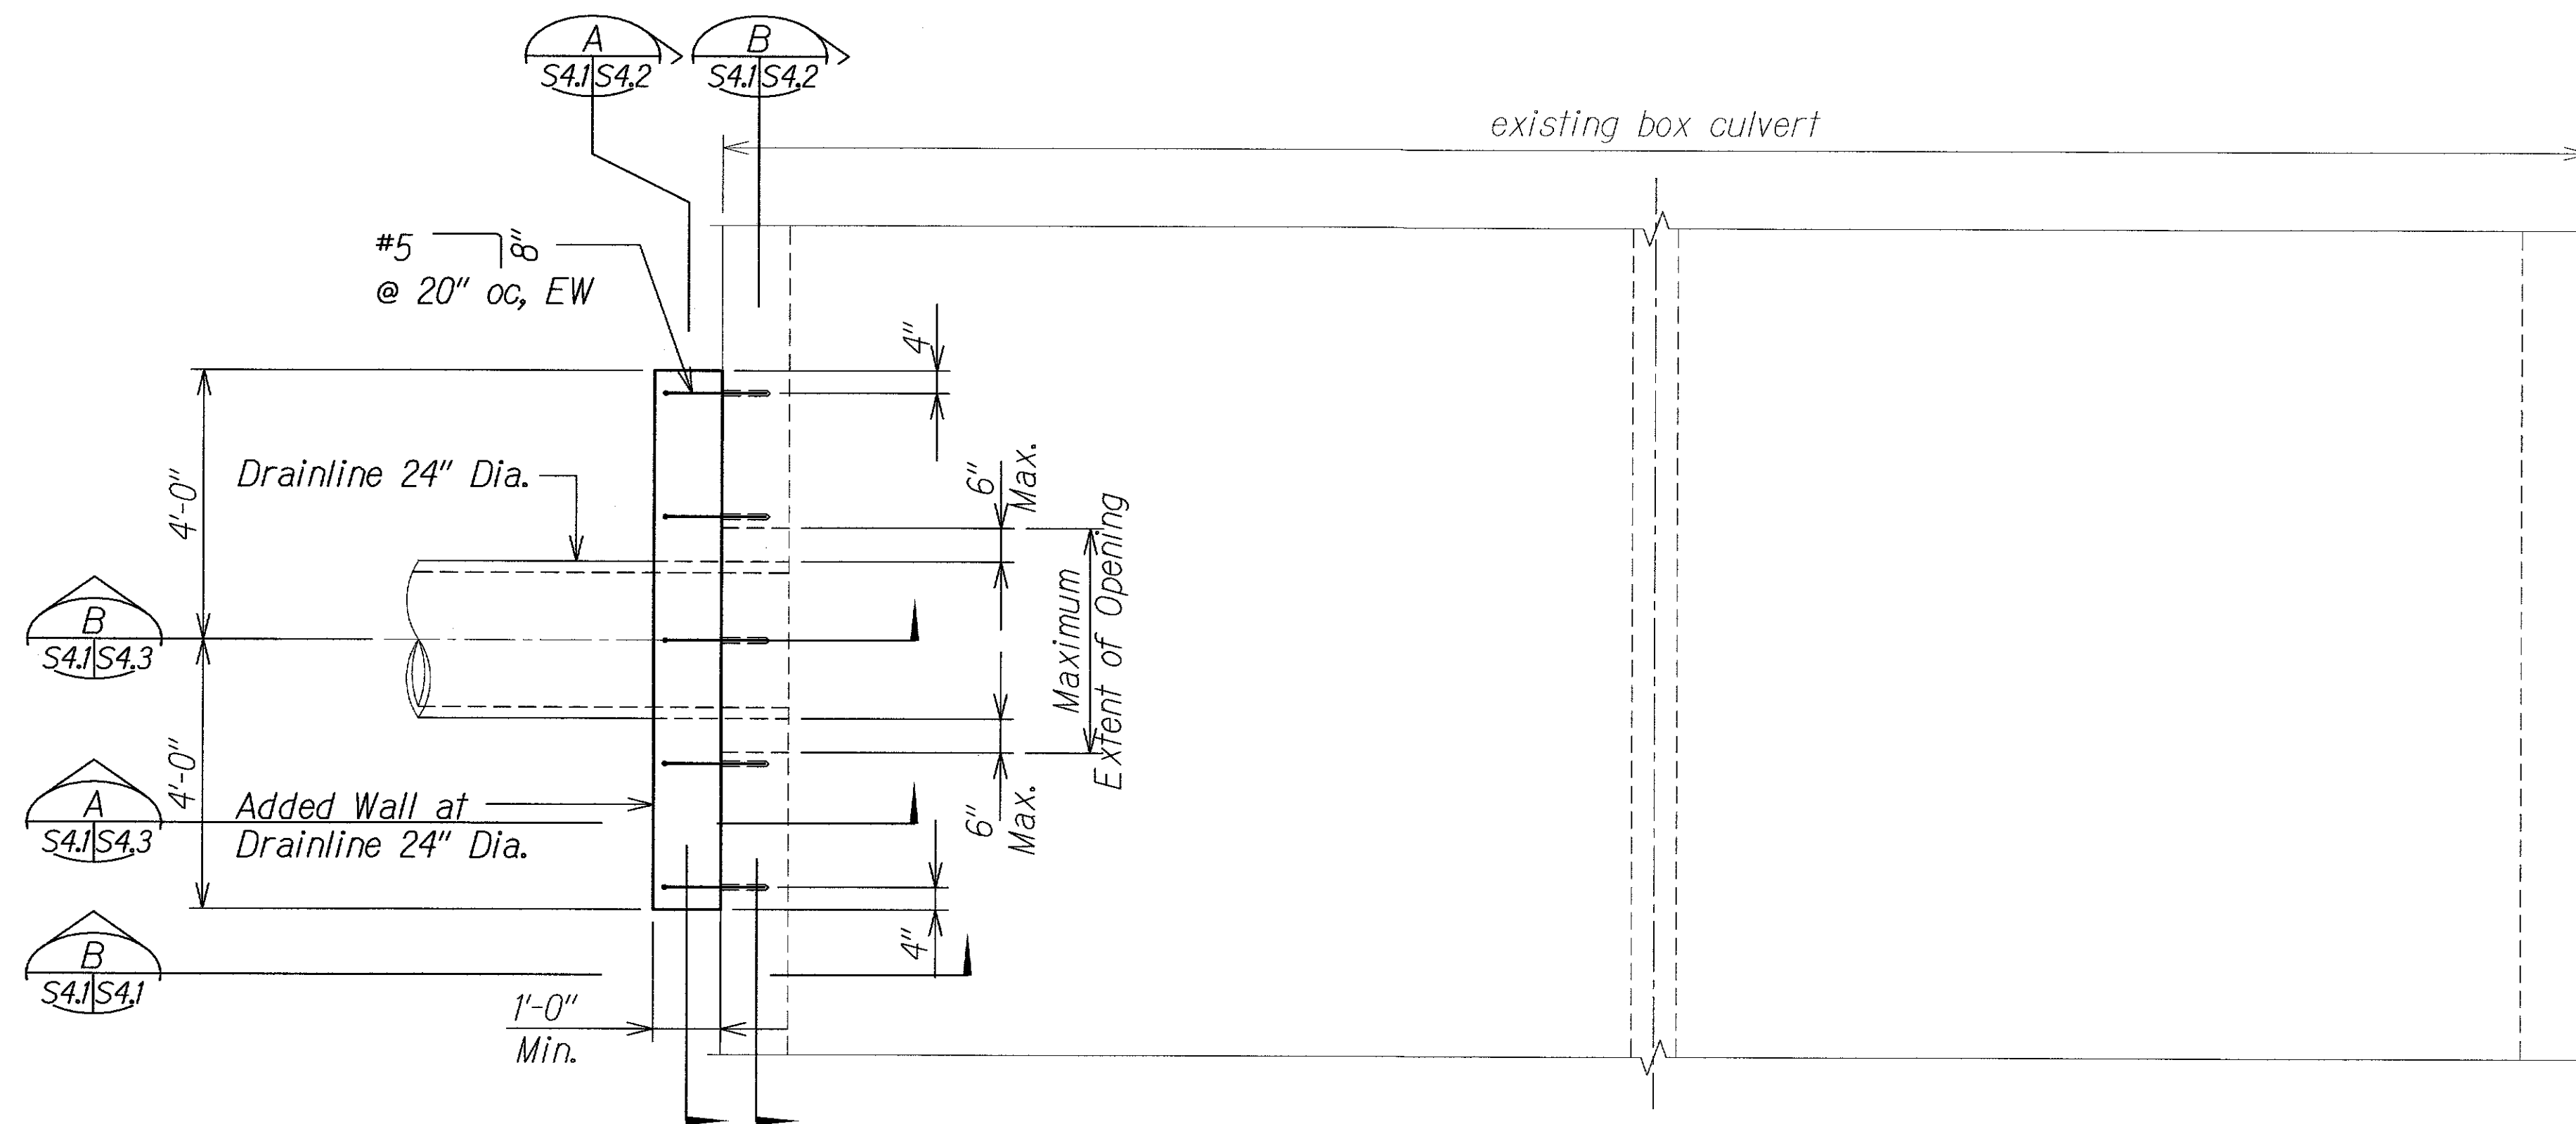

TYPICAL CONNECTION OF 24" DIA. DRAIN PIPE TO BOX CULVERT - PLAN

Scale: 1/2" = 1'-0"

A
S4.1 S4.1

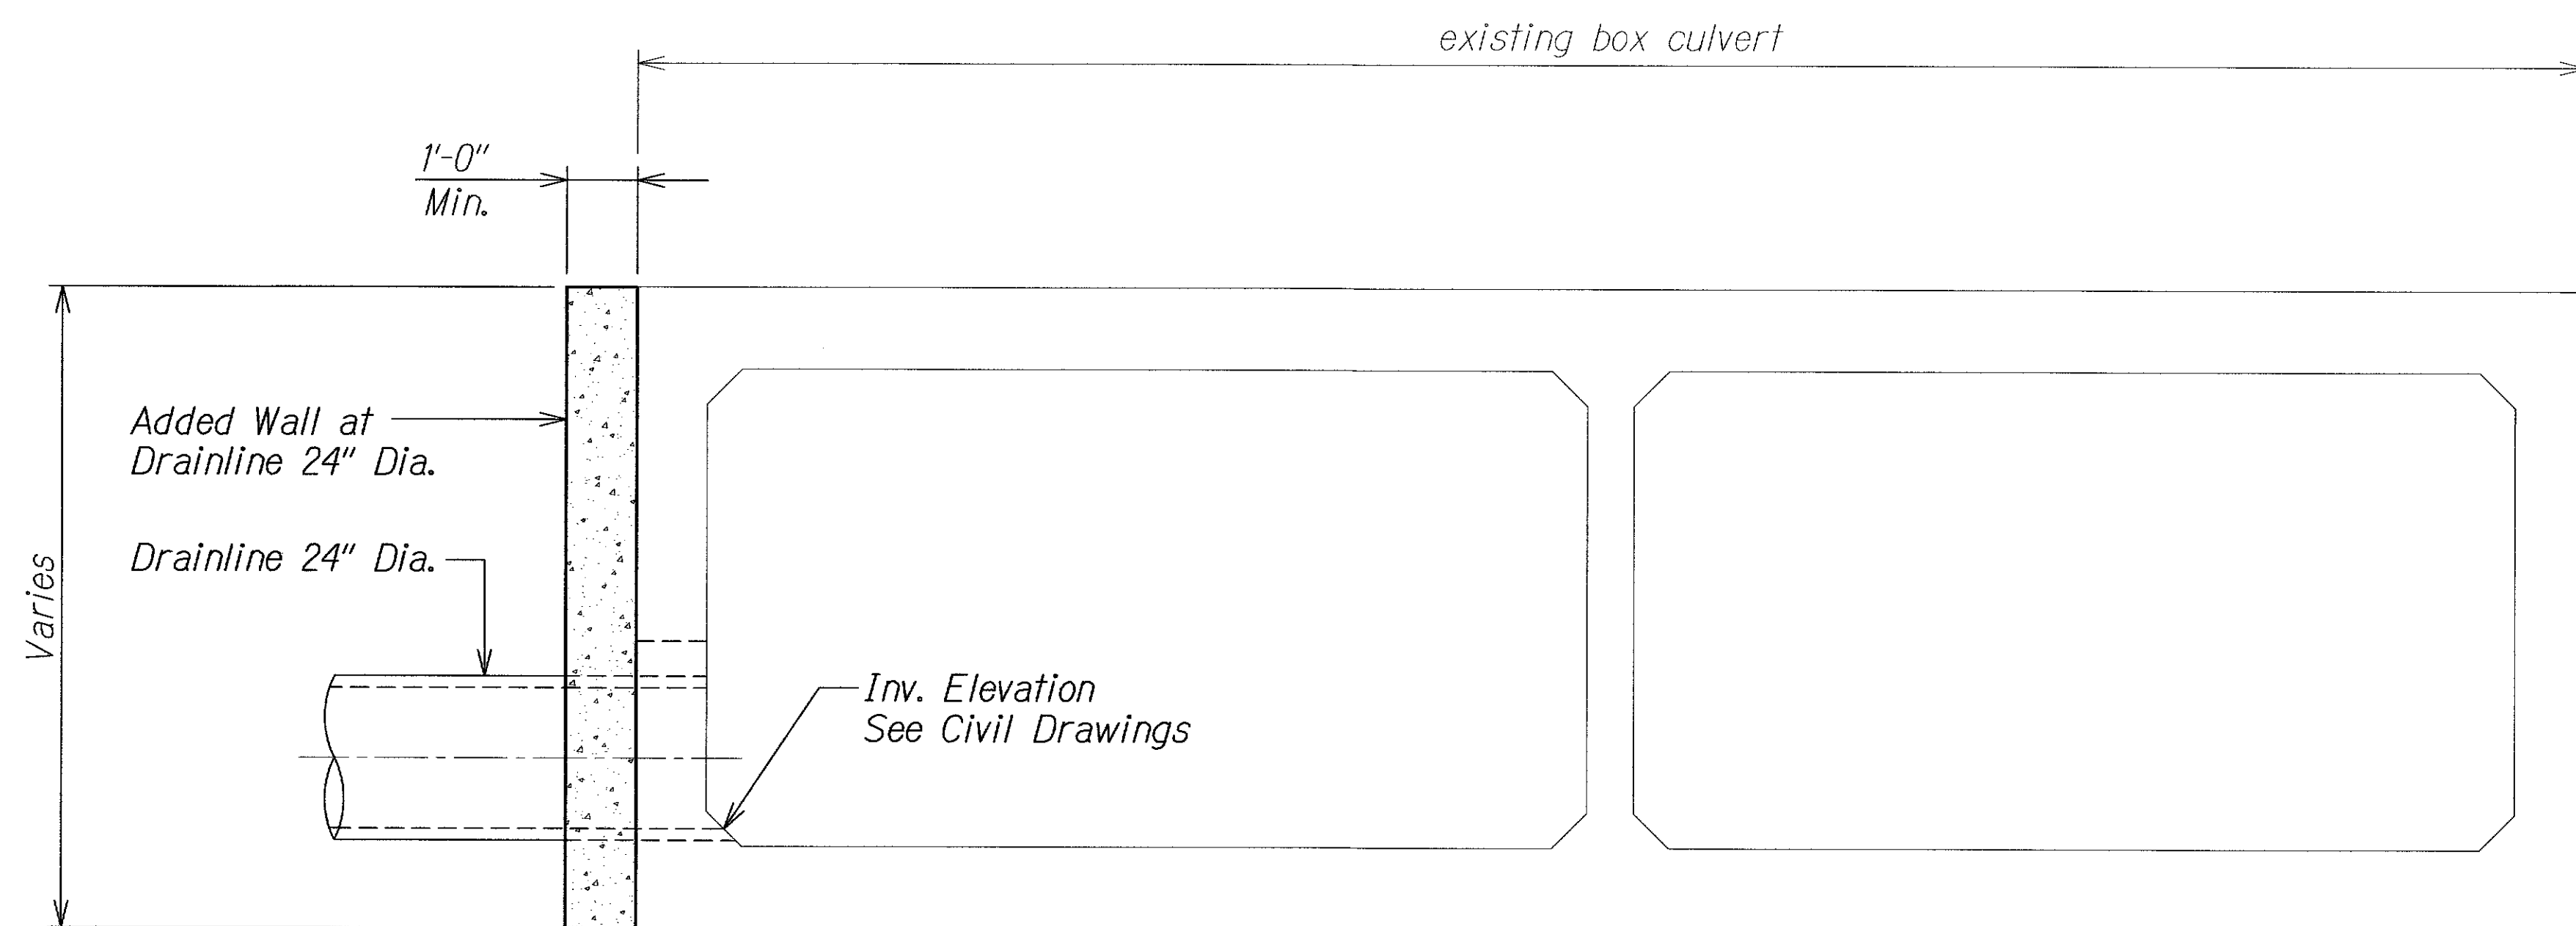

BOX CULVERT - SECTION

Scale: 1/2" = 1'-0"

B
S4.1 S4.1


FED. ROAD DIST. NO.	STATE	FED. AID PROJ. NO.	FISCAL YEAR	SHEET NO.	TOTAL SHEETS
HAWAII	HAW.	STP-093-1(22)	2013	ADD. 194	230

Notes:

- All work for removal of existing reinforced concrete will be paid for under Item No. 202.0200 - Removal of Portion of Existing Box Culvert.
- The work for evaluation, design, construction and removal of the temporary shoring shall be incidental to Pay Item 206.2000 - Excavation for Drainage Facilities.
- The Contractor shall be responsible for protecting the sides of the excavations from cave-ins. If the Contractor decides to brace or shore the cut slope, the Contractor shall submit working drawings and calculations. The working drawings and calculations shall be stamped by a registered Hawaii Structural Engineer and a registered Civil Engineer specializing in Geotechnical Engineering in the State of Hawaii. If the Contractor decides not to brace the cut slope, the Contractor shall submit, when requested by the Engineer, calculations, showing the stability of the slope, stamped by a registered Civil Engineer specializing in Geotechnical Engineering in the State of Hawaii. The working drawings and calculations shall be reviewed and accepted by the Engineer before proceeding with the construction.
- Structural General Note 6.(M) is applicable for the removal of existing reinforced concrete and connection of 24" dia. pipe connection.

CONSTRUCTION SEQUENCE:

- Install shoring, excavate trench for drain, and remove all superimposed loads from top slab of existing culvert.
- Sawcut opening in existing culvert wall.
- Install 24" drain pipe and reinforcing in opening of existing wall and fill blockout between drain and existing wall, See sheets S4.2 and S4.3.
- Place reinforcing for added wall and pour added wall, see Sheets S4.2 and S4.3.

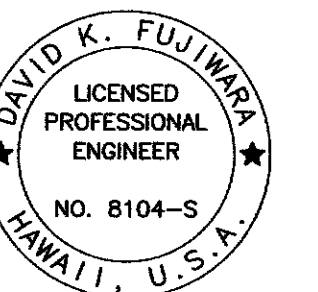


THIS WORK WAS PREPARED BY ME OR UNDER MY SUPERVISION.
David K. Fujimura
KSF, INC. APRIL 30, 2014
LIC. EXP. DATE

11/08/13	1 Add. 1 - Modified Notes
DATE	REVISION


STATE OF HAWAII DEPARTMENT OF TRANSPORTATION HIGHWAYS DIVISION TYPICAL CONN. OF 24" DIA. PIPE TO EXIST. BOX CULVERT-PLAN & SECTION FARRINGTON HIGHWAY INTERSECTION IMPROVEMENTS AT NANAKULI AVENUE AND HALEAKALA AVENUE Federal-Aid Project No. STP-093-1(22) Scale: As Shown Date: April 2013 SHEET No. S4.1 OF 3 SHEETS

FED. ROAD DIST. NO.	STATE	FED. AID PROJ. NO.	FISCAL YEAR	SHEET NO.	TOTAL SHEETS
HAWAII	HAW.	STP-093-1(22)	2013	ADD. 195	230

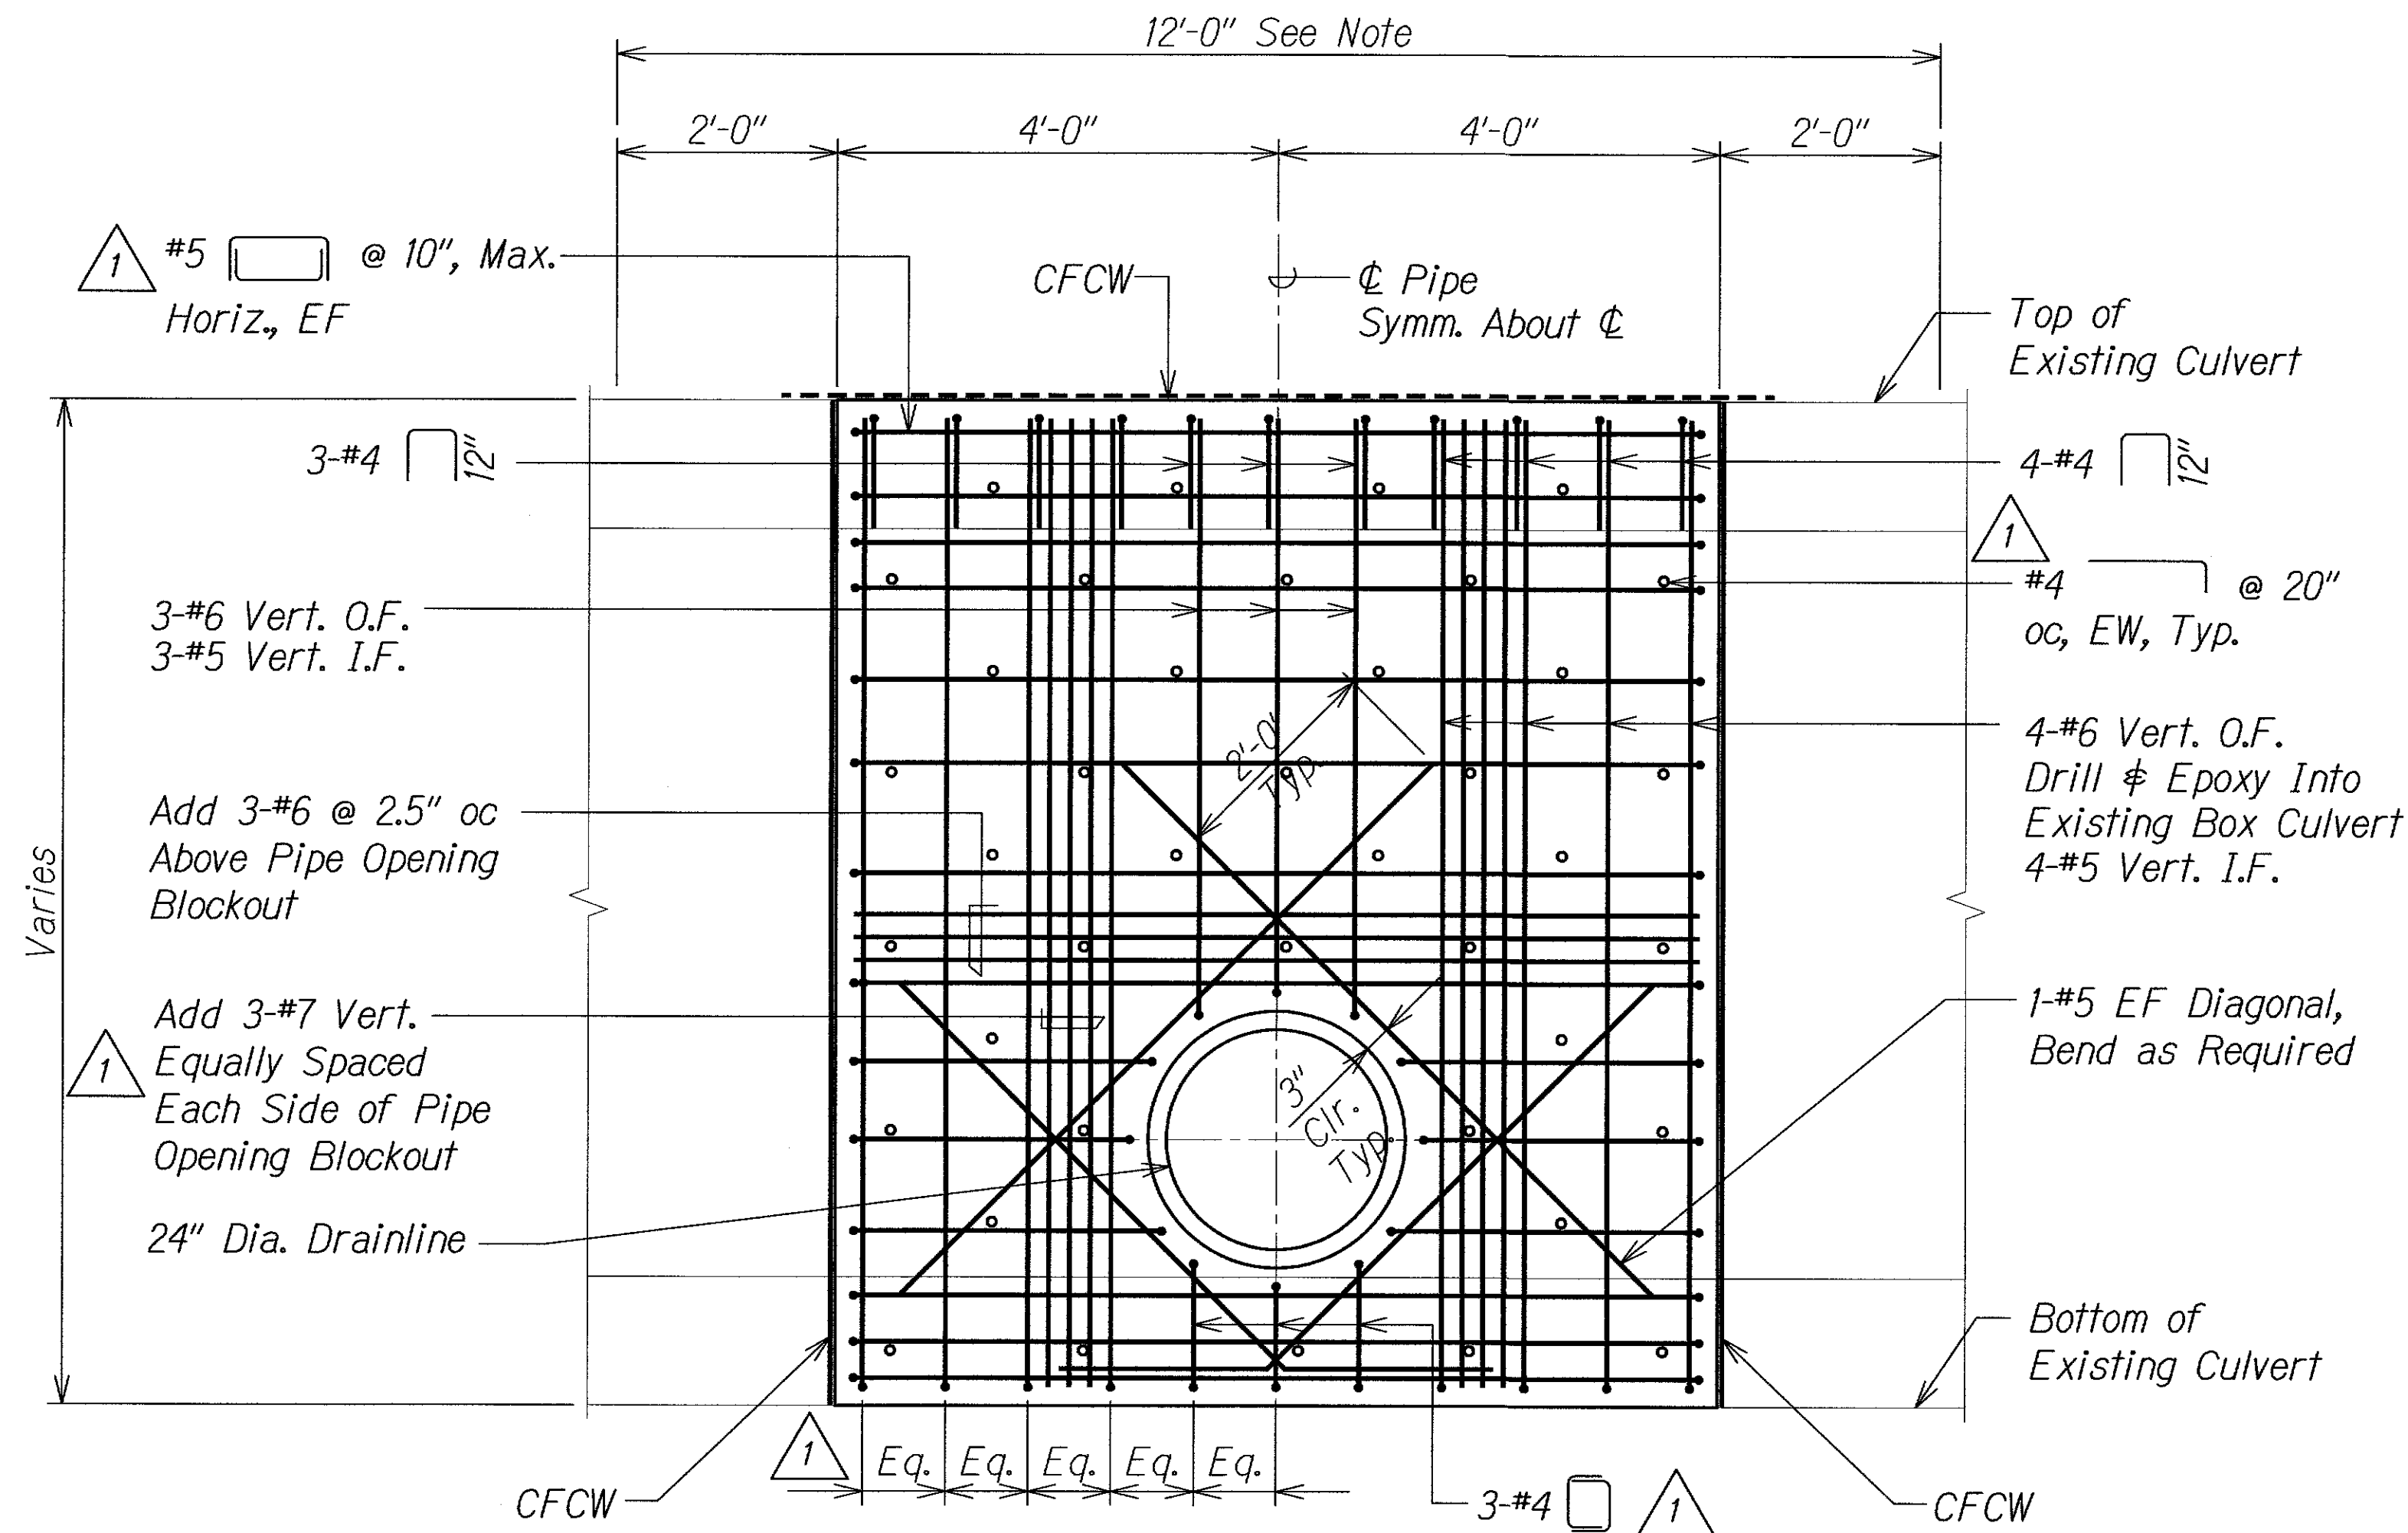

Note:
Remove all superimposed loads from top slab of existing culvert prior to removal of existing concrete.
See Specifications Section 206 for payment.


SECTION - ADDED WALL
AT EXISTING BOX CULVERT WALL A
Scale: 3/4" = 1'-0"

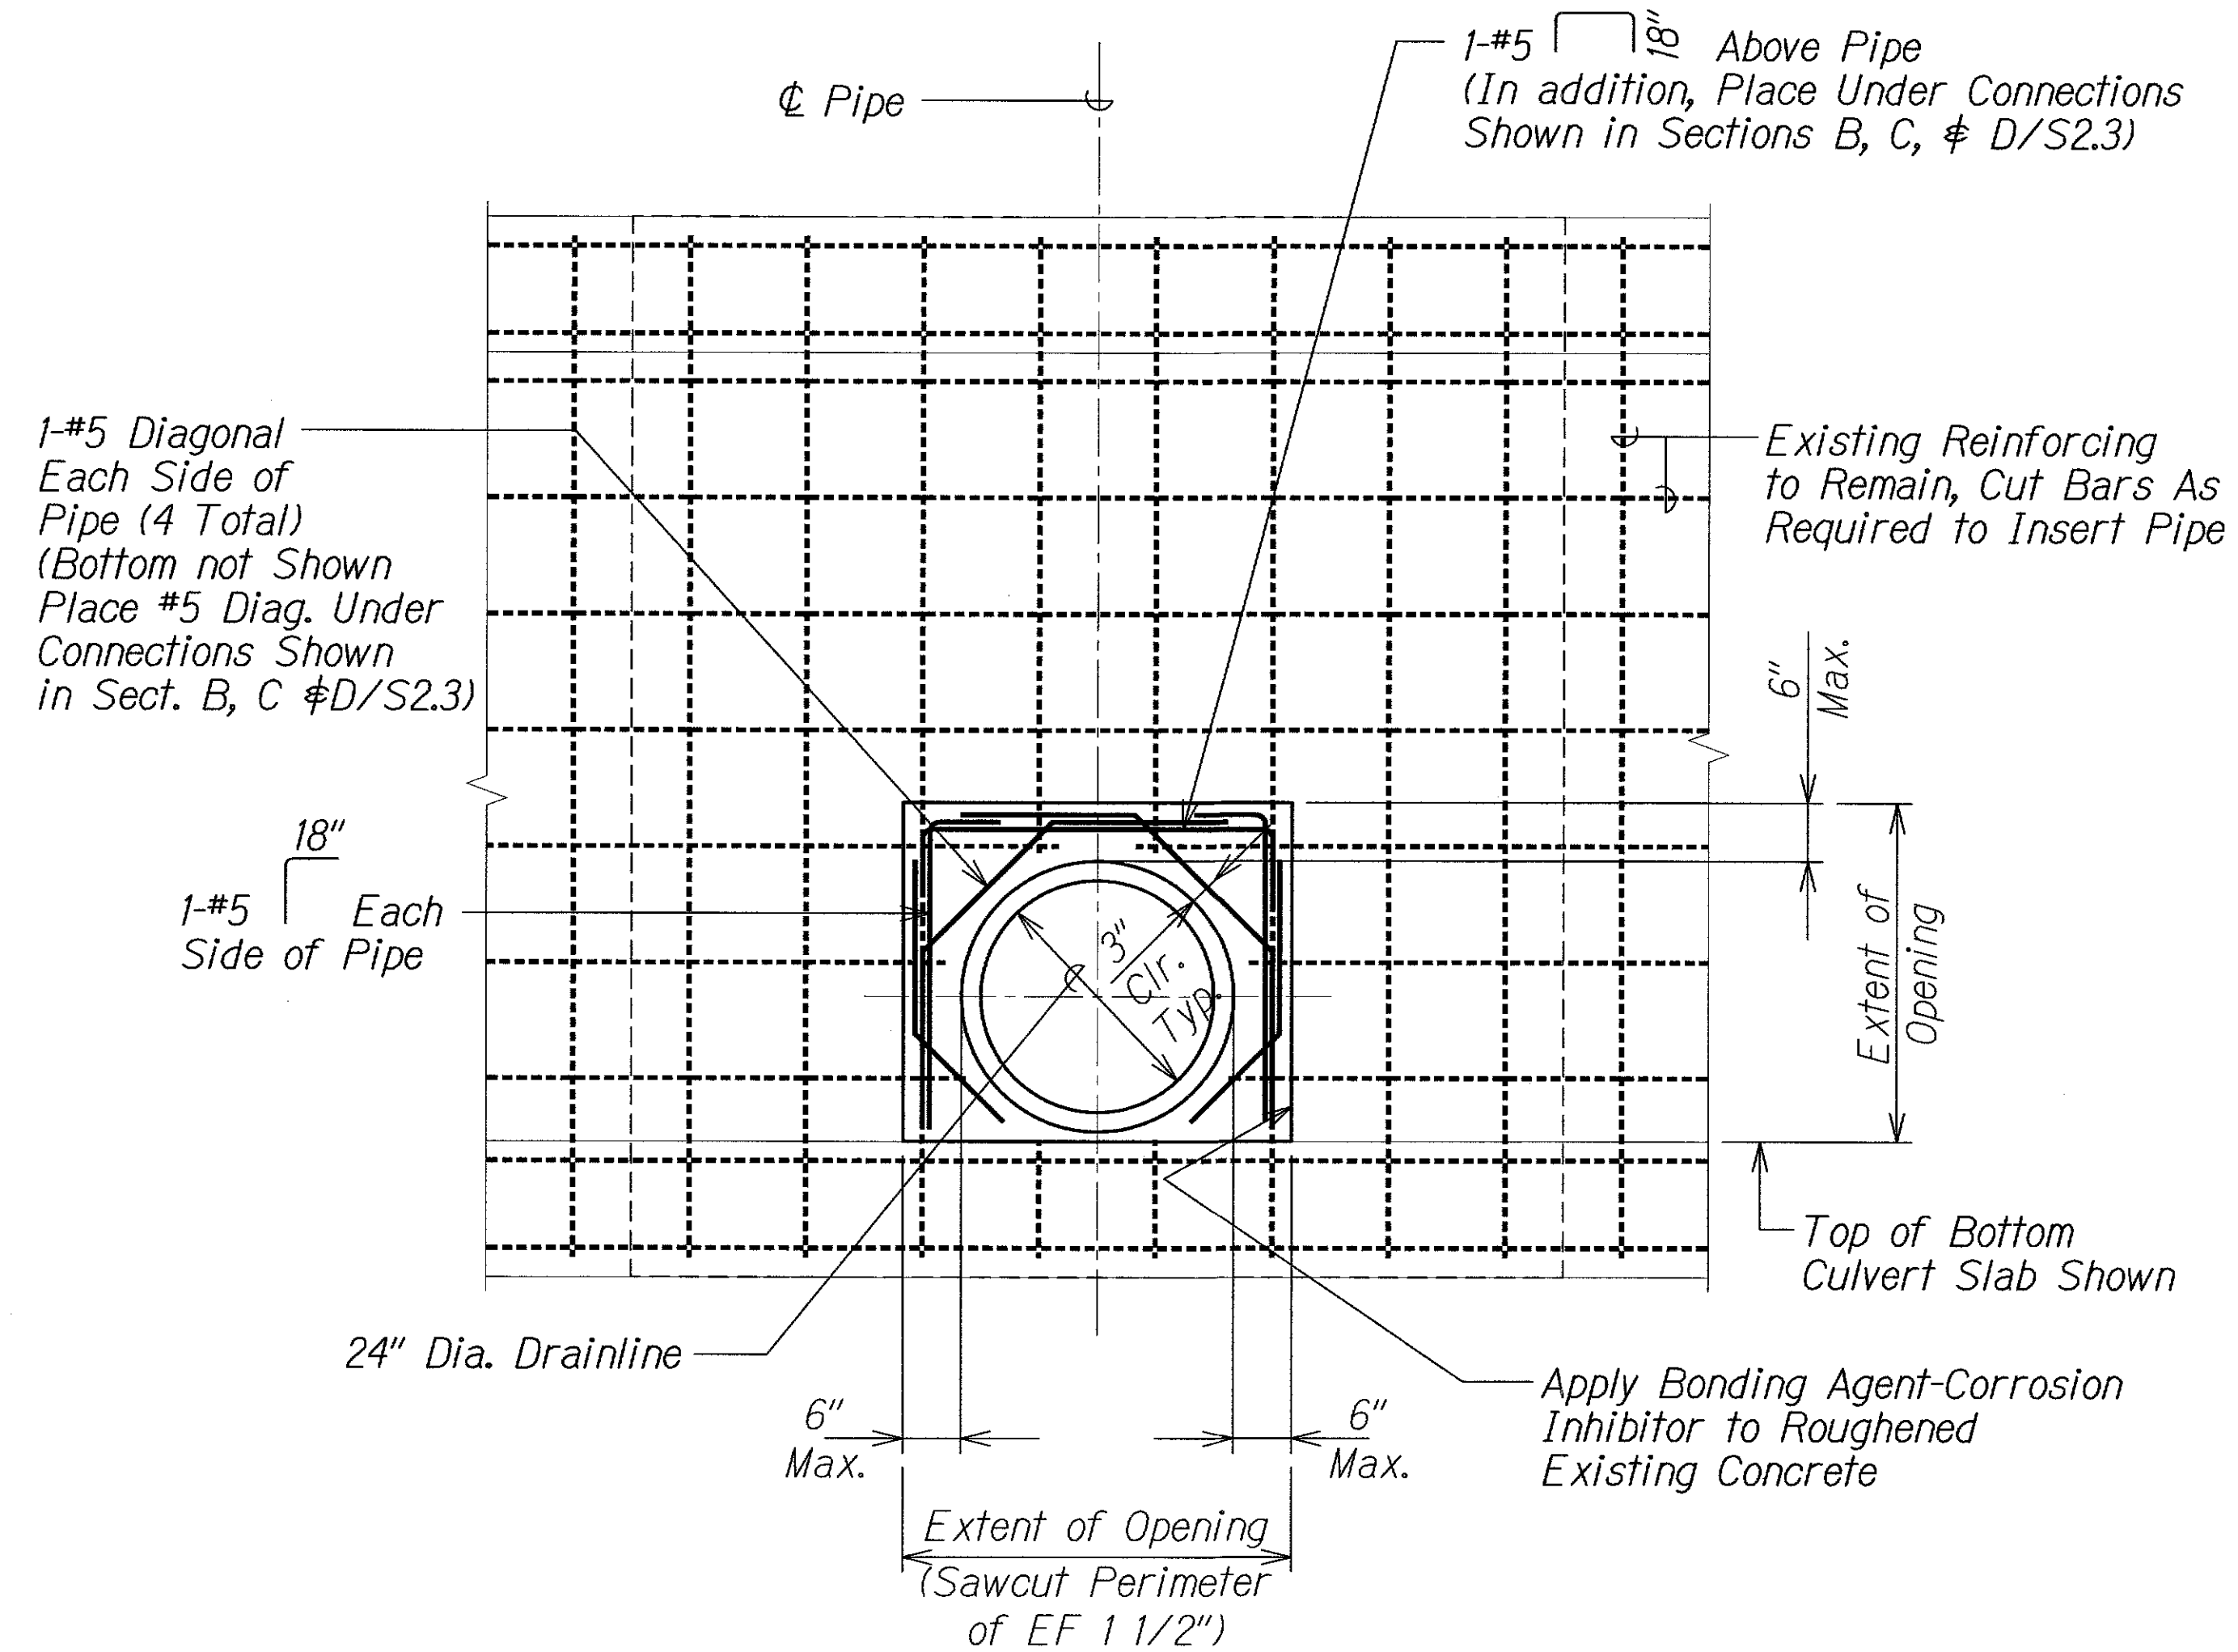

SECTION - ADDED REINFORCING WITHIN
EXISTING BOX CULVERT WALL AT OPENING B
Scale: 3/4" = 1'-0"

DATE	11/08/13
DESIGNED BY	ADD. 1 - Modified Section
CHECKED BY	
NOTED BY	
ORIGINAL PLAN	

DRAWING NAME: 2:00 ONGONG\12-026-FARRINGTON HWY. NAKAKULI TO HALEAKALA-UEHAWA\CAD\11-08-13 ADD\1\FHJ-S401 ADD.DWG PLOT TIME: 11-08-13 9:31 AM

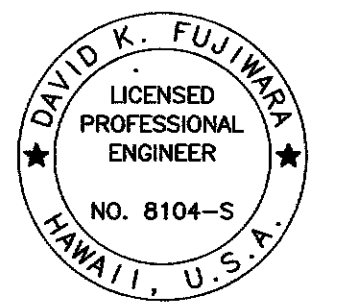


THIS WORK WAS PREPARED BY ME OR UNDER MY SUPERVISION.
David K. Fujiwara
KSF, INC. APRIL 30, 2014
LIC. EXP. DATE

STATE OF HAWAII
DEPARTMENT OF TRANSPORTATION
HIGHWAYS DIVISION
SECTIONS
FARRINGTON HIGHWAY INTERSECTION IMPROVEMENTS
AT NAKAKULI AVENUE AND HALEAKALA AVENUE
Federal-Aid Project No. STP-093-1(22)
Scale: As Shown Date: April 2013
SHEET No. S42 OF 3 SHEETS


11/08/13
DATE

1
REVISION

FED. ROAD DIST. NO.	STATE	FED. AID PROJ. NO.	FISCAL YEAR	SHEET NO.	TOTAL SHEETS
HAWAII	HAW.	STP-093-K22	2013	ADD. 196	230

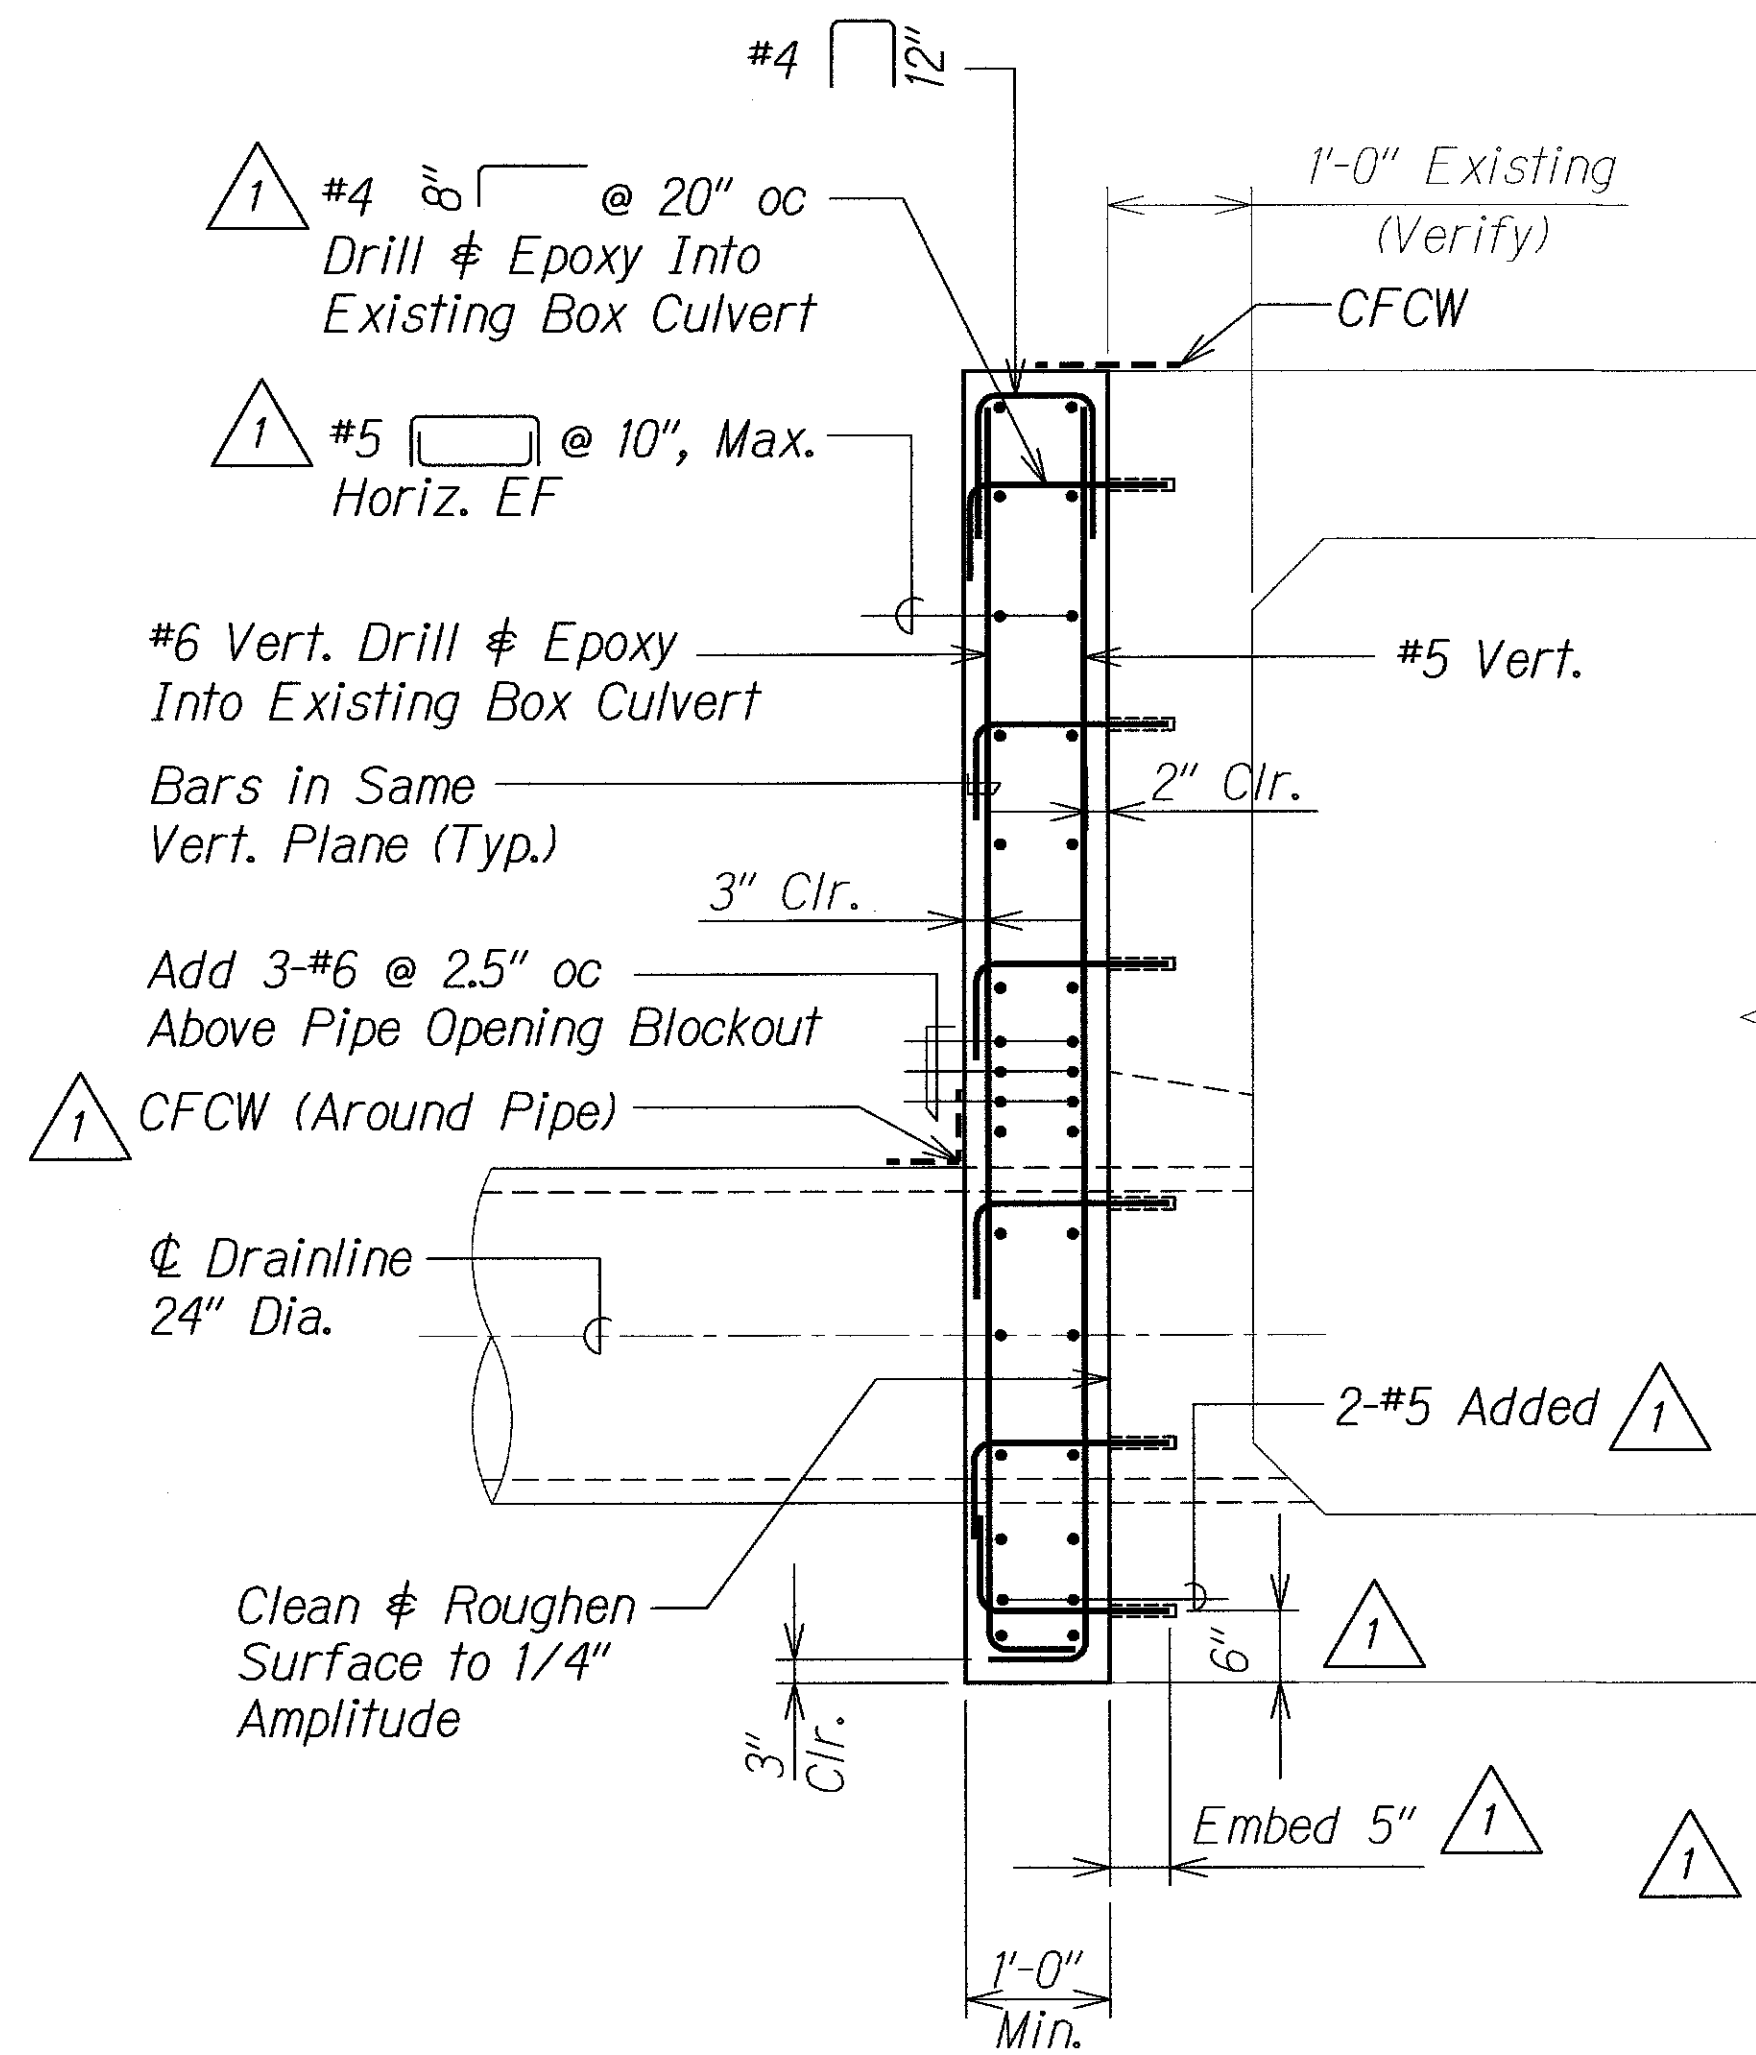


SECTION - ADDED WALL
AT 24" DIA. DRAINLINE A
Scale: 3/4" = 1'-0"

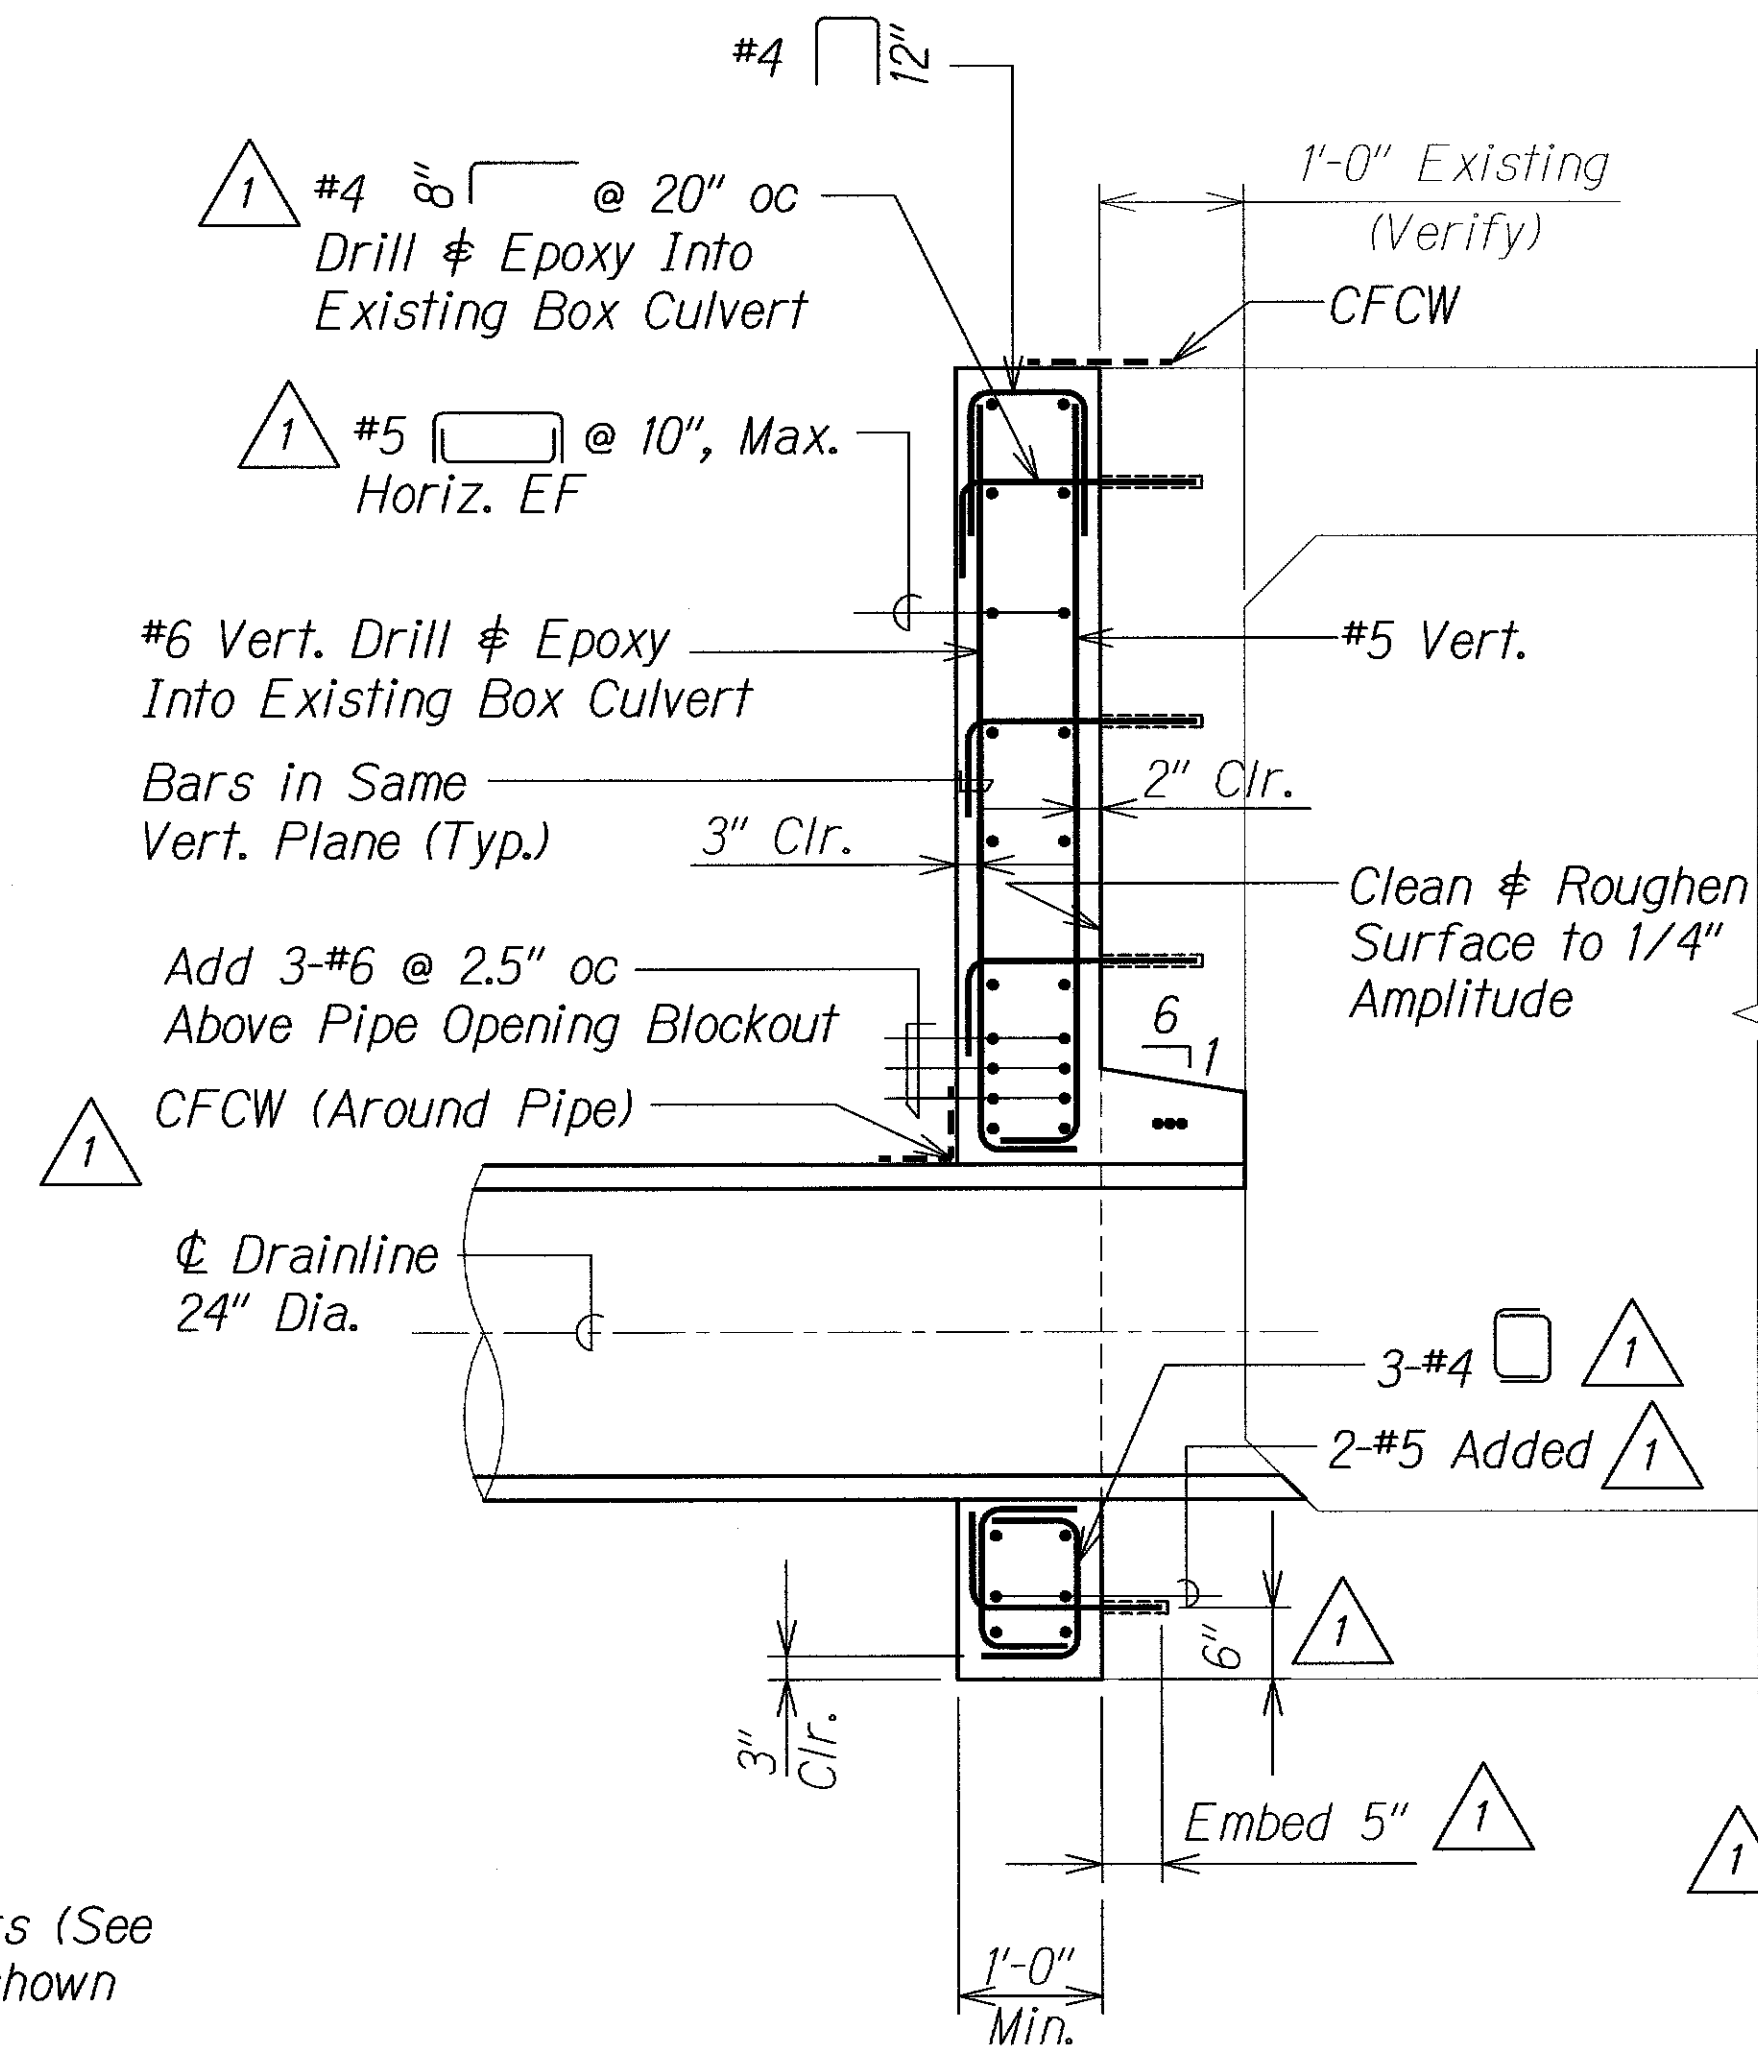

SECTION - ADDED WALL
AT 24" DIA. DRAINLINE B
Scale: 3/4" = 1'-0"

SURVEY PLOTTED BY	DATE
DRAWN BY	
TRACED BY	
CHECKED BY	
NO. BOOK	
QUANTITIES BY	
CHECKED BY	

DRAWING NAME: Z:\00 ONGOING\12-028-FARRINGTON HWY NANAKULI TO HALEAKALA-ULEHAWA\CAD\11-08-13 ADD\VFH-S401 ADD.DWG PLOT TIME: 11-08-13, 9:26 AM

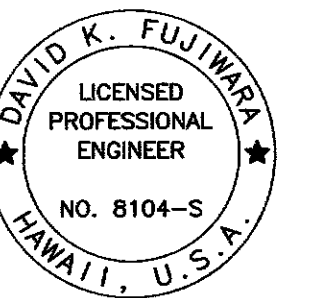

THIS WORK WAS PREPARED BY ME
OR UNDER MY SUPERVISION.
David K. Fujiwara
KSF, INC. APRIL 30, 2014
LIC. EXP. DATE

STATE OF HAWAII
DEPARTMENT OF TRANSPORTATION
HIGHWAYS DIVISION

SECTIONS


FARRINGTON HIGHWAY INTERSECTION IMPROVEMENTS
AT NANAKULI AVENUE AND HALEAKALA AVENUE
Federal-Aid Project No. STP-093-K22

Scale: As Shown Date: April 2013


SHEET No. S4.3 OF 3 SHEETS

11/08/13	1 Add. 1 - Modified Sections
DATE	REVISION

FED. ROAD DIST. NO.	STATE	FED. AID PROJ. NO.	FISCAL YEAR	SHEET NO.	TOTAL SHEETS
HAWAII	HAW.	STP-093-1(22)	2013	ADD. 197	230

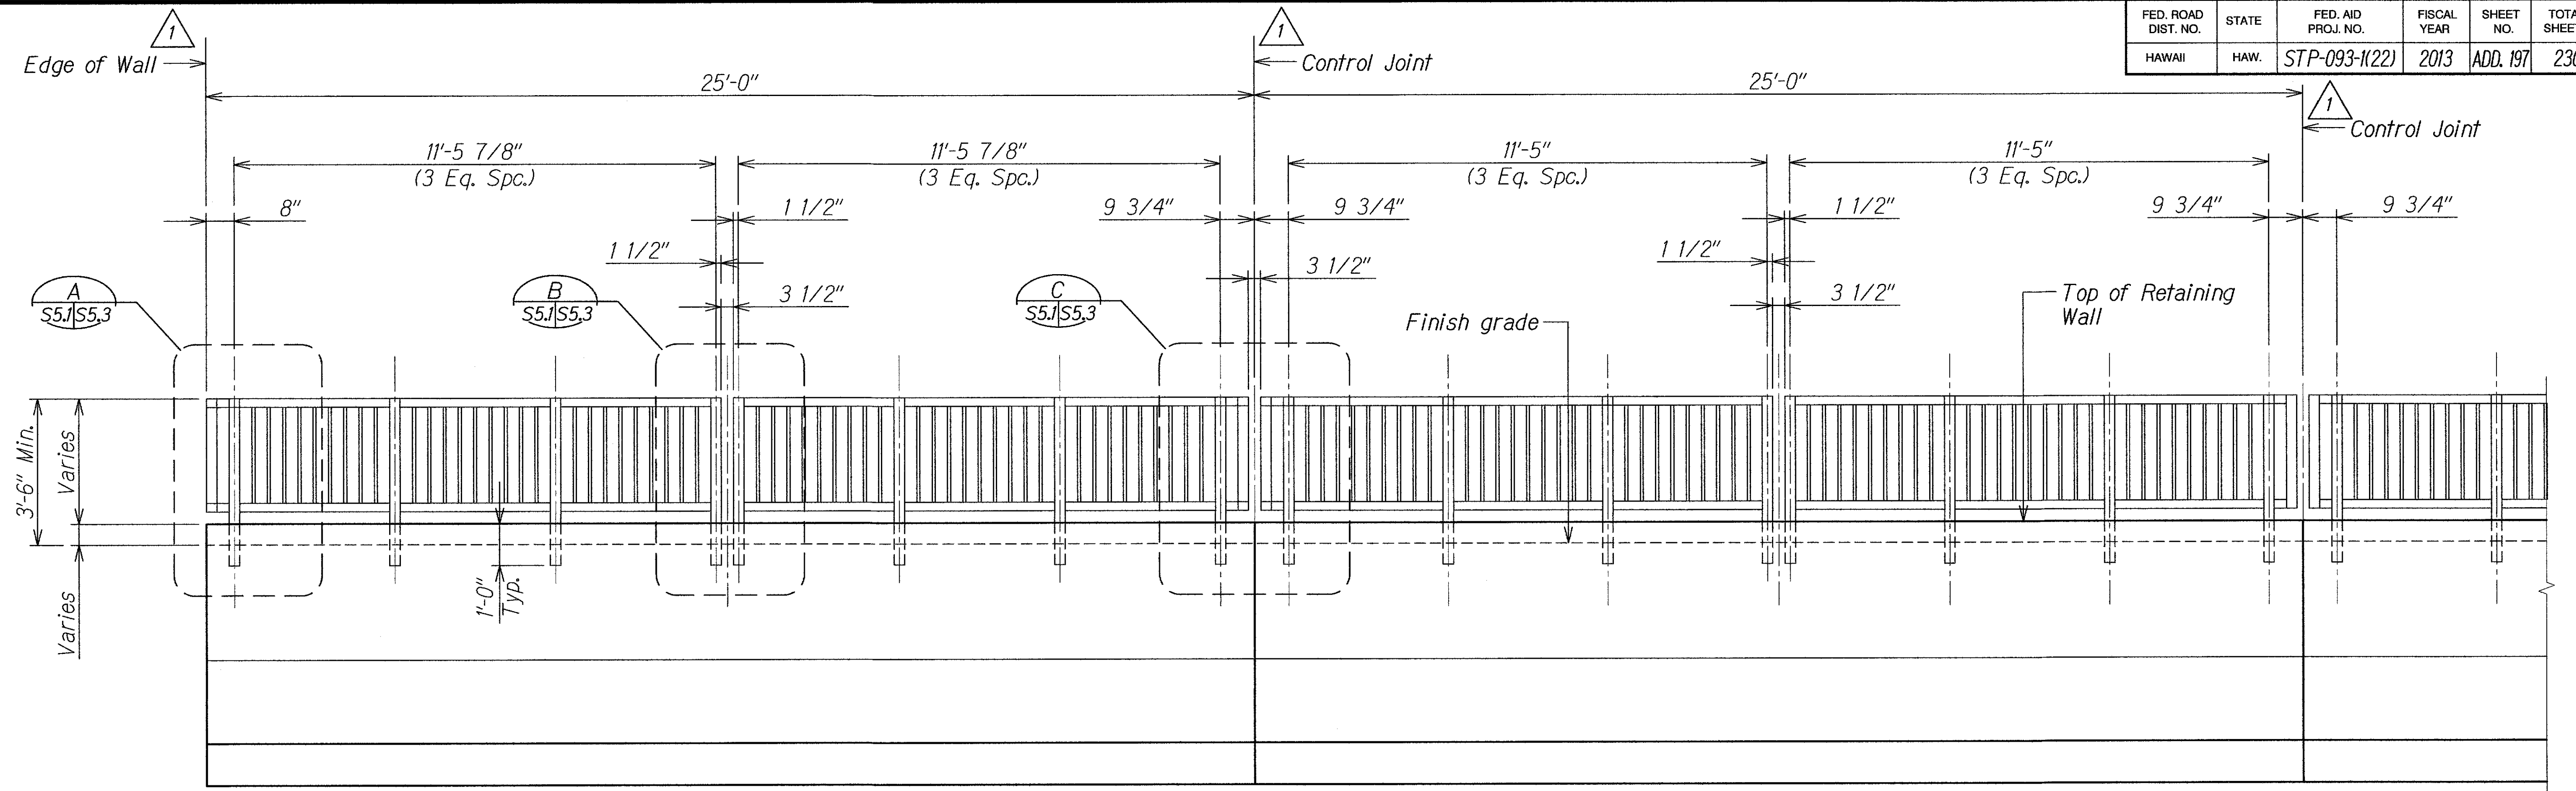


ELEVATION - FRP PEDESTRIAN RAILING AT RETAINING WALL
Scale: 1/2" = 1'-0"

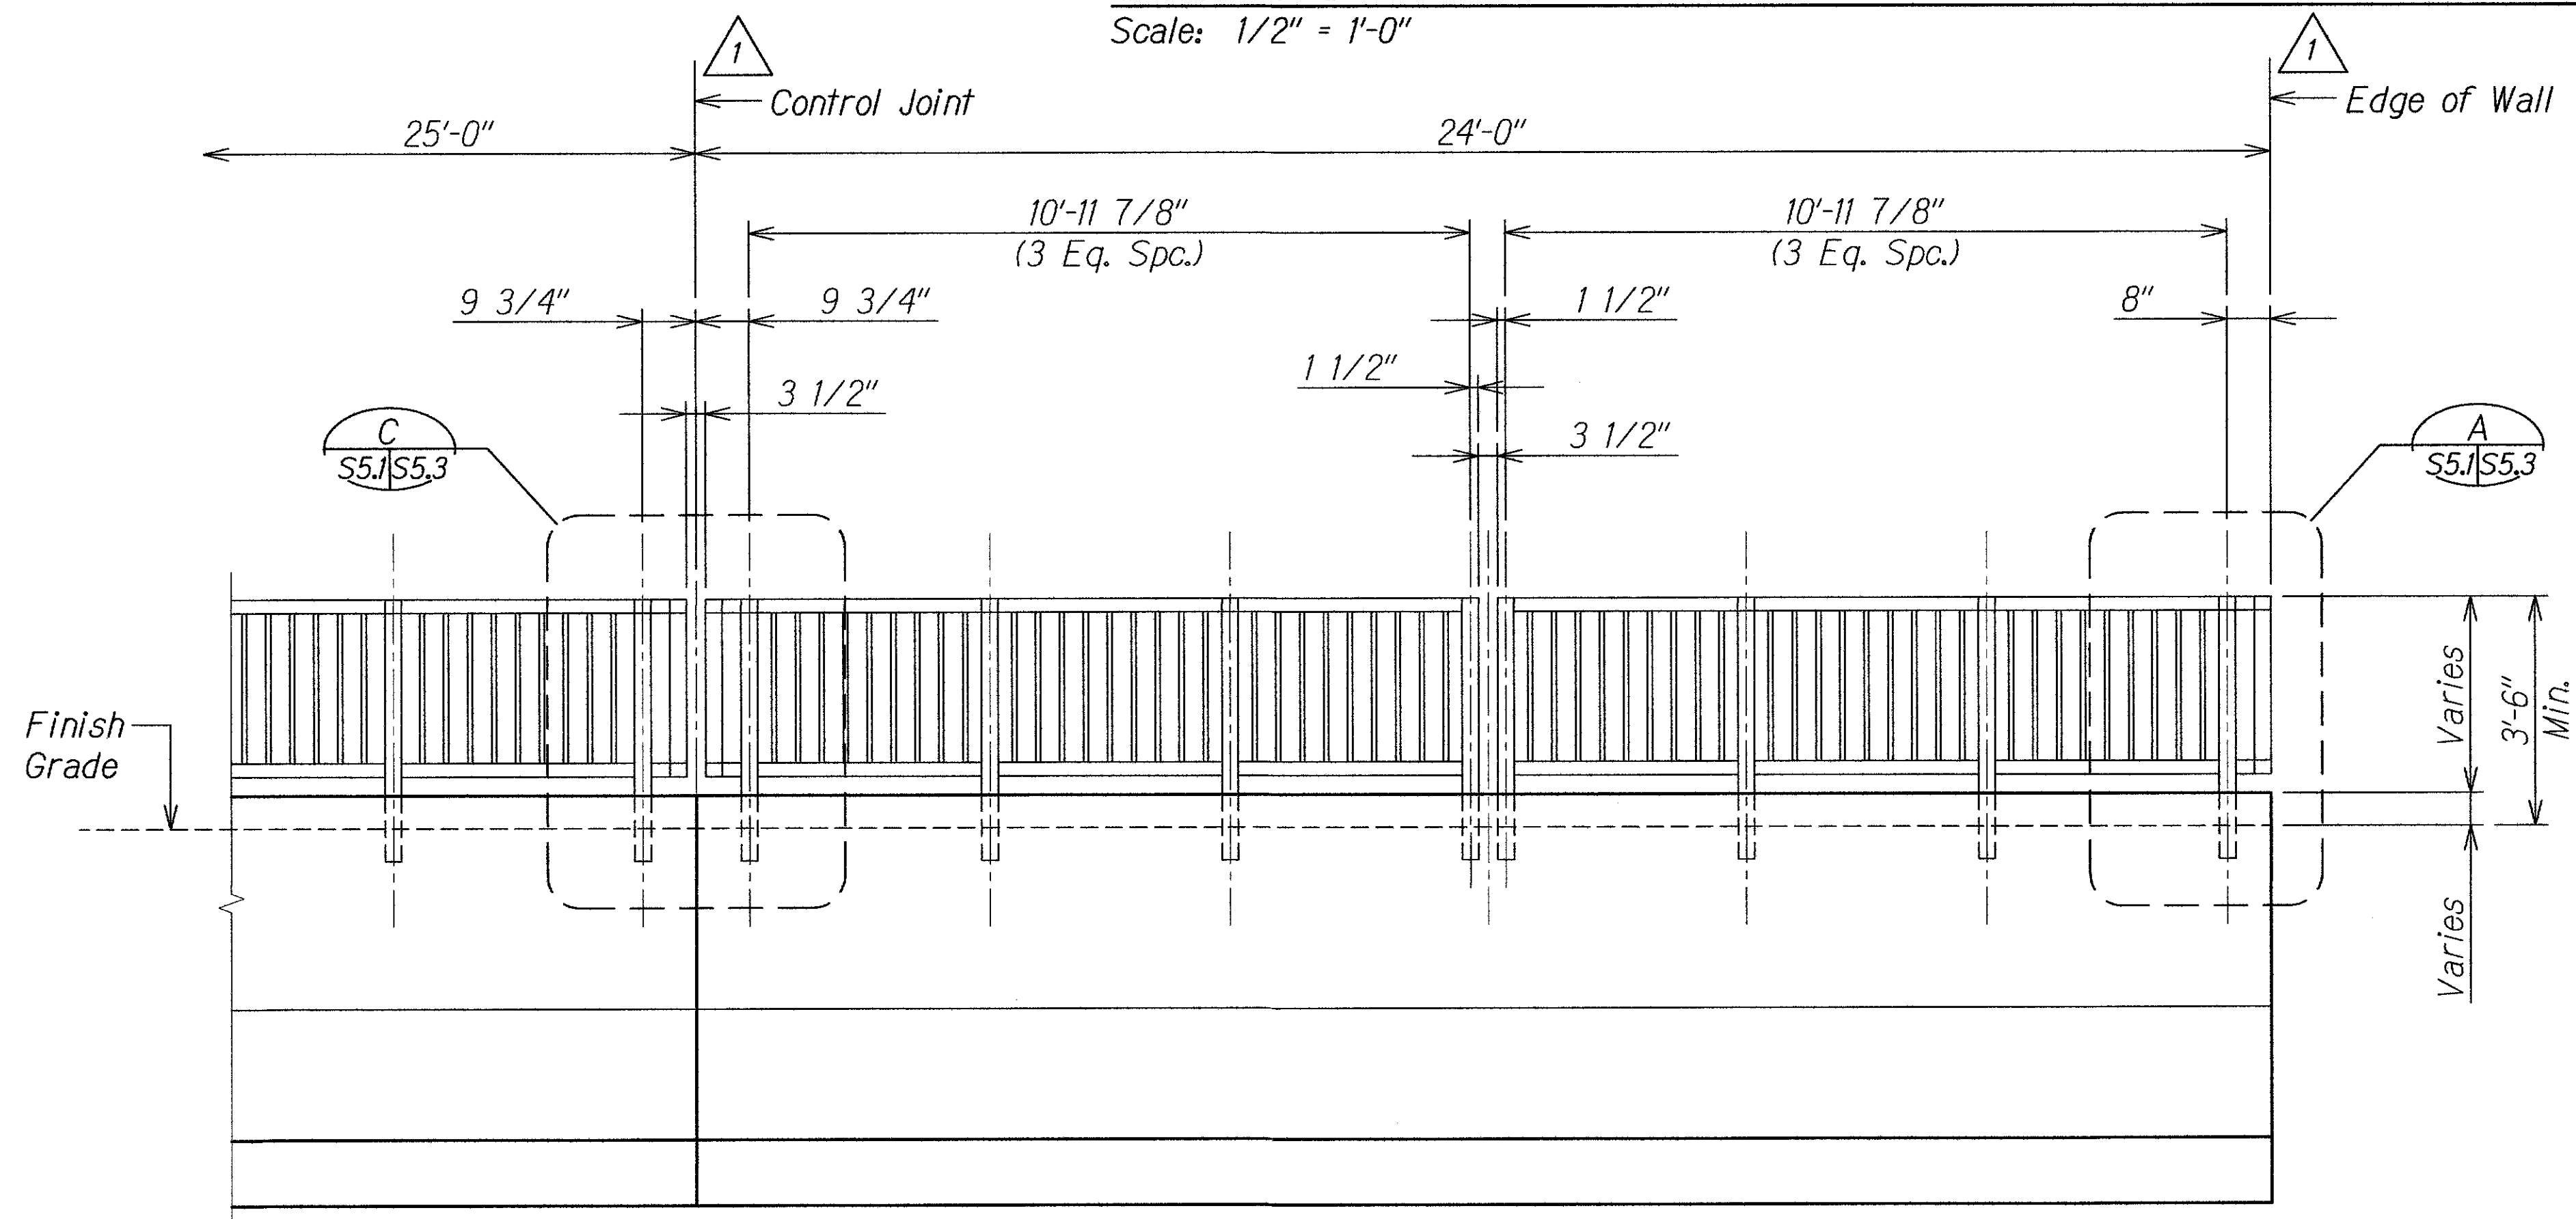

ELEVATION - FRP PEDESTRIAN RAILING AT END OF RETAINING WALL
Scale: 1/2" = 1'-0"

Note:
Contractor shall verify and coordinate FRP Railing supply lengths with retaining wall Control Joint locations.

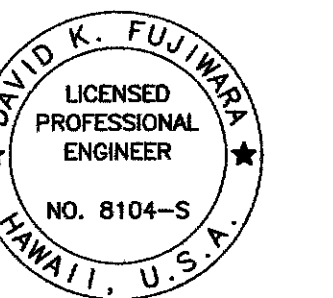

THIS WORK WAS PREPARED BY ME OR UNDER MY SUPERVISION.
David K. Fujiwara
KSF, INC. APRIL 30, 2014
LIC. EXP. DATE


SURVEY PLOTTED BY	DATE
DRAWN BY	
DESIGNED BY	
QUANTITIES BY	
CHECKED BY	
ORIGINAL PLAN	
NOTE BOOK	
No.	

DRAWING NAME: Z:\00 DONG\12-026-FARRINGTON HWY NAKAKULI TO HALEAKALA-UEHAWA\CAD\11-08-13 ADD\THU-SS01 ADD.DWG PLOT TIME: 11-04-13, 5:01 PM

11/08/13	1	Add. 1 - Added Callouts & Note
DATE	REVISION	

STATE OF HAWAII DEPARTMENT OF TRANSPORTATION HIGHWAYS DIVISION FRP PEDESTRIAN RAILING ELEVATIONS FARRINGTON HIGHWAY INTERSECTION IMPROVEMENTS AT NAKAKULI AVENUE AND HALEAKALA AVENUE Federal-Aid Project No. STP-093-1(22) Scale: As Shown Date: April 2013 SHEET No. S5J OF 3 SHEETS


FED. ROAD DIST. NO.	STATE	FED. AID PROJ. NO.	FISCAL YEAR	SHEET NO.	TOTAL SHEETS
HAWAII	HAW.	STP-093-1(22)	2013	198	230

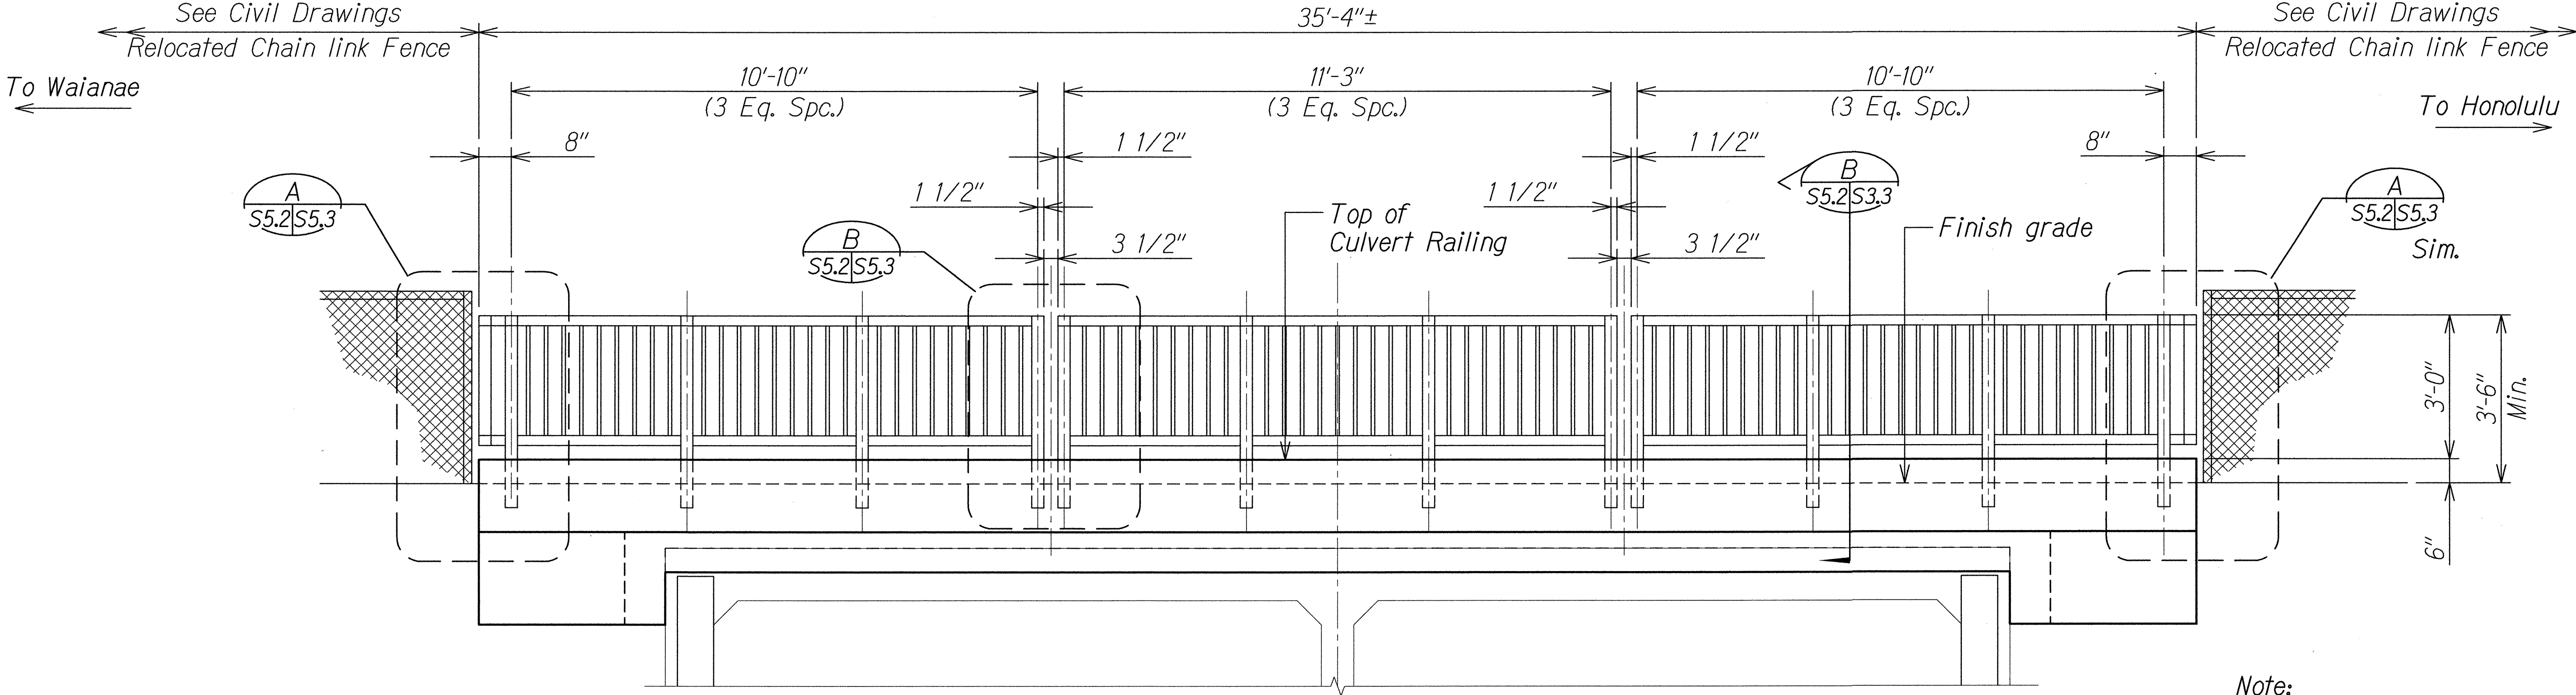

ELEVATION - FRP PEDESTRIAN RAILING AT CULVERT EXTENSION
Scale: 1/2" = 1'-0"

ORIGINAL PLAN	SURVEY PLATTED BY	DATE
NOTE BOOK	DRAWN BY	
No.	DESIGNED BY	
	CHECKED BY	


DRAWING NAME: Z:\00 ONGOING\12-026-FARRINGTON HWY NAKAKULI TO HALEAKALA-UEHAWA\CAD\07-17-13 FINAL 100% FHU-S501.DWG PLOT TIME: 07-16-13, 4:15 PM

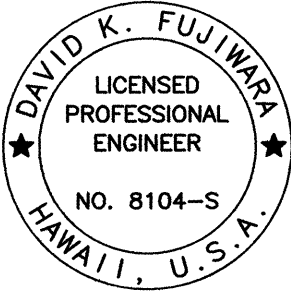

THIS WORK WAS PREPARED BY ME
OR UNDER MY SUPERVISION.
David K. Fujiwara
KSF, INC. APRIL 30, 2014
LIC. EXP. DATE

STATE OF HAWAII
DEPARTMENT OF TRANSPORTATION
HIGHWAYS DIVISION
FRP PEDESTRIAN RAILING
ELEVATION
FARRINGTON HIGHWAY INTERSECTION IMPROVEMENTS
AT NAKAKULI AVENUE AND HALEAKALA AVENUE
Federal-Aid Project No. STP-093-1(22)
Scale: As Shown Date: April 2013
SHEET No. S5.2 OF 3 SHEETS

FED. ROAD DIST. NO.	STATE	FED. AID PROJ. NO.	FISCAL YEAR	SHEET NO.	TOTAL SHEETS
HAWAII	HAW.	STP-093-1(22)	2013	ADD. 199	230

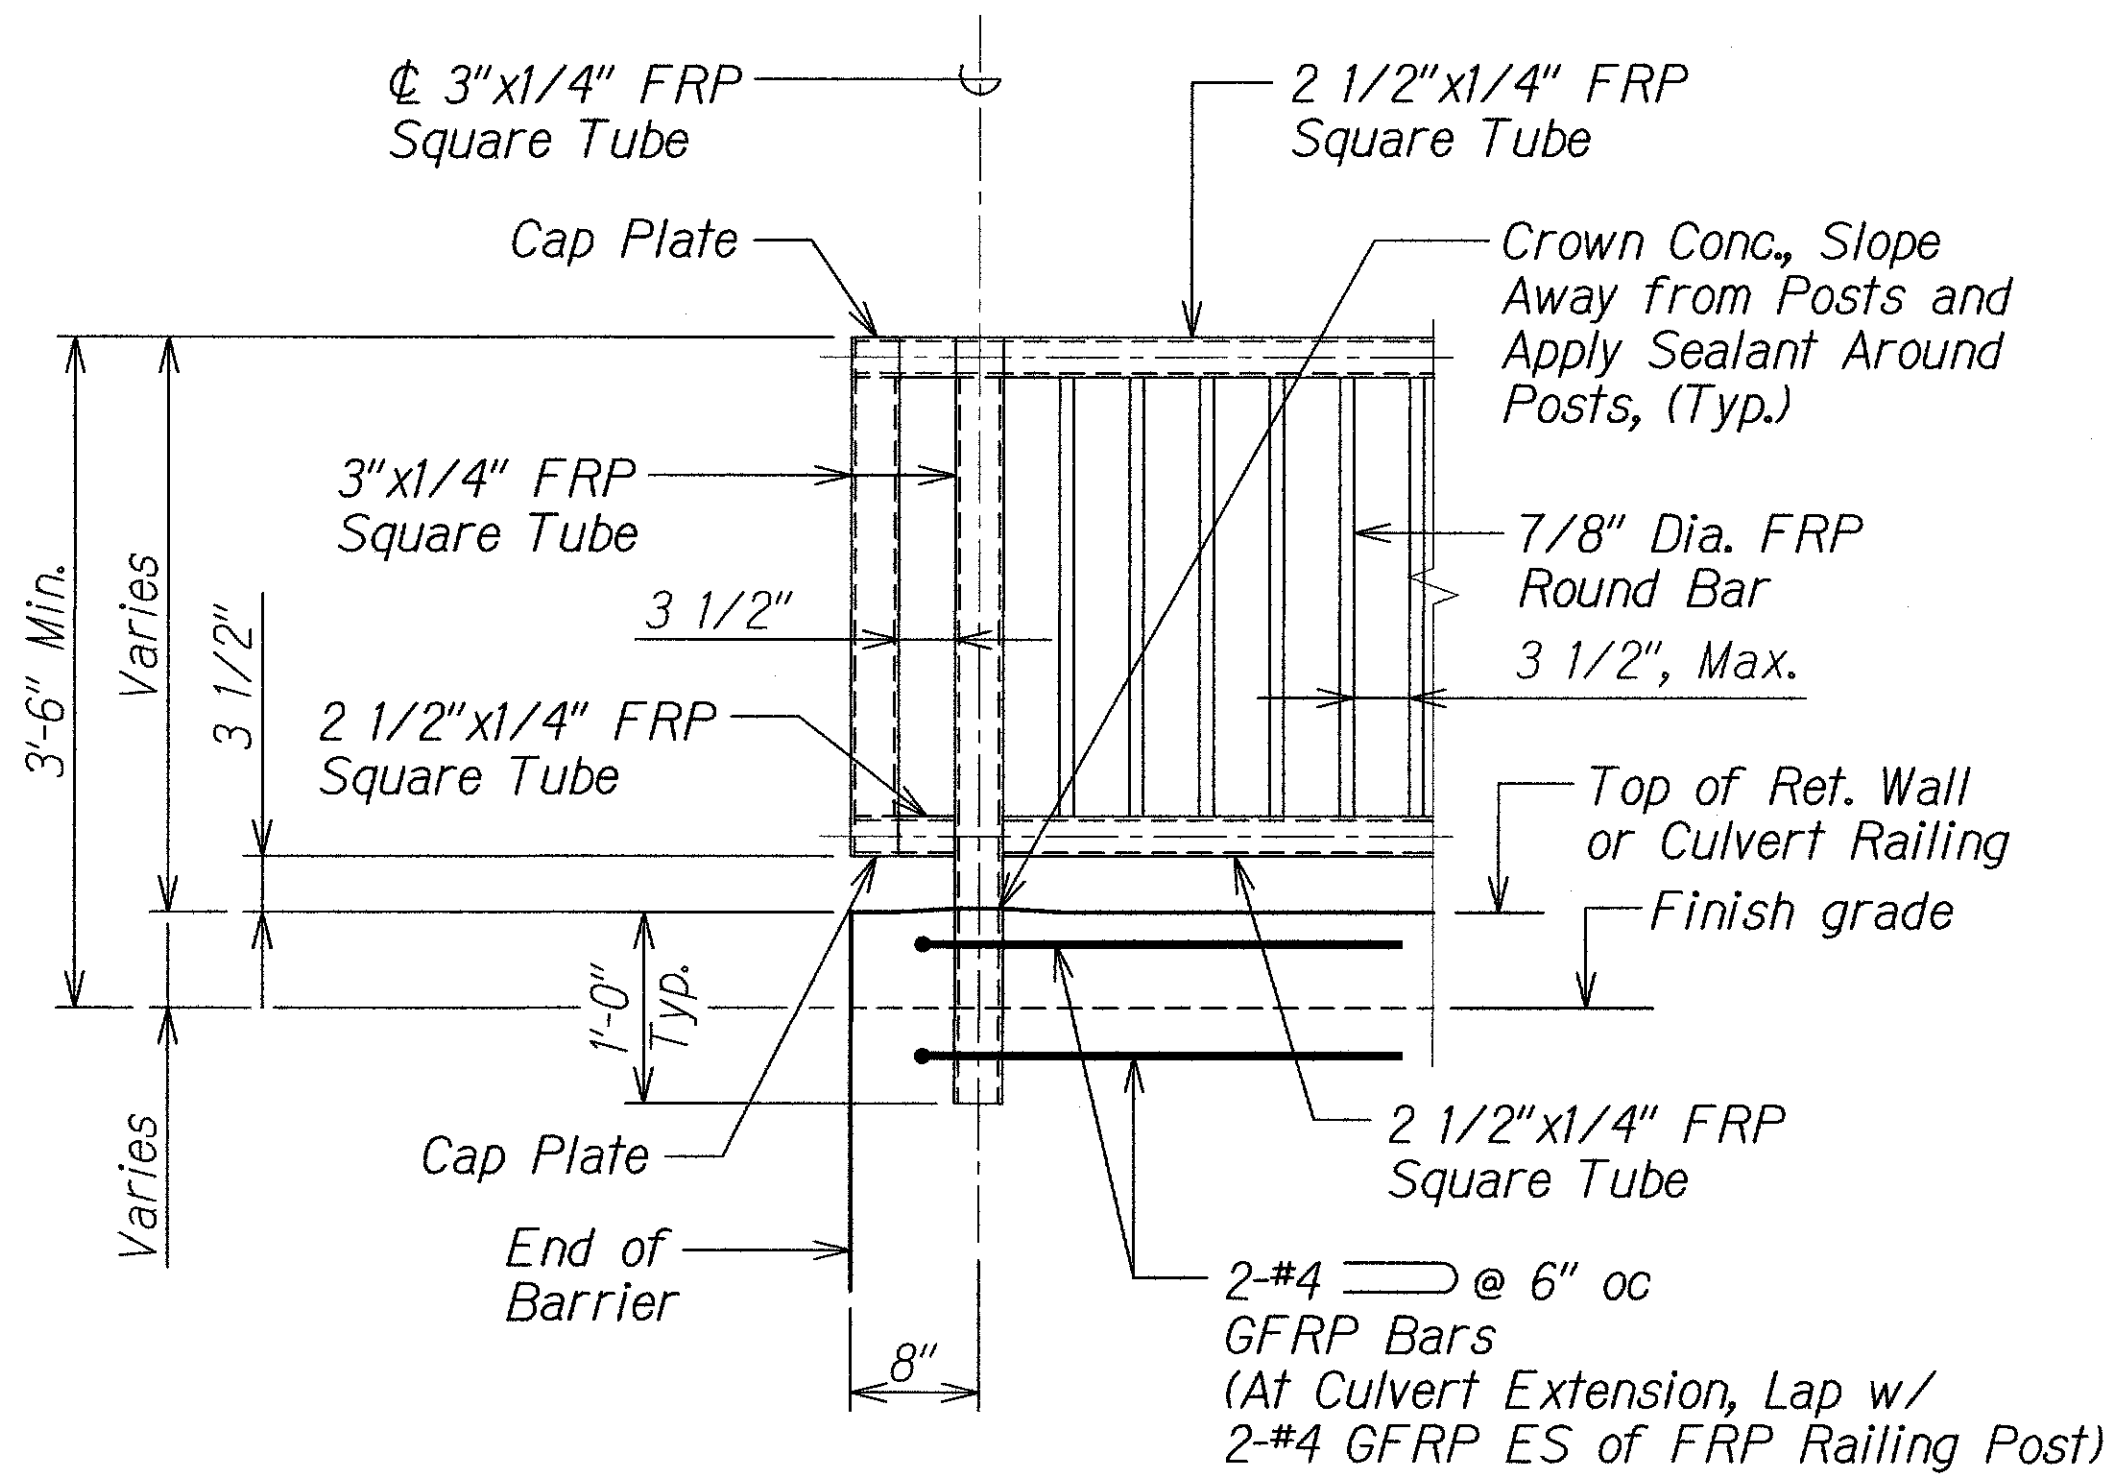


ELEVATION - END CONDITION FRP PEDESTRIAN RAILING ON RET. WALL OR CULVERT EXTENSION

Scale: 1" = 1'-0"

S5.2 S5.3

A
S5.1 S5.3

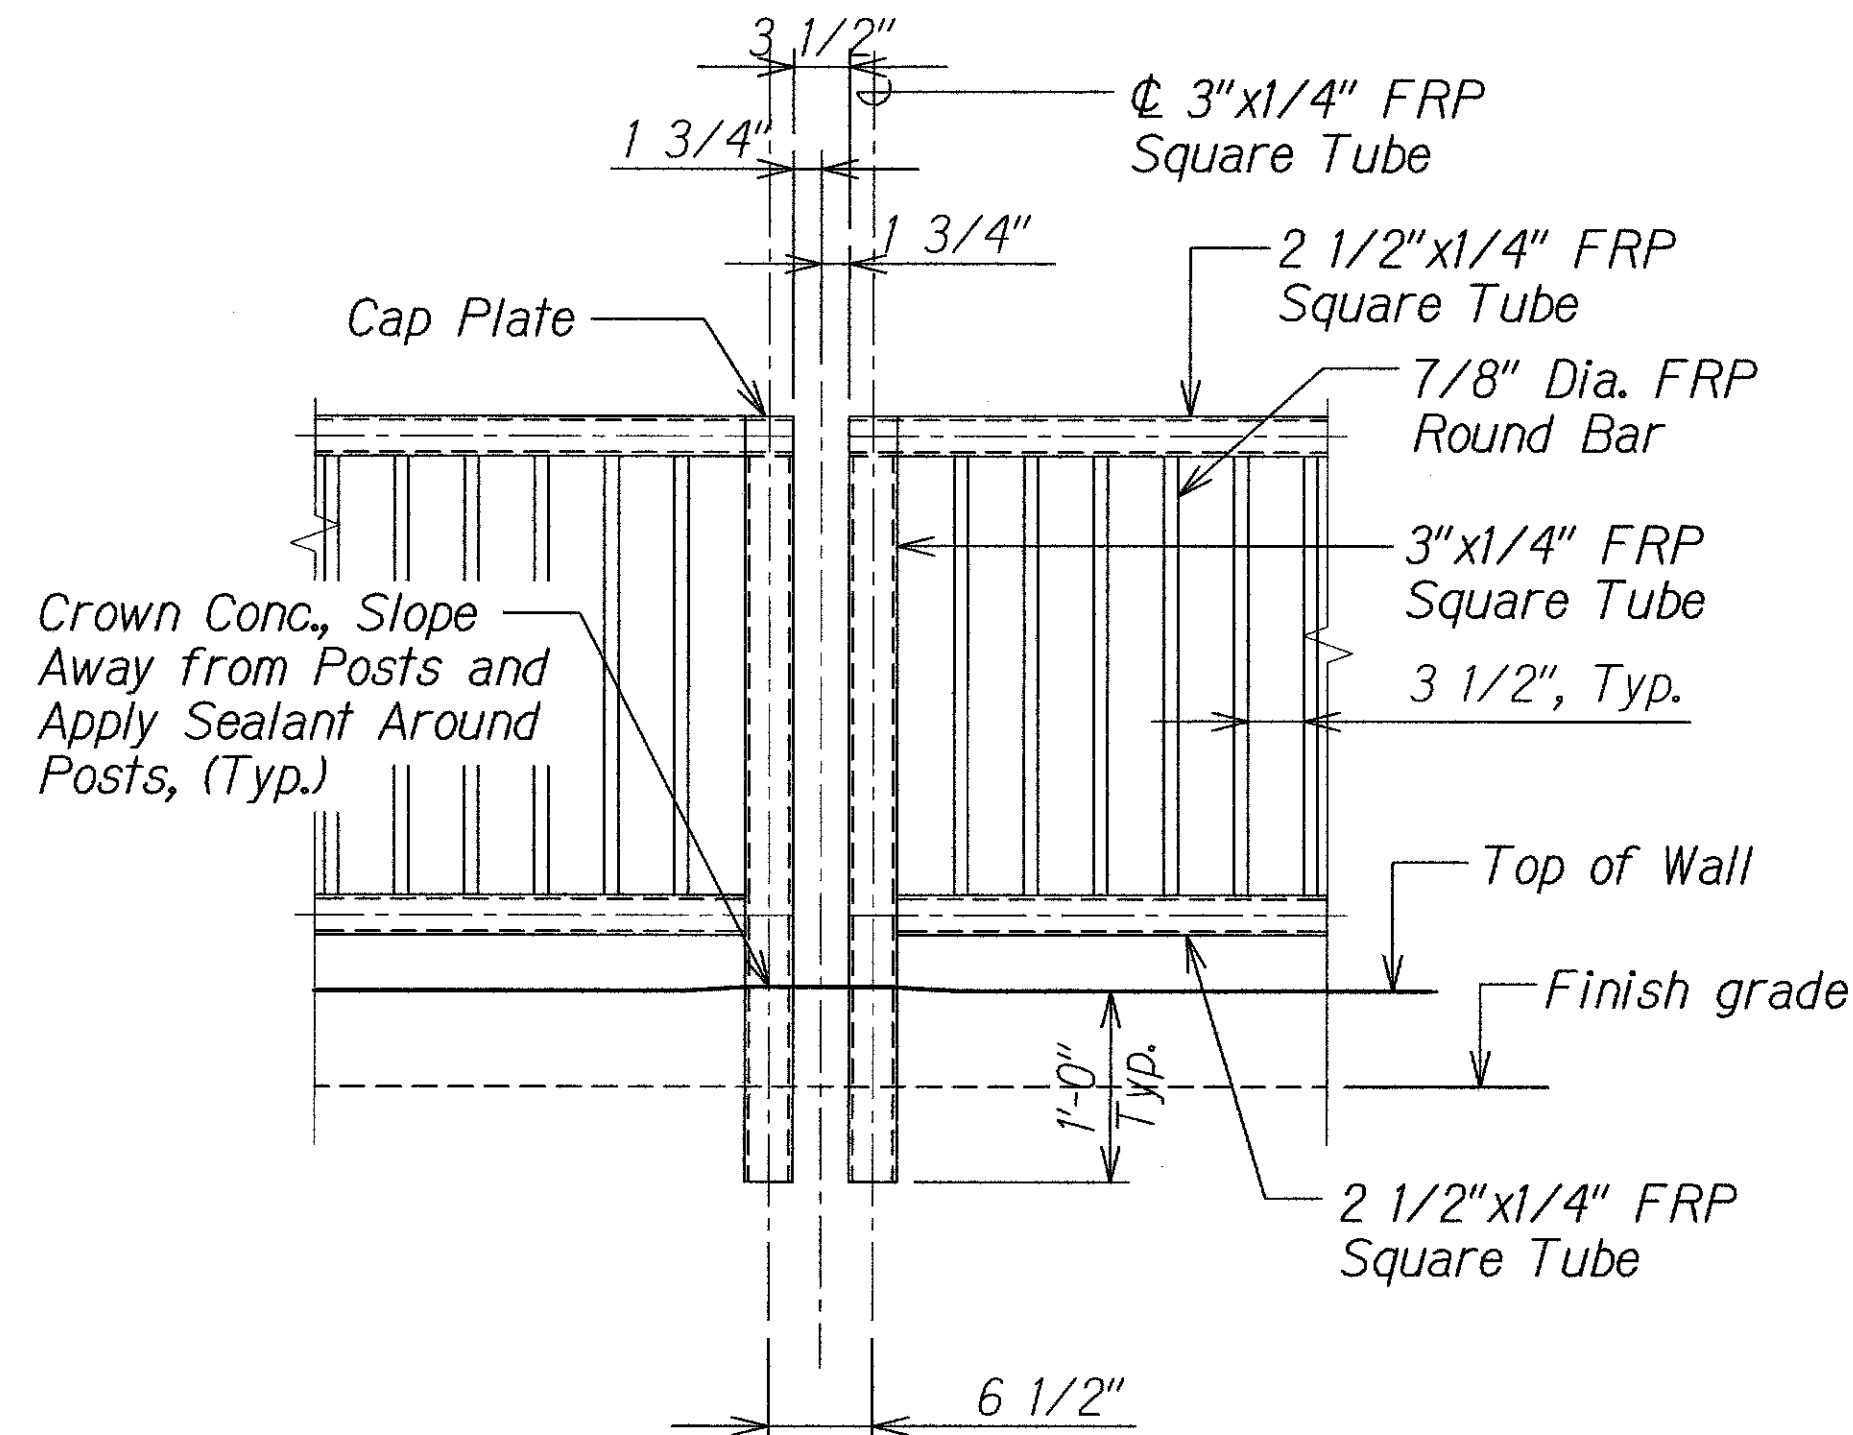


ELEVATION - AT TYPICAL BETWEEN PANEL FRP PEDESTRIAN RAILING ON RET. WALL OR CULVERT EXTENSION

Scale: 1" = 1'-0"

S5.2 S5.3

B
S5.1 S5.3

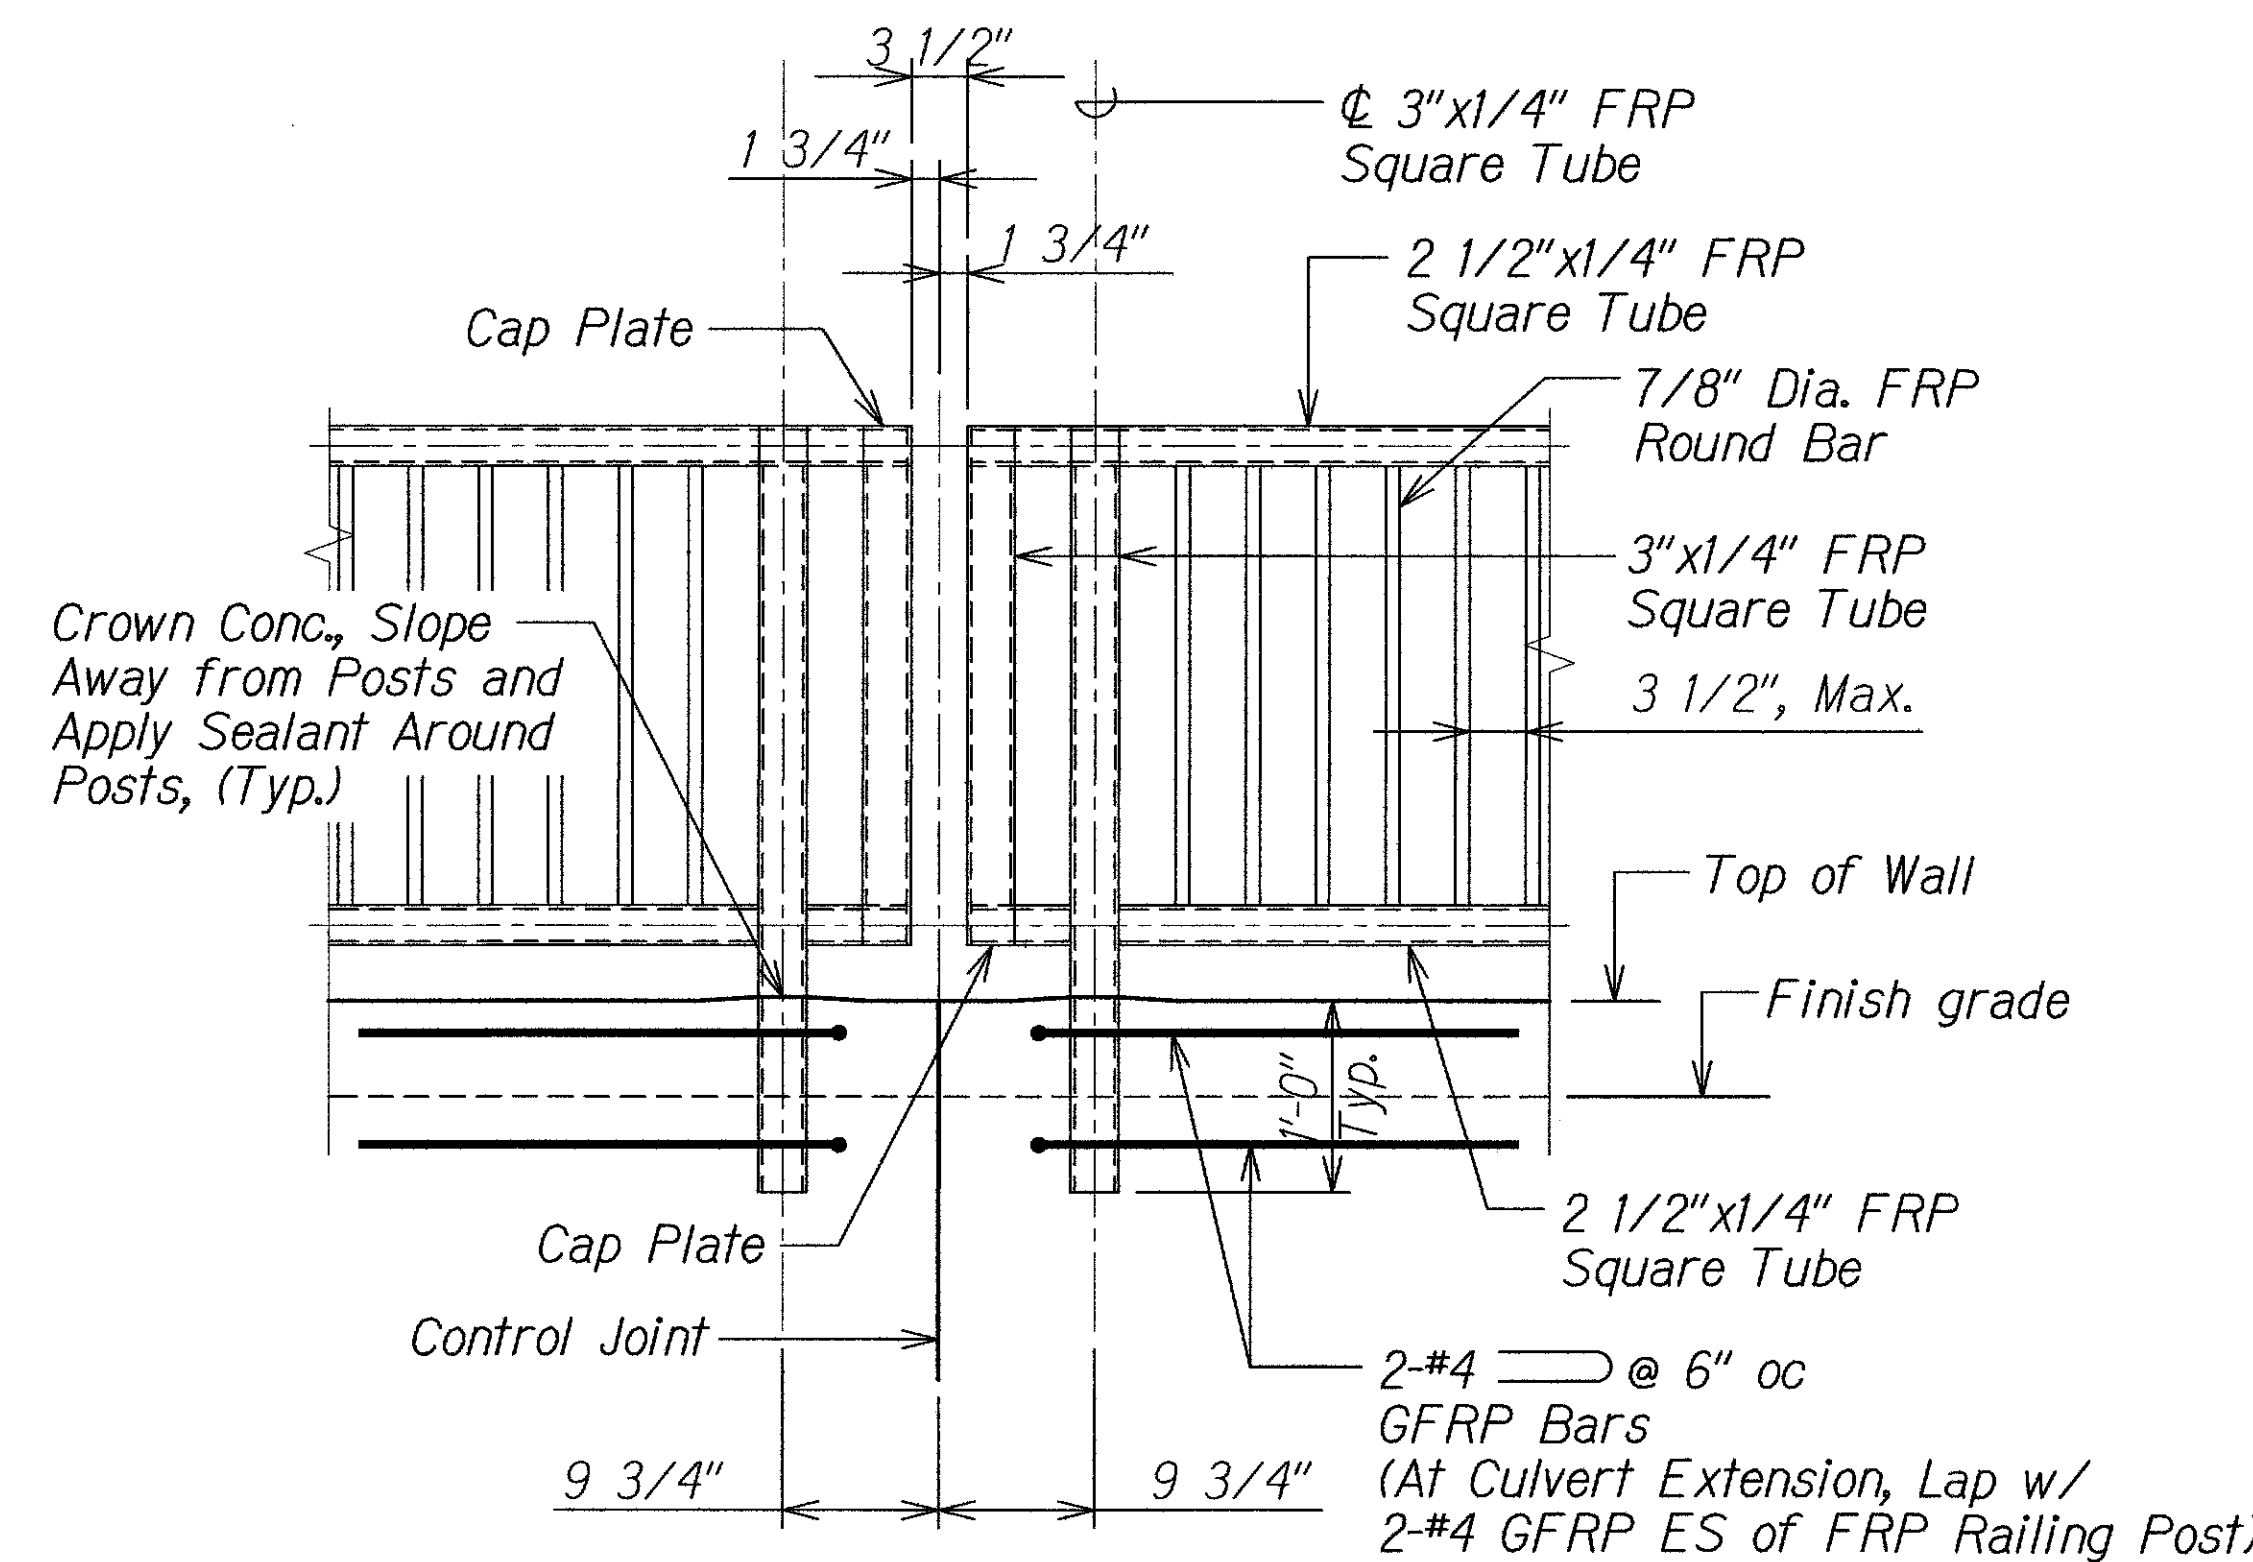


ELEVATION - AT CONTROL JOINT FRP PEDESTRIAN RAILING ON RET. WALL OR CULVERT EXTENSION

Scale: 1" = 1'-0"

S5.3

C
S5.1 S5.3

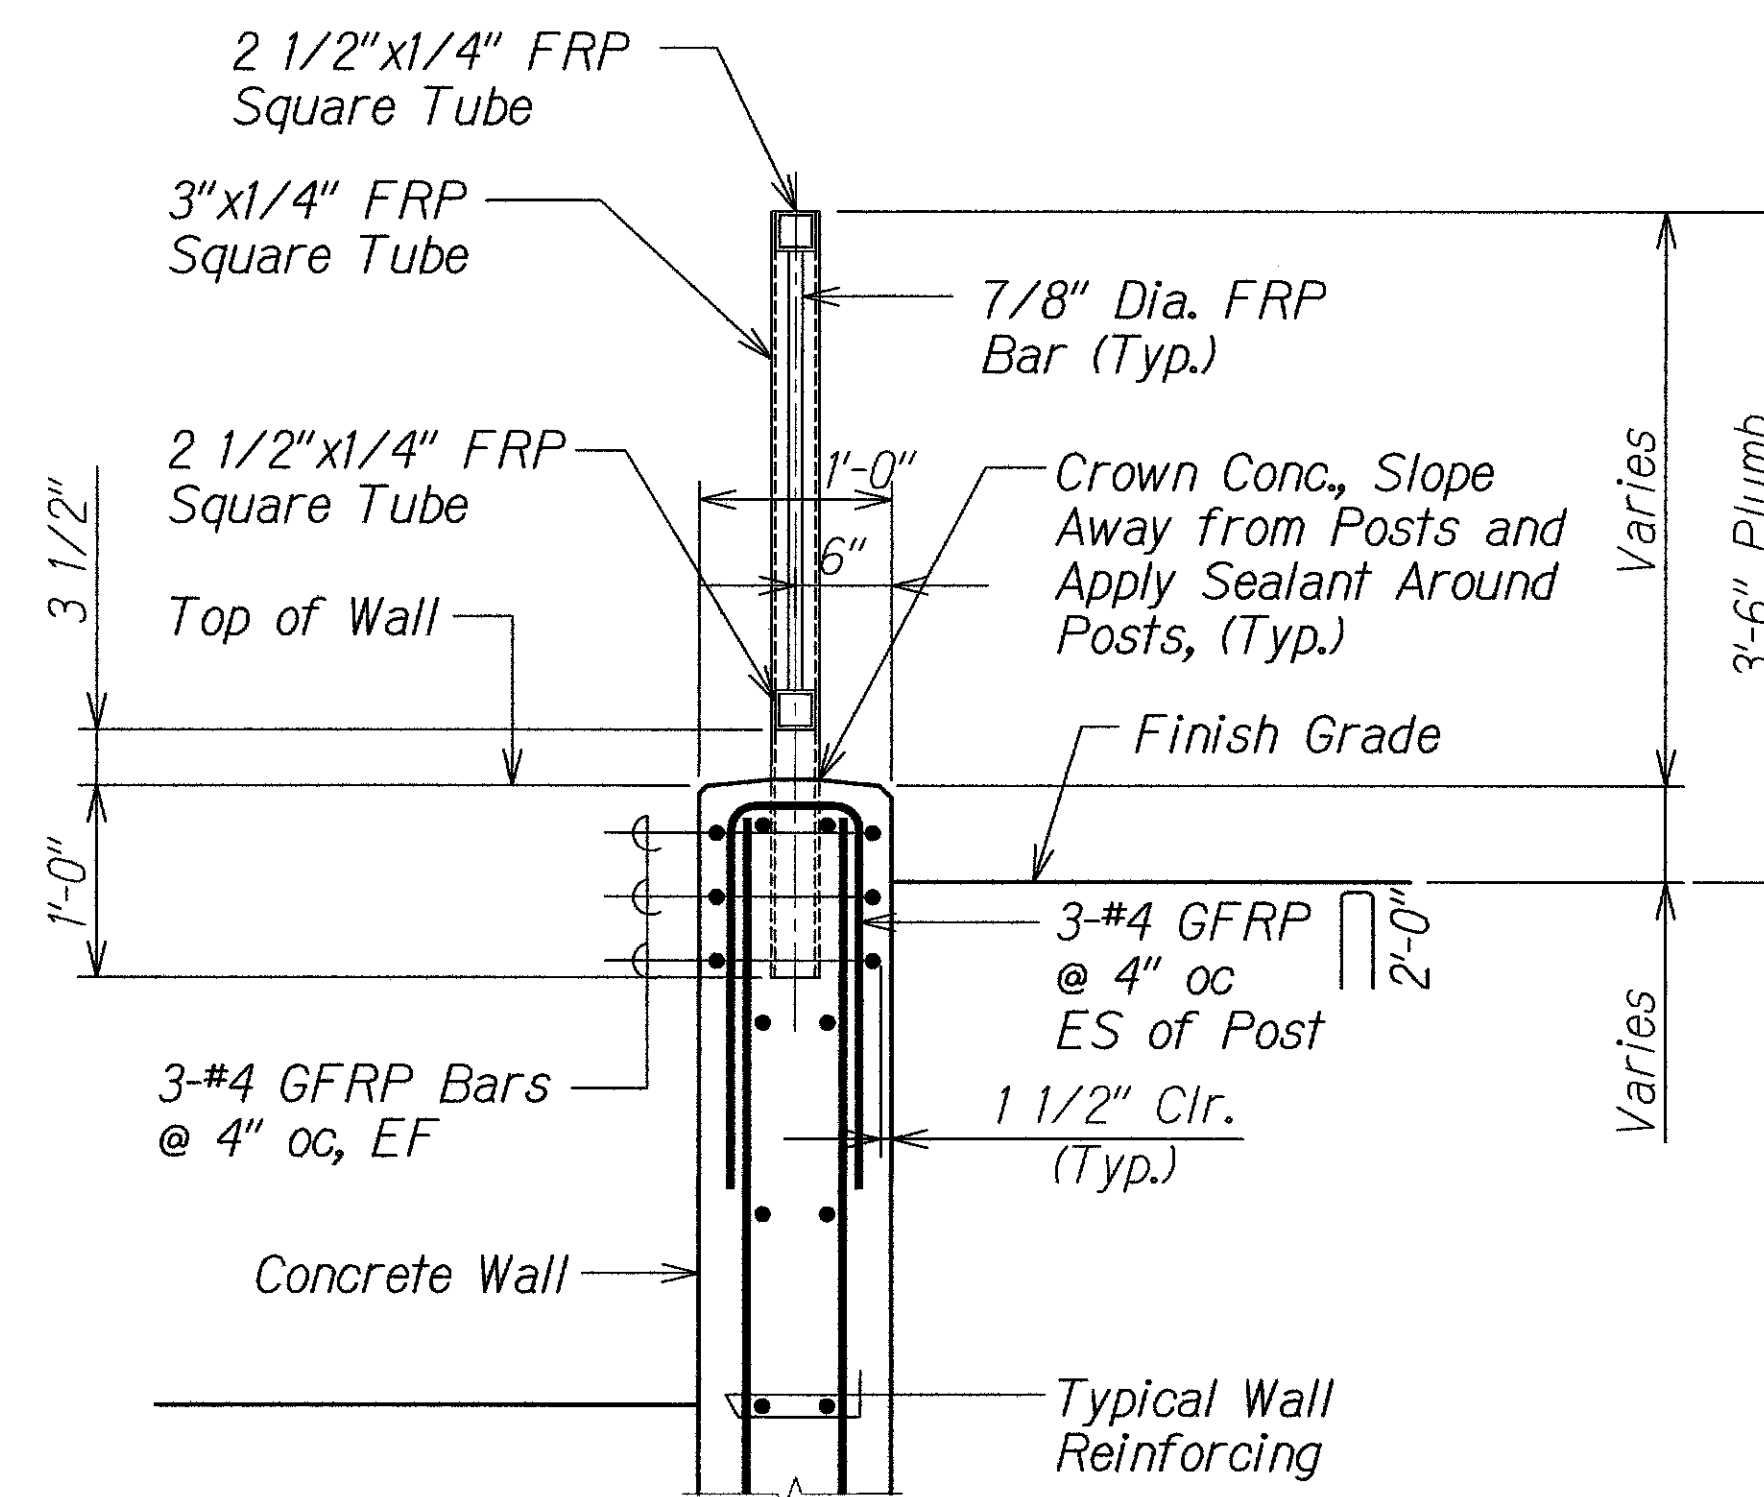

TYPICAL RAILING SECTION

Scale: 1" = 1'-0"


S5.3 S5.3

D
S5.3 S5.3

Notes:

- Top of railing shall be 3'-6" above finish grade adjacent to the railing.
- Control joints in the walls or barriers shall match railing joints.
- All openings in railing shall be capped and sealed to prevent water intrusion.
- Reinforcing at post locations is shown for concrete retaining wall only. See sheet S3.3 for condition at culvert extension.

- See Special Provisions Section 507.03 (B) (7) for painting details

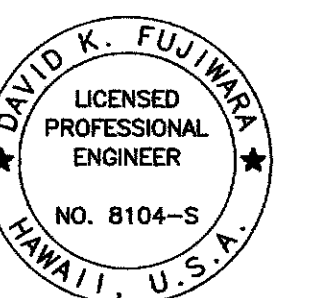

THIS WORK WAS PREPARED BY ME OR UNDER MY SUPERVISION.
David K. Fujiwara
KSF, INC. APRIL 30, 2014
LIC. EXP. DATE


STATE OF HAWAII DEPARTMENT OF TRANSPORTATION HIGHWAYS DIVISION	
FRP PEDESTRIAN RAILING ELEVATIONS AND SECTION	
FARRINGTON HIGHWAY INTERSECTION IMPROVEMENTS AT NAKAKULI AVENUE AND HALEAKALA AVENUE Federal-Aid Project No. STP-093-1(22)	
Scale: As Shown	Date: April 2013
SHEET No. S5.3 OF 3 SHEETS	

ADD. 199


SURVEY PLOTTED BY	DATE
DRAWN BY	
DESIGNED BY	
QUANTITIES BY	
CHECKED BY	
ORIGINAL PLAN	
NOTE BOOK	
No.	

DRAWING NAME: Z:\00 ONGOING\12-026-FARRINGTON HWY NAKAKULI TO HALEAKALA-UEHAWA\CAD\11-08-13 ADD\1\FHJ-SS01 ADD\1.DWG PLOT TIME: 11-04-13 5:01 PM

- Notes:
1. See Civil drawings for additional details.
 2. Traffic Signal Standard manufacturer's recommendations shall be followed.

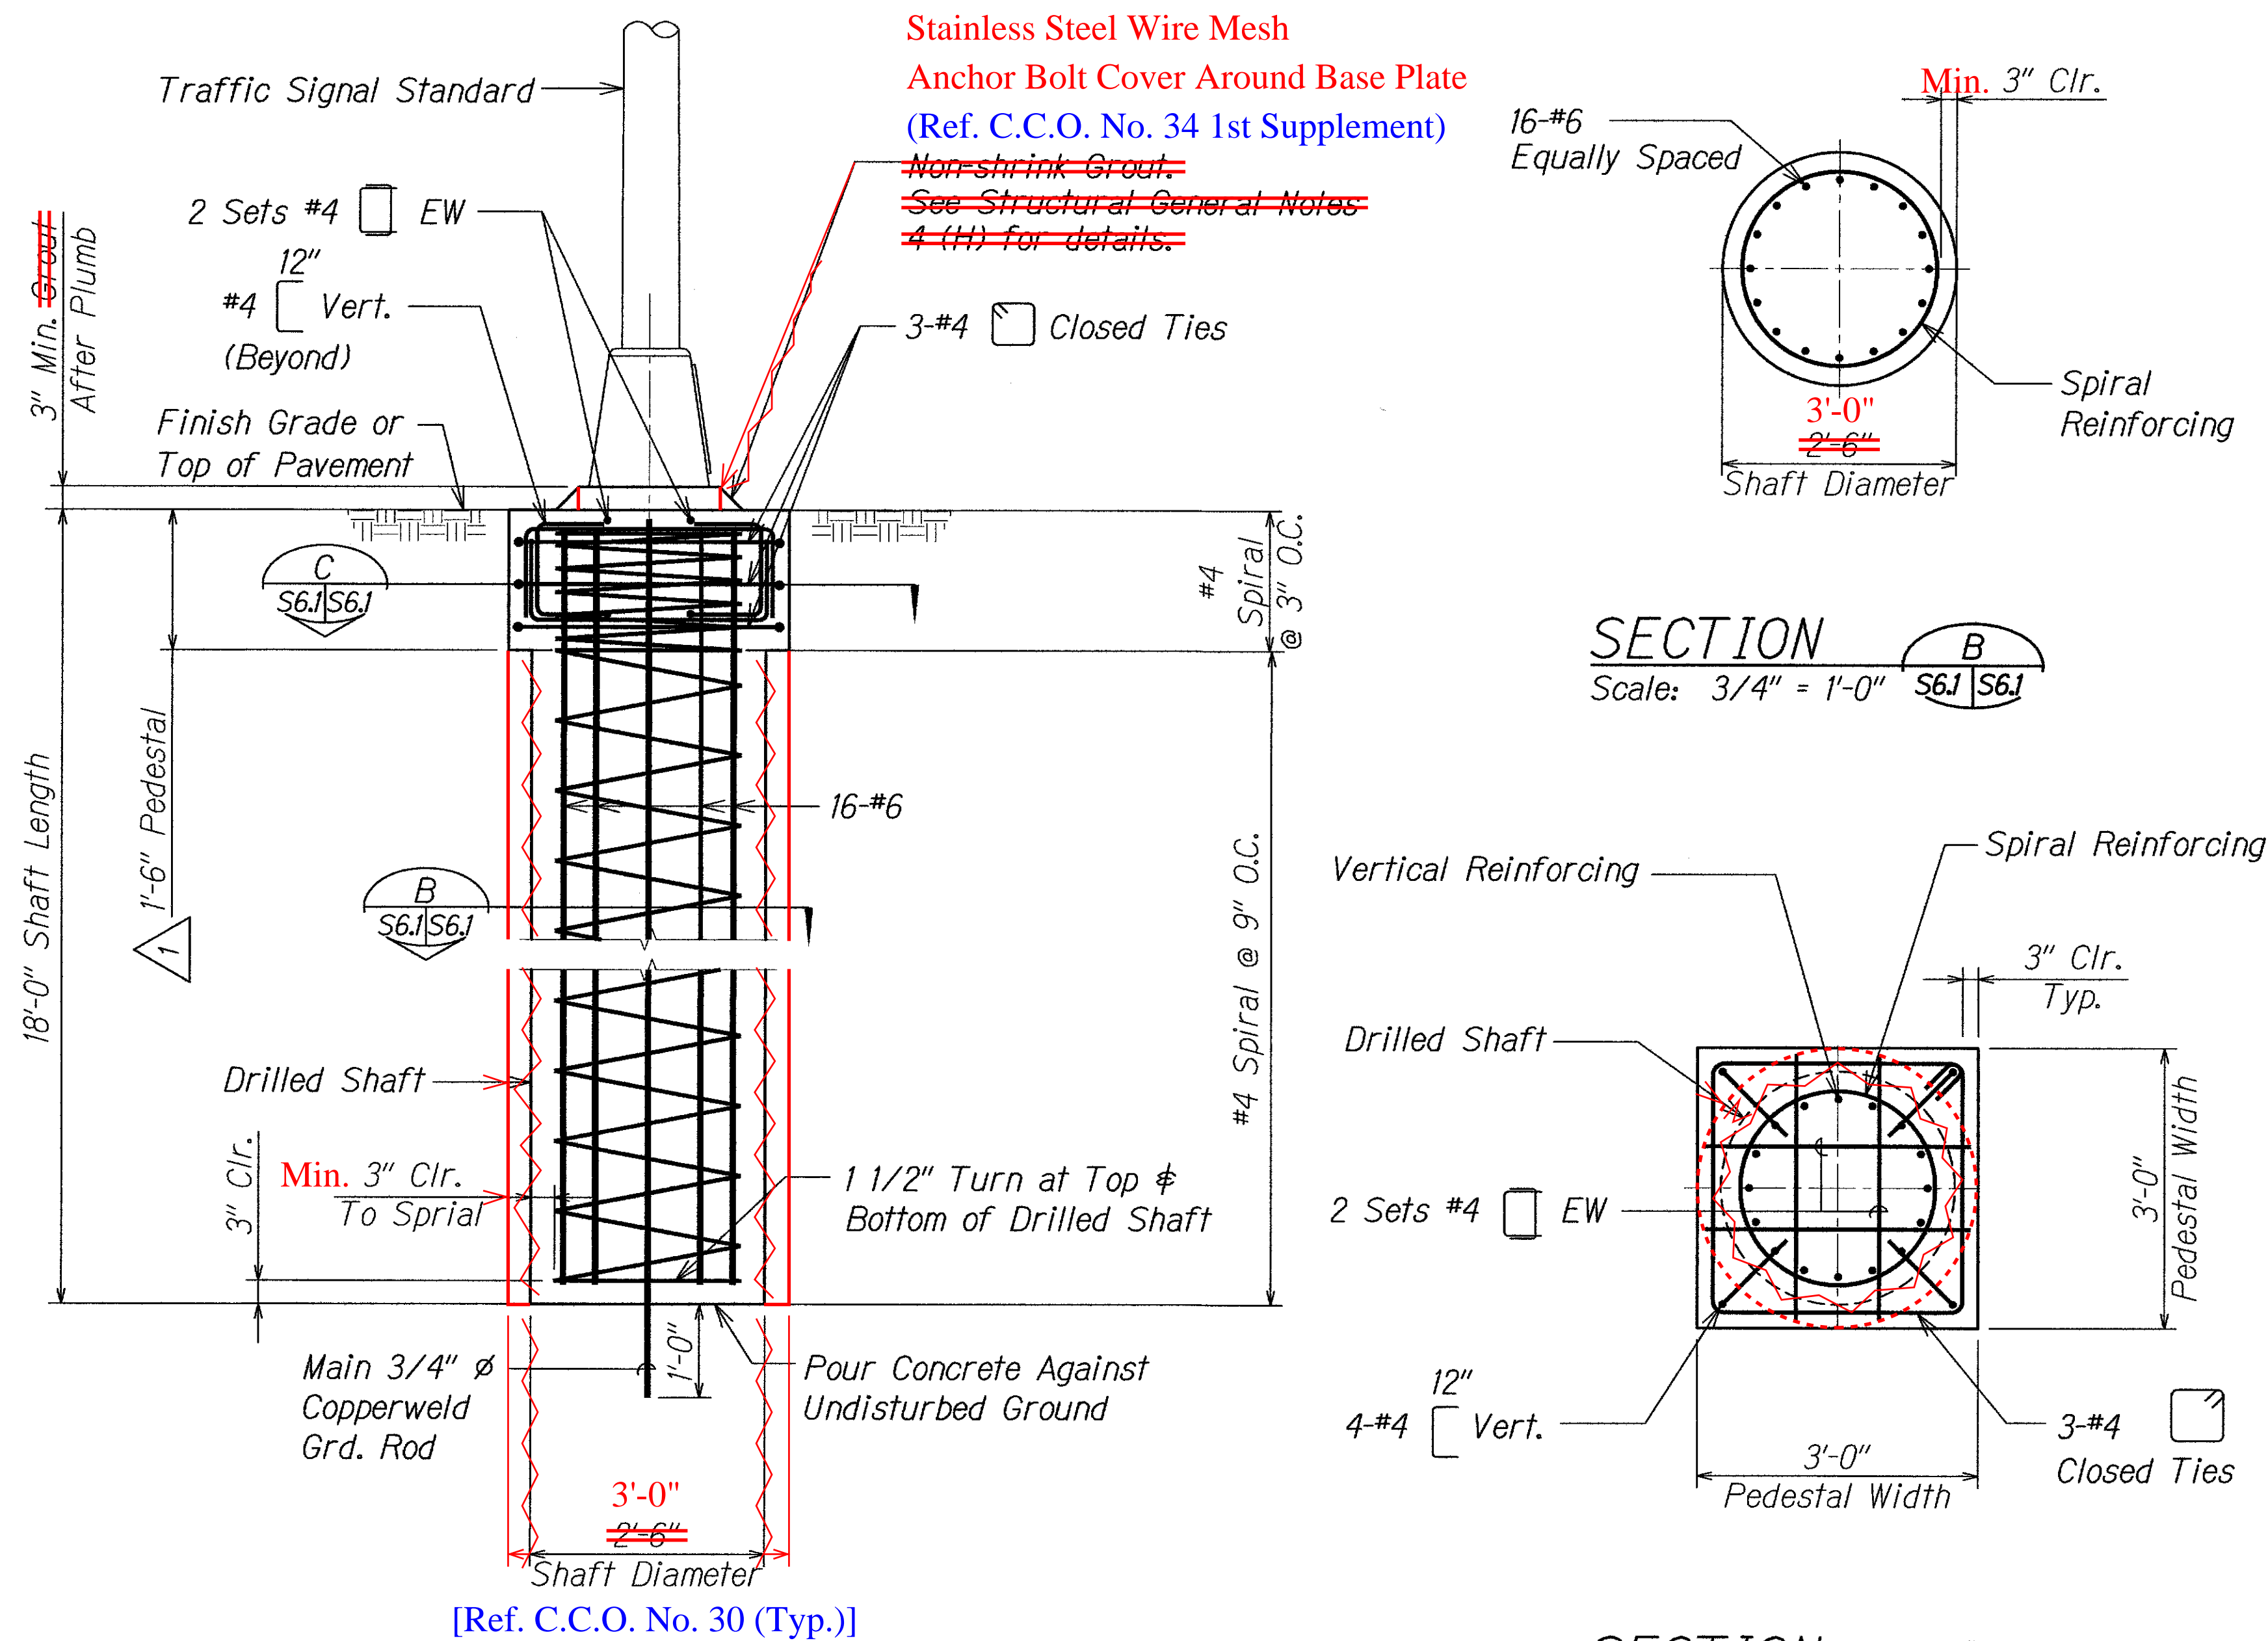


SECTION B
Scale: 3/4" = 1'-0"

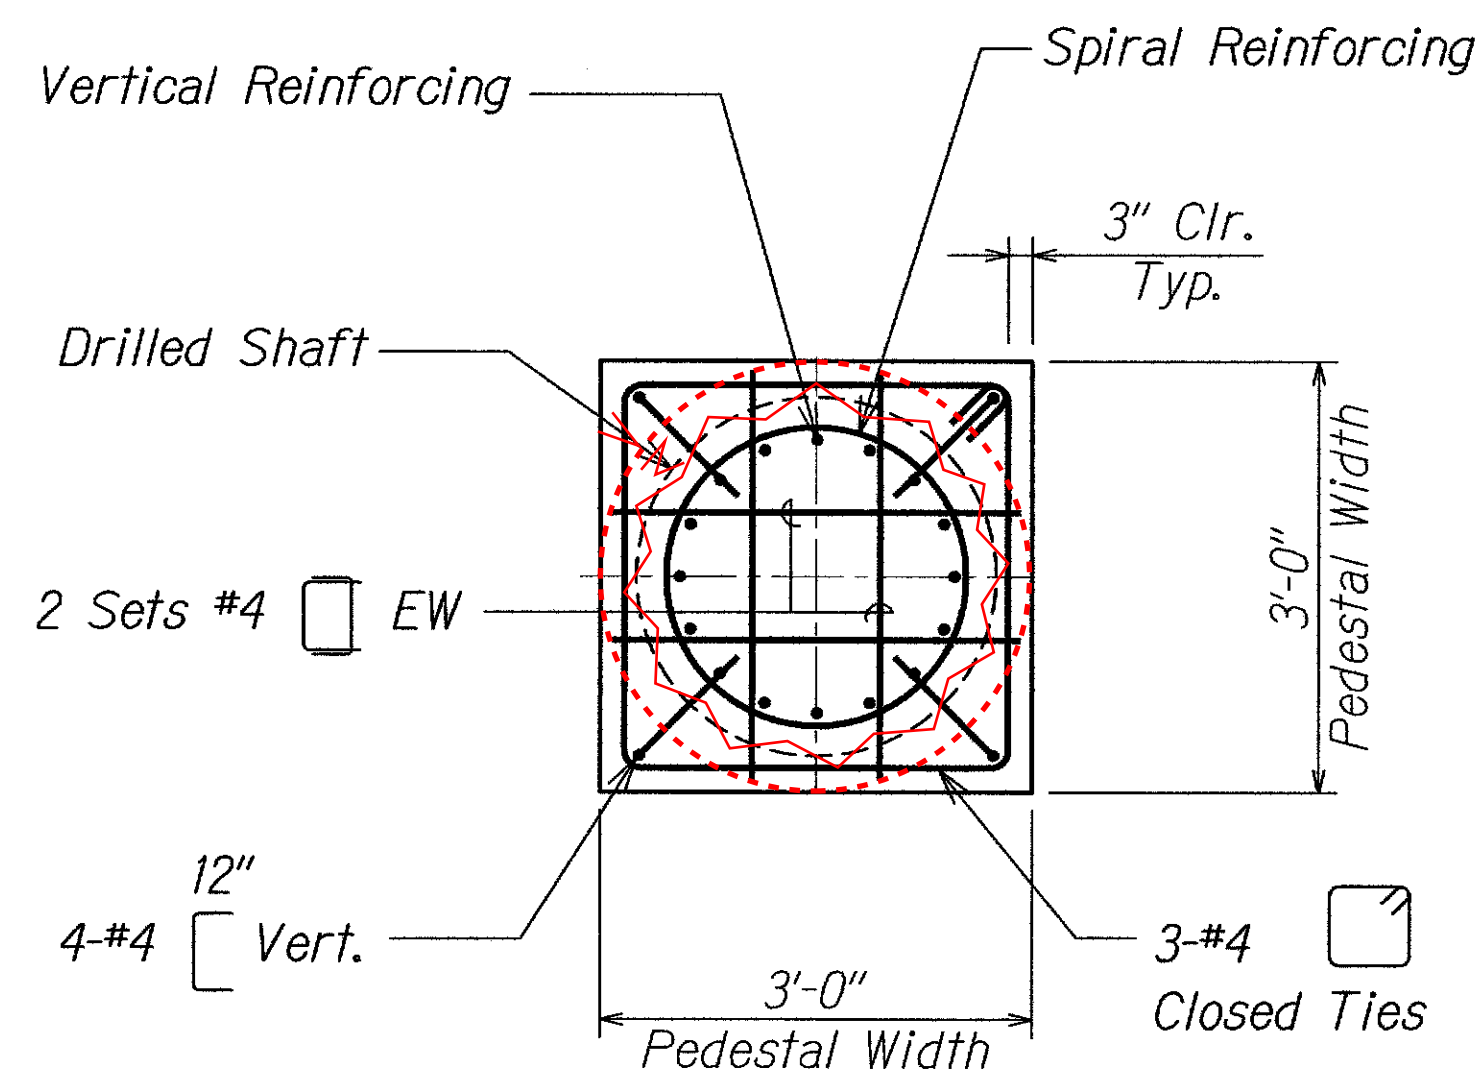

SECTION C
Scale: 3/4" = 1'-0"

TYPICAL POLE FOUNDATION A
Scale: 3/4" = 1'-0"

Drilled Shaft Schedule					
	Shaft Diameter Inch	Shaft Length Feet	Pedestal Width Inch	Vertical Reinforcing	Spiral Reinforcing
Type II - Traffic Signal Standard	36 30	18	36	16-#6	#4 @ 9"

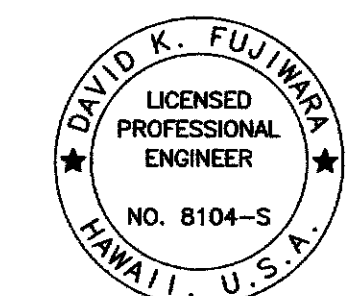

THIS WORK WAS PREPARED BY ME
OR UNDER MY SUPERVISION.
David K. Fujimura
KSF, INC. APRIL 30, 2014
LIC. EXP. DATE

STATE OF HAWAII
DEPARTMENT OF TRANSPORTATION
HIGHWAYS DIVISION
**TYPICAL TRAFFIC SIGNAL
POLE FOUNDATION**
FARRINGTON HIGHWAY INTERSECTION IMPROVEMENTS
AT NANAKULI AVENUE AND HALEAKALA AVENUE
Federal-Aid Project No. STP-093-1(22)
Scale: As Shown Date: April 2013
SHEET No. S6J OF 1 SHEETS

11/08/13
DATE

1
REVISION

Add. 1 - Modified Callout

"AS-BUILT"

ADD. 200