


FED. ROAD DIST. NO.	STATE	FEDERAL AID PROJ. NO.	FISCAL YEAR	SHEET NO.	TOTAL SHEETS
HAWAII	HAW.	STP-093-1(22)	2013	87	230

GENERAL TRAFFIC SIGNAL NOTES:


- All Traffic Signal work shall conform to the requirements of the Manual on Uniform Traffic Control Devices for Streets and Highways, U.S. Department of Transportation, Federal Highways Administration, 2009 Edition, and Amendments.
- The locations of the traffic signal standards, traffic signal standards with mast arm, traffic controller, transformer, pullboxes, conduits, & loop detectors shall be staked out in the field by the Contractor and locations accepted by the Engineer prior to construction and installation. Locations shown on plans shall be adjusted as necessary to prevent conflict with existing or new facilities.
- All direct-buried conduits shall be PVC Schedule 80.
- Loop detectors shall be installed according to Loop Detector Details shown on the Plans.
- Lead-in wires in pullbox near loops shall be tagged with Loop Number(s).
- See sheet TS-9 for Restoration of Non-Roadway Areas and Restoration of Existing Pavement Details due to Trench Excavation.
- Steel plates for covering trenches shall have skid resistant surface.
- All structures, pavements, utilities, landscaping, and other topographical features shown on the Plans are existing and shall remain unless noted or indicated otherwise. All grassed areas damaged by construction activities shall be top soiled and grassed.
- A solid #8 bare copper wire shall be pulled in all conduits with the traffic control cable for equipment ground.
- All splicing shall be done in the pullboxes.
- All traffic signal controller equipment shall be completely wired in the cabinet and shall control the traffic signal as called for in the Plans.
- The loop amplifier units furnished for this project shall be capable of operating the loop detector configurations shown on the Plans.
- The Contractor shall verify with the respective utility companies and government agencies, the locations of all electric, telephone, traffic signal, street light, cable television, fire alarm, gas, water, sewer, drain and other lines crossing the excavation path or in excavation areas.
- All work and materials for the traffic signal system shall conform to Special Provisions Section 623 - Traffic Signal System, except as otherwise provided on the Plans.
- Provide ground rod in all pullboxes, pullboxes adjacent to signal standards, pedestals, controller cabinets, and other locations ordered by the Engineer. Ground rod connectors shall be copper welded and shall meet ground to earth resistance as specified by the National Electric Code or local inspecting agency.

- Underground pipes, cables, or ductlines known to exist are indicated on the Plans. The Contractor shall verify the locations and depths of the facilities and exercise proper care in excavating in the area. Wherever connections of new utilities to existing utilities are shown on the Plans, the Contractor shall expose the existing lines at the proposed connections to verify their locations and depths prior to excavation for the new lines.
- During non-working hours, the Contractor shall provide two lanes for through traffic. On streets too narrow to make this practicable, the Contractor may work in one half of the roadway keeping one lane open to traffic and alternating the flow of traffic. During non-working hours, all trenches shall be covered with a safe, non-skid, traffic-bearing bridging material and all lanes shall be open to traffic.
- Where pedestrian walkways exist, they shall be maintained in passable condition or other facilities for pedestrians shall be provided. Passage between walkways at intersections shall likewise be provided.
- Driveways shall be kept open unless the owners of the property using these rights-of-way are otherwise provided for satisfactorily.
- No material and/or equipment shall be stockpiled or otherwise stored within street rights-of-way except at locations designated in writing and accepted by the Engineer.
- Traffic Signal Supports and Foundations shall meet the requirements of "AASHTO Standard Specifications for Structural Supports for Highway Signs, Luminaires, and Traffic Signals, 5th Edition 2009."
- Existing traffic signal standards to be replaced shall be removed together with its respective footing. The Contractor may elect to remove only the top portion of the footing. In such cases, the Contractor shall ensure that the remaining footing shall be 12 inches below the existing or finished grade.
- The existing traffic signal system, including interconnect, shall remain in operation until the new traffic signal system is put into service. The Contractor shall arrange his work accordingly to provide temporary relocations and wirings, as necessary.


TRAFFIC SIGNAL LEGEND AND ABBREVIATIONS:

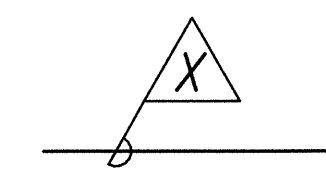


Conduits and Cables, Conduit Run X

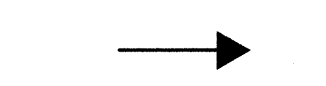


12" R-Y-↑ Traffic Signal Head




12" R-Y-G Traffic Signal Head

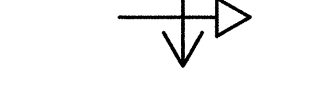


12" R-Y-← Traffic Signal Head




Pedestrian Signal Head




12" R-Y-↑ Traffic Signal Head with Back Plate

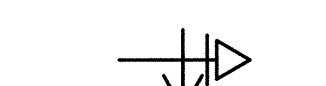


12" R-Y-G Traffic Signal Head with Back Plate

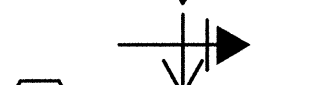


12" R-Y-← Traffic Signal Head with Back Plate

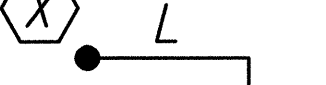


12" R-Y-G-← Traffic Signal Head with Back Plate




Signal Standard with Mast Arm Type II, or Type III

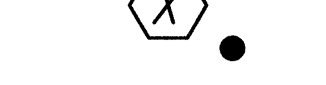


L=Length of Mast arm, Pole X, Footing Type C




Signal Standard Type I, Pole X, H=3', 7' or 10', Footing Type A




Loop Detectors




Pullbox Type A (Old Type "B")




Pullbox Type B (Old Type "C")




Pullbox Type C (Old Type "D")




Pedestrian Push Button Assembly (Arrow denotes direction on Push Button Sign)




Traffic Controller Model 170E and 332A Cabinet with Type D Concrete Base for Controller Cabinet

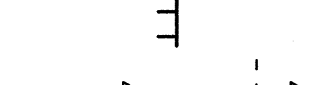


Street Sign Mounted to Mast Arm

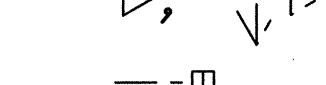


Existing Traffic Signal Head

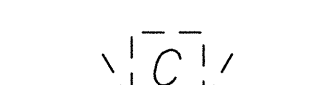


Existing Pedestrian Signal Head

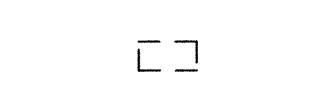


Existing Controller Cabinet

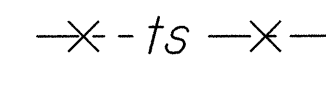


Existing Pullbox



Existing Traffic Signal Items to be removed




Existing Signal Standard with Mast Arm Type II, or Type III



Existing Signal Standard Type I, H=3', 7' or 10'

ORIGINAL PLAN	SURVEY PLOTTED BY	DATE
NOTE BOOK	DRAWN BY	
	DESIGNED BY	
	CHECKED BY	

T-1/DOT-FARRINGTON HWY INTERSECTIONS NANAKULI HALEAKALA/CADD/SHEETS/STP/TS-NOTES.DGN

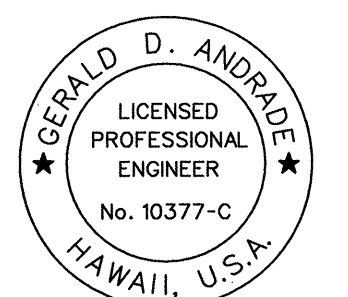

THIS WORK WAS PREPARED BY ME OR UNDER MY SUPERVISION.

Signature: *Gerald D. Andrade* Date: 04/30/14


EXPIRATION DATE OF THE LICENSE

STATE OF HAWAII
DEPARTMENT OF TRANSPORTATION
HIGHWAYS DIVISION

**TRAFFIC SIGNAL
NOTES AND LEGEND**

FARRINGTON HIGHWAY INTERSECTION IMPROVEMENTS
AT NANAKULI AVENUE AND HALEAKALA AVENUE
Federal-Aid Project No. STP-093-1(22)



Scale: None Date: April 2013

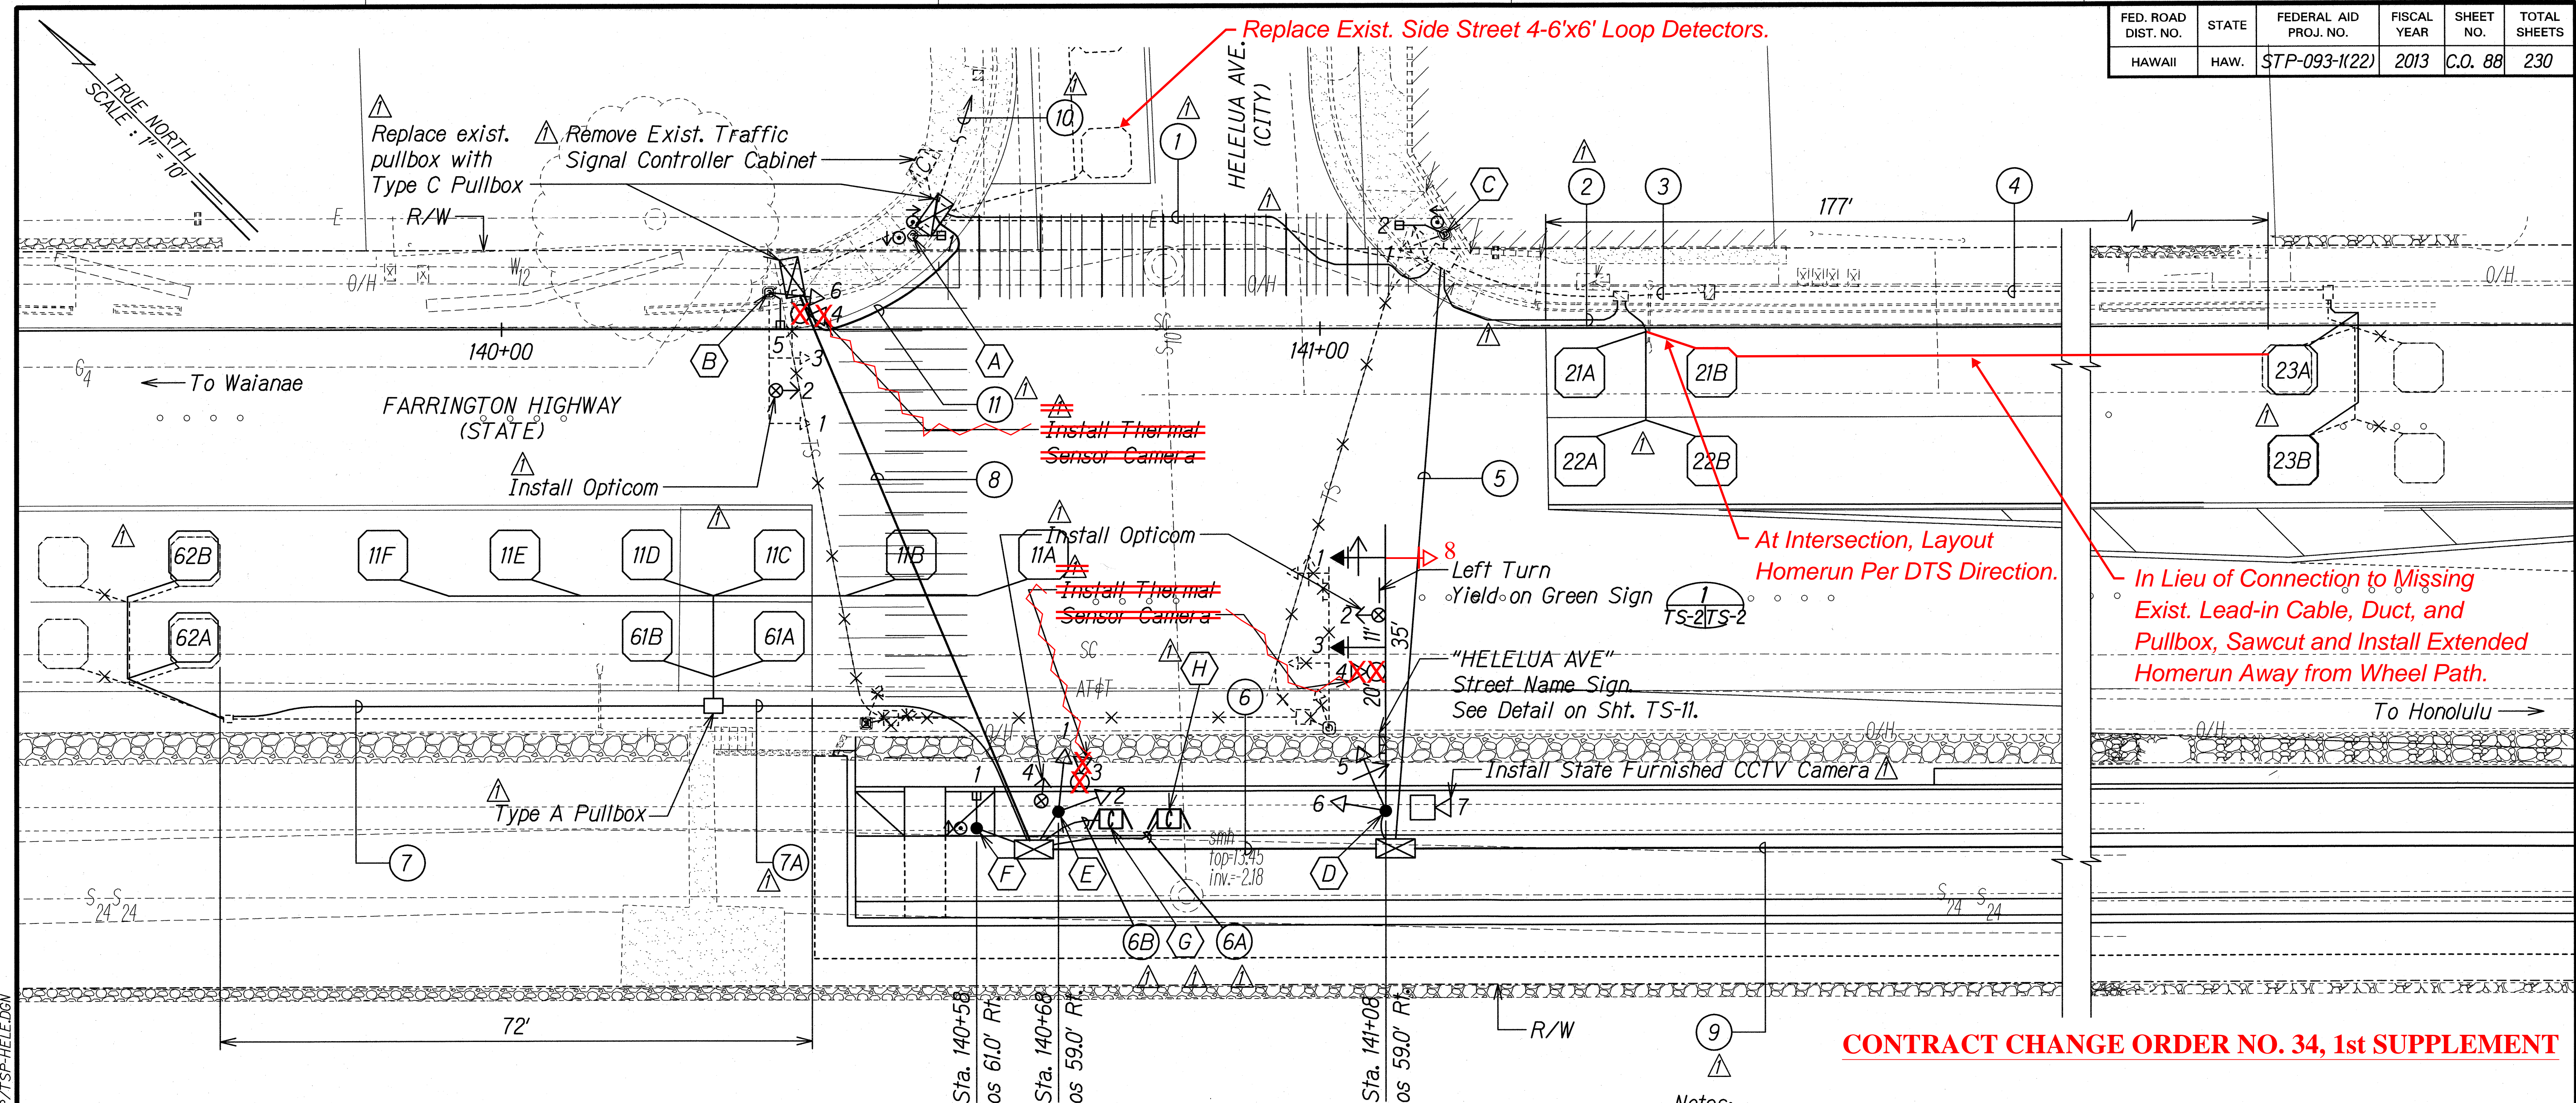

CONTRACT CHANGE ORDER NO. 34, 1st SUPPLEMENT

- Notes:
- For foundation details see Sheet S6.1.
 - For Interconnect Plan, See Sheet C.O.94S-1.
 - Contractor to terminate all fiber optic cable in cabinet patch panel.
 - Contractor to terminate power in CCTV cabinet to terminal block and surge suppressor.
 - Contractor to pull coax, camera control, and 3C#12 into CCTV cabinet.
 - CCTV integration by others.

6/21/17	△ Add Thermal Cameras, Opticom
	CCTV Camera and Interconnect
	Conduit & Cable
DATE	REVISION

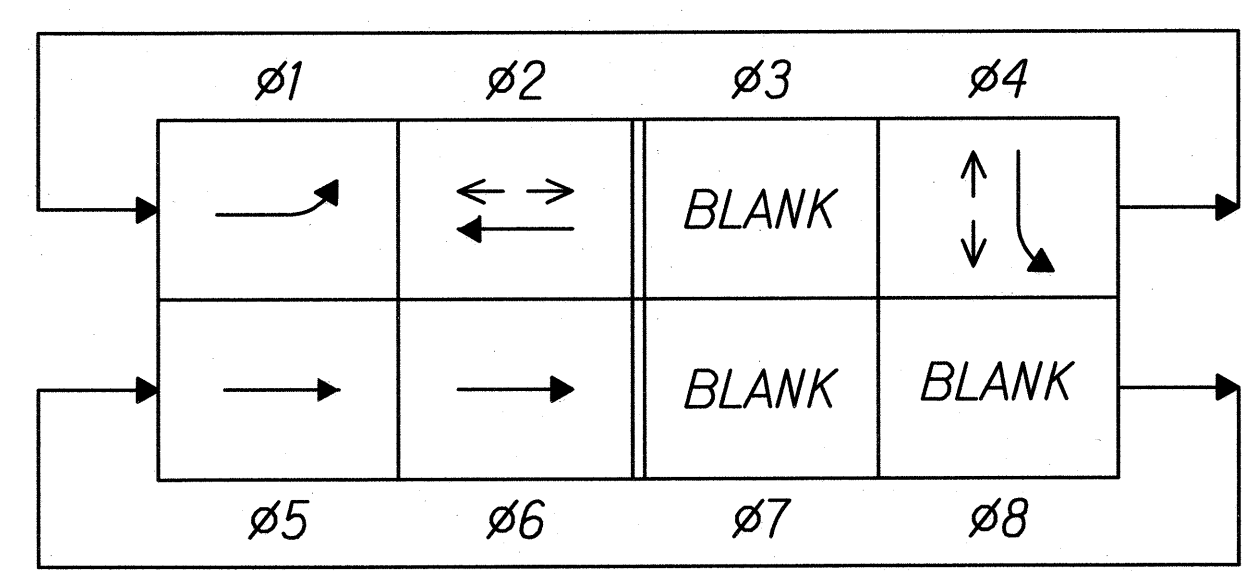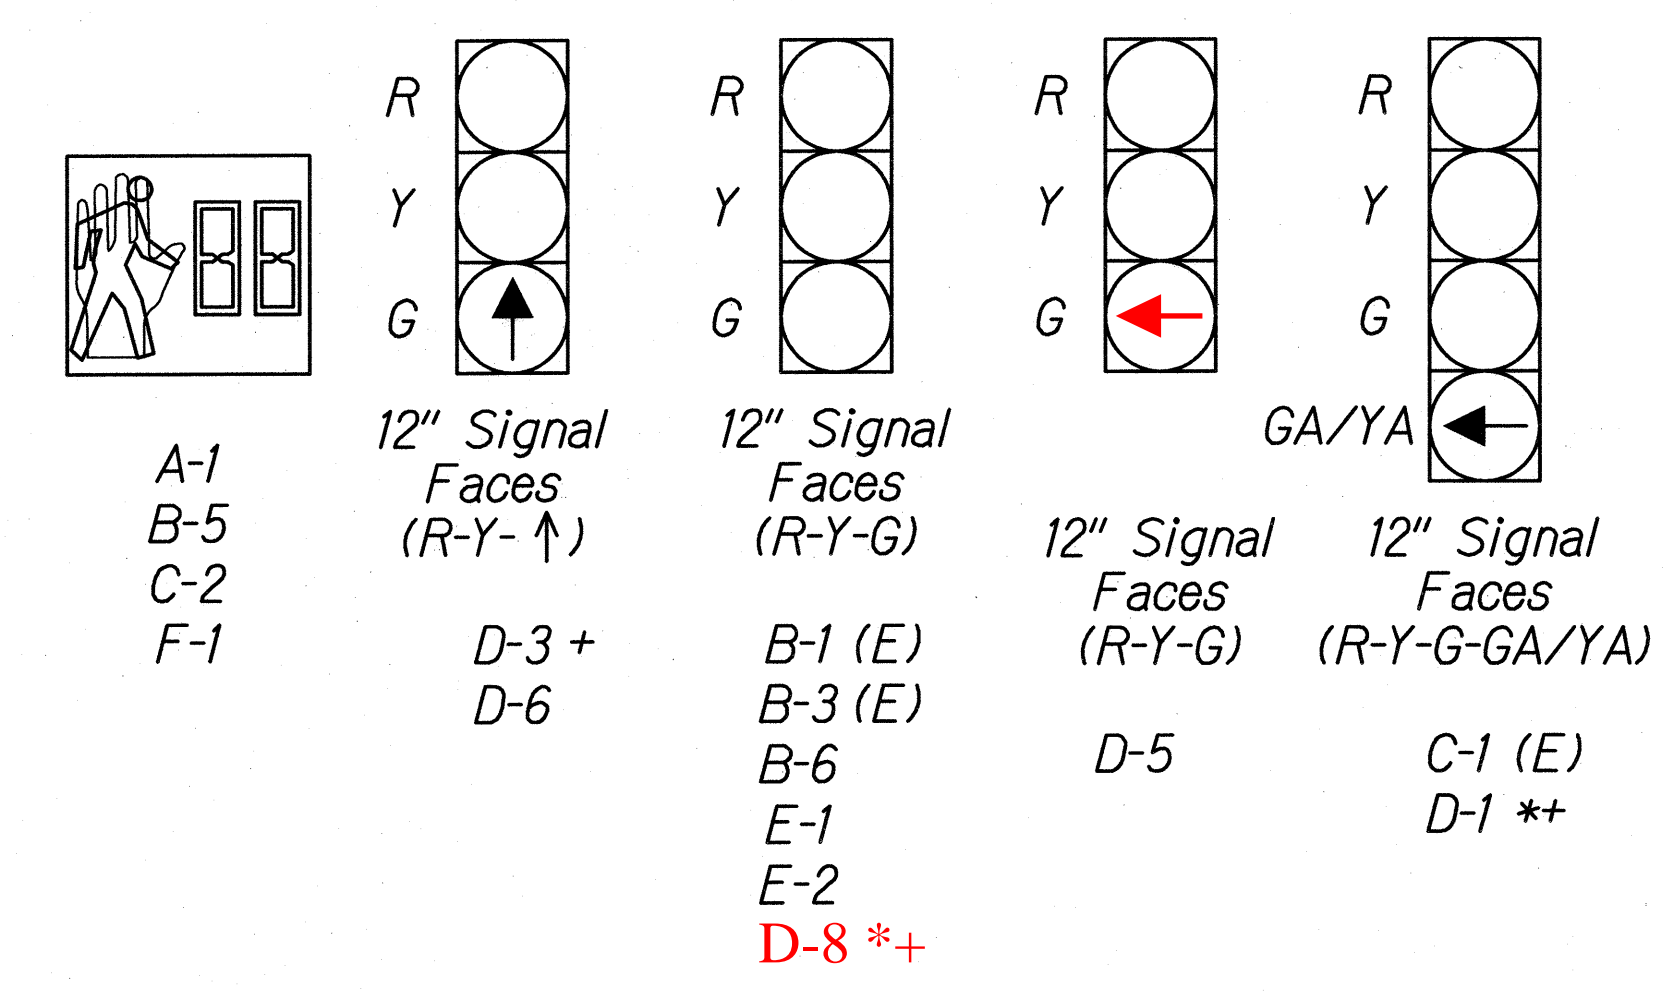

PHASE DIAGRAM
 Model 170E Controller
 Model 332A Cabinet
 → Vehicle Movement
 ↔ Pedestrian Movement

LEFT TURN YIELD ON GREEN
 Not to Scale
 R10-12 24"X30"

GERALD D. ANDRADE
 LICENSED PROFESSIONAL ENGINEER
 No. 10377-C
 HAWAII, U.S.A.

STATE OF HAWAII
 DEPARTMENT OF TRANSPORTATION
 HIGHWAYS DIVISION

TRAFFIC SIGNAL PLAN
FARRINGTON AND HELELUA

FARRINGTON HIGHWAY INTERSECTION IMPROVEMENTS
 AT NAKAKULI AVENUE AND HALEAKALA AVENUE
 Federal-Aid Project No. STP-093-1(22)

Scale: 1"=10' Date: April 2013

FARRINGTON AND HELELUA

Material List				
Pole	Base Type	Standard Type	Mounting Type	PPB Assembly
A(E)	exist	I-exist	(1) Type I (ped head)	
B(E)	exist	II-exist	(1) Type VI (exist)	
			(2) Opticom (Horiz.)	
			(3) Type VI (exist)	
			(4) Thermal Camera (Horiz.)	
			(5) Type VI (ped head)	
			(6) Type IV	
C(E)	exist	I-exist	(1) Type I (exist)	
			(2) Type III (ped head)	
D	*	II-35	(1) Type VI	
			(2) Opticom (Horiz.)	
			(3) Type VI	
			(4) Thermal Camera (Horiz.)	
			(5)(6) Type V	
			(7) CCTV Camera (Horiz.) **	
E	*	I-10	(1)(2) Type II	
			(3) Thermal Camera (Vert.)	
			(4) Opticom (Vert.)	
F	*	I-8	(1) Type I (ped head)	1
G	D		170E Controller	
			332A Cabinet and Base	
H	D		332A Cabinet and Base **	

- * For Traffic Signal Pole Base, See Std. Plan TE-32, TE-33, TE-33A.1 and TE-33A.2.
- ** CCTV Camera and 332A Cabinet Base for CCTV System
Furnished by the State

Cable and Conduit Schedule											
Run	Conduit Size	Type 1 Signal Control 26C#14	Type 2 PPB/Loops 2C#14	Type 5 Signal Control 4C#14	Type 6 Power 3C#6	Type 7 Opticom 3C#20	12PR#19 Inter-connect	72F Single Mode FOC	Coax	Camera Control	3C#12
1	2"	1									
	2"		3								
	2-2"	Spare									
2	2"		2								
3	2"(E)		1(E)								
4	2"(E)		1(E)								
5	2"	1									
	3-2"	Spare									
6	2"	1					1				
	2"							1			
	2"								1	1	1
	2"			1							
	2"					1					
6A	2"				1						
	2"							1			
	2"								1	1	1
	2"	Spare									
6B	2-2"	2									
	2"		5								
	2"		5								
	2"				1						
	2"					3					
	2"						1				
	2"			3							
7	2"		1								
7A	2"		4								
8	2"	1									
	2"		5								
	2"				2						
	2"			1							
	2"					1					
	2"	Spare									
9	2"						1				
	2"							1			
	2-2"	Spare									
10	2"(E)				1(E) 1						
11	2"	1									
	2"		5								
	2"				2						
	2"	Spare									

CONTRACT CHANGE ORDER NO. 30

6/21/17	△ Add Thermal Cameras, Opticoms, CCTV Camera and Interconnect Conduit & Cable
DATE	REVISION

GERALD D. ANDRADE

LICENSED PROFESSIONAL ENGINEER

No. 10377-C

HAWAII, U.S.A.

THIS WORK WAS PREPARED BY ME OR UNDER MY SUPERVISION.

SIGNATURE

04/30/18

EXPIRATION DATE OF THE LICENSE

STATE OF HAWAII

DEPARTMENT OF TRANSPORTATION

HIGHWAYS DIVISION

MATERIAL LIST AND CABLE AND CONDUIT SCHEDULE

FARRINGTON HIGHWAY INTERSECTION IMPROVEMENTS AT NAKAKULI AVENUE AND HALEAKALA AVENUE

Federal-Aid Project No. STP-093-1(22)

Scale: None


Date: April 2013

SHEET No. TS-3 OF 13 SHEETS


"AS-BUILT"

C.O. 89

FED. ROAD DIST. NO.	STATE	FEDERAL AID PROJ. NO.	FISCAL YEAR	SHEET NO.	TOTAL SHEETS
HAWAII	HAW.	STP-093-1(22)	2013	C.O. 90	230

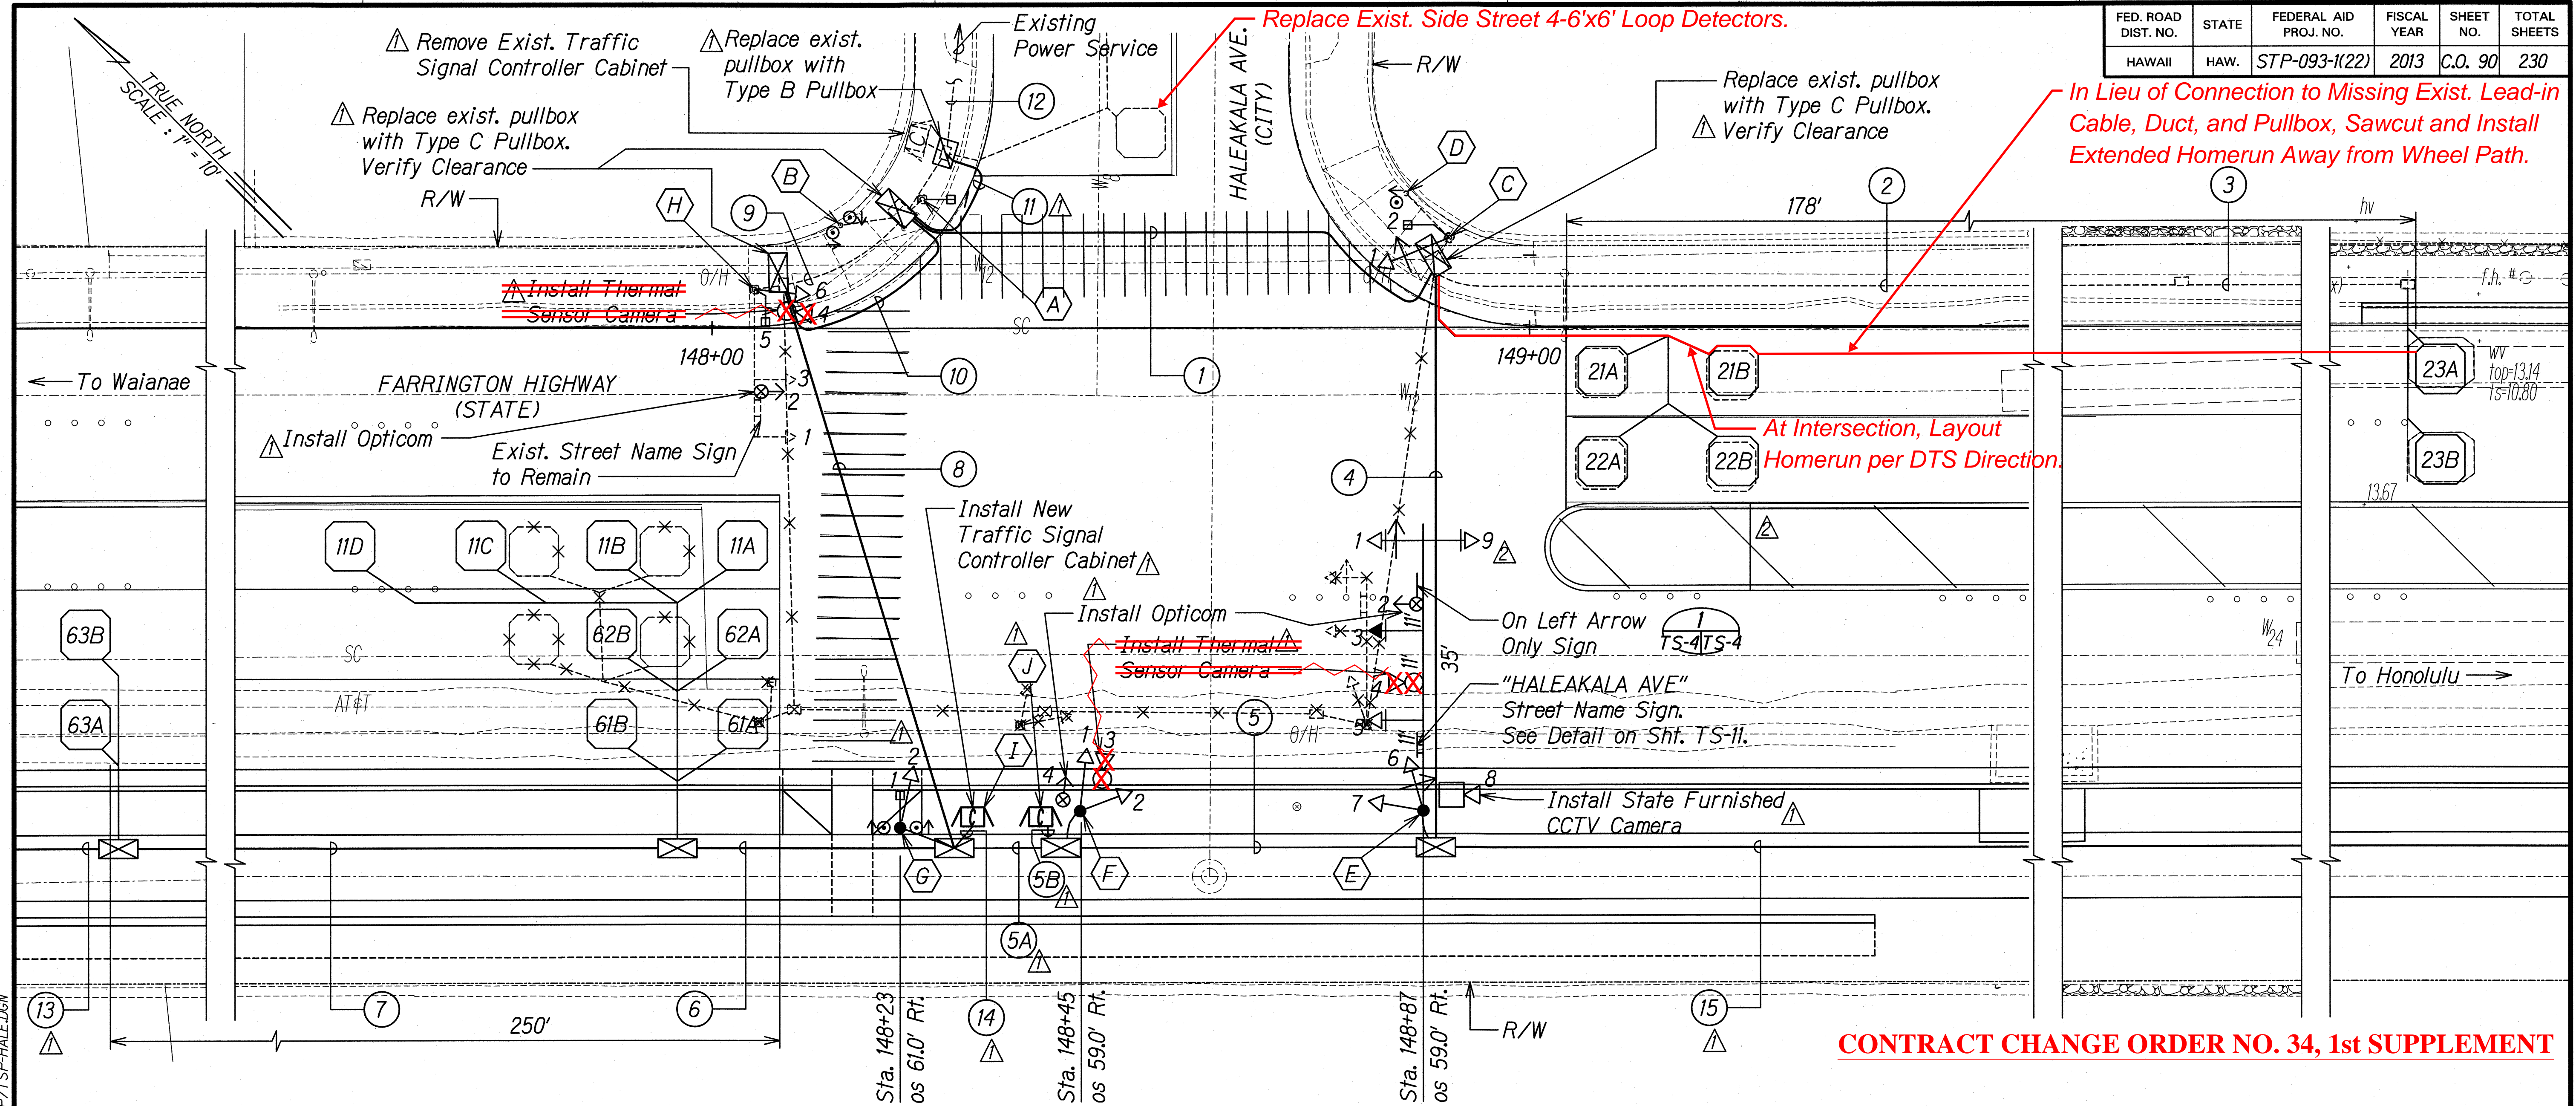

CONTRACT CHANGE ORDER NO. 34, 1st SUPPLEMENT

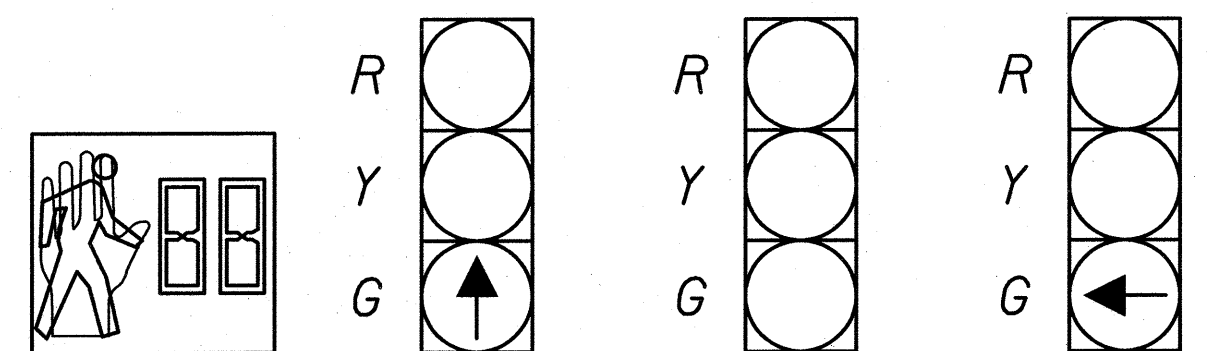


A-1
C-2
G-1
H-5

12" Signal Faces (R-Y-↑)
E-3 +
E-5 +

12" Signal Faces (R-Y-G)
E-7
F-1
F-2
G-2
H-1 (E)
H-3 (E)
H-6
E-9 **


12" Signal Faces (R-Y-←)
C-1
E-1 **
E-6

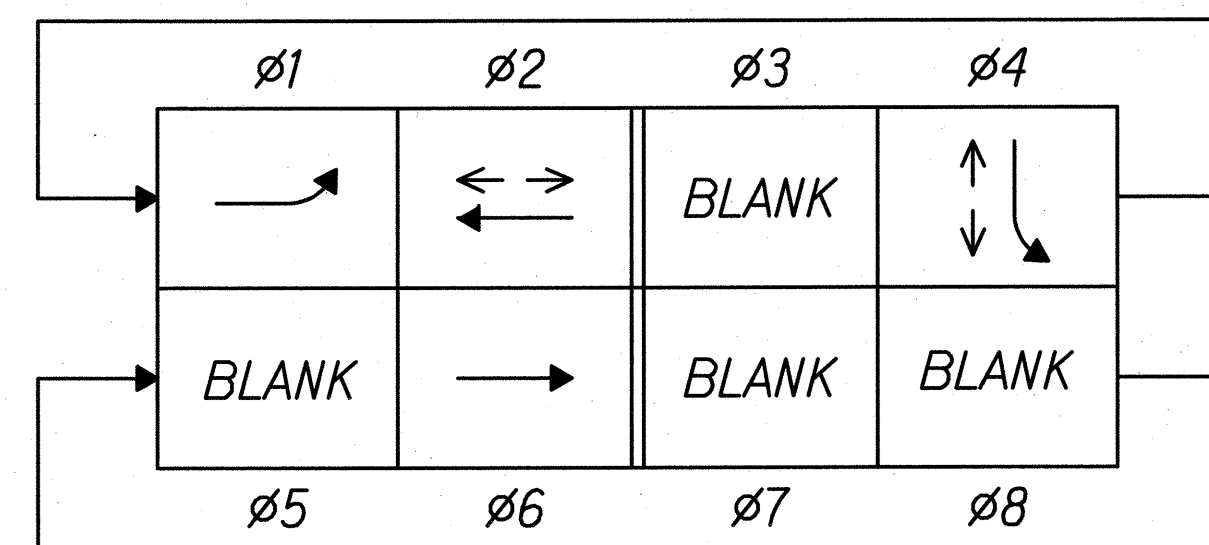

PHASE DIAGRAM
Model 170E Controller
Model 332A Cabinet

→ Vehicle Movement
↔ Pedestrian Movement

- Notes:
1. For foundation details see Sheet S6.1
2. For Interconnect Plan, See Sheet C.O. 94 S-1

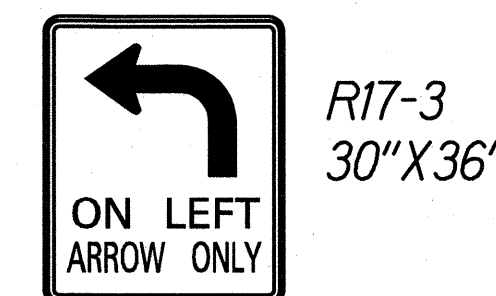

ON LEFT ARROW ONLY SIGN
Not to Scale

DATE	REVISION
2/9/18	△ Add Contra-Flow Signal Head
6/21/17	△ Add Thermal Cameras, Opticom New Controller, CCTV Camera and Interconnect Conduit & Cable

THIS WORK WAS PREPARED BY ME OR UNDER MY SUPERVISION.
SIGNATURE: *Gerald D. Andrade* DATE: 04/30/18
EXPIRATION DATE OF THE LICENSE

STATE OF HAWAII
DEPARTMENT OF TRANSPORTATION
HIGHWAYS DIVISION

TRAFFIC SIGNAL PLAN
FARRINGTON AND HALEAKALA

FARRINGTON HIGHWAY INTERSECTION IMPROVEMENTS
AT NANAKULI AVENUE AND HALEAKALA AVENUE
Federal-Aid Project No. STP-093-1(22)

Scale: 1"=10' Date: April 2013

SHEET No. TS-4 OF 13 SHEETS

"AS-BUILT"

C.O. 90

T:\DOT-FARRINGTON HWY INTERSECTIONS\NANAKULI HALEAKALA\CADD\Sheets\TSP\TSP-HALE.DGN

DESIGNED BY	DATE
DRAWN BY	
CHECKED BY	
NOTED BY	
ORIGINAL PLAN	

FARRINGTON AND HALEAKALA

Material List				
Pole	Base Type	Standard Type	Mounting Type	PPB Assembly
A(E)	exist	I-exist	(1) Type I (ped head)	
B(E)	exist	I-exist		
C(E)	exist	I-exist	(1) Type I (exist)	
			(2) Type III (ped head)	
D(E)	exist	I-exist		1
E	*	II-35	(1) Type VI	
			(2) Opticom (Horiz.)	
			(3) Type VI	
			(4) Thermal Camera (Horiz.)	
			(5) Type VI	
			(6X7) Type V	
			(8) CCTV Camera (Horiz.)**	
			(9) Type VI	
F	*	I-10	(1X2) Type II	
			(3) Thermal Camera (Horiz.)	
			(4) Opticom (Horiz.)	
G	*	I-8	(1) Type I (ped head)	1
			(2) Type II	
H(E)	exist	II-exist	(1) Type VI (exist)	
			(2) Opticom (Horiz.)	
			(3) Type VI (exist)	
			(4) Thermal Camera (Horiz.)	
			(5) Type VI (ped head)	
			(6) Type IV	
I	D		170E Controllor	
			332A Cabinet	
			and Base	
J	D		332A Cabinet and Base**	

- * For Traffic Signal Pole Base, See Std. Plan TE-32, TE-33, TE-33A.1 and TE-33A.2.
- ** CCTV Camera and 332A Cabinet Base for CCTV System Furnished by the State

Cable and Conduit Schedule

Run	Conduit Size	Type 1 Signal Control 26C#14	Type 2 PPB/Loops 2C#14	Type 5 Signal Control 4C#14	Type 6 Power 3C#6	Type 7 Opticom 3C#20	12PR#19 Inter-connect	72F Single Mode FOC	Coax	Camera Control	3C#12
1	2"	1									
	3-2"	Spare									
2	2"(E)		1								
3	2"(E)		1								
4	2"	1									
	2"		3								
	2-2"	Spare									
5	2"	1									
	2"		3								
	2"							1			
	2"								1	1	1
	2"						1				
	2"			1							
	2"					1					
	2"										
	2"	Spare									
5A	2"	1									
	2"		3								
	2"			2							
	2"				1						
	2"					2					
	2"						1				
	2"							1			
	2"								1	1	1
5B	2"				1						
	2"							2			
	2"								1	1	1
	2"	Spare									
6	2"		3								
	2"						1				
	2"							1			
	2"	Spare									
7	2"		1								
	2"						1				
	2"							1			
	2"	Spare									
8	2"	1									
	2"		2								
	2"			1							
	2"				2						
	2"					1					
	2"										
	2"										
	2"	Spare									
9	2"(E)	1(E)									
10	2"		2								
	2"				1						
	2"				1						
	2"	Spare									
11	2"		1								
	2"				1						
	2"				1						
	2"	Spare									
12	2"(E)				1						
					1(E)						

FED. ROAD DIST. NO.	STATE	FEDERAL AID PROJ. NO.	FISCAL YEAR	SHEET NO.	TOTAL SHEETS
HAWAII	HAW.	STP-093-1(22)	2013	C.O. 91	230

CONTRACT CHANGE ORDER NO. 30

2/9/18	△ Add Contra-Flow Signal Head
6/21/17	△ Add Thermal Cameras, Opticom CCTV Camera and Interconnect
	Conduit & Cable
DATE	REVISION

GERALD D. ANDRADE

LICENSED PROFESSIONAL ENGINEER

No. 10377-C

HAWAII, U.S.A.

THIS WORK WAS PREPARED BY ME OR UNDER MY SUPERVISION.

Signature

04/30/18

EXPIRATION DATE OF THE LICENSE

STATE OF HAWAII

DEPARTMENT OF TRANSPORTATION

HIGHWAYS DIVISION

MATERIAL LIST AND

CABLE AND CONDUIT SCHEDULE

FARRINGTON HIGHWAY INTERSECTION IMPROVEMENTS

AT NANAKULI AVENUE AND HALEAKALA AVENUE

Federal-Aid Project No. STP-093-1(22)

Scale: None

Date: April 2013

"AS-BUILT"

C.O. 91

FED. ROAD DIST. NO.	STATE	FEDERAL AID PROJ. NO.	FISCAL YEAR	SHEET NO.	TOTAL SHEETS
HAWAII	HAW.	STP-093-1(22)	2013	C.O. 91S-1	230

FARRINGTON AND HALEAKALA

△ Cable and Conduit Schedule											
Run ○	Conduit Size	Type 1 Signal Control 26C#14	Type 2 PPB/ Loops 2C#14	Type 5 Signal Control 4C#14	Type 6 Power 3C#6	Type 7 Opticom 3C#20	12PR#19 Inter- connect	72F Single Mode FOC	Coax	Camera Control	3C#12
13	2"						1				
	2"							1			
	2-2"	Spare									
14	2-2"	2									
	2"		5								
	2"		4								
	2"			3							
	2"				1						
	2"					3					
	2"						2				
15	2"						1				
	2"							1			
	2-2"	Spare									

CONTRACT CHANGE ORDER NO. 17

6/21/17	△ Add Thermal Cameras, Opticoms
	CCTV Camera and Interconnect
	Conduit & Cable
DATE	REVISION

GERALD D. ANDRADE

LICENSED PROFESSIONAL ENGINEER

No. 10377-C

HAWAII, U.S.A.

THIS WORK WAS PREPARED BY ME OR UNDER MY SUPERVISION.

Signature

04/30/18

EXPIRATION DATE OF THE LICENSE

STATE OF HAWAII

DEPARTMENT OF TRANSPORTATION

HIGHWAYS DIVISION

MATERIAL LIST AND CABLE AND CONDUIT SCHEDULE

FARRINGTON HIGHWAY INTERSECTION IMPROVEMENTS AT NANAKULI AVENUE AND HALEAKALA AVENUE

Federal-Aid Project No. STP-093-1(22)

Scale: None

Date: April 2013

"AS-BUILT"

C.O.91S-1

ORIGINAL PLAN	SURVEY PLOTTED BY	DATE
NOTE BOOK	DRAWN BY	
	TRACED BY	
	DESIGNED BY	
	QUANTITIES BY	
	CHECKED BY	

T-1/20T - FARRINGTON HWY INTERSECTIONS NANAKULI HALEAKALA/CADD/SHEETS/TS-1/TS-02B-HALE.DGN

Material List				
Pole	Base Type	Standard Type	Mounting Type	PPB Assembly
A(E)	exist	II-exist	(1) Type VI (exist)	
			(2)(3) Type IV (exist)	
			(4) Type IV (ped head) (exist)	
B	*	II-25	(1) Type VI	
			(2) Type VI	
			(3)(4) Type IV	
			(5) Type IV (ped head)	1
C	D		332A Cabinet and Base**	

* For Traffic Signal Pole Base, See Std. Plan TE-33, TE-33A.1 and TE-33A.2.
** 332A Cabinet Base for CCTV System Furnished by the State

Cable and Conduit Schedule							
Run	Conduit Size	Type 1 Signal Control 26C#14	Type 2 PPB/ Loops 2C#14	Type 6 Power 3C#6	12PR#19 Inter-connect	Other	72F Single Mode FOC
1	2-2"	1					
	2"		2				
	2"				2		
	2"						2
	2"	Spare					
2	2-2"(E)	2					
	2"(E)		1				
	2"(E)				2		
3	2"				1		
	2"						1
	2-2"	Spare					
4	2"				1		
	2"						1
	2-2"	Spare					
5	2"			1		1-12 Strand Fiber Optic Cable	
6	2"						2
	2"	Spare					
7	2"			1			
	2"					1-12 Strand Fiber Optic Cable	
	2"						2
	2"	Spare					

CONTRACT CHANGE ORDER NO. 17

6/21/17	△ Add Interconnect Conduit & Cable
DATE	REVISION

GERALD D. ANDRADE
LICENSED PROFESSIONAL ENGINEER
No. 10377-C
HAWAII, U.S.A.




THIS WORK WAS PREPARED BY ME OR UNDER MY SUPERVISION.
SIGNATURE: *G. Andrade* EXPIRATION DATE OF LICENSE: 04/30/18

STATE OF HAWAII
DEPARTMENT OF TRANSPORTATION
HIGHWAYS DIVISION

TRAFFIC SIGNAL PLAN
AT STA. 164+00

FARRINGTON HIGHWAY INTERSECTION IMPROVEMENTS
AT NANAKULI AVENUE AND HALEAKALA AVENUE
Federal-Aid Project No. STP-093-1(22)

Scale: 1"=10' Date: April 2013

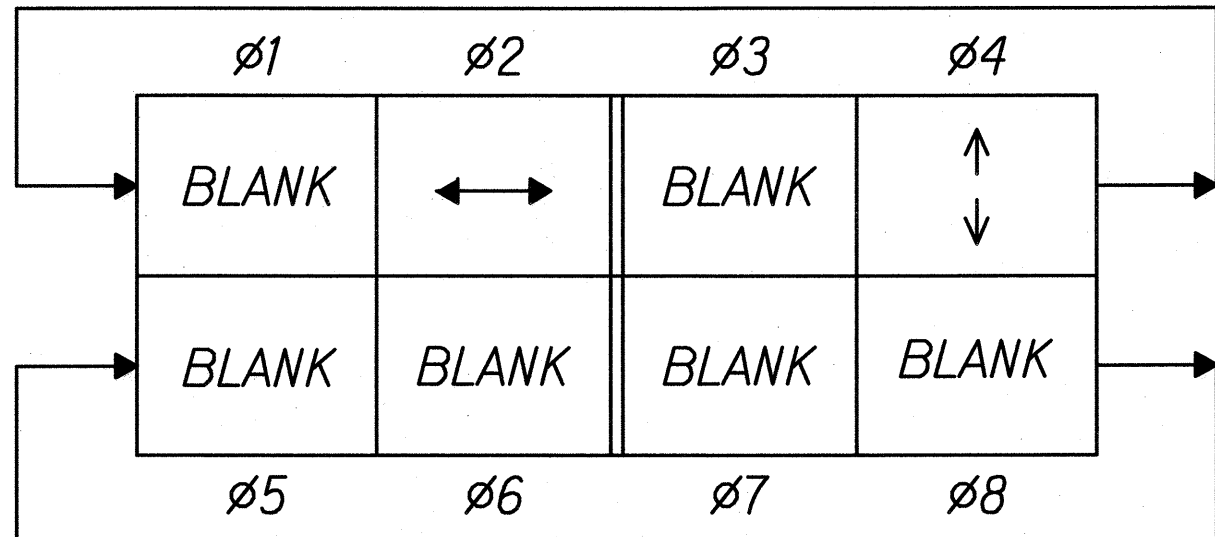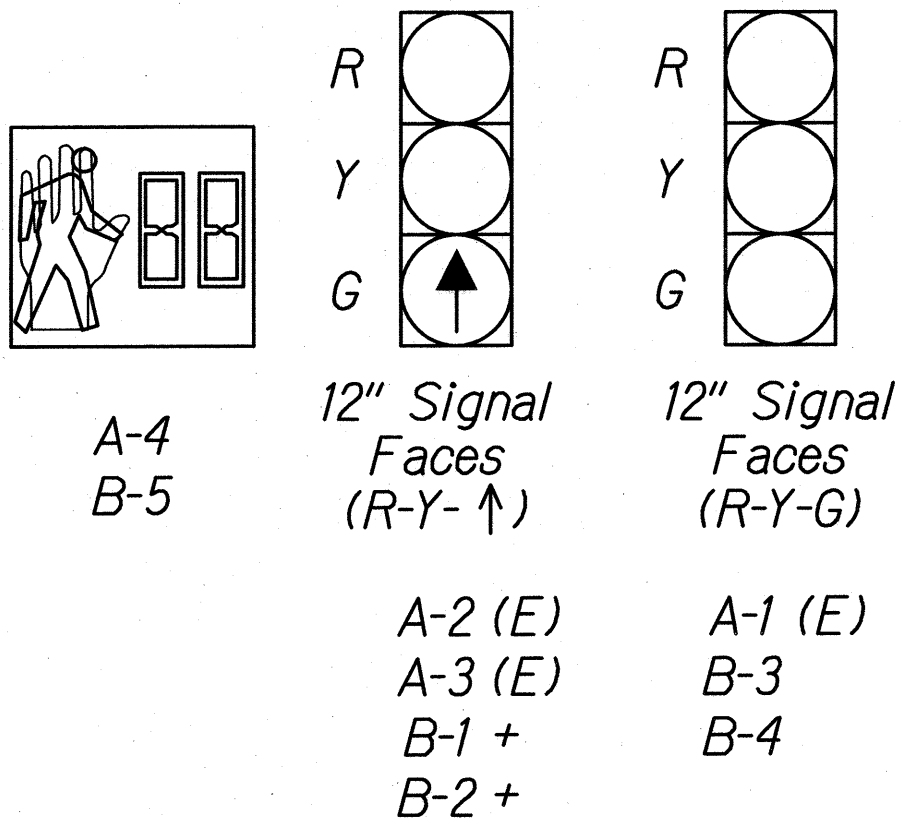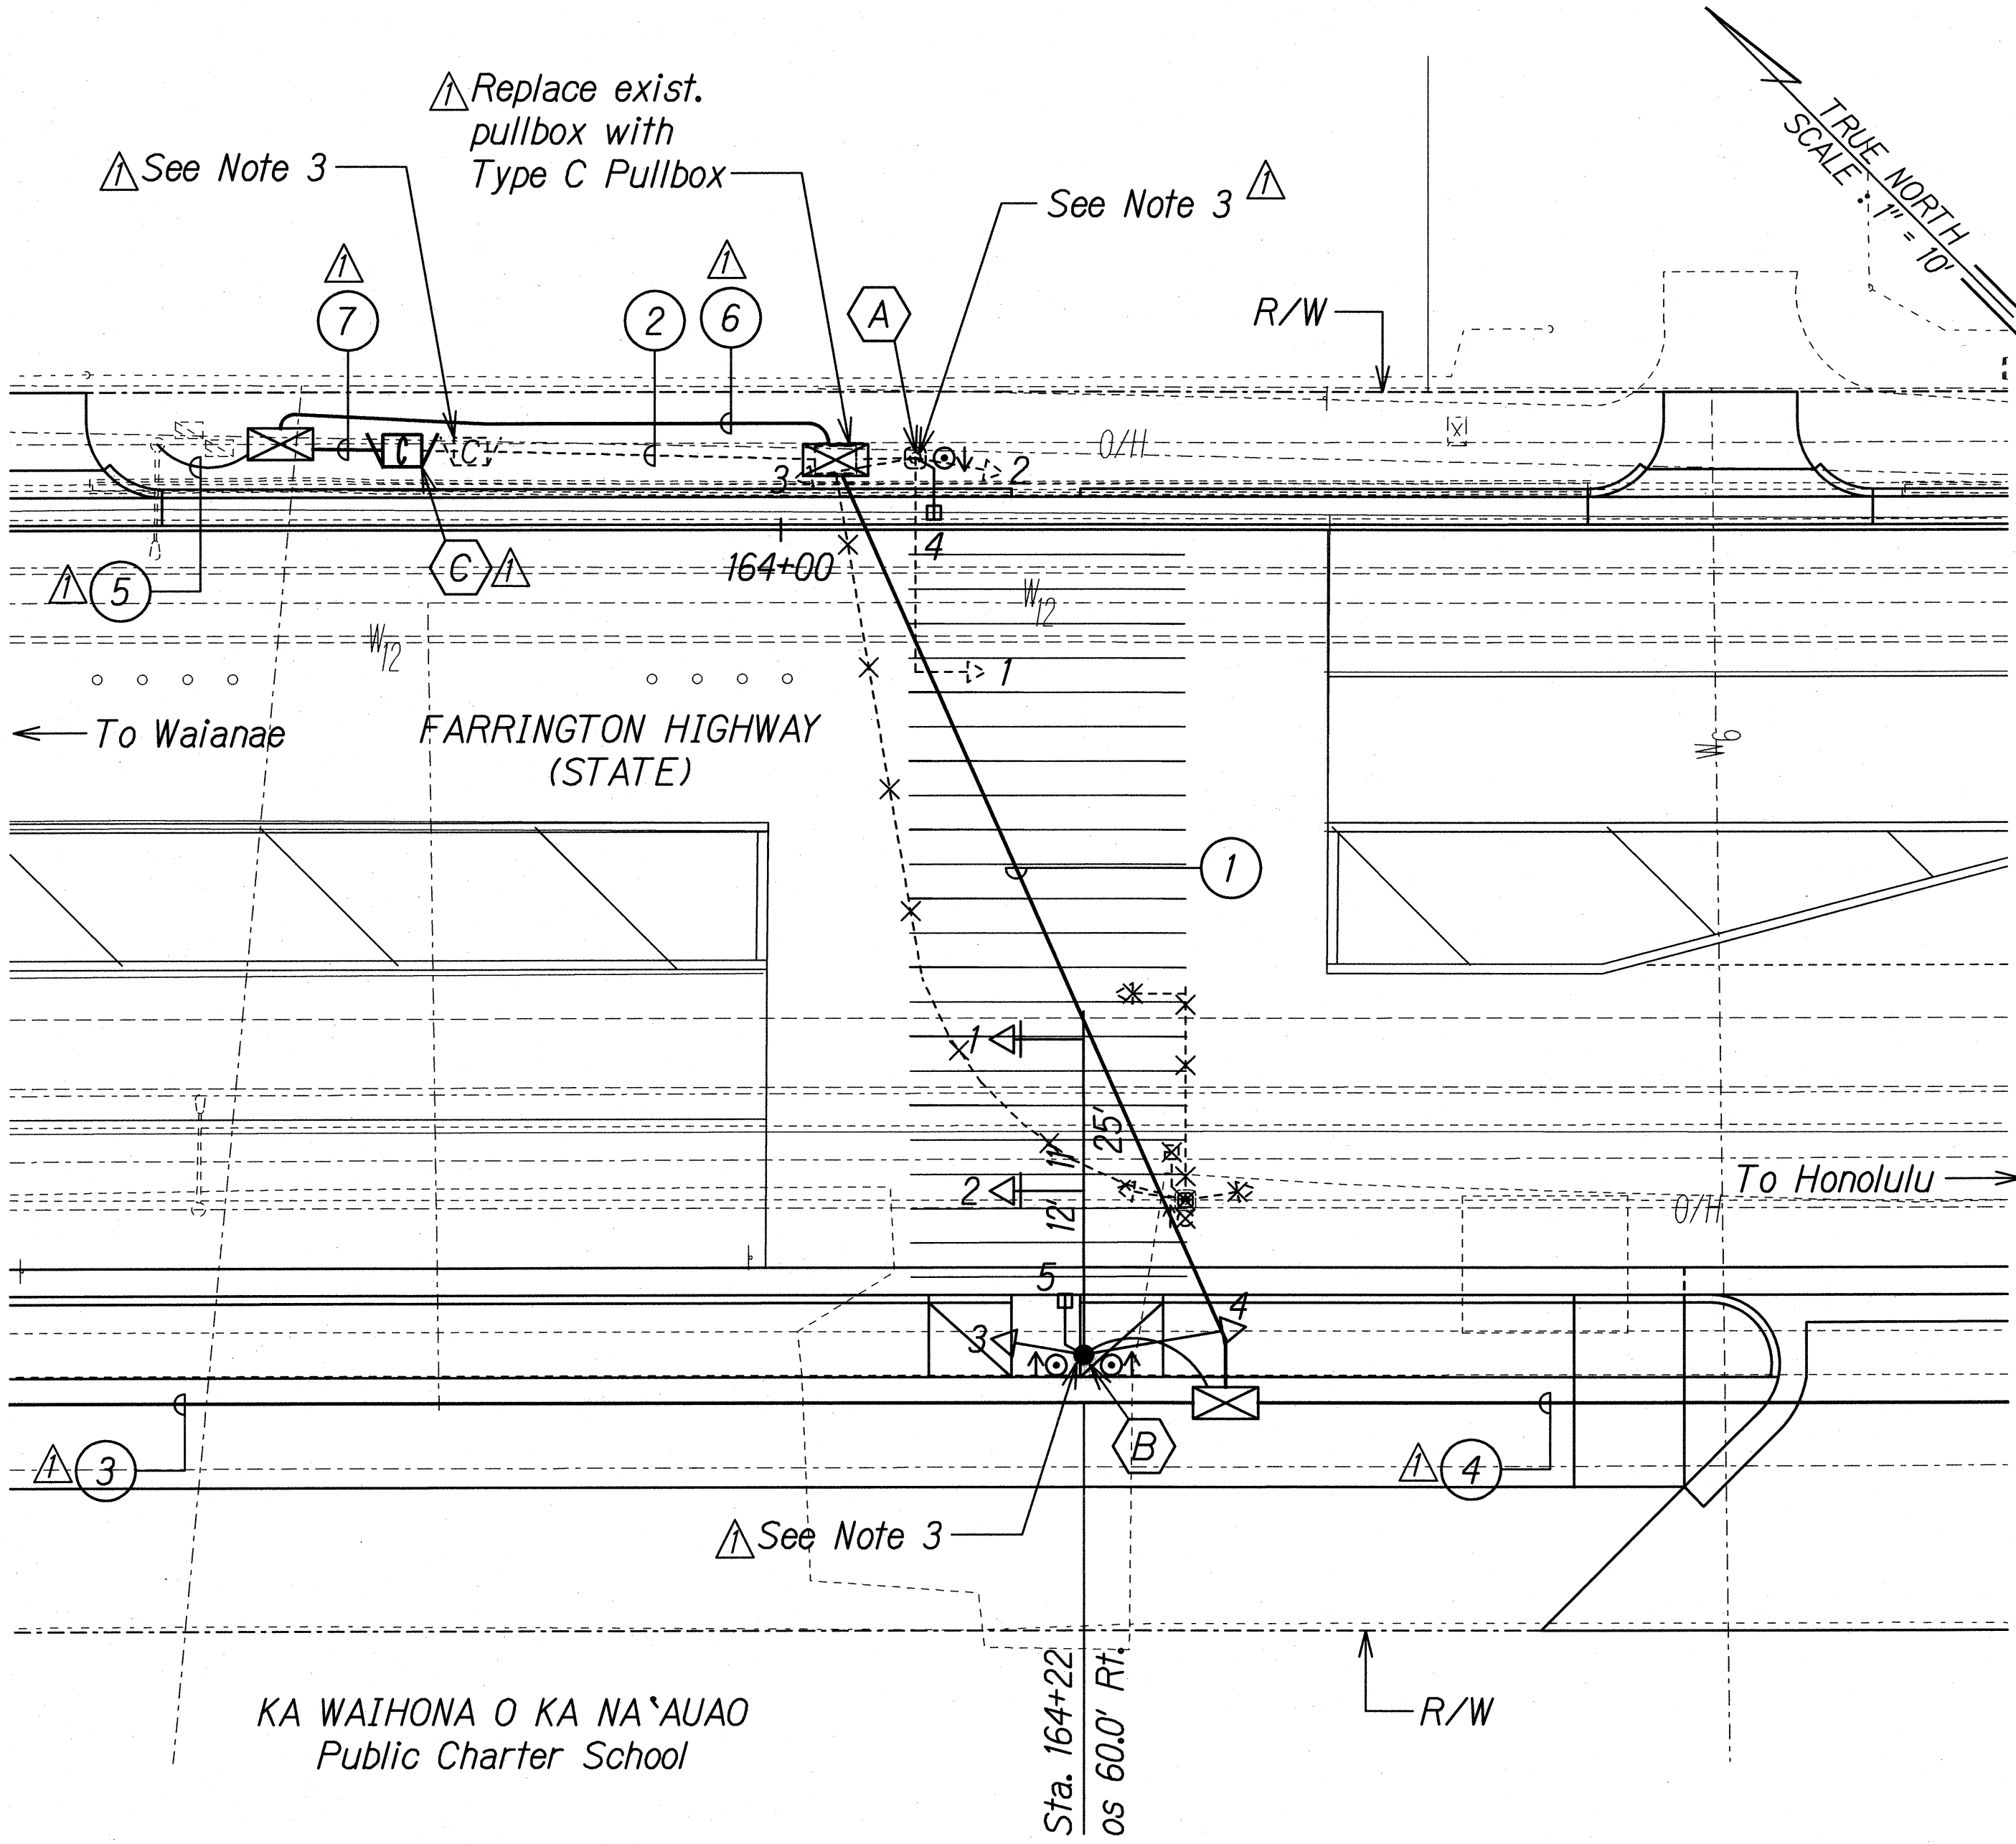


PHASE DIAGRAM
Model 170E Controller
Model 332A Cabinet
→ Vehicle Movement
↔ Pedestrian Movement

- Notes:
- For foundation details see Sheet S6.1
 - For Interconnect Plan, See Sheet C.O. 94S-1
 - Existing traffic signal controller and traffic signal poles to be removed and salvaged upon completion of Nanakuli Village Center intersection. Eradicate crosswalk markings upon removal of traffic signal. Interconnect system and traffic signal pullboxes to remain.


DATE: _____
SURVEY PLOTTED BY: _____
DRAWN BY: _____
DESIGNED BY: _____
CHECKED BY: _____
NOTE BOOK: _____
No. _____

TS-6 DOT-FARRINGTON HWY INTERSECTIONS NANAKULI HALEAKALA/CADD/Sheets/TS-6/TSP-KAWAHOA.DGN

Y:\2015\15-002\DWG\C-35 TRAFFIC SIGNAL PLAN.DWG Aug 14, 2017-8:37 AM


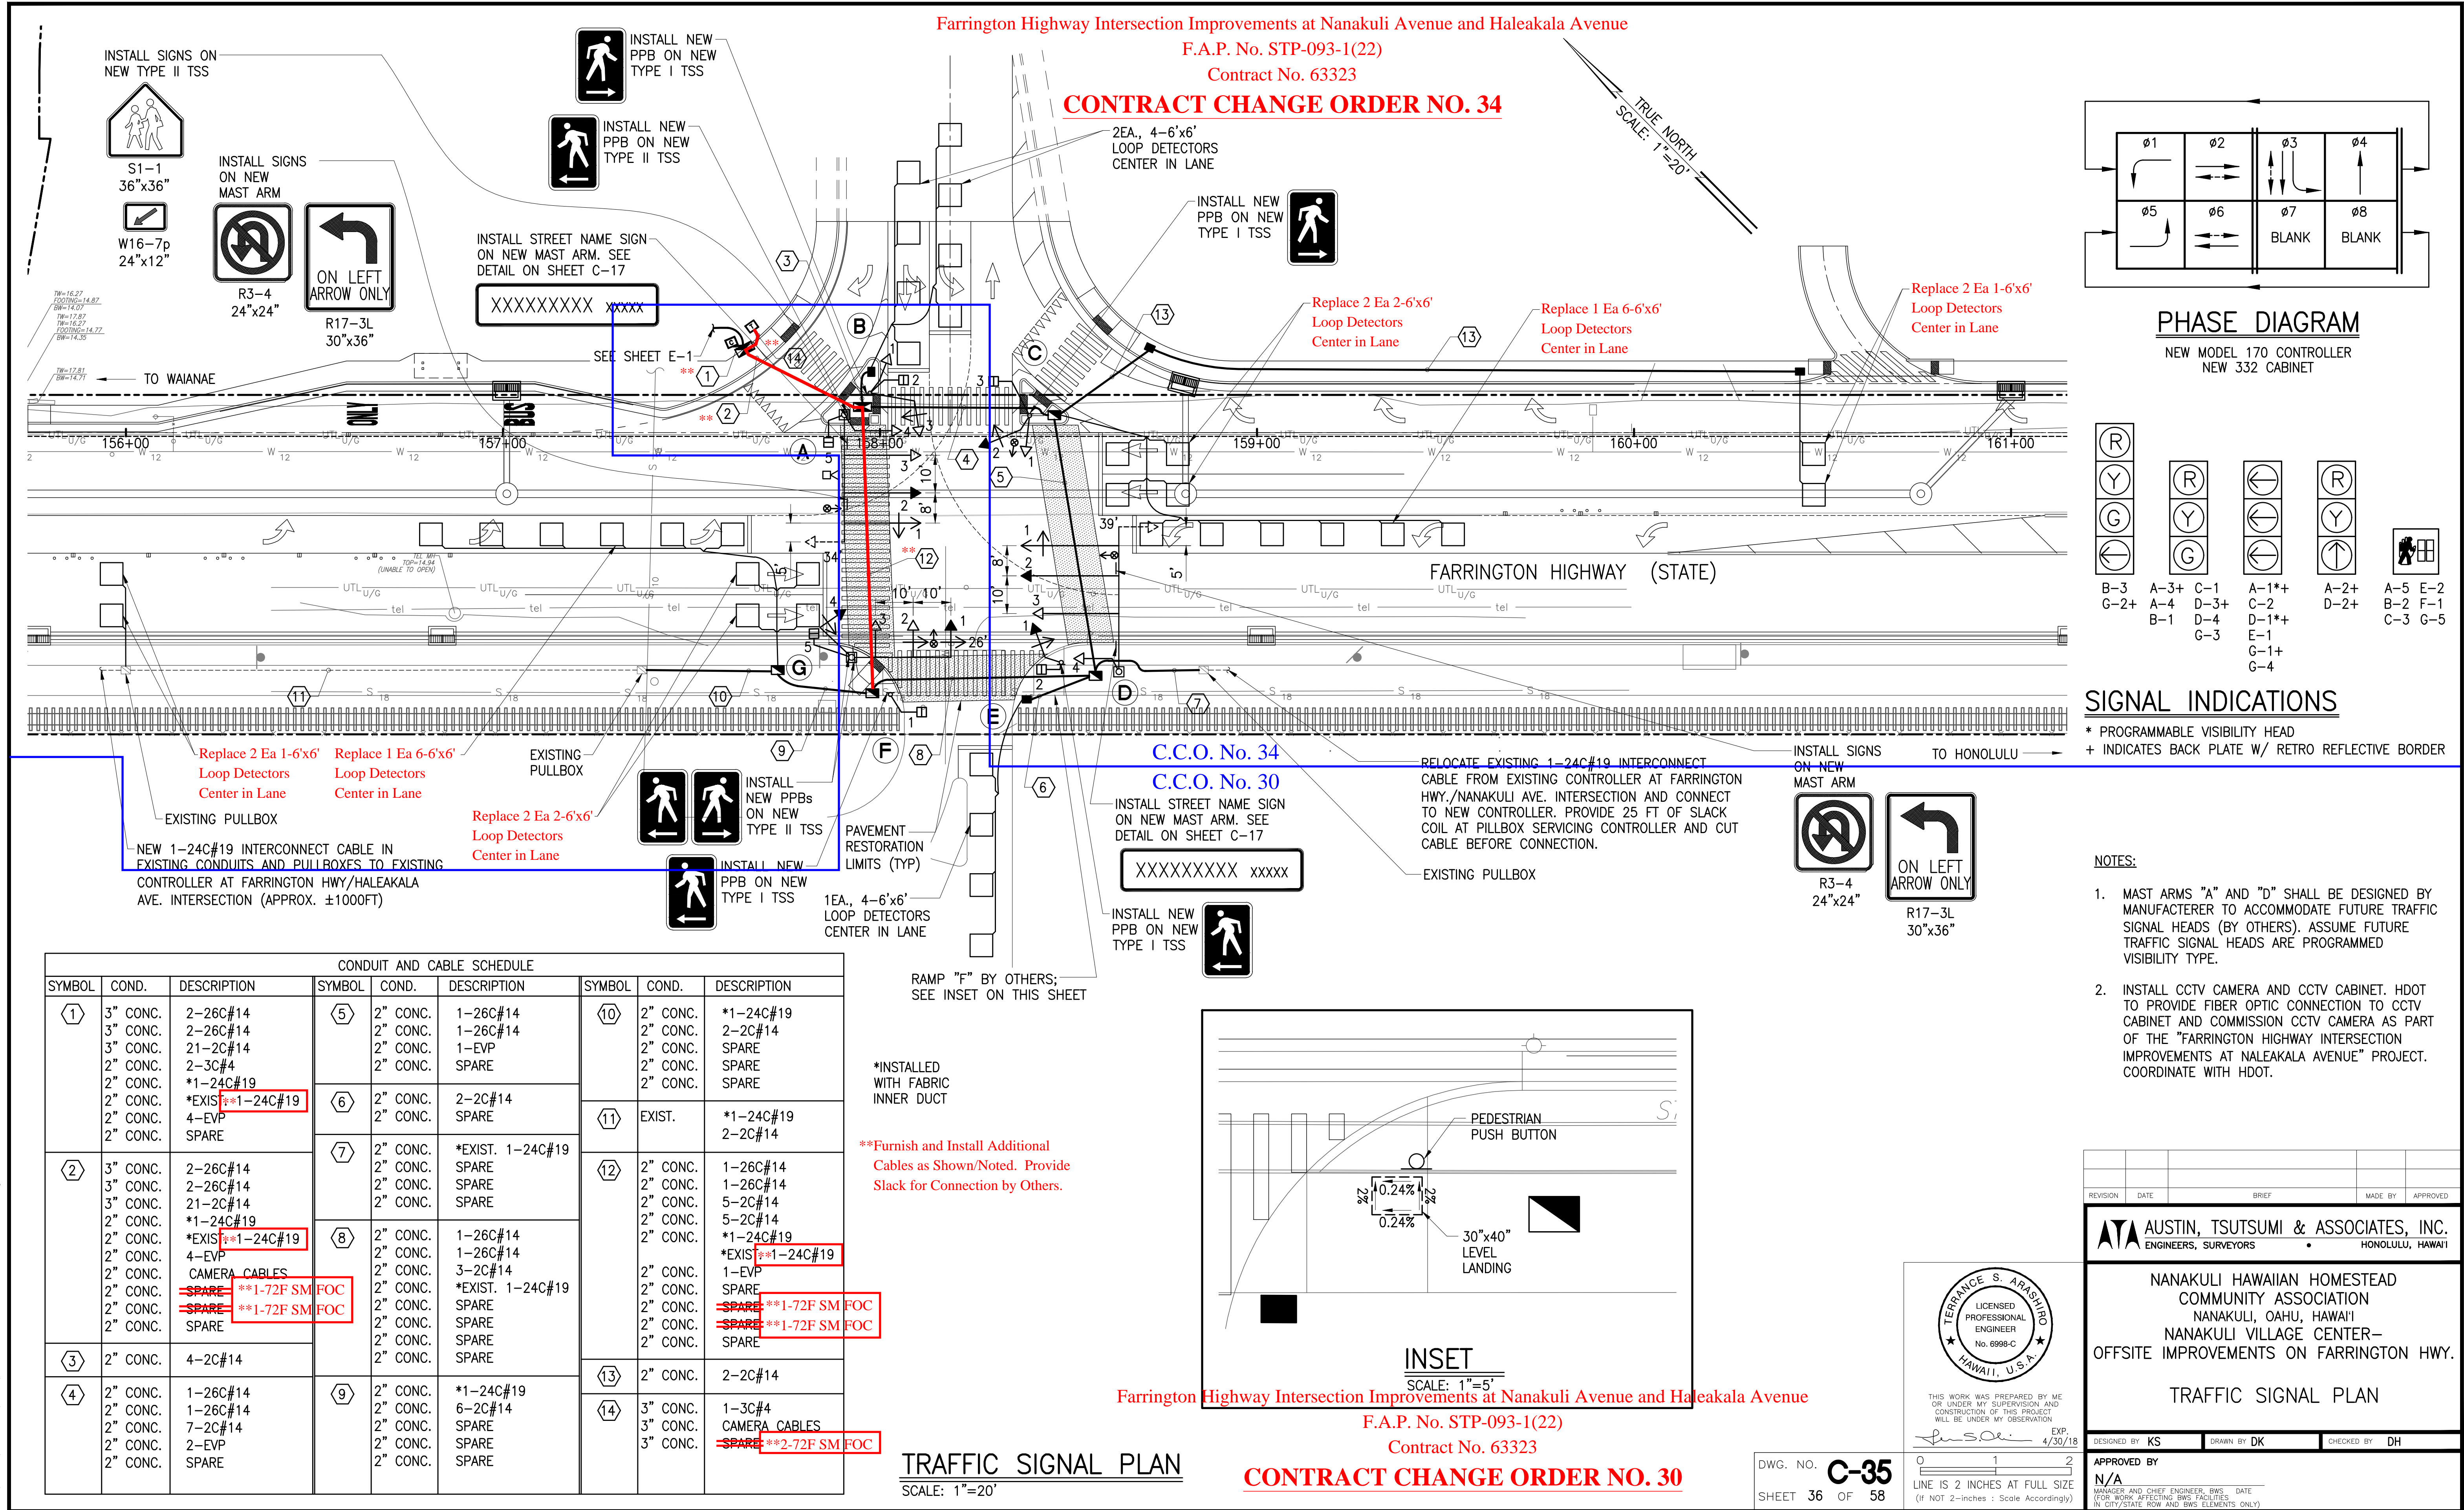


FED. ROAD DIST. NO.	STATE	FEDERAL AID PROJ. NO.	FISCAL YEAR	SHEET NO.	TOTAL SHEETS
HAWAII	HAW.	STP-093-1(22)	2013	C.O. 93	230

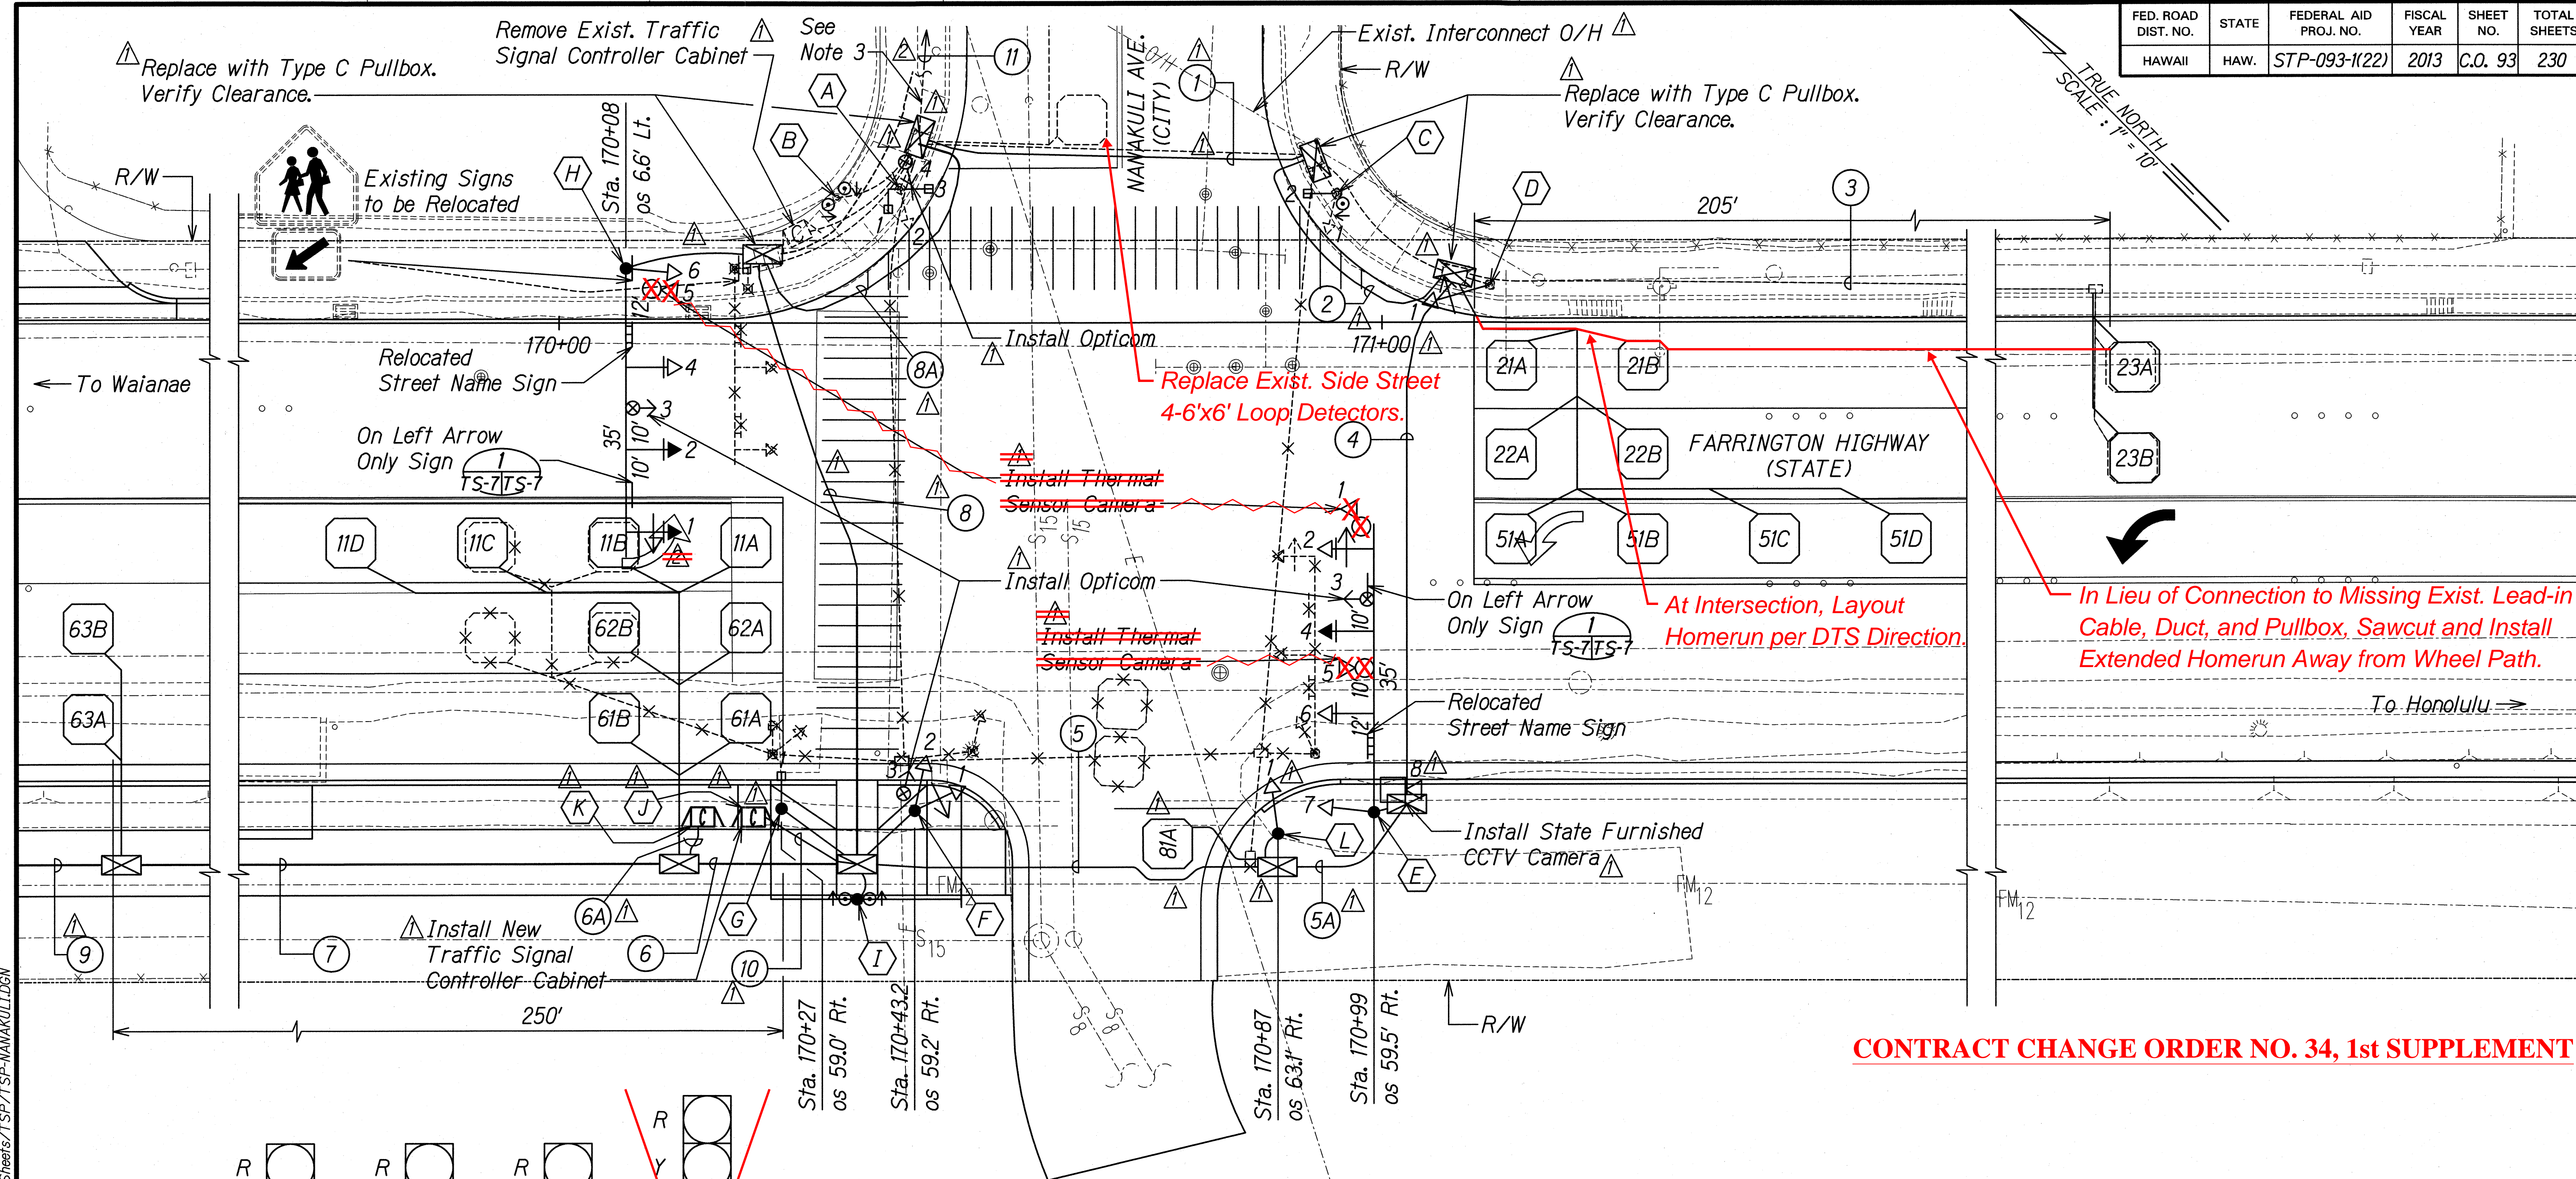


CONTRACT CHANGE ORDER NO. 34, 1st SUPPLEMENT

DESIGNED BY	DATE
DRAWN BY	
CHECKED BY	
NOTED BY	
QUANTITIES BY	
DATE	

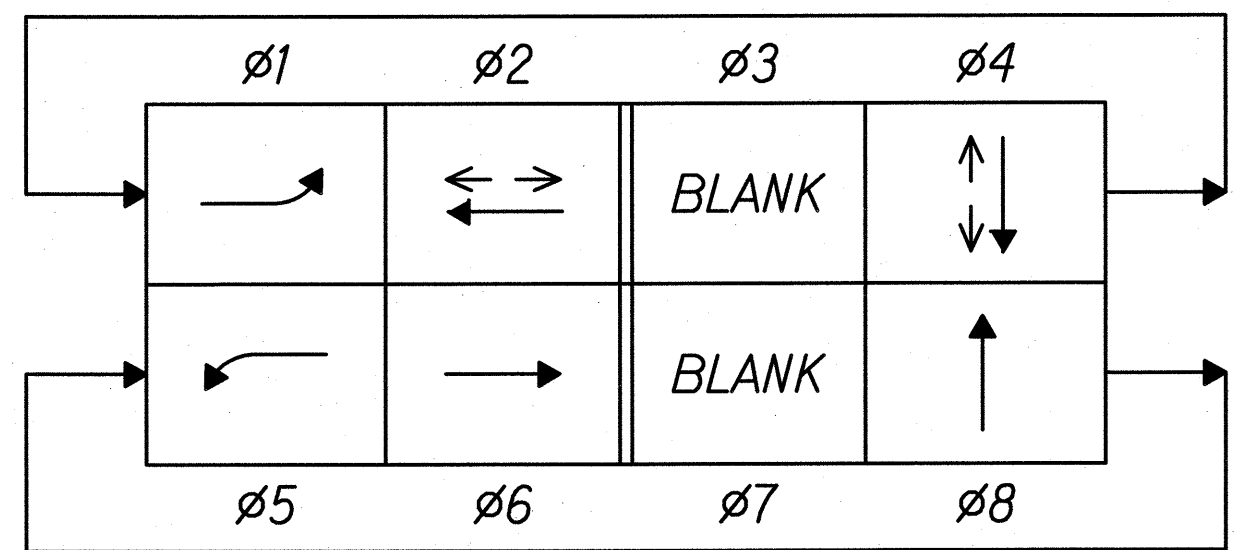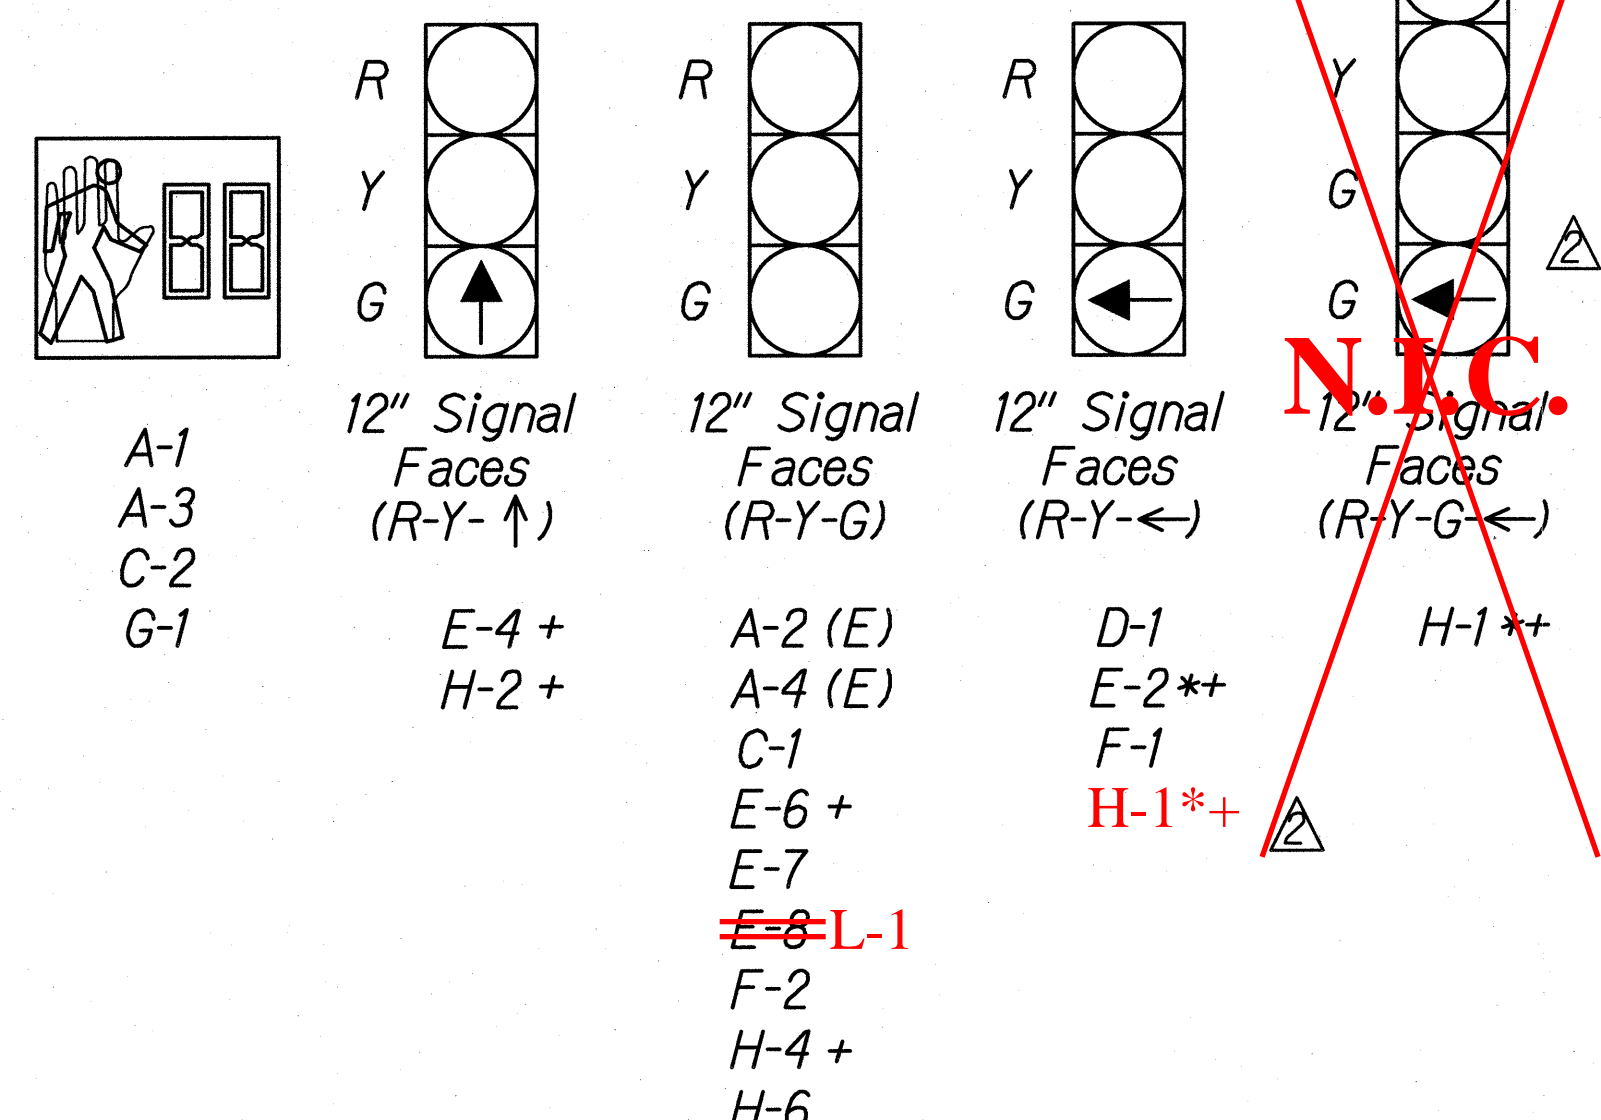

PHASE DIAGRAM
Model 170E Controller
Model 332A Cabinet
→ Vehicle Movement
↔ Pedestrian Movement

- Notes:
- For foundation details see Sheet S6.1
 - For Interconnect Plan, See Sheet C.O. 94S-1
 - For Traffic Signal System electrical details, See Sheet C.O. 145S-3

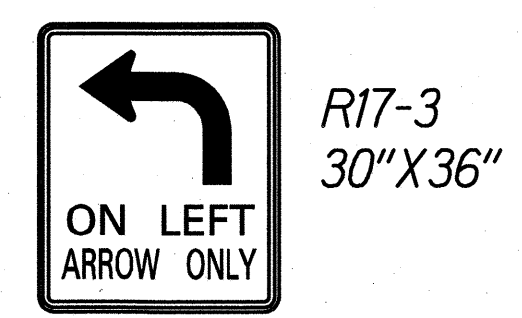

ON LEFT ARROW ONLY SIGN
Not to Scale

DATE	REVISION
2/9/18	Revised Contra-Flow Signal Head
6/21/17	Add Thermal Cameras, Opticoms New Controller, CCTV Camera and Interconnect Conduit & Cable

THIS WORK WAS PREPARED BY ME OR UNDER MY SUPERVISION.
SIGNATURE: *Gerald D. Andrade* EXPIRATION DATE: 04/30/18

STATE OF HAWAII
DEPARTMENT OF TRANSPORTATION
HIGHWAYS DIVISION

TRAFFIC SIGNAL PLAN
FARRINGTON AND NANAKULI
FARRINGTON HIGHWAY INTERSECTION IMPROVEMENTS
AT NANAKULI AVENUE AND HALEAKALA AVENUE
Federal-Aid Project No. STP-093-1(22)
Scale: 1"=10' Date: April 2013

"AS-BUILT"

C.O. 93

FARRINGTON AND NANAKULI

Material List				
Pole	Base Type	Standard Type	Mounting Type	PPB Assembly
A(E)	exist	I-exist	(1X3) Type IV (ped head)	
			(2) Type I (exist)	
			(4) Opticom (Vert.)	
B(E)	exist	I-exist		
C(E)	exist	I-exist	(1) Type I (exist)	
			(2) Type IV (ped head)	
D(E)	exist	I-exist	(1) Type I	
			(4) Thermal Camera (Horiz.)	
E	*	II-35	(2) Type VI	
			(3) Opticom (Horiz.)	
			(4) Type VI	
			(5) Thermal Camera (Horiz.)	
			(6) Type VI	
			(7) Type V	
F	*	I-10	(8) CCTV Camera (Horiz.)**	
			(1X2) Type II	
			(3) Opticom (Vert.)	
G	*	I-8	(1) Type I (ped head)	1
H	*	II-35	(1) Type VI	
			(2) Type VI	
			(3) Opticom (Horiz.)	
			(4) Type VI	
			(5) Thermal Camera (Horiz.)	
			(6) Type IV	
I	*	I-3		2
J	D		170E Controller	
K	D		332A Cabinet and Base	
			332A Cabinet and Base**	
L	*	I-10	(1) Type II	

* For Traffic Signal Pole Base, See Std. Plan TE-32, TE-33, TE-33A.1 and TE-33A.2.
** CCTV Camera and 332A Cabinet Base for CCTV System furnished by the State.

Cable and Conduit Schedule											
Run ○	Conduit Size	Type 1 Signal Control 26C#14	Type 2 PPB/ Loops 2C#14	Type 5 Signal Control 4C#14	Type 6 Power 3C#6	Type 7 Opticom 3C#20	12PR#19 Inter- connect	72F Single Mode FOC	Coax	Camera Control	3C#12
1	2"	1									
	3-2"		Spare								
2	2"	1									
	2"		1								
	2-2"	Spare									
3	2"(E)		1								
4	2"	1									
	2"		4								
	2-2"	Spare									
5	2"	1									
	2"								1	1	1
	2"			2							
	2"		5								
	2"					1					
	2"	Spare									
5A	2"	1									
	2"		4								
	2"			2							
	2"					1					
	2"								1	1	1
	2"	Spare									
6	2"		3								
	2"				1						
	2"						1				
	2"			Spare				≠			
	2"								1	1	1
	2"	Spare									
6A	2"				1						
	2"							1			
	2"								1	1	1
	2"	Spare									
7	2"		1								
	2"						1				
	2"							1			
	2"	Spare									
8	2"	1									
	2"		2								
	2"				1						
	2"				1						
	2"					1					
	2"			1							
	2"						1				
	2"	Spare									

CONTRACT CHANGE ORDER NO. 30

6/21/17	△ Add Thermal Cameras, Opticoms, CCTV Camera, Interconnect Conduit
	¢ Cable
DATE	REVISION

THIS WORK WAS PREPARED BY ME OR UNDER MY SUPERVISION.

Gerald D. Andrade
SIGNATURE

04/30/18
EXPIRATION DATE OF THE LICENSE

STATE OF HAWAII
DEPARTMENT OF TRANSPORTATION
HIGHWAYS DIVISION

**MATERIAL LIST AND
CABLE AND CONDUIT SCHEDULE**

FARRINGTON HIGHWAY INTERSECTION IMPROVEMENTS
AT NANAKULI AVENUE AND HALEAKALA AVENUE
Federal-Aid Project No. STP-093-1(22)

Scale: None Date: April 2013

"AS-BUILT"

C.O. 94

DATE	_____
SURVEY PLOTTED BY	_____
DRAWN BY	_____
DESIGNED BY	_____
NOTED BY	_____
CHECKED BY	_____
ORIGINAL PLAN	_____
NOTE BOOK	_____
No.	_____

T-1/201 - FARRINGTON HWY INTERSECTIONS NANAKULI HALEAKALA/CADD/CHANGEORDER/COI/7SP-093B-NANAKULI.DGN

FED. ROAD DIST. NO.	STATE	FEDERAL AID PROJ. NO.	FISCAL YEAR	SHEET NO.	TOTAL SHEETS
HAWAII	HAW.	STP-093-1(22)	2013	C.O. 94S-1	230

FARRINGTON AND NANAKULI

△

Cable and Conduit Schedule											
Run	Conduit Size	Type 1 Signal Control 26C#14	Type 2 PPB/ Loops 2C#14	Type 5 Signal Control 4C#14	Type 6 Power 3C#6	Type 7 Opticom 3C#20	12PR#19 Inter-connect	72F Single Mode FOC	Coax	Camera Control	3C#12
8A	2"	1									
	2"		2								
	2"				1						
	2"				1						
	2-2"	Spare									
9	2"						1				
	2"							1			
	2-2"	Spare									
10	2-2"	2									
	2"		5								
	2"		6								
	2"				1						
	2"					1					
	2"			3							
	2"					3					
11	2"(E)				1(E)						
	2"				1						
△	2"				1						

CONTRACT CHANGE ORDER NO. 30

2/9/18	△ Revised Contra-Flow Signal Head
6/21/17	△ Add Thermal Cameras, Opticoms, CCTV Camera, Interconnect Conduit
	¢ Cable
DATE	REVISION

ORIGINAL PLAN	SURVEY PLOTTED BY	DATE
NOTE BOOK	DRAWN BY	
	DESIGNED BY	
	QUANTITIES BY	
	CHECKED BY	

T-1/DOIT - FARRINGTON HWY INTERSECTIONS NANAKULI HALEAKALA/CADD/CHANGEORDER C01/TSP-03C-NANAKULI.DGN

GERALD D. ANDRADE

LICENSED PROFESSIONAL ENGINEER

No. 10377-C

HAWAII, U.S.A.

THIS WORK WAS PREPARED BY ME OR UNDER MY SUPERVISION.

Signature

04/30/18

EXPIRATION DATE OF THE LICENSE

STATE OF HAWAII

DEPARTMENT OF TRANSPORTATION

HIGHWAYS DIVISION

MATERIAL LIST AND CABLE AND CONDUIT SCHEDULE


FARRINGTON HIGHWAY INTERSECTION IMPROVEMENTS AT NANAKULI AVENUE AND HALEAKALA AVENUE

Federal-Aid Project No. STP-093-1(22)

Scale: None

Date: April 2013

FED. ROAD DIST. NO.	STATE	FEDERAL AID PROJ. NO.	FISCAL YEAR	SHEET NO.	TOTAL SHEETS
HAWAII	HAW.	STP-093-1(22)	2013	C.O. 94S-2	230

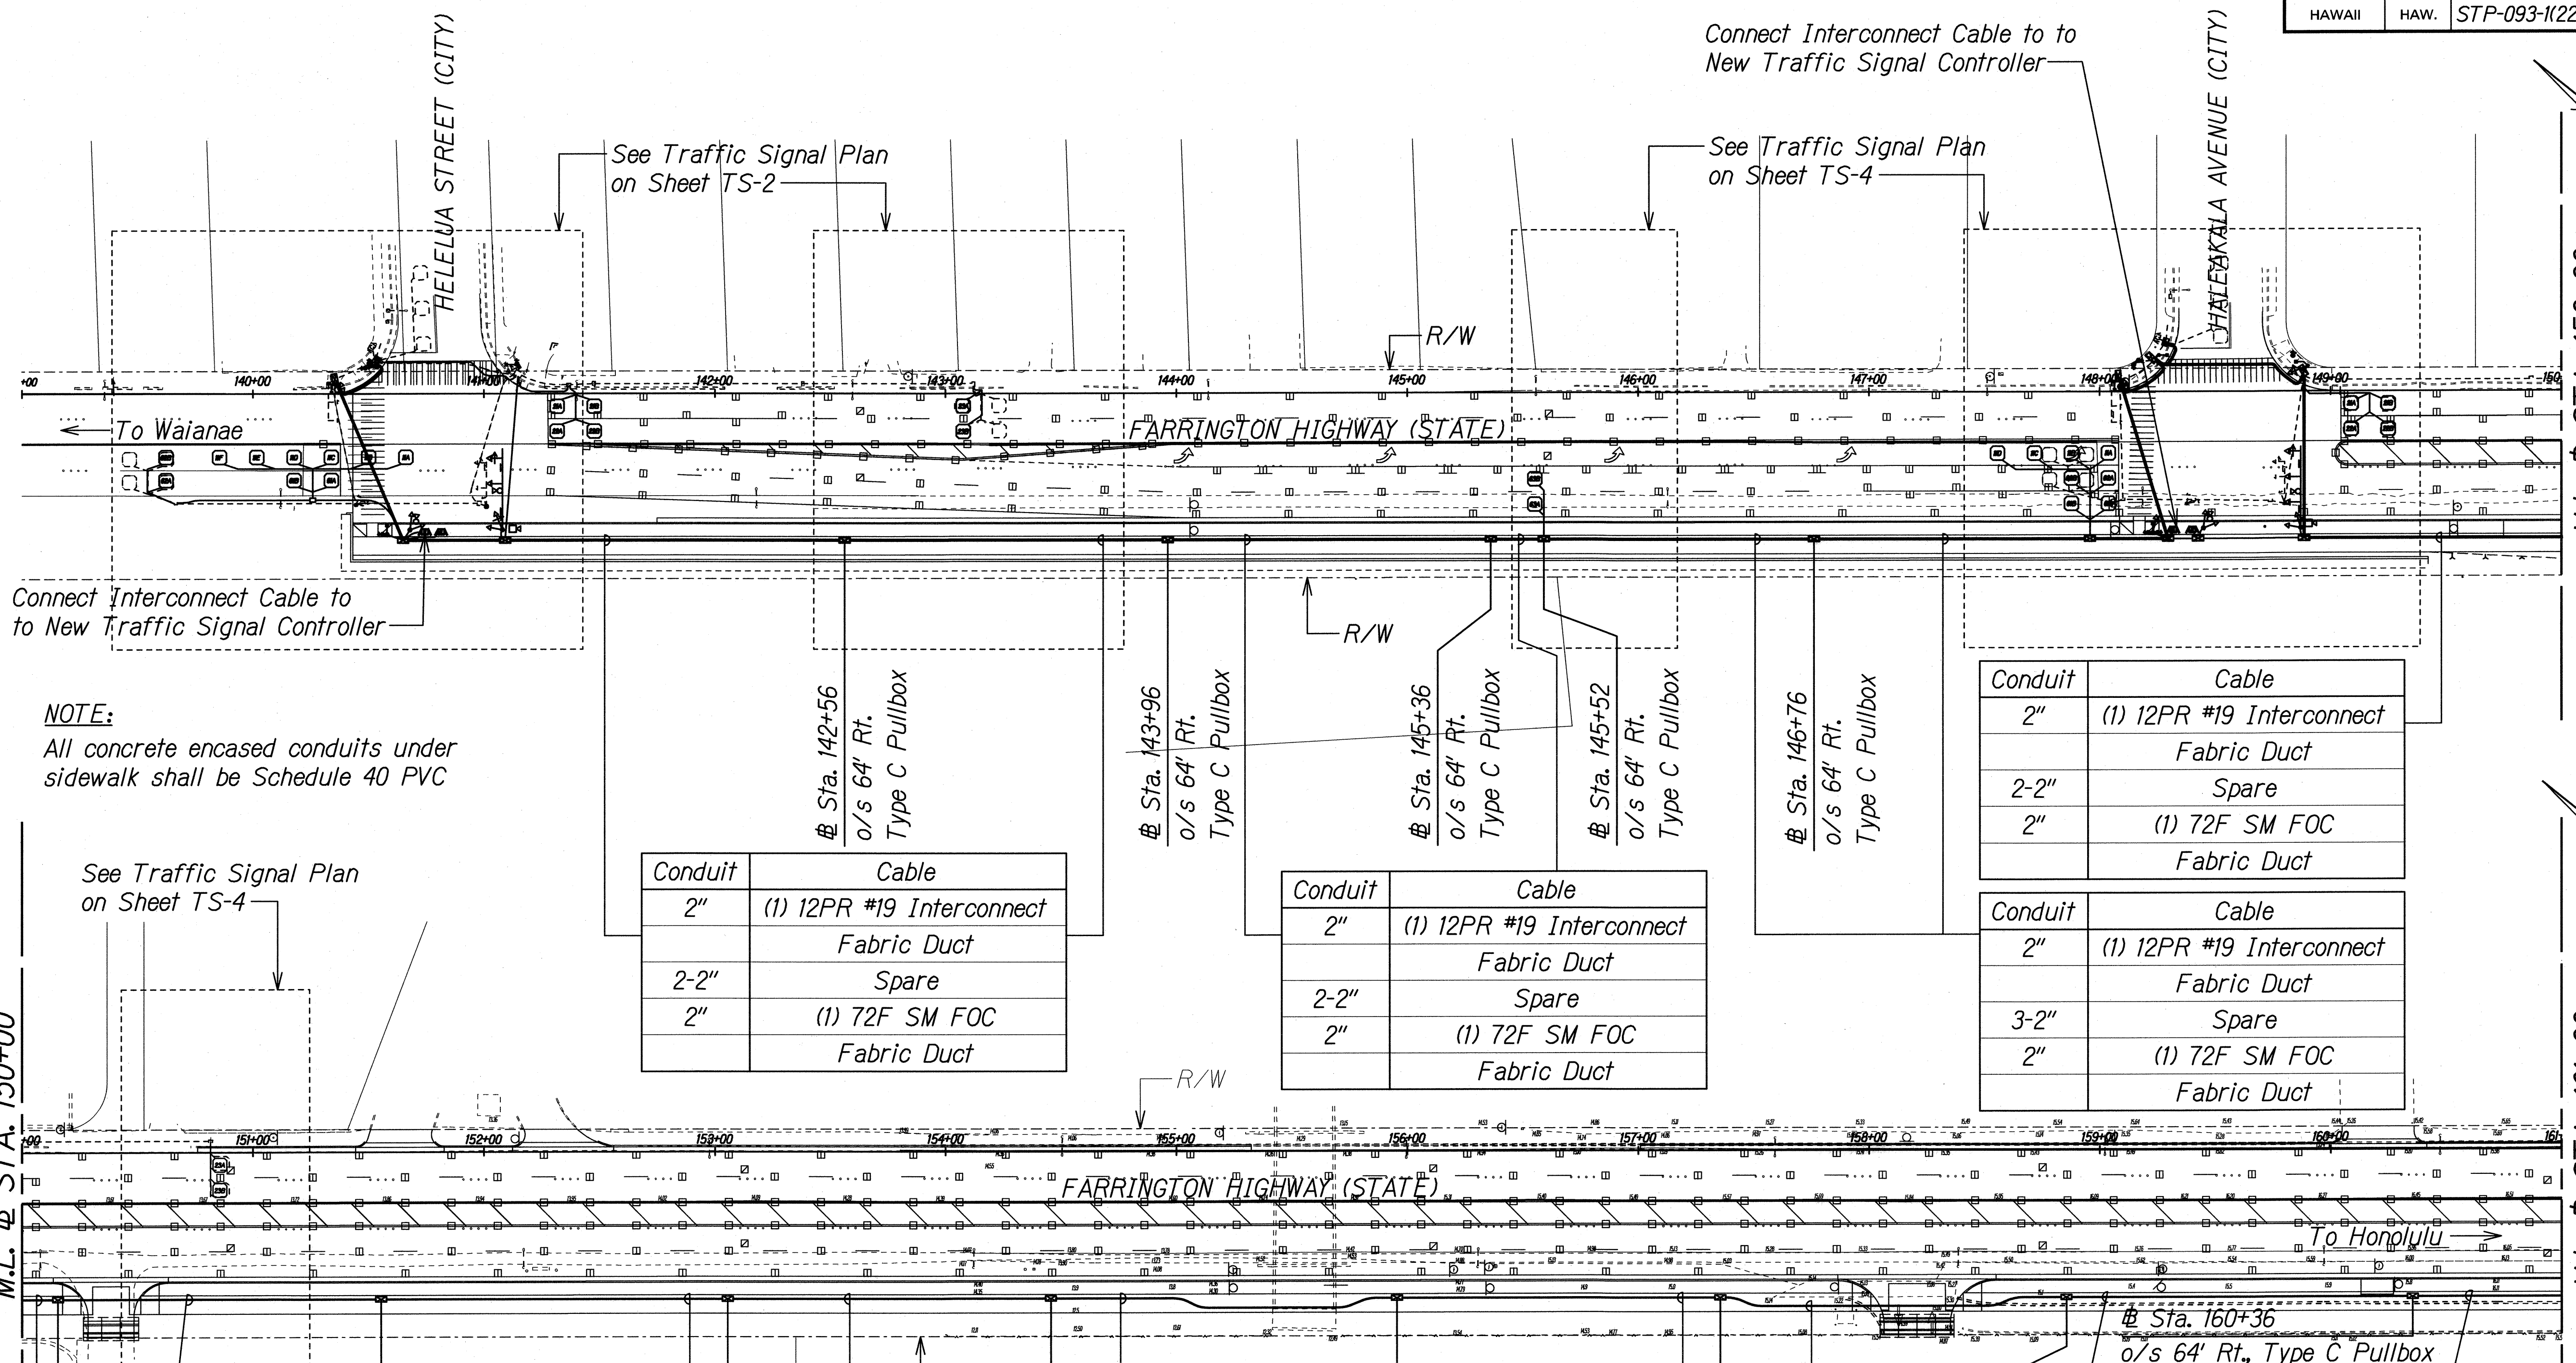

NOTE:
All concrete encased conduits under sidewalk shall be Schedule 40 PVC

Conduit	Cable
2"	(1) 12PR #19 Interconnect Fabric Duct
2-2"	Spare
2"	(1) 72F SM FOC Fabric Duct

Conduit	Cable
2"	(1) 12PR #19 Interconnect Fabric Duct
2-2"	Spare
2"	(1) 72F SM FOC Fabric Duct

Conduit	Cable
2"	(1) 12PR #19 Interconnect Fabric Duct
2-2"	Spare
2"	(1) 72F SM FOC Fabric Duct

Conduit	Cable
2"	(1) 12PR #19 Interconnect Fabric Duct
3-2"	Spare
2"	(1) 72F SM FOC Fabric Duct

Conduit	Cable
2"	(1) 12PR #19 Interconnect Fabric Duct
2-2"	Spare
2"	(1) 72F SM FOC Fabric Duct

Conduit	Cable
2"	(1) 12PR #19 Interconnect Fabric Duct
2-2"	Spare
2"	(1) 72F SM FOC Fabric Duct

6/21/17	△ Add Thermal Cameras, Opticoms New Controller, CCTV Camera and Interconnect Conduit & Cable
DATE	REVISION

THIS WORK WAS PREPARED BY ME OR UNDER MY SUPERVISION.
Signature: *Gerald D. Andrade*
EXPIRATION DATE OF LICENSE: 04/30/18

STATE OF HAWAII
DEPARTMENT OF TRANSPORTATION
HIGHWAYS DIVISION

INTERCONNECT PLAN

CONTRACT CHANGE ORDER NO. 17

**FARRINGTON HIGHWAY INTERSECTION IMPROVEMENTS
AT NANAULI AVENUE AND HALEAKALA AVENUE**

Federal-Aid Project No. STP-093-1(22)

Scale: 1"=40' Date: April 2013


"AS-BUILT"

C.O. 94S-2

ORIGINAL PLAN	DATE
NOTED BY	
DESIGNED BY	
CHECKED BY	

T:\DOT-FARRINGTON HWY INTERSECTIONS\NANAULI HALEAKALA\CADD\CHANGEORDER\17\STP093-1-INTERCONNECT.DGN

FED. ROAD DIST. NO.	STATE	FEDERAL AID PROJ. NO.	FISCAL YEAR	SHEET NO.	TOTAL SHEETS
HAWAII	HAW.	STP-093-1(22)	2013	C.O. 94S-3	230

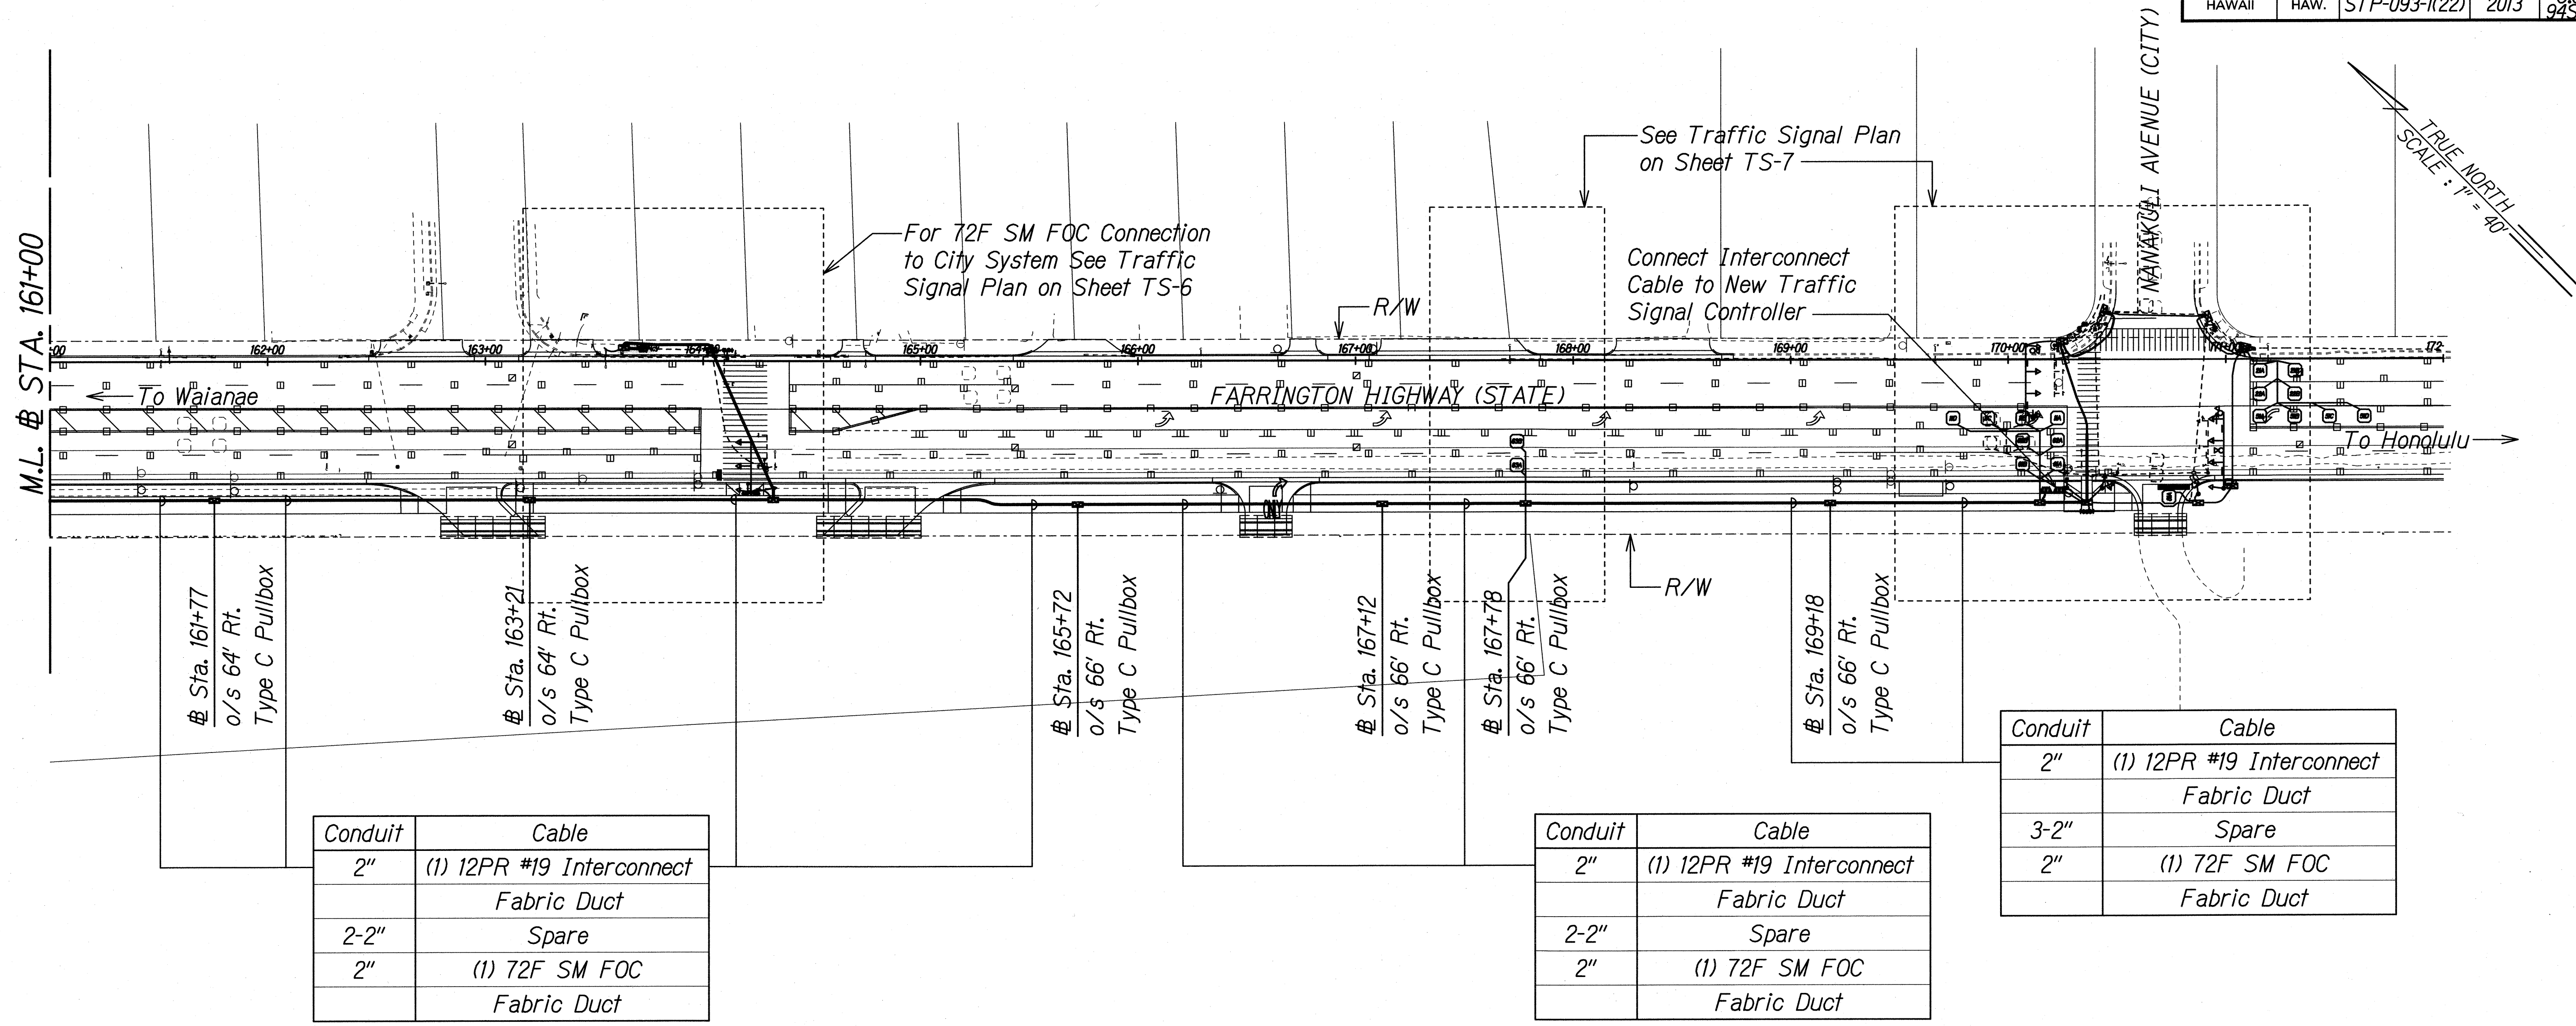

NOTE:
All concrete encased conduits under sidewalk shall be Schedule 40 PVC

CONTRACT CHANGE ORDER NO. 17

6/21/17	△ Add Thermal Cameras, Opticom's
	New Controller, CCTV Camera and
	Interconnect Conduit & Cable
DATE	REVISION

THIS WORK WAS PREPARED BY ME OR UNDER MY SUPERVISION.

Gerald D. Andrade
SIGNATURE

04/30/18
EXPIRATION DATE OF THE LICENSE

STATE OF HAWAII
DEPARTMENT OF TRANSPORTATION
HIGHWAYS DIVISION

INTERCONNECT PLAN


FARRINGTON HIGHWAY INTERSECTION IMPROVEMENTS
AT NANAKULI AVENUE AND HALEAKALA AVENUE
Federal-Aid Project No. STP-093-1(22)

Scale: 1"=40' Date: April 2013


ORIGINAL PLAN	SURVEY PLOTTED BY	DATE
NOTE BOOK	DRAWN BY	
	DESIGNED BY	
	QUANTITIES BY	
	CHECKED BY	

T:\DOT-FARRINGTON HWY INTERSECTIONS\NANAKULI\HALEAKALA\CADD\CHANGEORDER\CO1\TS07B-INTERCONNECT.DGN


FED. ROAD DIST. NO.	STATE	FEDERAL AID PROJ. NO.	FISCAL YEAR	SHEET NO.	TOTAL SHEETS
HAWAII	HAW.	STP-093-1(22)	2013	C.O. 94S-4	230

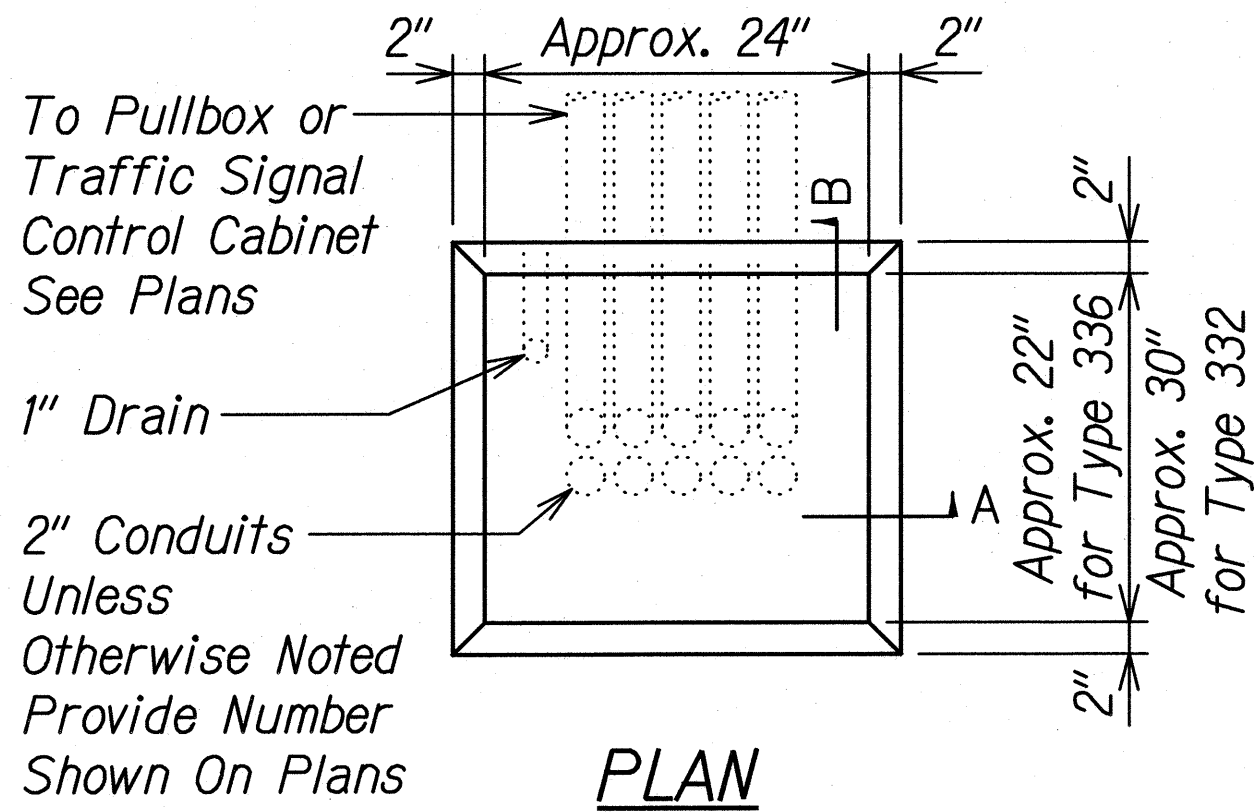

- NOTE(S):**
- Concrete shall be Class "B".
 - Dimensions shall be altered to suit controller cabinet actually furnished.
 - Conduit bends and drain are incidental to concrete base.
 - Refer to Cabinet Manufacturer's Specifications for details of anchor bolts and base setting.
 - All exposed surfaces of concrete base shall be given a Class 2, Rubbed Finish.

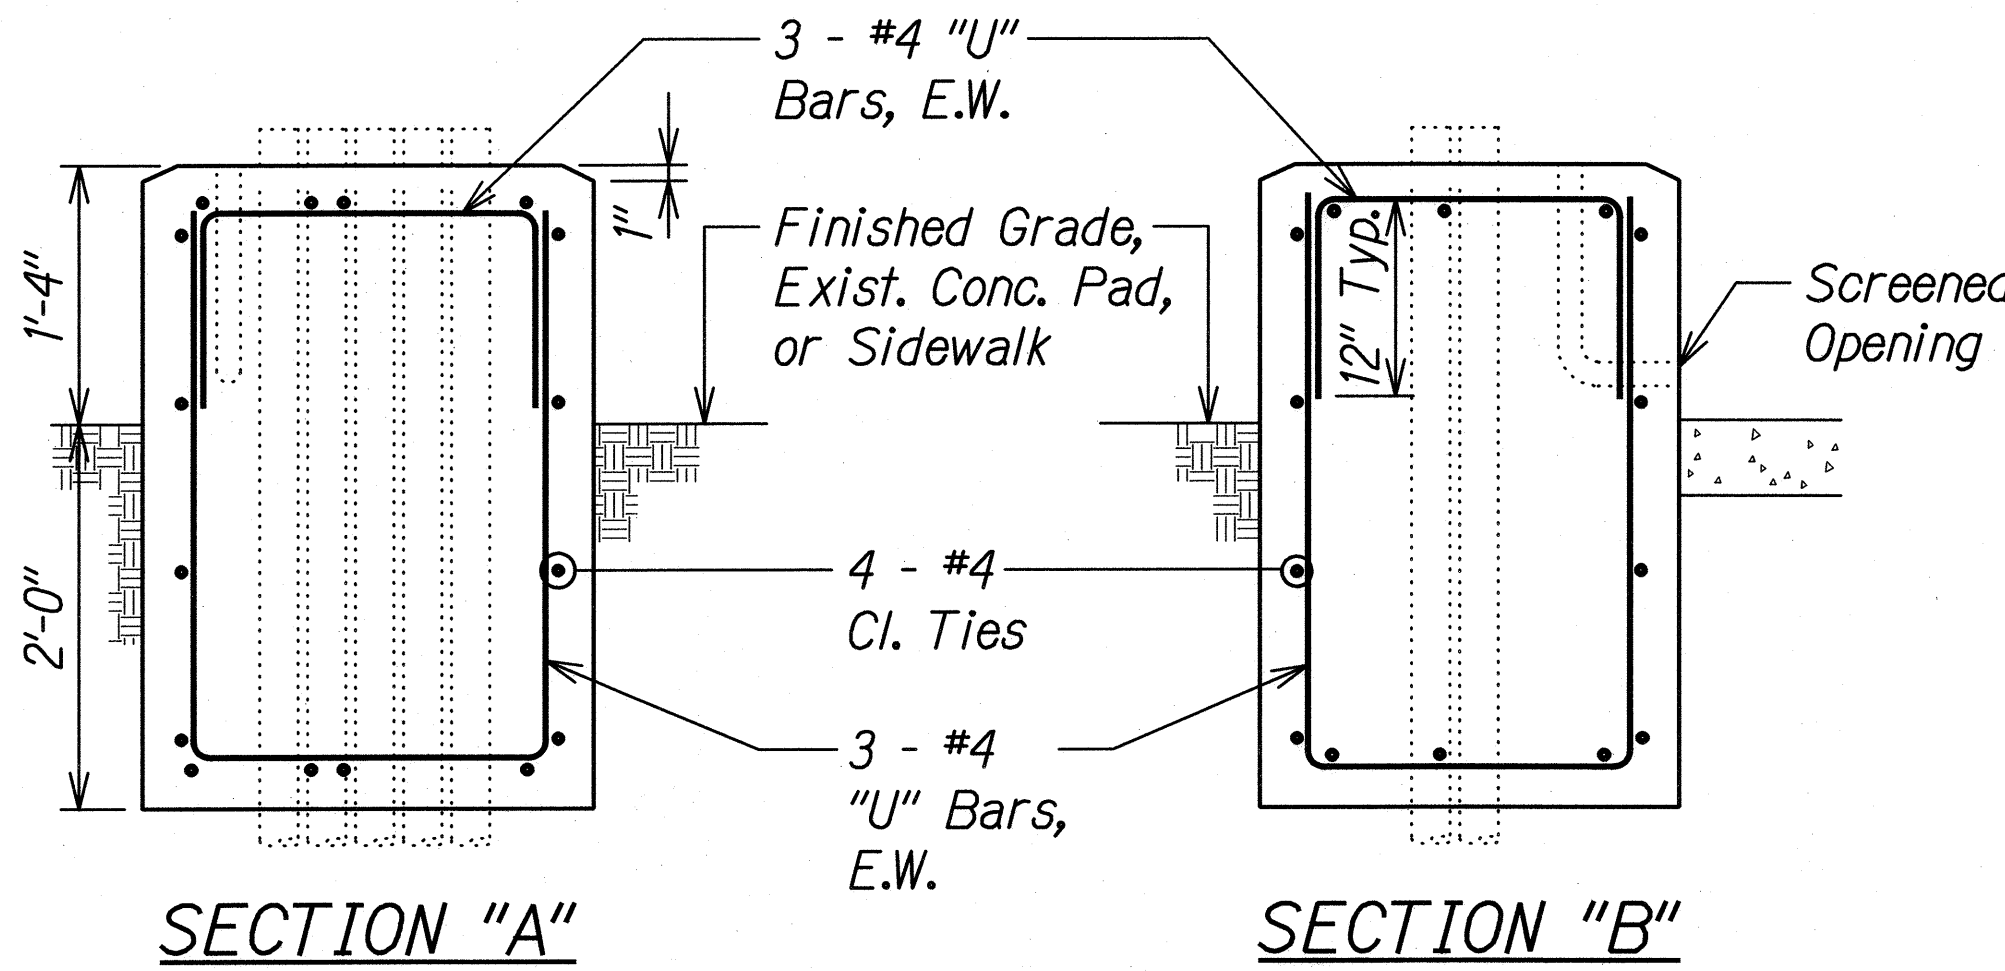

**TYPE "D" CONCRETE
BASE FOR CCTV CABINET**
Not to Scale

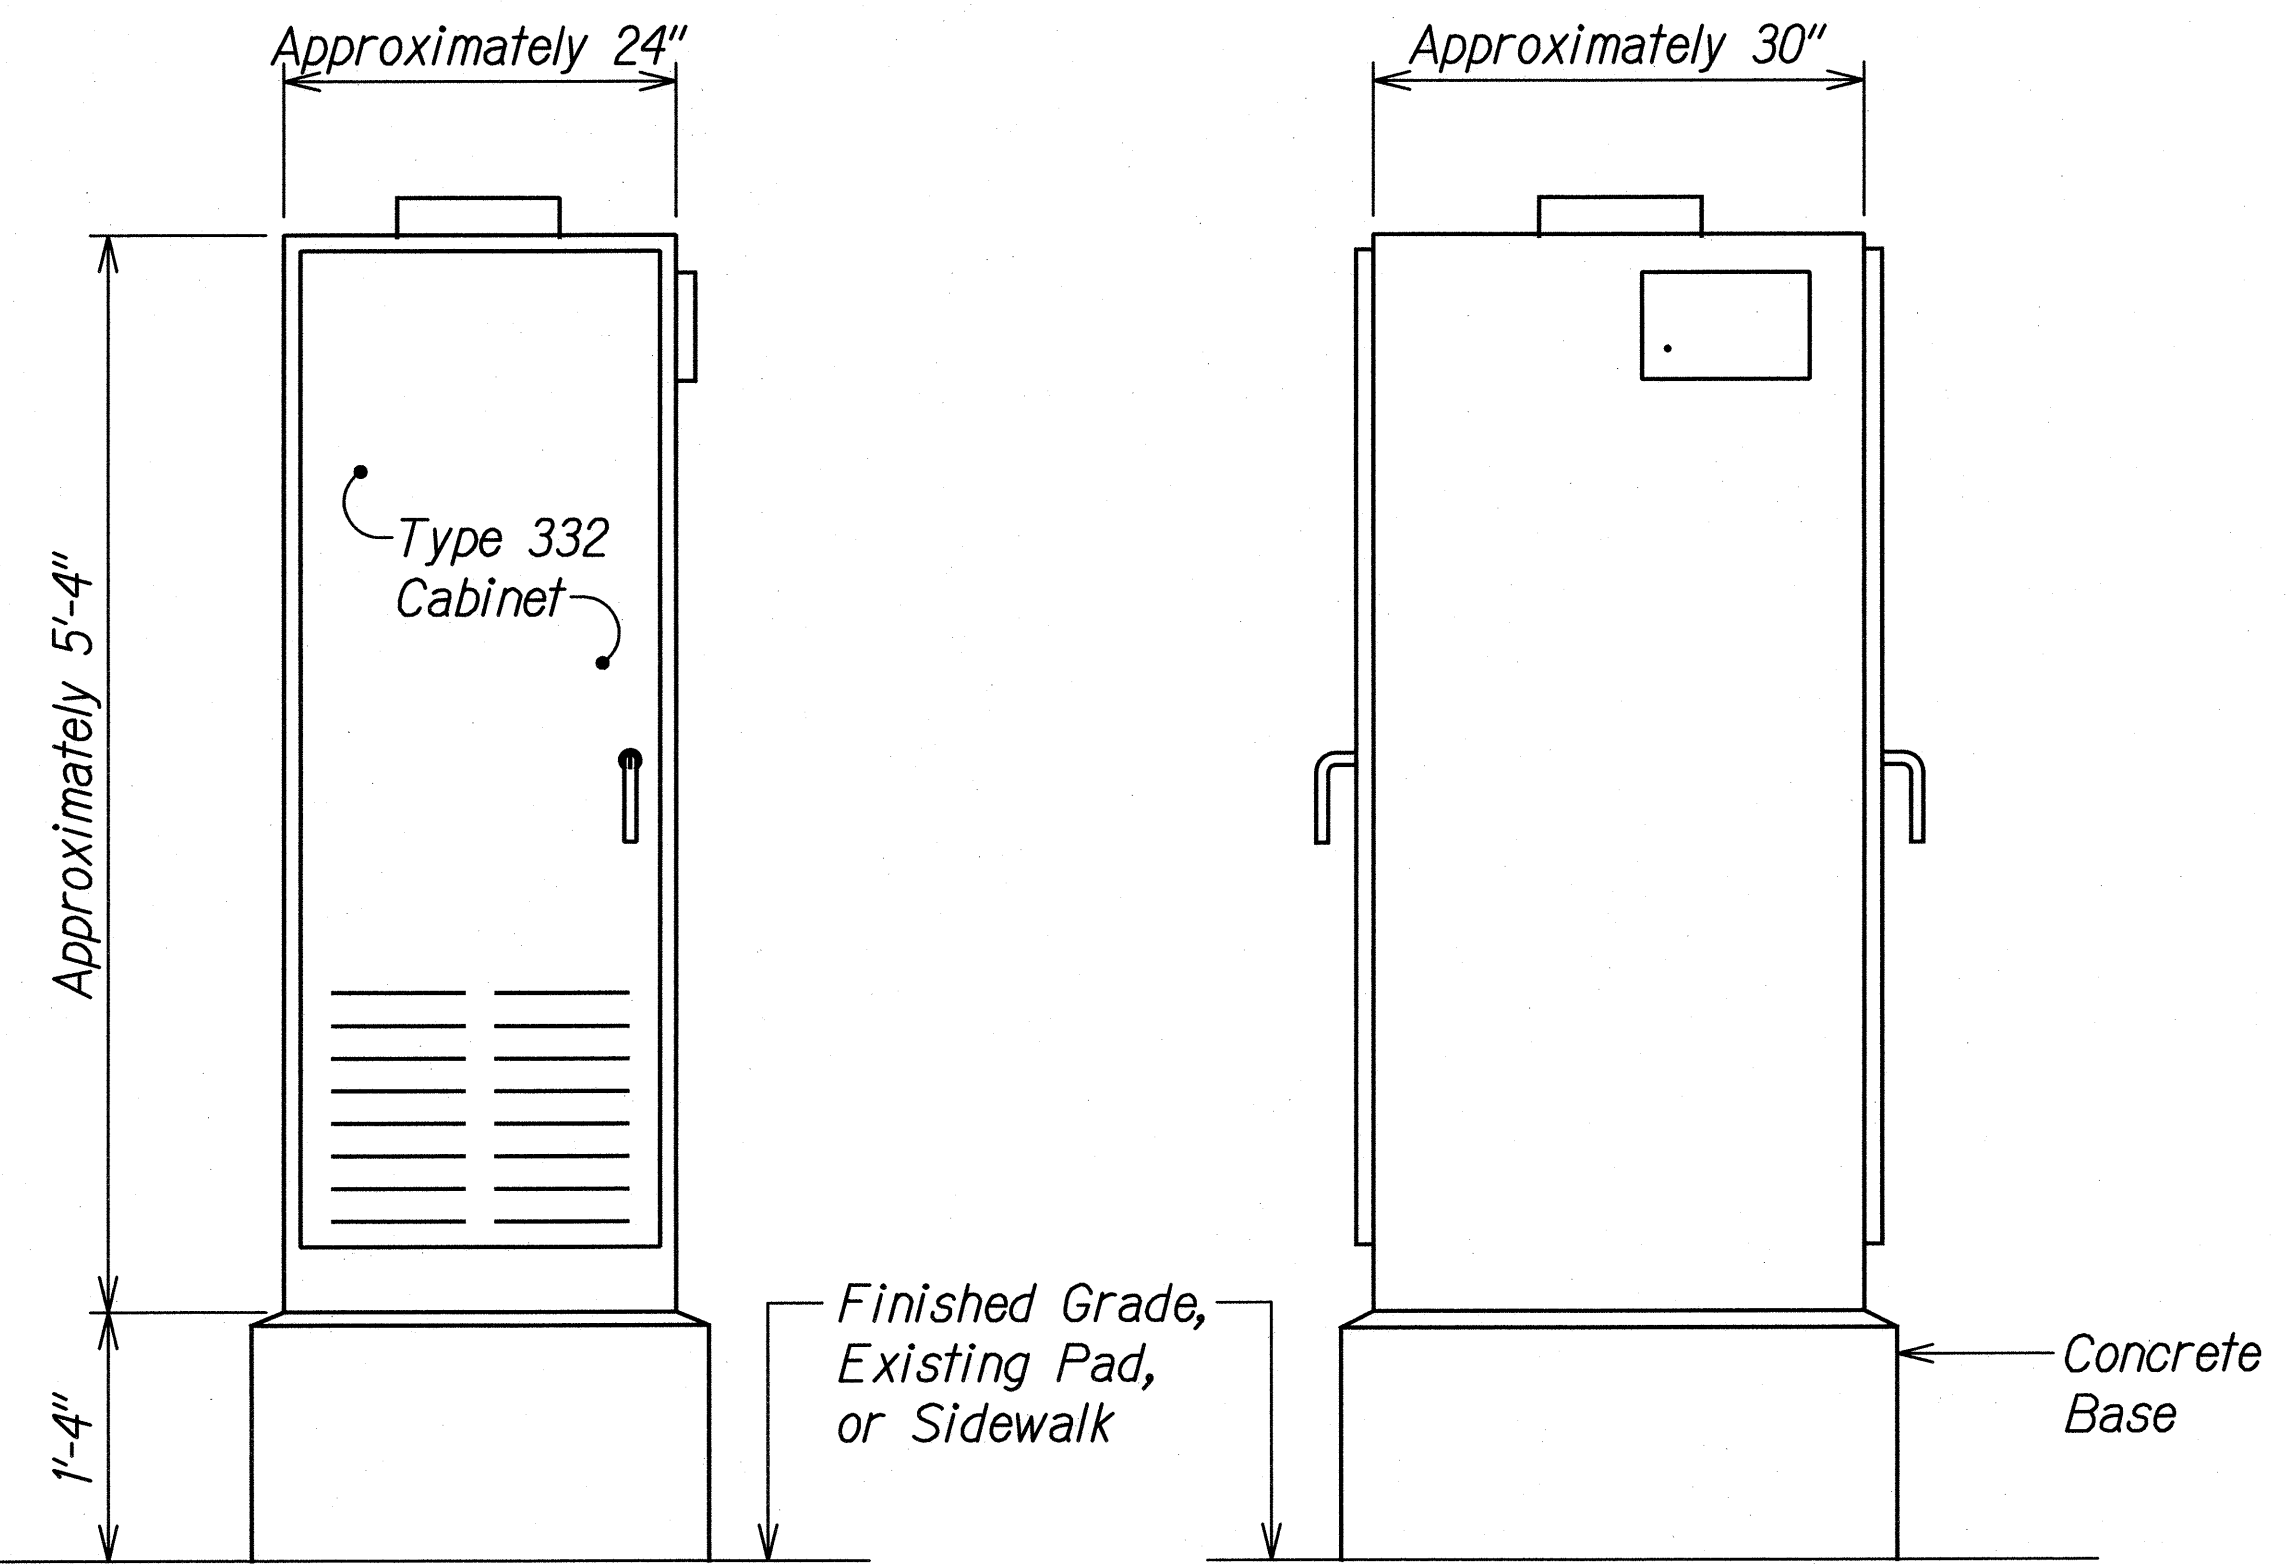

TYPE 332 CCTV EQUIPMENT CABINET
Not to Scale

CONTRACT CHANGE ORDER NO. 18

6/21/17	Added this Sheet
DATE	REVISION

THIS WORK WAS PREPARED BY ME OR UNDER MY SUPERVISION.

Gerald D. Andrade

SIGNATURE EXPIRATION DATE OF THE LICENSE 04/30/18


STATE OF HAWAII
DEPARTMENT OF TRANSPORTATION
HIGHWAYS DIVISION

CCTV DETAILS 1

**FARRINGTON HIGHWAY INTERSECTION IMPROVEMENTS
AT NANAKULI AVENUE AND HALEAKALA AVENUE
Federal-Aid Project No. STP-093-1(22)**


Scale: NTS Date: April 2013

DESIGNED BY	DATE
DRAWN BY	
CHECKED BY	
NOTED BY	
ORIGINAL PLAN	

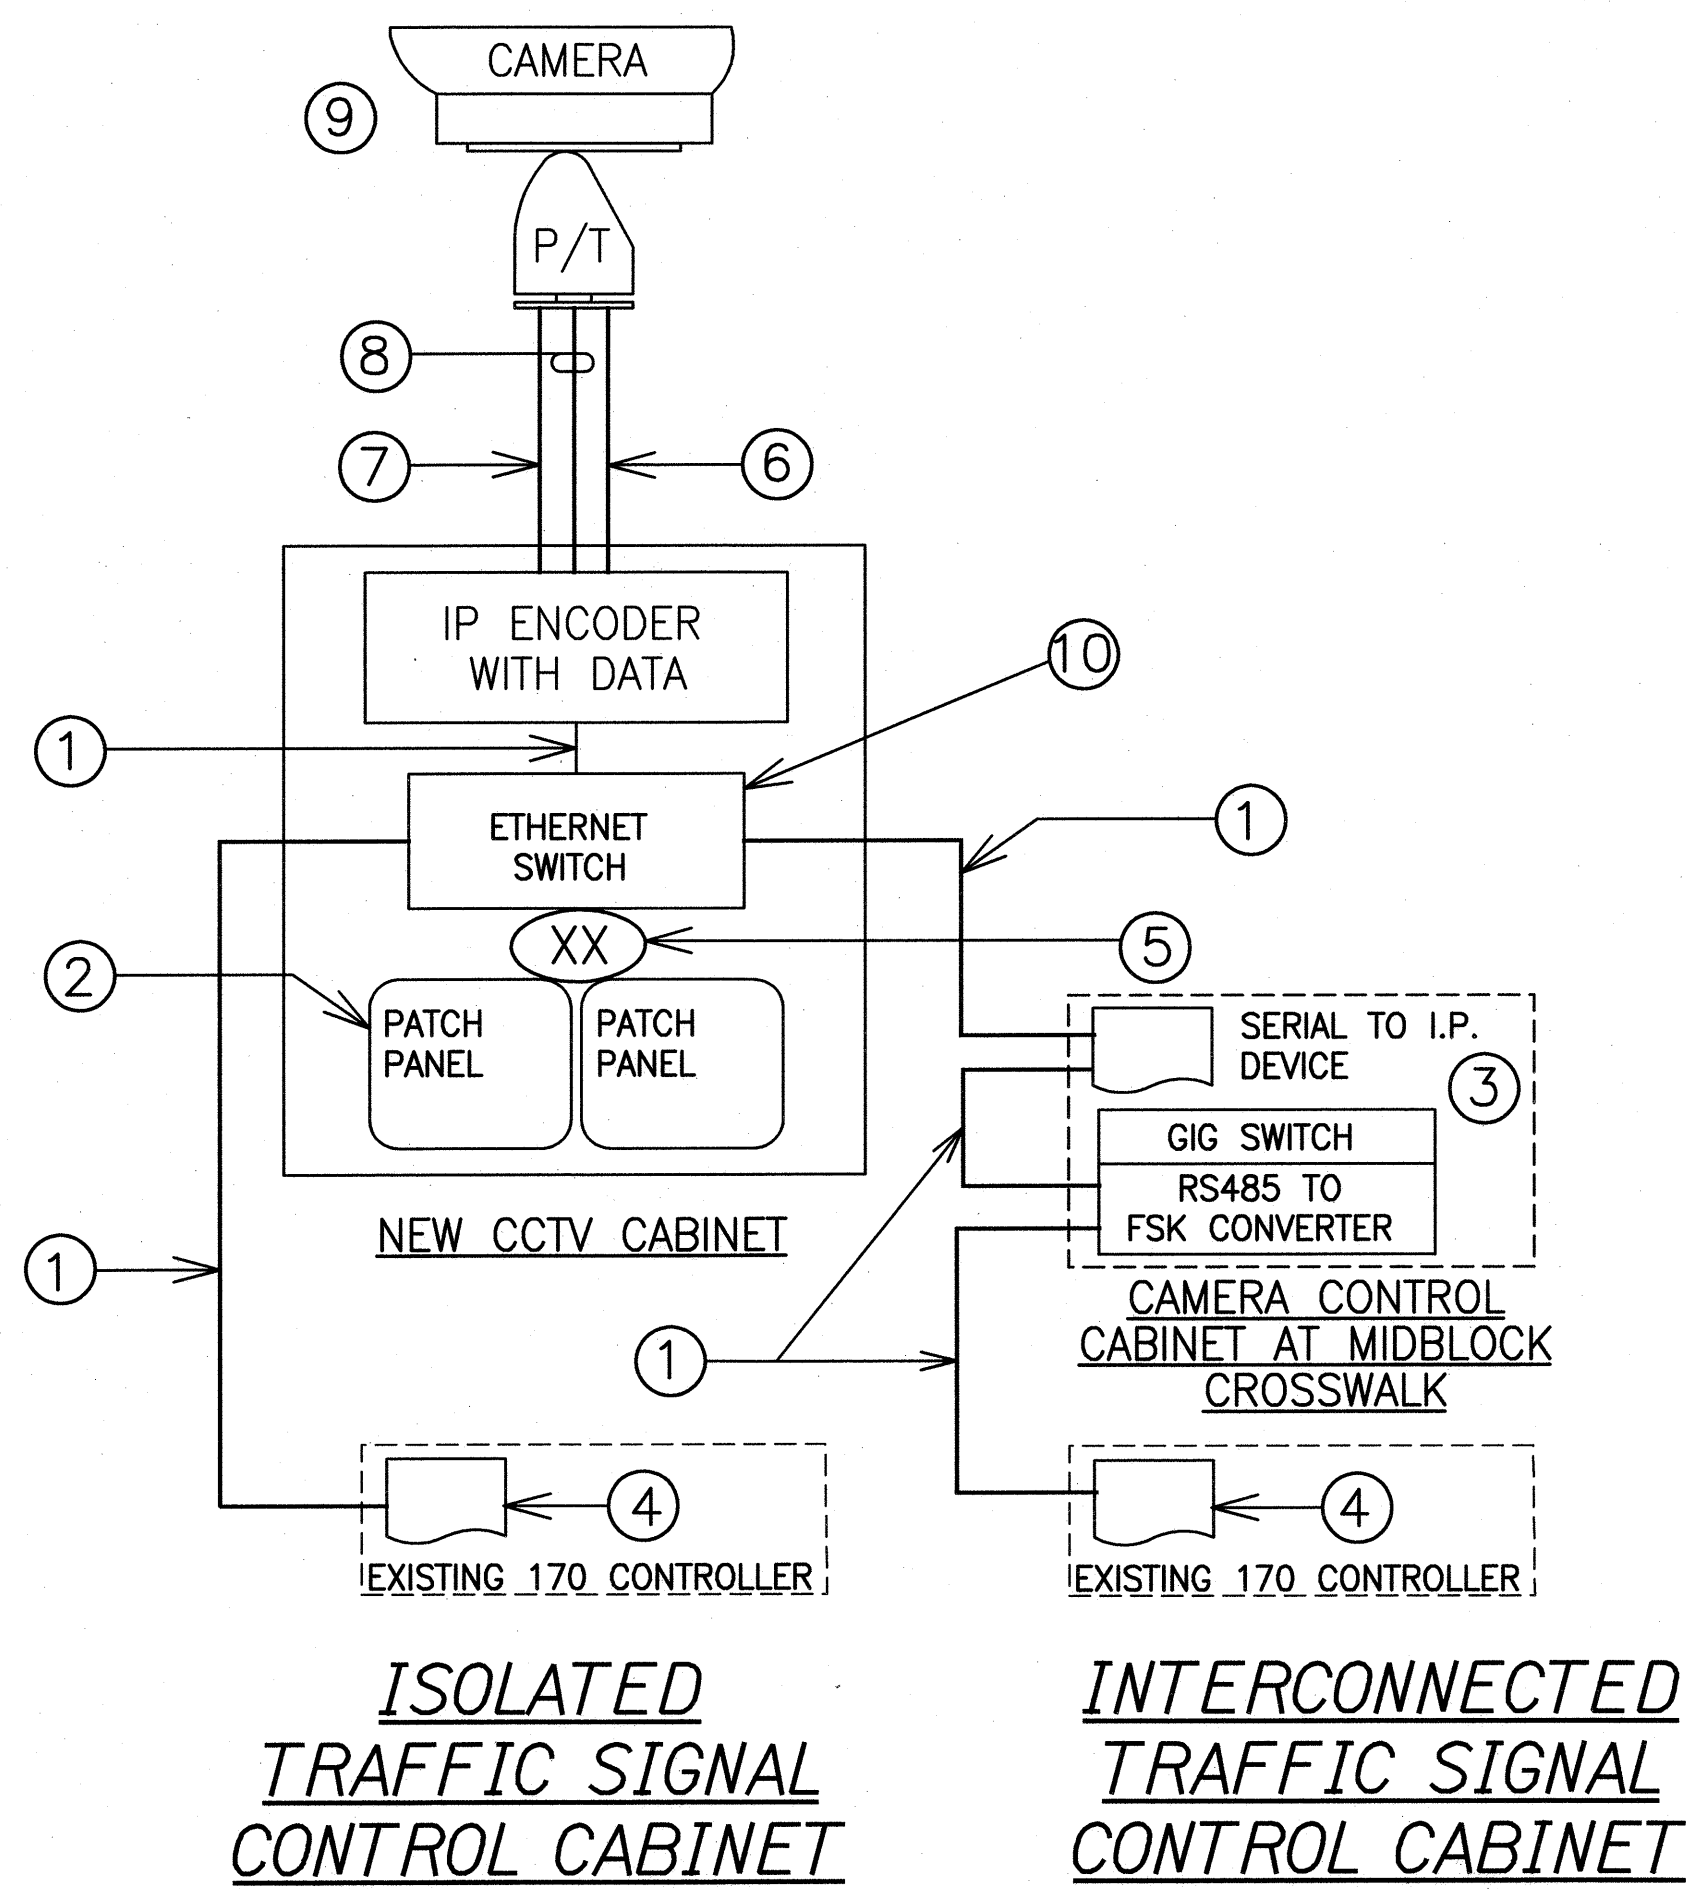

CABINET DEVICE LAYOUT DETAIL
Not to Scale

- ① Category 5e cable.
- ② 72-port patch panels, provide number as shown on system block diagram on sheet TS-8E. Fiber pairs to be terminated and spliced color for color with st connectors to patch panel. Fusion splice connectors to fiber in splice trays, coordinate all splicing with the City Department of Transportation Services.
- ③ Interconnected signals equipment, serial to I.P. device and RS485 to FSK Converter.
- ④ Provide I.P. card for isolated intersection in existing traffic signal controller. Verify requirements with Department of Transportation Services.
- ⑤ Fiber optic cabling and connectors as required. Connection to fiber pair as indicated on system block diagram on sheet TS-8E.
- ⑥ Coaxial cable with sun resistant jacket.
- ⑦ One pair #18 cable for camera controls with sun resistant jacket.
- ⑧ Coaxial camera cable with sun resistant jacket.
- ⑨ CCTV camera with pan/tilt unit.
- ⑩ 10/100 mb hardened switch or hardened gigabit switch as indicated on system block diagram on sheet TS-8E.

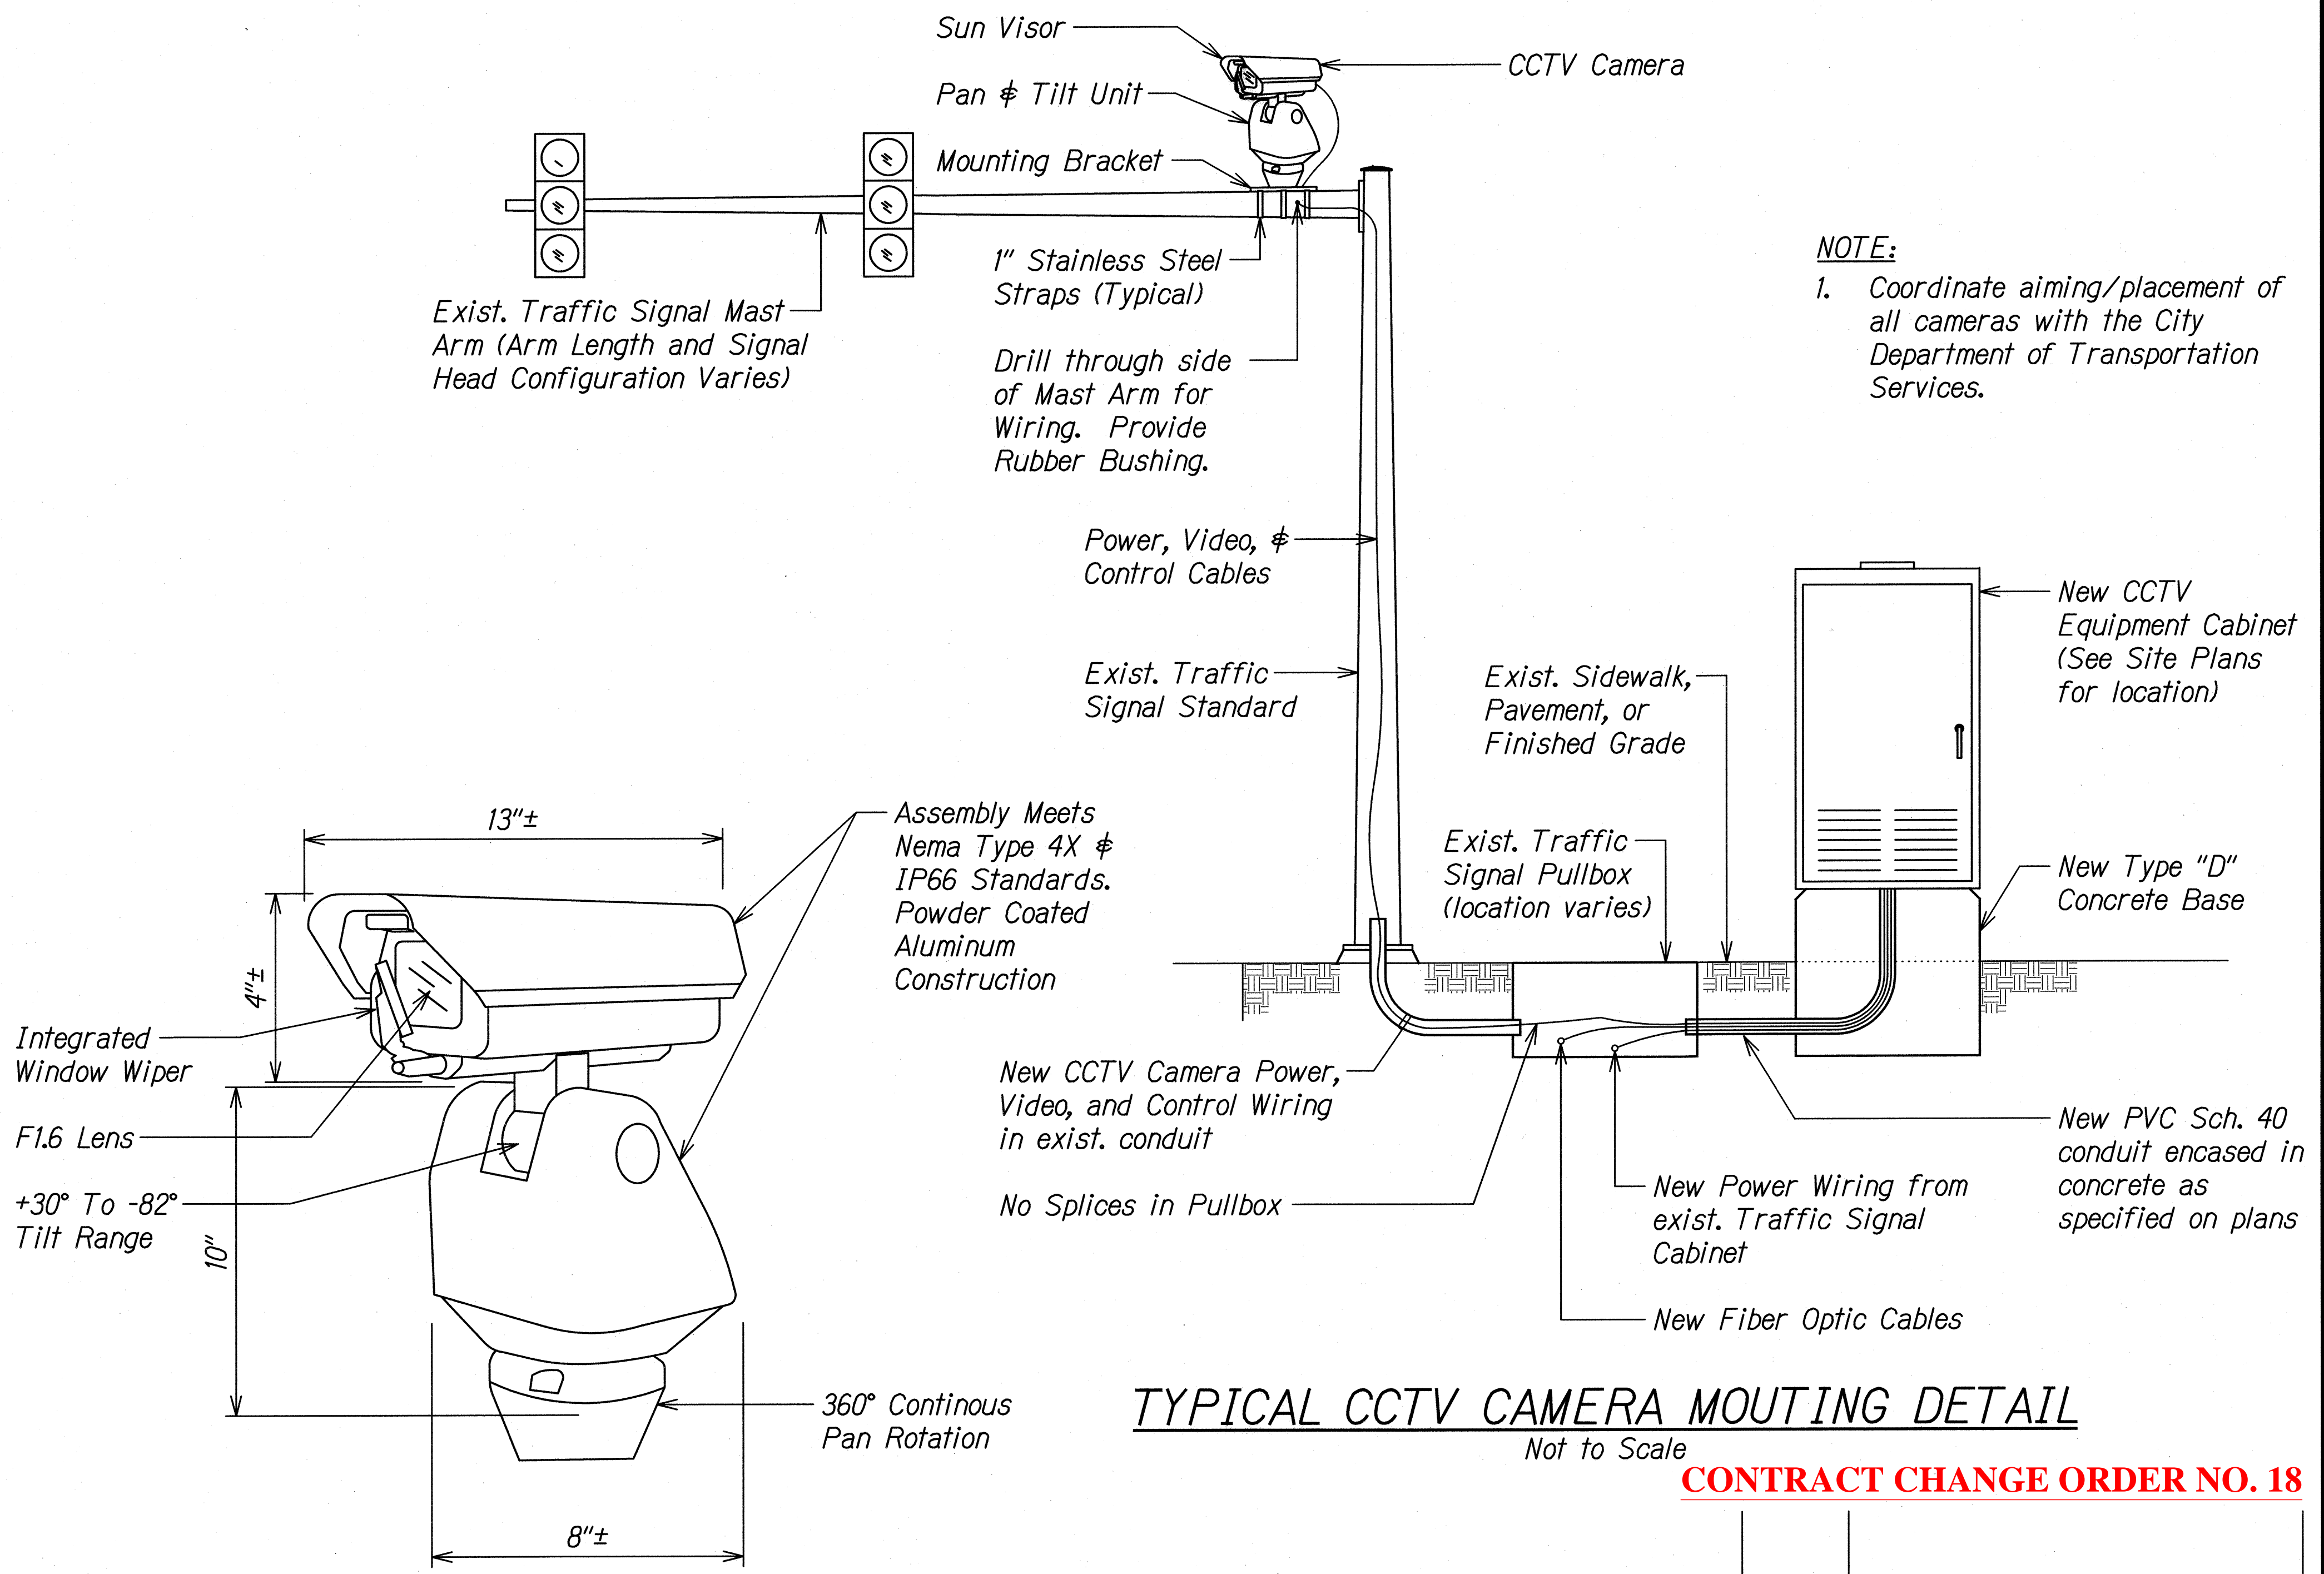

TYPICAL CCTV CAMERA MOUNTING DETAIL
Not to Scale

- NOTES:**
- 1. Digital position and zoom control feedback using "D" protocol.
 - 2. UL listed, rated for full continuous duty, CE Class B.
 - 3. Assembly rated for 90 mph operation.

CAMERA DETAIL
Not to Scale

CONTRACT CHANGE ORDER NO. 18

6/21/17	Added this Sheet
DATE	REVISION

THIS WORK WAS PREPARED BY ME OR UNDER MY SUPERVISION.

Gerald D. Andrade

SIGNATURE

EXPIRATION DATE OF THE LICENSE 04/30/18

STATE OF HAWAII
DEPARTMENT OF TRANSPORTATION
HIGHWAYS DIVISION

CCTV DETAILS 2


FARRINGTON HIGHWAY INTERSECTION IMPROVEMENTS AT NANAKULI AVENUE AND HALEAKALA AVENUE
Federal-Aid Project No. STP-093-1(22)

Scale: NTS Date: April 2013

"AS-BUILT"

C.O. 94S-5

FED. ROAD DIST. NO.	STATE	FEDERAL AID PROJ. NO.	FISCAL YEAR	SHEET NO.	TOTAL SHEETS
HAWAII	HAW.	STP-093-1(22)	2013	C.O. 94S-6	230

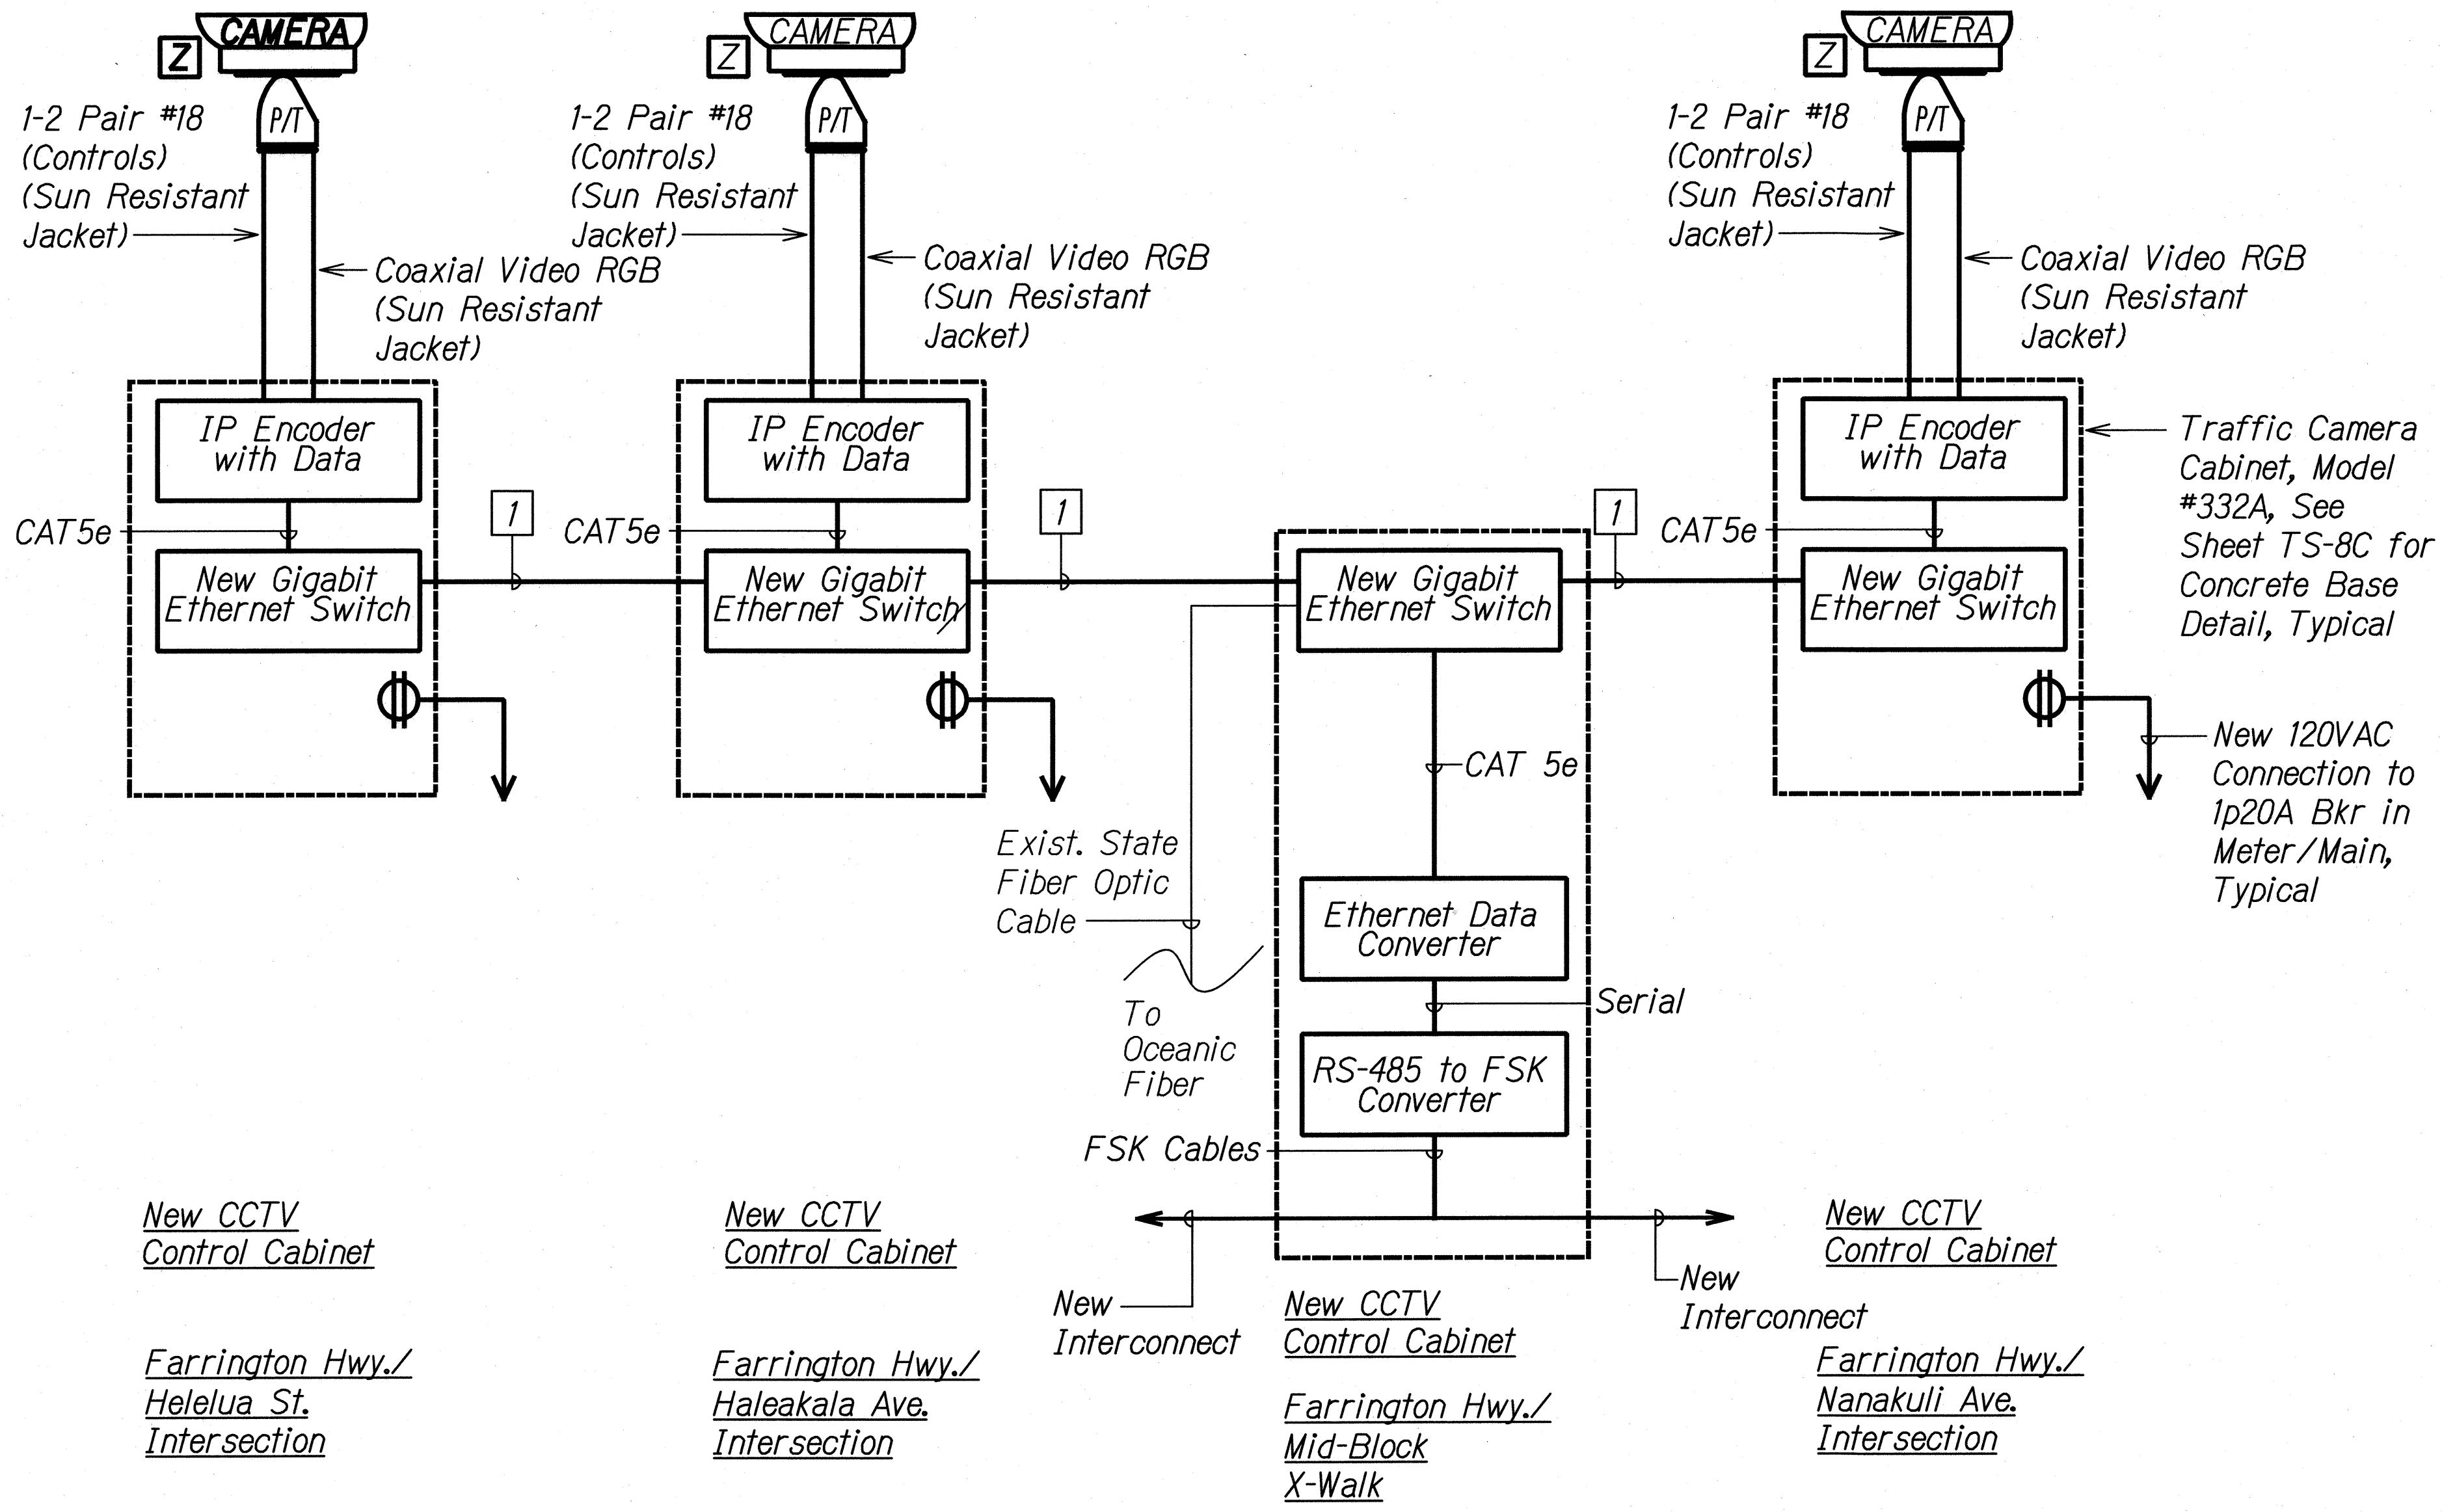

New CCTV Control Cabinet
Farrington Hwy./
Helelua St.
Intersection


New CCTV Control Cabinet
Farrington Hwy./
Haleakala Ave.
Intersection

New CCTV Control Cabinet
Farrington Hwy./
Mid-Block X-Walk

New CCTV Control Cabinet
Farrington Hwy./
Nanakuli Ave.
Intersection

NOTES:

- Light Lines Denote Existing Items.
Bold Lines Denote New Work.
- 1 - Indicates One New 72 Strand Single Mode Fiber Optic Cable, 9/125 Micron Loose-Tube
- Coordinate Interconnection of New CCTV System with the City's Existing Traffic Control System with the City Department of Transportation Services.
- Coordinate all Work at the City's Traffic Management Center with the City Department of Transportation Services.

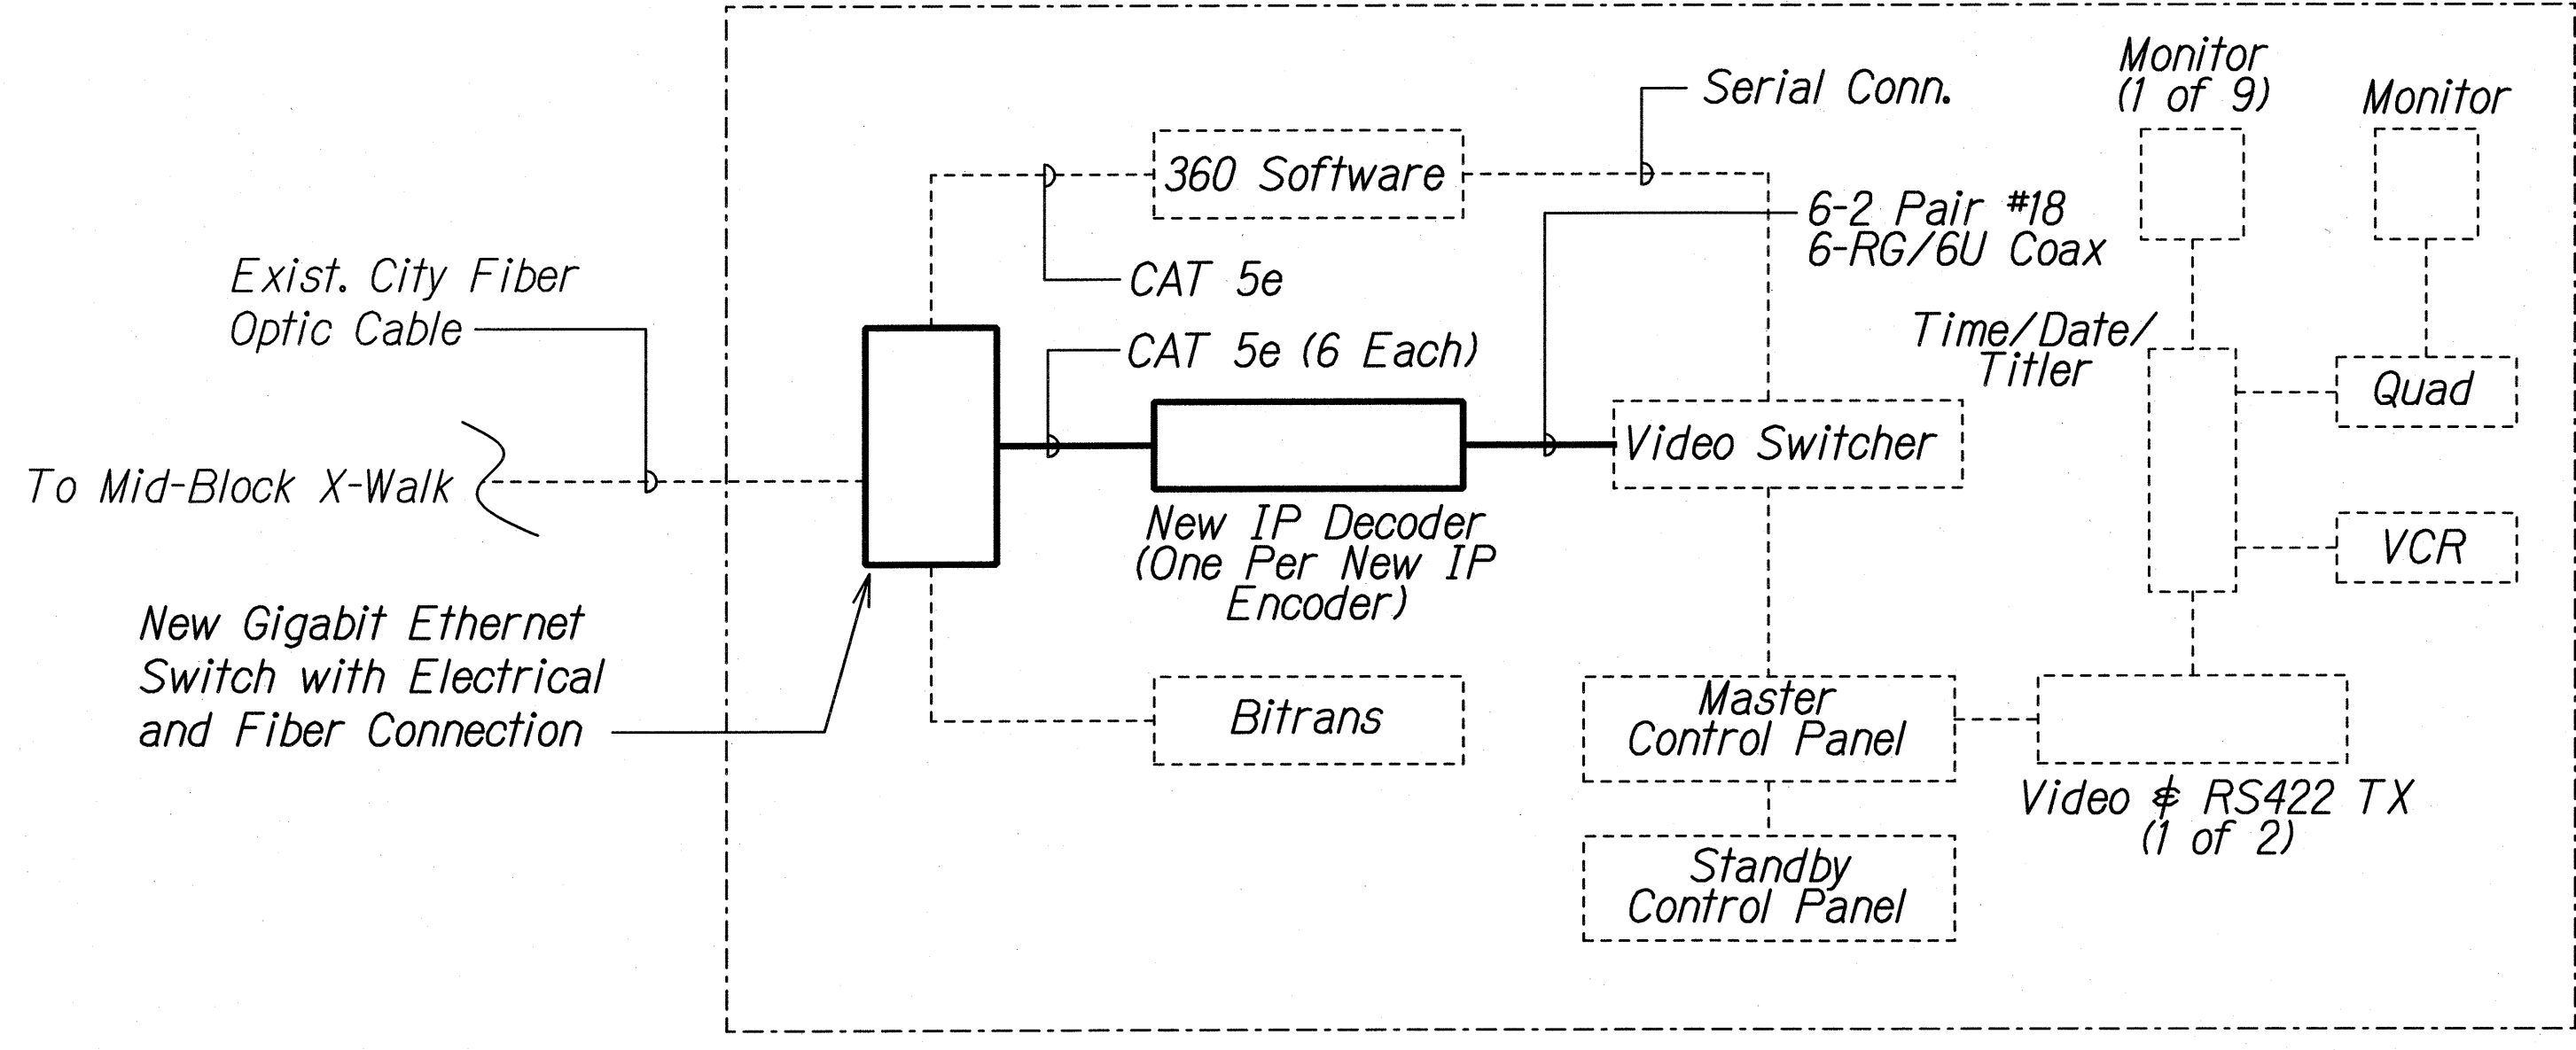

TRAFFIC CAMERA BLOCK DIAGRAM
Not to Scale

CONTRACT CHANGE ORDER NO. 18

6/21/17	Added Sheet
DATE	REVISION

THIS WORK WAS PREPARED BY ME OR UNDER MY SUPERVISION.

SIGNATURE: *Gerald D. Andrade* EXPIRATION DATE OF THE LICENSE: 04/30/18

STATE OF HAWAII
DEPARTMENT OF TRANSPORTATION
HIGHWAYS DIVISION


TRAFFIC CAMERA DIAGRAM

FARRINGTON HIGHWAY INTERSECTION IMPROVEMENTS
AT NANAKULI AVENUE AND HALEAKALA AVENUE
Federal-Aid Project No. STP-093-1(22)

Scale: None Date: April 2013


"AS-BUILT"

C.O. 94S-6

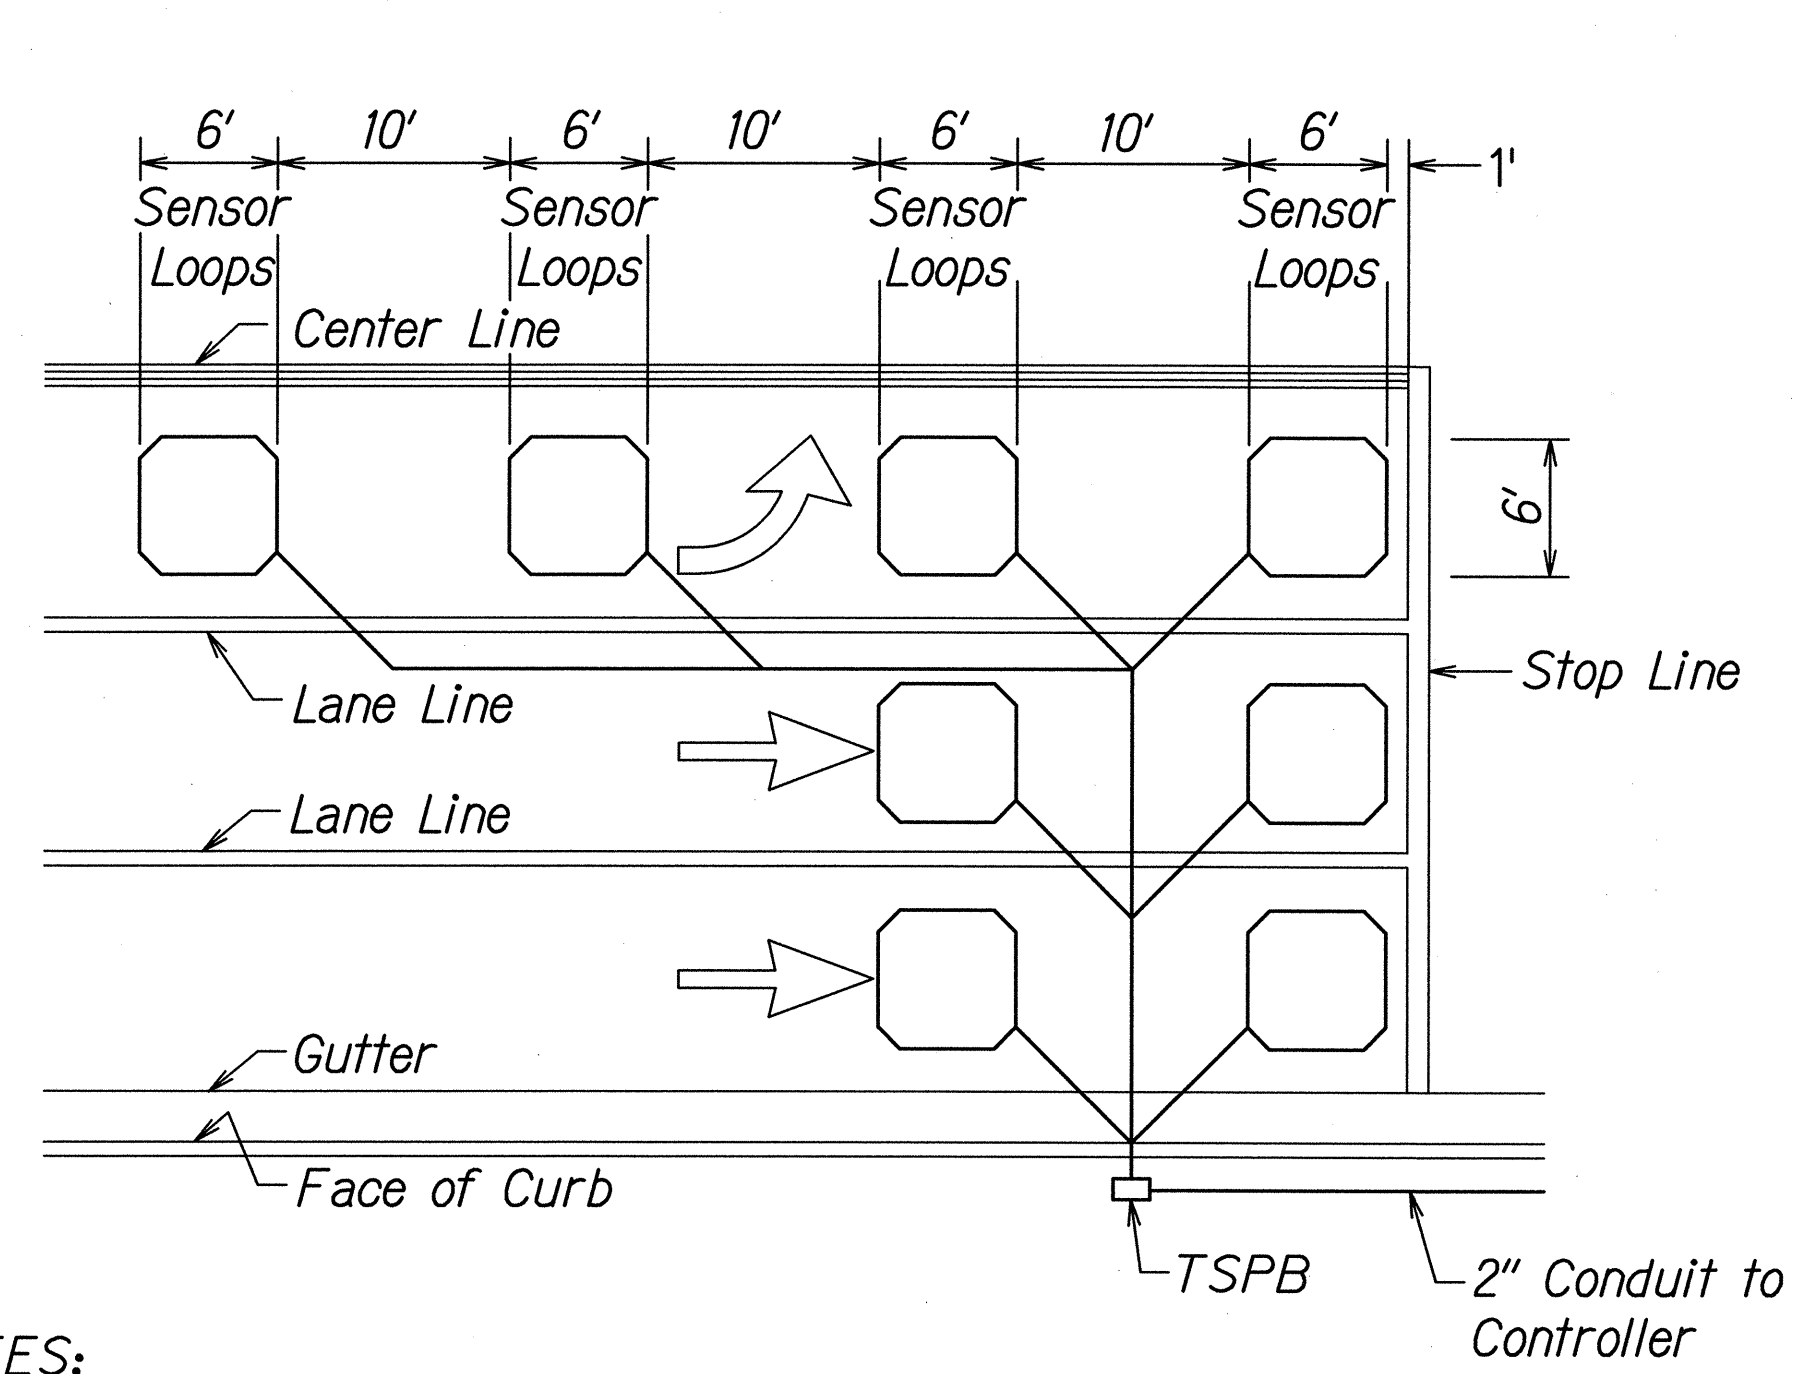


- NOTES:
1. Center sensor loops in lanes.
 2. Collector cables shall be twisted 2 turns per foot.
 3. Number of loops and locations vary. See project plans.
 4. Number and locations of collector sawcuts may be varied in the field to suit.

TYPICAL SENSOR LOOP LAYOUT

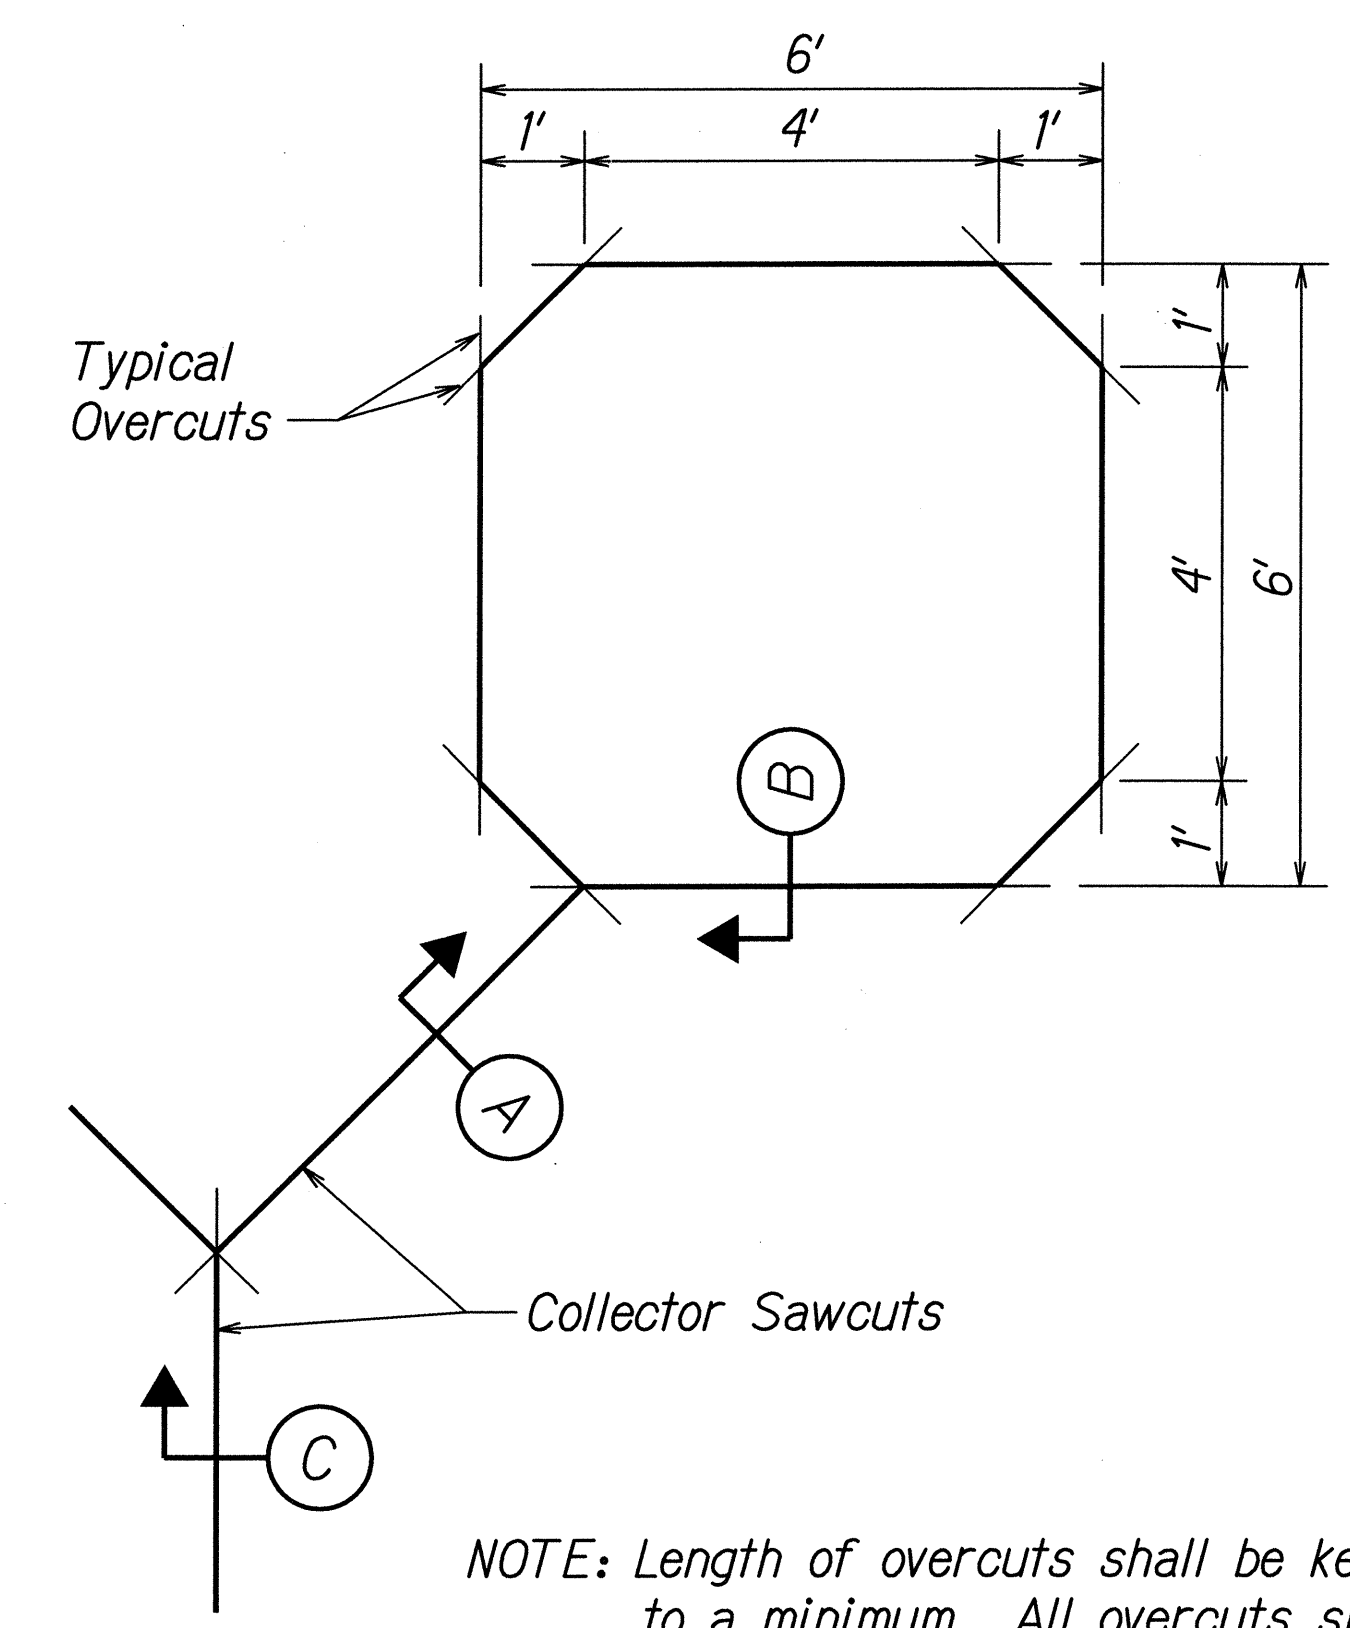


NOTE: Length of overcuts shall be kept to a minimum. All overcuts shall be back filled with hot tar.

TYPICAL SENSOR LOOP SAWCUT DETAIL

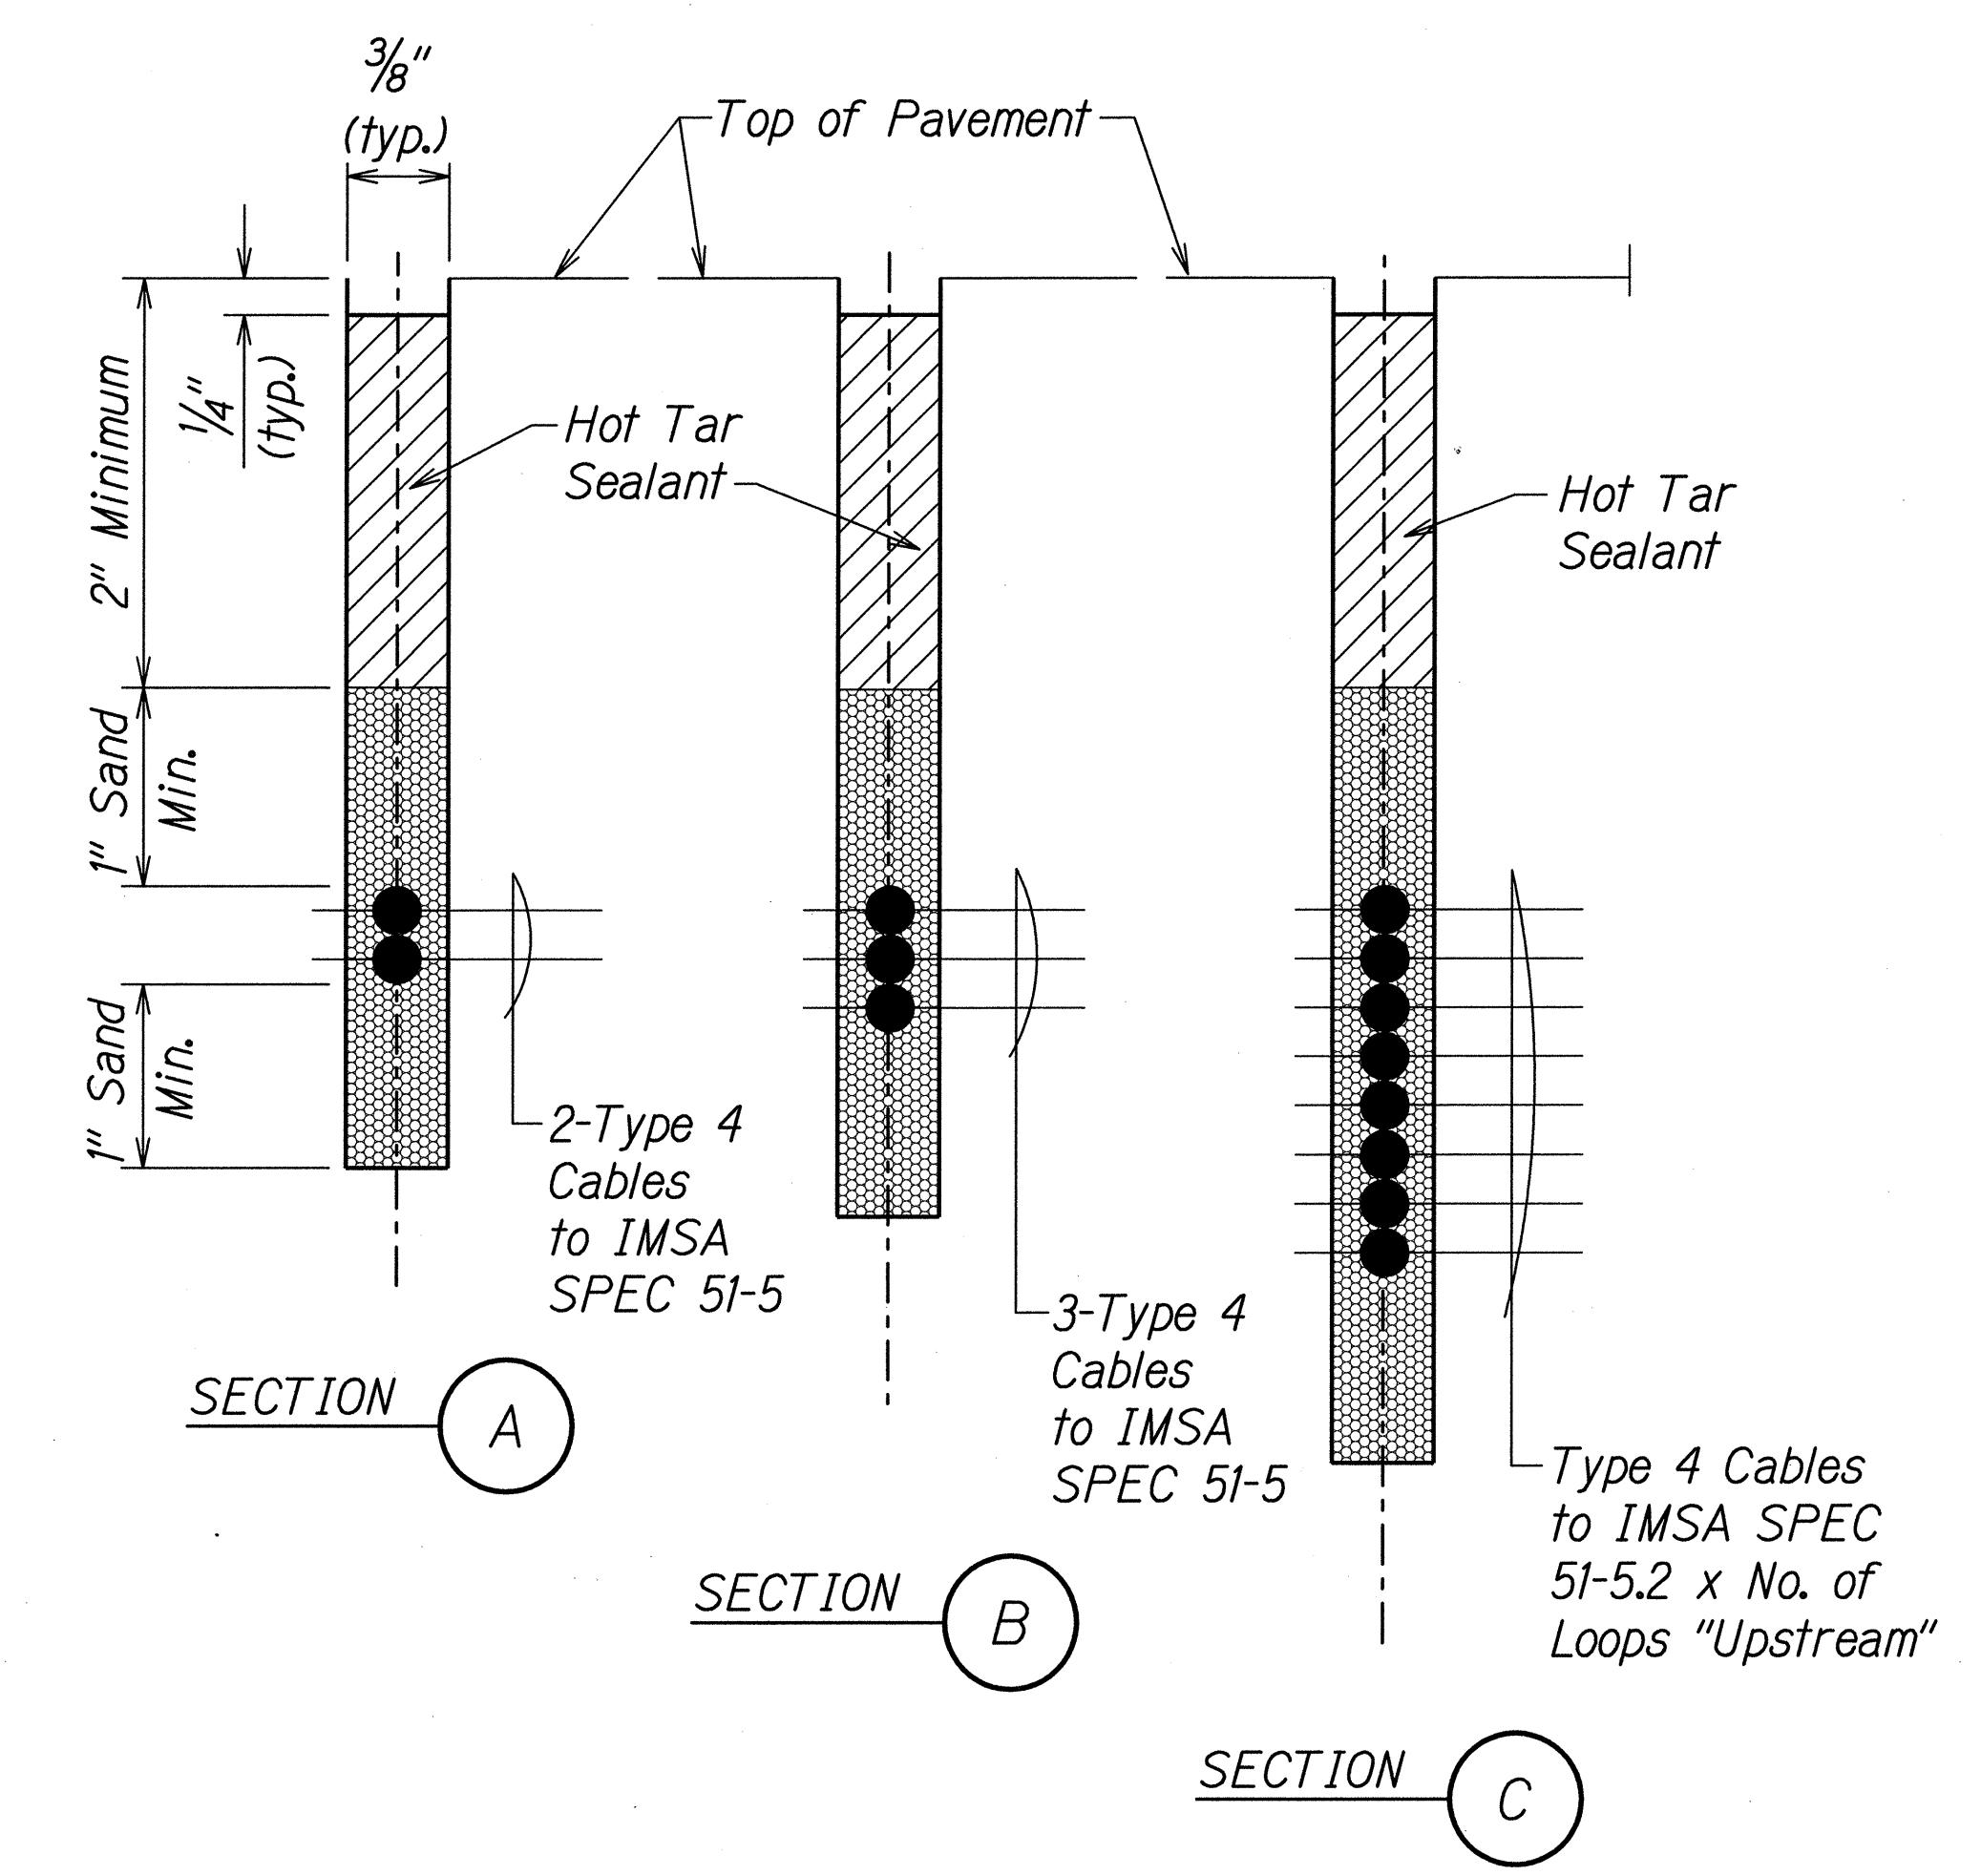


TYPICAL SECTION THROUGH SENSOR LOOP

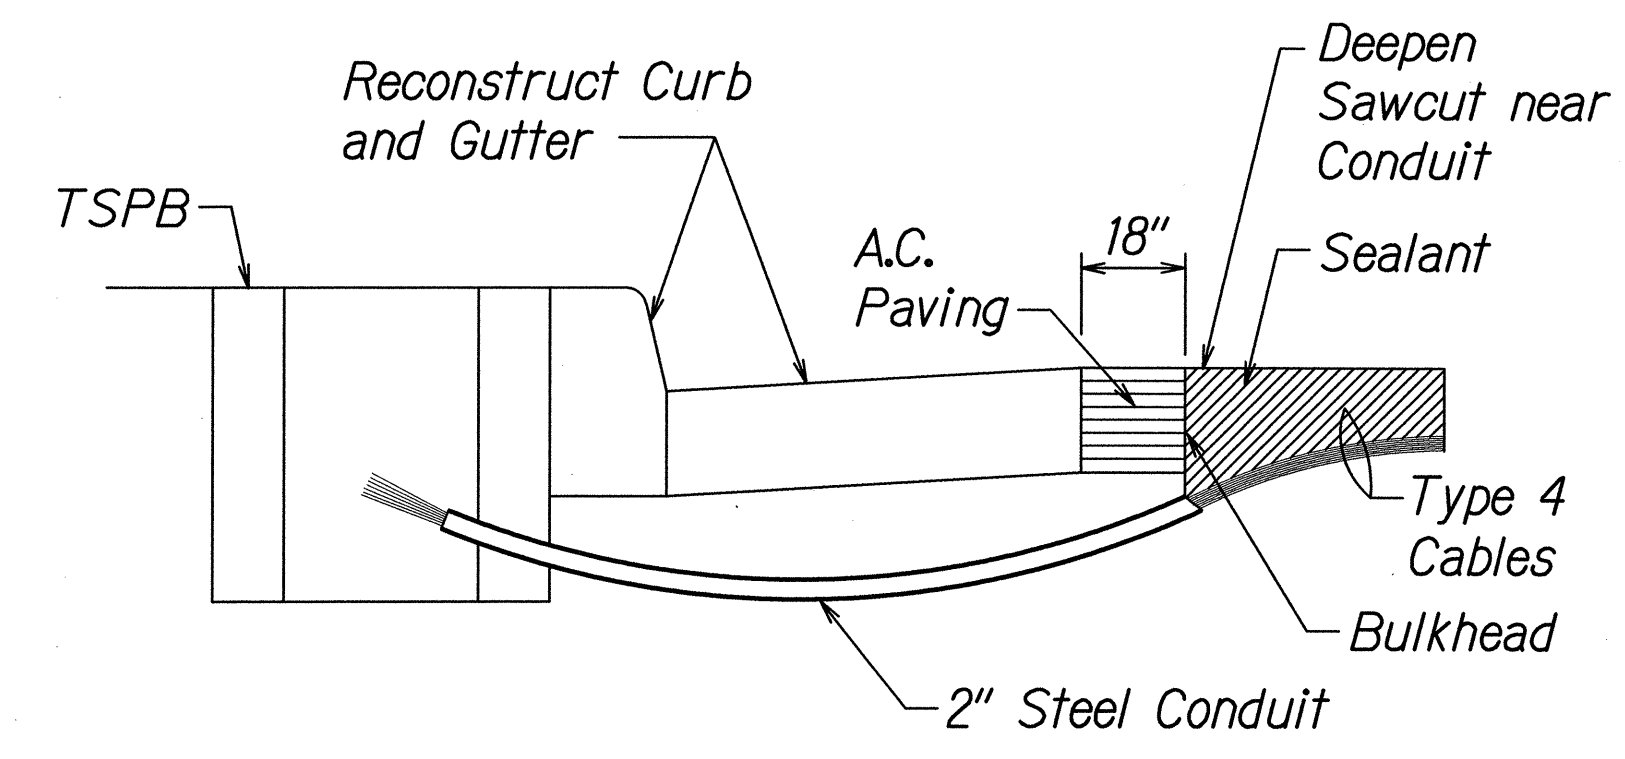

- NOTES ON CONSTRUCTION AT END OF SAWCUT
1. Seal roadway end of conduit after installation of conductors.
 2. Install bulkhead across conduit trench.
 3. Place hot tar in sawcut.
 4. Backfill over conduit with new A.C.
 5. Reconstruct curb and gutter as required.

DETAIL OF SENSOR LOOP INSTALLATION AT EDGE OF ROADWAY

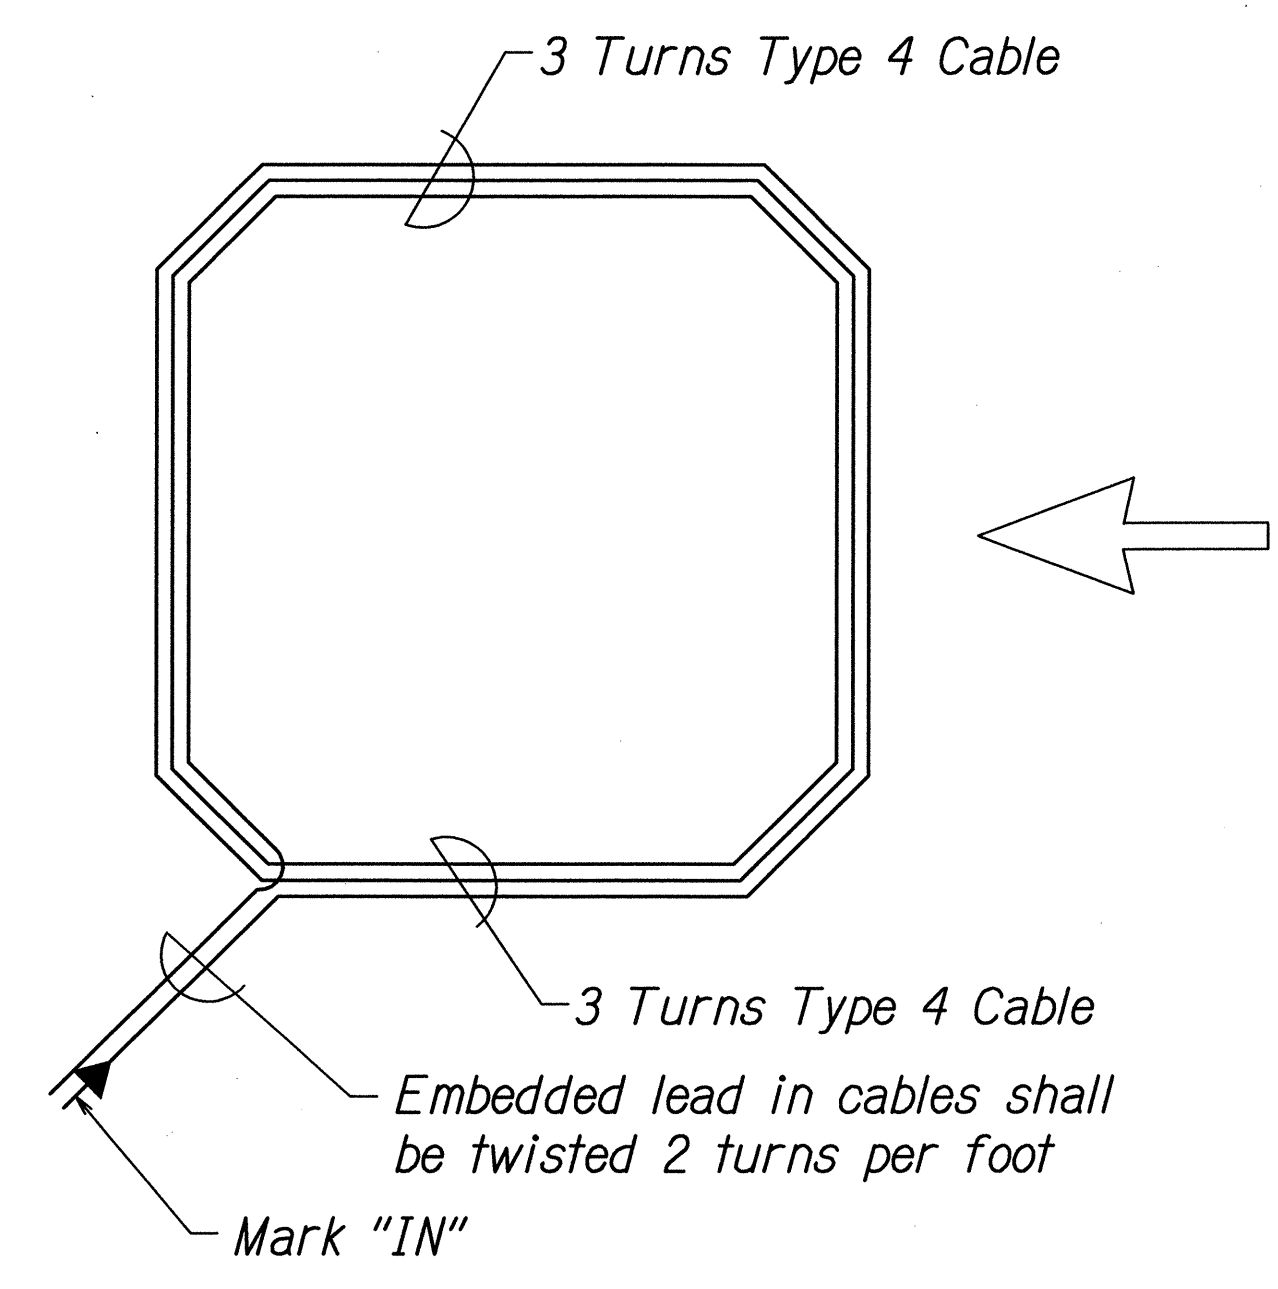

TYPICAL SENSOR LOOP WIRING DIAGRAM

TYPES OF CABLES

- Type 1 Signal Loop Cable: Stranded No. 14, 26 conductors
- Type 2 Detector lead in cable and pedestrian push button circuit cable: Stranded, No. 14, two conductors
- Type 3 Interconnect Cable: Solid No. 19, 12 pairs
- Type 4 Loop Sensor Cable: Solid No. 12, single conductor to IMSA spec. 51-5
- Type 5 Cable from signal loop to signal head: Stranded, No. 14, four conductors
- Type 6 Service Cable: Solid, No. 6, three conductors
- Type 7 Optical Detector Cable: Berktek Type B, Stranded, No. 20, three conductors
- Type 8 Drop Cable: Solid, No. 14, four conductors

THIS WORK WAS PREPARED BY ME OR UNDER MY SUPERVISION.

Signature: *Gerald D. Andrade* Date: 04/30/14

EXPIRATION DATE OF THE LICENSE

STATE OF HAWAII
DEPARTMENT OF TRANSPORTATION
HIGHWAYS DIVISION






LOOP DETECTOR DETAILS

FARRINGTON HIGHWAY INTERSECTION IMPROVEMENTS
AT NANAKULI AVENUE AND HALEAKALA AVENUE
Federal-Aid Project No. STP-093-1(22)

Scale: None Date: April 2013


SHEET No. TS-10 OF 13 SHEETS

FED. ROAD DIST. NO.	STATE	FEDERAL AID PROJ. NO.	FISCAL YEAR	SHEET NO.	TOTAL SHEETS
HAWAII	HAW.	STP-093-I(22)	2013	97	230

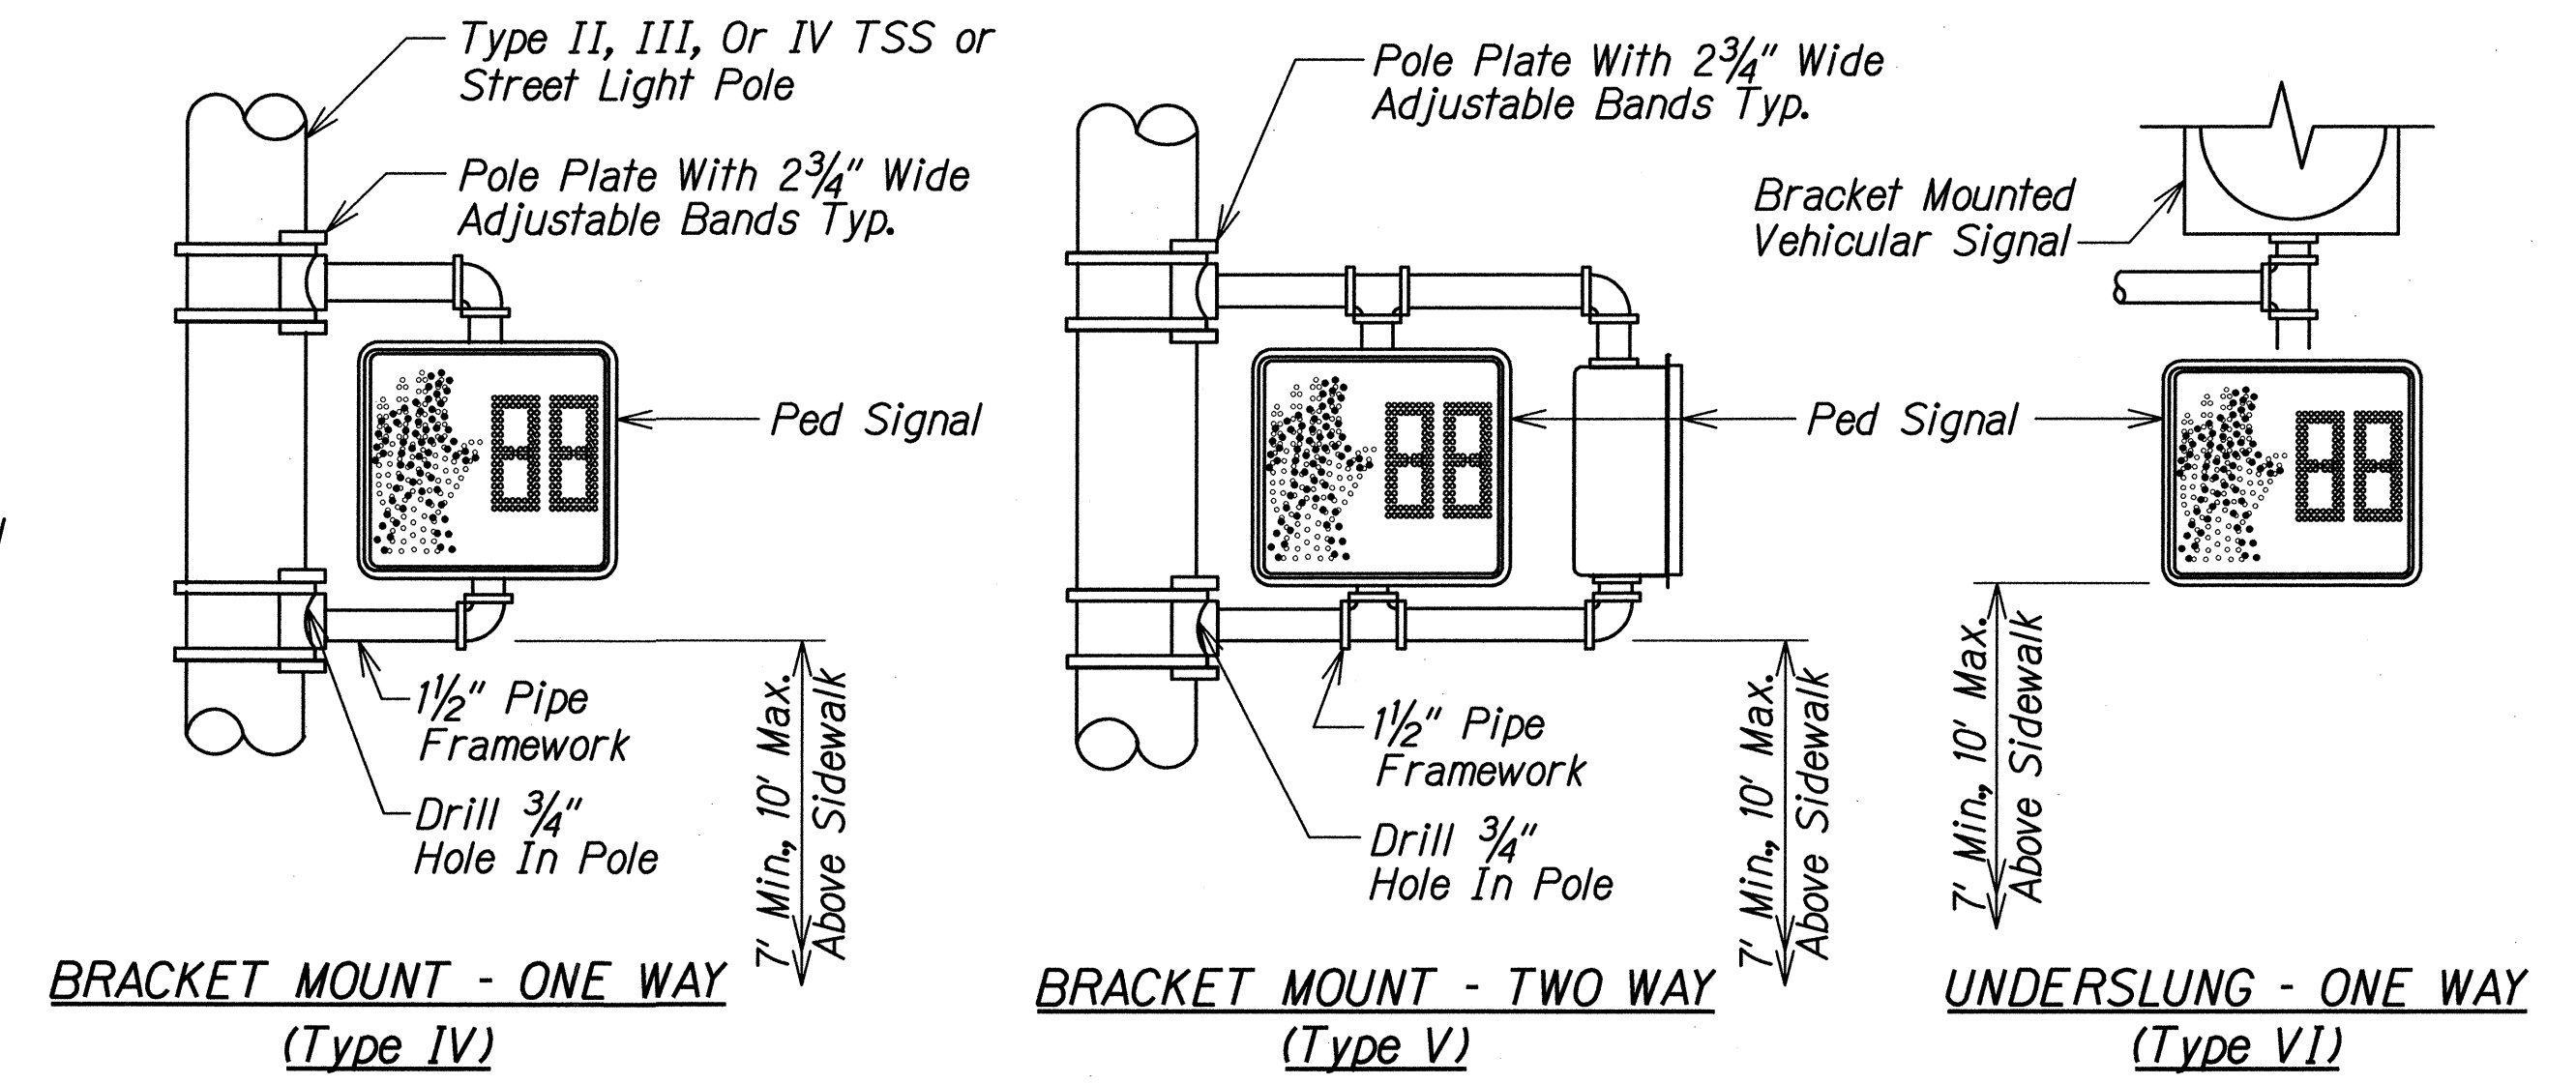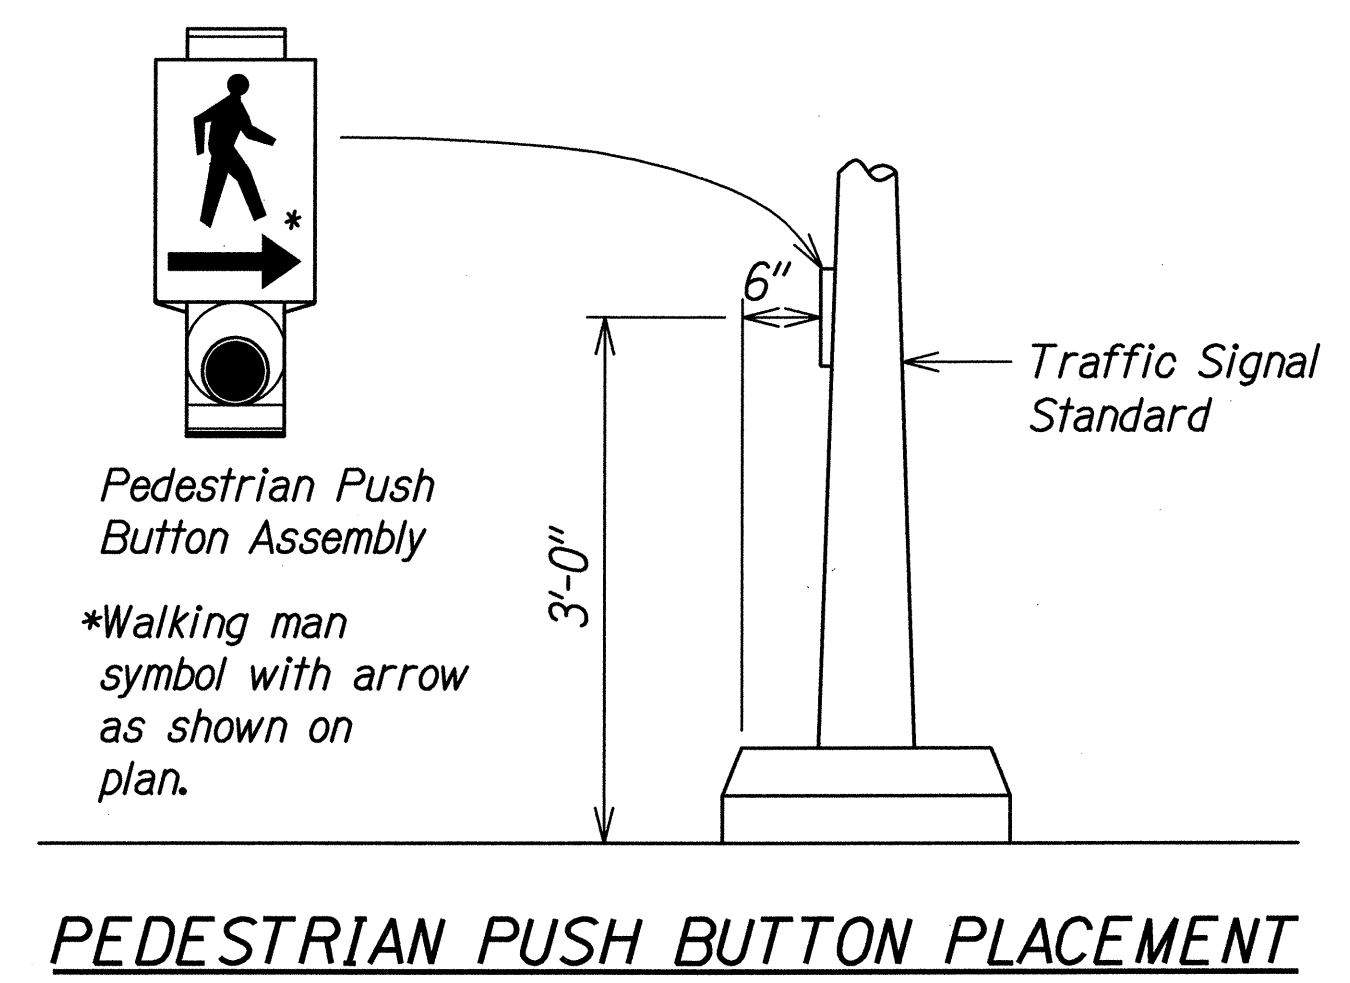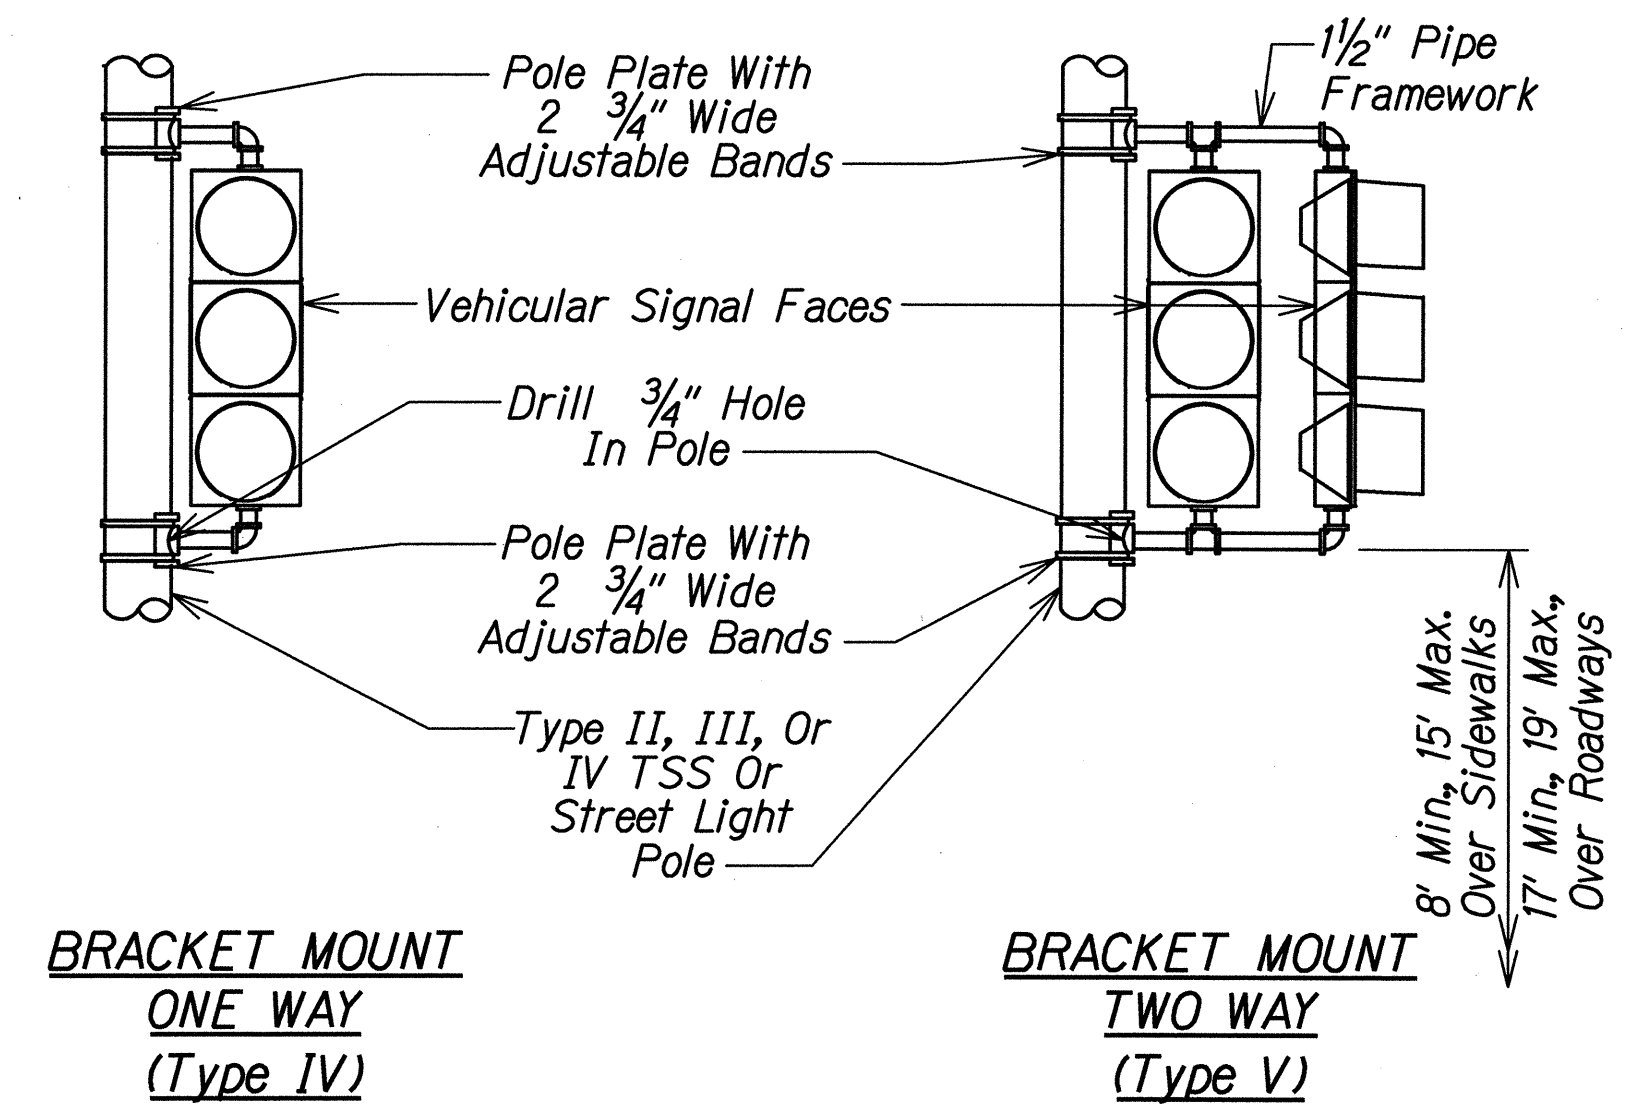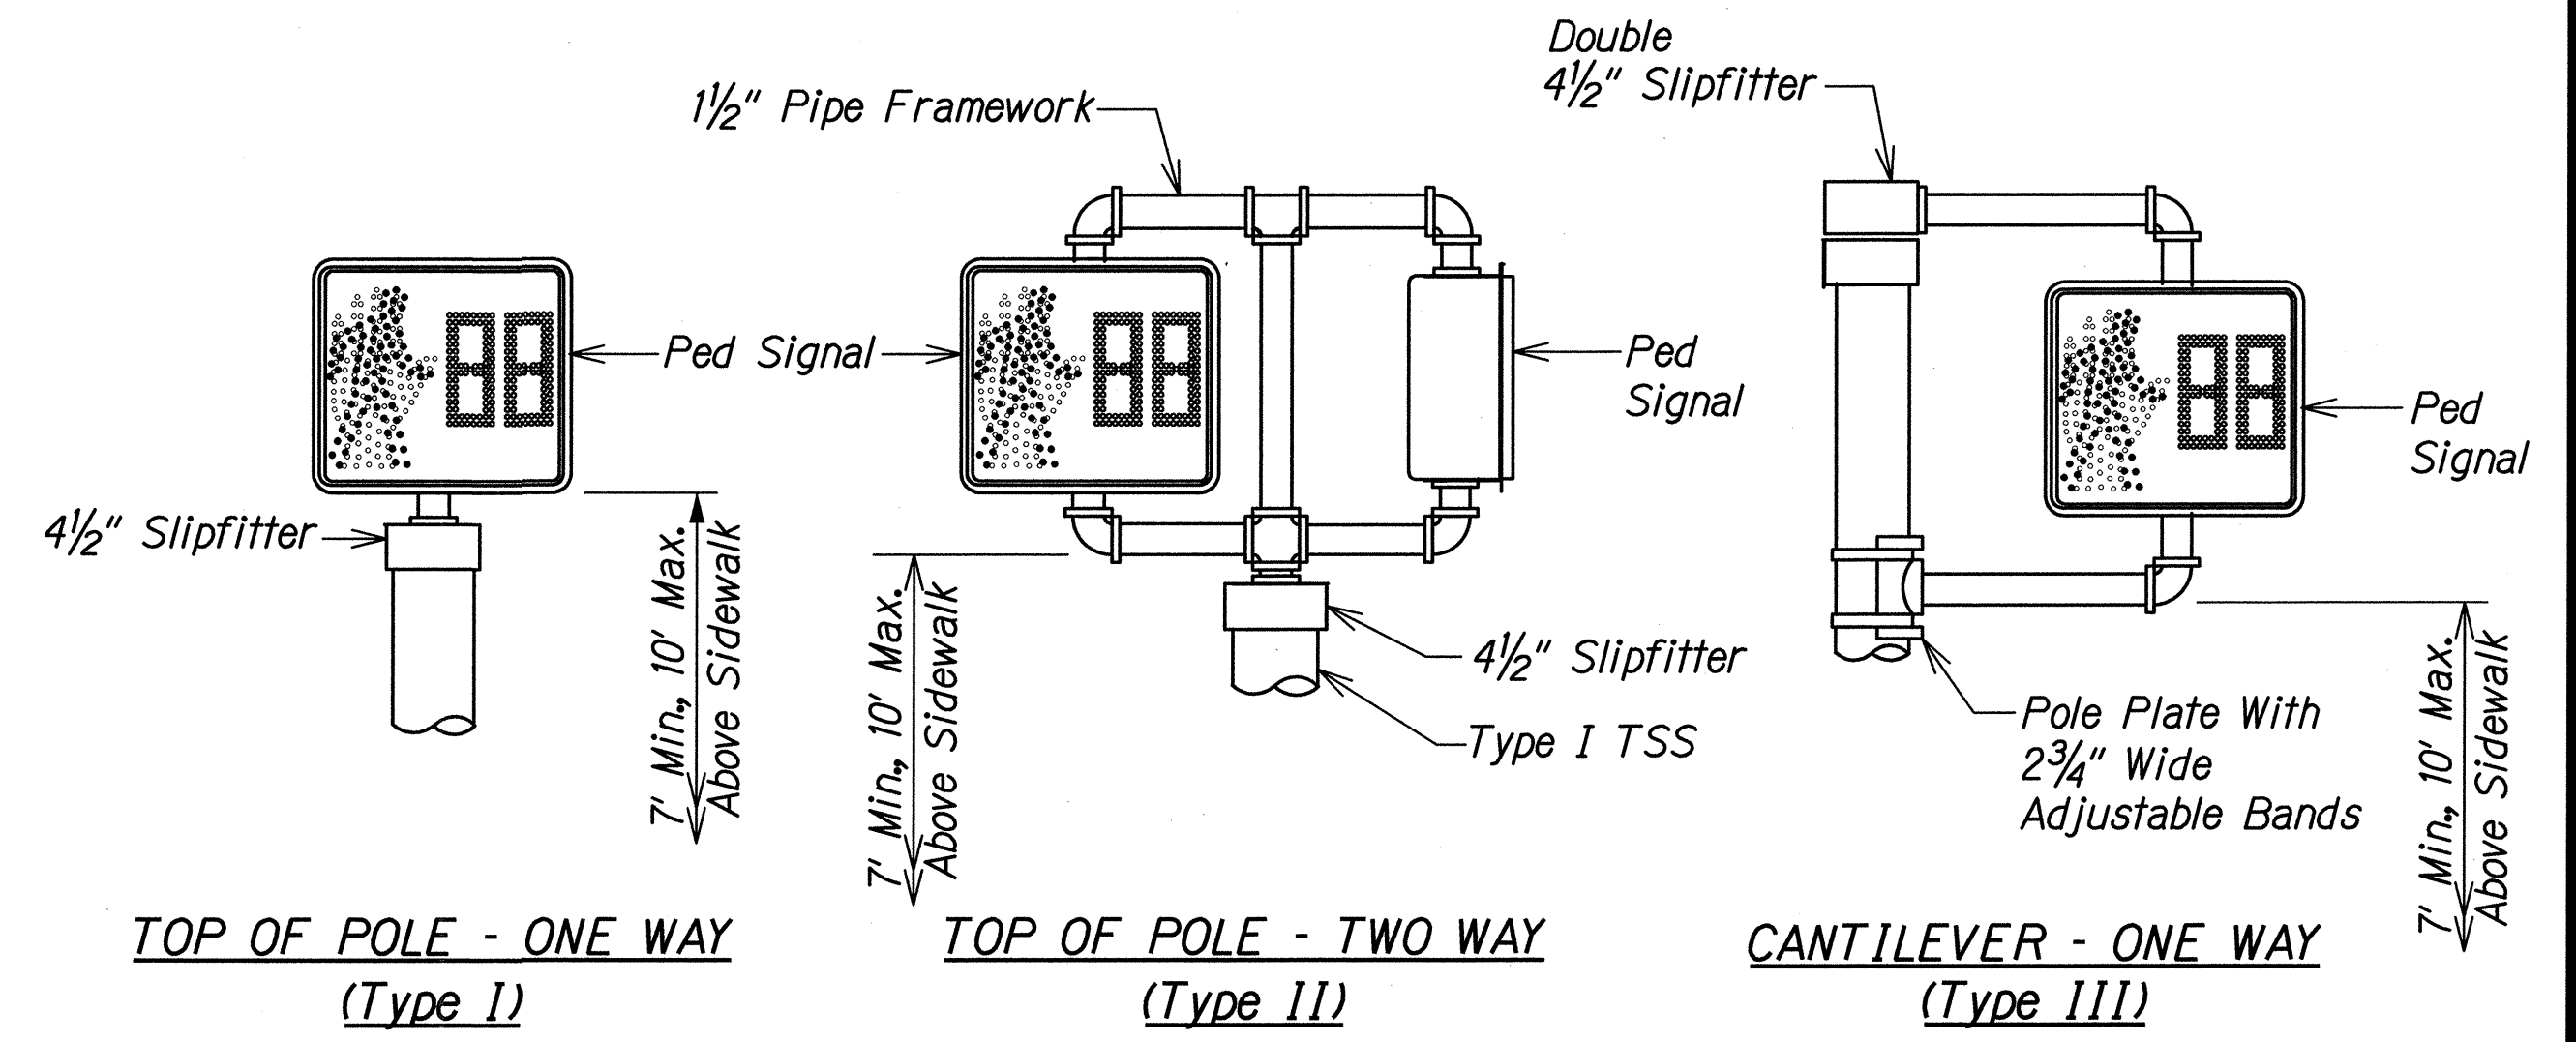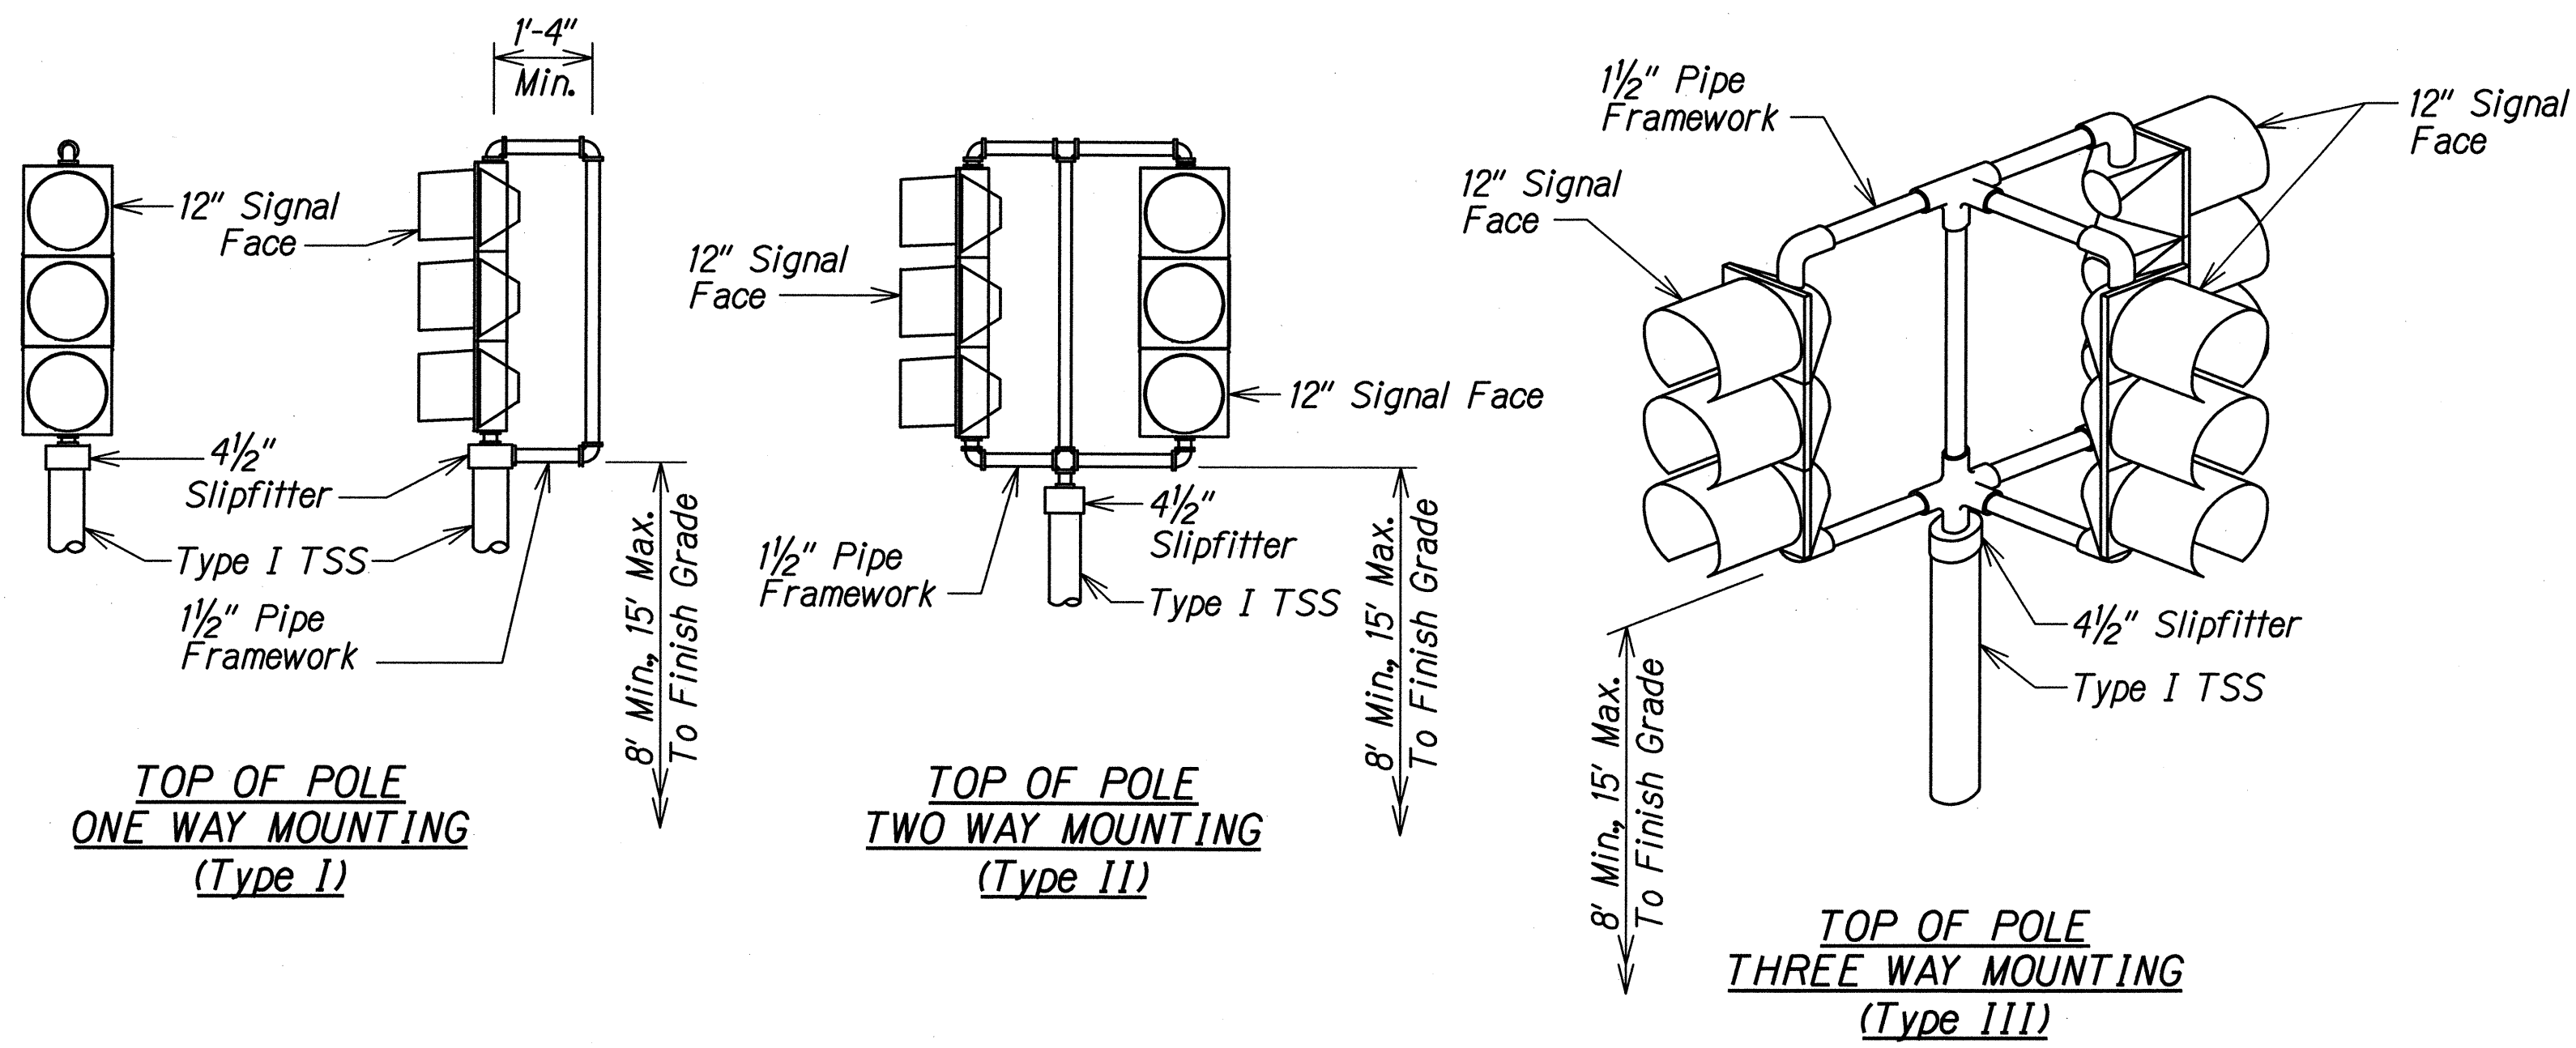


PEDESTRIAN SIGNAL MOUNTINGS

- NOTES:**
1. Stainless Steel Bands shall be 1/2" Wide X .050" thick, minimum. Tensile strength shall be 100,000 PSI minimum.
 2. Upper Arm, Lower Arm And Vertical Support Tube shall be of 356 Cast Aluminum.
 3. All Wiring Shall Be Concealed.
 4. Vertical Tube Clamp shall be of Malleable Iron, Grade 32510.
 5. All Aluminum Parts shall have an Alodine 1200 finish.

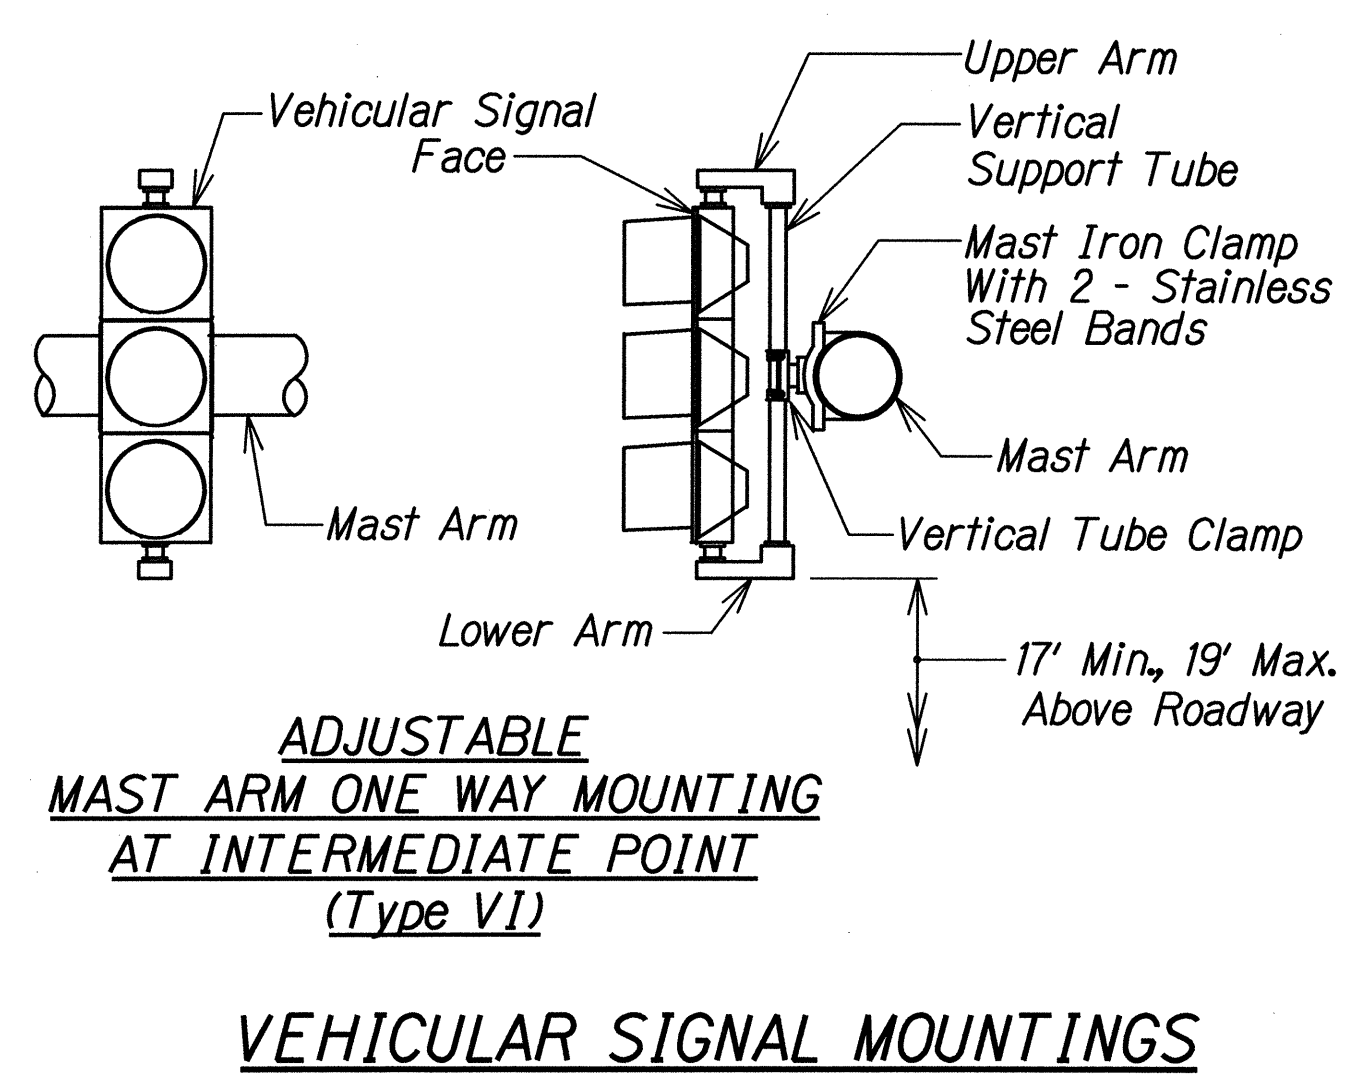

VEHICULAR SIGNAL MOUNTINGS

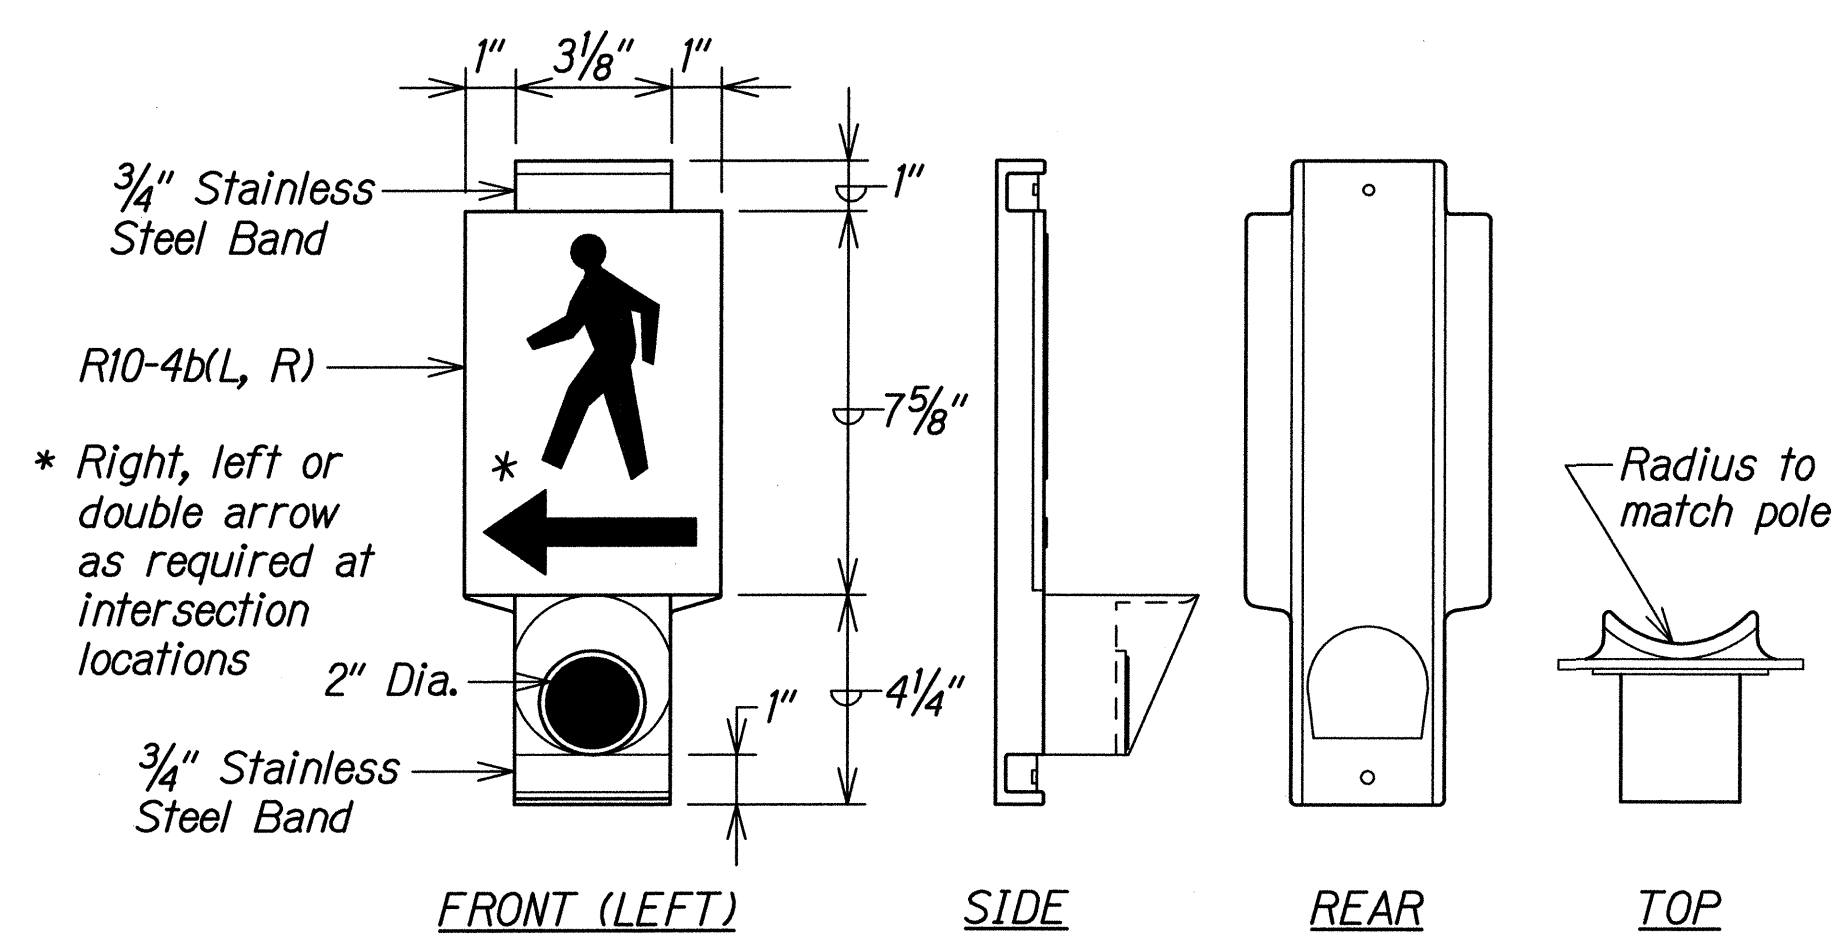

STATE OF HAWAII
DEPARTMENT OF TRANSPORTATION
HIGHWAYS DIVISION

**TRAFFIC SIGNAL PLAN
MOUNTING BRACKET DETAILS**

FARRINGTON HIGHWAY INTERSECTION IMPROVEMENTS
AT NANAKULI AVENUE AND HALEAKALA AVENUE
Federal-Aid Project No. STP-093-I(22)


Scale: None Date: April 2013

SHEET No. TS-II OF 13 SHEETS

FED. ROAD DIST. NO.	STATE	FEDERAL AID PROJ. NO.	FISCAL YEAR	SHEET NO.	TOTAL SHEETS
HAWAII	HAW.	STP-093-1(22)	2013	98	230


GENERAL NOTES

1. Provide a minimum of one 16 ϕ x 2.5m Copperweld Ground Rod in each pullbox. When directed by the Traffic Signal Inspector/Engineer, install additional Ground Rods. Cost of Ground Rods shall be incidental to the pullboxes.
2. All pre-cast concrete pullboxes shall be manufactured in two pieces.
3. The pullbox with cover shall be capable of supporting an MS 18 Loading.
4. The maximum weight of the pullbox cover shall not exceed 27 kilograms.
5. The openings for the conduits on all pullboxes shall be pre-cast concrete knockouts.
6. After installing the conduits in the openings of the pullboxes, the Contractor shall fill the excess opening in the pre-cast knockouts with concrete mortar.
7. Prior to installing the pullboxes, the Contractor shall level the bottom of the trench and achieve a minimum of 95% relative compaction of the bottom of the trench.
8. All concrete shall be Class A (21 MPa (3,000 psi), min.)
9. Rebars shall be Grade 300 and all lapped splices shall be 360mm minimum.
10. The #57 or #67 size aggregate shall conform to latest version of AASHTO M43 (ASTM D 448).
11. Type "C" Pullbox shall be installed in a location protected from vehicular traffic (i.e. raised sidewalk, behind A.C. curbs, traffic signal standard or pipe guards).

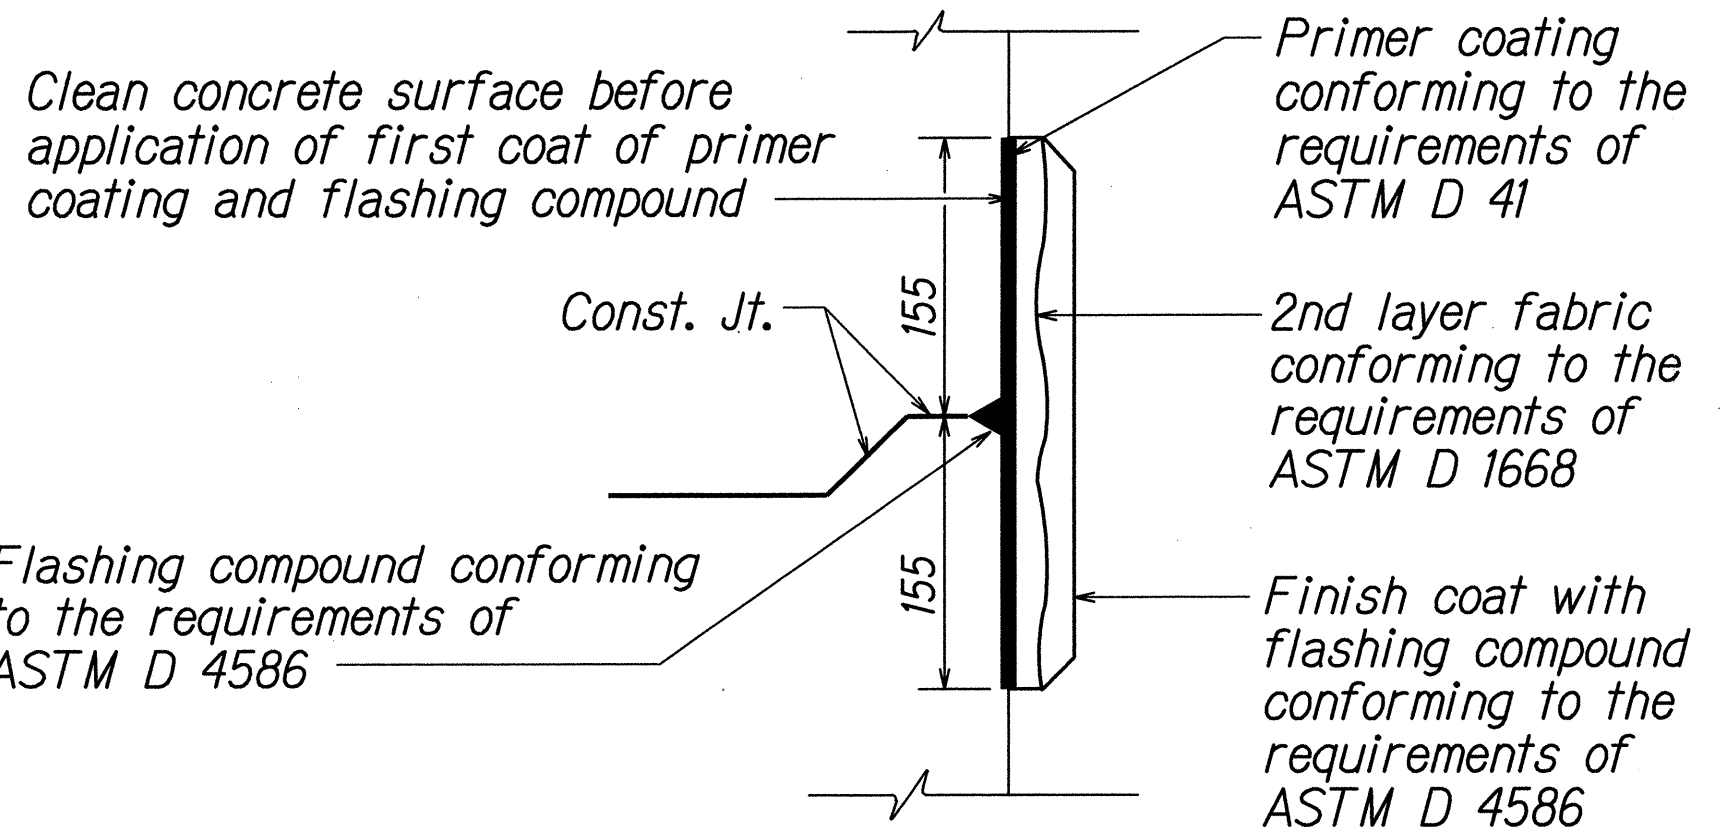


TYPICAL FLASHING COMPOUND WATERPROOFING DETAILS


ALL DIMENSIONS ARE IN MILLIMETERS UNLESS OTHERWISE SHOWN

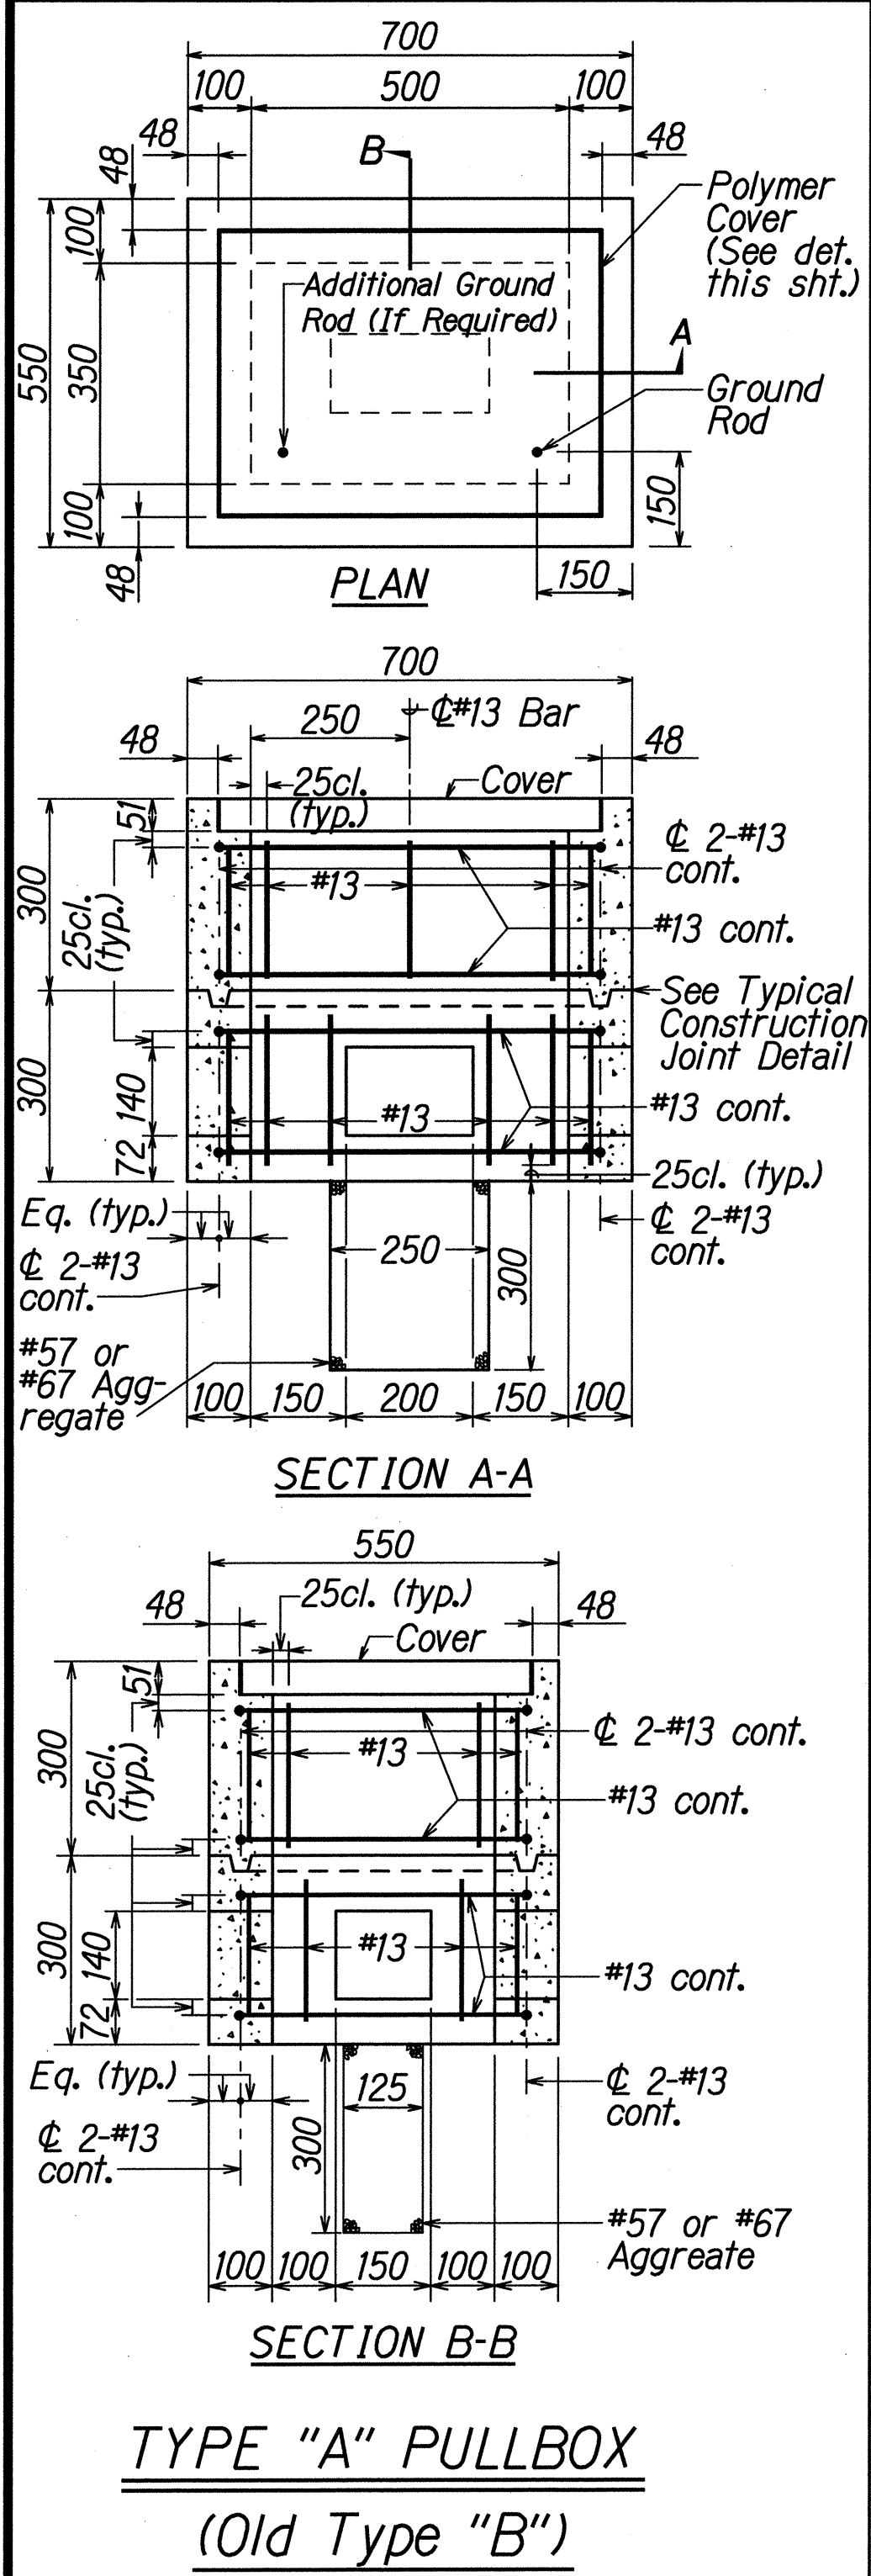


TYPE "A" PULLBOX (Old Type "B")

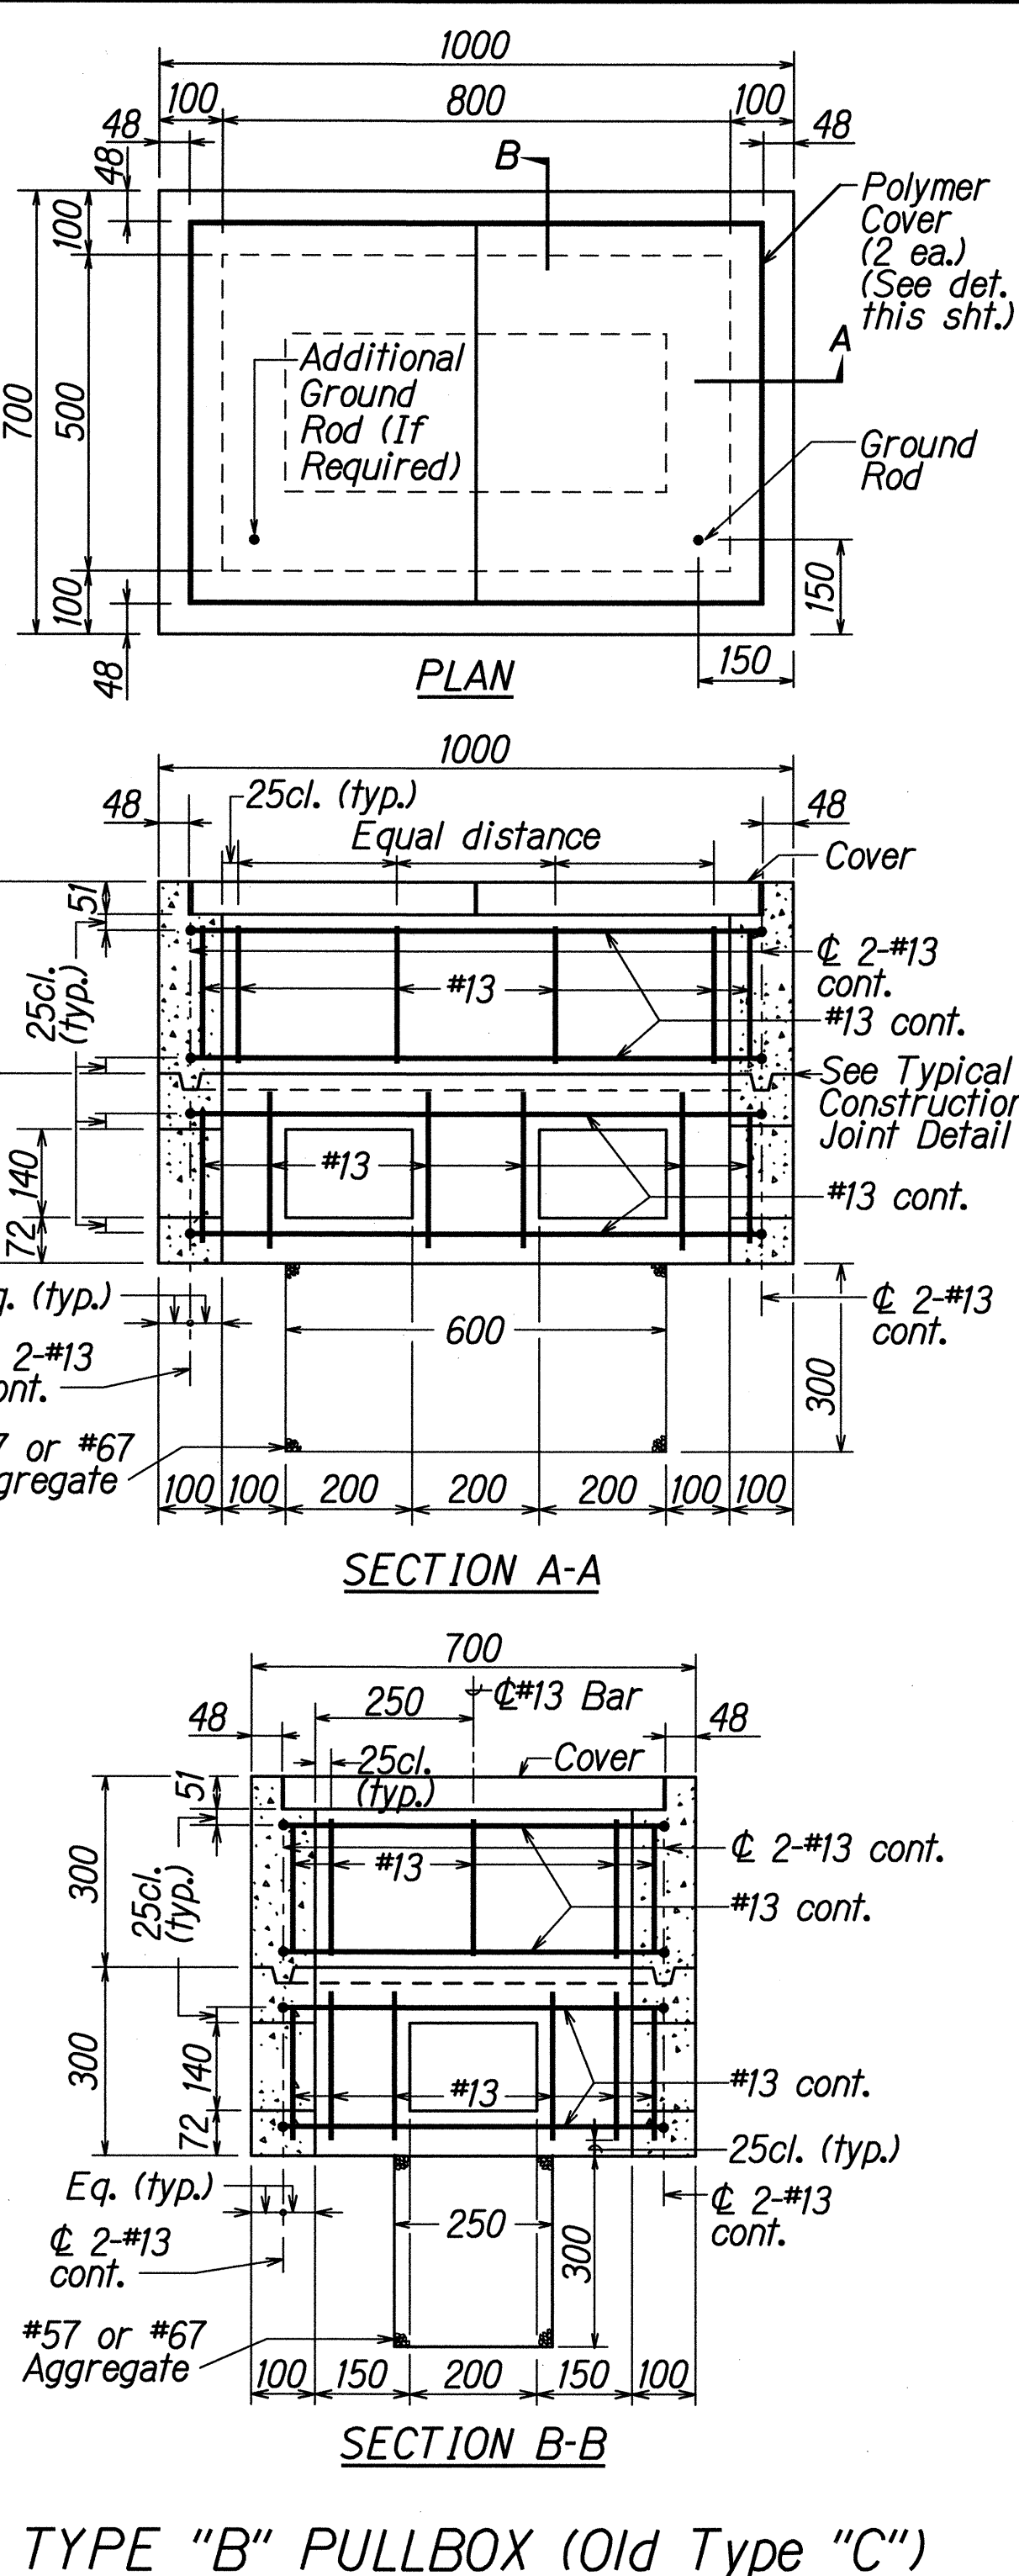


TYPE "B" PULLBOX (Old Type "C")

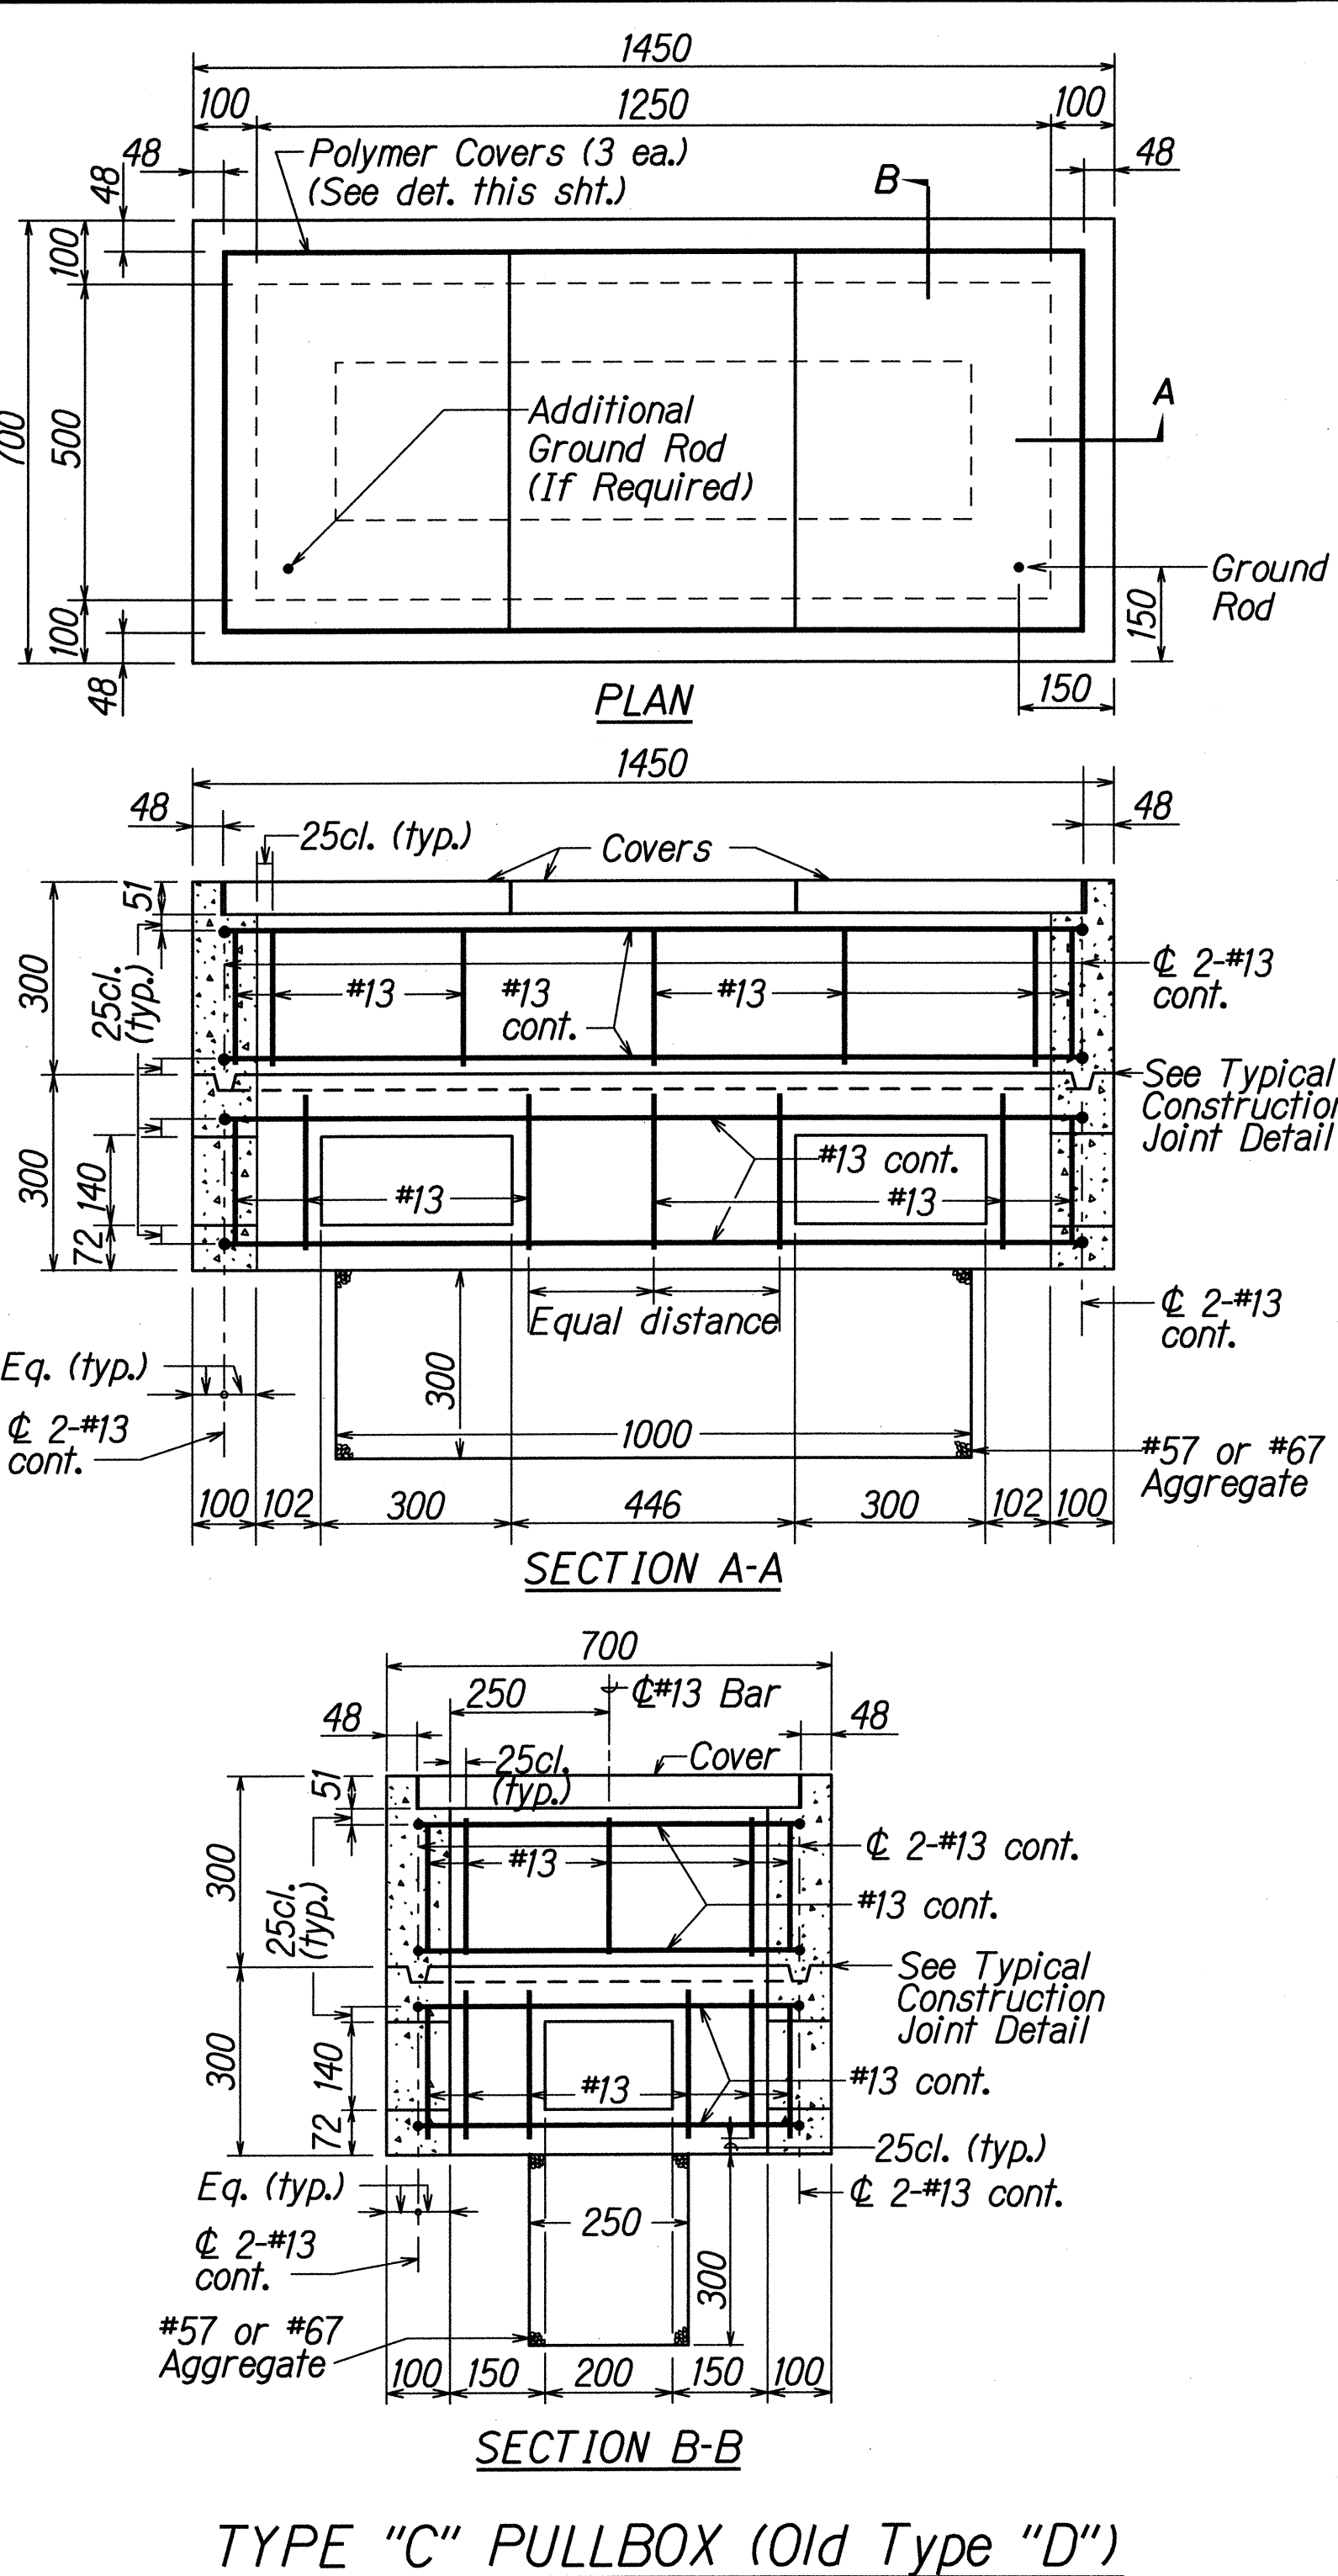

TYPE "C" PULLBOX (Old Type "D")

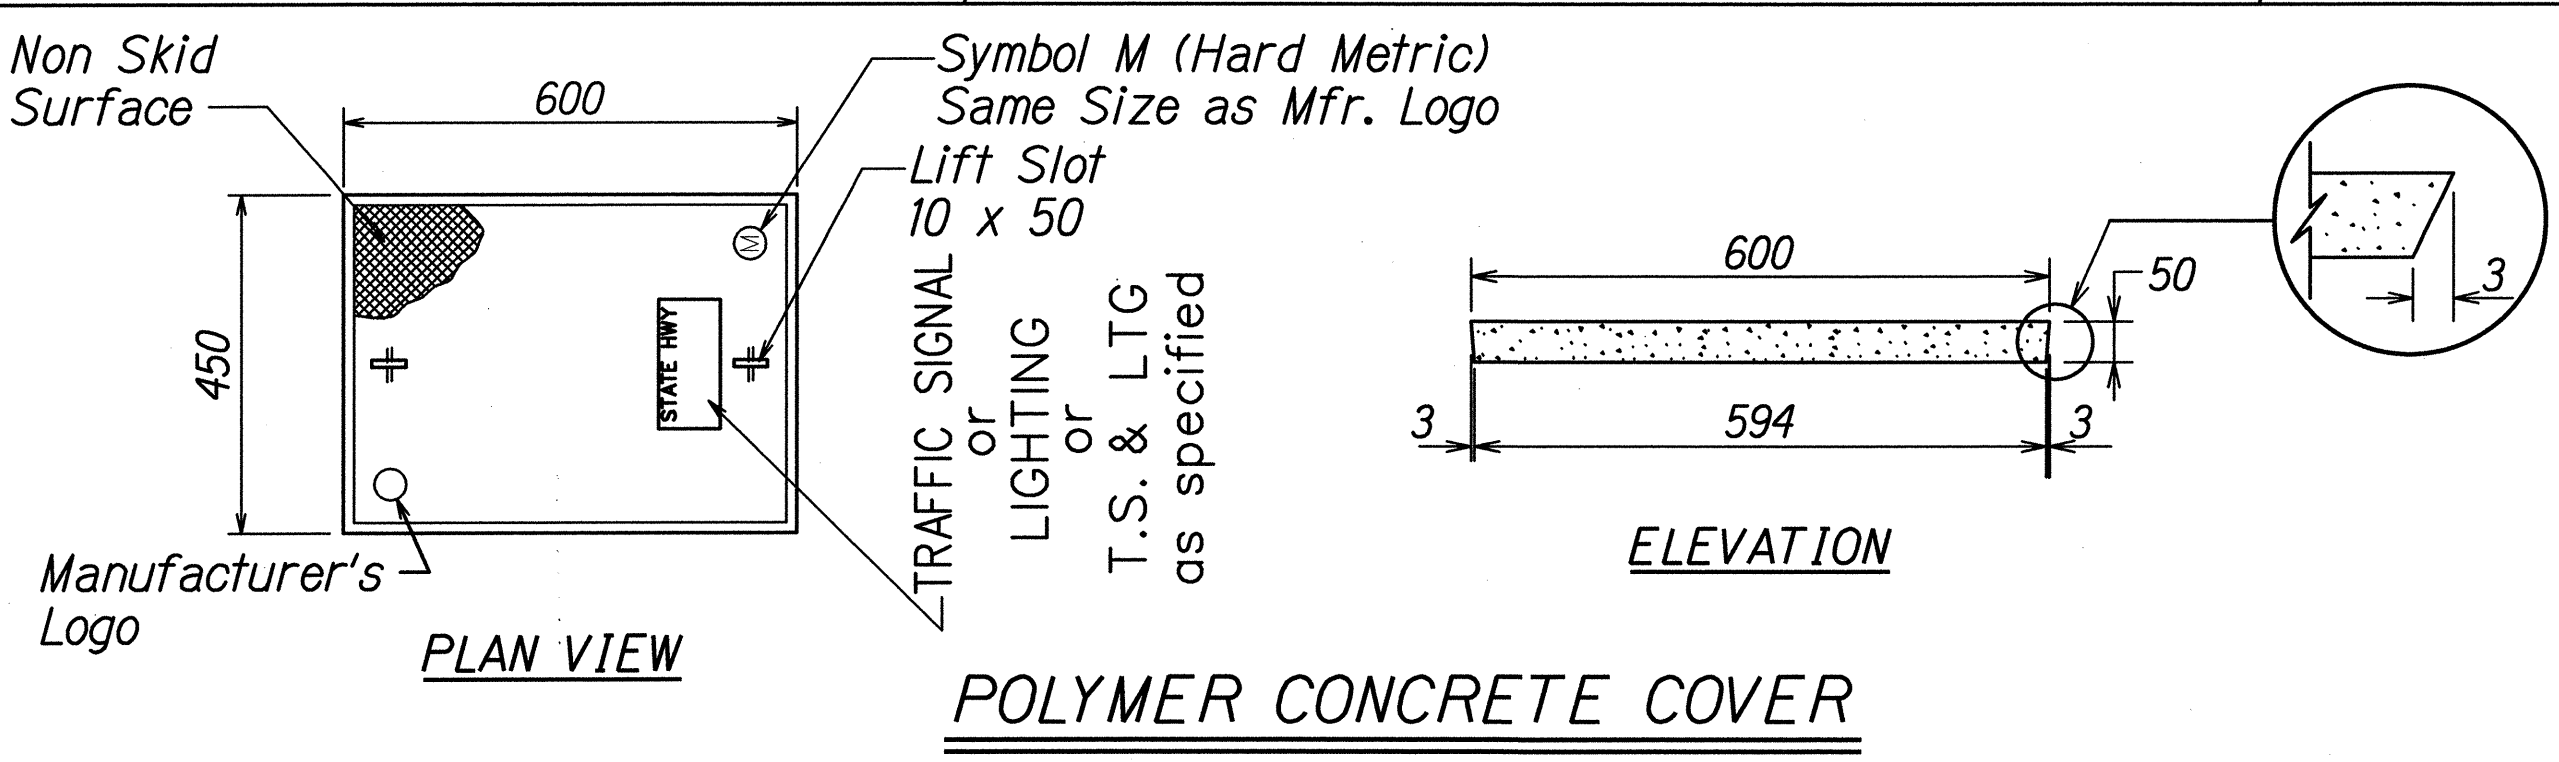

POLYMER CONCRETE COVER

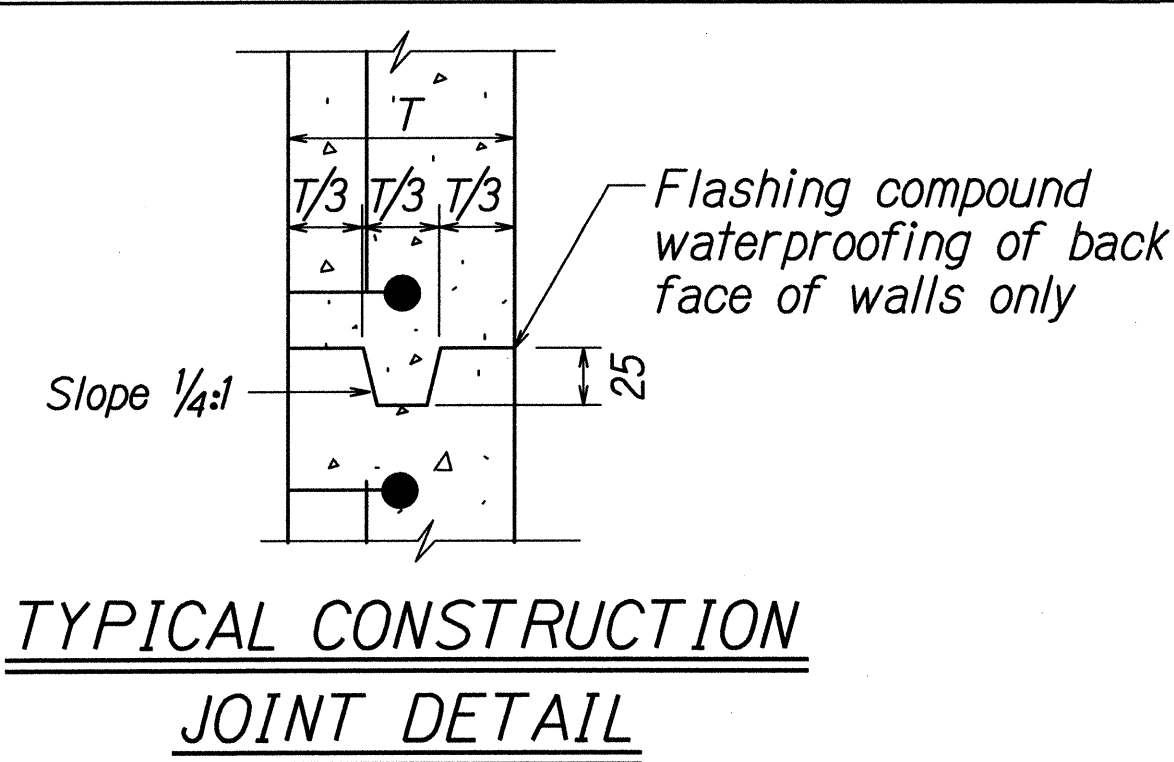

TYPICAL CONSTRUCTION JOINT DETAIL

STATE OF HAWAII
DEPARTMENT OF TRANSPORTATION
HIGHWAYS DIVISION


PULLBOX AND COVER DETAILS

FARRINGTON HIGHWAY INTERSECTION IMPROVEMENTS
AT NANAKULI AVENUE AND HALEAKALA AVENUE
Federal-Aid Project No. STP-093-1(22)

Scale: None Date: April 2013

SHEET No. TS-12 OF 13 SHEETS


FED. ROAD DIST. NO.	STATE	FEDERAL AID PROJ. NO.	FISCAL YEAR	SHEET NO.	TOTAL SHEETS
HAWAII	HAW.	STP-093-1(22)	2013	97	230

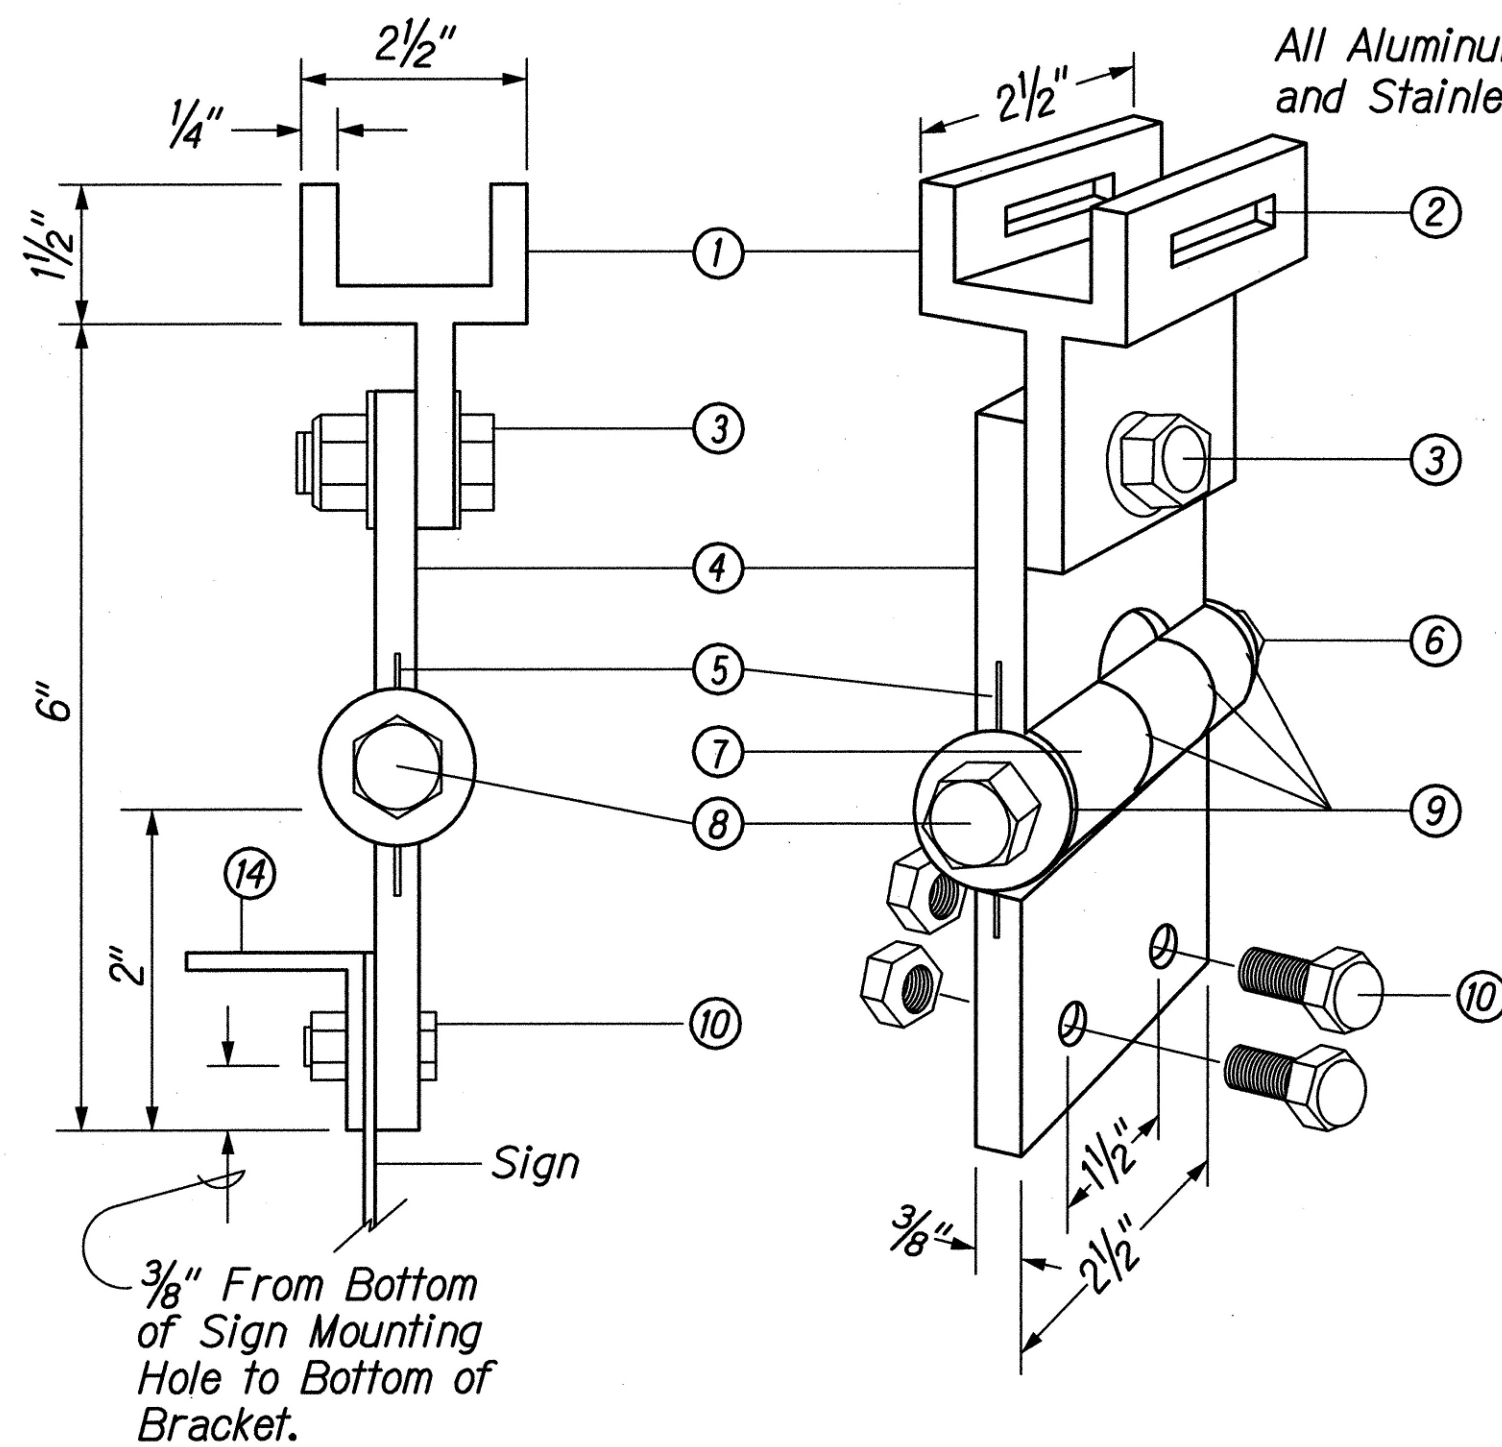

**FIXED LENGTH NON-ADJUSTABLE
SWING SIGN BRACKET**


- ① Pivotal Upper Bracket
- ② 15/8" X 1/4" Slot for Double Strapping to Electrolier Mast Arm. (M2G-34S(HD) .030" X 3/4" Heavy Duty Stainless Steel Strap With M2G-34B(HD) Buckle Recommended.)
- ③ 1/2" - 13 X 1 1/2" Stainless Steel Hex Head Bolt with Stainless Steel Hex Lock Nut and 1/16" Stainless Steel Washer (Both Sides). Allows Upper Bracket to Pivot and Align with Electolier Mast Arm.
- ④ 6" Overall Drop with Fixed Length Sign Bracket
- ⑤ Stainless Steel Damperer Spring (Removable)
- ⑥ Stainless Steel Hex Lock Nut with 1/16" Stainless Steel Washer
- ⑦ 1" O.D. Axle Housing
- ⑧ 1/2" - 13 X 4" Stainless Steel Hex Head Bolt with 1/16" Stainless Steel Washer
- ⑨ Oilite Bushing
- ⑩ Sign Mounting Sets, Consisting of Two Each 5/16" - 18 X 1" Stainless Steel Hex Head Bolt with Stainless Steel Hex Lock Nut. Two Holes on 1/2' Centers Provide Positive Lock Sign Mounted to Bracket.
- ⑪ 8 1/4" Overall Length Upper Adjustable Sigh Bracket Section
- ⑫ 9" Overall Length Lower Adjustable Sign Bracket Section, Including Axle Housing (8" Overall Length to Top of Axle Housing)
- ⑬ 1/2" - 13 X 1 1/2" Stainless Steel Hex Bolt with Stainless Steel Hex Lock Nut and 1/16" Stainless Steel Washer (Both Sides). Loosen Lock Nut . Adjust Bracket Teeth to Level Sign.
- ⑭ 1 1/4" X 1 1/4" X 1/8" Aluminum Angle

All Aluminum 6061T6 Alloy
and Stainless Steel Components.

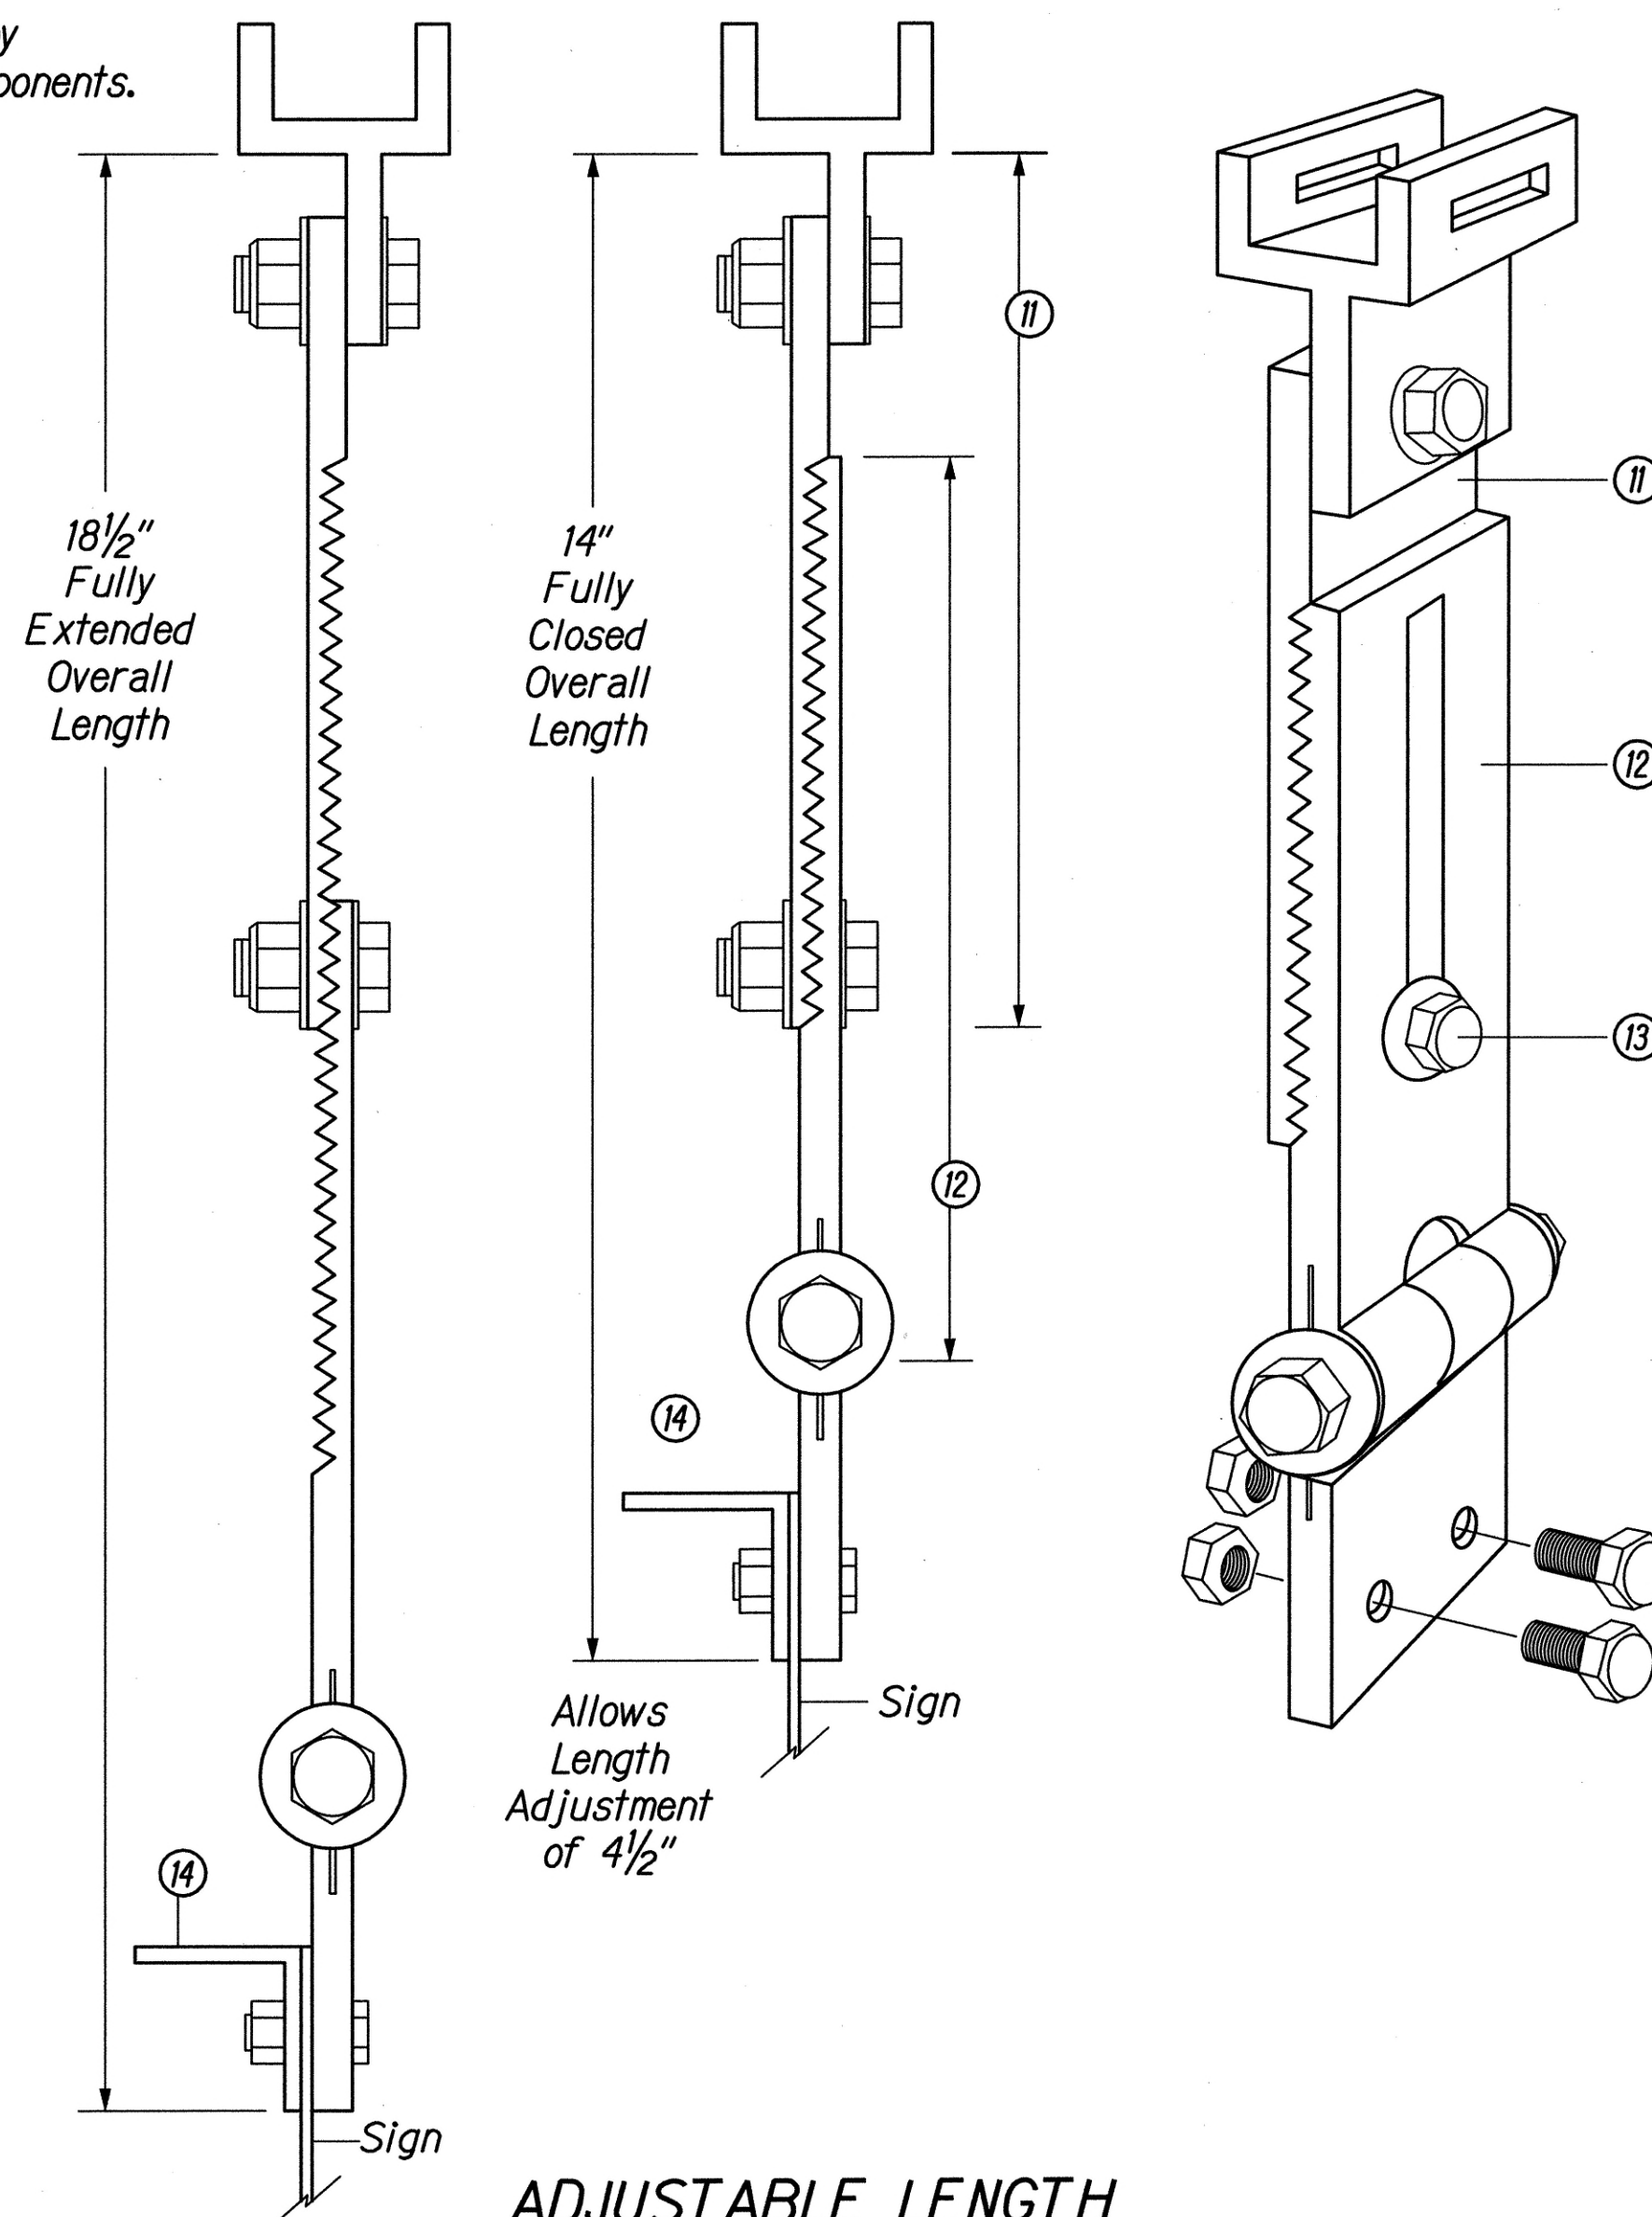


**ADJUSTABLE LENGTH
SWING SIGN BRACKET**


Note: Dimensions may vary slightly

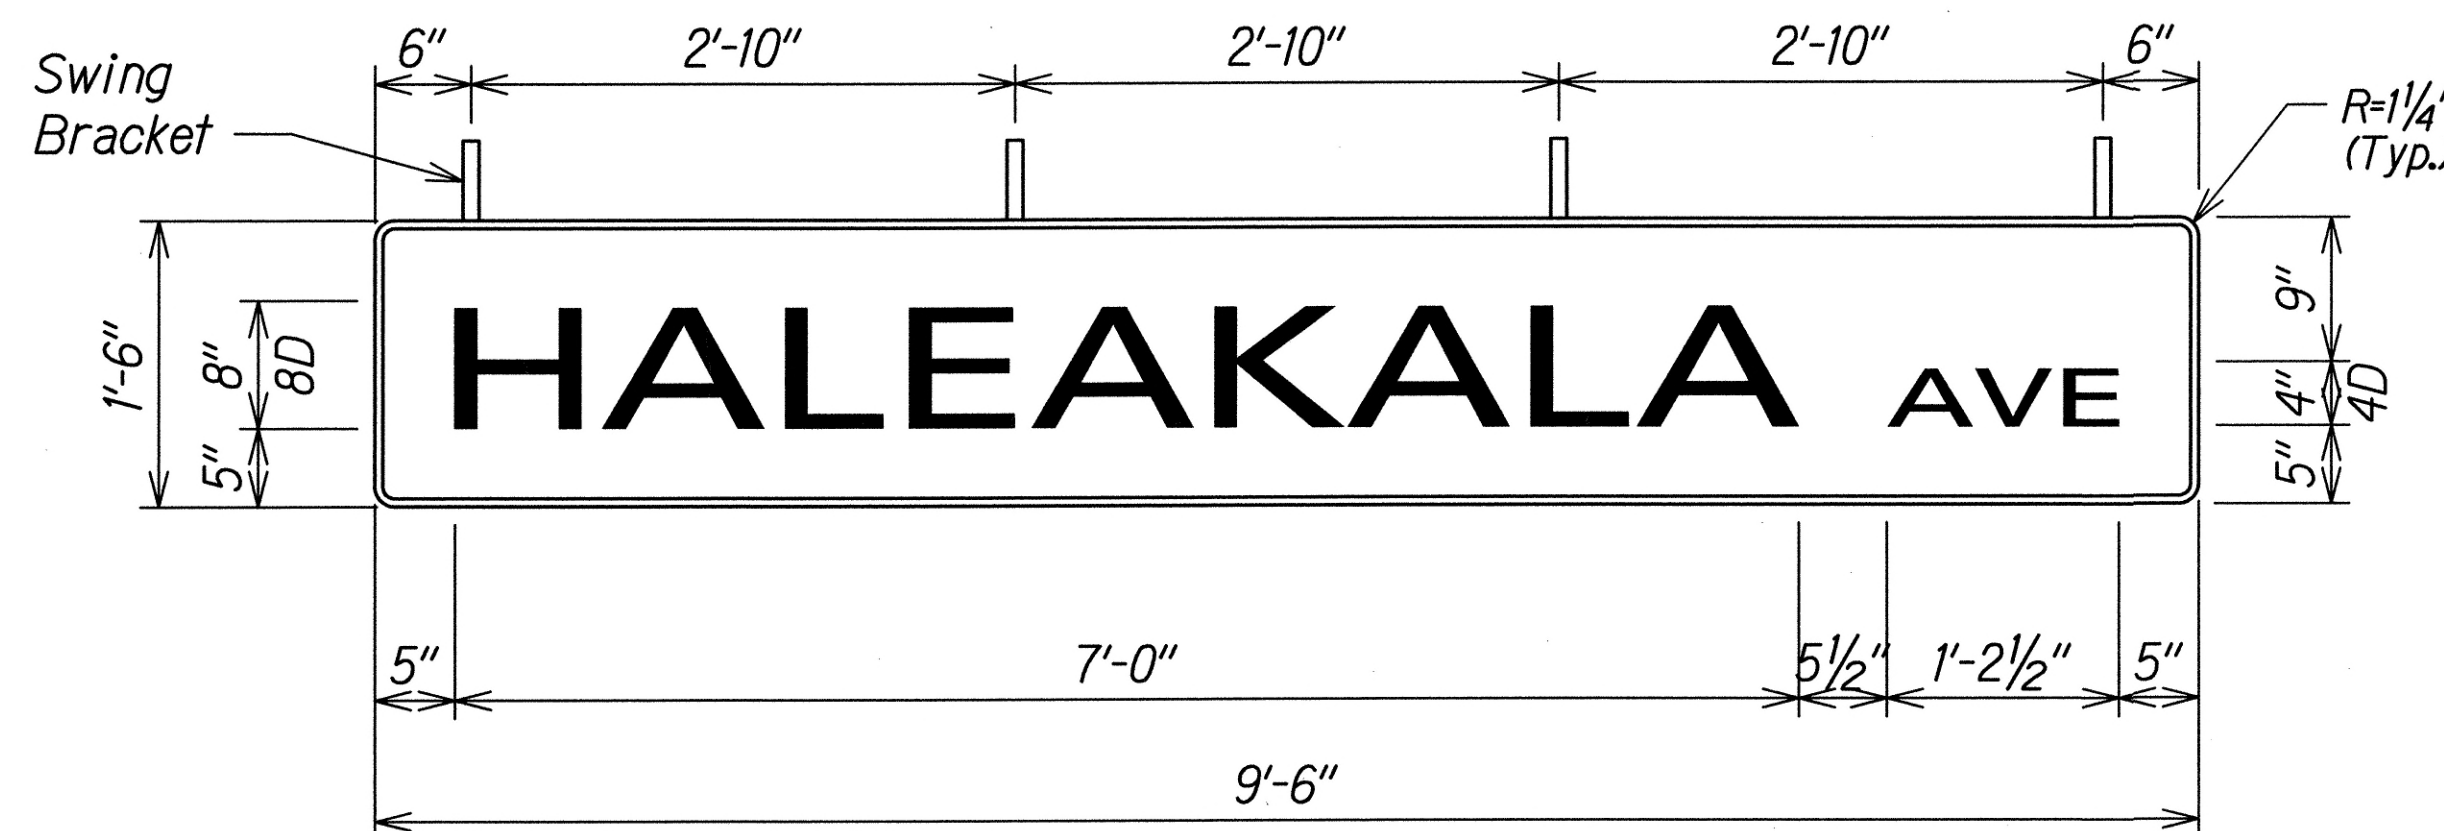

STREET NAME SIGN DETAIL
NTS

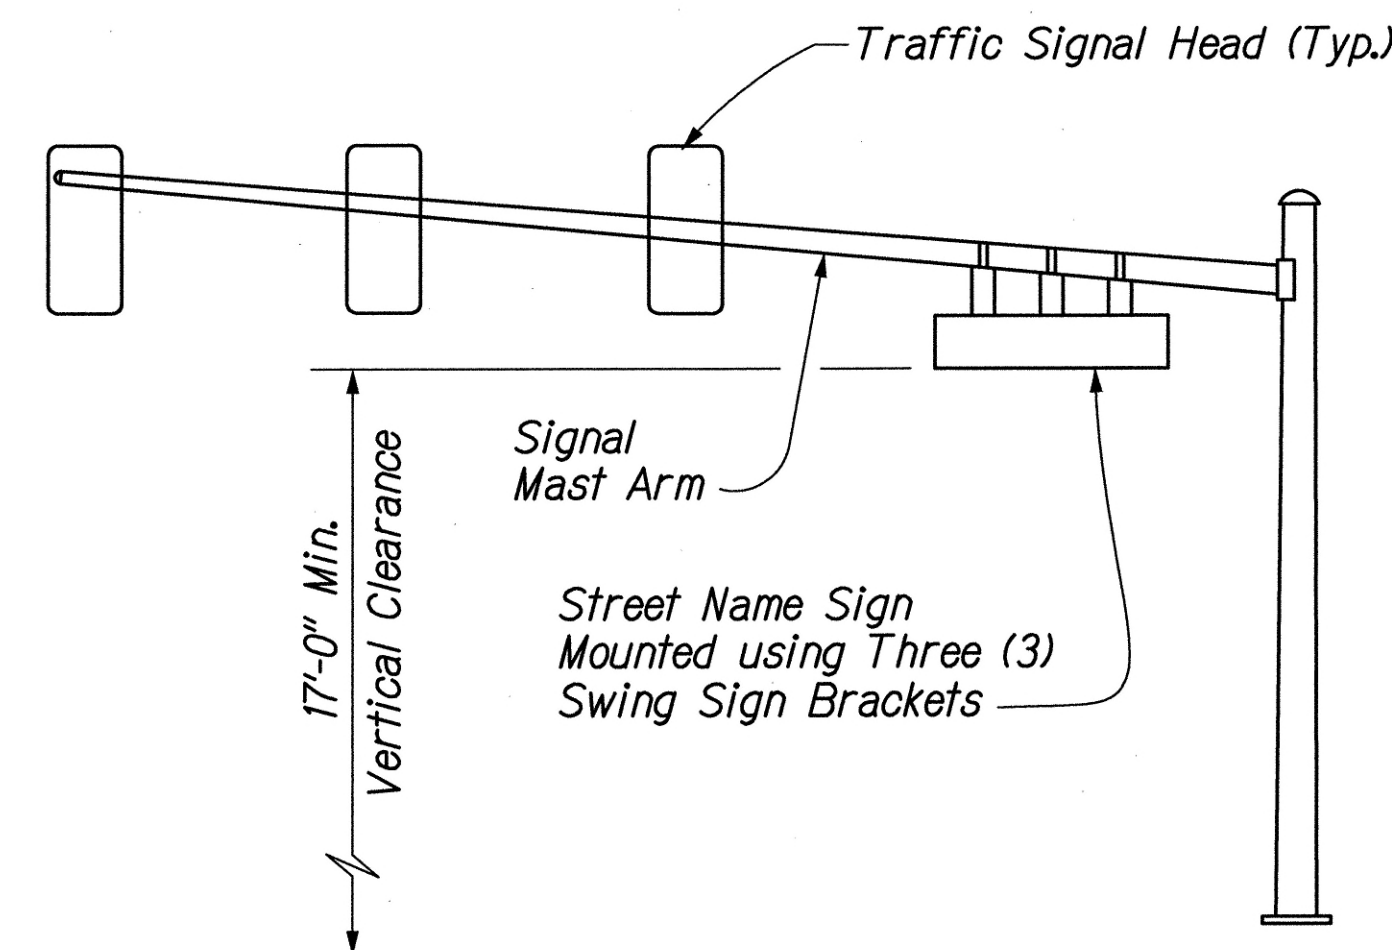

**SIGN MOUNTING
ON MAST ARM**

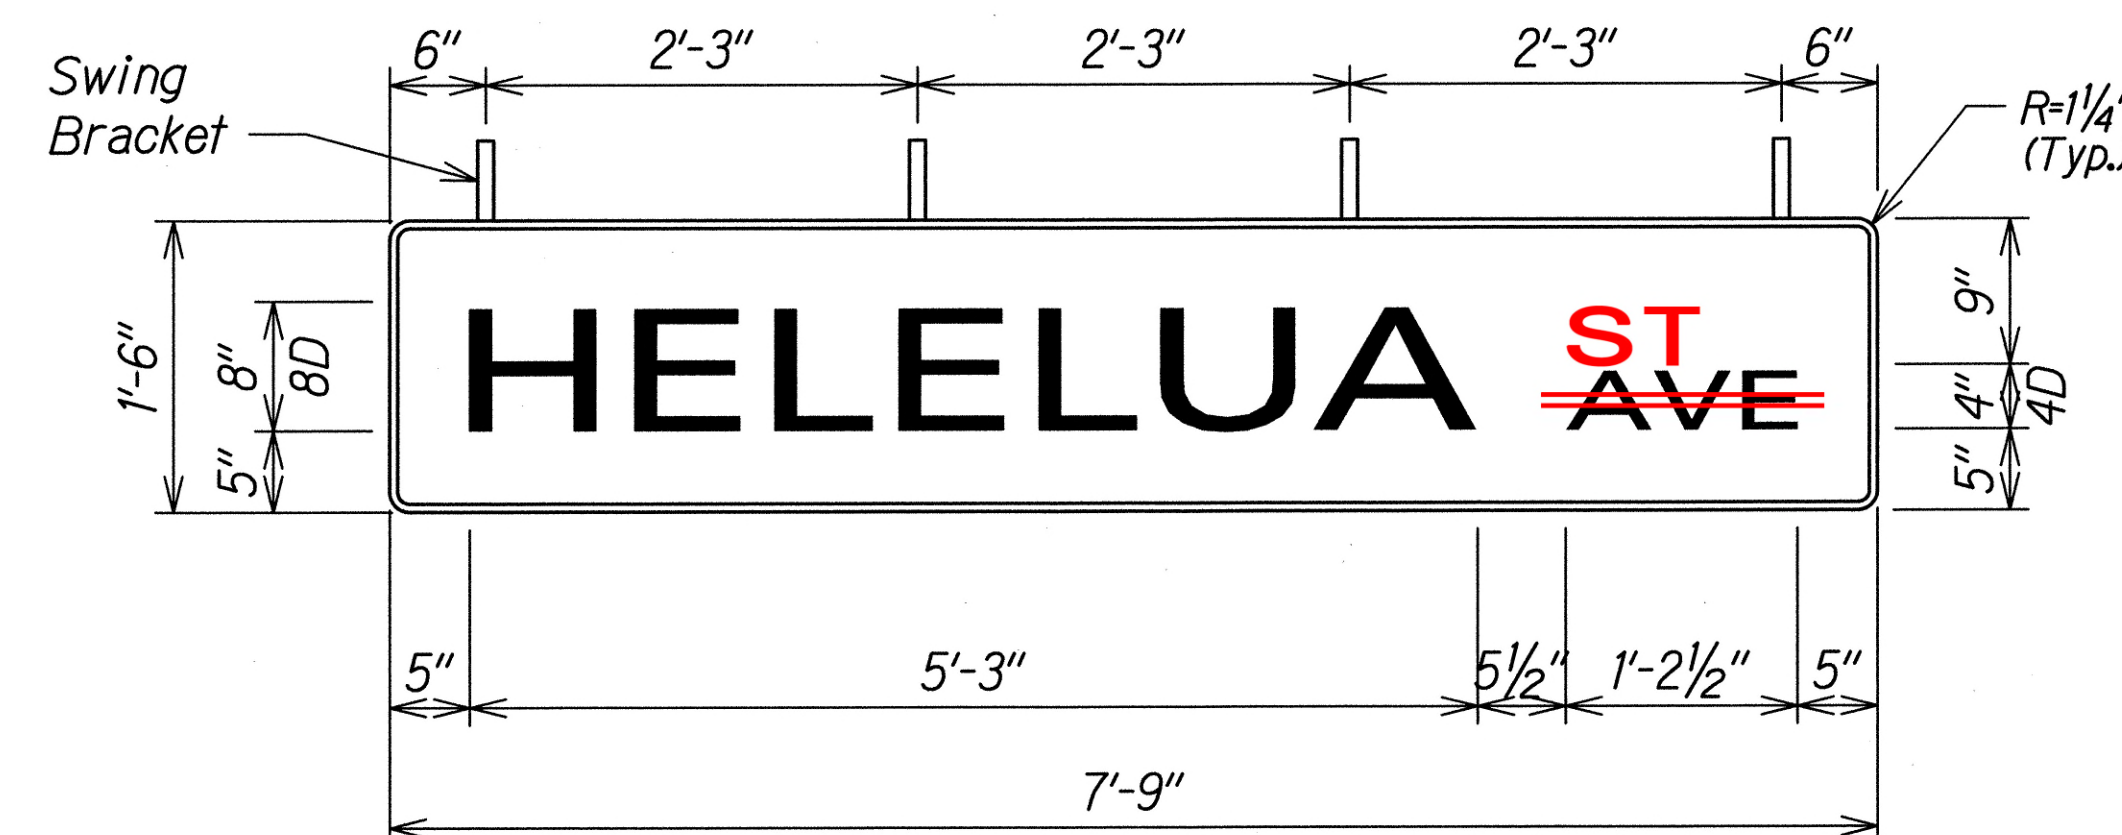

STREET NAME SIGN DETAIL
NTS

NOTES:

1. Font size and spacing shall conform to Federal Highway Administration Standard Highway signs convention.
2. Legend shall be the same on both sides of sign.
3. Colors: Legend - White
Background - Green
4. Adjust Swing Sign bracket lengths to level sign.

CONTRACT CHANGE ORDER NO. 30

THIS WORK WAS PREPARED BY ME
OR UNDER MY SUPERVISION.

Signature: *Gerald D. Andrade*
EXPIRATION DATE OF THE LICENSE: 04/30/14

STATE OF HAWAII
DEPARTMENT OF TRANSPORTATION
HIGHWAYS DIVISION

SIGN BRACKET DETAILS

FARRINGTON HIGHWAY INTERSECTION IMPROVEMENTS
AT NANAKULI AVENUE AND HALEAKALA AVENUE
Federal-Aid Project No. STP-093-1(22)

Scale: None Date: April 2013

SHEET No. TS-13 OF 13 SHEETS

"AS-BUILT"