
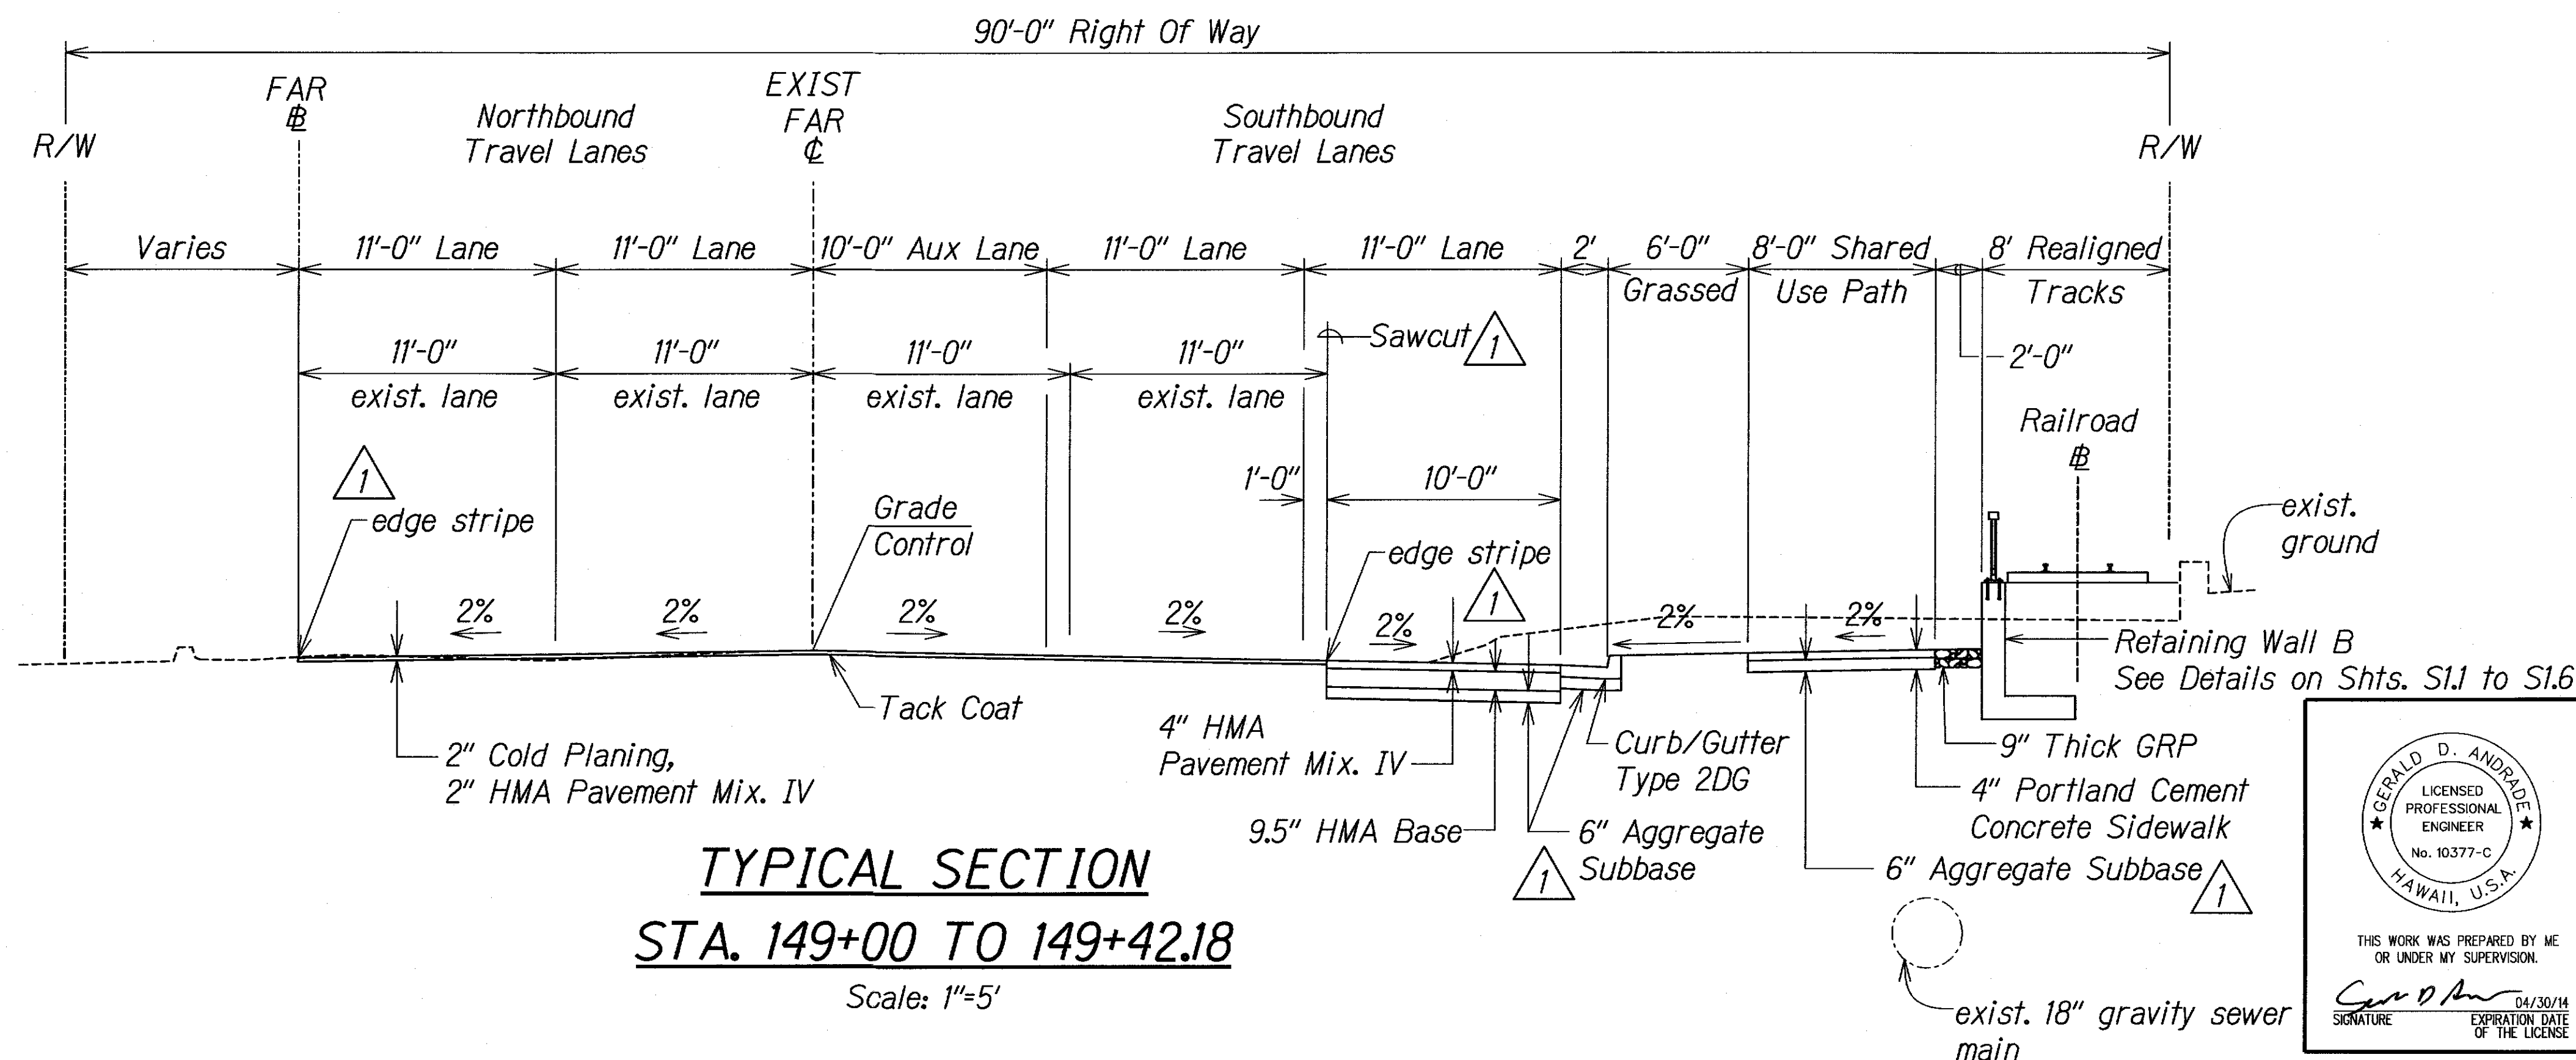


FED. ROAD DIST. NO.	STATE	FEDERAL AID PROJ. NO.	FISCAL YEAR	SHEET NO.	TOTAL SHEETS
HAWAII	HAW.	STP-093-K22	2013	ADD13	230

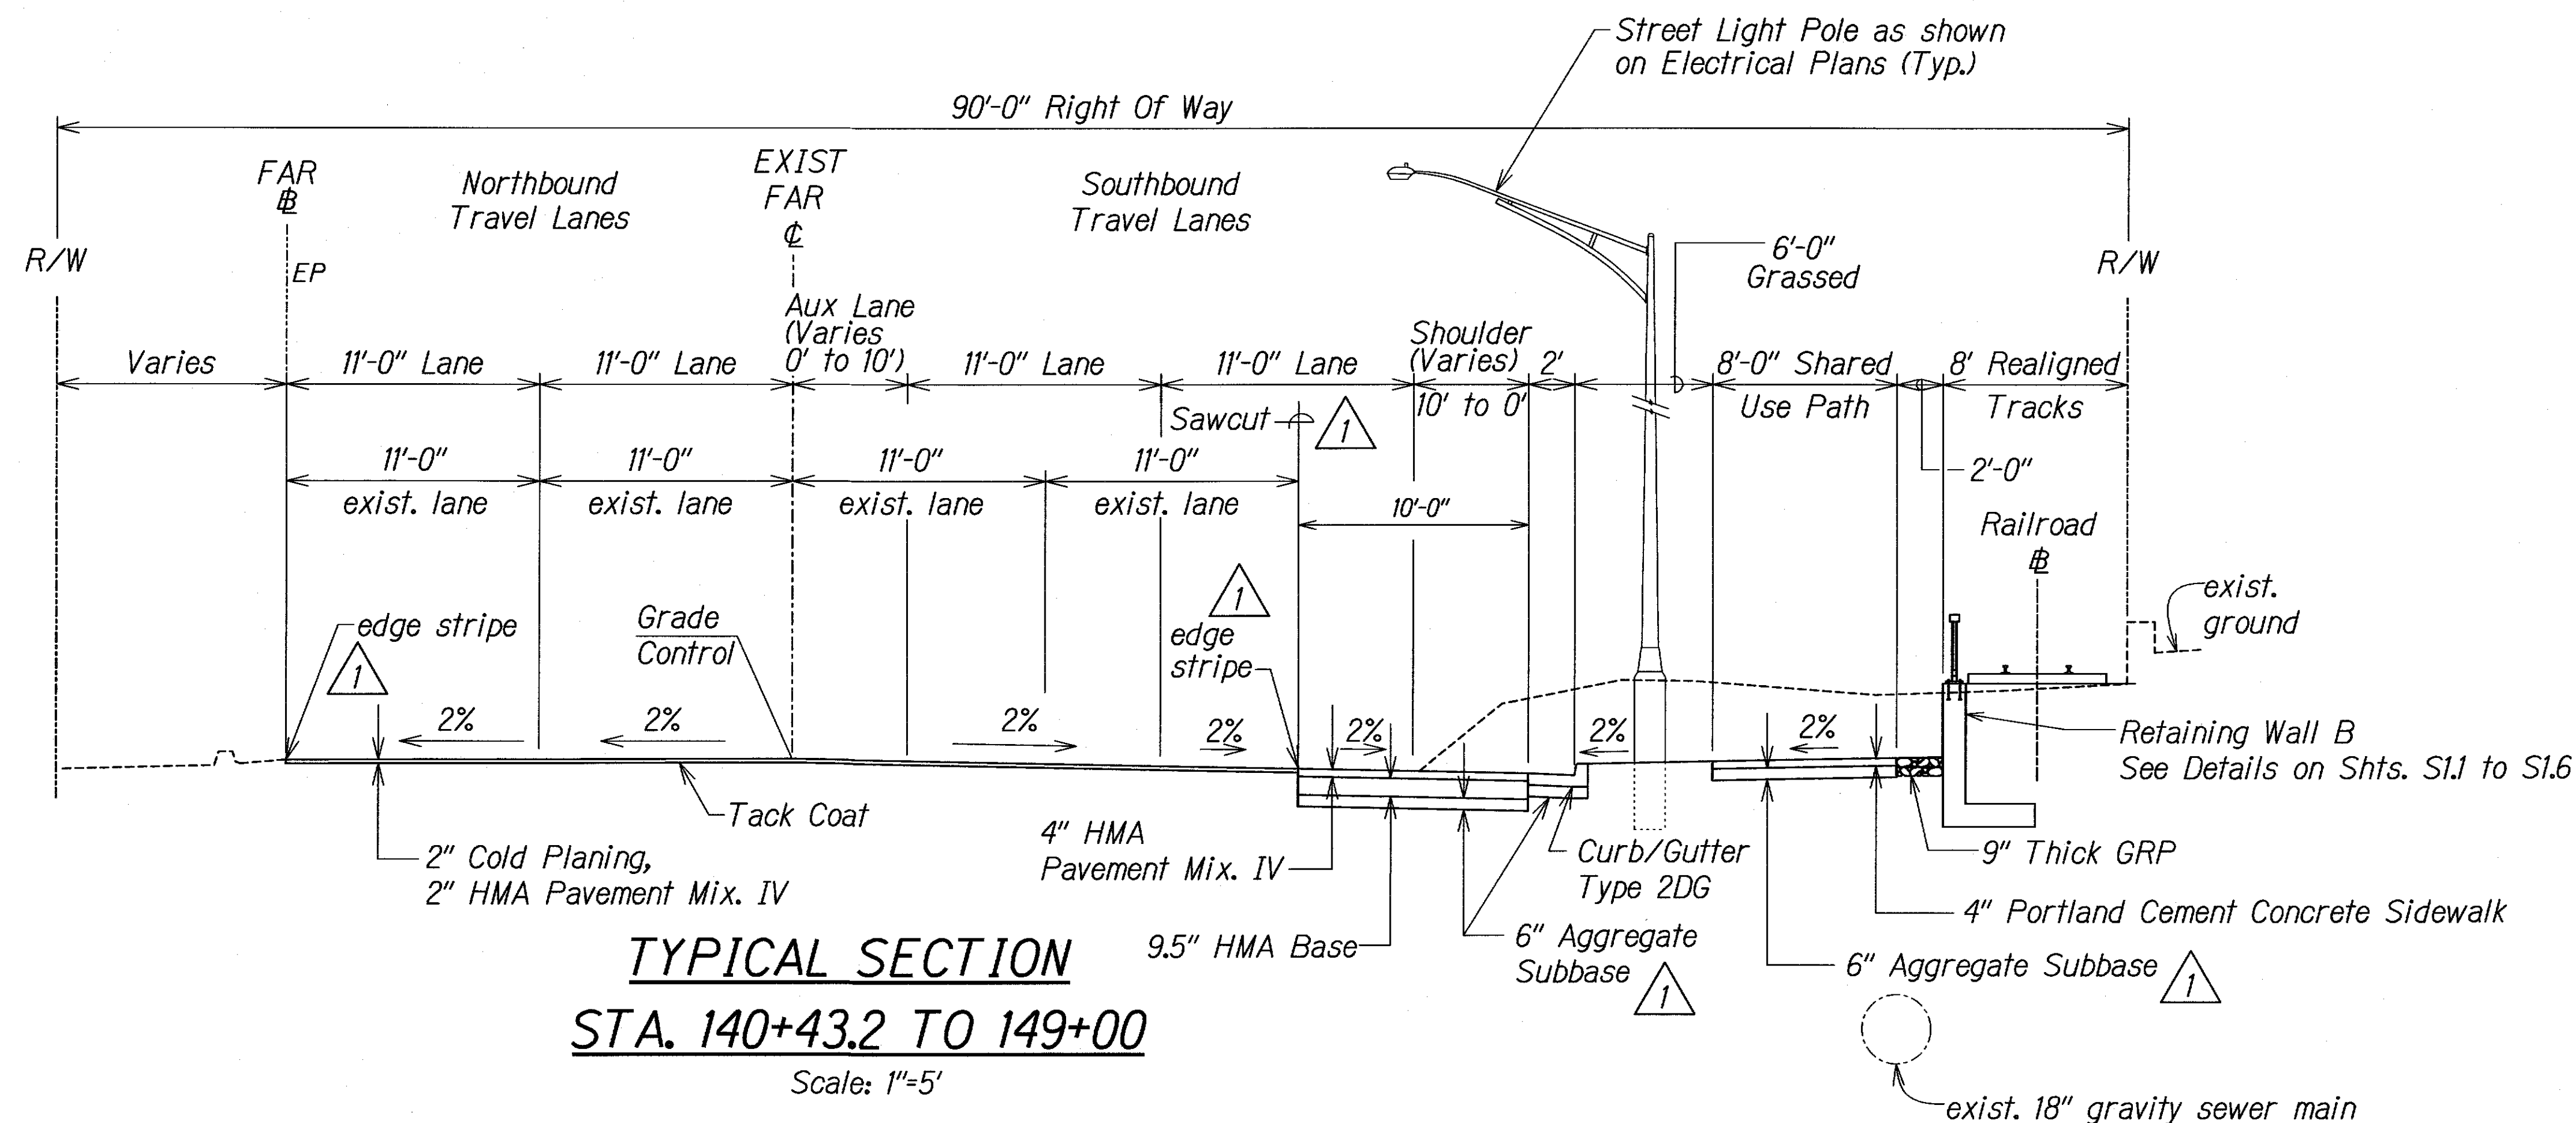

DATE	_____
SURVEY PLOTTED BY	_____
DESIGNED BY	_____
CHECKED BY	_____
ORIGINAL PLAN	_____
NOTE BOOK	_____
NO.	_____

1/2-DOT-FARRINGTON HWY INTERSECTIONS NANAKULI HALEAKALA/CADD/Sheets/Section/T-1dgm

11/06/13	Revised Typical Sections
Date	Revision

STATE OF HAWAII
DEPARTMENT OF TRANSPORTATION
HIGHWAYS DIVISION

TYPICAL SECTIONS
STA. 141+00 TO 149+42.22

FARRINGTON HIGHWAY INTERSECTION IMPROVEMENTS
AT NANAKULI AVENUE AND HALEAKALA AVENUE
Federal-Aid Project No. STP-093-K22

Scale: 1"=5' Date: April 2013


GERALD D. ANDRADE
LICENSED PROFESSIONAL ENGINEER
No. 10377-C
HAWAII, U.S.A.

THIS WORK WAS PREPARED BY ME
OR UNDER MY SUPERVISION.


Signature: _____
Date: 04/30/14
EXPIRATION DATE OF THE LICENSE

SHEET No. T-1 OF 3 SHEETS

FED. ROAD DIST. NO.	STATE	FEDERAL AID PROJ. NO.	FISCAL YEAR	SHEET NO.	TOTAL SHEETS
HAWAII	HAW.	STP-093-1(22)	2013	ADD14	230

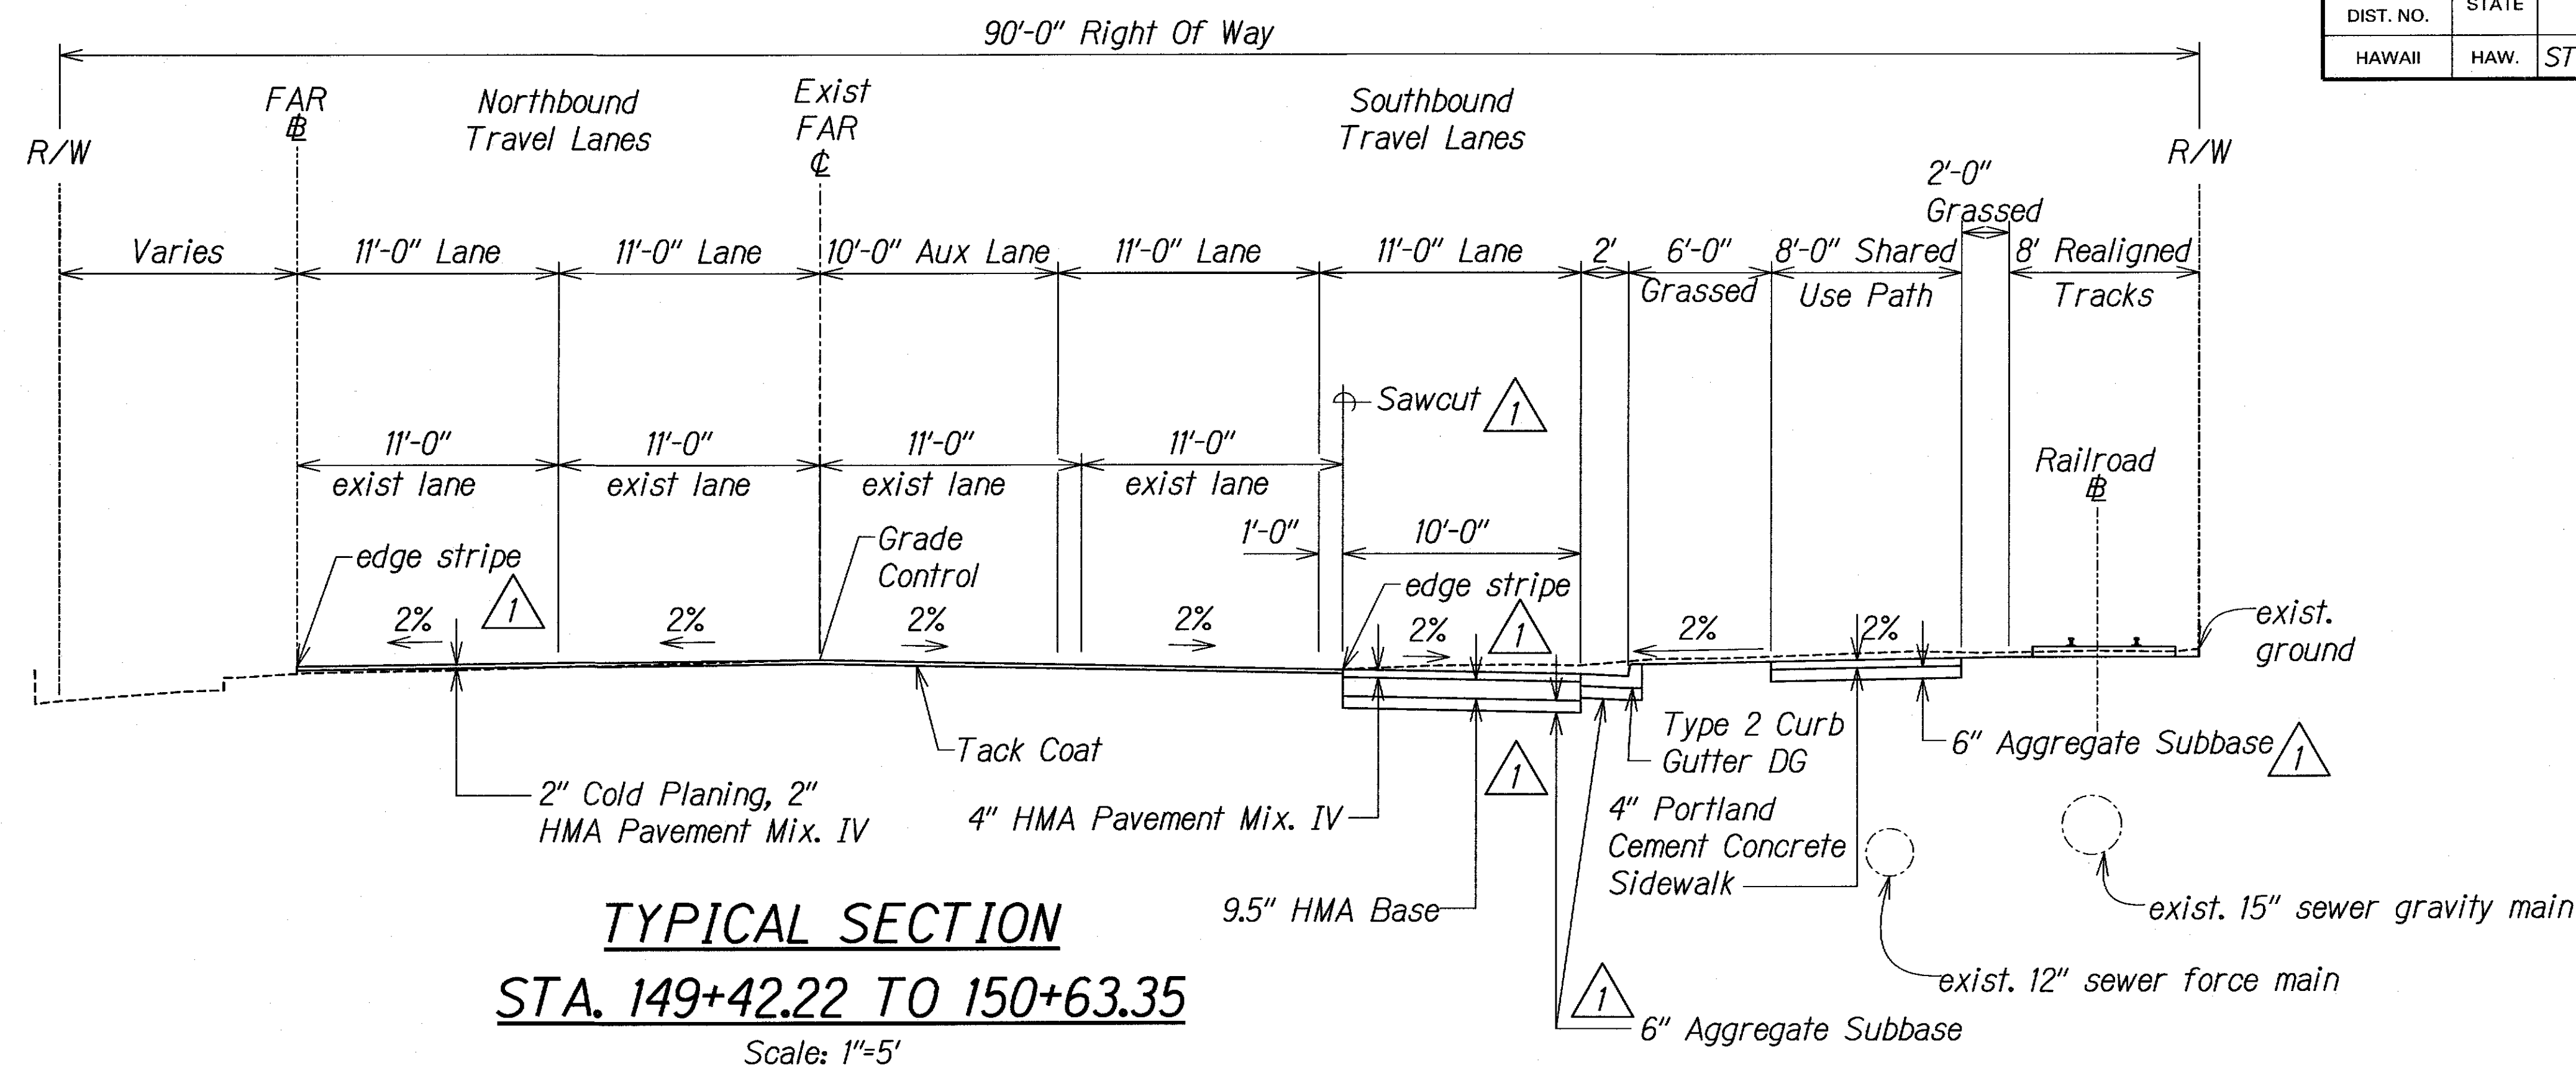


TYPICAL SECTION
STA. 149+42.22 TO 150+63.35
 Scale: 1"=5'

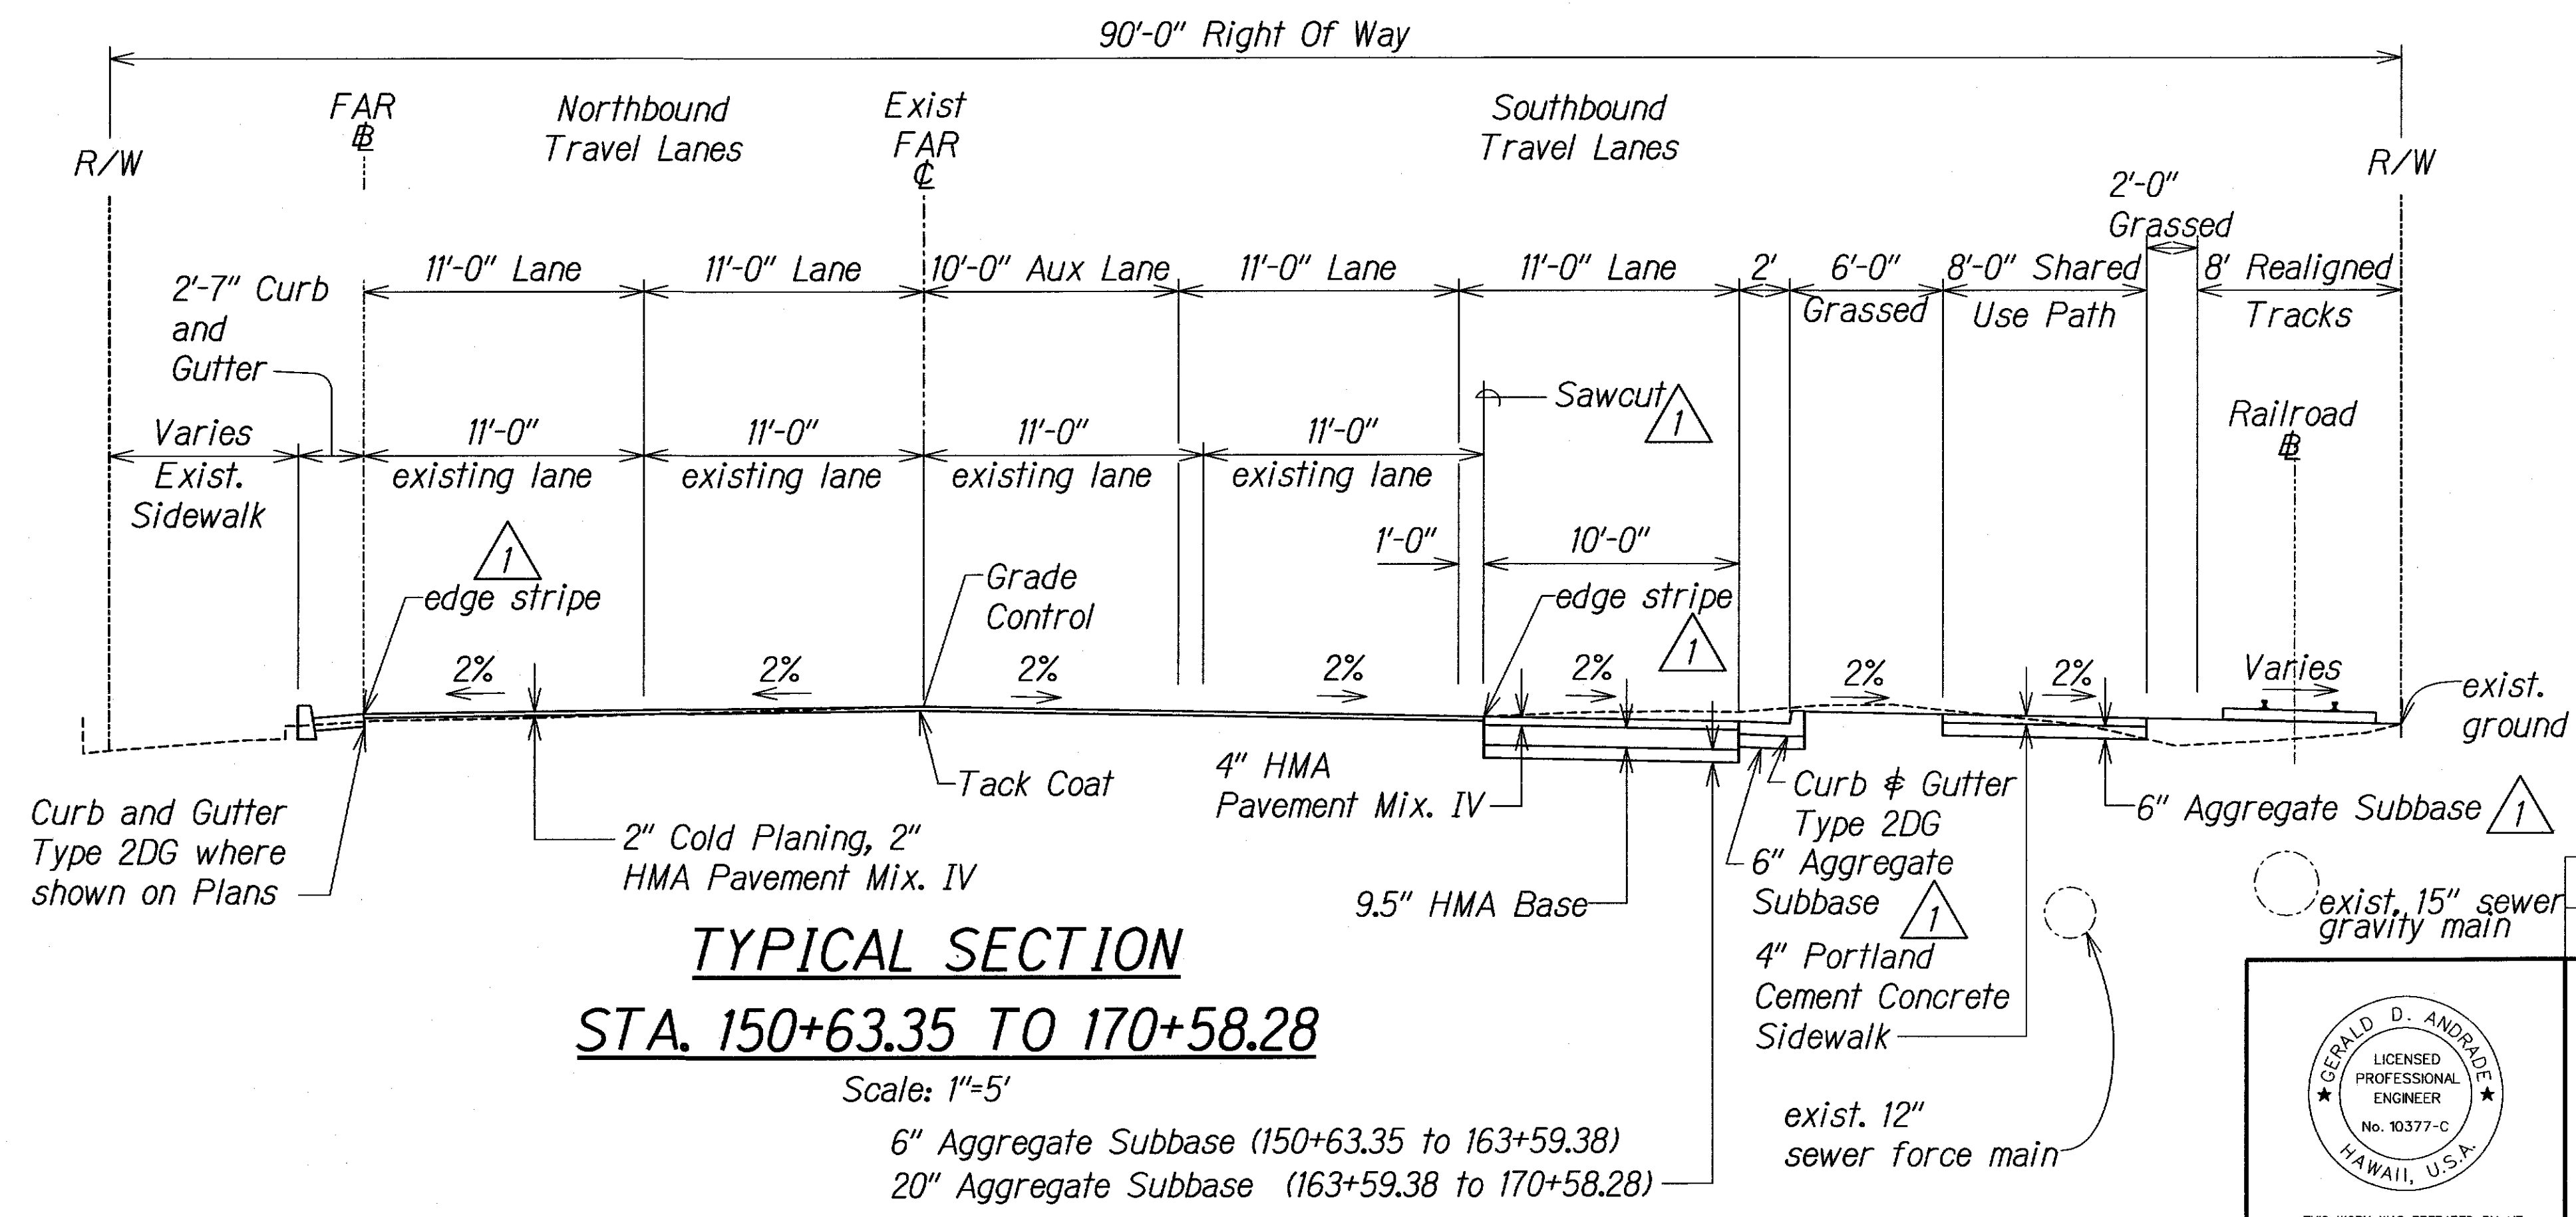

TYPICAL SECTION
STA. 150+63.35 TO 170+58.28
 Scale: 1"=5'

Date	Revision
11/06/13	Revised Typical Sections

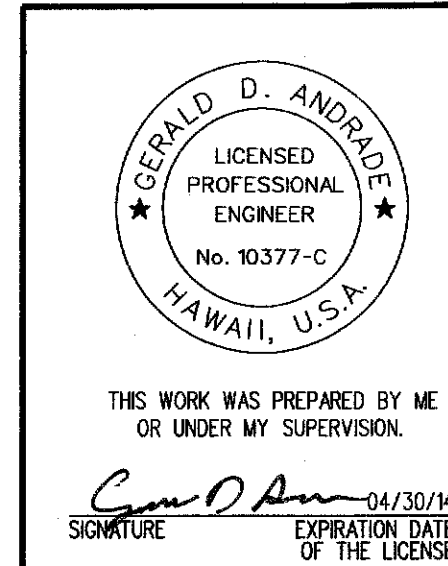

STATE OF HAWAII
 DEPARTMENT OF TRANSPORTATION
 HIGHWAYS DIVISION


TYPICAL SECTIONS
STA. 149+42.22 TO 170+58.28
 FARRINGTON HIGHWAY INTERSECTION IMPROVEMENTS
 AT NANAKULI AVENUE AND HALEAKALA AVENUE
 Federal-Aid Project No. STP-093-1(22)

Scale: _____ Date: April 2013

ORIGINAL PLAN	DATE
DESIGNED BY	
CHECKED BY	
NOTED BY	
DATE	

J:\DOT-FARRINGTON HWY INTERSECTIONS\NANAKULI HALEAKALA\CADD\Sheets\Section\T-2.dgn

FED. ROAD DIST. NO.	STATE	FEDERAL AID PROJ. NO.	FISCAL YEAR	SHEET NO.	TOTAL SHEETS
HAWAII	HAW.	STP-093-1(22)	2013	ADD15	230

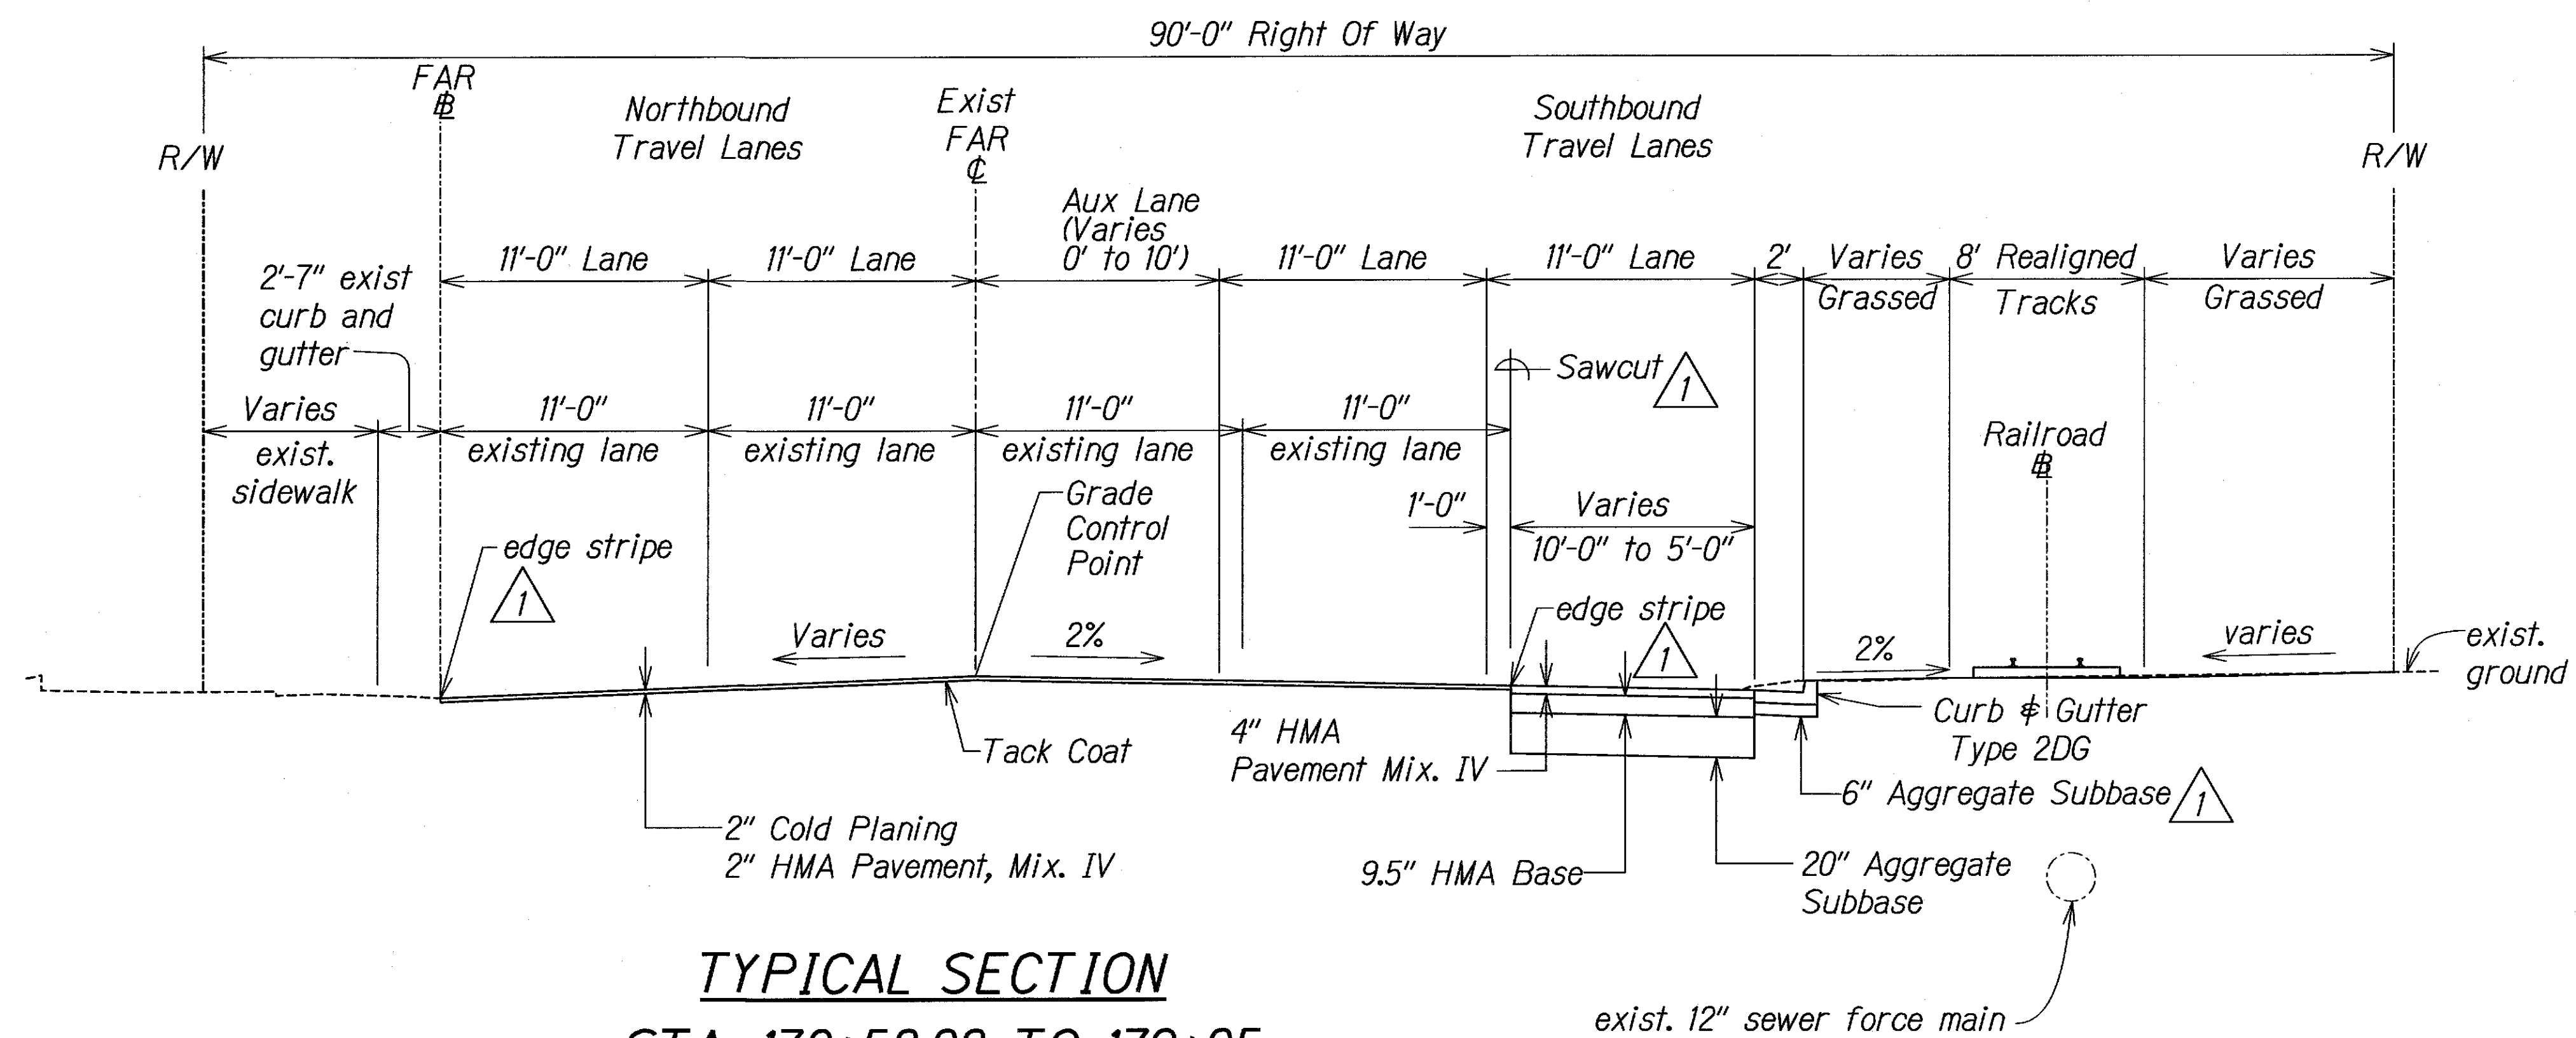

TYPICAL SECTION
STA. 170+58.28 TO 179+25
 Scale: 1"=5'

ORIGINAL PLAN	SURVEY PLOTTED BY	DATE
NOTE BOOK	DRAWN BY	
	DESIGNED BY	
	CHECKED BY	
	APPROVED BY	

J:\DOT-FARRINGTON HWY INTERSECTIONS\HAWAII\HALEAKALA\CADD\Sheets\Section\T-3.dgn

11/06/13	△ Revised Typical Section
Date	Revision

THIS WORK WAS PREPARED BY ME OR UNDER MY SUPERVISION.

Signature: *Gerald D. Andrade* 04/30/14
 EXPIRATION DATE OF THE LICENSE

STATE OF HAWAII
 DEPARTMENT OF TRANSPORTATION
 HIGHWAYS DIVISION

TYPICAL SECTIONS
STA. 170+58.28 TO 179+25
 FARRINGTON HIGHWAY INTERSECTION IMPROVEMENTS
 AT NANAKULI AVENUE AND HALEAKALA AVENUE
 Federal-Aid Project No. STP-093-1(22)

Scale: 1"=5' Date: April 2013