




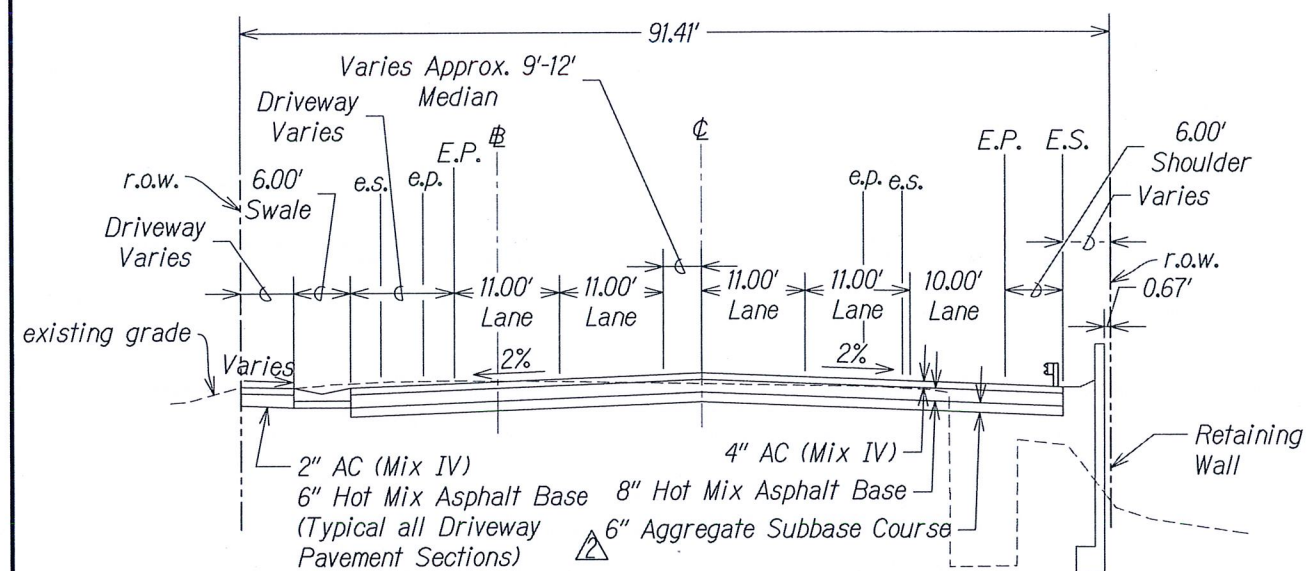


STA. 162+80.00 TO STA. 162+92.79
Scale: 1" = 10'

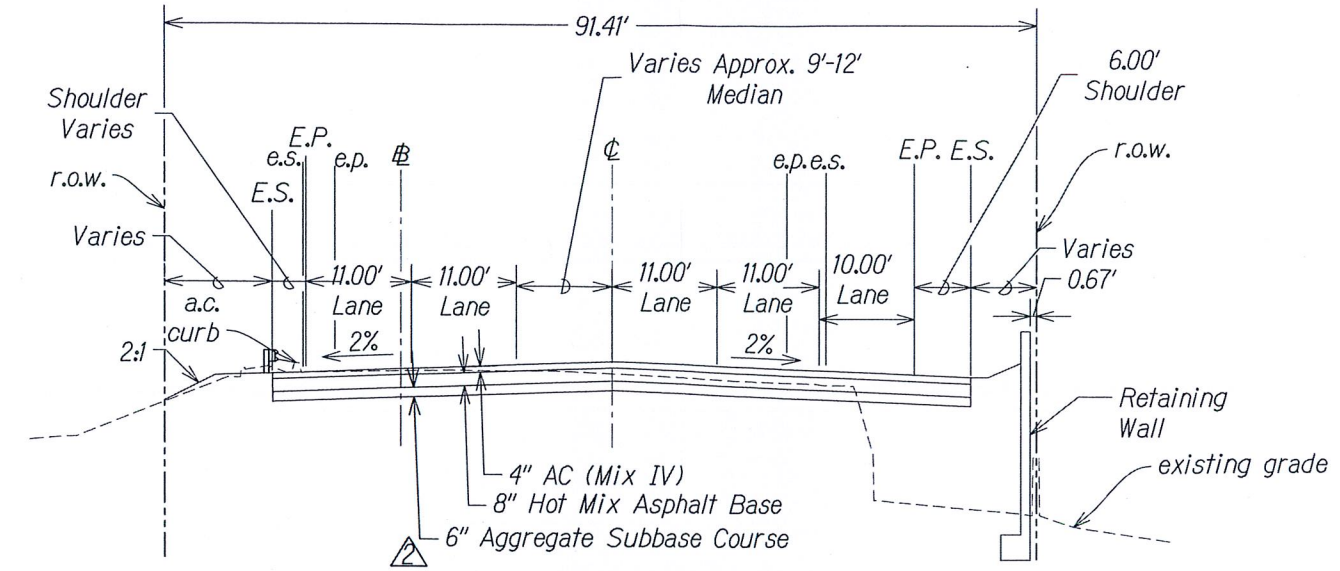

STA. 162+92.79 TO STA. 163+12.61
Scale: 1" = 10'

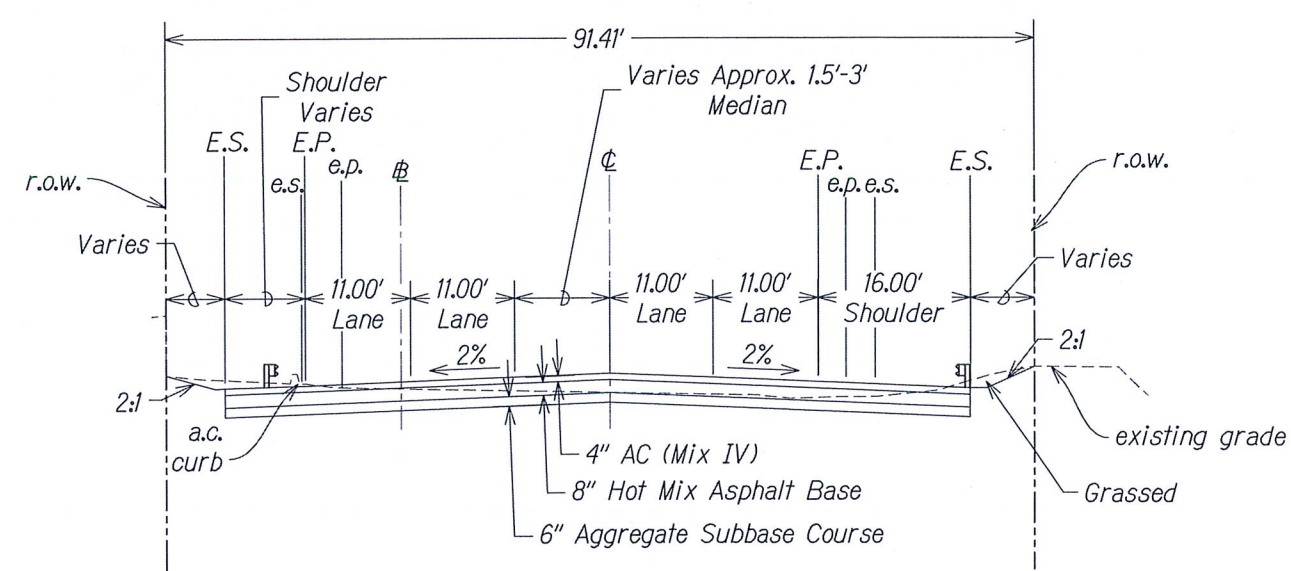

STA. 164+54.94 TO STA. 165+00.10
Scale: 1" = 10'


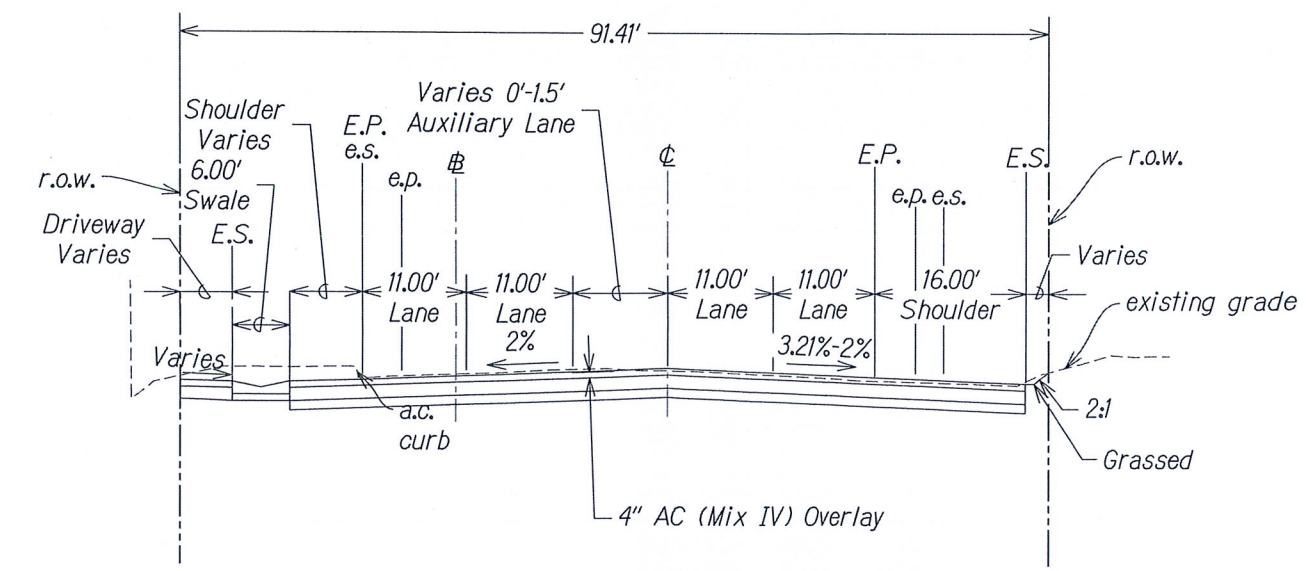


STA. 165+00.10 TO STA. 165+57.18
Scale: 1" = 10'

NOTE:

- For Typical Bridge Section Sta. 163+12.62 to Sta. 164+54.95 See Structural Sheet 57 & 72.
- For Driveway Details, See Sheet 39.

GRAPHICAL SCALE:

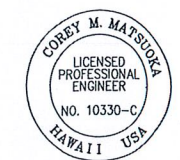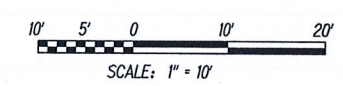


THIS WORK WAS PREPARED BY ME OR UNDER MY SUPERVISION

Corey Matsuzaka
SIGNATURE


4/30/16
EXPIRATION DATE OF THE LICENSE

10/30/15	Changed Subbase Course
DATE	REVISION
STATE OF HAWAII DEPARTMENT OF TRANSPORTATION HIGHWAYS DIVISION	
TYPICAL SECTIONS	
FARRINGTON HIGHWAY Replacement of Maipalaoa Bridge Federal Aid Project No. BR-093-1(21)	
Scale: 1" = 10'	Date: JUNE 2015
SHEET No. 2 OF 2 SHEETS	


BORING No. 1

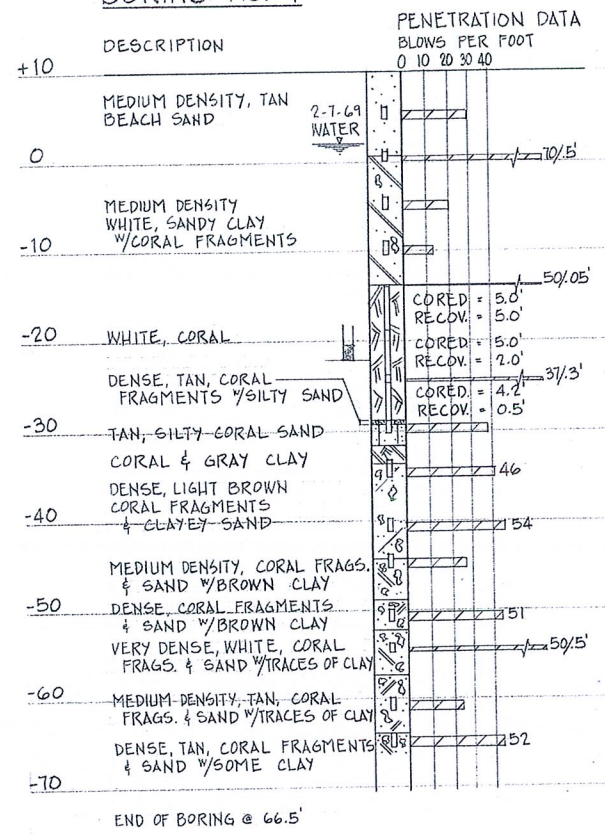


BORING No. 2

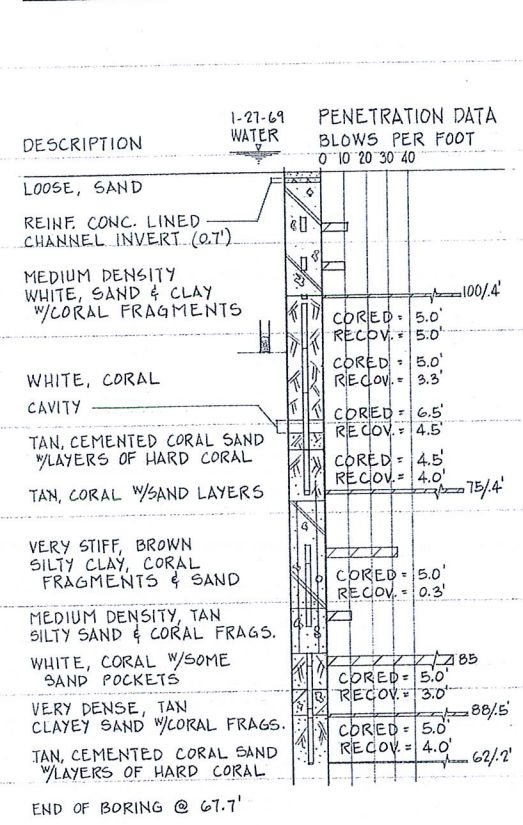


BORING No. 3

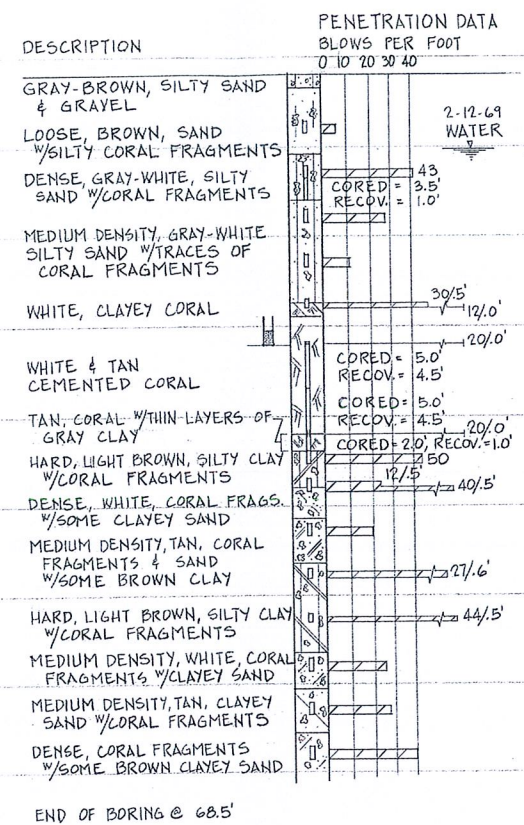

BORING No. 4

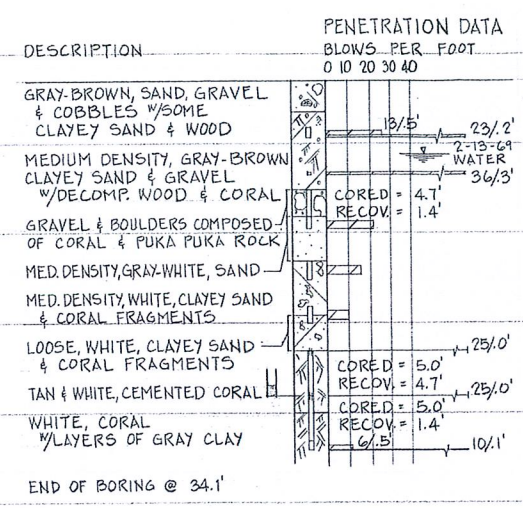

BORING No. 5

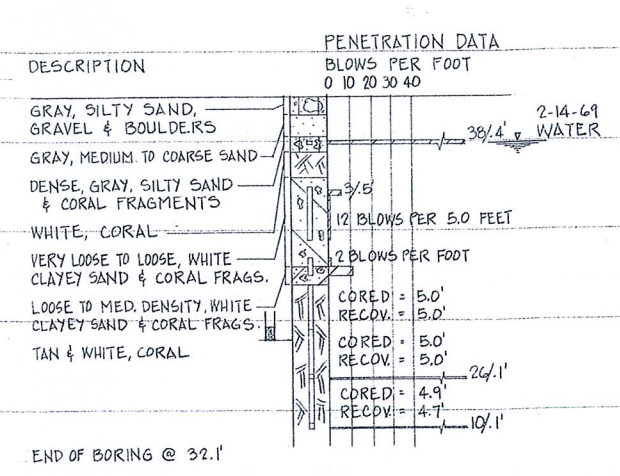

A BORING LOGS

NOTE:
BORING LOGS TAKEN FROM REPORT
PREPARED BY WALTER LUM ASSOCIATES, INC.
"FARRINGTON HIGHWAY WIDENING, MAIPALOA
BRIDGE" DATED FEBRUARY 26, 1969.

LEGEND
H ESTIMATED PILE TIP ELEV.

DATE: _____
SURVEY PLOTTED BY: _____
PLAN: _____
DESIGNED BY: _____
NOTE BOOK: _____
CHECKED BY: _____



THIS WORK WAS PREPARED BY
ME OR UNDER MY SUPERVISION
WALTER LUM ASSOCIATES, INC.
E. K. Waterhouse

STATE OF HAWAII
DEPARTMENT OF TRANSPORTATION
HIGHWAYS DIVISION
MAIPALOA
MAIPALOA BRIDGE WIDENING
BORING LOGS
FARRINGTON HIGHWAY WIDENING
PROJECT 900B-02-68
UNIT 2
SCALE: AS NOTED
SHEET No. 6 OF 7 SHEETS