

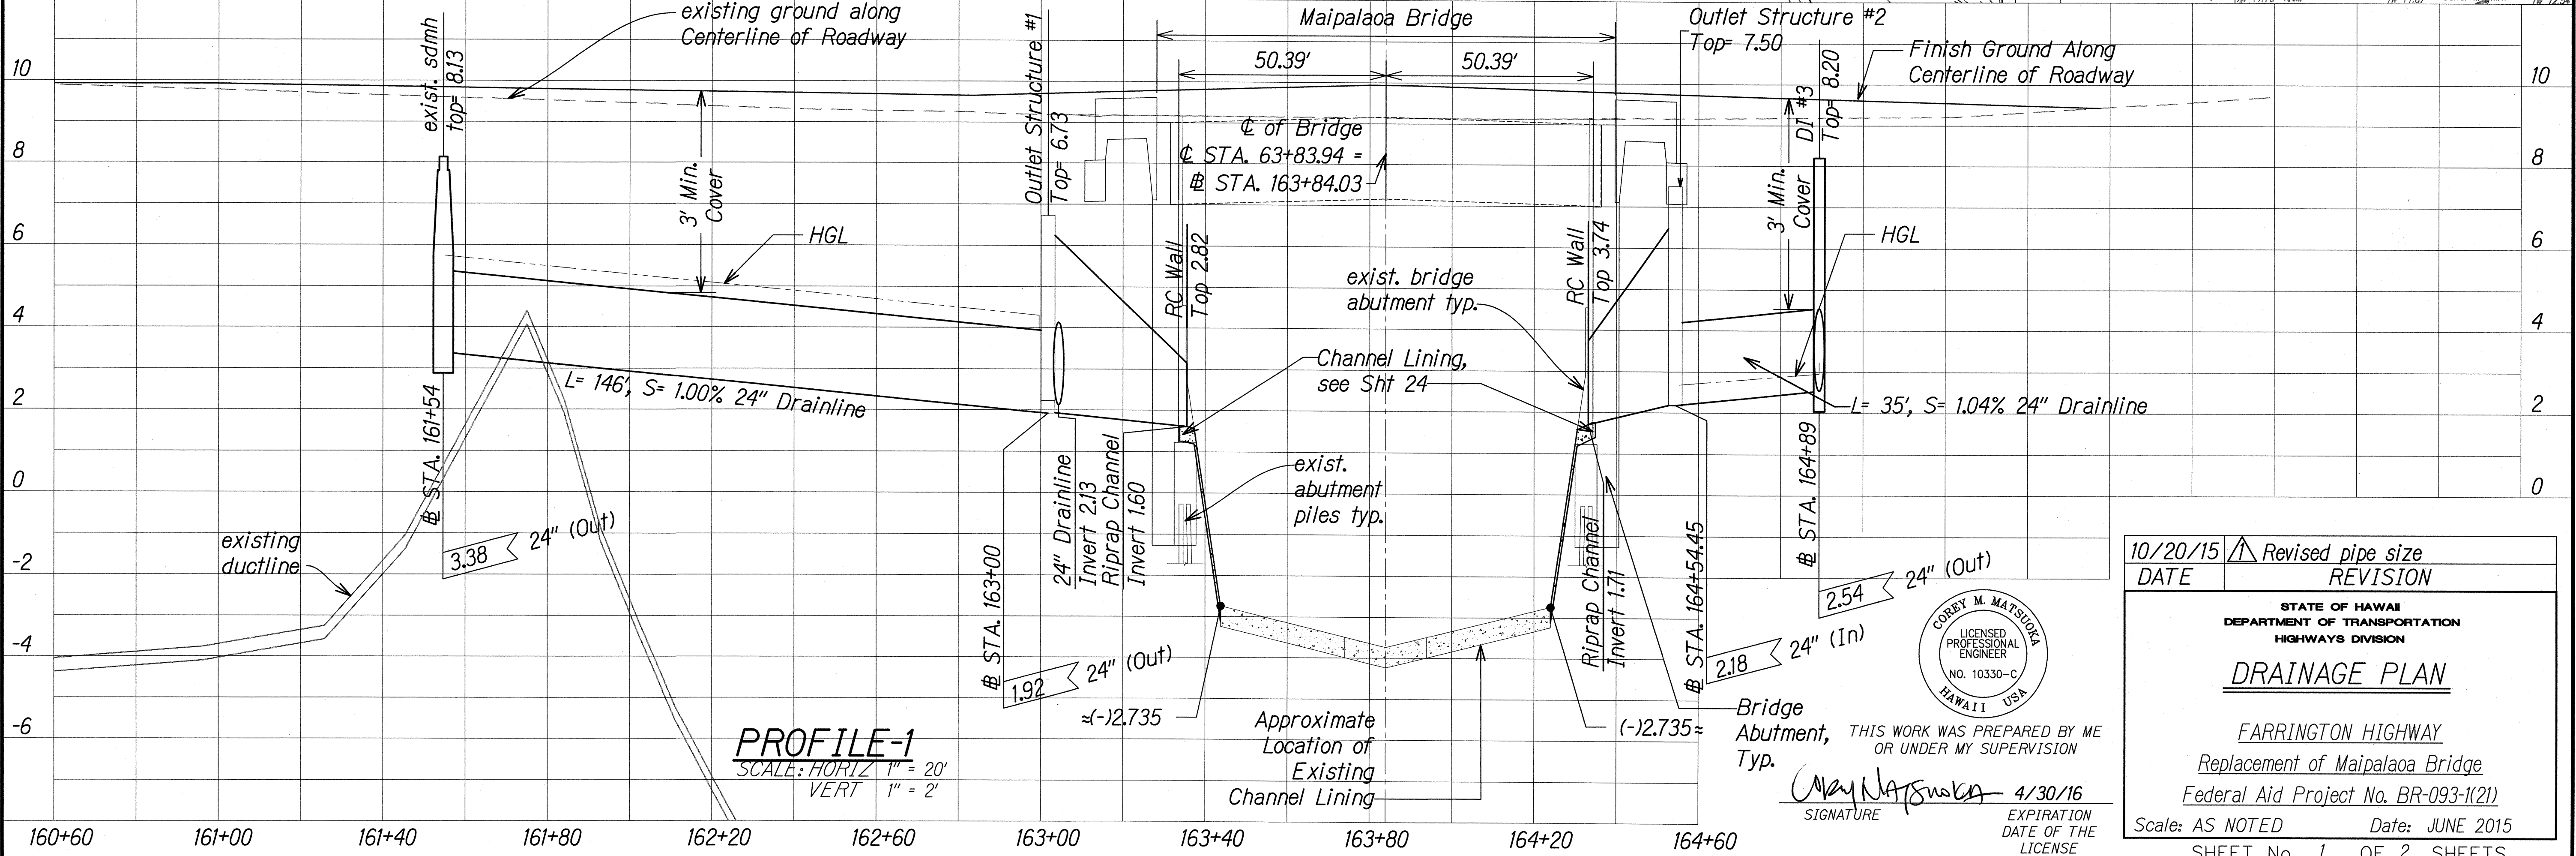


FED. ROAD DIST. NO.	STATE	FED. AID PROJ. NO.	FISCAL YEAR	SHEET NO.	TOTAL SHEETS
HAWAII	HAW.	BR-093-1(21)	2015	34	99

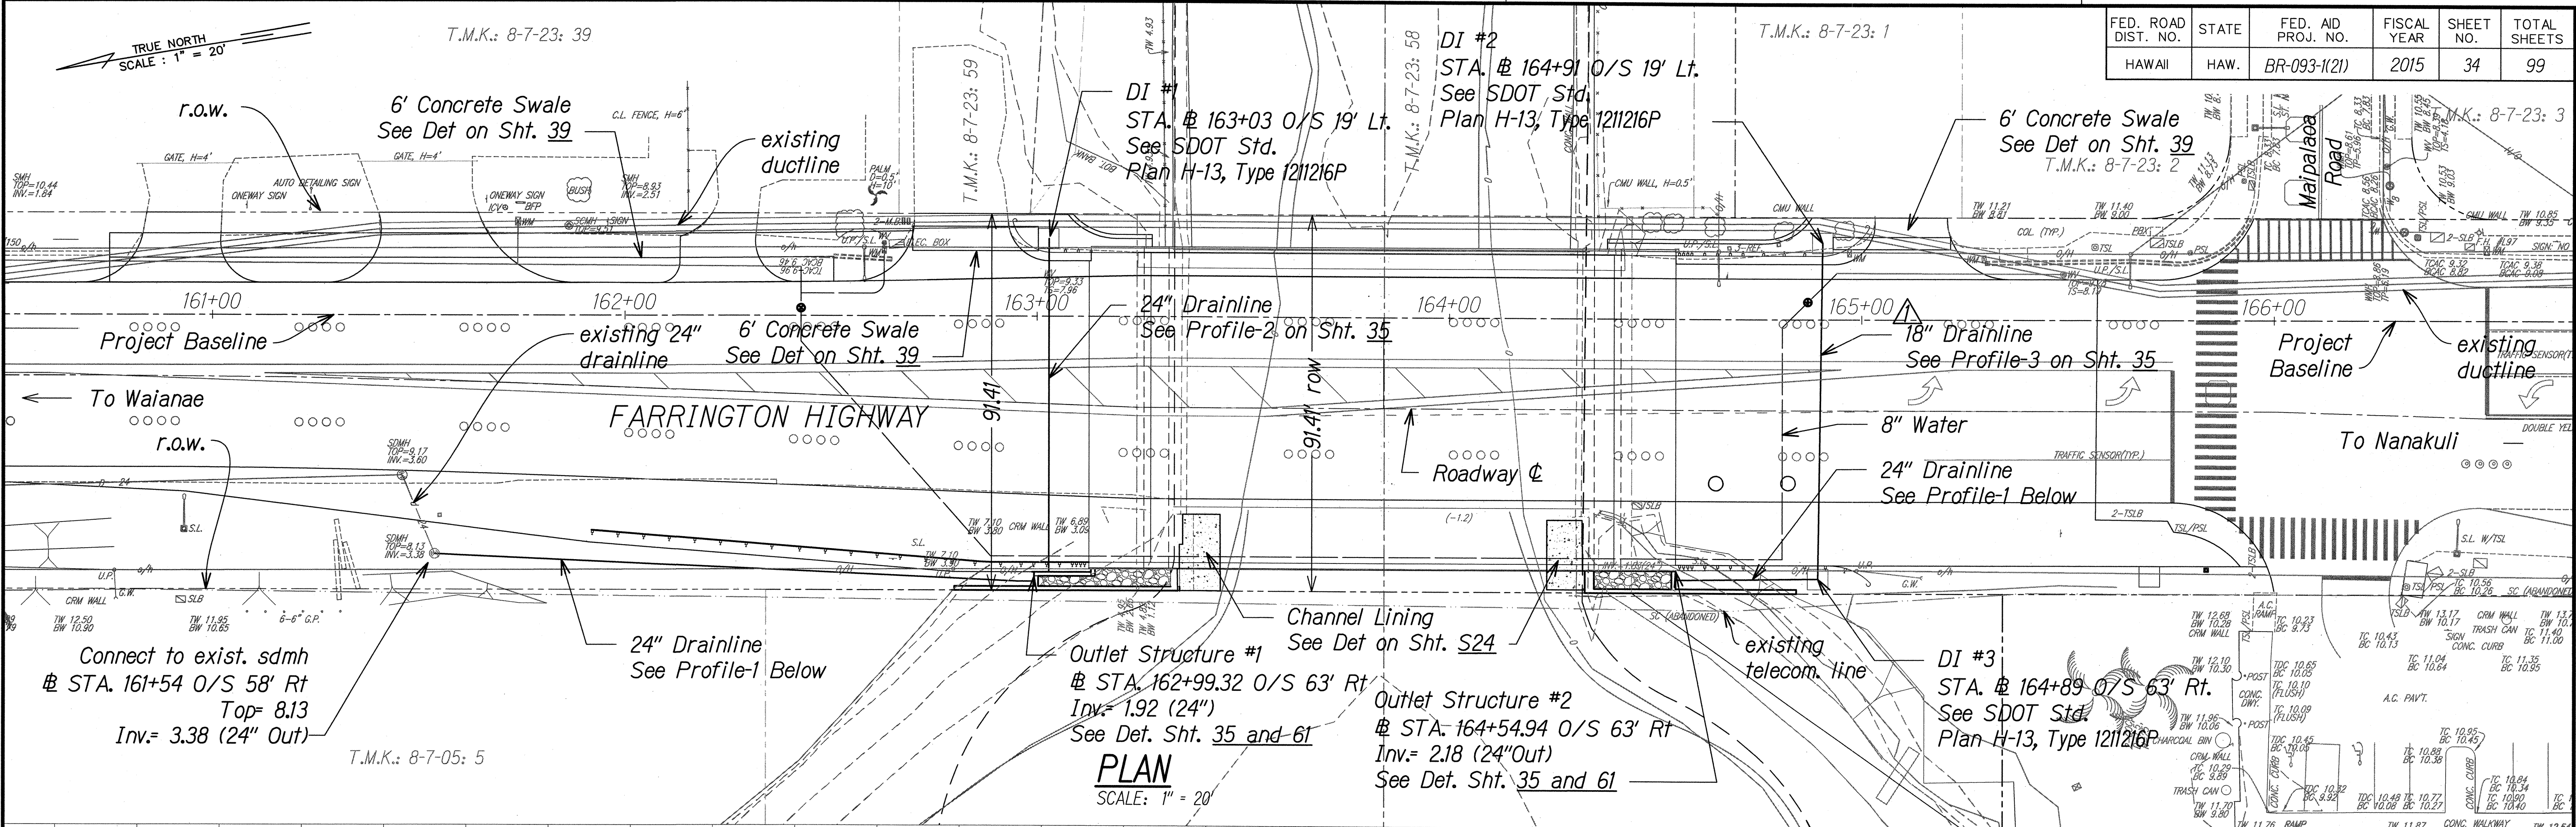


10/20/15	Revised pipe size
DATE	REVISION
STATE OF HAWAII DEPARTMENT OF TRANSPORTATION HIGHWAYS DIVISION	
DRAINAGE PLAN	
FARRINGTON HIGHWAY Replacement of Maipalaoa Bridge Federal Aid Project No. BR-093-1(21)	
Scale: AS NOTED	Date: JUNE 2015
SHEET No. 1 OF 2 SHEETS	

GRAPHICAL SCALE:

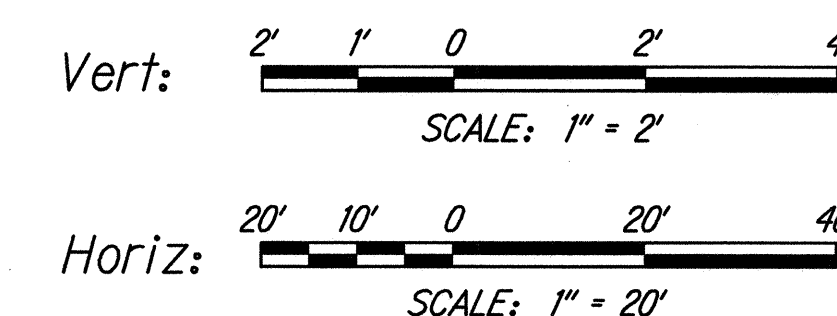


NOTE:


1. For Typical Trench Detail, See Detail Sheet 38

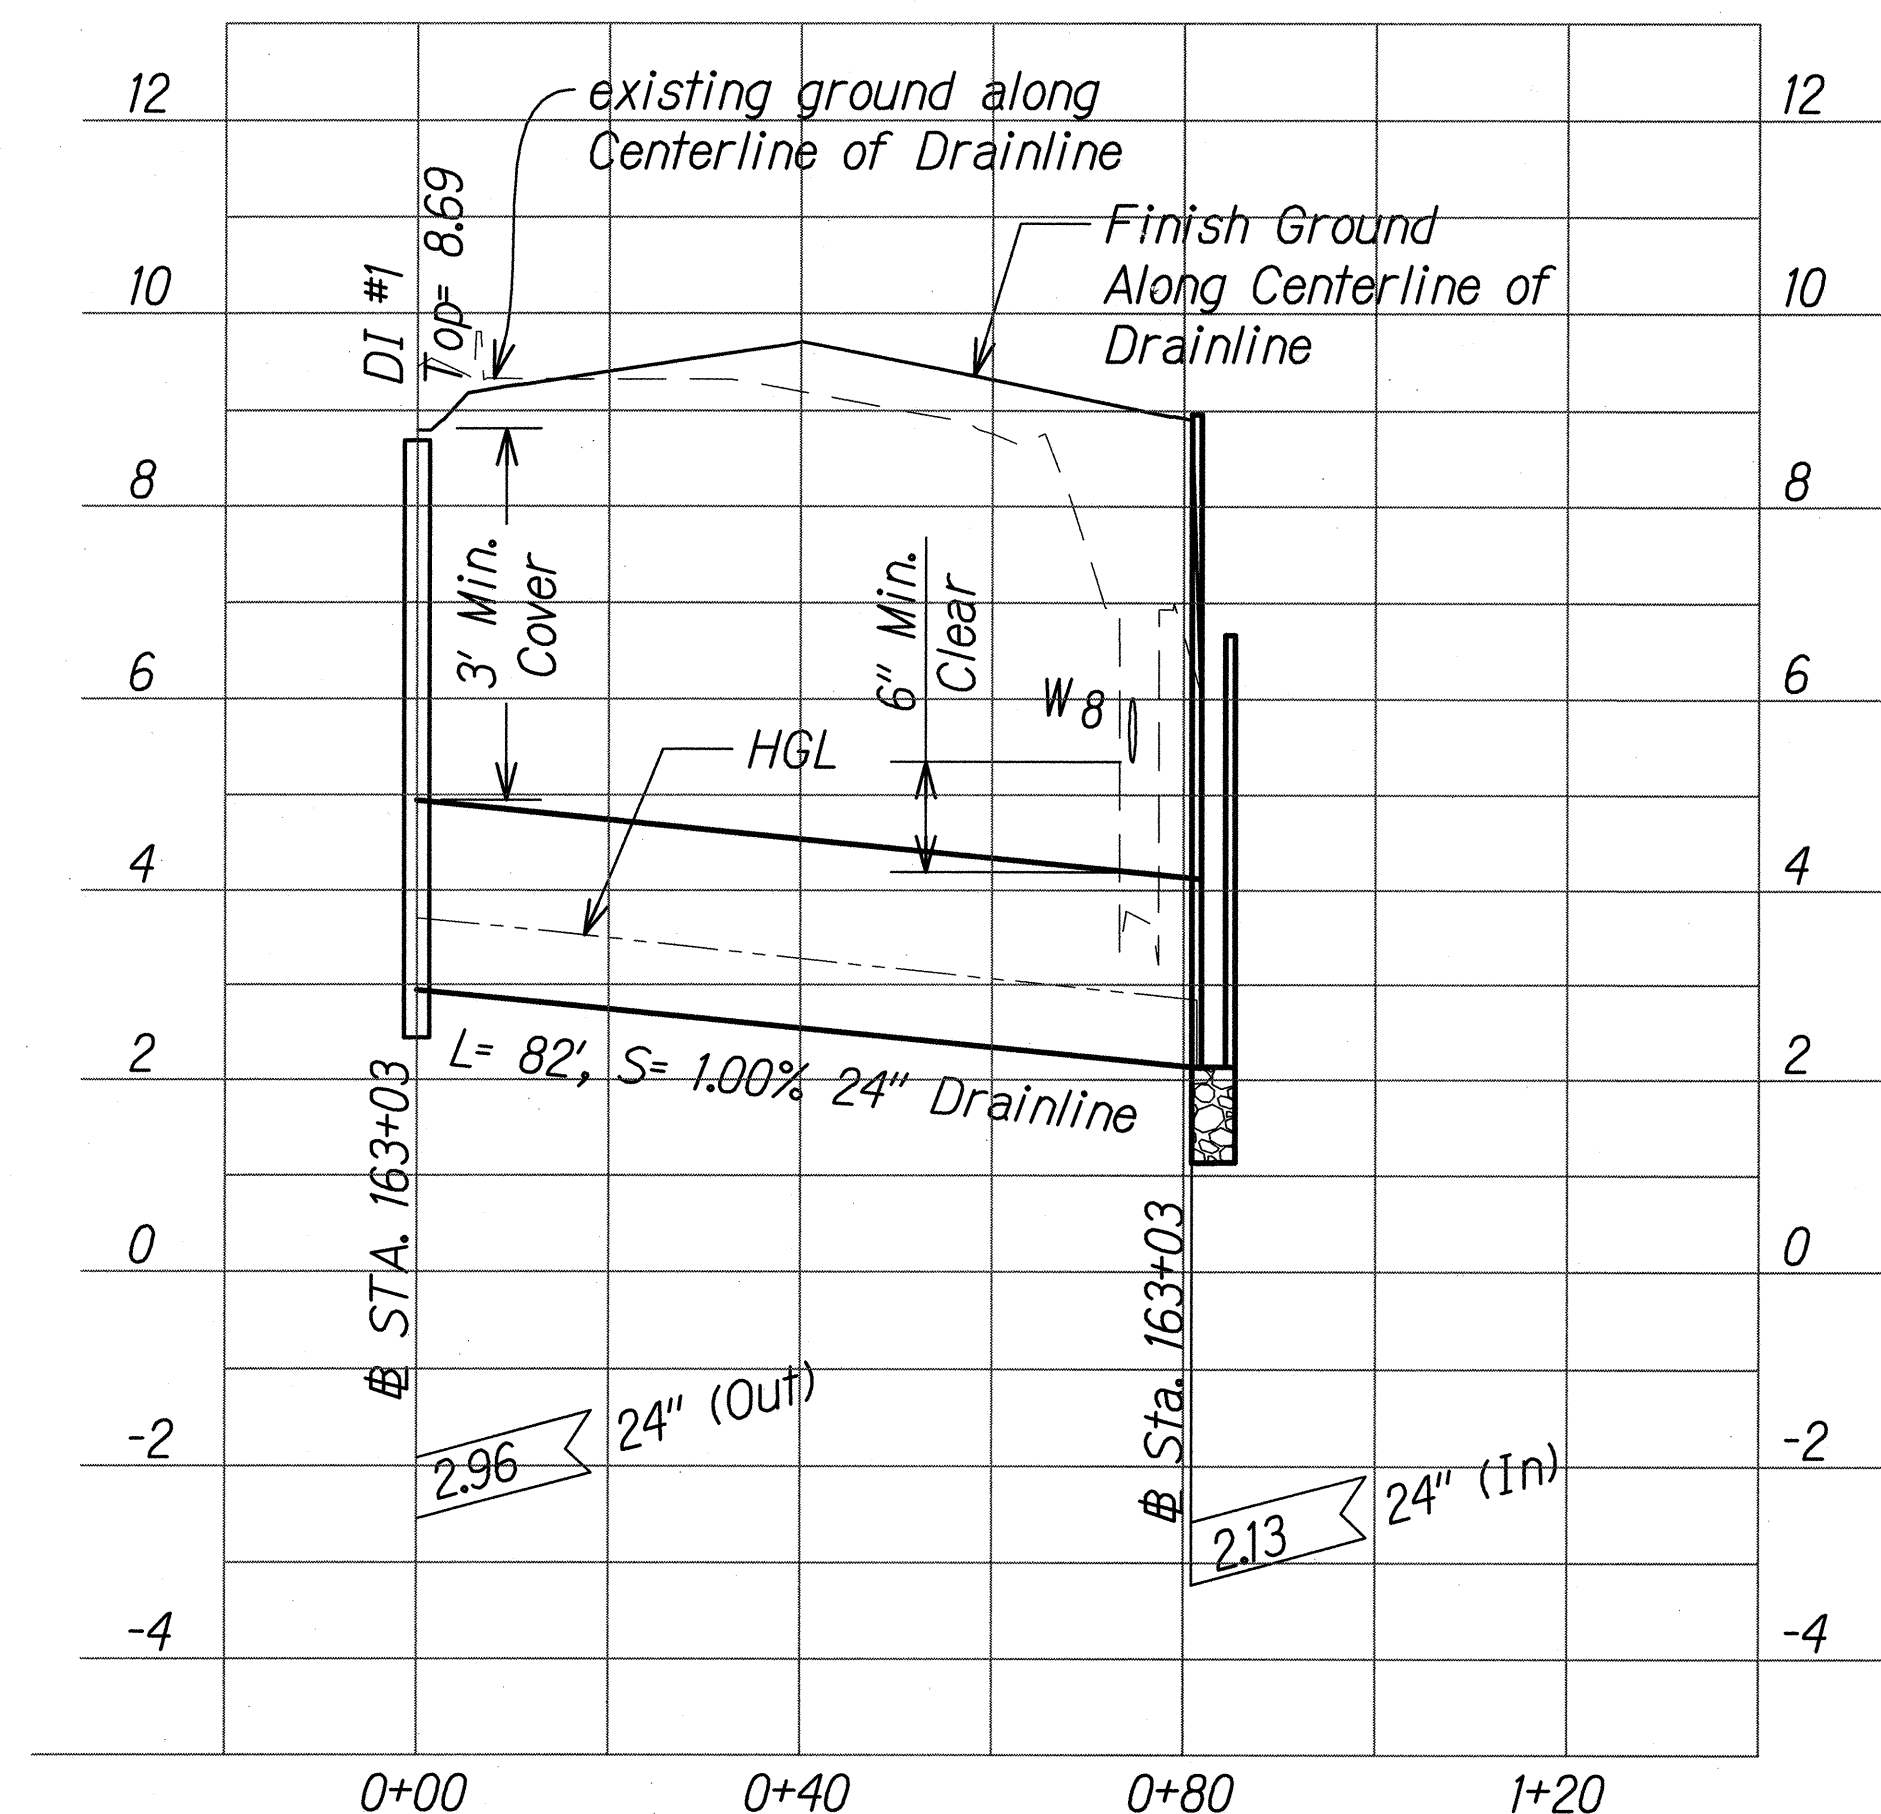


PROFILE-2
SCALE: HORIZ 1" = 20'
VERT 1" = 2'

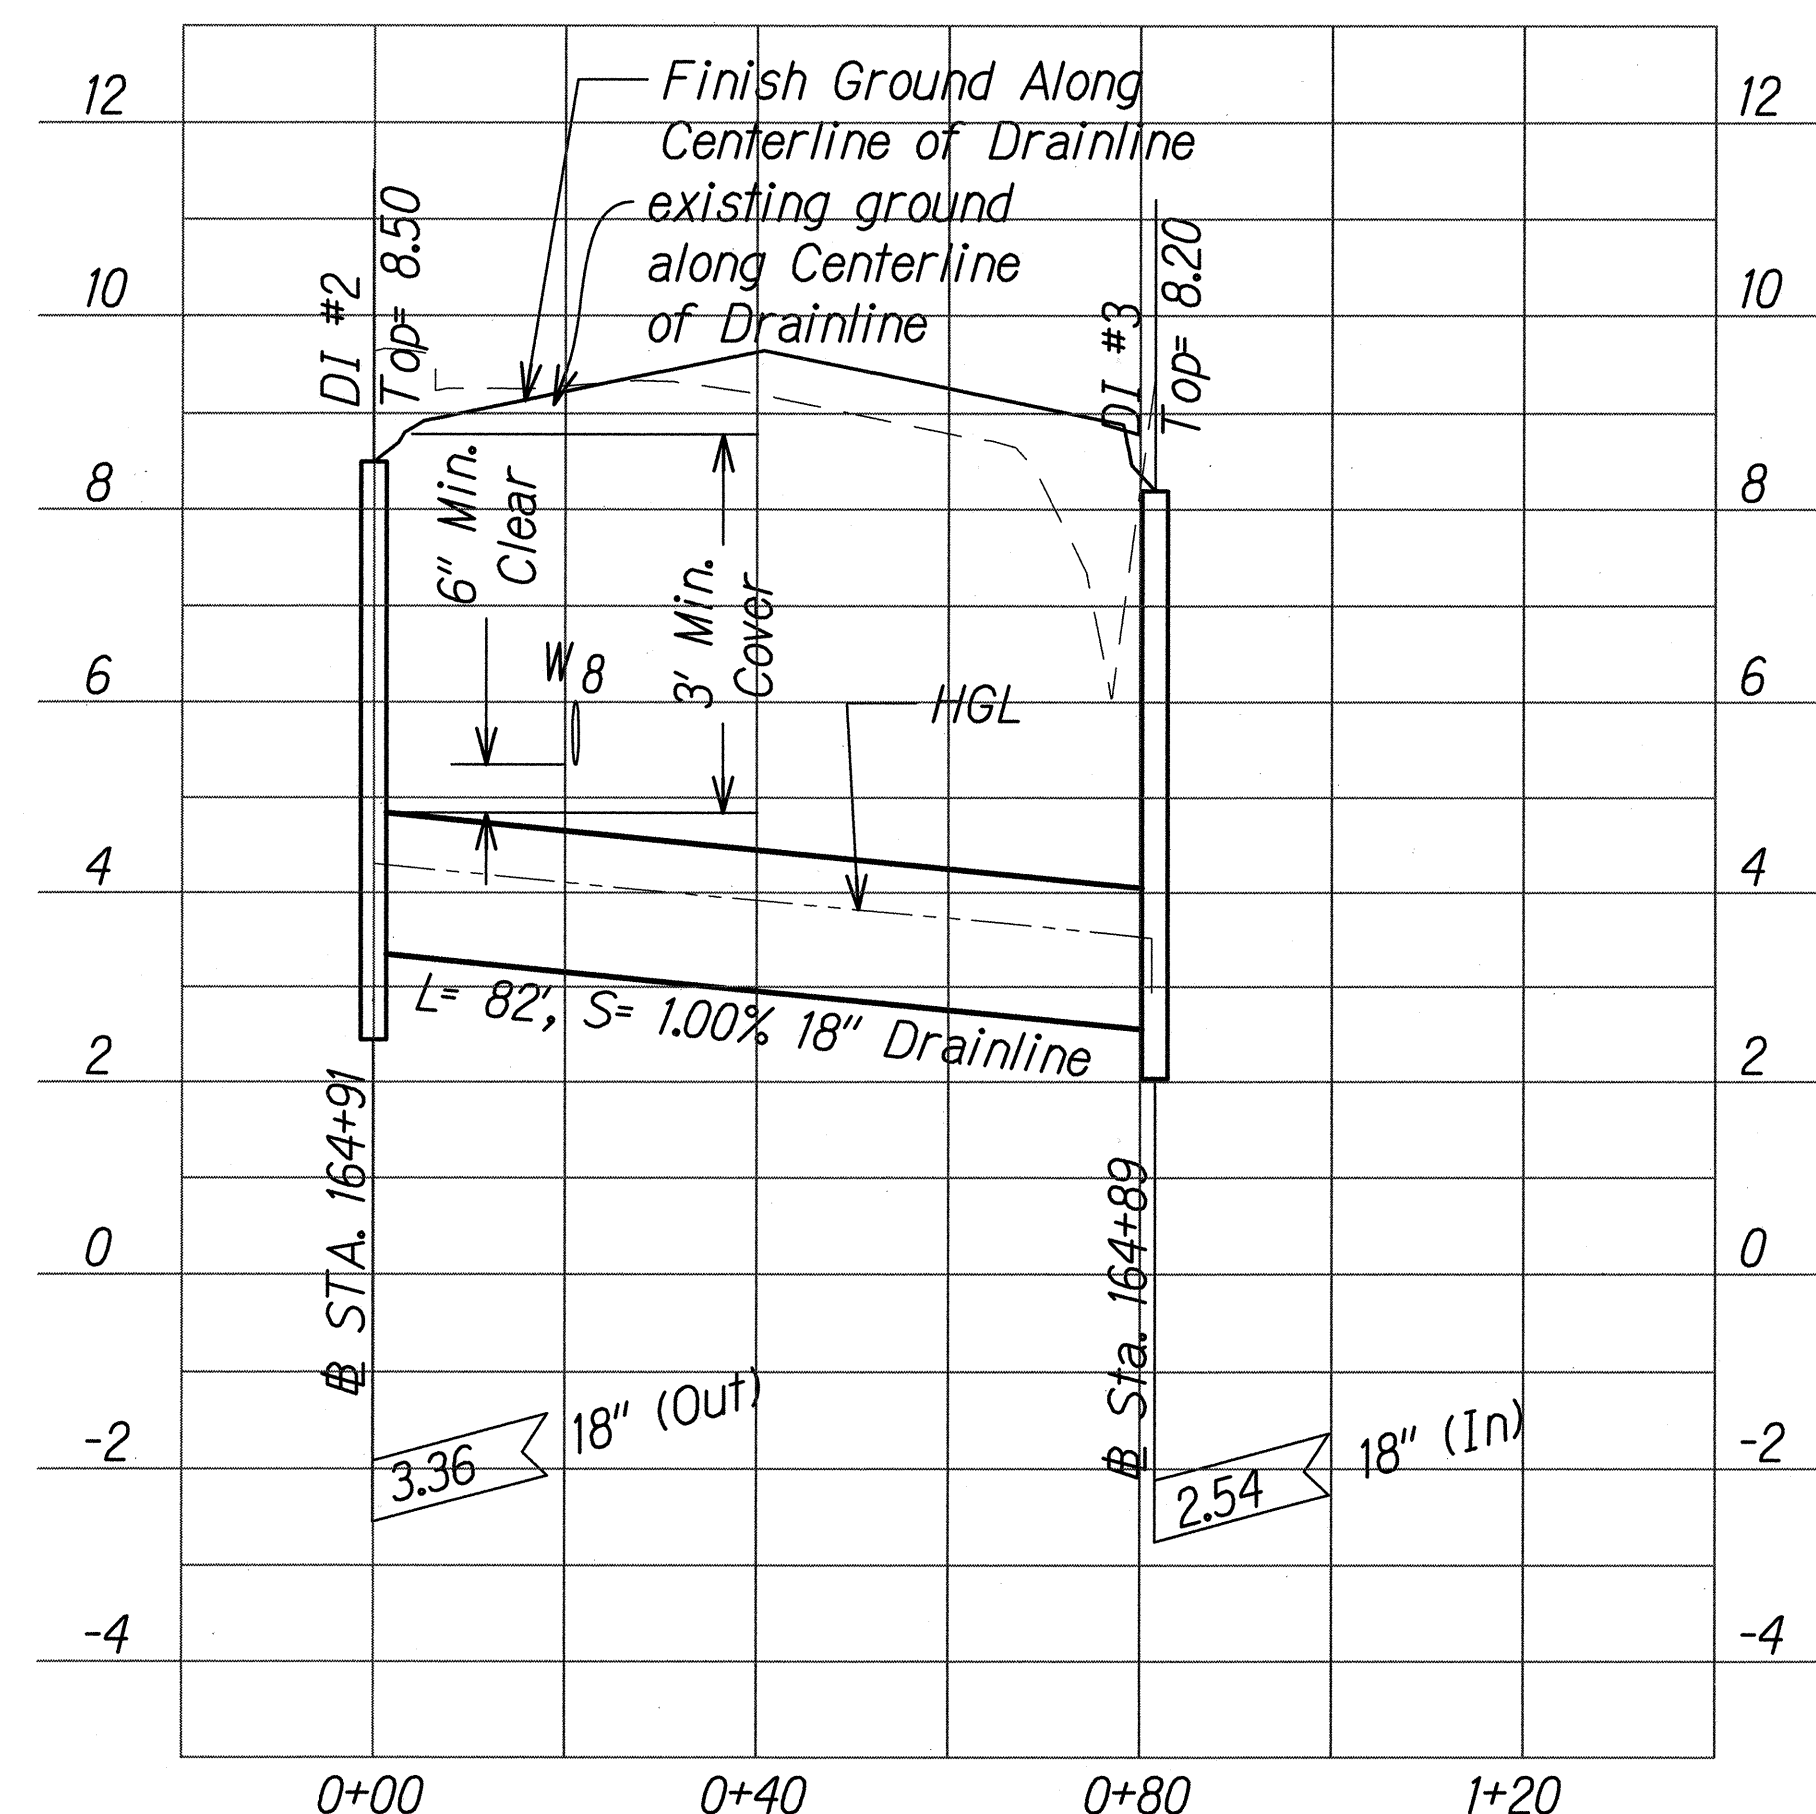

PROFILE-3
SCALE: HORIZ 1" = 20'
VERT 1" = 2'

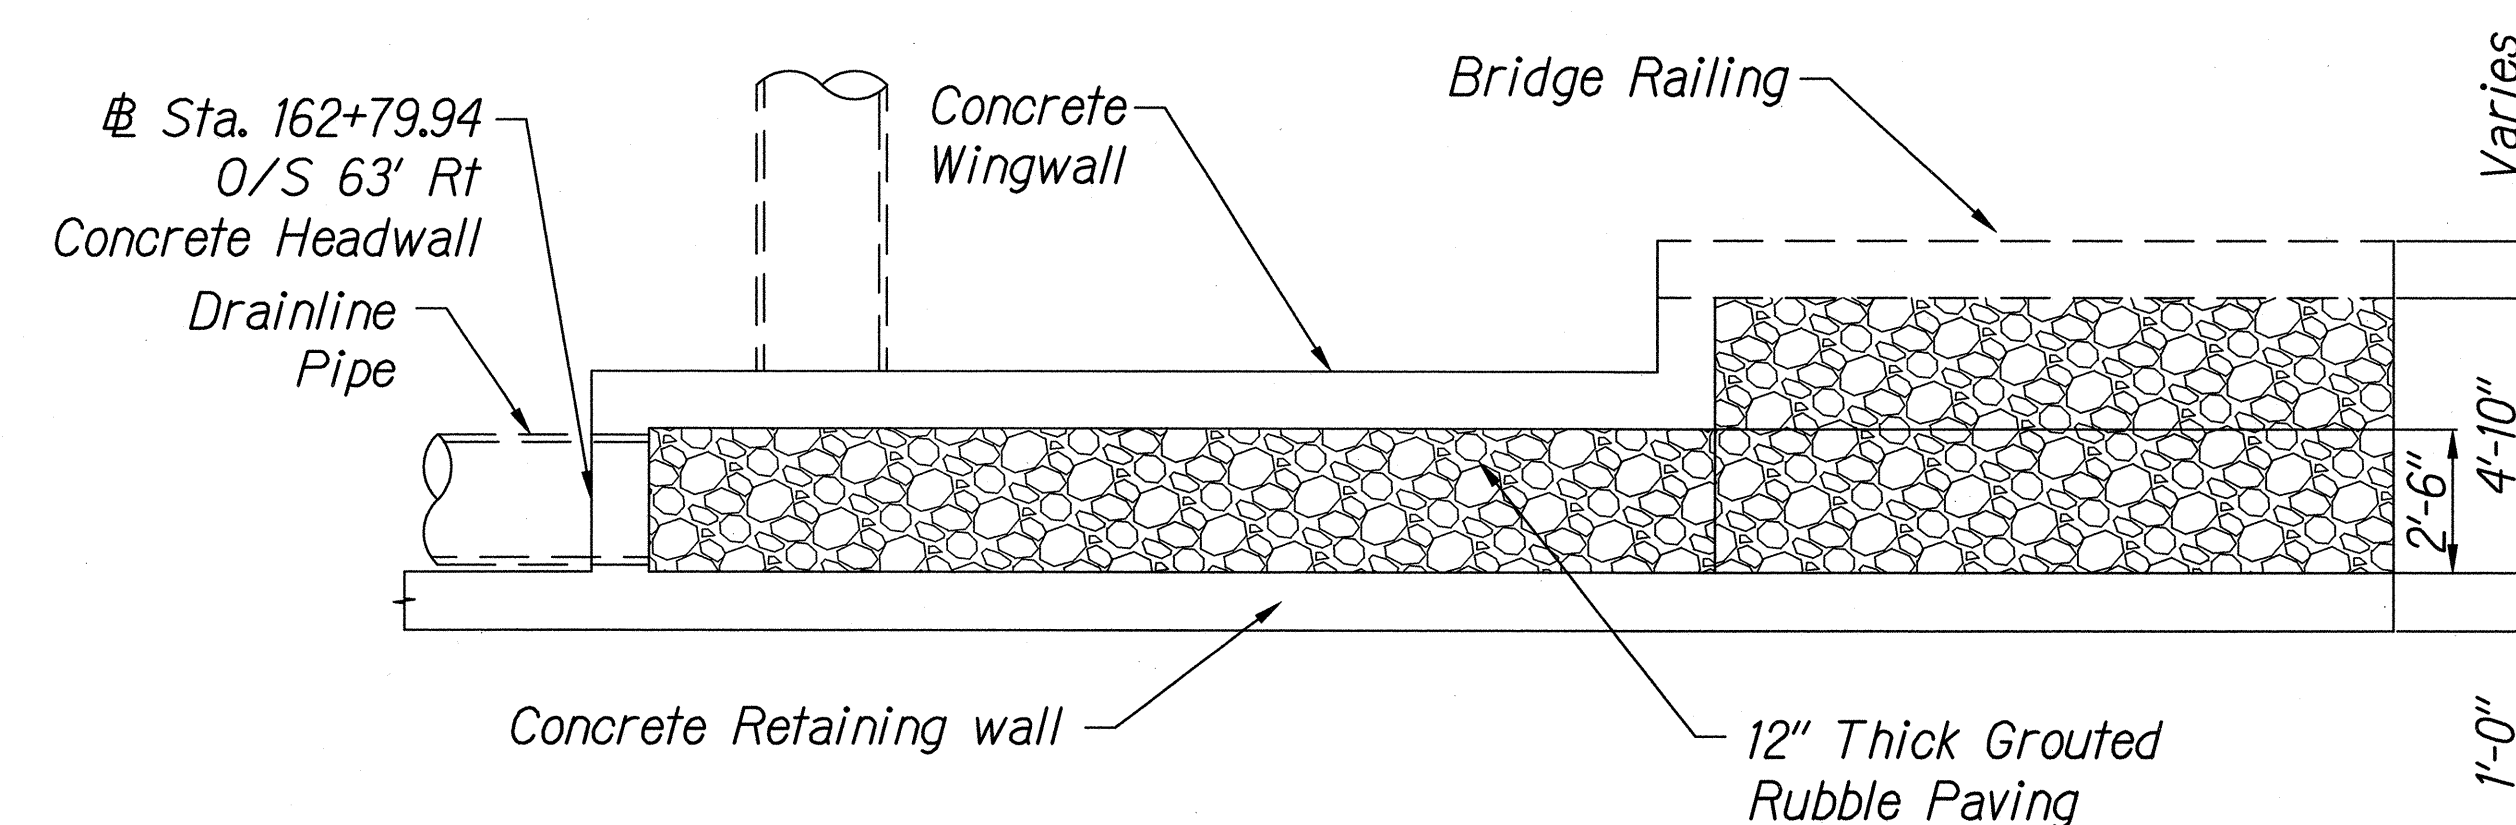


OUTLET STRUCTURE #1 - NORTH SIDE
Scale: N.T.S.

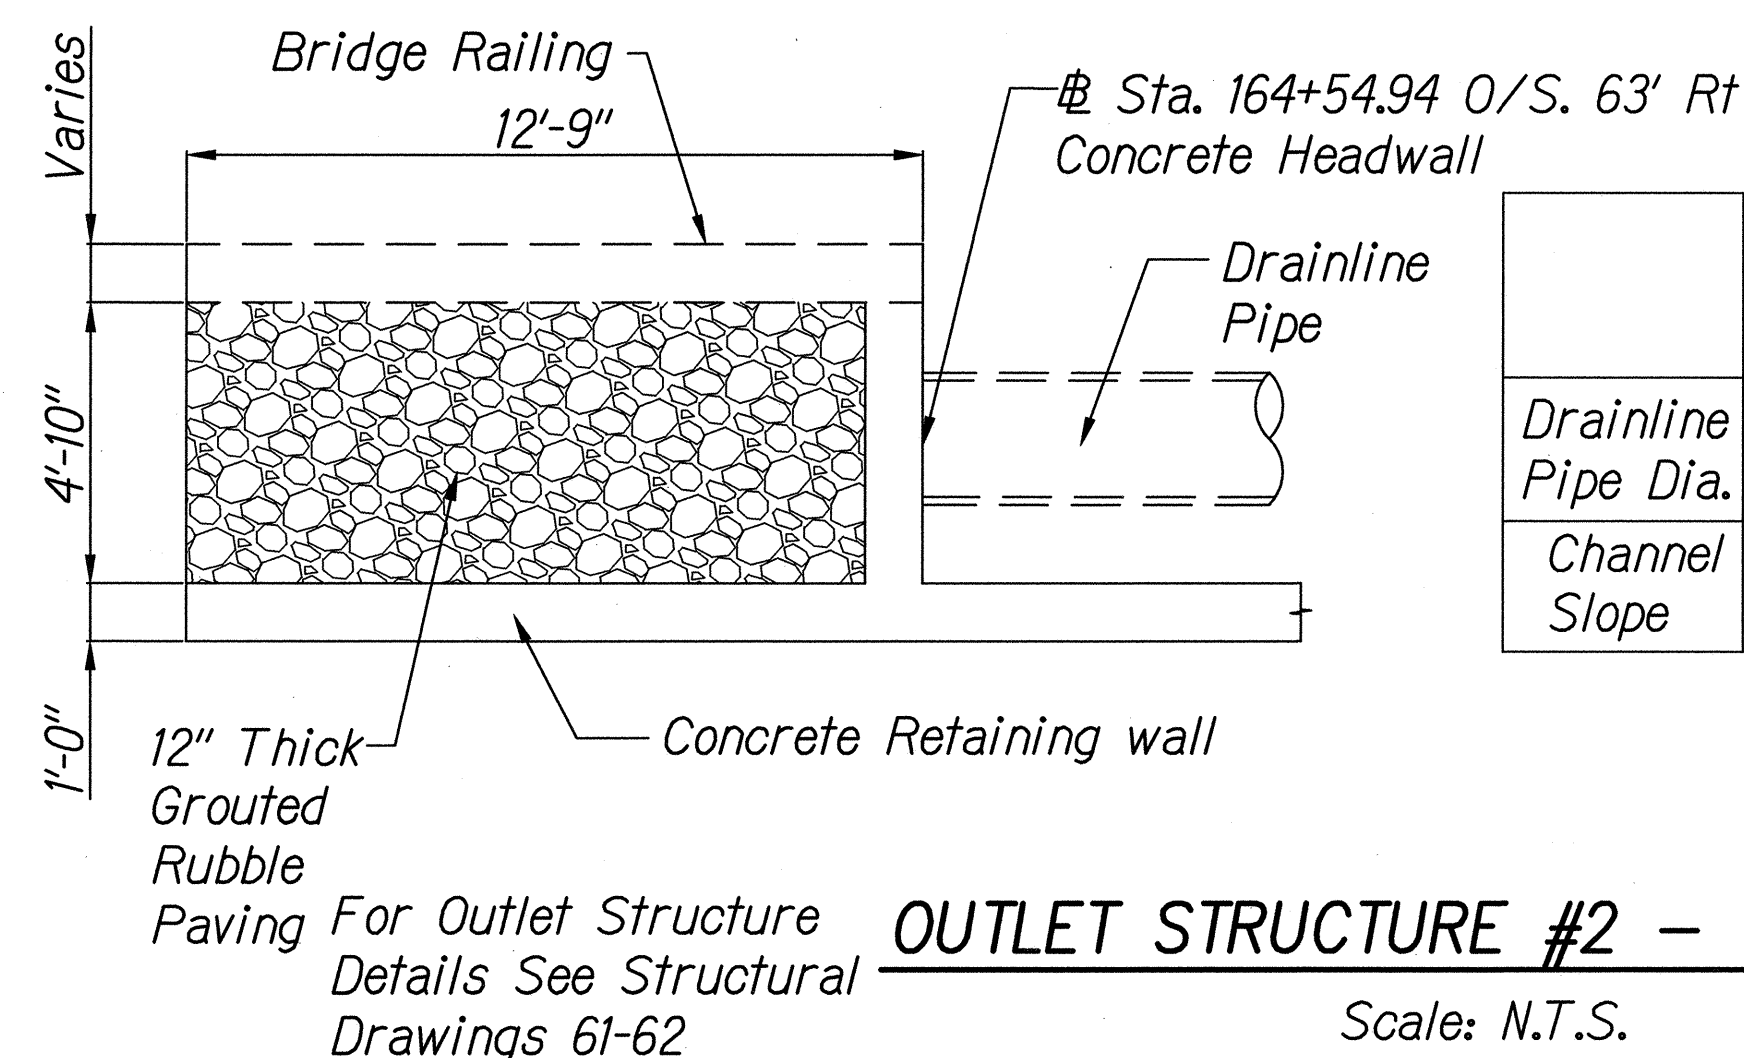

OUTLET STRUCTURE #2 - SOUTH SIDE
Scale: N.T.S.

NOTE:

1. Contractor to Field Bend Rebar in Detail 4/S-12 As Needed.

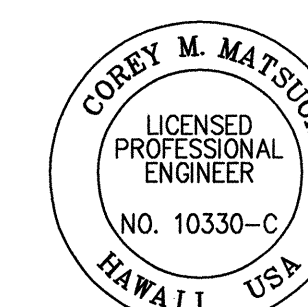

THIS WORK WAS PREPARED BY ME OR UNDER MY SUPERVISION

Corey Matsuda
SIGNATURE

4/30/16
EXPIRATION DATE OF THE LICENSE