



FED. ROAD DIST. NO.	STATE	FED. AID PROJ. NO.	FISCAL YEAR	SHEET NO.	TOTAL SHEETS
HAWAII	HAW.	BR-093-1(21)	2015	18	99

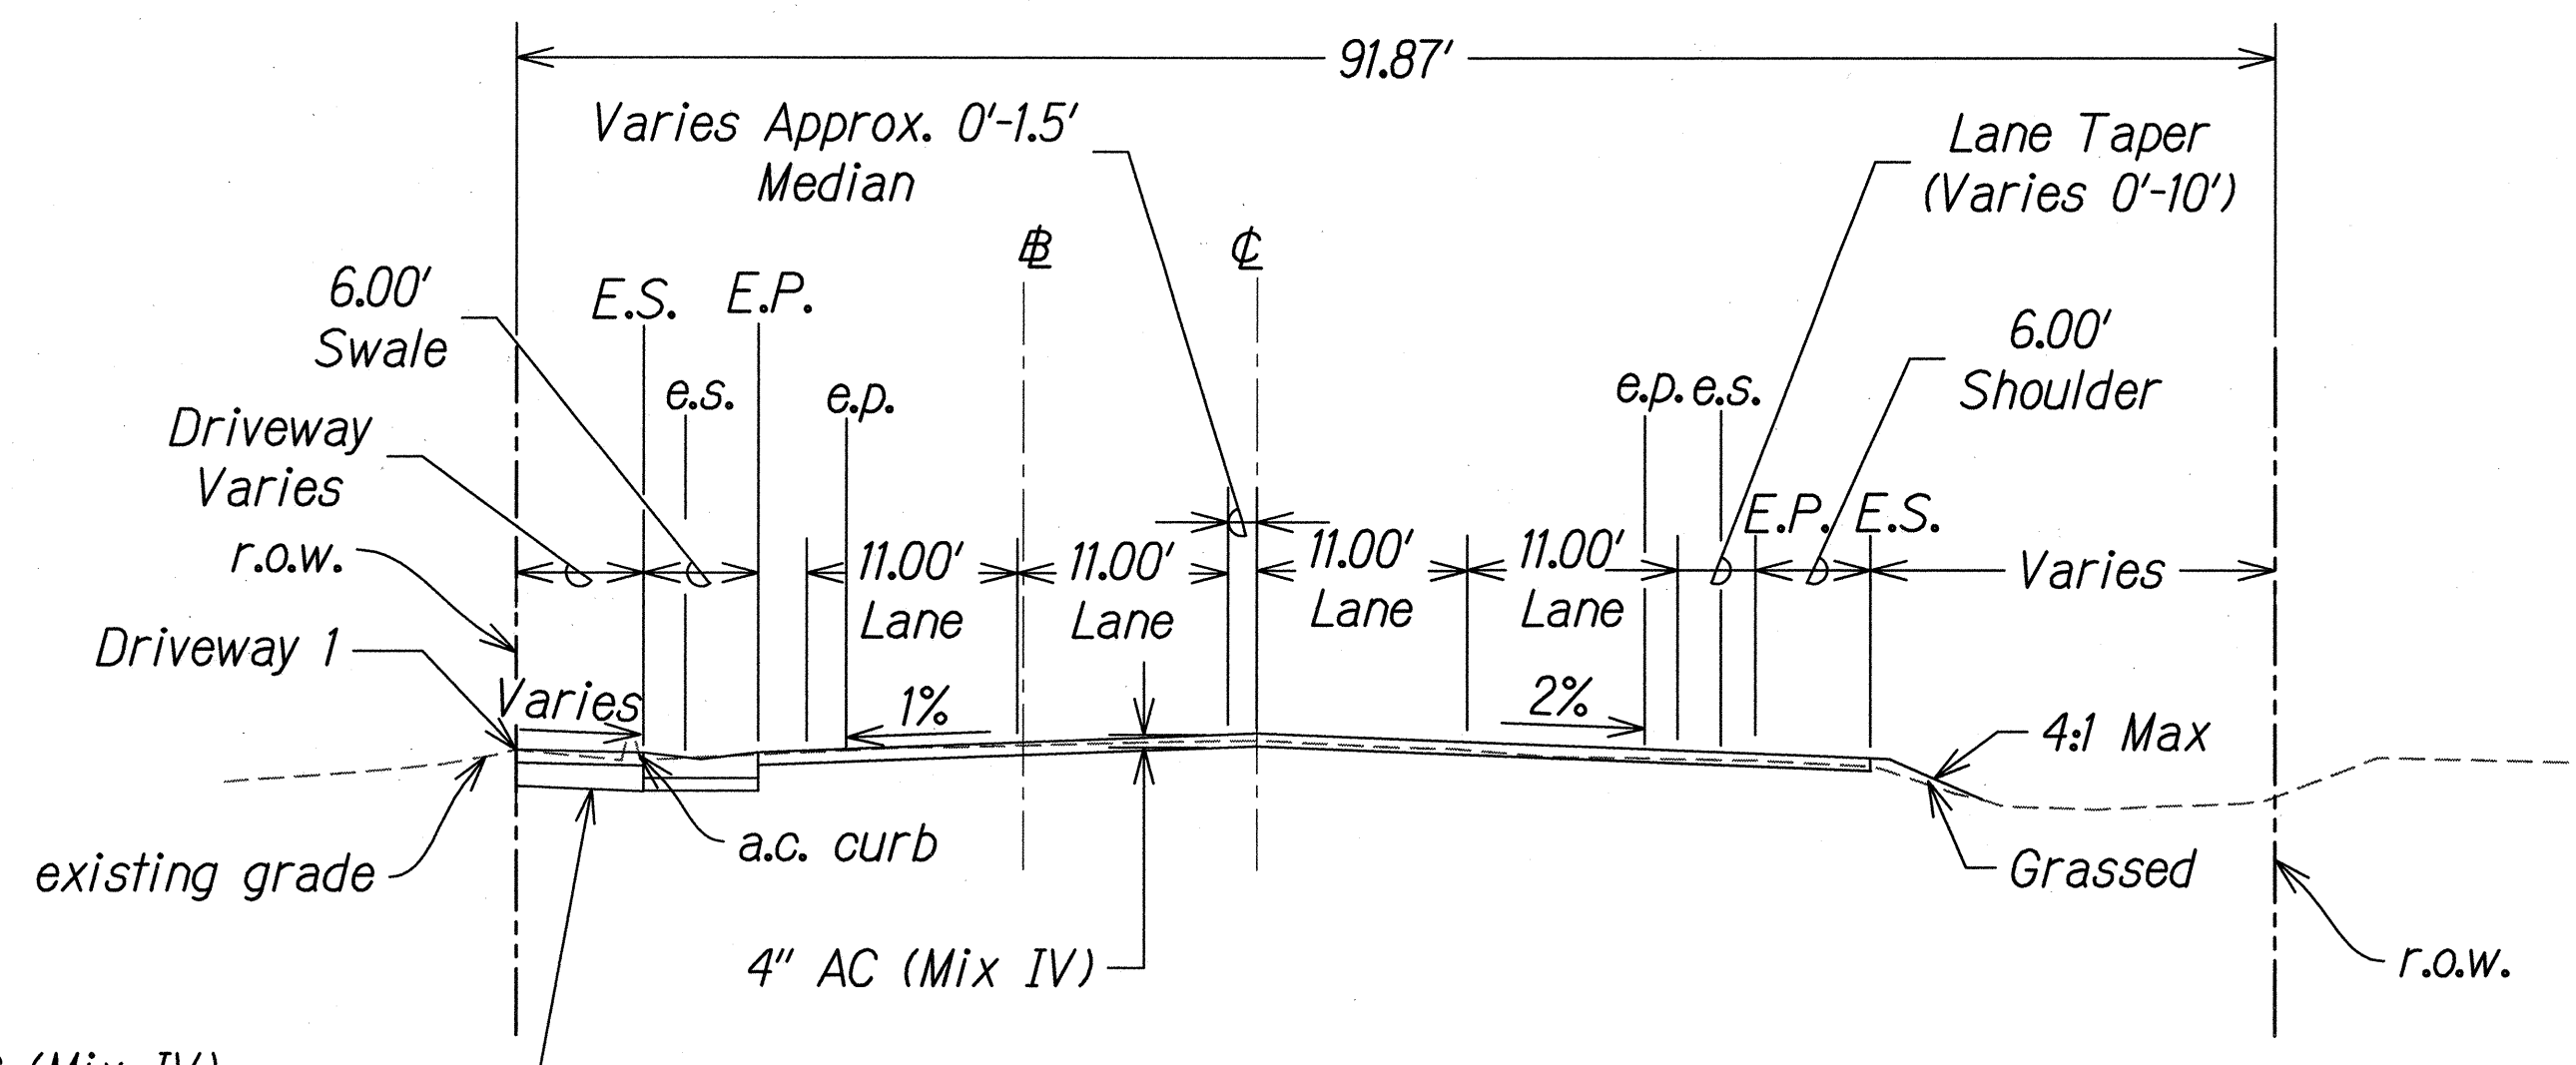


2" AC (Mix IV)
6" Hot Mix Asphalt Base
(Typical all Driveway
Pavement Sections)


STA. 160+50.22 TO STA. 161+00.10
Scale: 1" = 10'

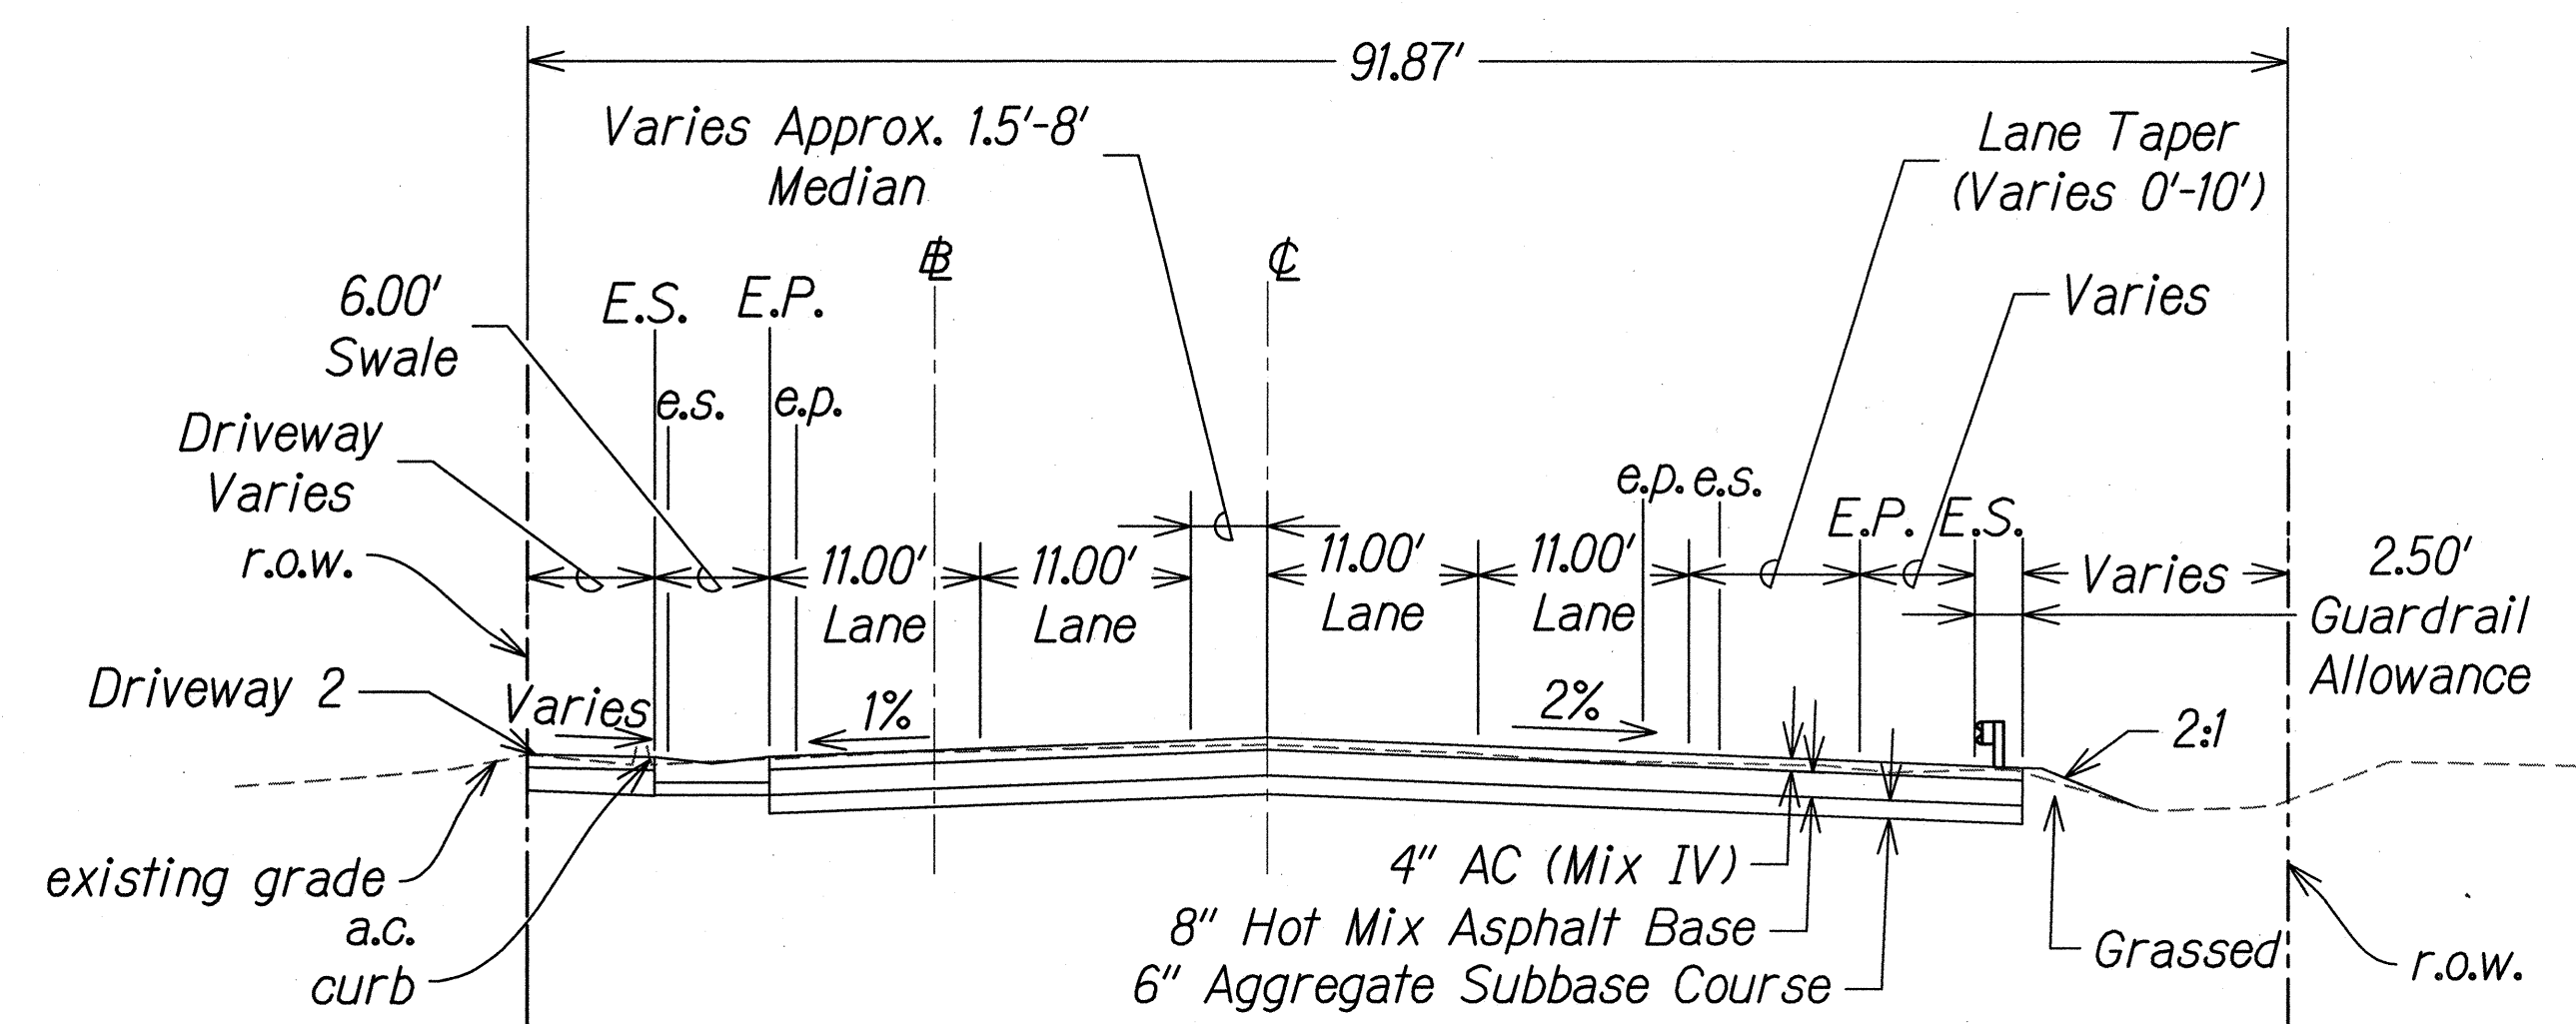

STA. 161+00.10 TO STA. 162+50
Scale: 1" = 10'

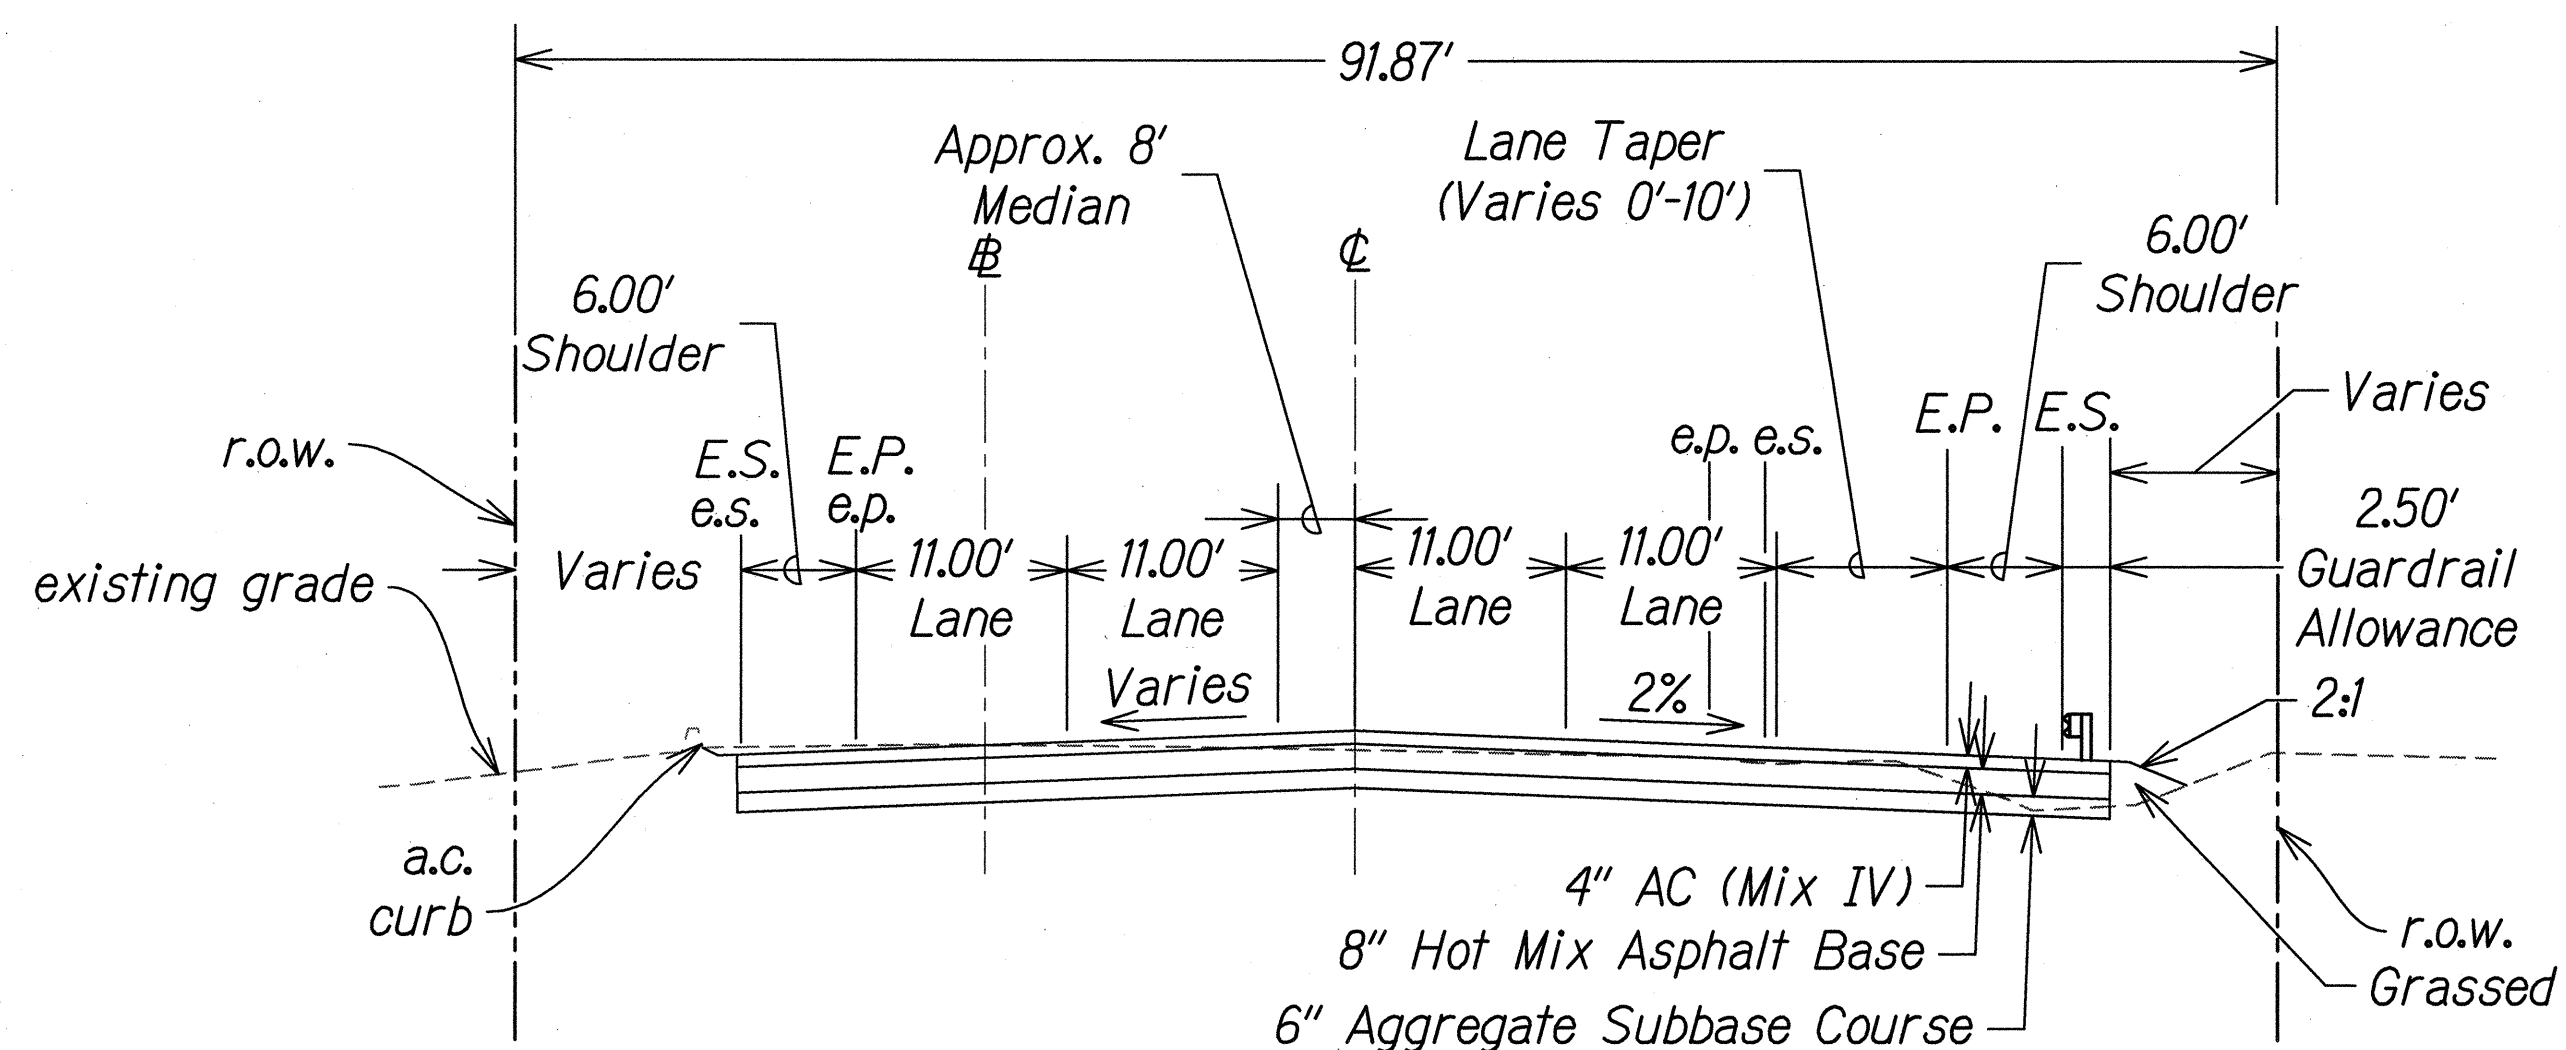

STA. 162+50 TO STA. 162+62
Scale: 1" = 10'


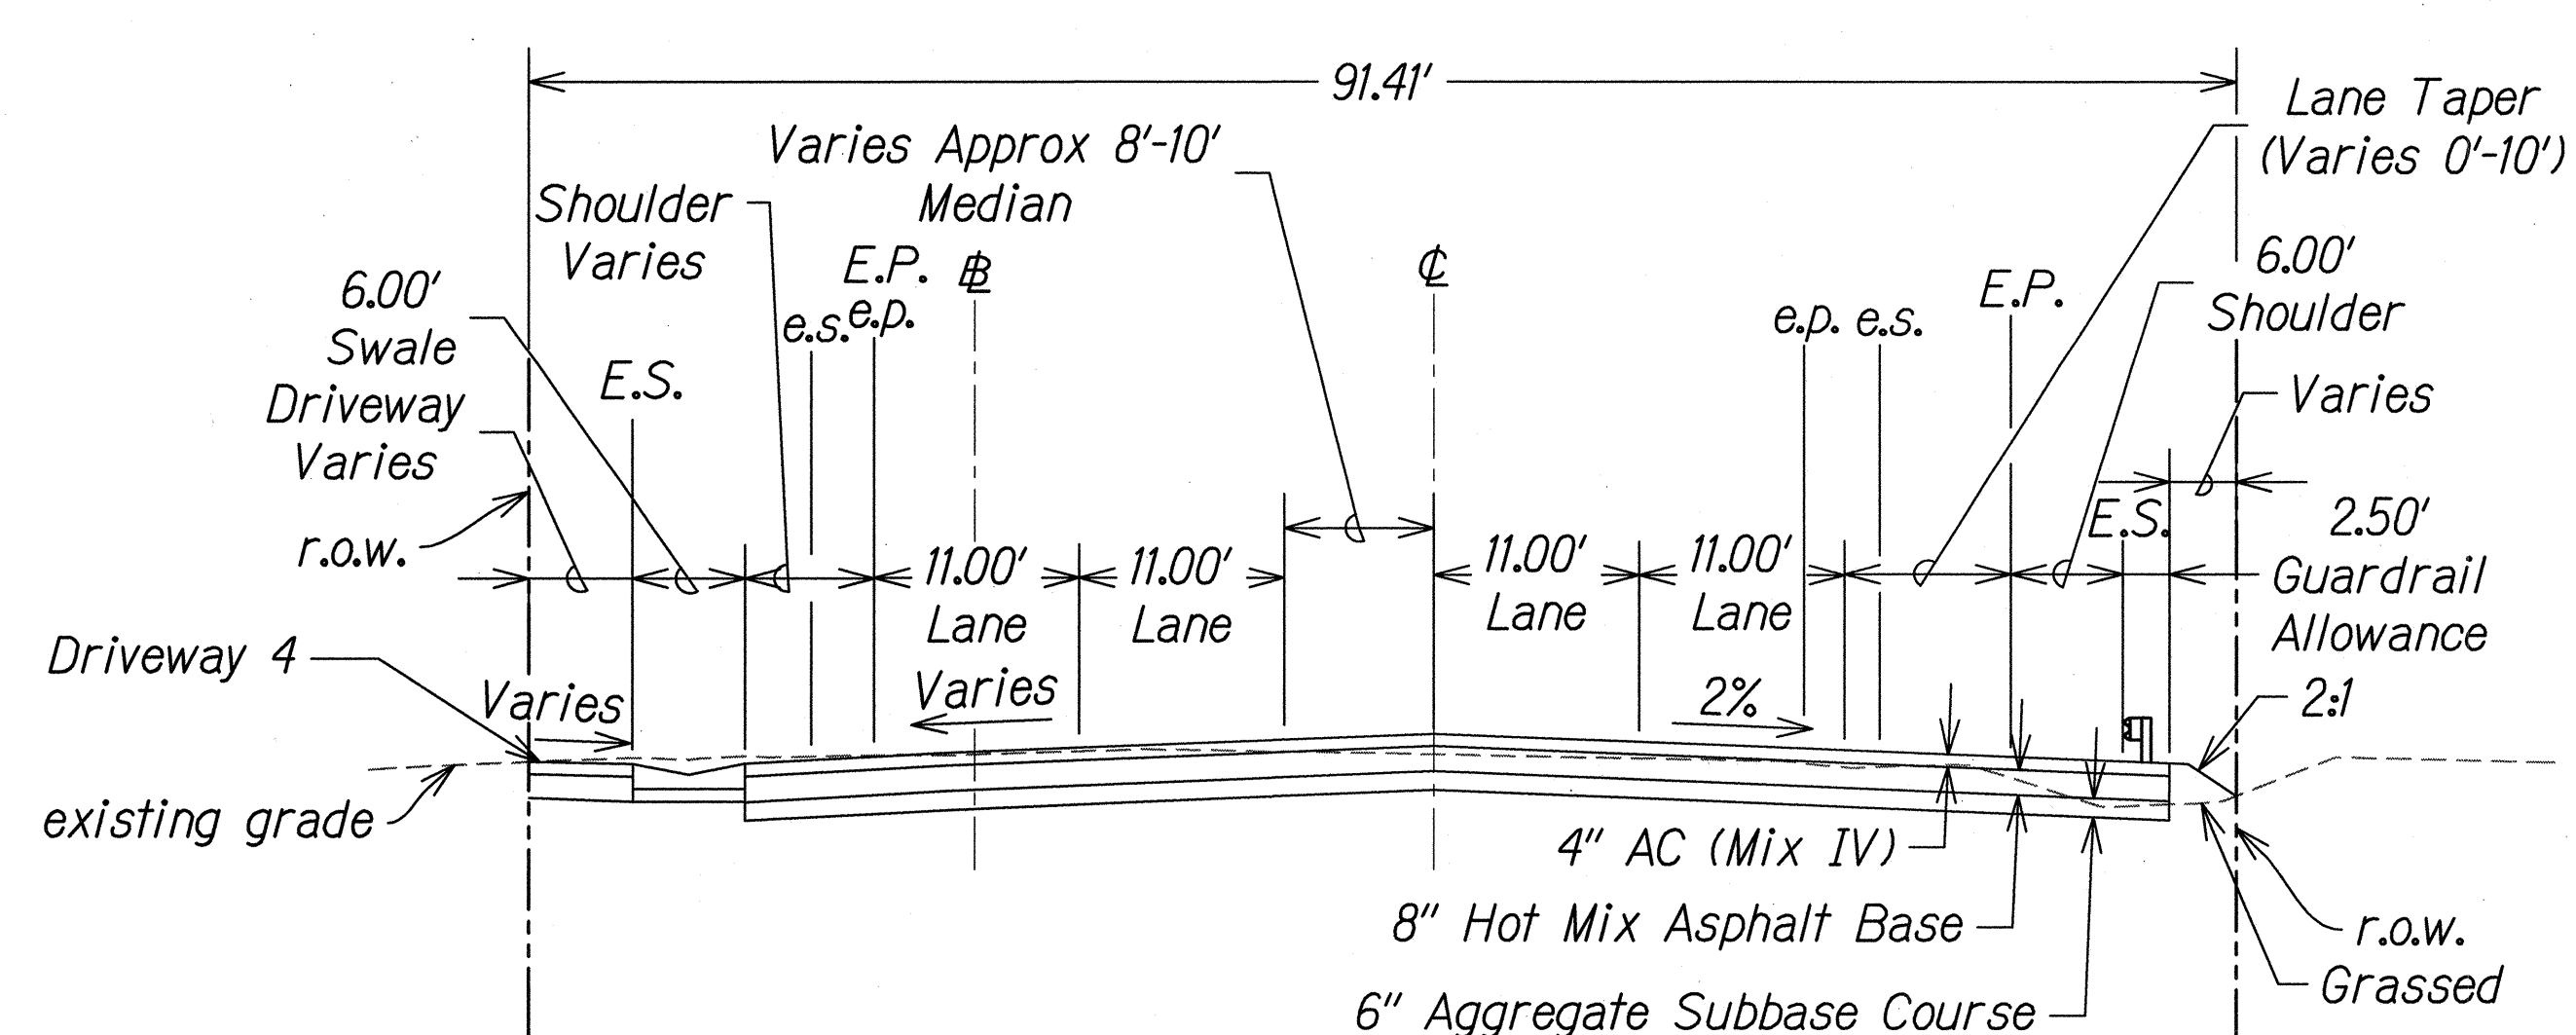


STA. 162+62 TO STA. 162+80
Scale: 1" = 10'

NOTE:

1. For Typical Bridge Section,
See Structural Sheet 57 & 72.
2. For Driveway Details,
See Sheet 39.

GRAPHICAL SCALE:

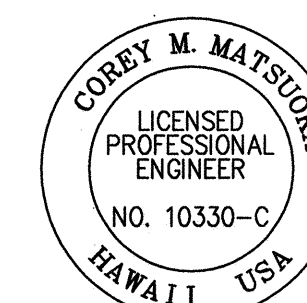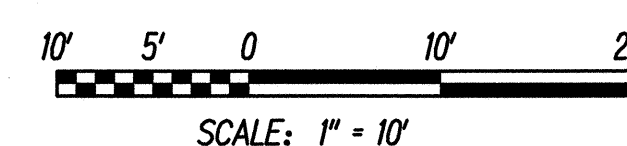

THIS WORK WAS PREPARED BY ME
OR UNDER MY SUPERVISION

Corey Matsuda
SIGNATURE

4/30/16
EXPIRATION
DATE OF THE
LICENSE


STATE OF HAWAII
DEPARTMENT OF TRANSPORTATION
HIGHWAYS DIVISION

TYPICAL SECTIONS

FARRINGTON HIGHWAY
Replacement of Maipalaoa Bridge
Federal Aid Project No. BR-093-1(21)


Scale: 1" = 10' Date: JUNE 2015
SHEET No. 1 OF 2 SHEETS

FED. ROAD DIST. NO.	STATE	FED. AID PROJ. NO.	FISCAL YEAR	SHEET NO.	TOTAL SHEETS
HAWAII	HAW.	BR-093-1(21)	2015	19	99

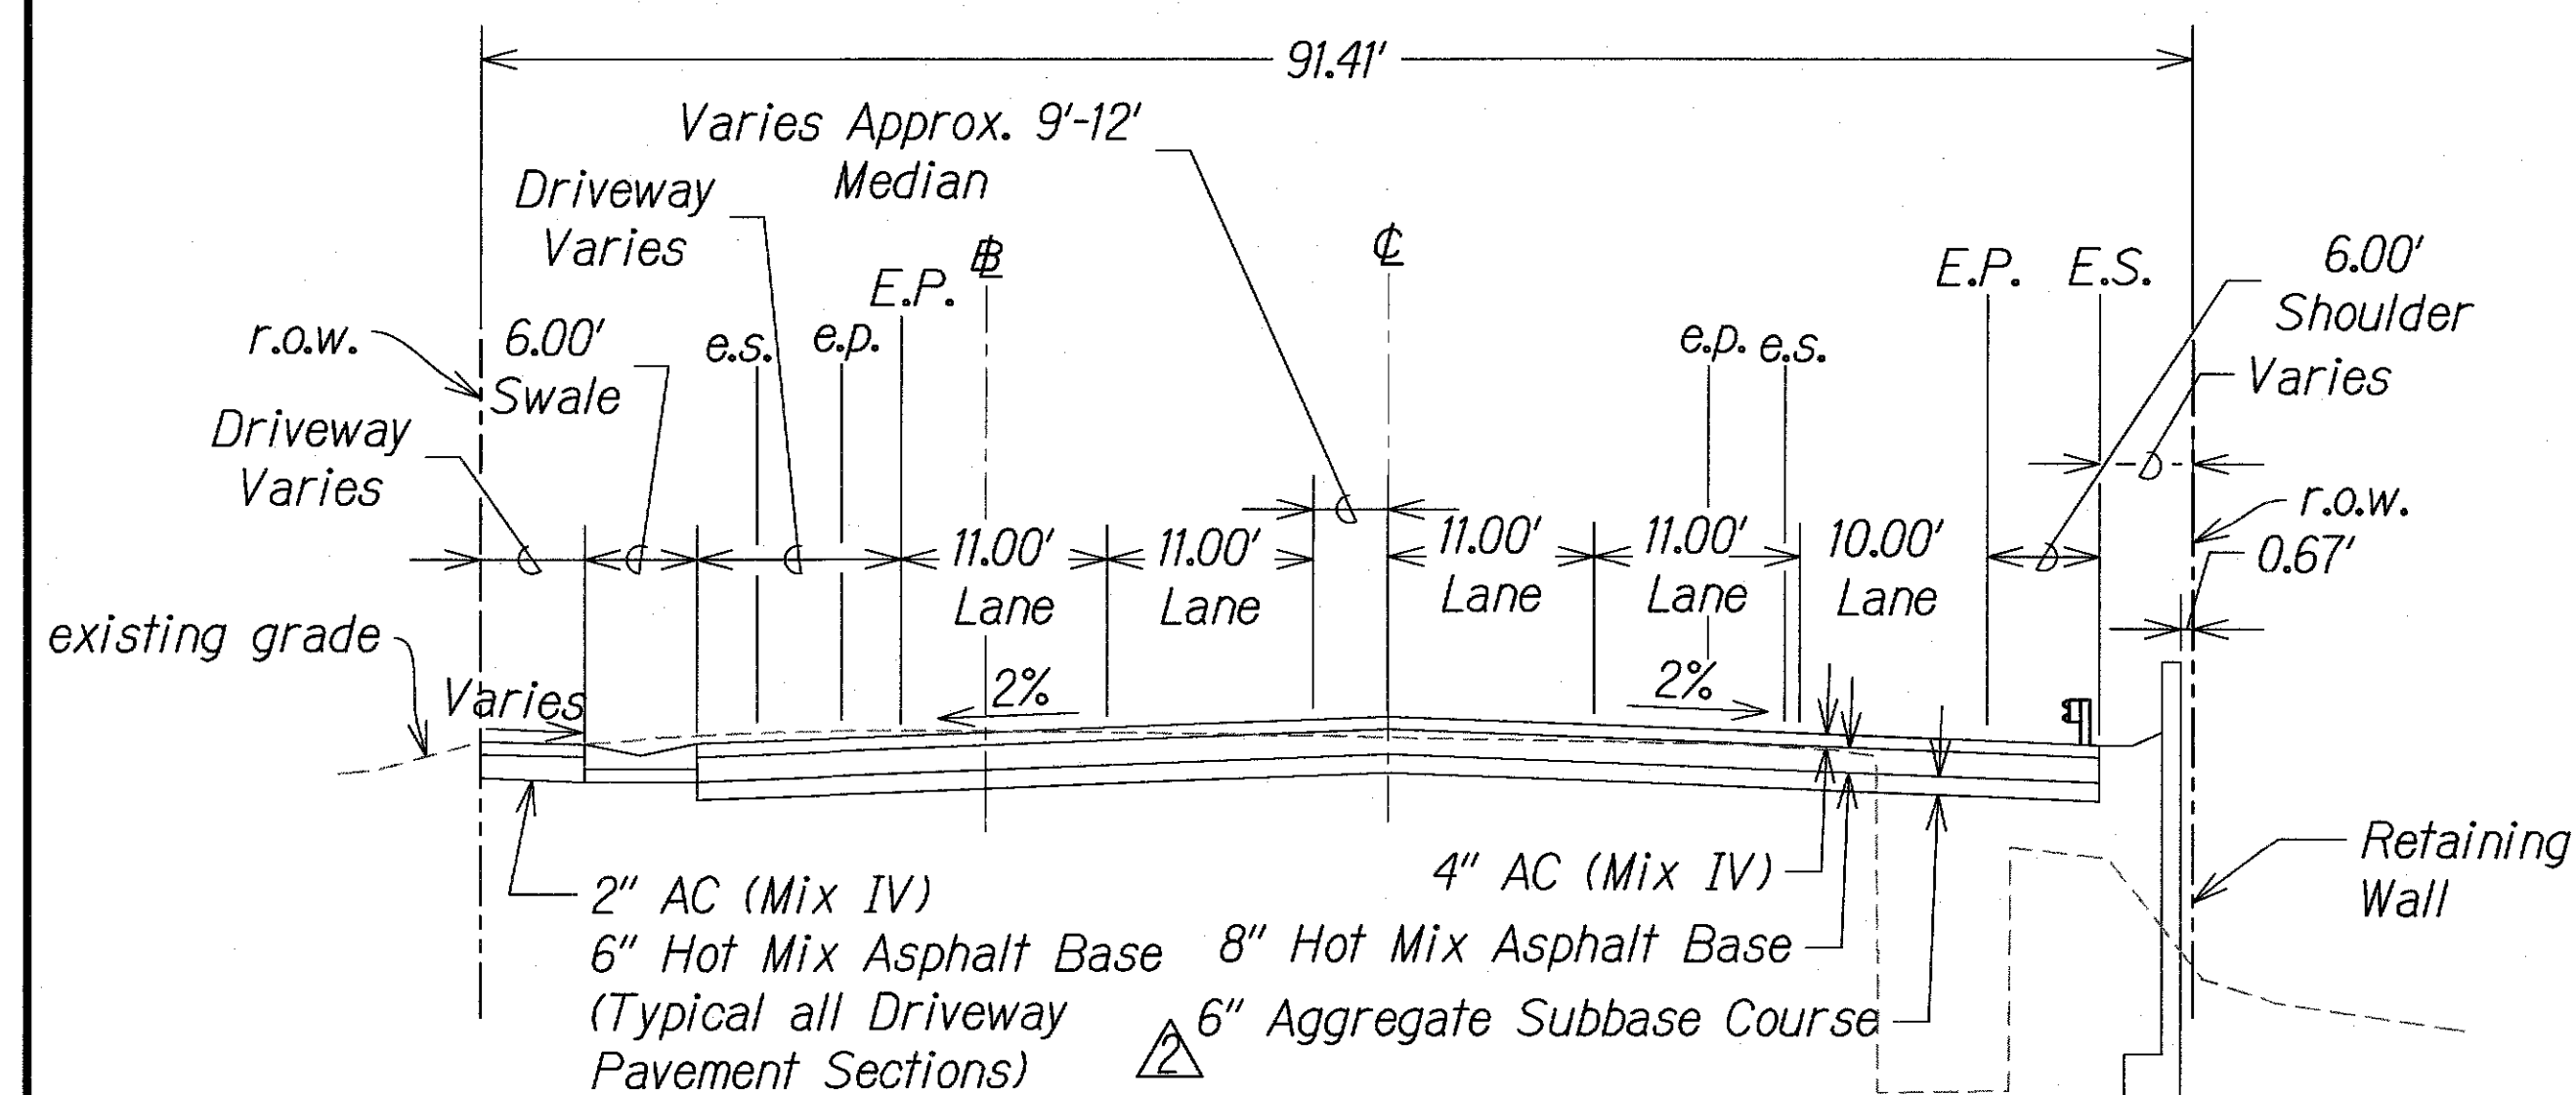


STA. 162+80.00 TO STA. 162+92.79

Scale: 1" = 10'

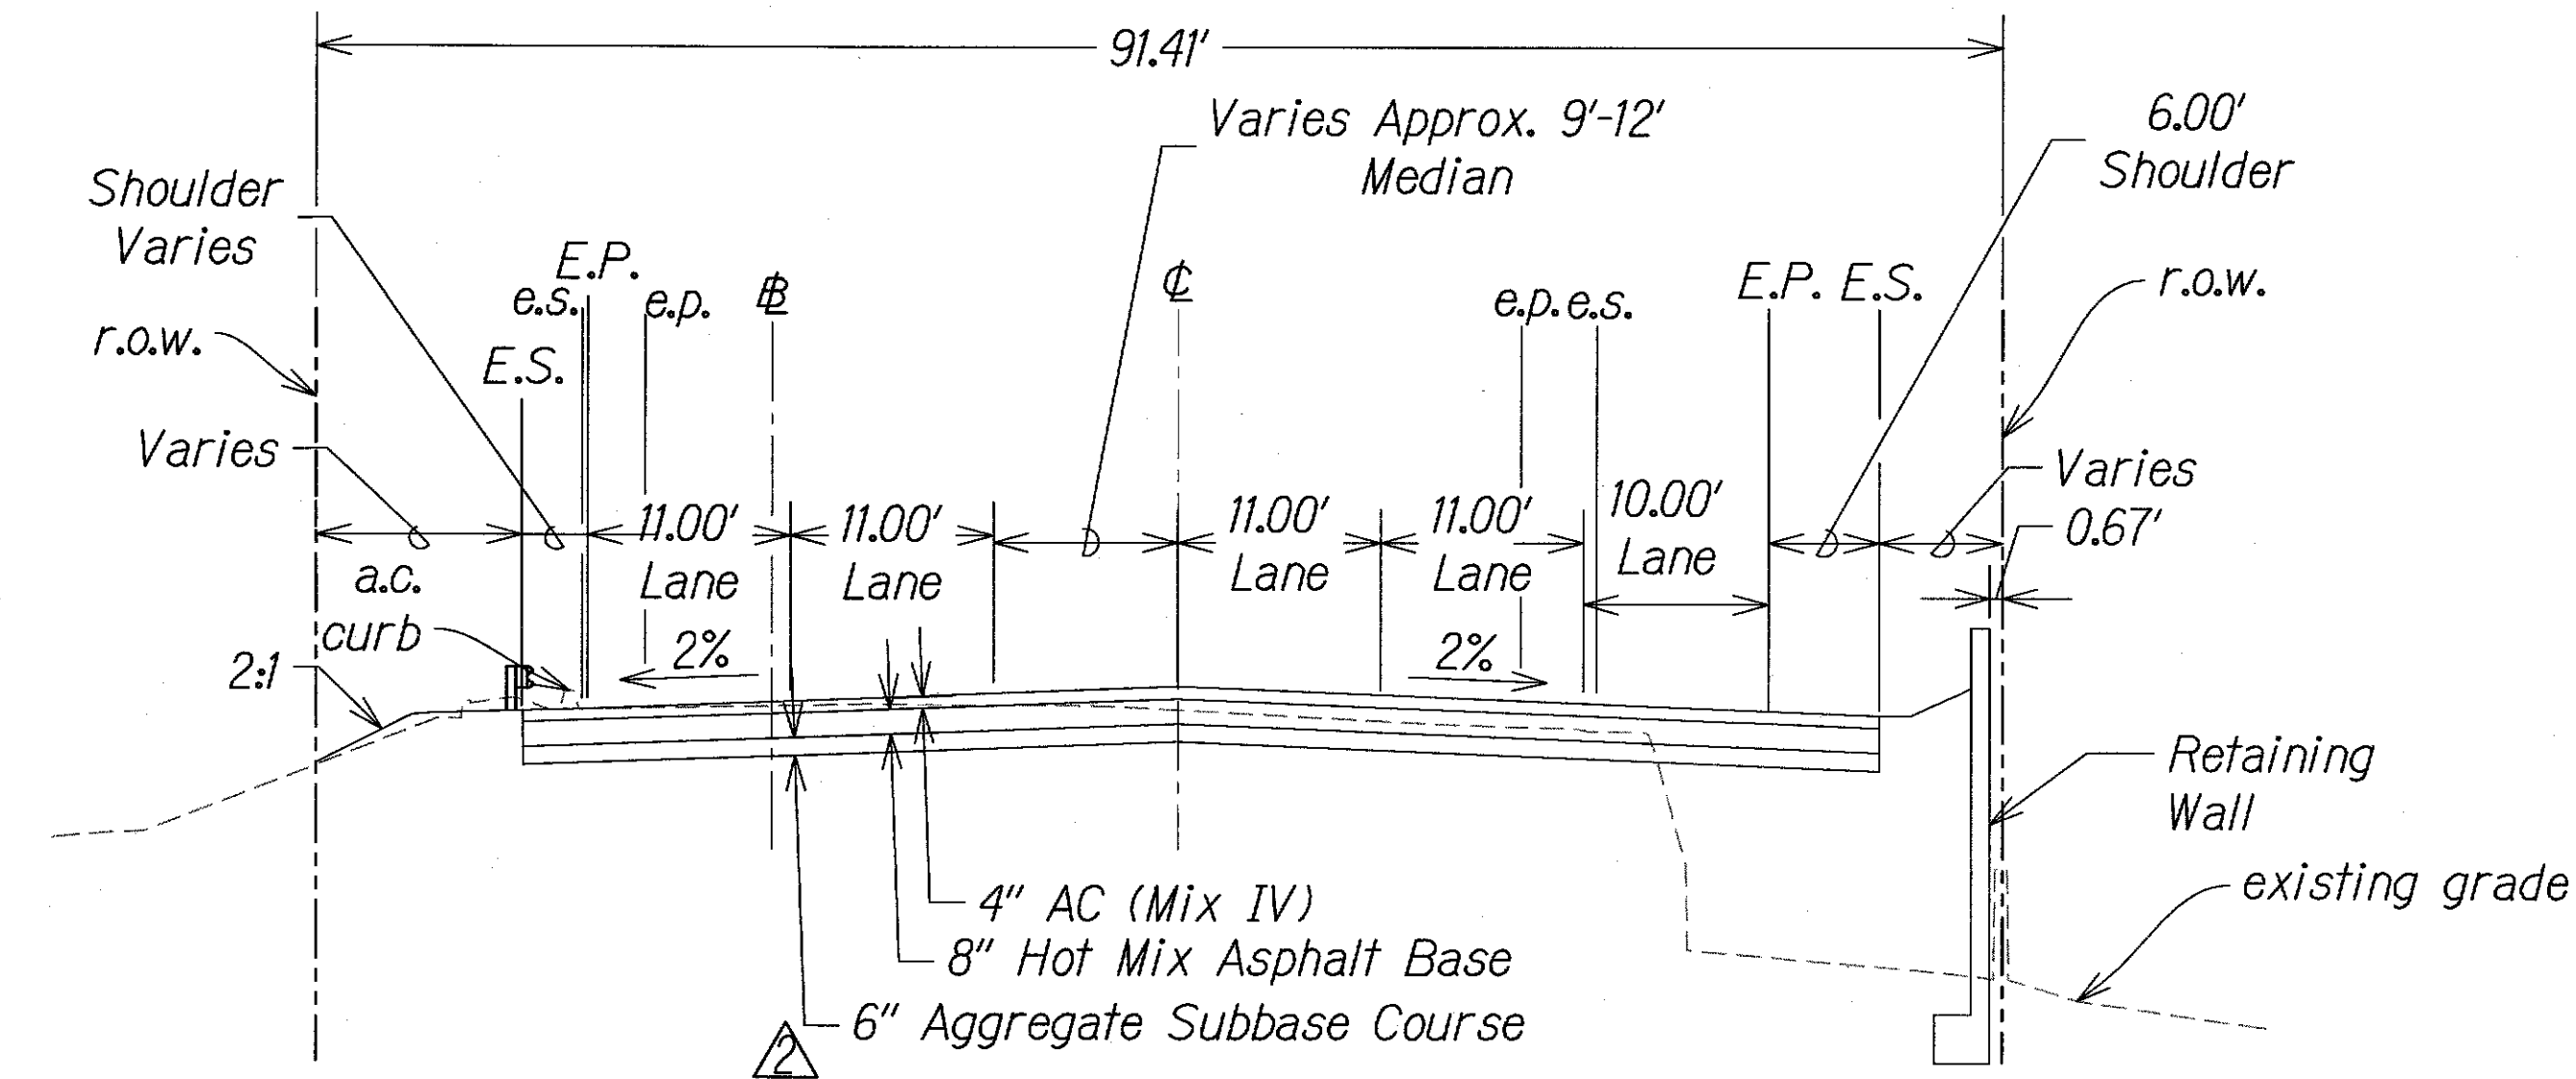


STA. 162+92.79 TO STA. 163+12.61

Scale: 1" = 10'

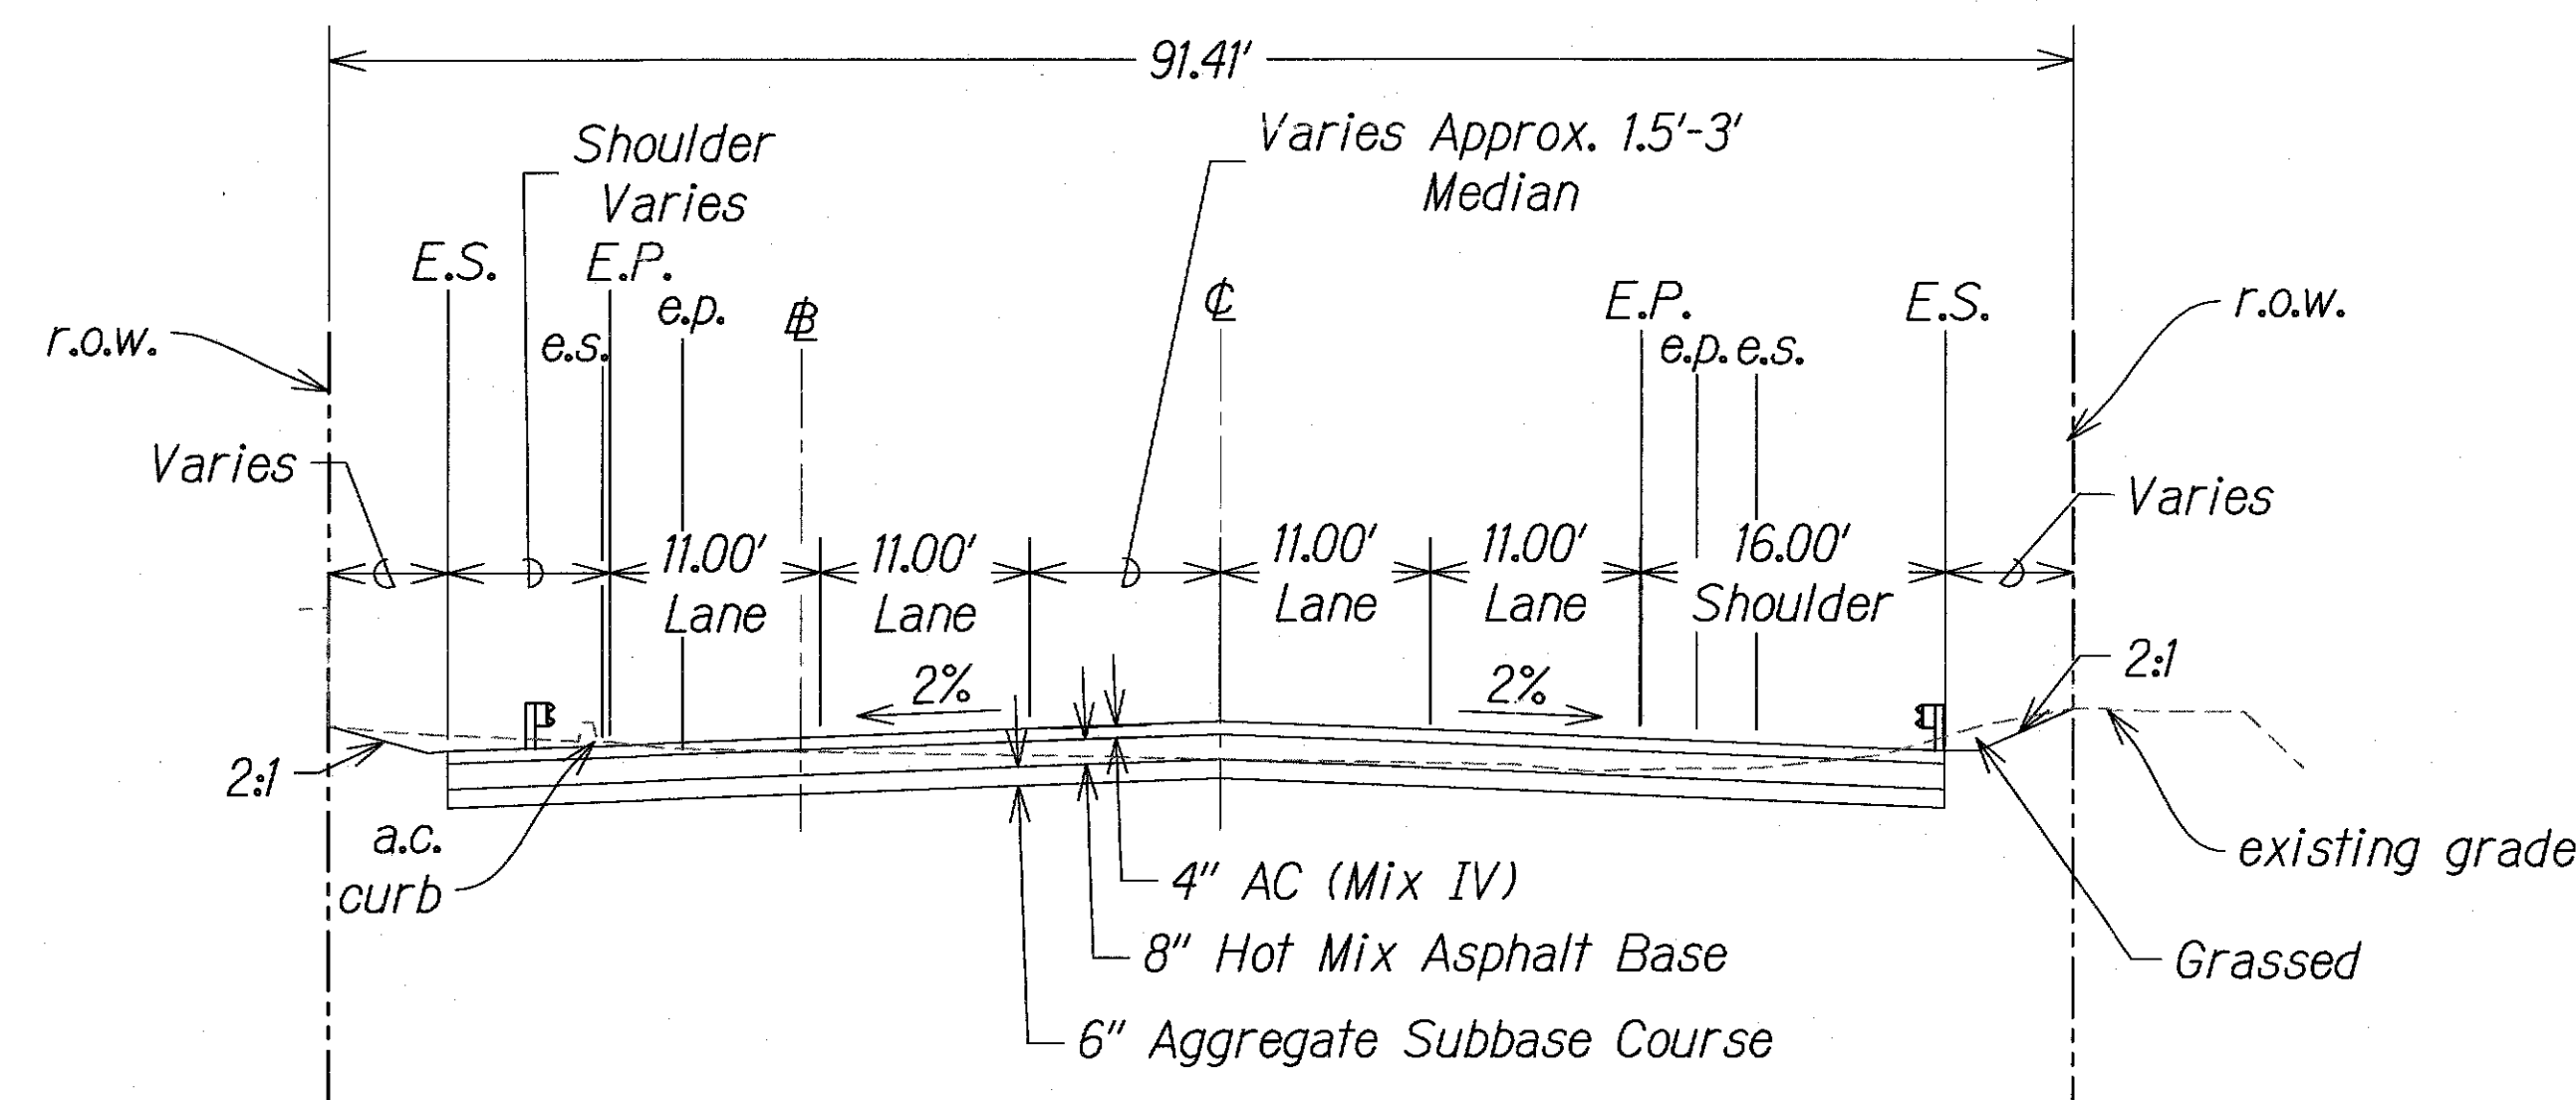

STA. 164+54.94 TO STA. 165+00.10

Scale: 1" = 10'

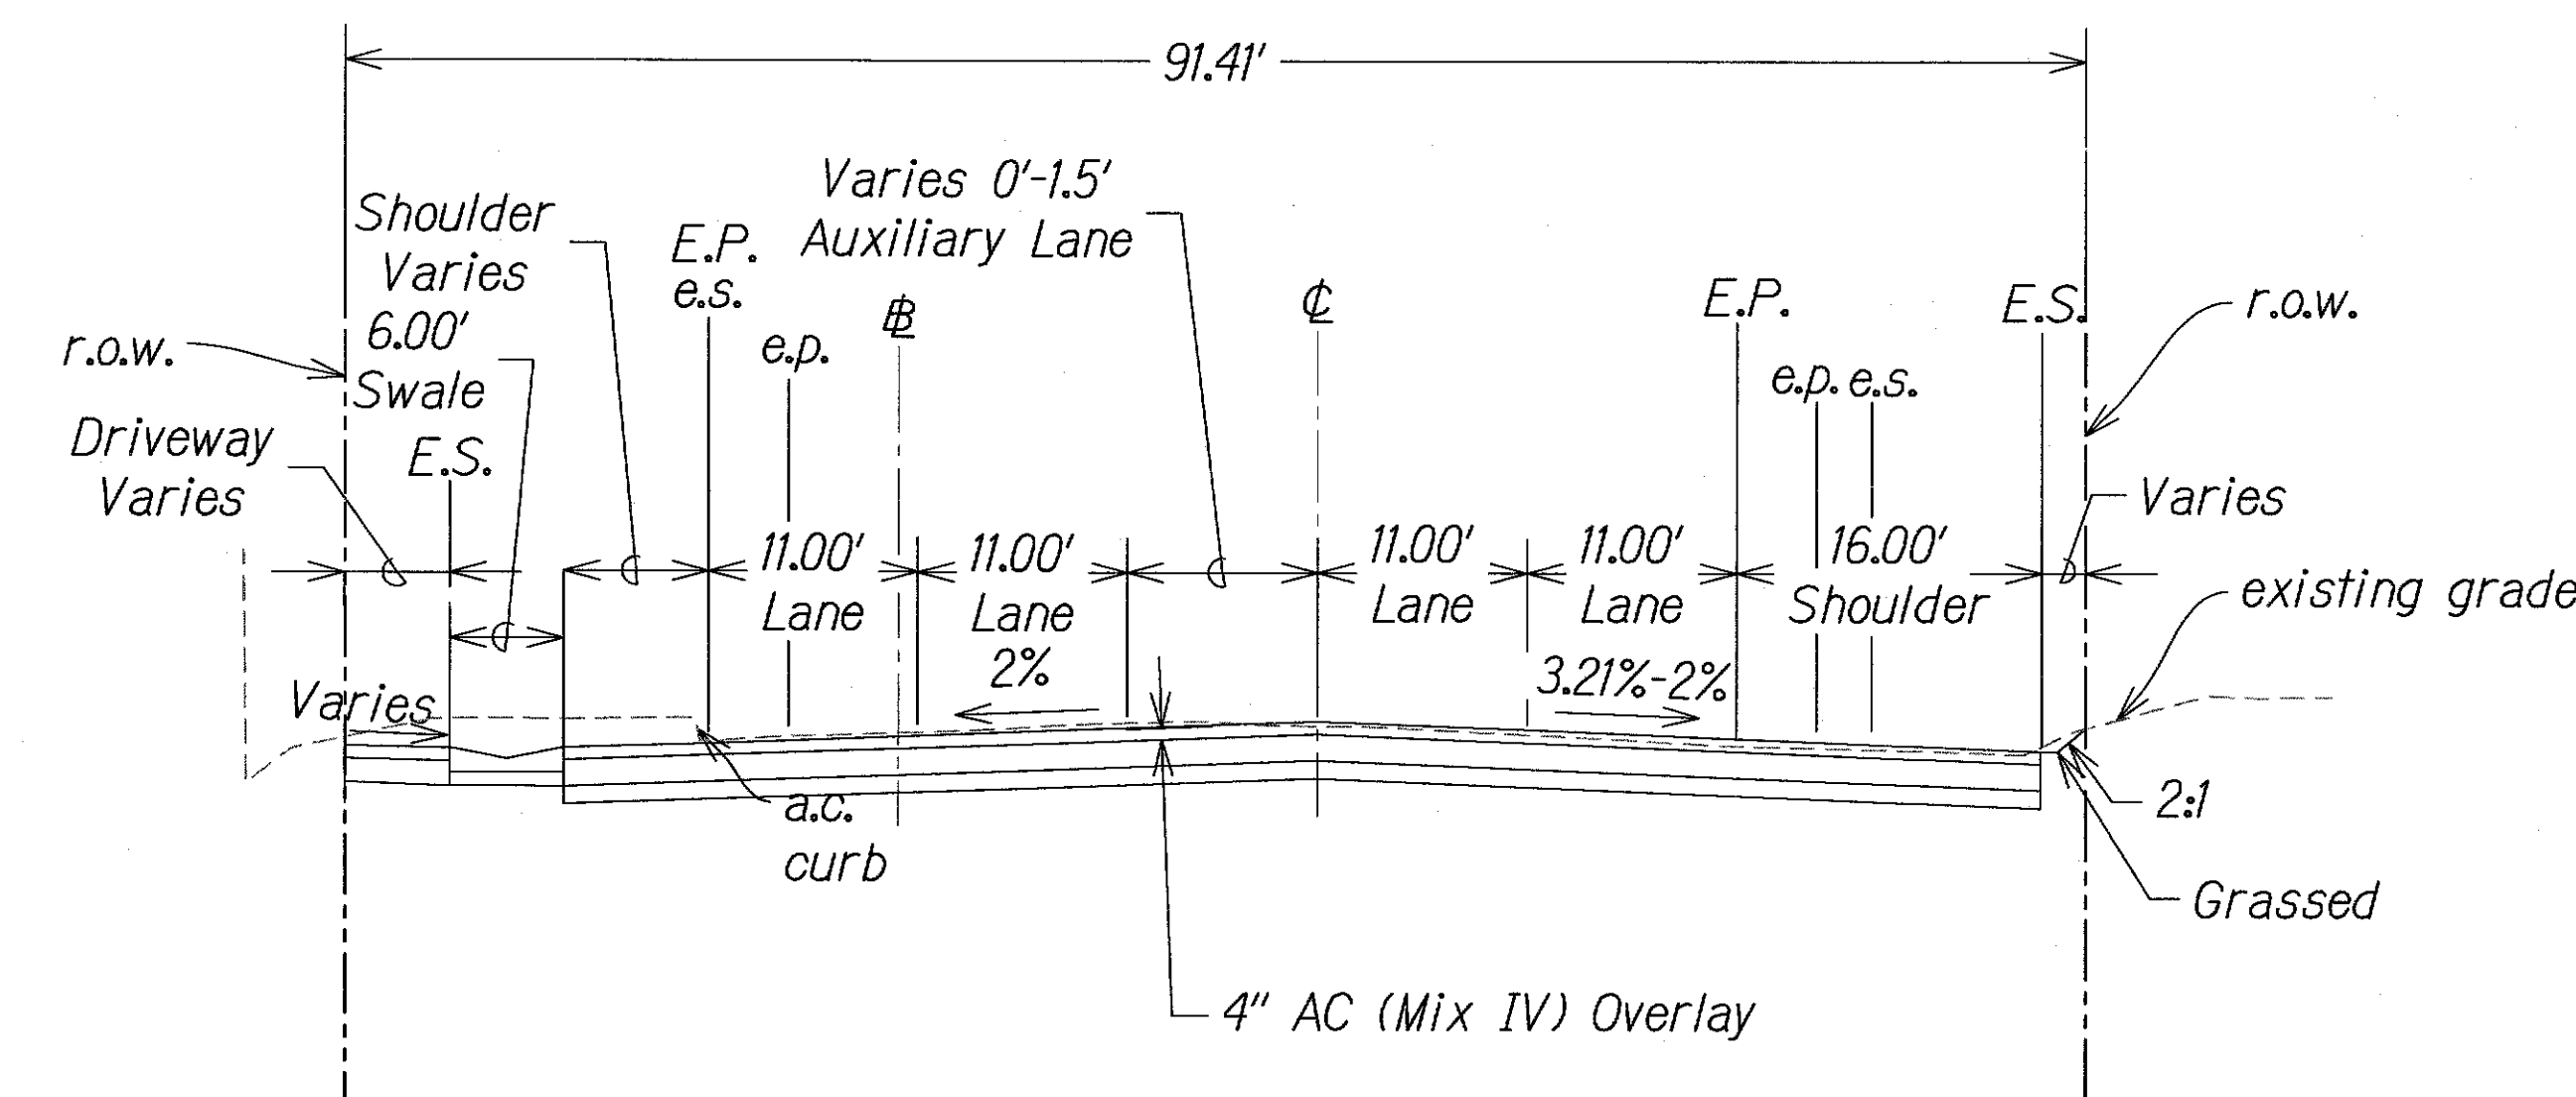



STA. 165+00.10 TO STA. 165+57.18

Scale: 1" = 10'

NOTE:

- For Typical Bridge Section Sta. 163+12.62 to Sta. 164+54.95 See Structural Sheet 57 & 72.
- For Driveway Details, See Sheet 39.

GRAPHICAL SCALE:

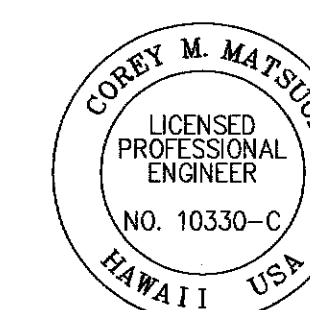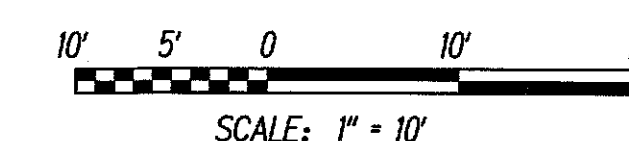

THIS WORK WAS PREPARED BY ME OR UNDER MY SUPERVISION

SIGNATURE *Corey M. Matsuka* 4/30/16 EXPIRATION DATE OF THE LICENSE

10/30/15 DATE	Changed Subbase Course REVISION
STATE OF HAWAII DEPARTMENT OF TRANSPORTATION HIGHWAYS DIVISION	
TYPICAL SECTIONS	
FARRINGTON HIGHWAY Replacement of Maipalaoa Bridge Federal Aid Project No. BR-093-1(21)	
Scale: 1" = 10'	Date: JUNE 2015
SHEET No. 2 OF 2 SHEETS	