

INDEX TO DRAWINGS	
SHEET NO.	DESCRIPTION
1	TITLE SHEET
2	STANDARD PLANS SUMMARY
3-4	GENERAL NOTES & LEGEND
5-6	WATER POLLUTION & EROSION CONTROL NOTES
7-8	TYPICAL SECTION & DETAILS
9-12	ROADWAY PLANS
13	PAVEMENT MARKINGS, LEGEND, DETAILS AND NOTES
14	LOW SPEED UNDIVIDED HIGHWAY WORK ZONE SIGNING PLAN, NOTES & DETAILS
15-18	PAVEMENT MARKING AND SIGNING PLAN

STATE OF HAWAII
DEPARTMENT OF TRANSPORTATION
HIGHWAYS DIVISION
HONOLULU, HAWAII

PLANS FOR




FARRINGTON HIGHWAY RESURFACING

ORANGE STREET TO KILI DRIVE

PROJECT NO. 93B-01-03M

DISTRICT OF WAIANAE
ISLAND OF OAHU

FED. ROAD DIST. NO.	STATE	PROJ. NO.	FISCAL YEAR	SHEET NO.	TOTAL SHEETS
HAWAII	HAW.	93B-01-03M	2007	1	18

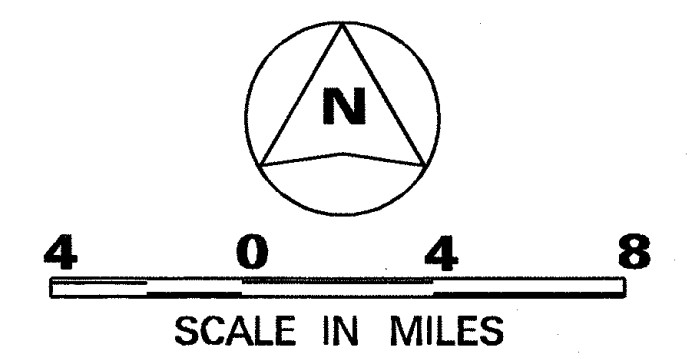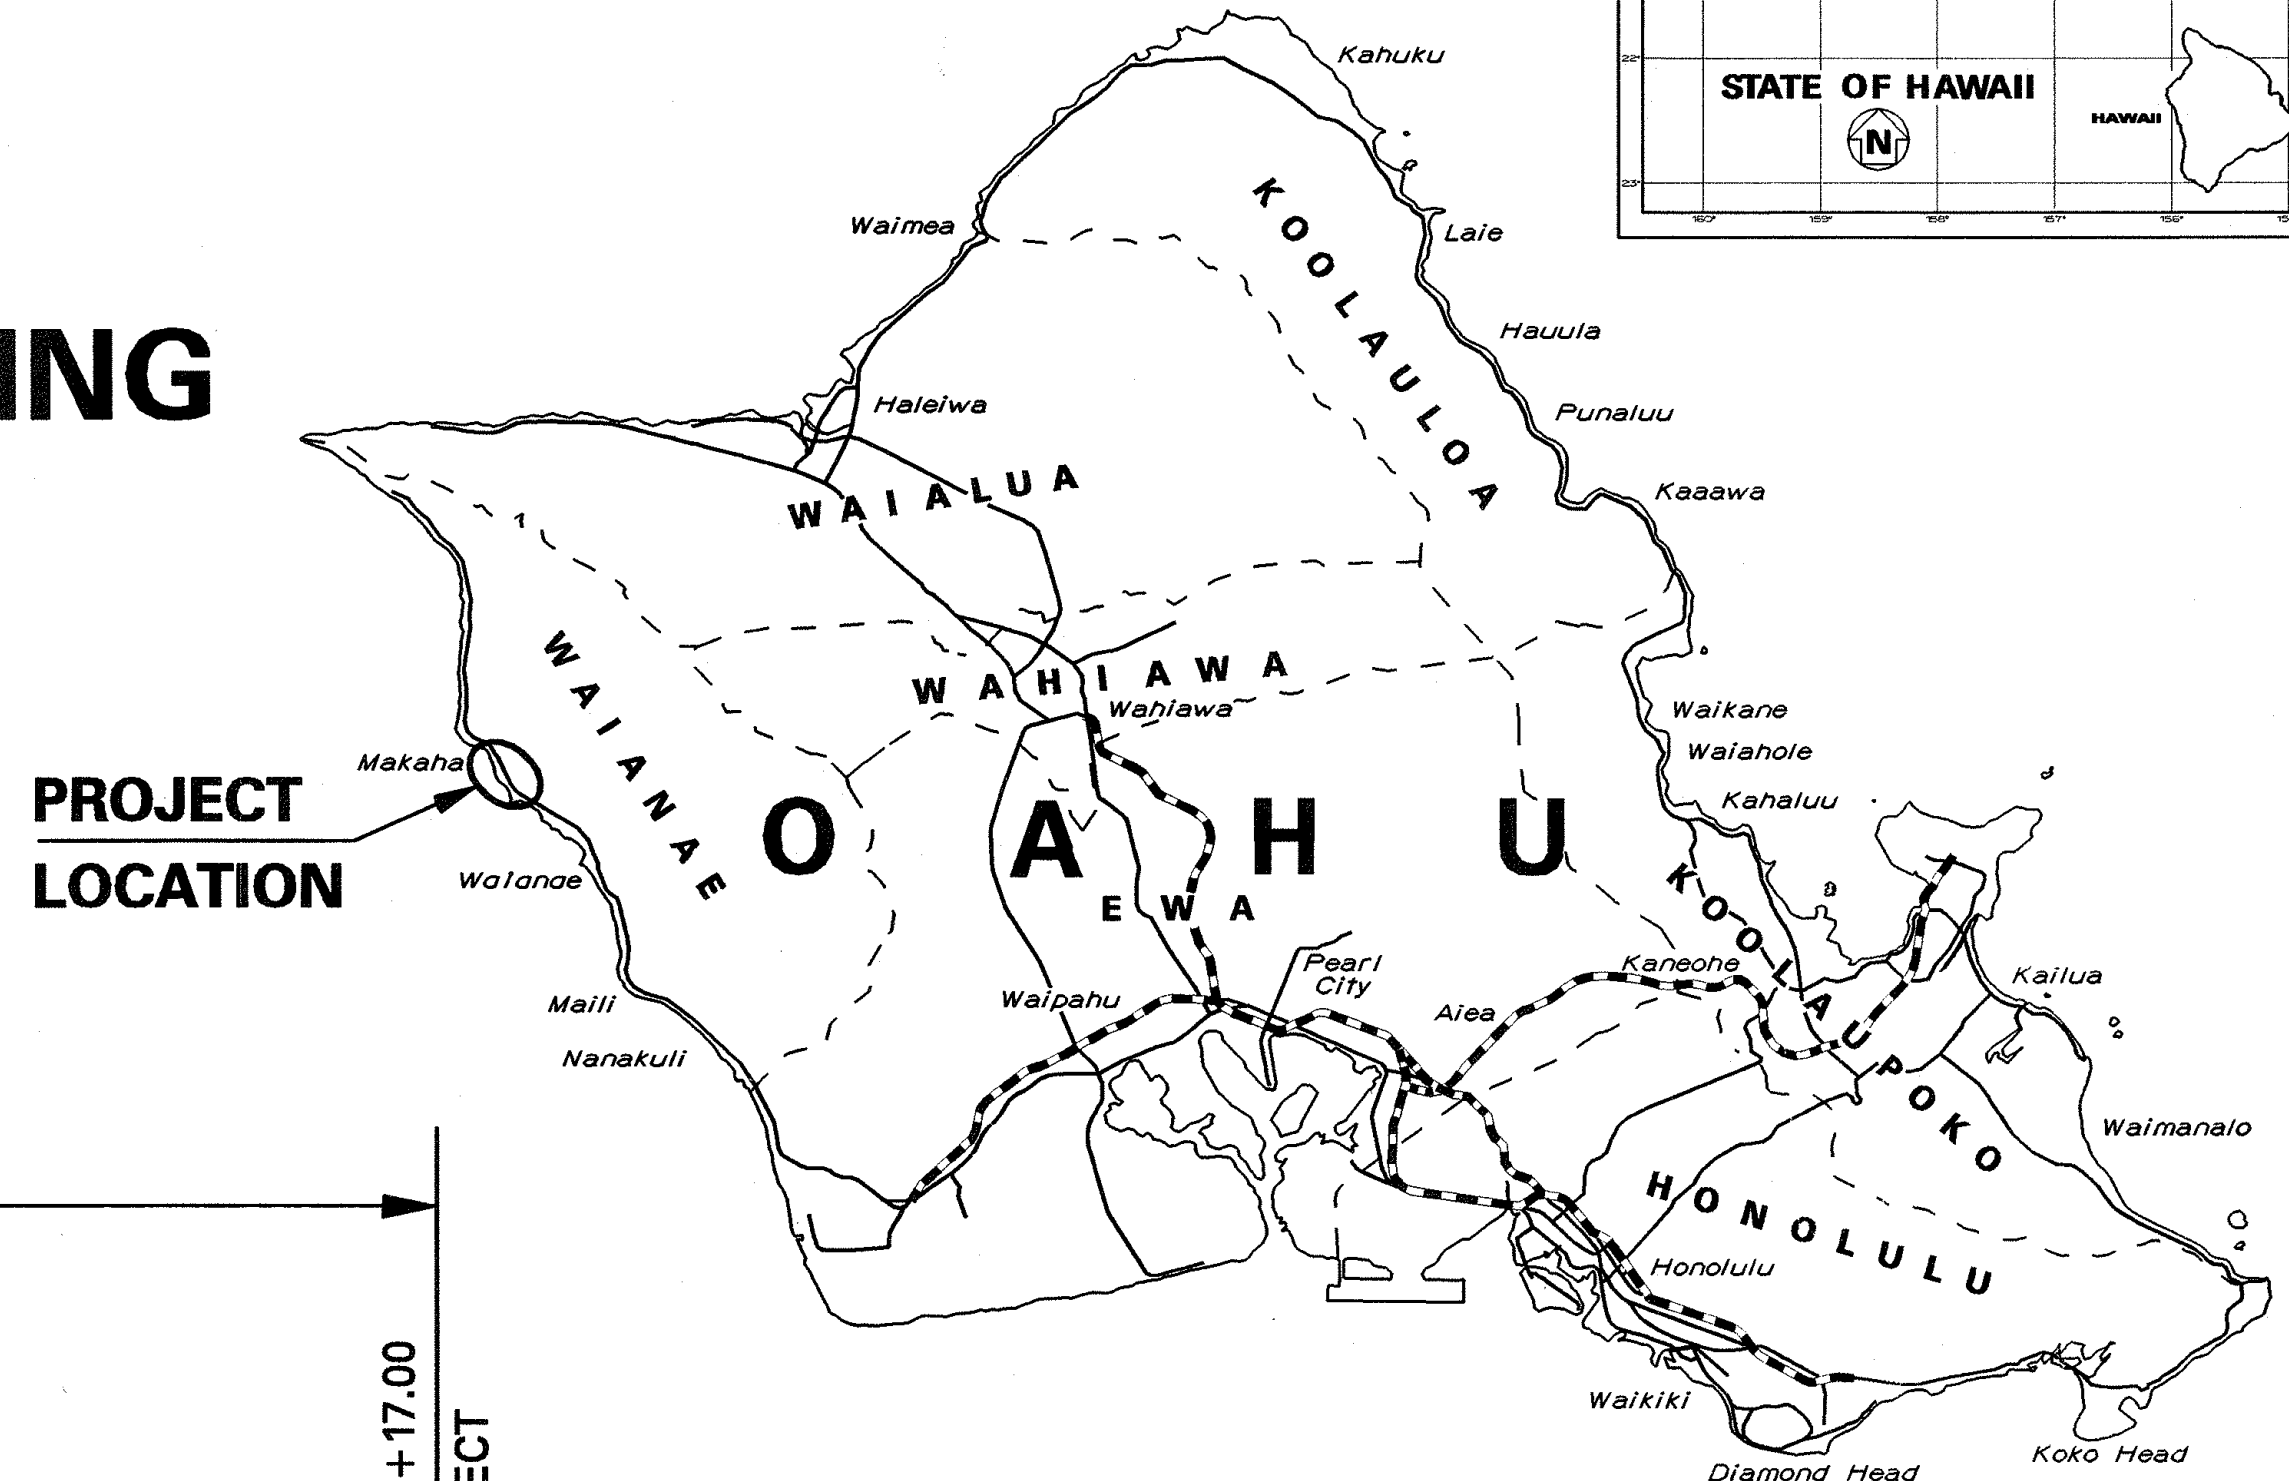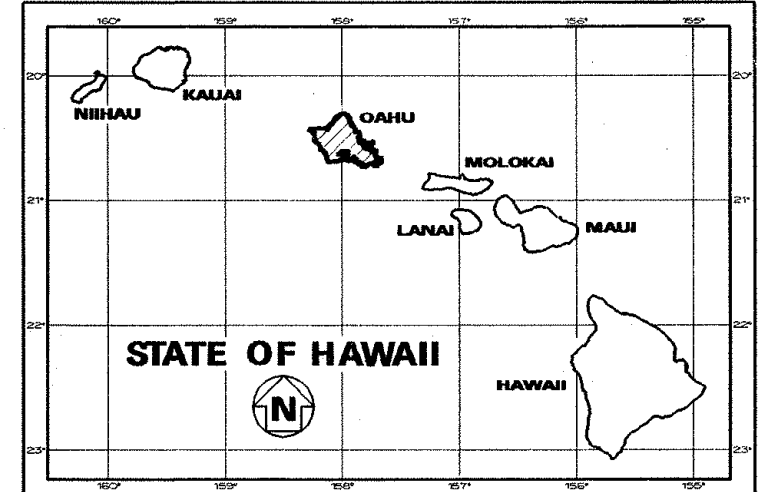


MILE POST 12.80 TO MILE POST 14.04

CHANGES MADE DURING CONSTRUCTION HAVE BEEN INCORPORATED ON THESE PLANS EXCEPT CHANGES IN THE ORIGINAL THEORETICAL QUANTITIES. FOR ACTUAL QUANTITIES, REFER TO PROJECT LEDGER AND/OR COMPLETION BOOK.

[Signature] 5/16/06
RESIDENT ENGINEER DATE

DEPARTMENT OF TRANSPORTATION
STATE OF HAWAII

APPROVED:
[Signature] 5-16-06
DIR. OF TRANSPORTATION DATE

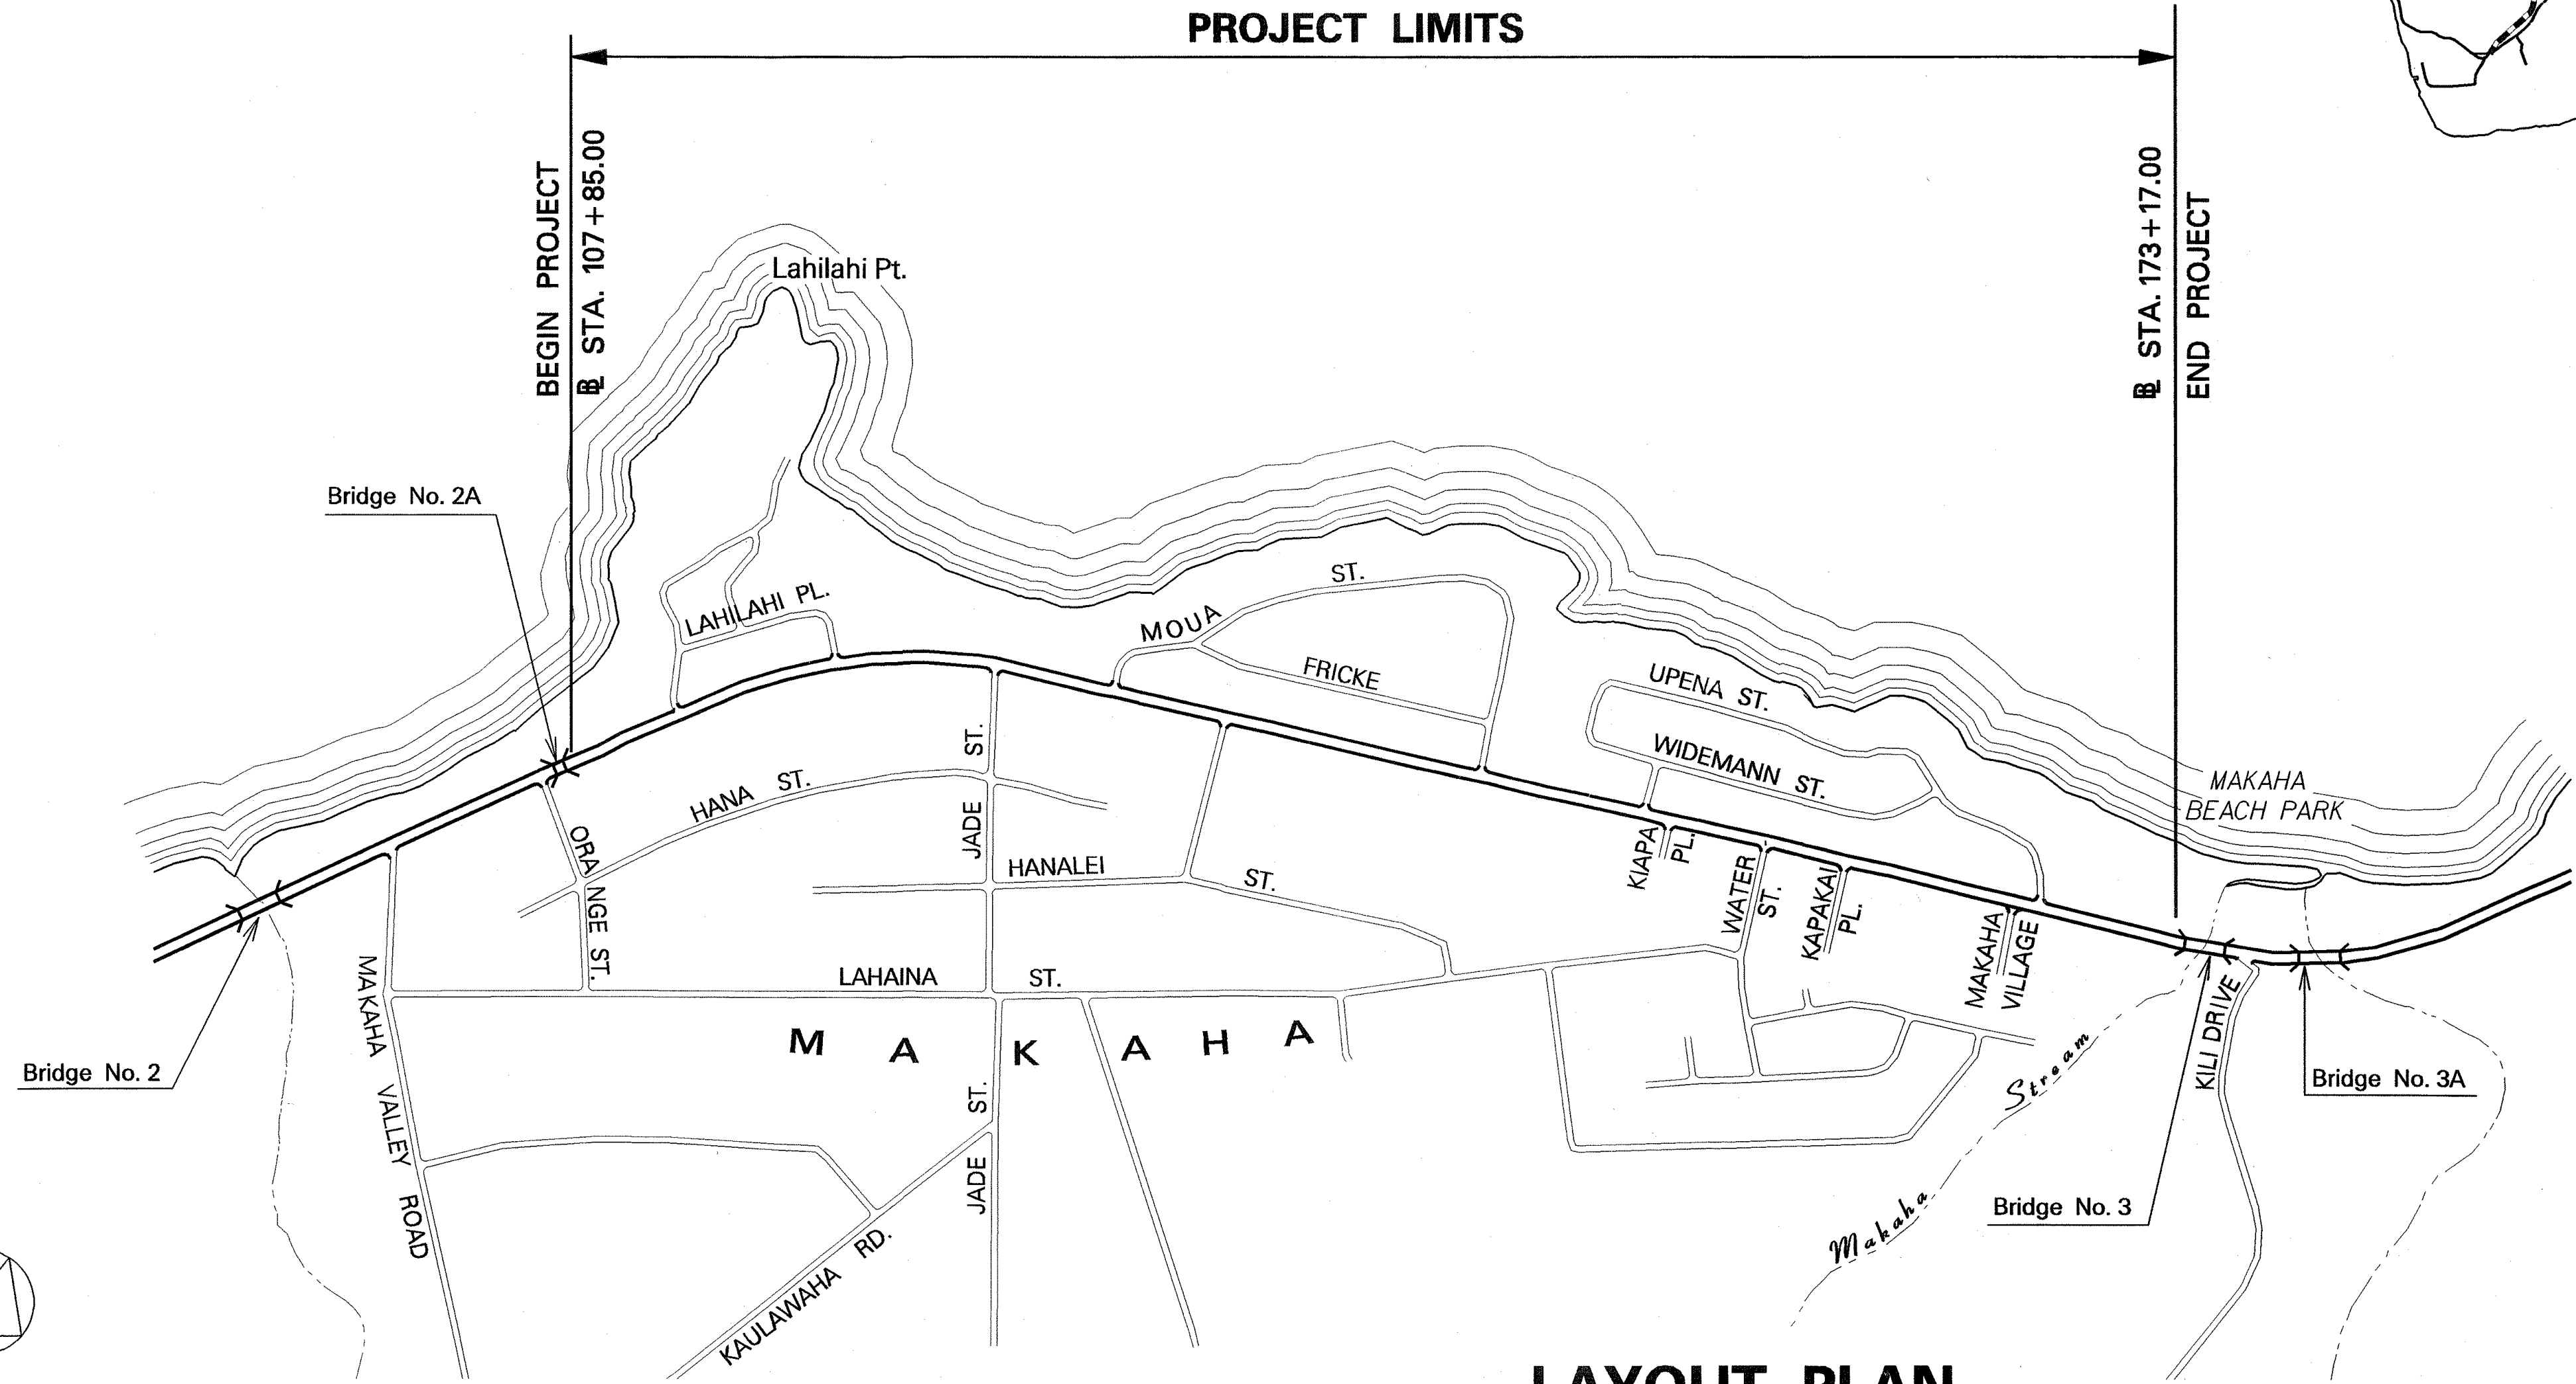

LAYOUT PLAN

GROSS LENGTH OF PROJECT.....1.24 MILES
NET LENGTH OF PROJECT.....1.24 MILES

HWY-DD AUGUST 2006
MANAGED BY PHONE DATE
DESIGNED BY

692-7570