
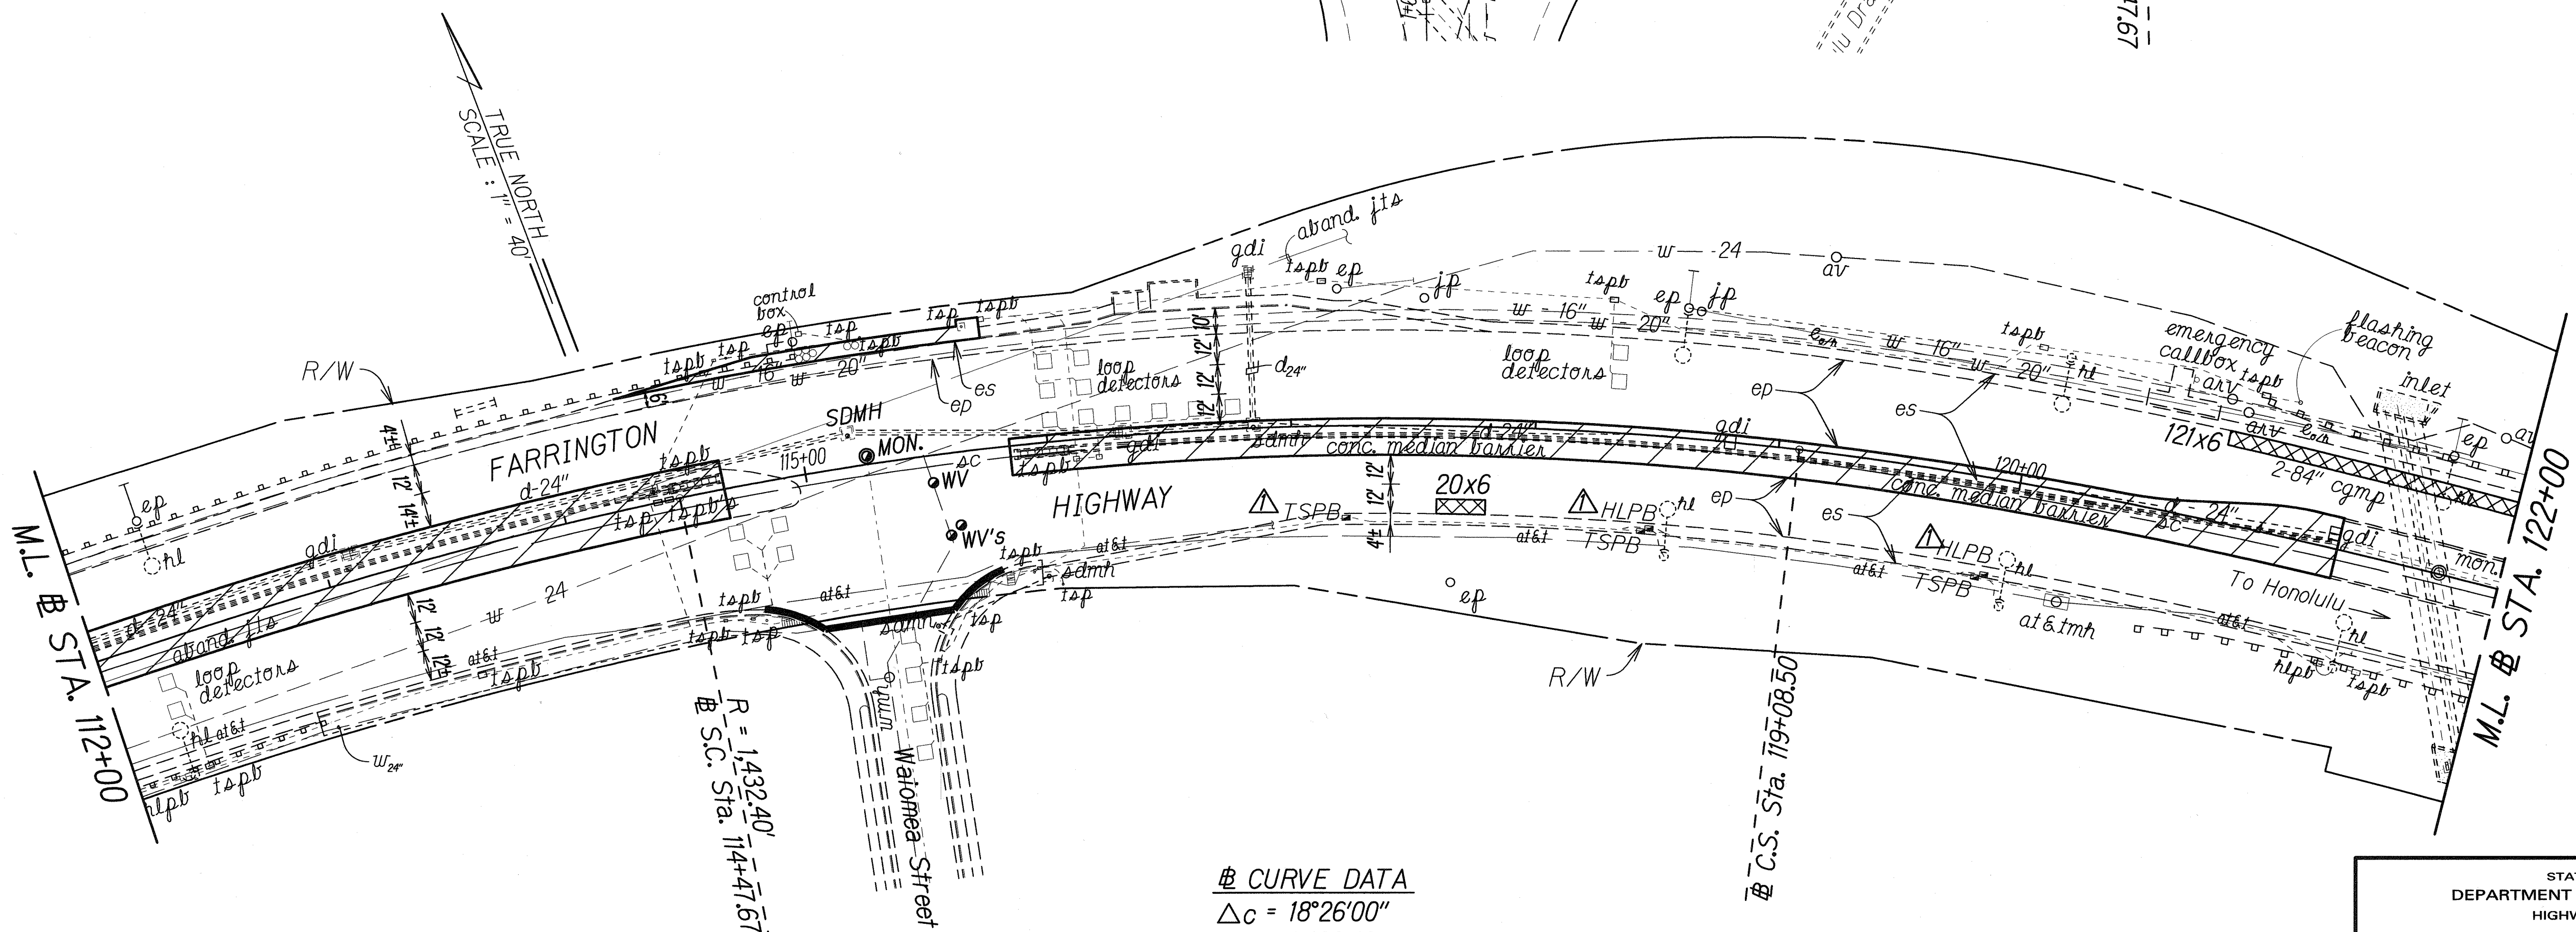


FED. ROAD DIST. NO.	STATE	PROJ. NO.	FISCAL YEAR	SHEET NO.	TOTAL SHEETS
HAWAII	HAW.	93A-01-06M	2010	ADD. 15	36

TRUE NORTH
SCALE: 1" = 40'

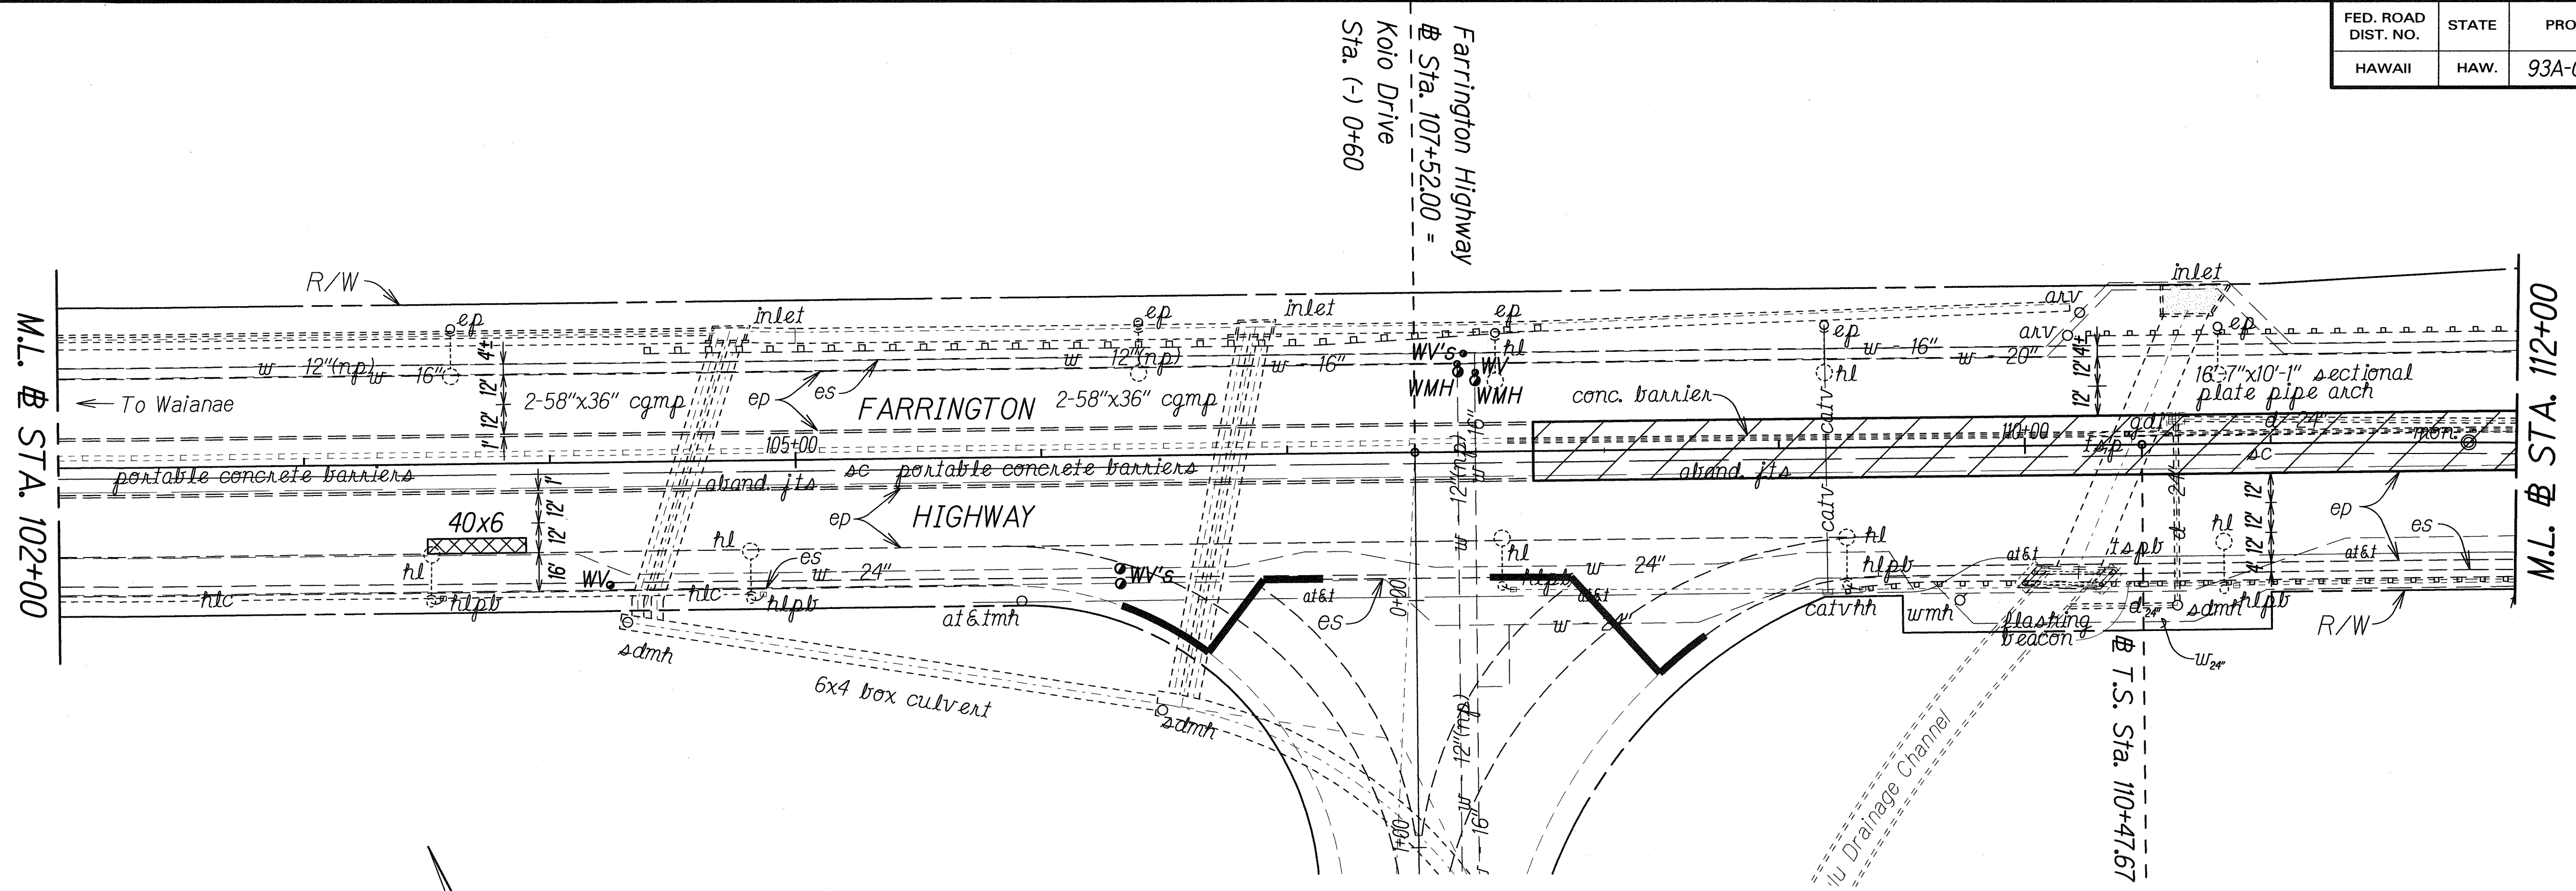

Ⓔ CURVE DATA
 $\Delta c = 18^\circ 26' 00''$
 $R = 1,432.40'$
 $Lc = 460.83'$
 $Ls = 400.00'$

SURVEY PLOTTED BY	DATE
DRAWN BY	
CHECKED BY	
NOTE BOOK	
DATE	
CHECKED BY	

6/18/10 Δ Adjusted TSPB and HLPB.

DATE REVISION

STATE OF HAWAII
DEPARTMENT OF TRANSPORTATION
HIGHWAYS DIVISION

ROADWAY PLANS

FARRINGTON HIGHWAY
Pavement Preventive Maintenance
Keananolo Bridge to Palailai Interchange
Project No. 93A-01-06M

Scale: 1" = 40' Date: March 2010

SHEET No. 6 OF 11 SHEETS