
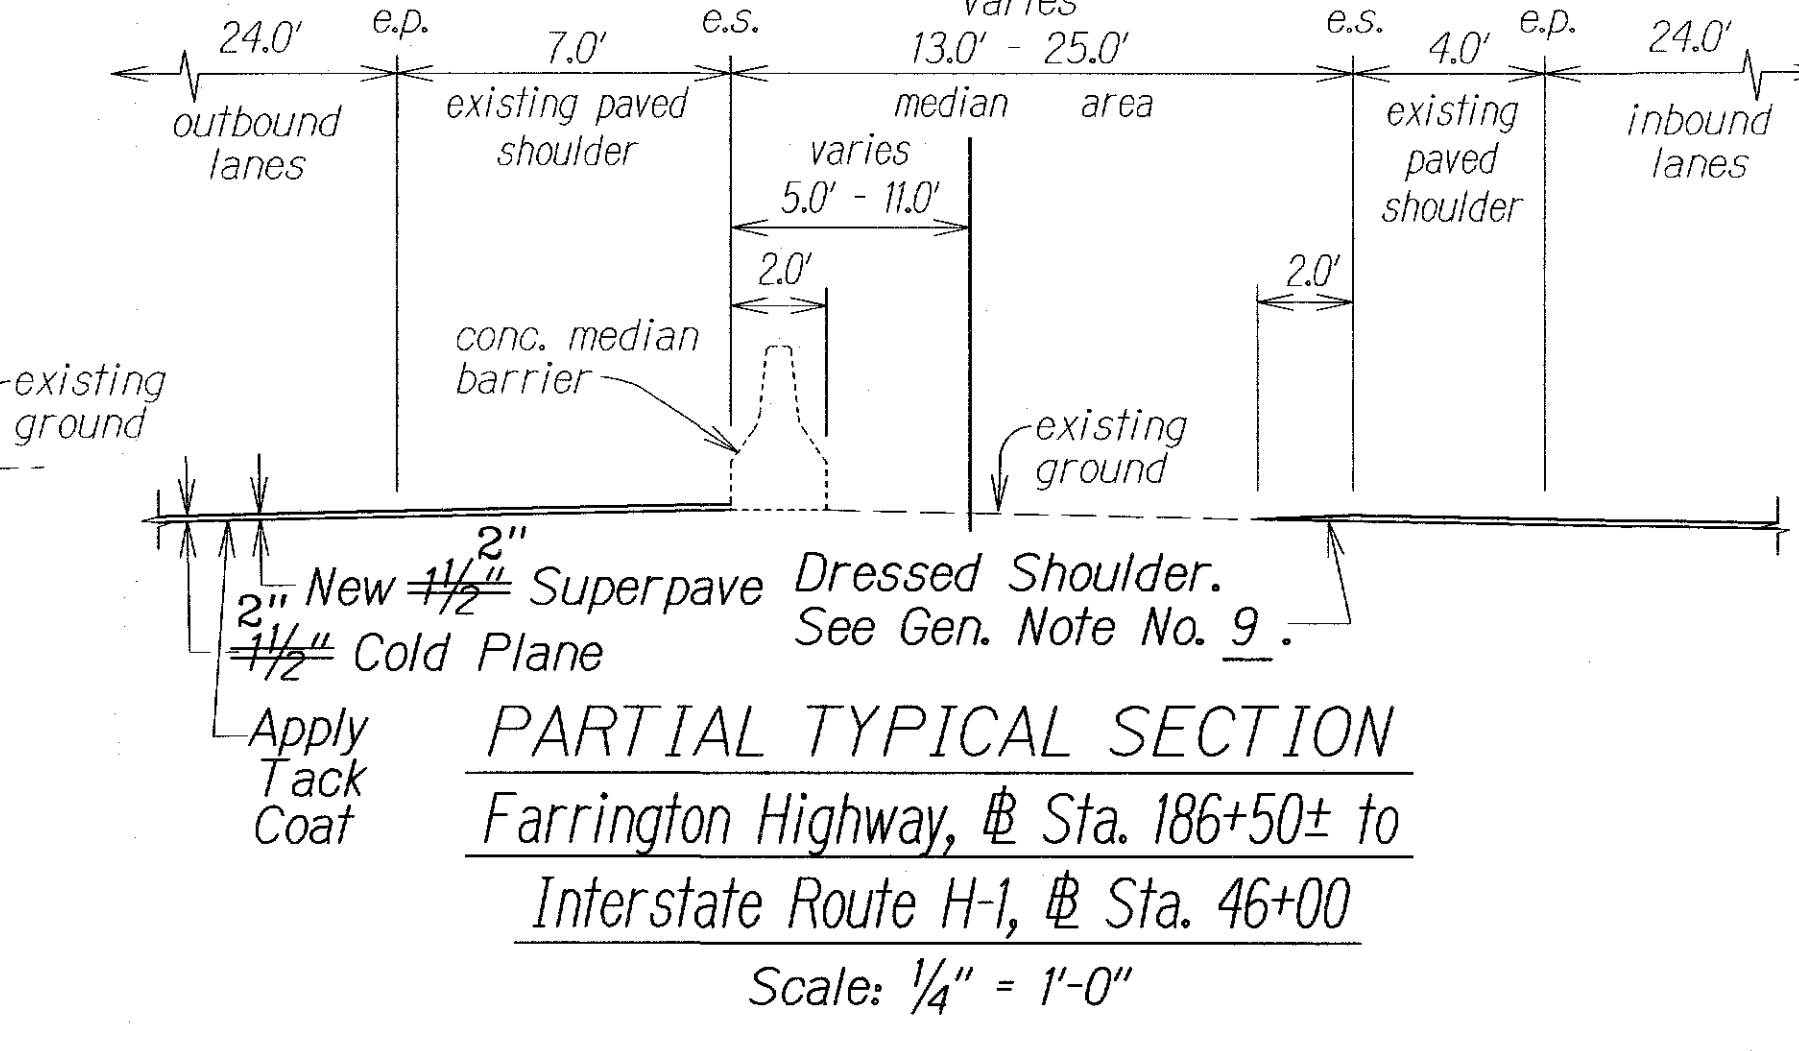
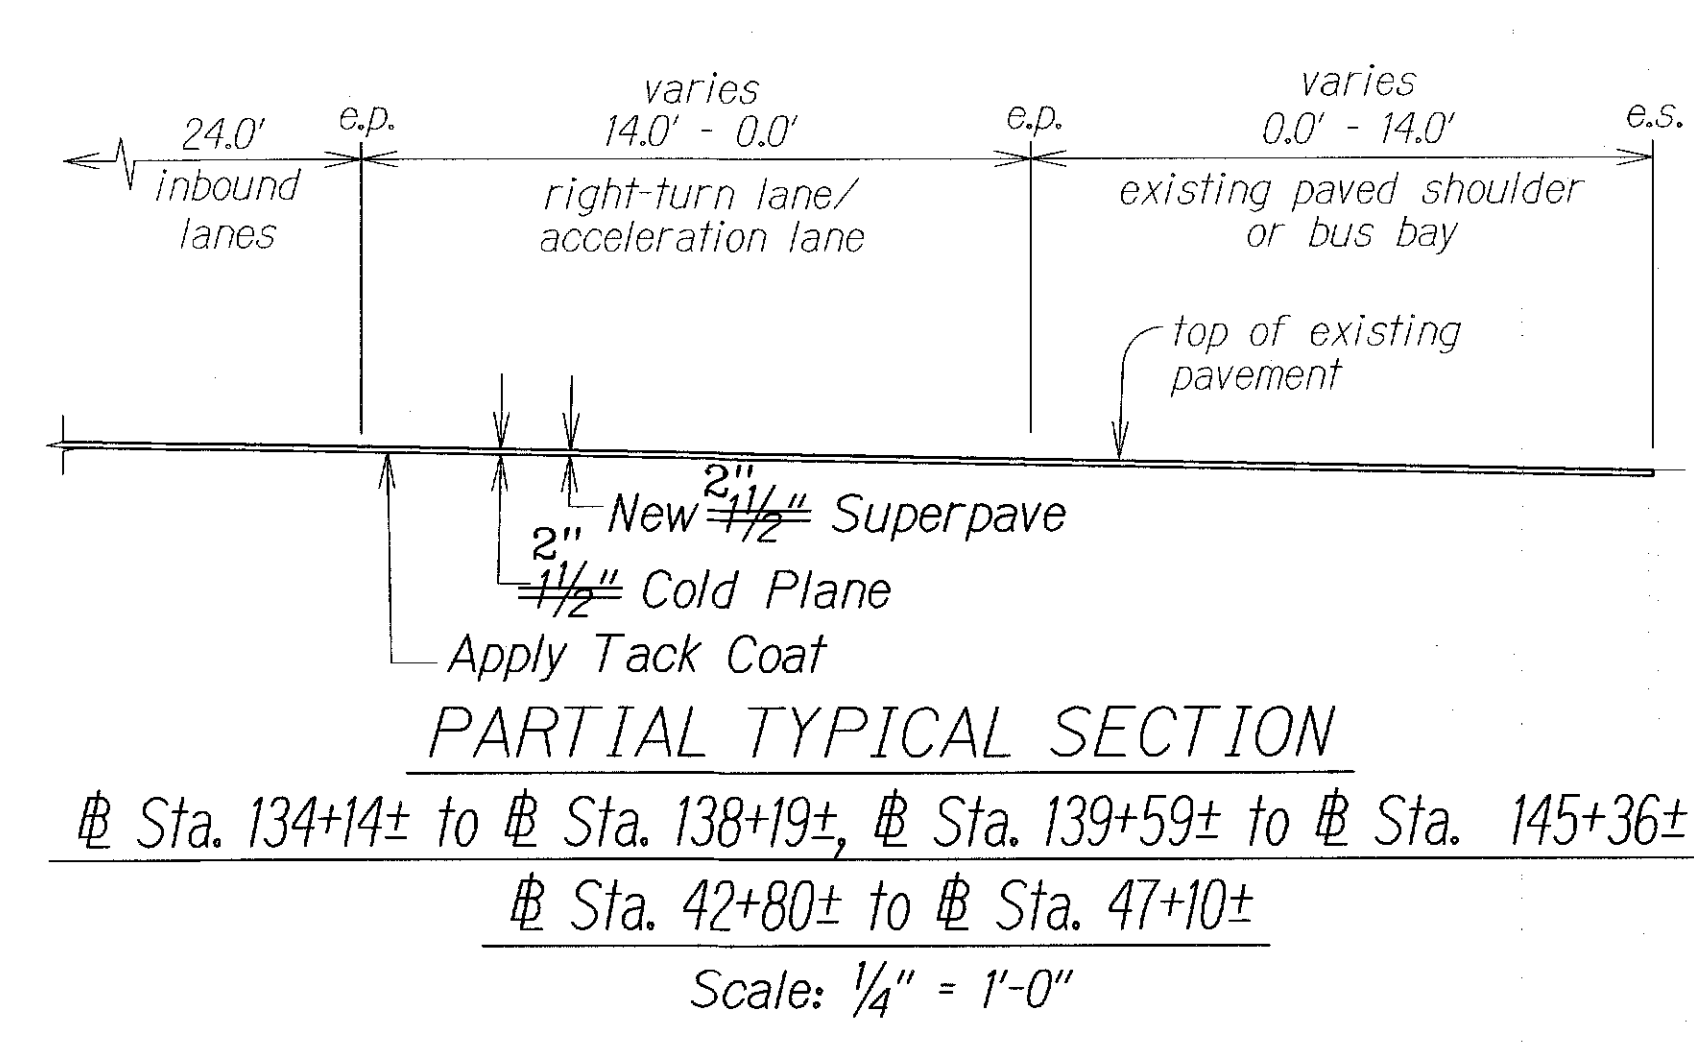
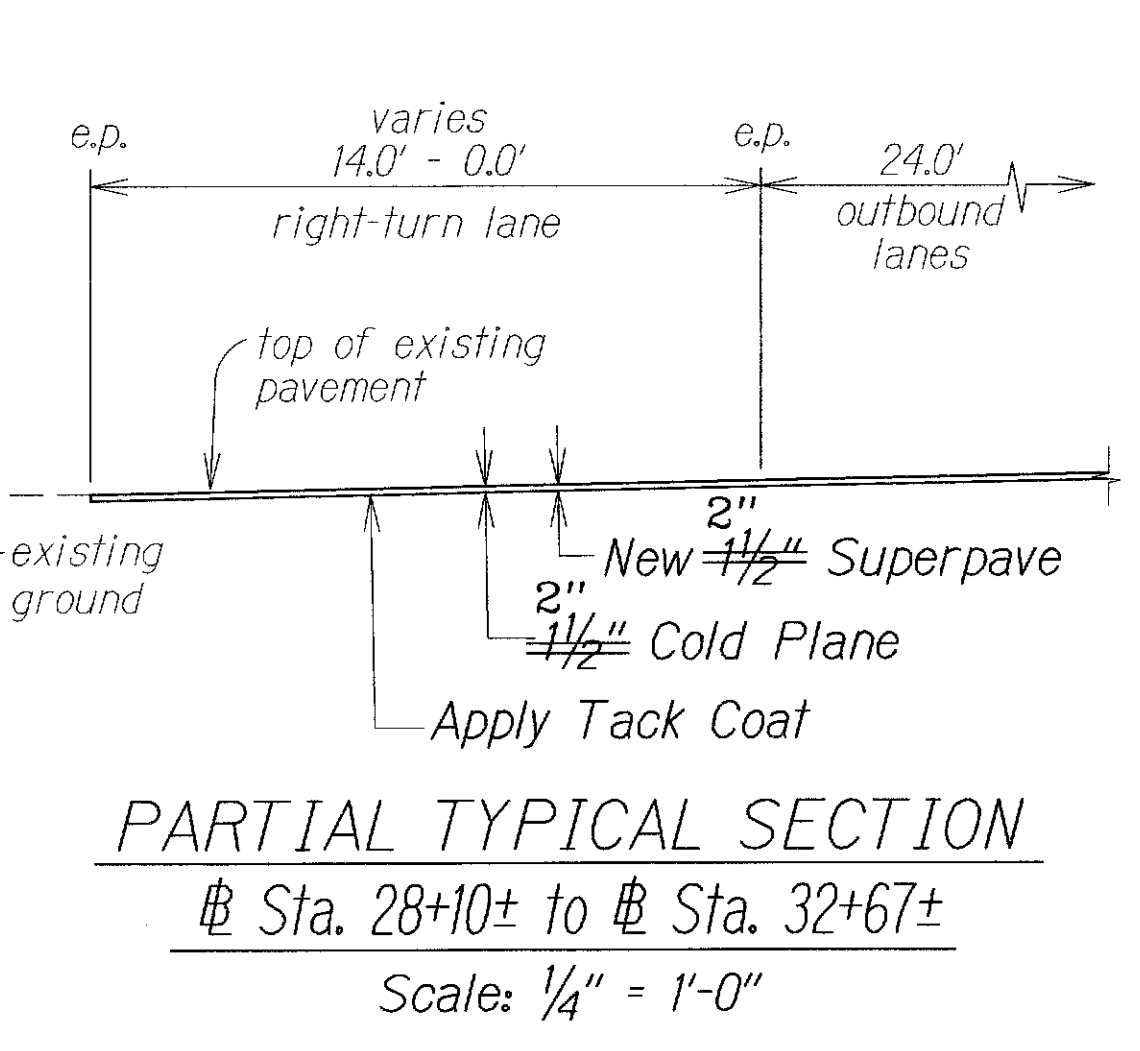
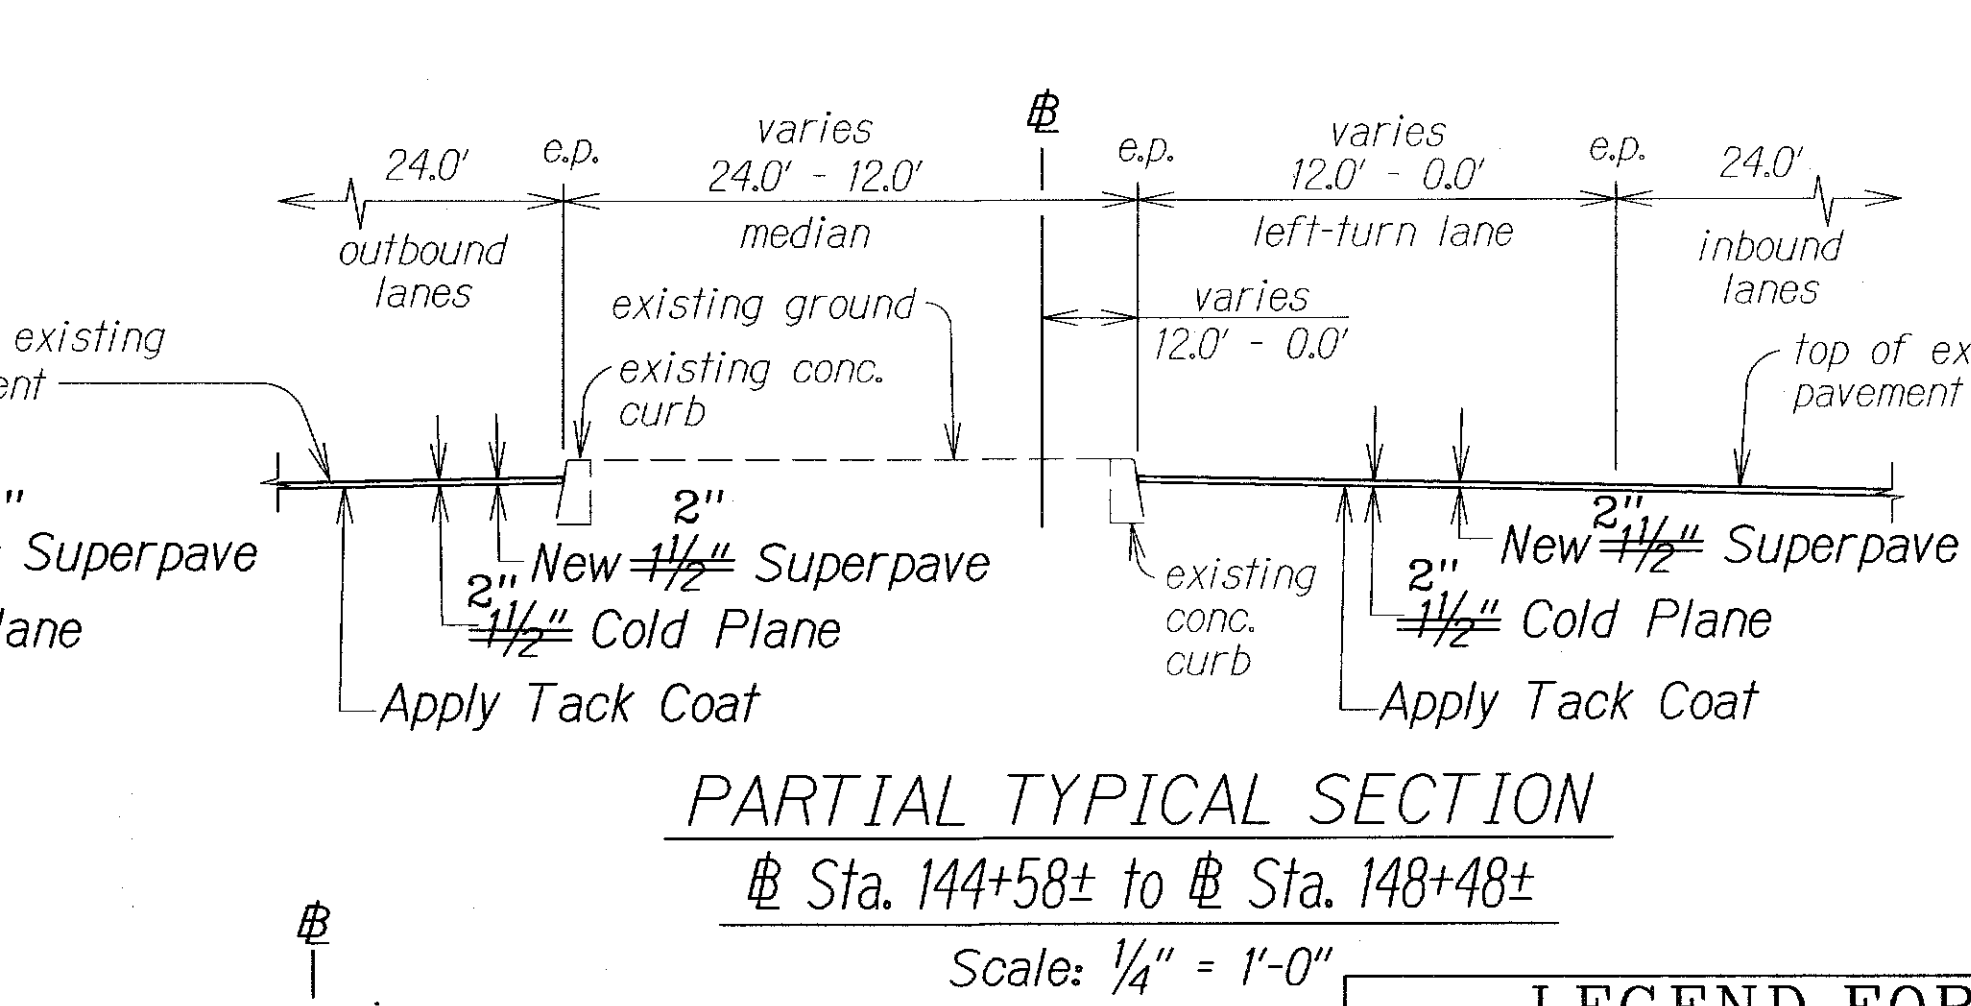
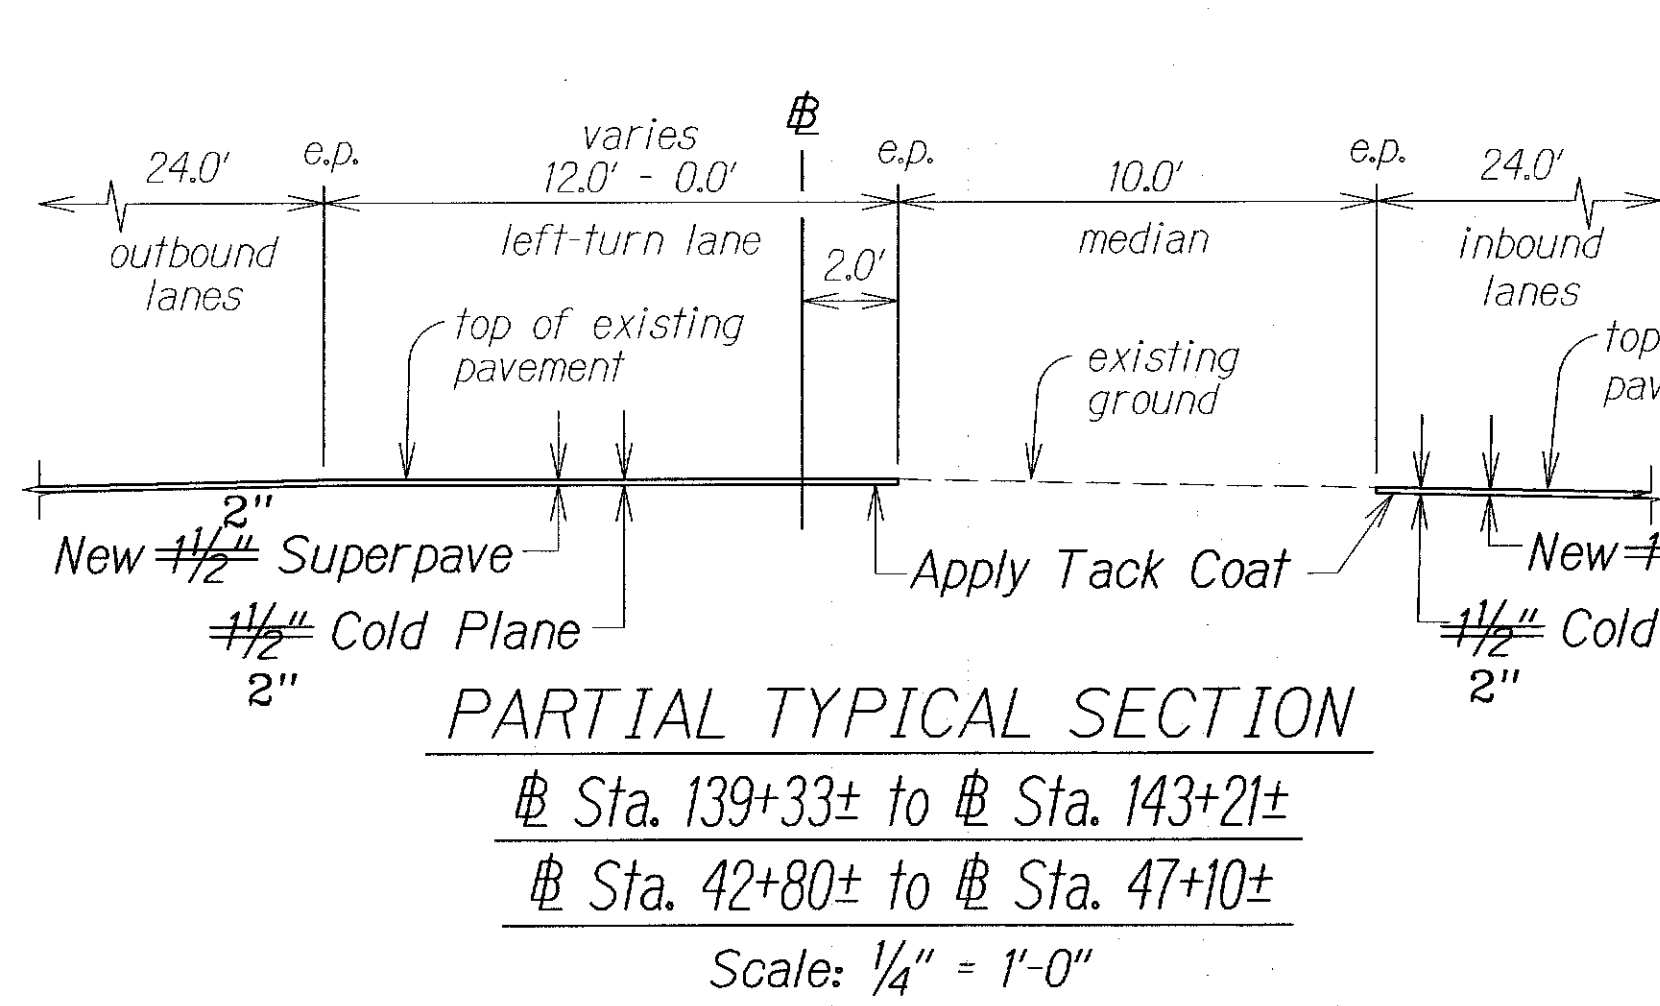
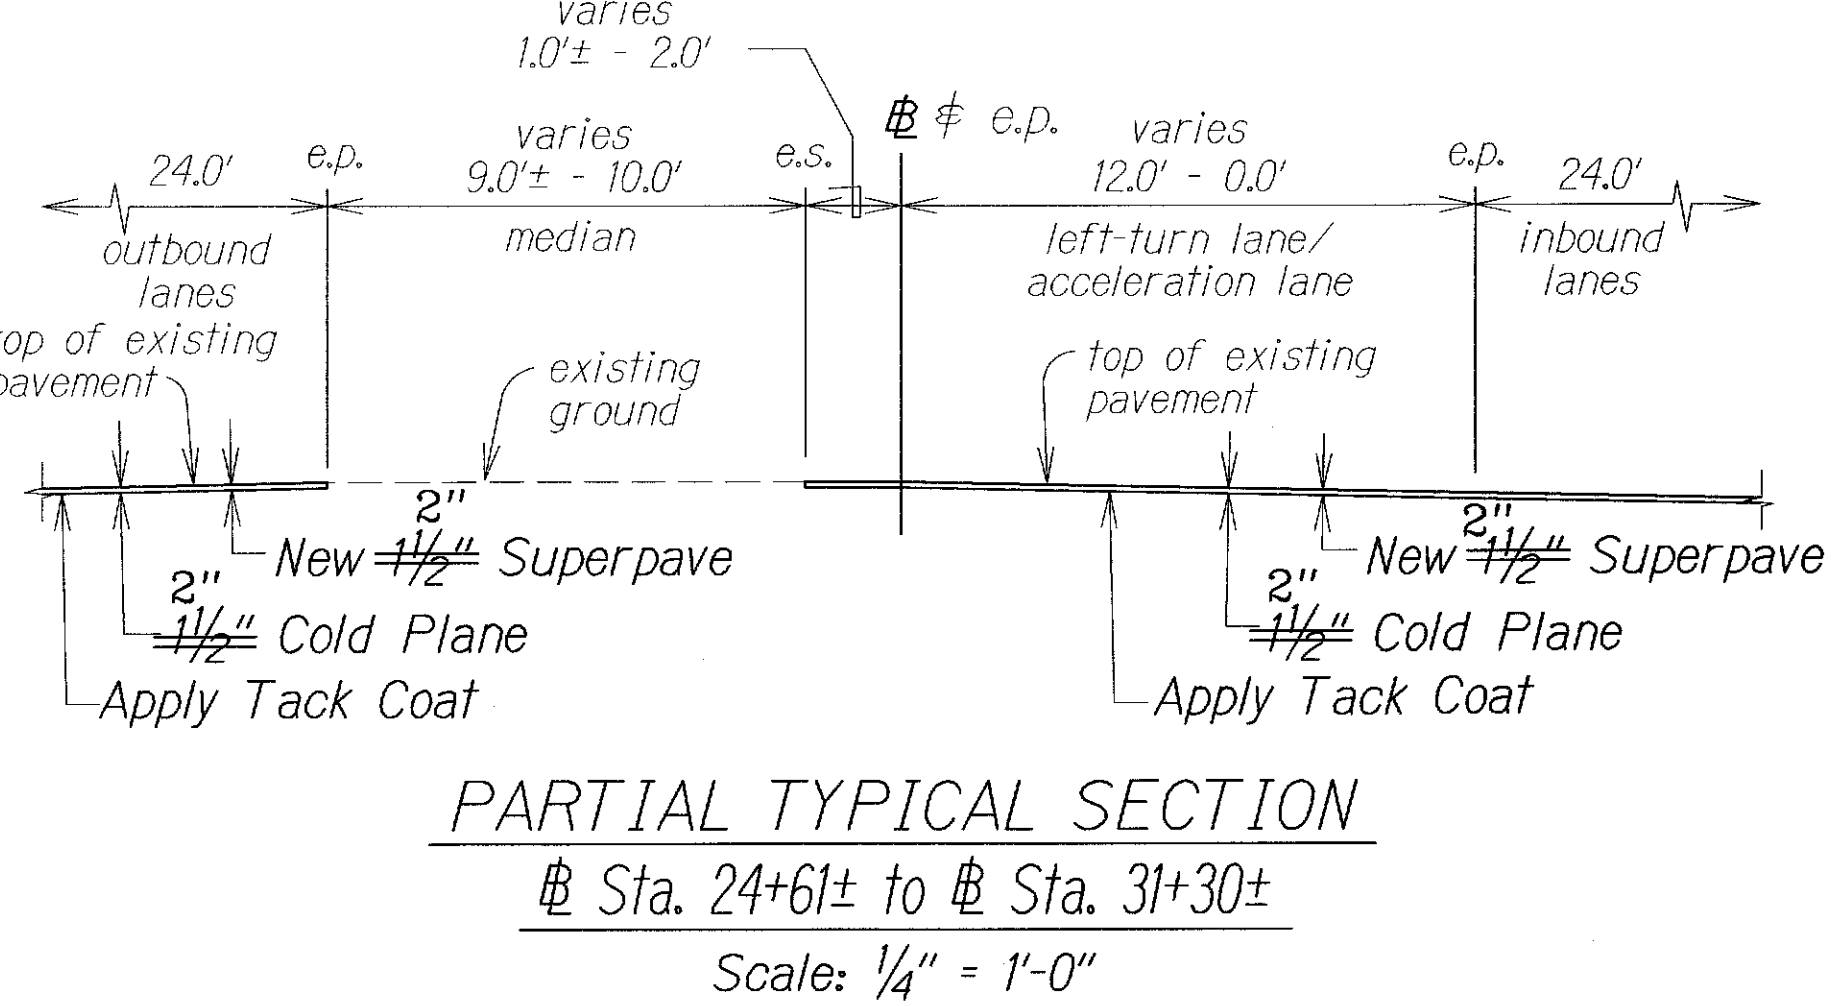
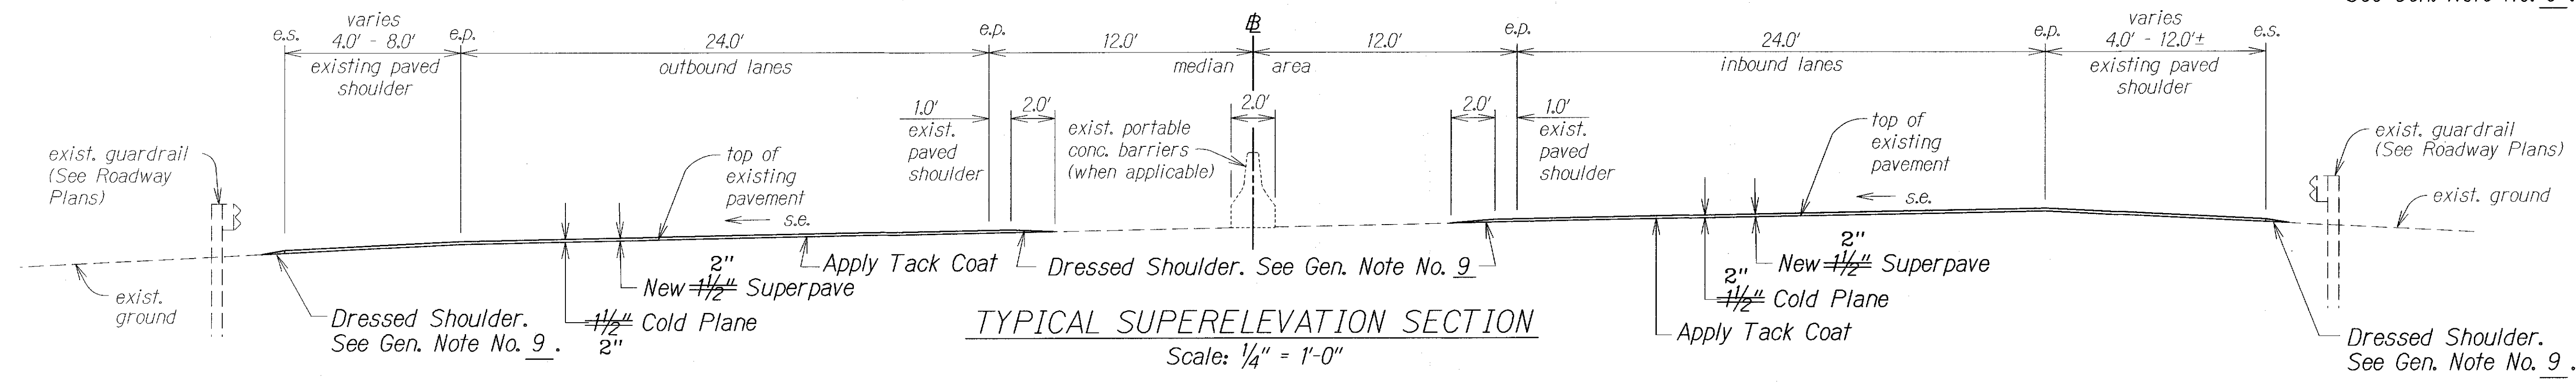


FED. ROAD DIST. NO.	STATE	PROJ. NO.	FISCAL YEAR	SHEET NO.	TOTAL SHEETS
HAWAII	HAW.	93A-01-06M	2010	6	36

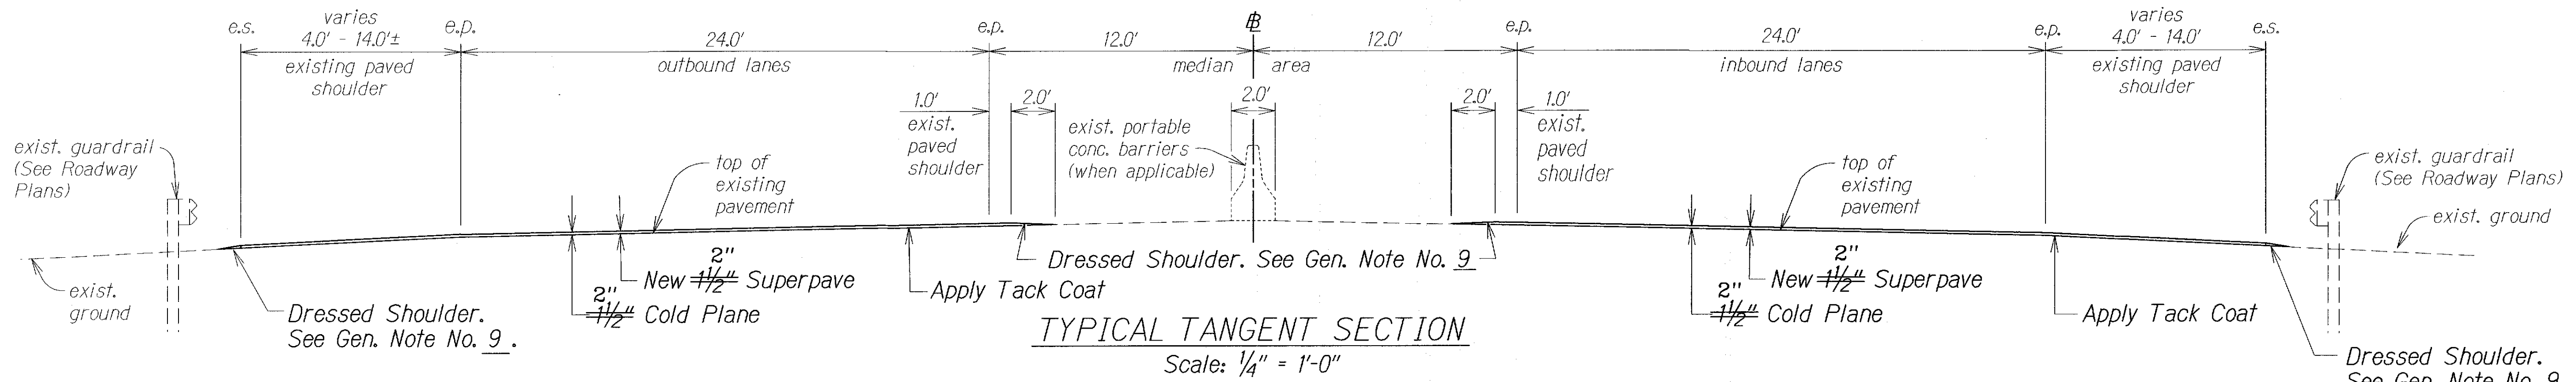

LEGEND FOR AS-BUILT POSTINGS	
	Squiggly line for as-built deletion
	Double line for as-built deletion
	Text for as-built posting

STATE OF HAWAII
DEPARTMENT OF TRANSPORTATION
HIGHWAYS DIVISION

TYPICAL SECTIONS
FARRINGTON HIGHWAY
Pavement Preventive Maintenance
Keananō Bridge to Palailai Interchange
Project No. 93A-01-06M




Scale: 1/4" = 1'-0" Date: March 2010

SHEET No. 1 OF 4 SHEETS

SURVEY PLOTTED BY	DATE
DRAWN BY	
CHECKED BY	
DESIGNED BY	
QUANTITIES BY	
NOTED BY	
ORIGINAL PLAN	

"AS-BUILT"

FED. ROAD DIST. NO.	STATE	PROJ. NO.	FISCAL YEAR	SHEET NO.	TOTAL SHEETS
HAWAII	HAW.	93A-01-06M	2010	7	36

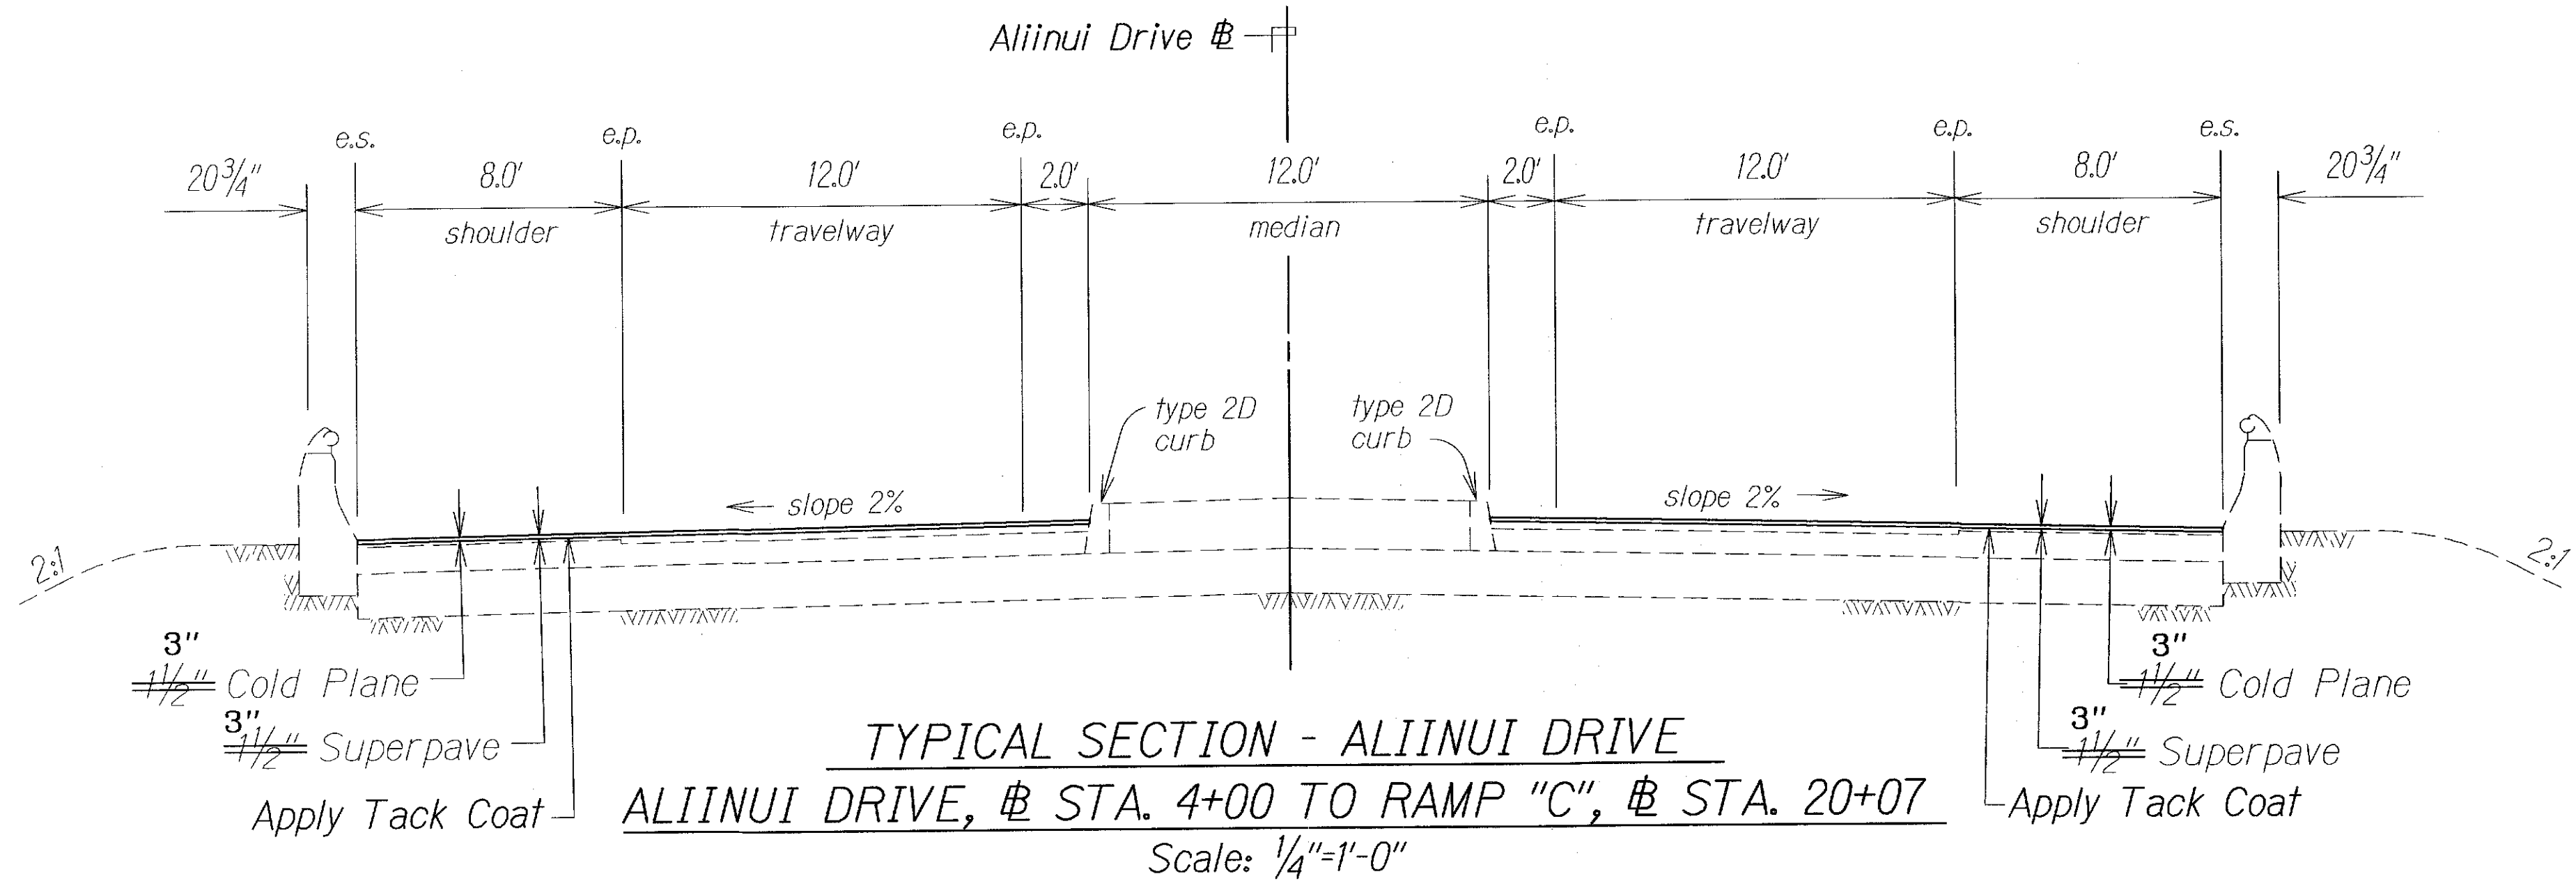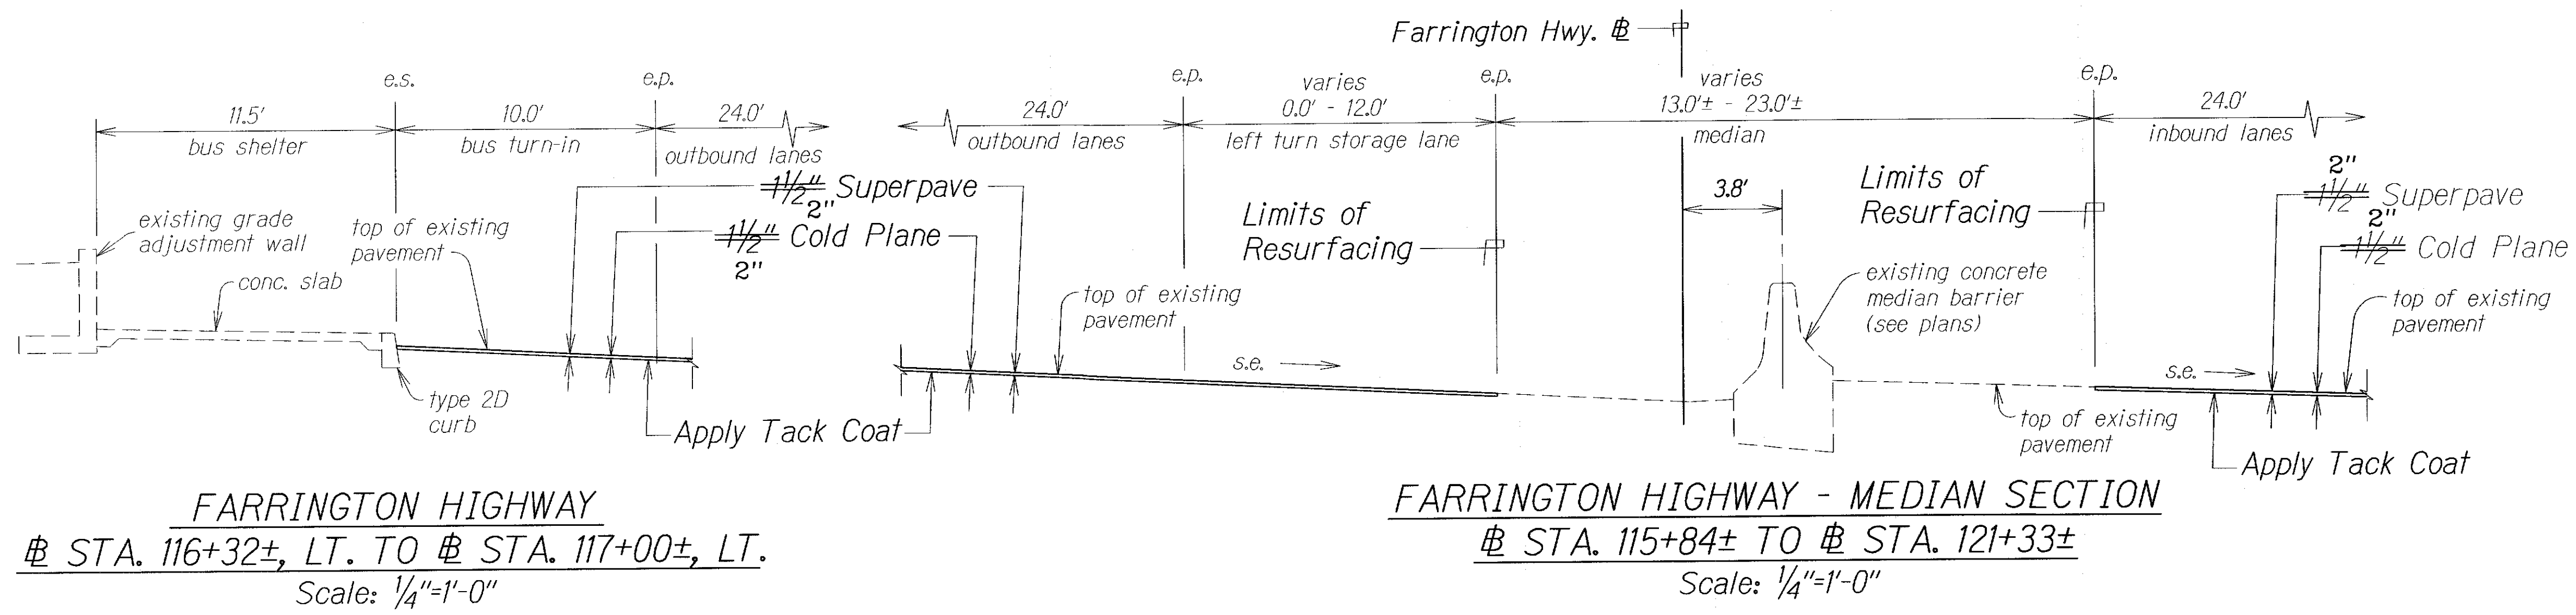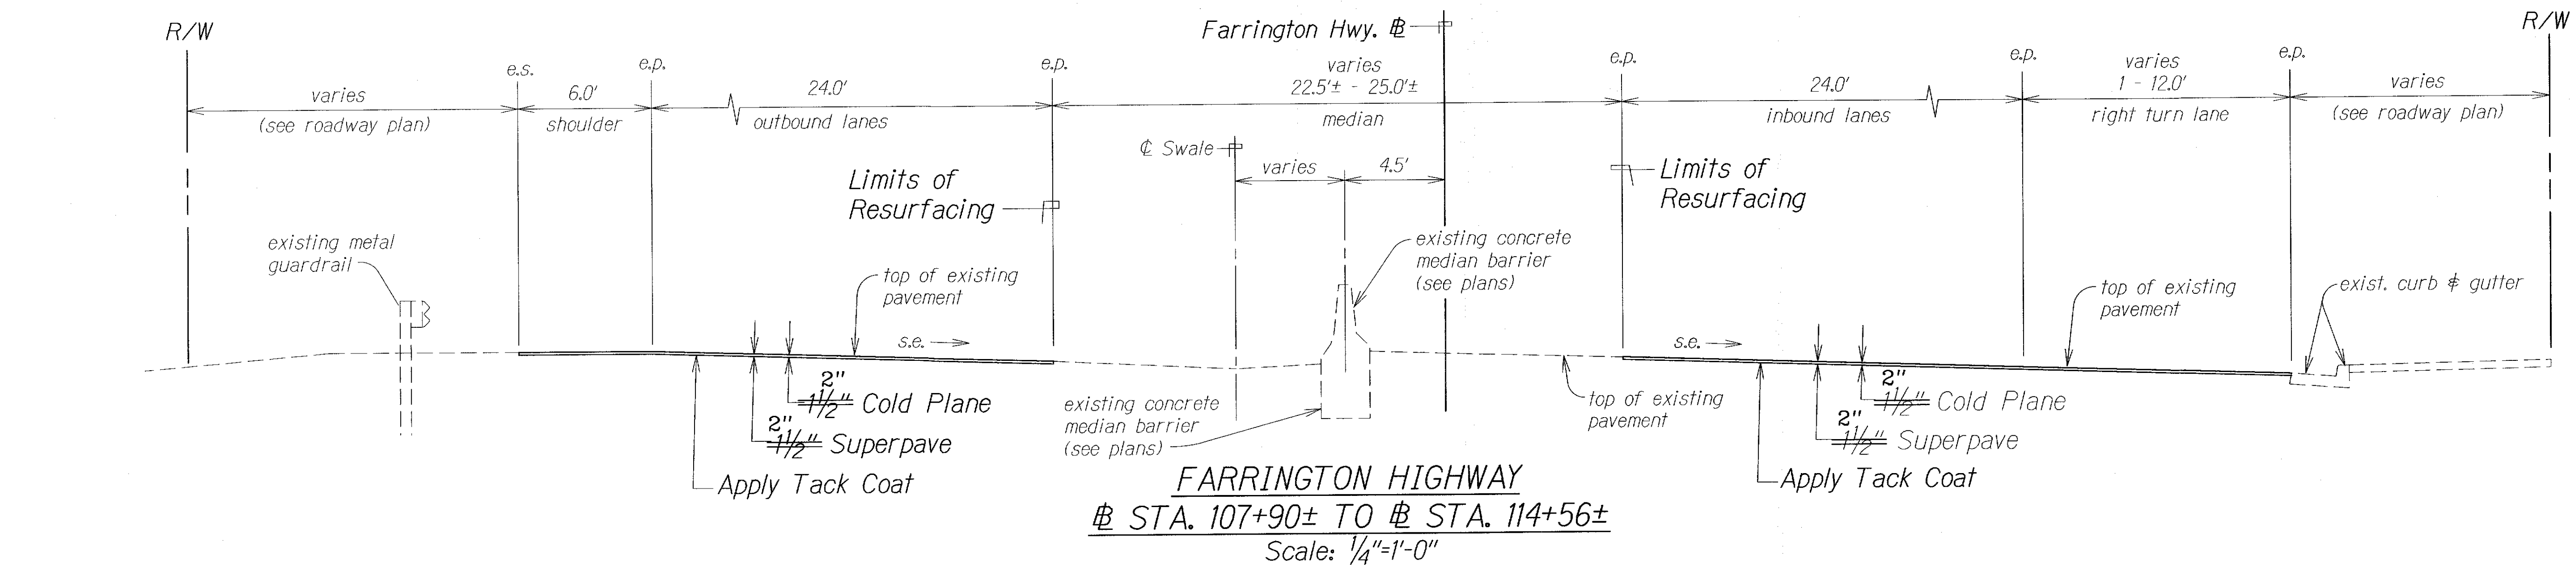

LEGEND FOR AS-BUILT POSTINGS	
	Squiggly line for as-built deletion
	Double line for as-built deletion
	Text for as-built posting


STATE OF HAWAII
DEPARTMENT OF TRANSPORTATION
HIGHWAYS DIVISION

TYPICAL SECTIONS
FARRINGTON HIGHWAY
Pavement Preventive Maintenance
Keananōio Bridge to Palailai Interchange
Project No. 93A-01-06M
Scale: 1/4" = 1'-0" Date: March 2010
SHEET No. 2 OF 4 SHEETS


SURVEY PLOTTED BY	DATE
DRAWN BY	
TRACED BY	
QUANTITIES BY	
CHECKED BY	

"AS-BUILT"


FED. ROAD DIST. NO.	STATE	PROJ. NO.	FISCAL YEAR	SHEET NO.	TOTAL SHEETS
HAWAII	HAW.	93A-01-06M	2010	8	36

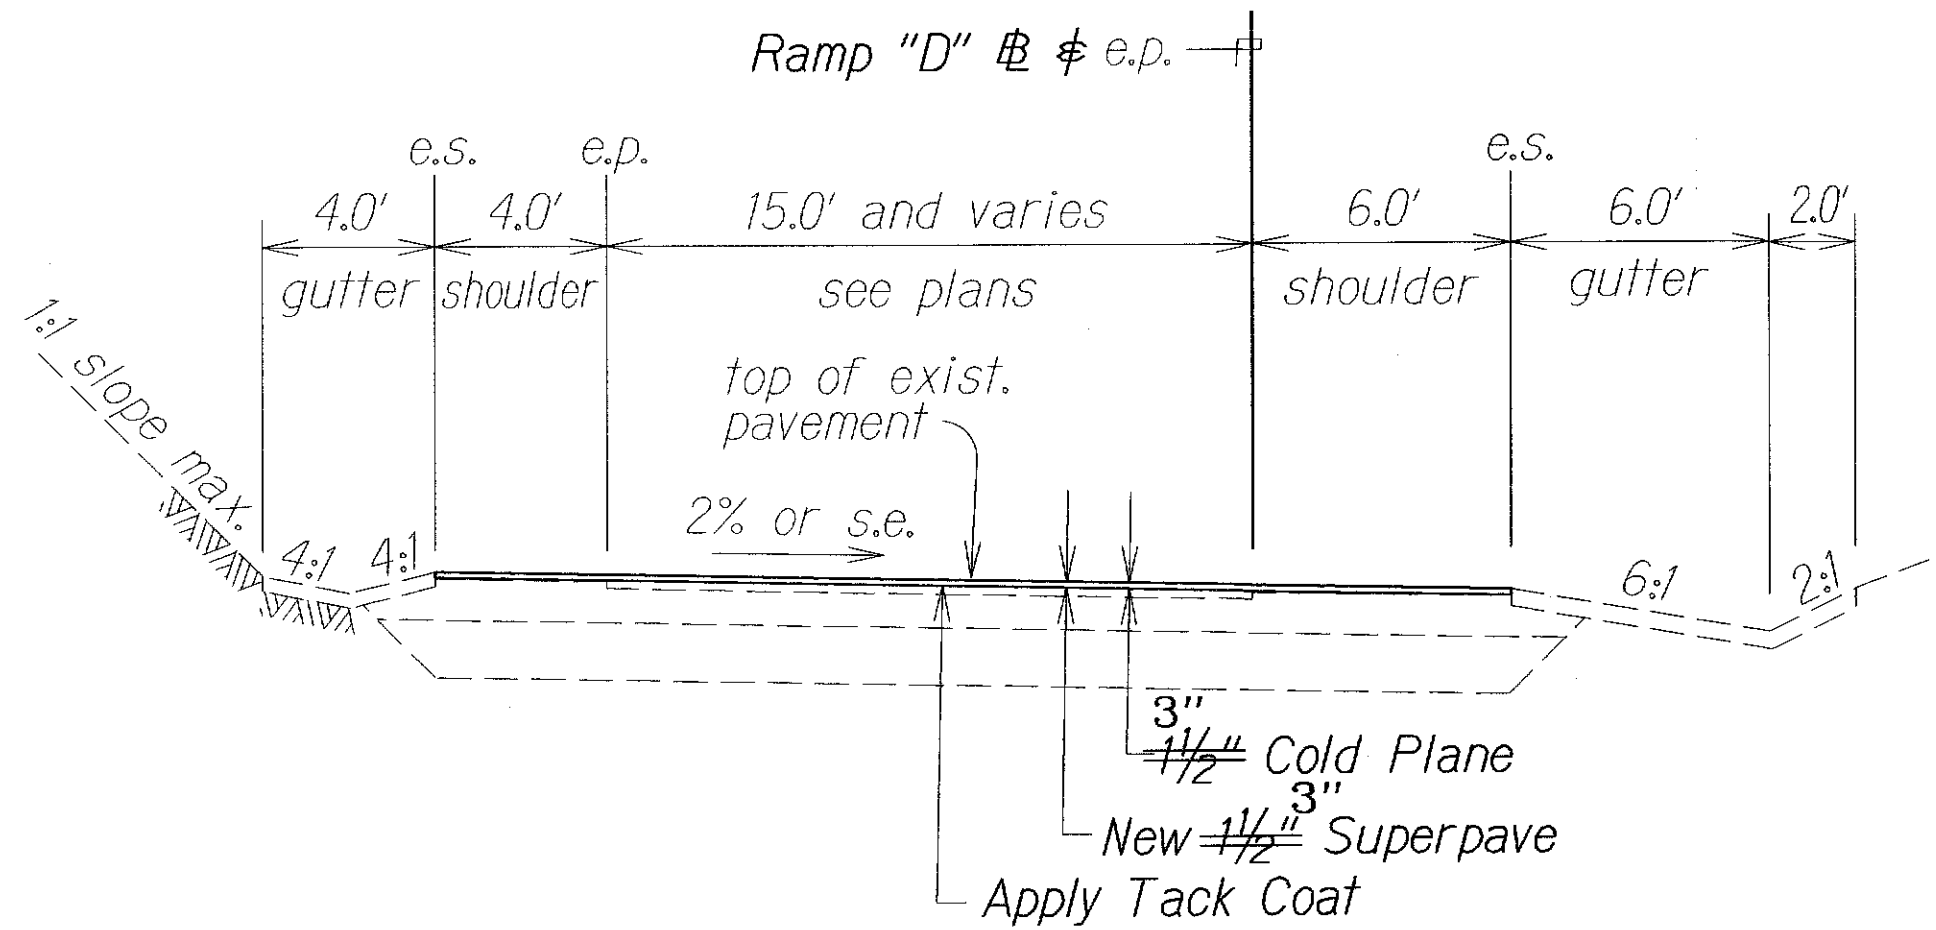


TYPICAL SECTION
RAMP "D"
Scale: 1"=4'

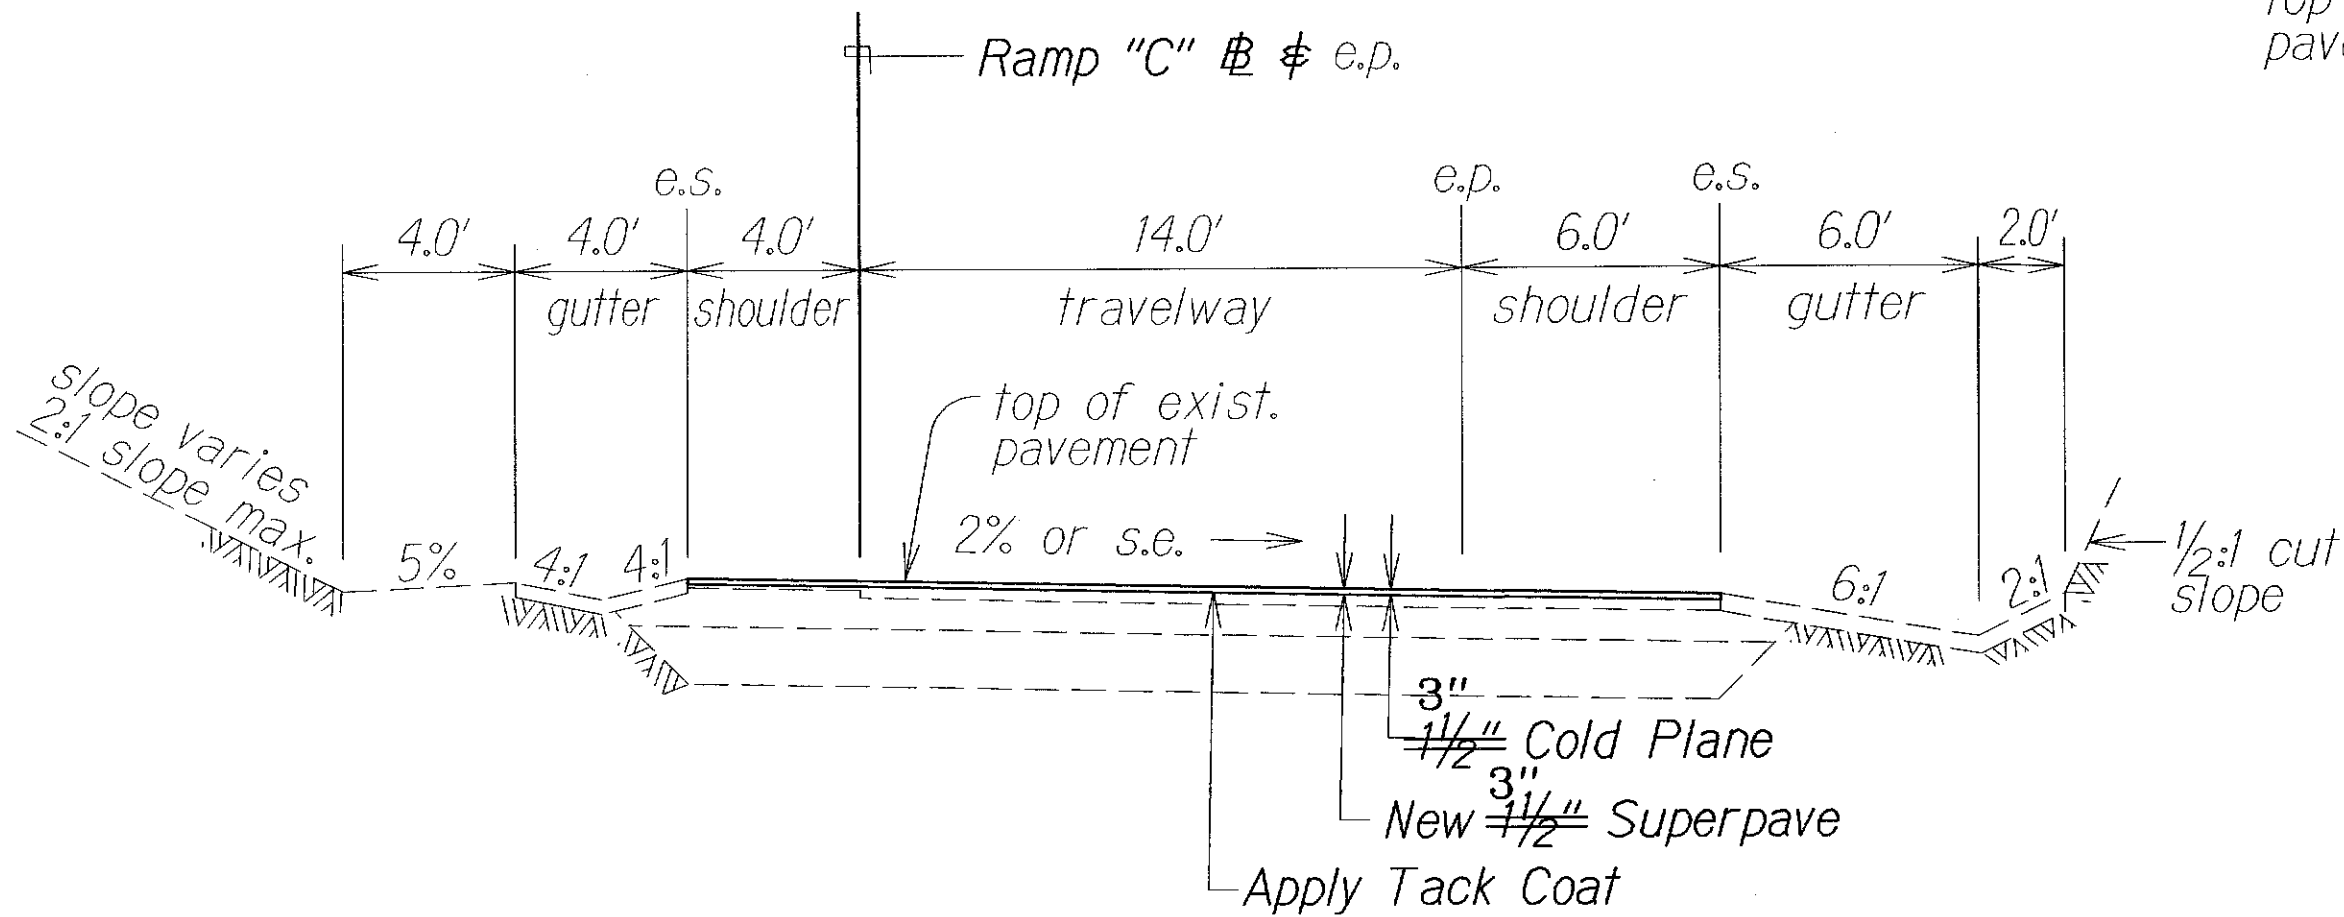


TYPICAL SECTION
RAMP "C"
Scale: 1"=4'

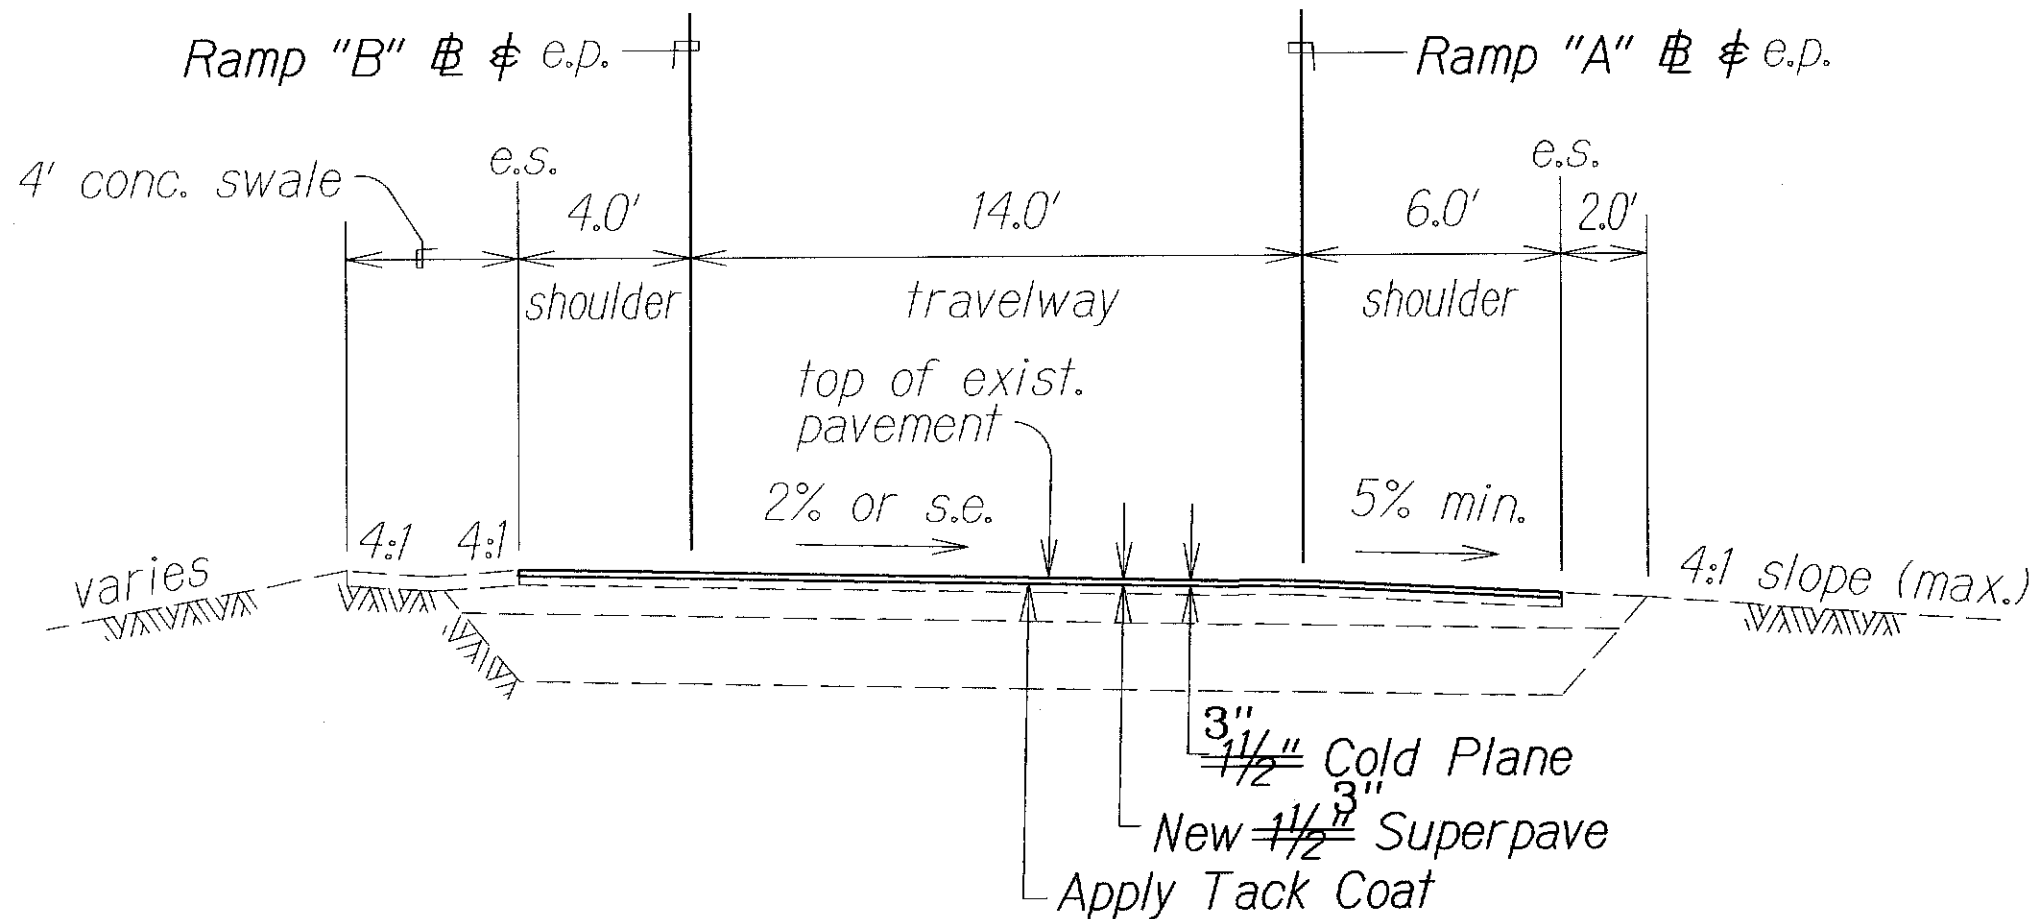


TYPICAL SECTION
RAMPS "A" AND "B"
Scale: 1"=4'

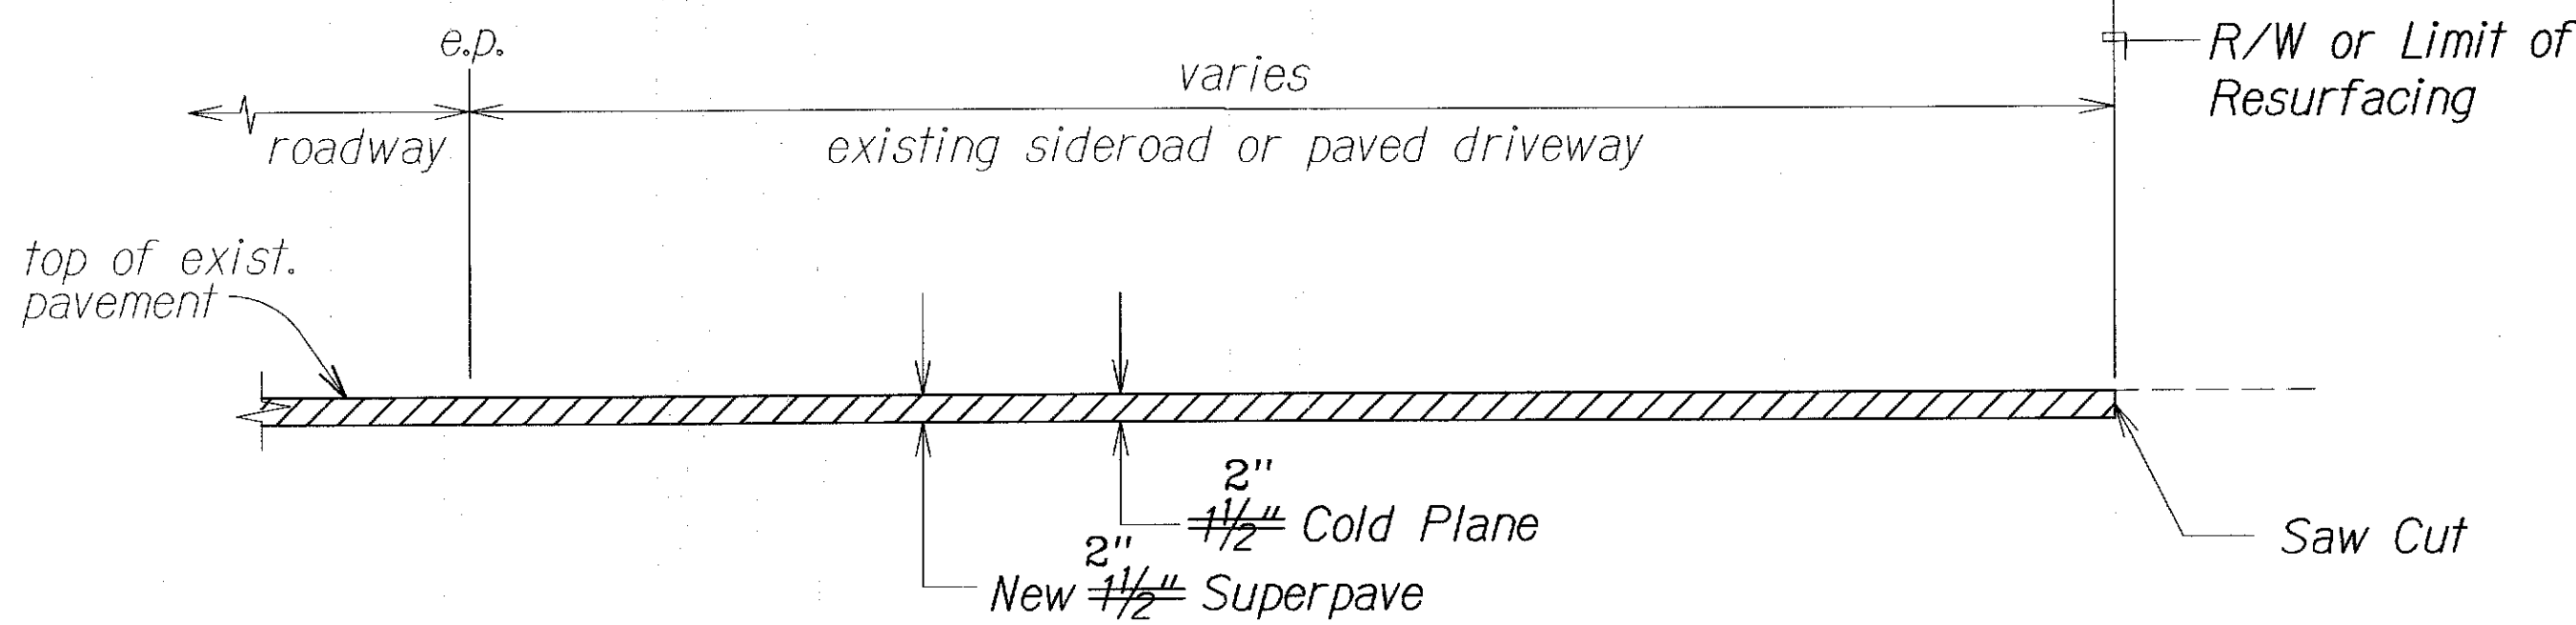

RESURFACING AT PAVED SIDEROAD
OR PAVED DRIVEWAY DETAIL
Not to Scale

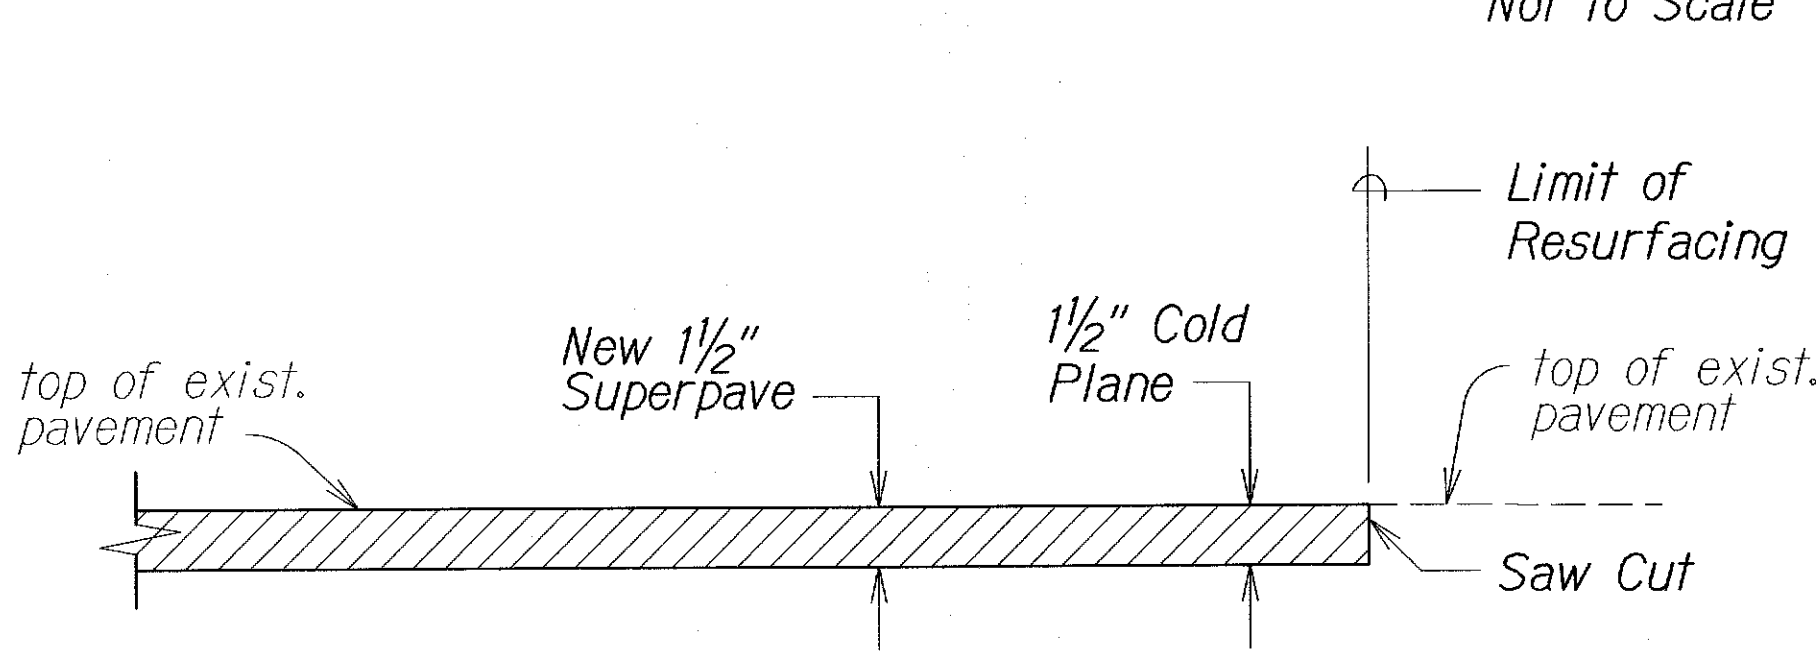


COLD PLANING TRANSITION
TO EXISTING PAVEMENT DETAIL
Not to Scale

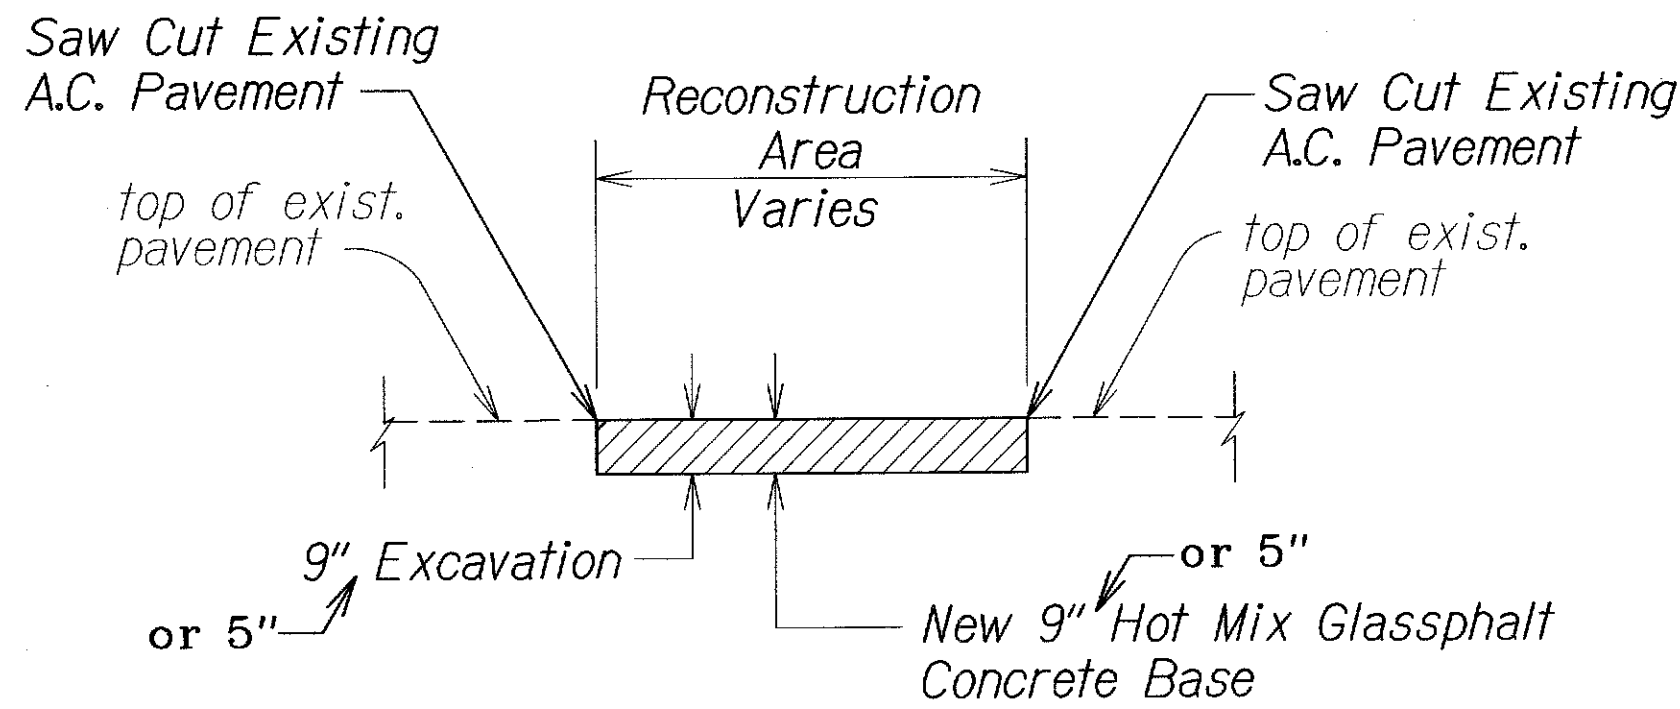

Note: The Cold Planing Work will Remove $\frac{1}{2}$ " of the New Hot Mix Glassphalt Concrete Base prior to Paving of the New $\frac{1}{2}$ " of Superpave.

TYPICAL RECONSTRUCTION AREA
Not to Scale

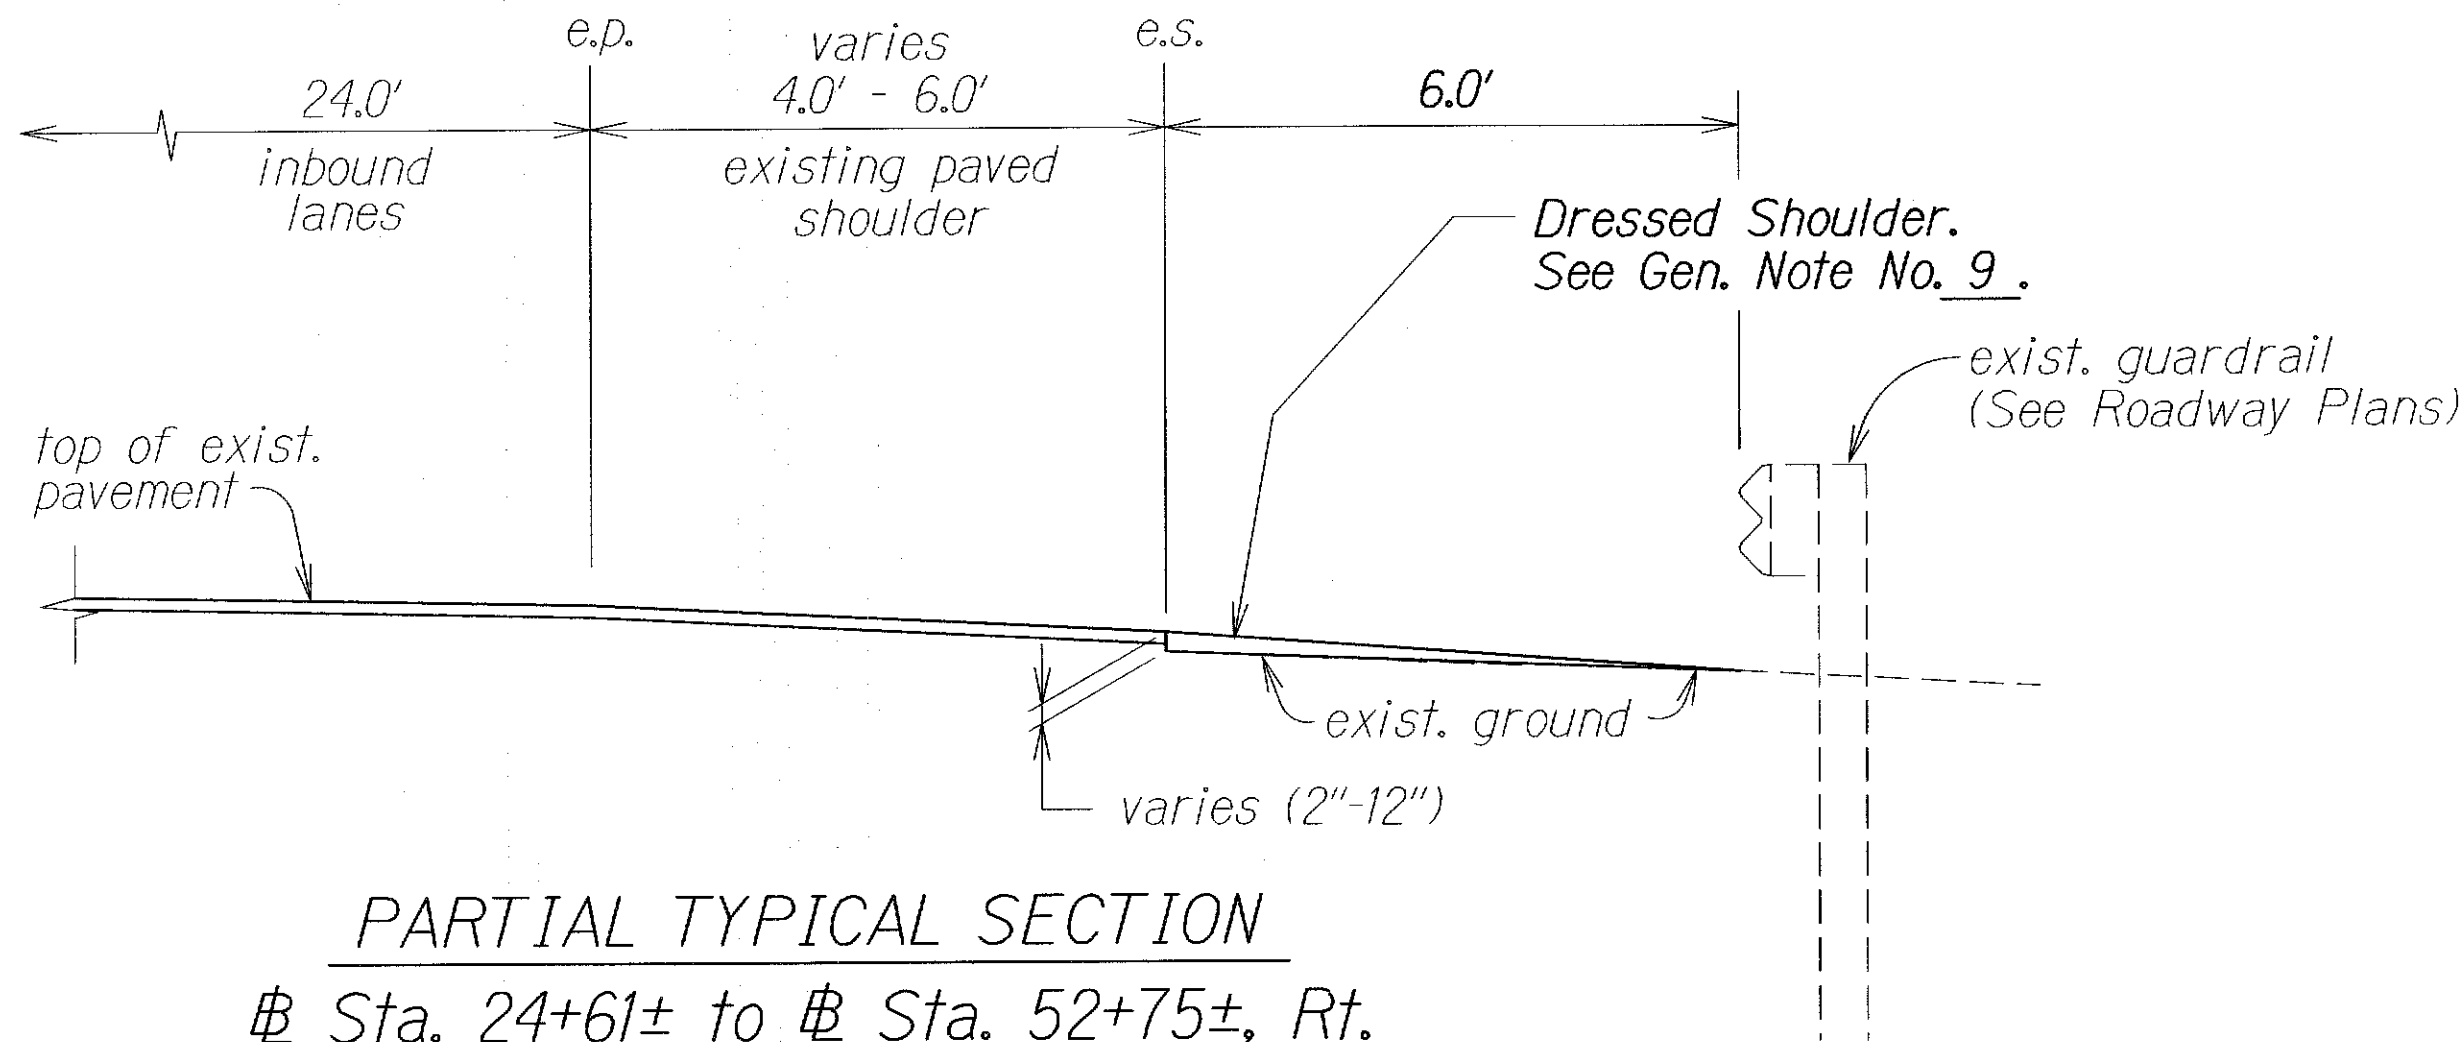

PARTIAL TYPICAL SECTION
Sta. 24+61± to Sta. 52+75±, Rt.
Sta. 93+00± to Sta. 95+00±, Rt.
Scale: 1/2" = 1'-0"


Note: If distance between e.s. and guardrail face is less than 6-ft. dressing of shoulder shall be up to the face of the guardrail.

LEGEND FOR AS-BUILT POSTINGS	
	Squiggly line for as-built deletion
	Double line for as-built deletion
Roadway	Text for as-built posting


STATE OF HAWAII DEPARTMENT OF TRANSPORTATION HIGHWAYS DIVISION	
TYPICAL SECTIONS	
FARRINGTON HIGHWAY	
Pavement Preventive Maintenance	
Keananolo Bridge to Palailai Interchange	
Project No. 93A-01-06M	
Scale: As Noted	Date: March 2010
SHEET No. 3 OF 4 SHEETS	

ORIGINAL PLAN	SURVEY PLOTTED BY	DATE
NOTE BOOK	DRAWN BY	
dd2	QUANTITIES BY	
N. Vardoglu	CHECKED BY	

FED. ROAD DIST. NO.	STATE	PROJ. NO.	FISCAL YEAR	SHEET NO.	TOTAL SHEETS
HAWAII	HAW.	93A-01-06M	2010	9	36

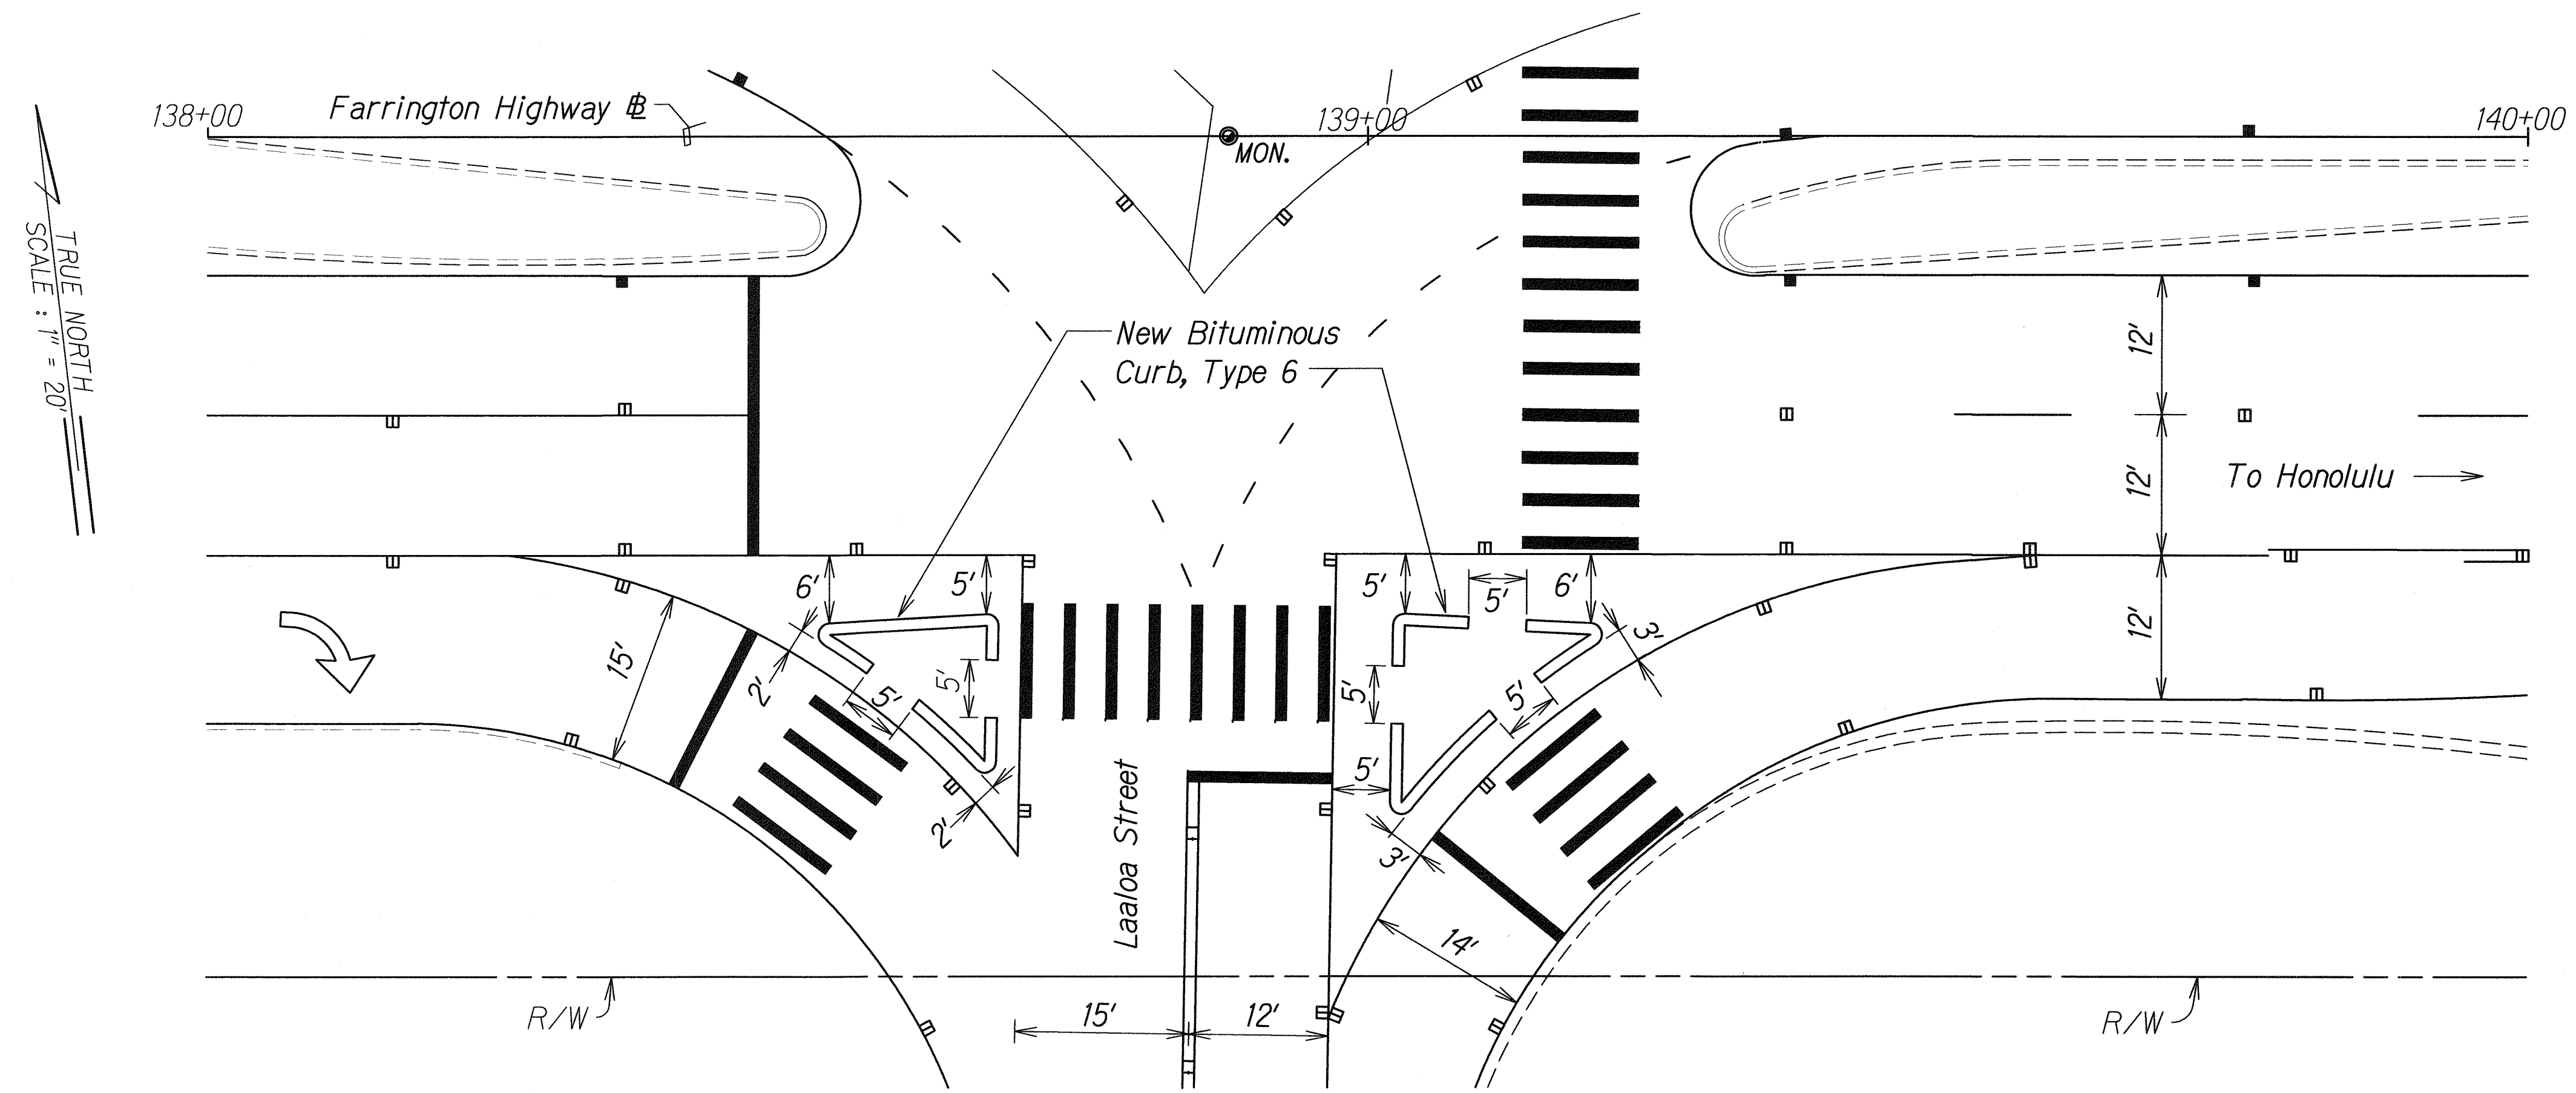


INTERSECTION DETAIL
Scale: 1"=20'

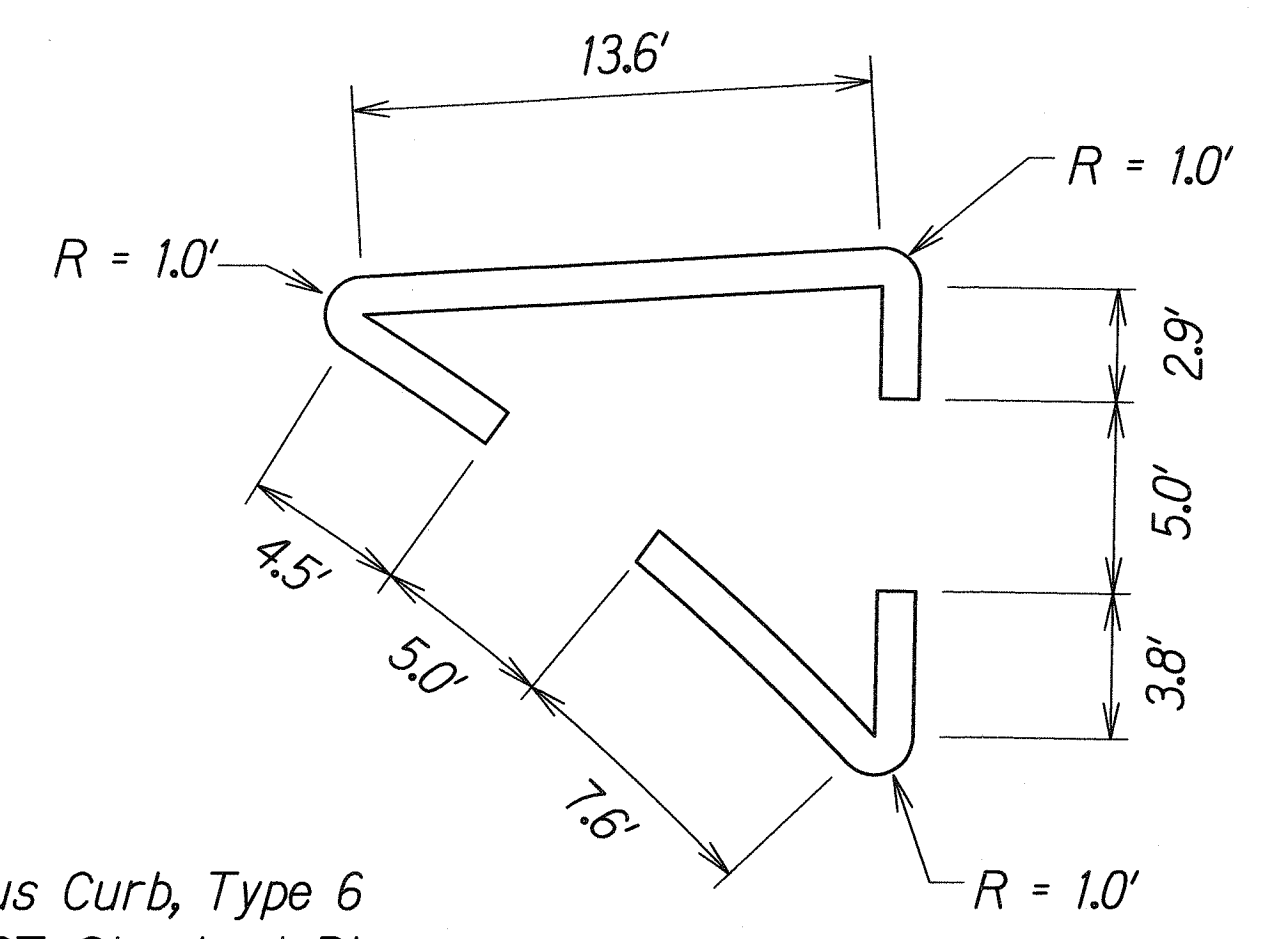

DETAIL
Scale: 1"=5'

Install 40.0 L.F. Bituminous Curb, Type 6
For Details, Refer to HDOT Standard Plan D-04 .

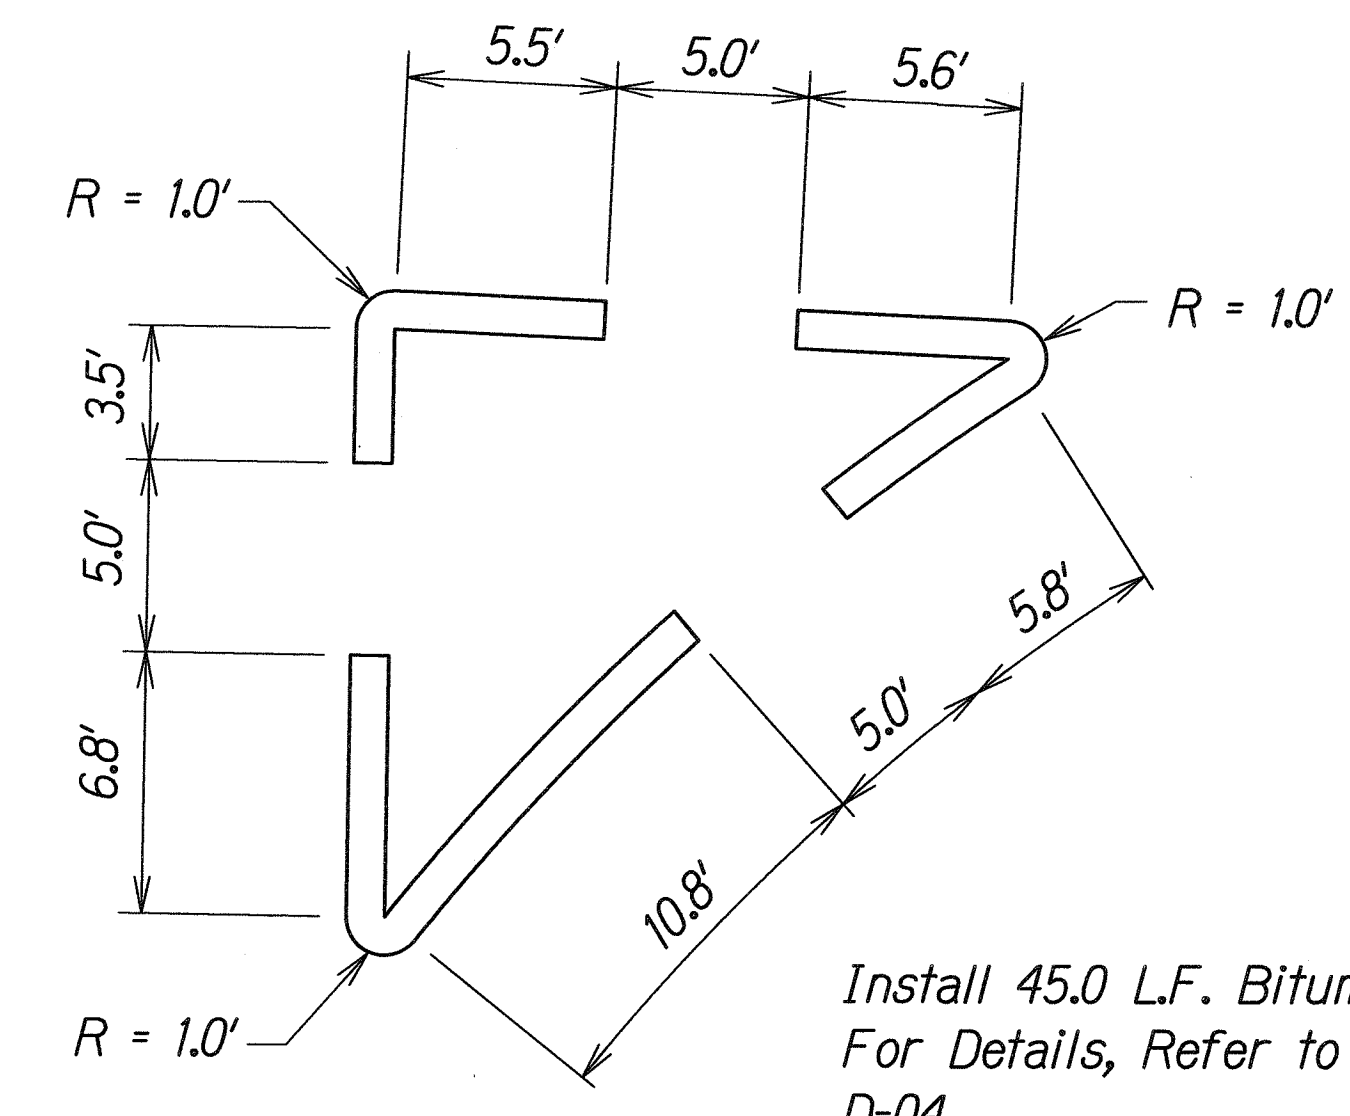

DETAIL
Scale: 1"=5'

Install 45.0 L.F. Bituminous Curb, Type 6
For Details, Refer to HDOT Standard Plan D-04 .

STATE OF HAWAII
DEPARTMENT OF TRANSPORTATION
HIGHWAYS DIVISION

TYPICAL DETAILS
FARRINGTON HIGHWAY
Pavement Preventive Maintenance
Keanoio Bridge to Palailai Interchange
Project No. 93A-01-06M

Scale: As Shown
Date: March 2010

SHEET No. 4 OF 4 SHEETS

DESIGNED BY	DATE
CHECKED BY	
NOTED BY	
QUANTITIES BY	
PLANNED BY	
ORIGINAL PLAN	