
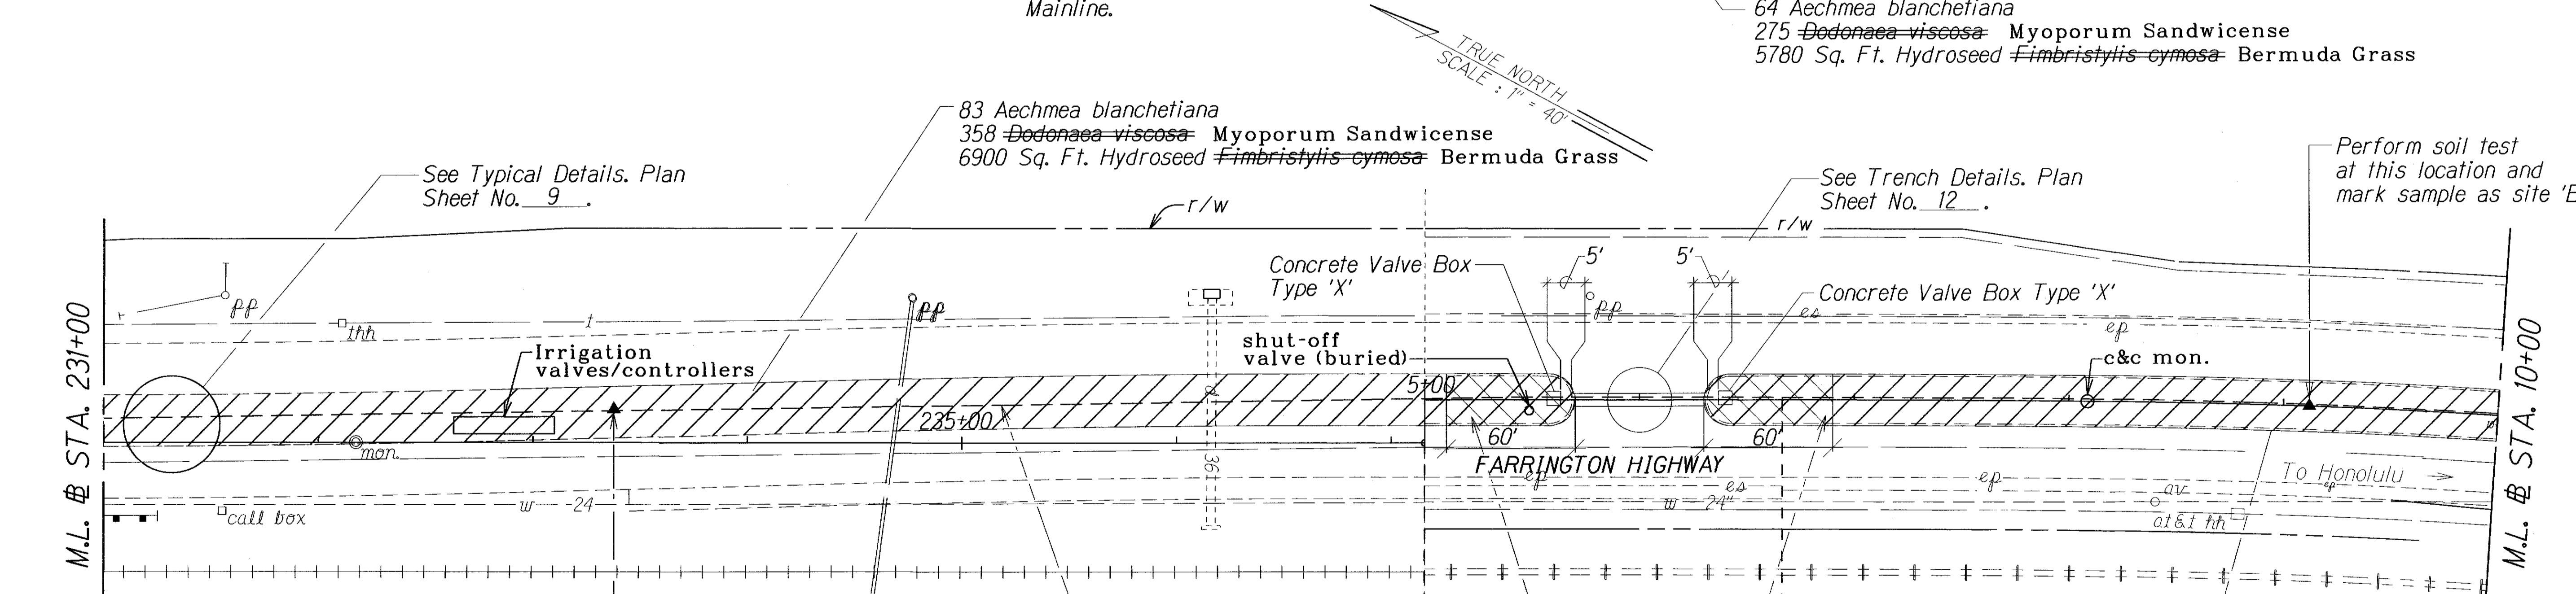


FED. ROAD DIST. NO.	STATE	PROJ. NO.	FISCAL YEAR	SHEET NO.	TOTAL SHEETS
HAWAII	HAW.	93A-02-10M	2010	6	12

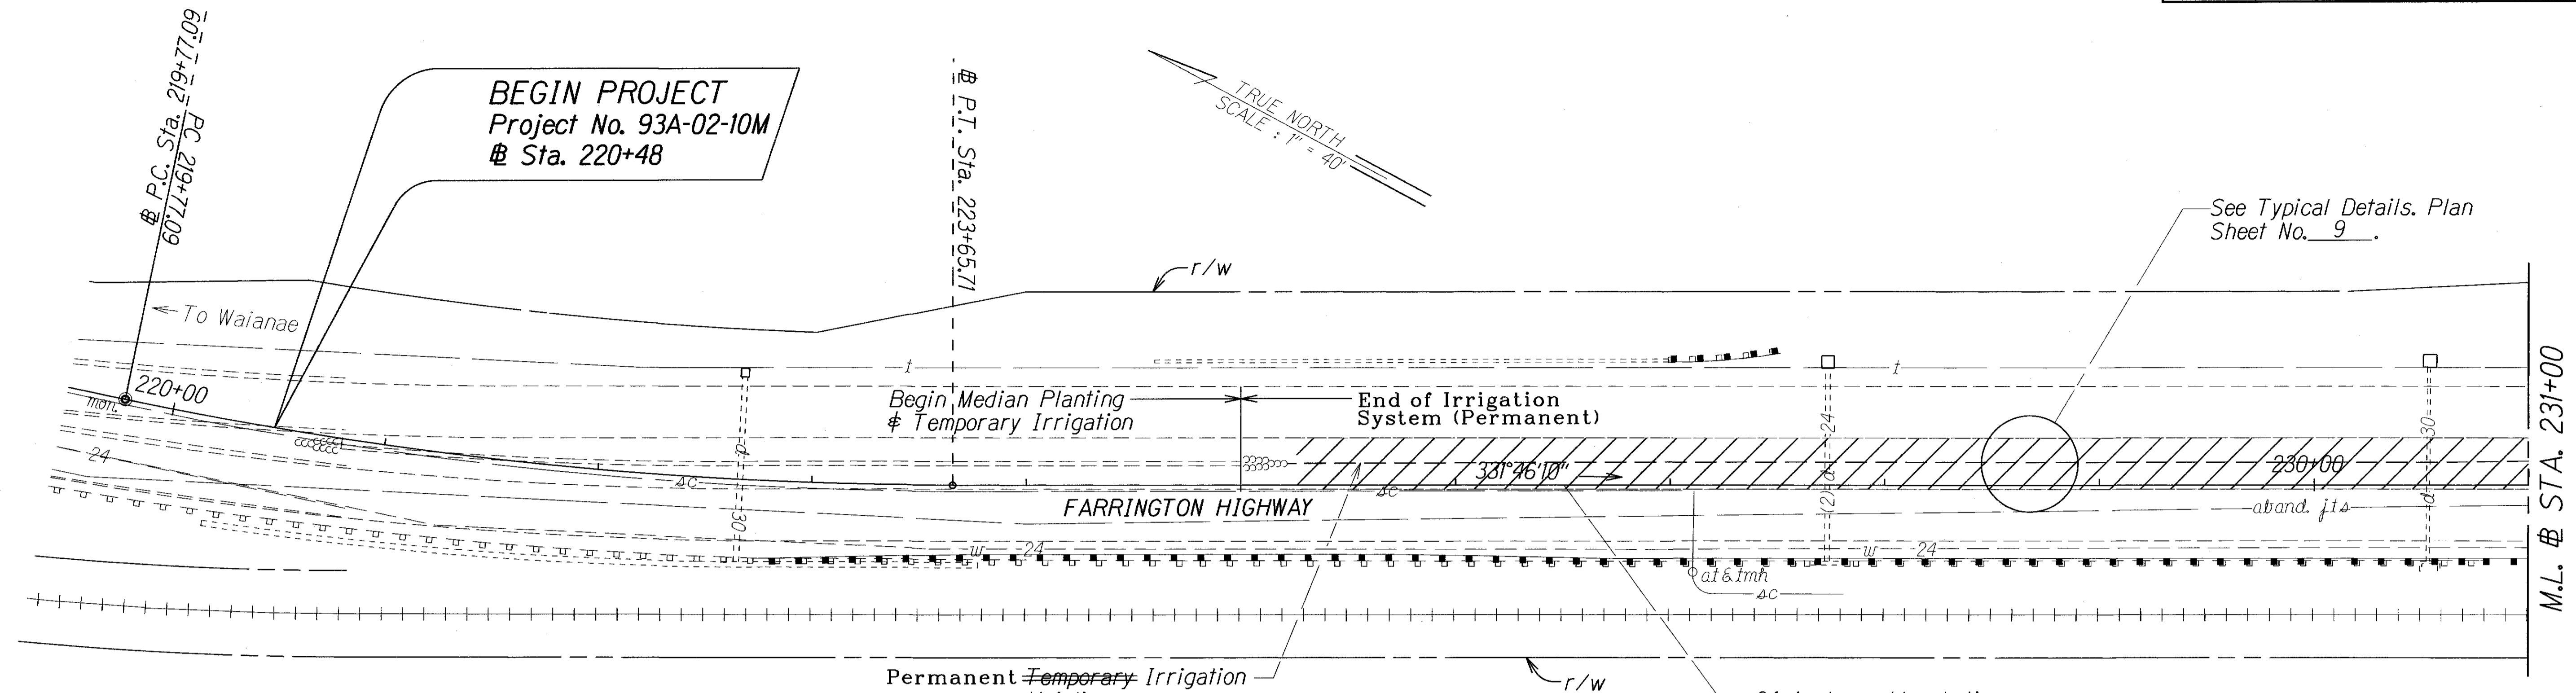

ORIGINAL PLAN	SURVEY PLOTTED BY	DATE
NOTED BOOK	TRACED BY	
DESIGNED BY	QUANTITIES BY	
CHECKED BY		

LEGEND FOR AS-BUILT POSTINGS	
	Squiggly line for as-built deletion
	Double line for as-built deletion
Roadway	Text for as-built posting

STATE OF HAWAII
DEPARTMENT OF TRANSPORTATION
HIGHWAYS DIVISION

LANDSCAPE PLANS

FARRINGTON HIGHWAY MEDIAN IMPROVEMENTS


Milepost 3.50 to Milepost 4.36
Project No. 93A-02-10M

Scale: 1" = 40' Date: April, 2010

SHEET No. 1 OF 3 SHEETS

"AS-BUILT"

FED. ROAD DIST. NO.	STATE	PROJ. NO.	FISCAL YEAR	SHEET NO.	TOTAL SHEETS
HAWAII	HAW.	93A-02-10M	2010	8	12

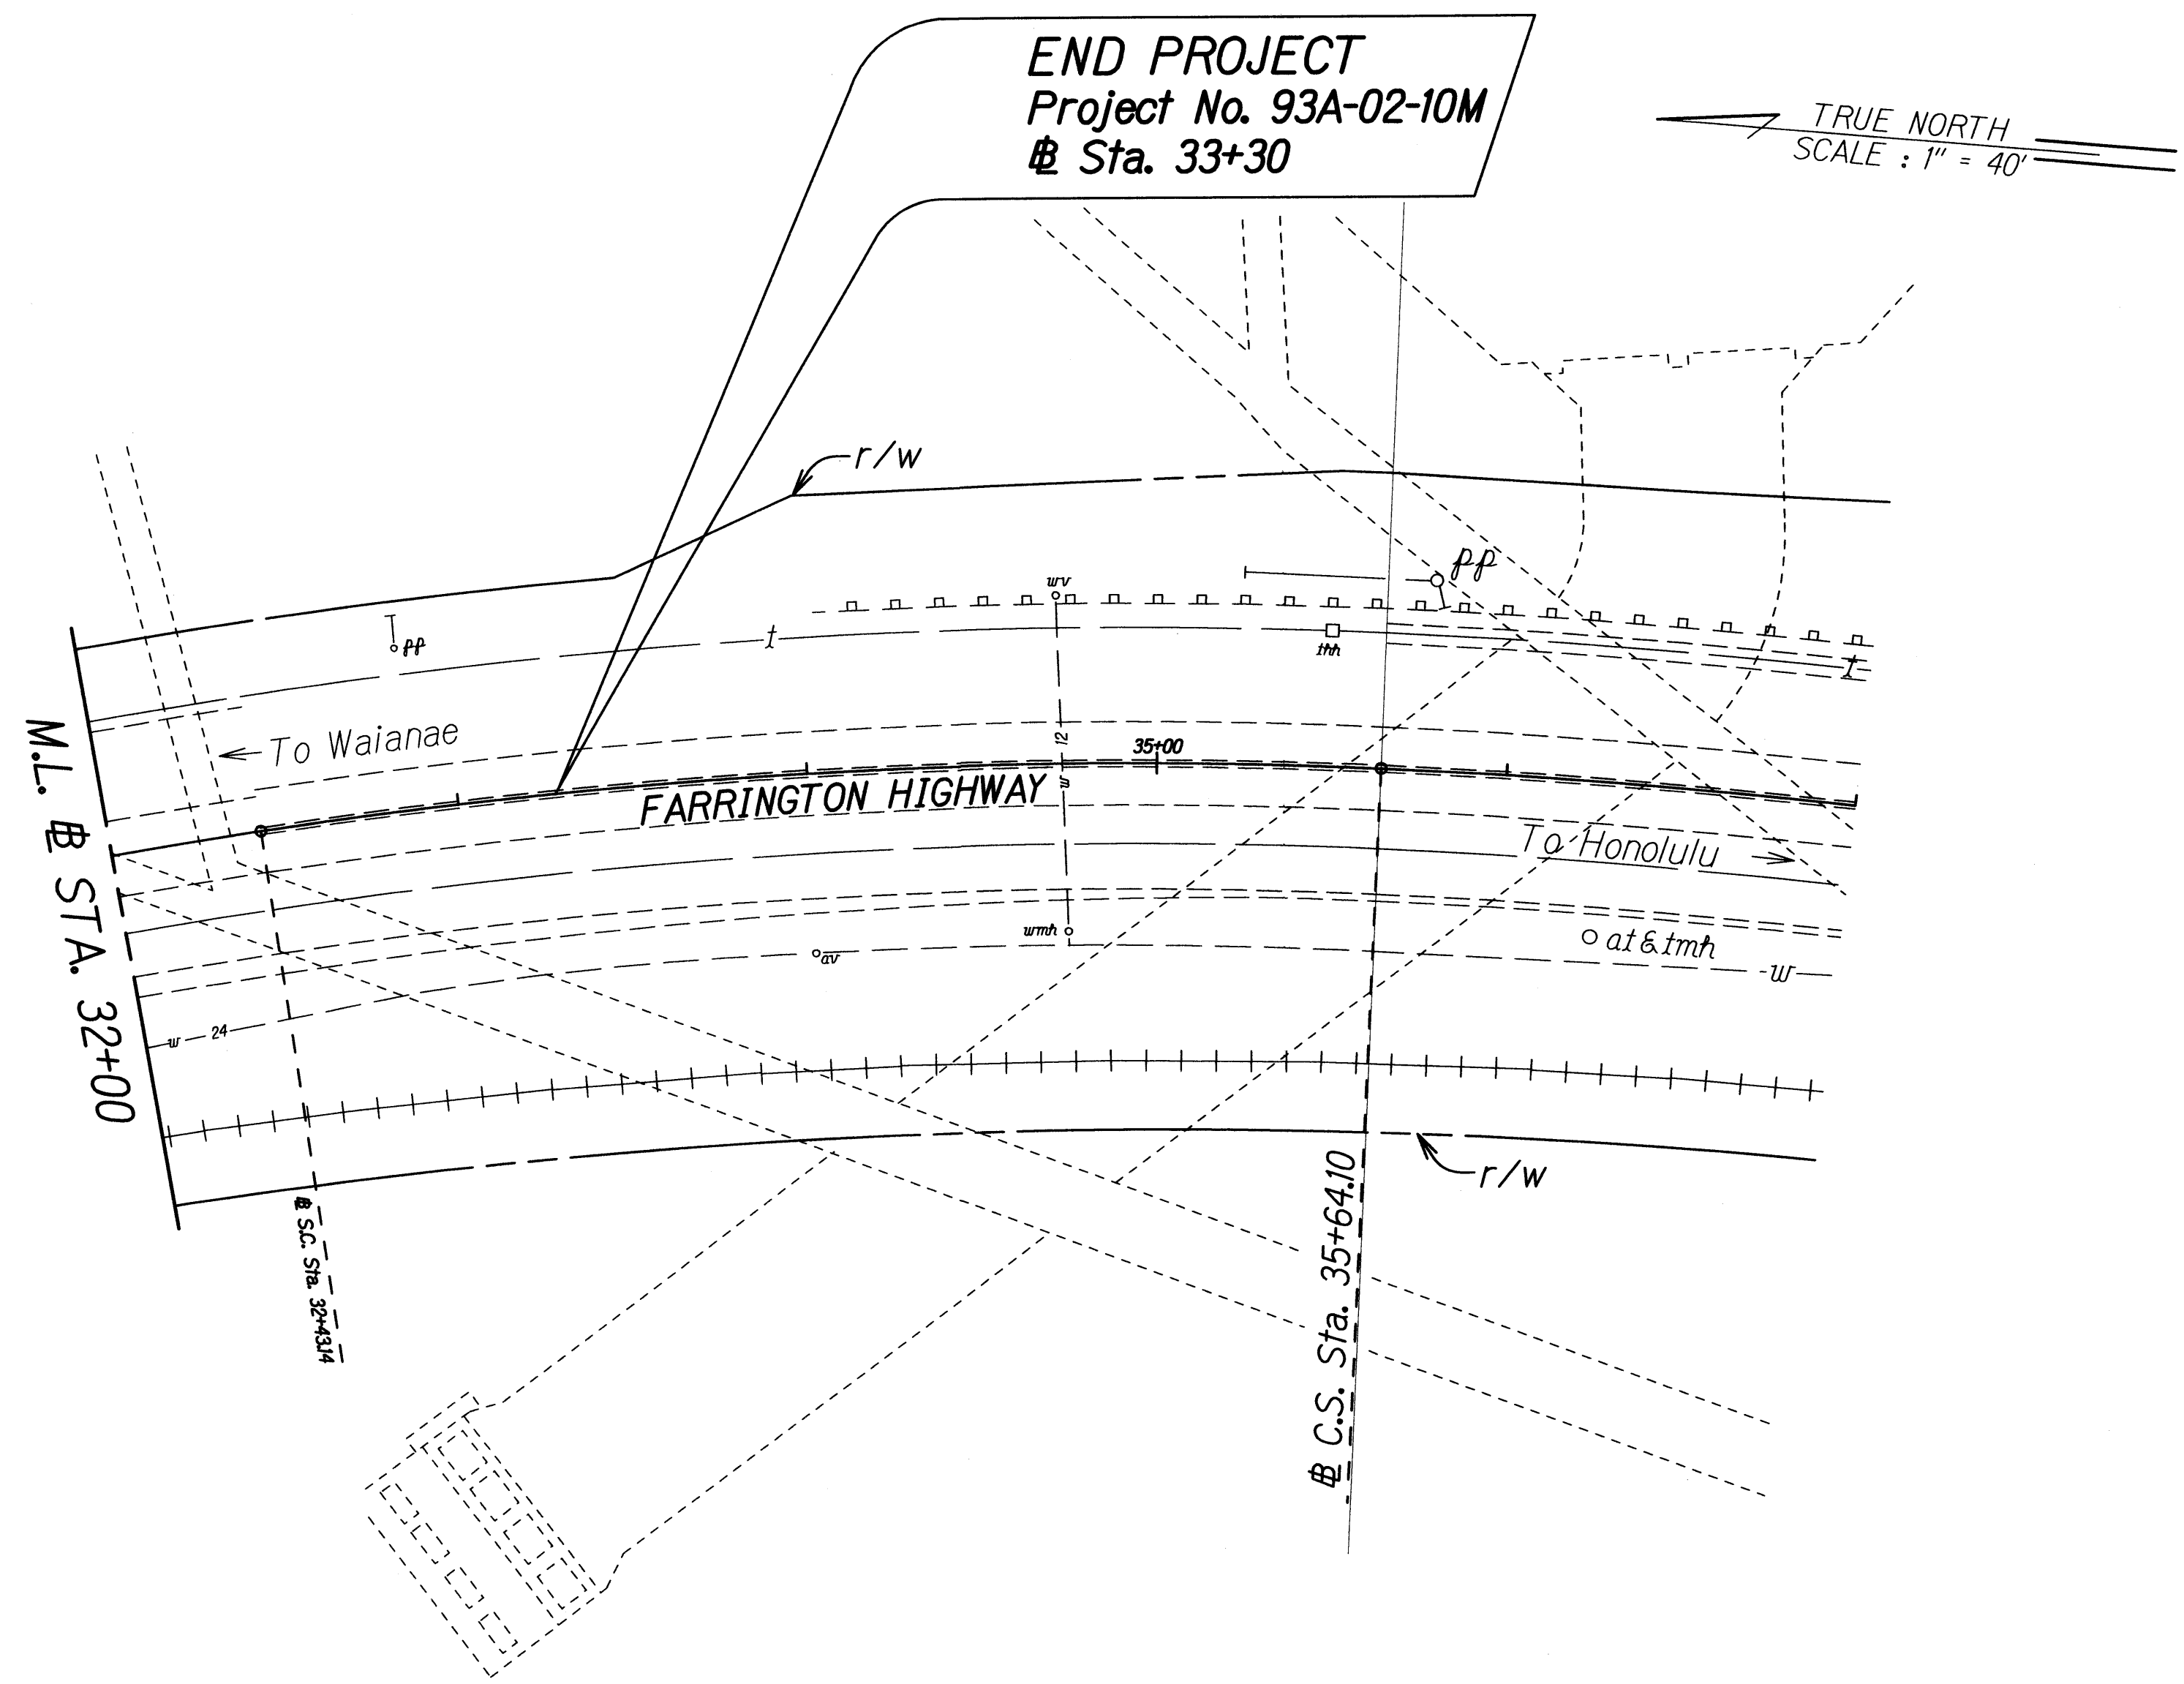

ORIGINAL PLAN	SURVEY PLOTTED BY	DATE
NOTE BOOK	DRAWN BY	
	DESIGNED BY	
	QUANTITIES BY	
	CHECKED BY	

STATE OF HAWAII
DEPARTMENT OF TRANSPORTATION
HIGHWAYS DIVISION

LANDSCAPE PLANS

FARRINGTON HIGHWAY MEDIAN IMPROVEMENTS
Milepost 3.50 to Milepost 4.36
Project No. 93A-02-10M

Scale: 1" = 40' Date: April, 2010

SHEET No. 3 OF 3 SHEETS