


FED. ROAD DIST. NO.	STATE	PROJ. NO.	FISCAL YEAR	SHEET NO.	TOTAL SHEETS
HAWAII	HAW.	93A-02-10M	2010	9	12

PLANT NOTES

- Landscape Contractor shall field verify all plant quantities and dimensions prior to installation. Quantities shown on plant list are for reference only, verify actual quantities as shown on plan. If there is a discrepancy, the planting plan shall take precedence.
- Landscape Contractor shall be responsible for locating and protecting existing utilities.
- Prior to shrub hole excavation, all planting locations shall be staked out by Contractor for approval by Engineer. Do not plant until ground has been prepared and free of stones greater than 1/2" diameter, site is neat, orderly, and the Engineer accepts site for planting.
- Notify the Engineer of any discrepancies in plant locations or insufficient plant quantities due to difference in plans and actual field conditions.
- Notify Engineer 30 days prior to planting operations for approval of all plant material at place of growth. All plant material not approved by the Engineer will subject to rejection.
- The Engineer will inspect plants at the place of growth and after the delivery to the project. Each tree shall be tagged by the Engineer with a consecutively numbered plastic tamper-resistant and self-locking seal. Seals shall remain on trees and only be removed by the Engineer at the completion of the plant establishment period. Trees delivered to the project without Engineer's seal will be rejected.
- Plants shall meet size indicated by minimum height and spread. Plants shall be straight and uniformly shaped, unless unique or special characteristics are specified, and shall be undamaged, sound, healthy, vigorous and free of disease and insect infestation. Plants not conforming to these requirements on delivery to the project and at the end of the plant establishment period will be rejected.
- The Contractor shall be solely responsible for the complete removal and damages resulting from the introduction of planting any plant species listed on the Hawaii Department of Agriculture "Noxious Weed Rules" as defined in the Statute, Hawaii Administrative Rules 4:66:1 or the "Federal Noxious Weed List" as defined in Title 7 of the Code of Federal Regulations (CFR), Parts 360 and 361.

PLANT SCHEDULE

	Quantity	Botanical Name	Common Name	Comments
⊗	256	<i>Aechmea blanchetiana</i>	Bromeliad	3 gallon, Min. 18" Height, 2 1/2' Width, Orange
▨	22,680 sq. ft.	Bermuda Grass <i>Fimbristylis cymosa</i>	Bermuda Grass <i>Mau'u Aki Aki</i>	Hydroseed, seed to be supplied by Dr. Joe DeFrank (ph. 956-5698)
○	1,104	<i>Myoporum Sandwicense</i> <i>Dodonaea viscosa</i>	Naio <i>A'ali'i</i>	3 gallon, Min. 18" Height, 2' Width

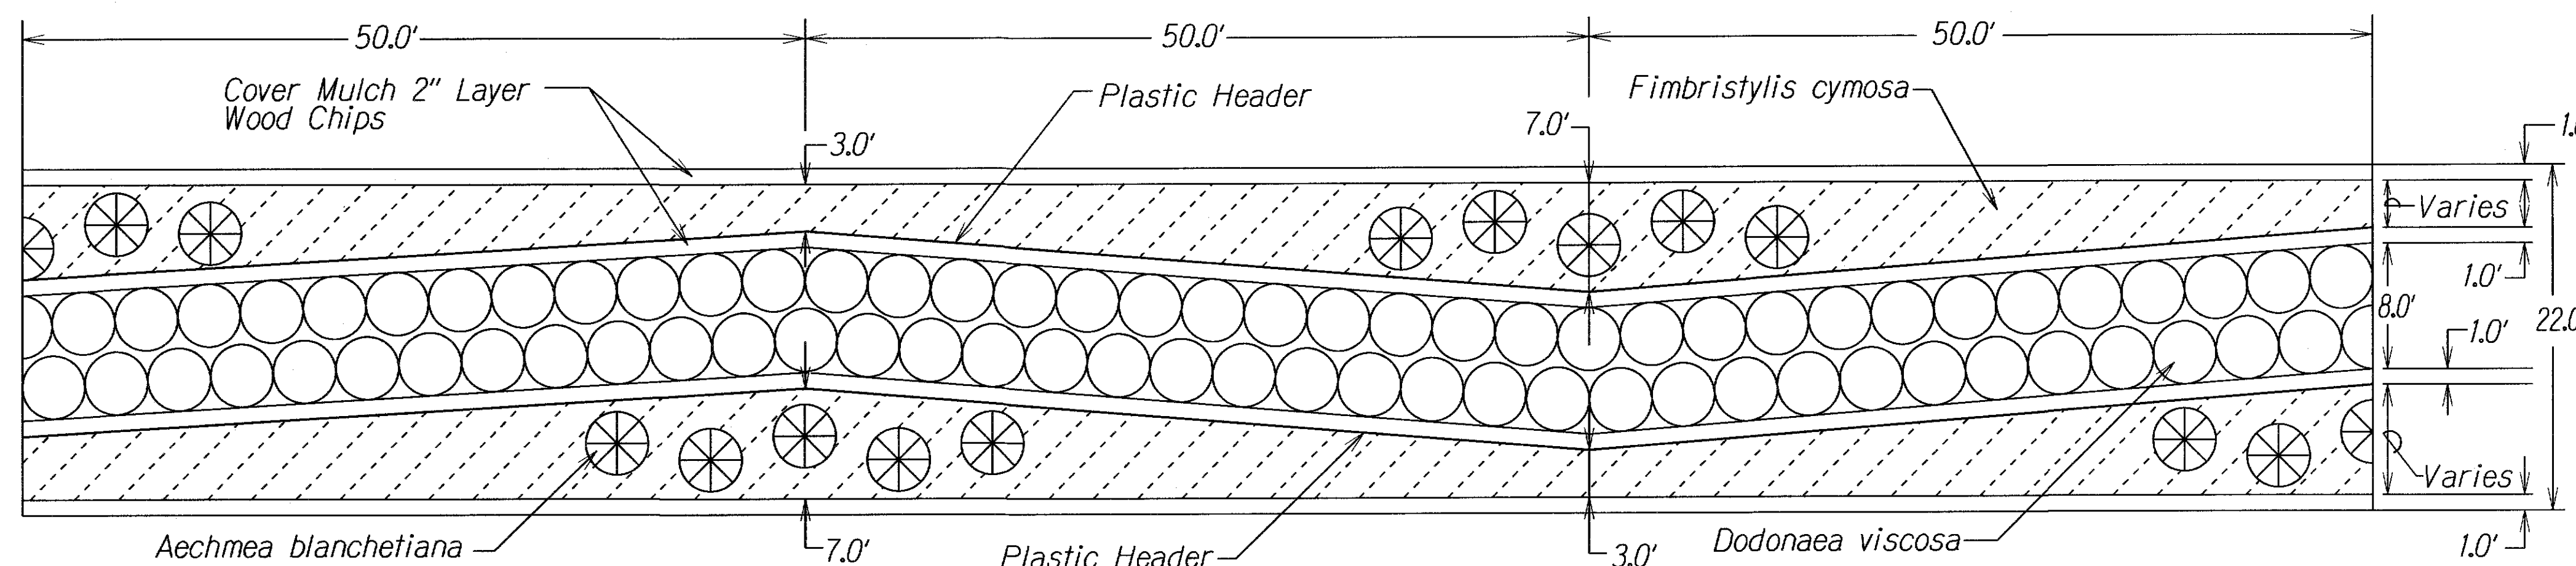

Typical Median Planting Detail
Not to Scale

Note: Typical 50 Foot Segment Consists of 26 Dodonaea viscosa, 6 Aechmea blanchetiana and 500 sq. ft. Fimbristylis cymosa

LEGEND FOR AS-BUILT POSTINGS

~~~~~	Squiggly line for as-built deletion
==	Double line for as-built deletion
Roadway	Text for as-built posting

STATE OF HAWAII  
DEPARTMENT OF TRANSPORTATION  
HIGHWAYS DIVISION

**PLANTING NOTES & TYPICAL DETAILS**

FARRINGTON HIGHWAY MEDIAN IMPROVEMENTS

Milepost 3.50 to Milepost 4.36

Project No. 93A-02-10M

Scale: N.T.S. Date: May, 2010

SHEET No. 1 OF 1 SHEETS

ORIGINAL SURVEY PLOTTED BY DATE  
DESIGNED BY  
NOTED BY  
CHECKED BY