

INDEX TO DRAWINGS	
SHEET NO.	DESCRIPTION
1	TITLE SHEET
2	STANDARD PLANS SUMMARY
3	GENERAL NOTES & LEGEND
4 - 5	WATER POLLUTION AND EROSION CONTROL NOTES
6 - 19	TRAFFIC PLANS

STATE OF HAWAII

DEPARTMENT OF TRANSPORTATION

HIGHWAYS DIVISION

HONOLULU, HAWAII

"AS-BUILT"

PLANS FOR

FARRINGTON HIGHWAY

SAFETY IMPROVEMENTS




LEIHOKU STREET TO KILI DRIVE

FEDERAL AID PROJECT NO. HSIP-093-1(23)

DISTRICT OF WAIANAE

ISLAND OF OAHU

FED. ROAD DIST. NO.	STATE	FED. AID PROJ. NO.	FISCAL YEAR	SHEET NO.	TOTAL SHEETS
HAWAII	HAW.	HSIP-093-1(23)	2011	1	19

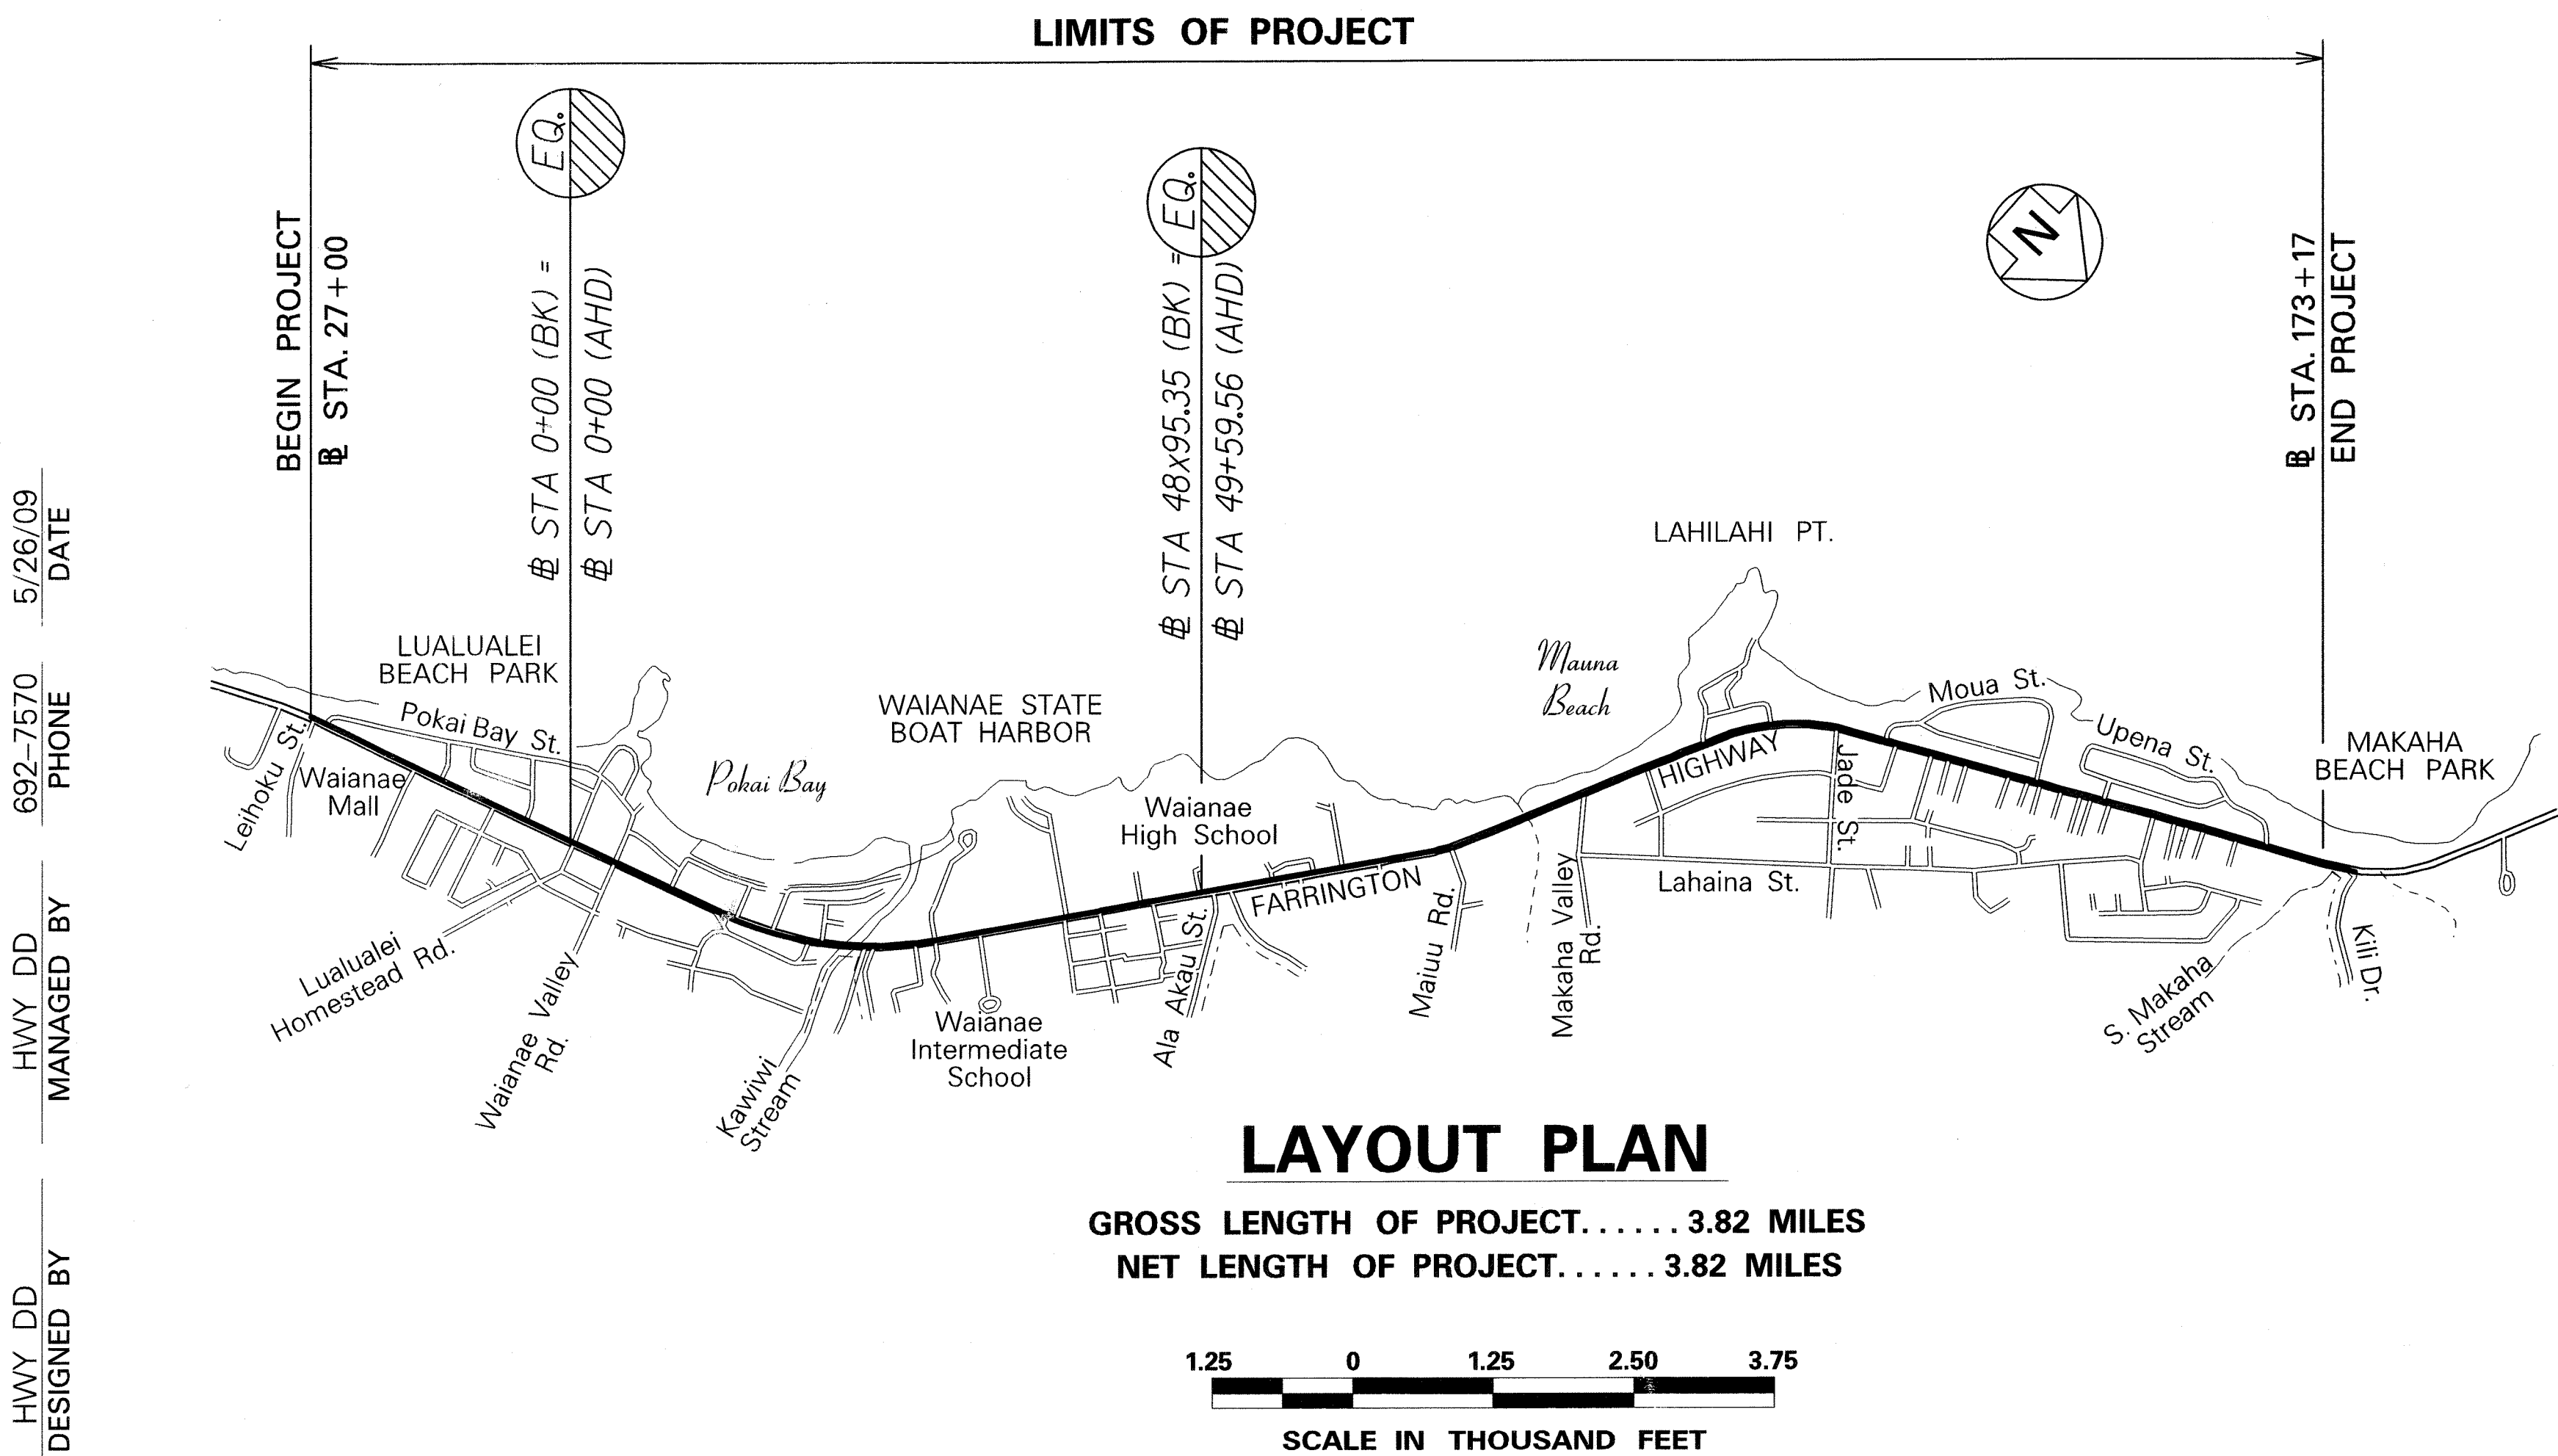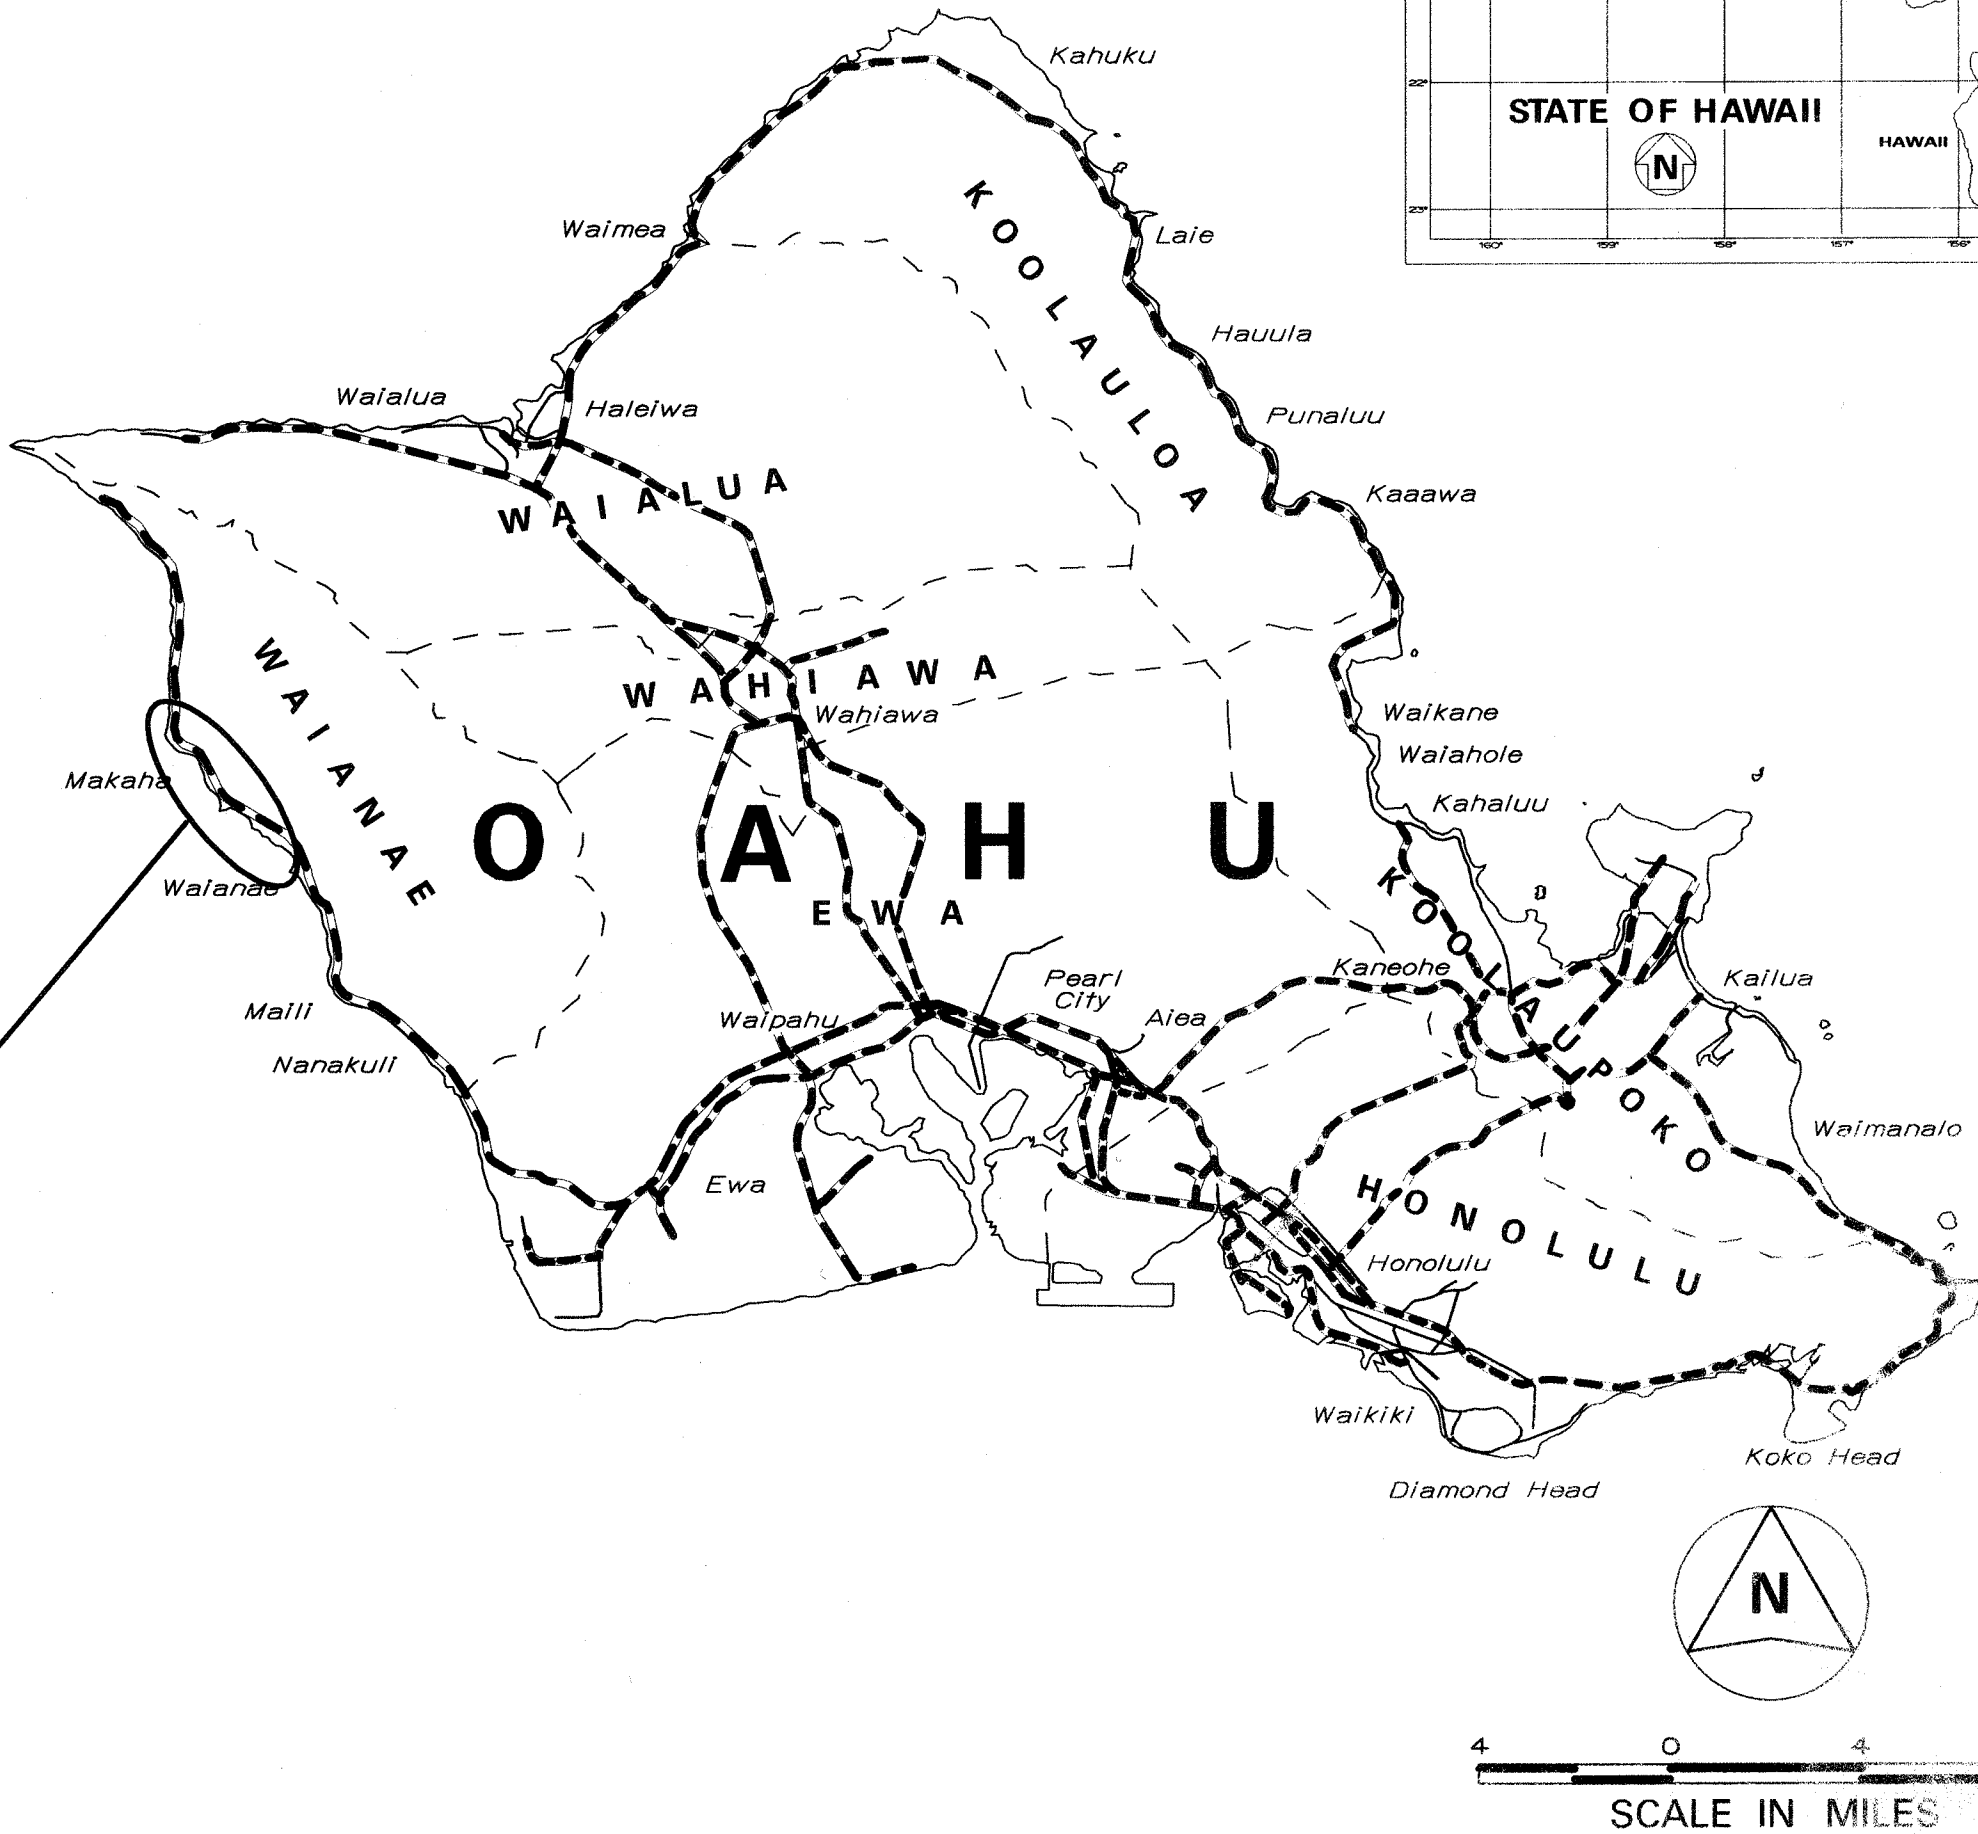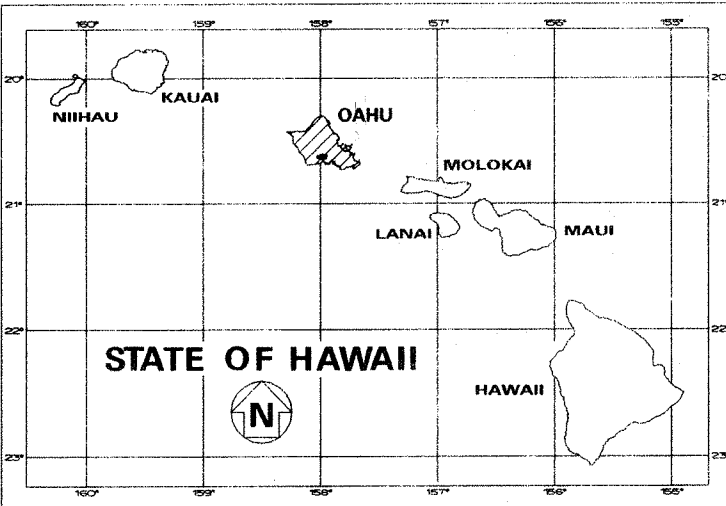

----- FEDERAL AID PROJECTS PREVIOUSLY CONSTRUCTED OR UNDER CONSTRUCTION

MILE POST 10.25 TO MILE POST 14.04

	HAKIMO RD TO WAIANAE VALLEY RD	WAIANAE RD TO NW RD TO WAIANAE HS	NW RD TO WAIANAE HS TO JADE ST	JADE ST TO WATER ST	WATER ST TO LAWAIA ST
ADT (2010)	33,200	27,700	20,700	7,800	5,300
ADT (2030)	39,600	35,100	29,400	10,000	6,700
DHV	2,970	2,810	2,210	750	540
K	7.5	8.0	7.5	7.5	8.0
T	4.0	4.0	4.5	4.0	4.0
T24	4.0	3.0	5.0	4.0	5.5

CHANGES MADE DURING CONSTRUCTION HAVE BEEN INCORPORATED ON THESE PLANS EXCEPT CHANGES IN THE ORIGINAL THEORETICAL QUANTITIES. FOR ACTUAL QUANTITIES, REFER TO PROJECT LEDGER AND/OR COMPUTATION BOOK.

[Signature]
RESIDENT ENGINEER

3/15/12
DATE

DEPARTMENT OF TRANSPORTATION
STATE OF HAWAII

APPROVED:

[Signature]
DIR. OF TRANSPORTATION

11/02/11
DATE