

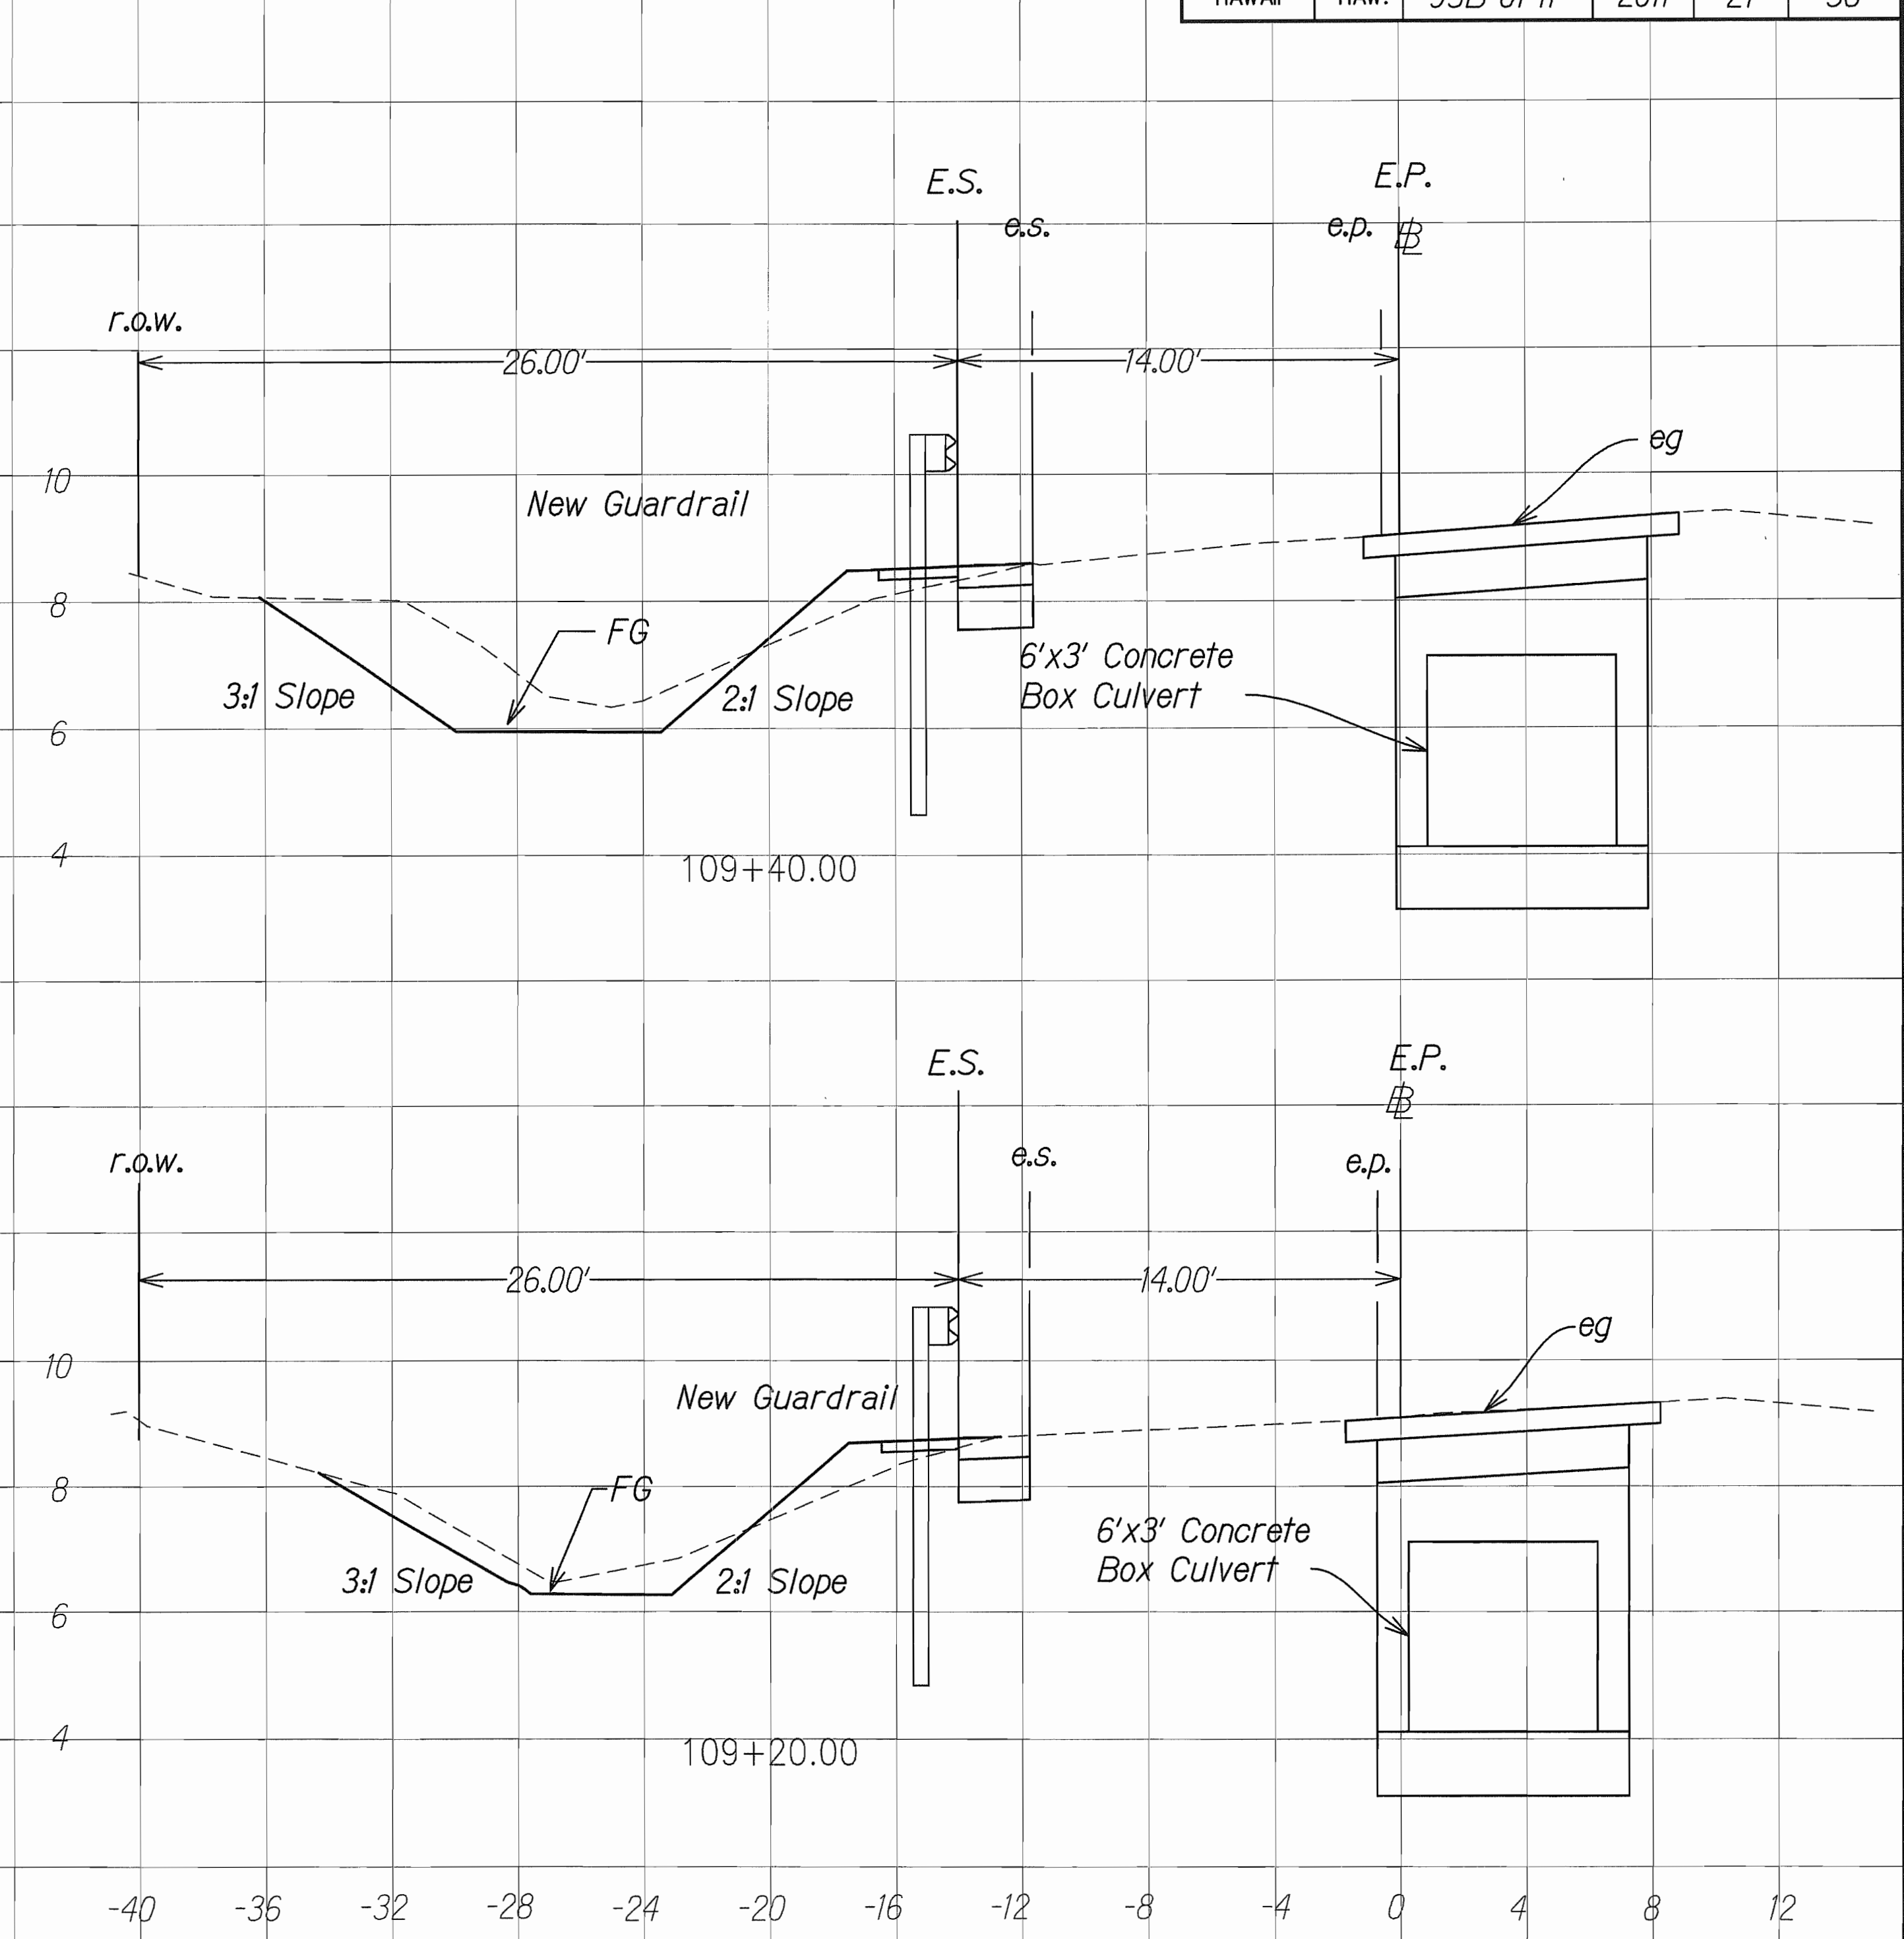


FED. ROAD DIST. NO.	STATE	FED. AID PROJ. NO.	FISCAL YEAR	SHEET NO.	TOTAL SHEETS
HAWAII	HAW.	93B-01-11	2011	27	38

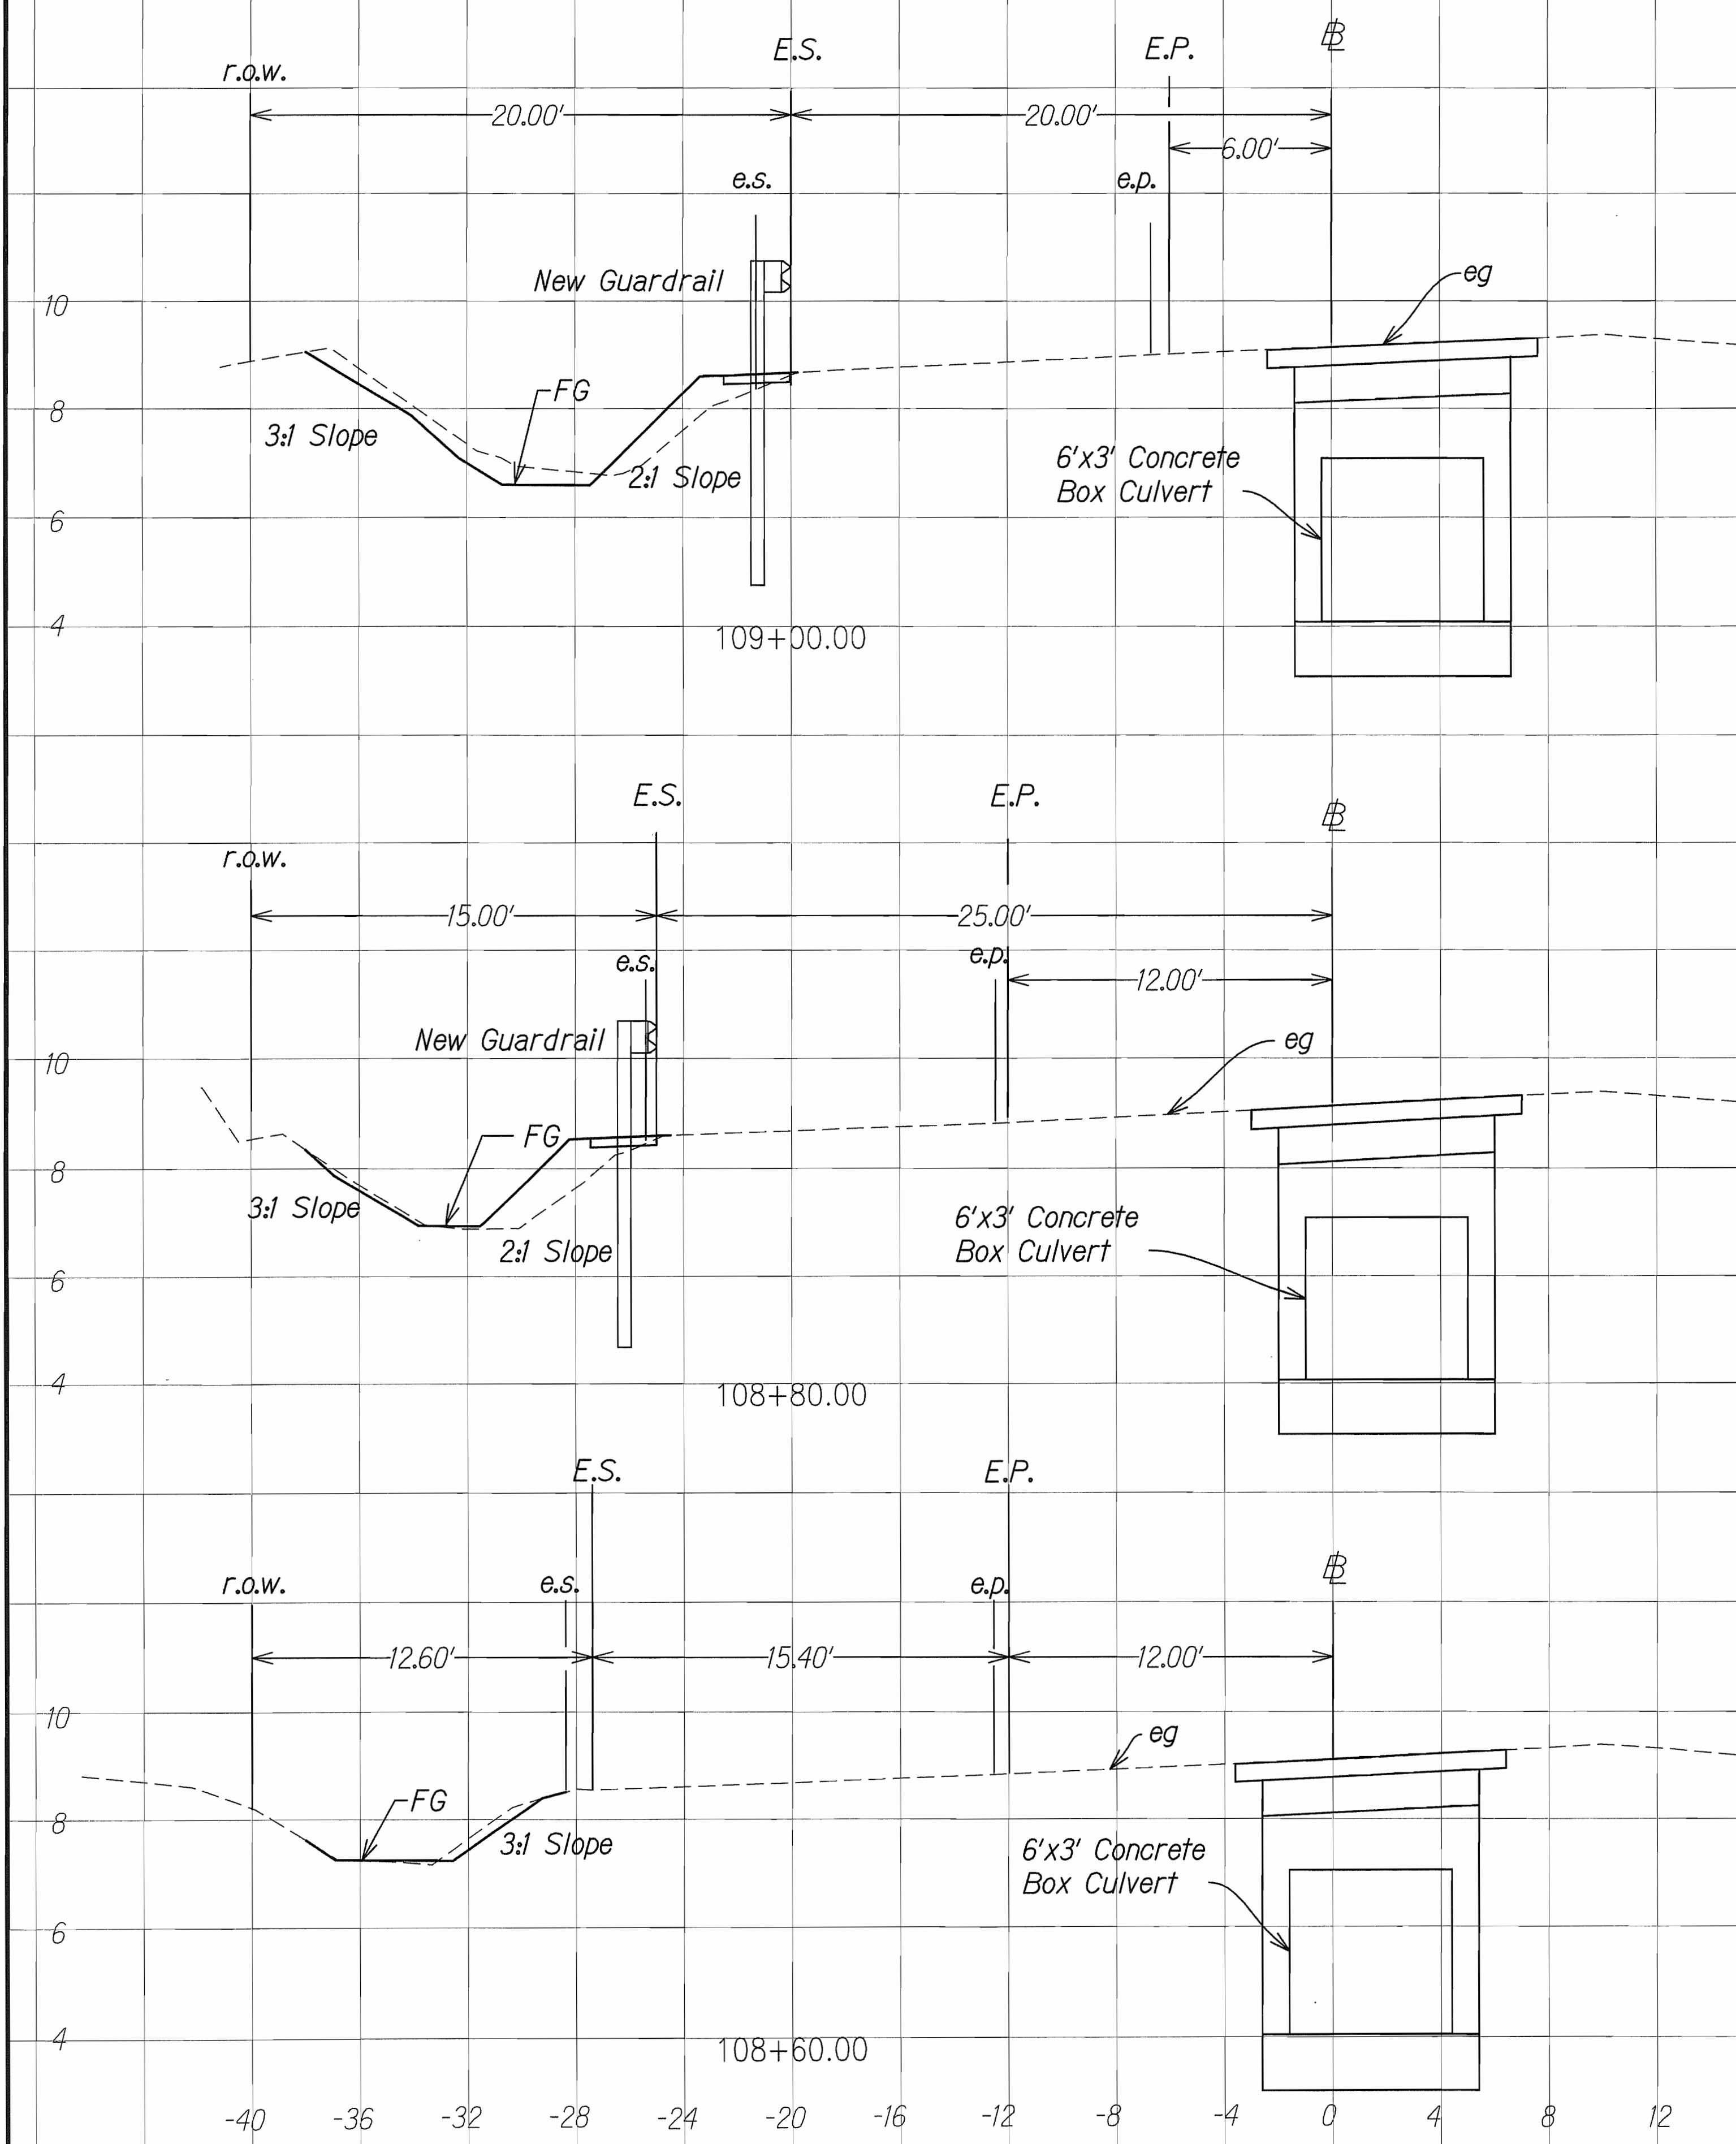

GRAPHICAL SCALE:

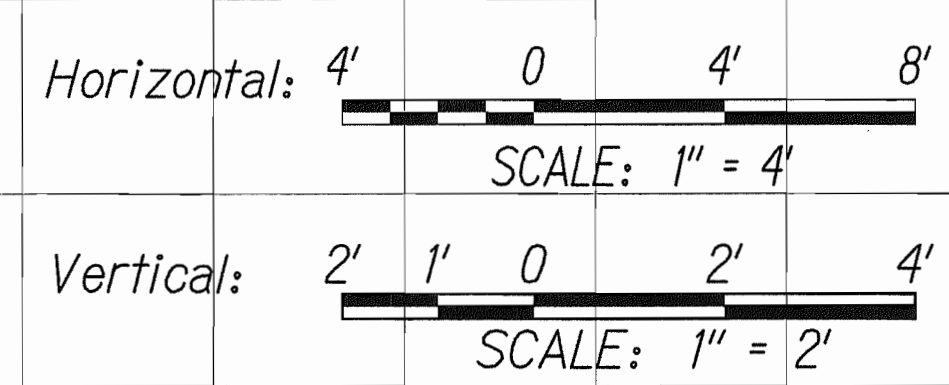

CORREY M. MATSUOKA

LICENSED PROFESSIONAL ENGINEER

NO. 10330-C

HAWAII USA

THIS WORK WAS PREPARED BY ME

OR UNDER MY SUPERVISION

Correy Matsuka

SIGNATURE

4/30/12

EXPIRATION DATE OF THE LICENSE

STATE OF HAWAII

DEPARTMENT OF TRANSPORTATION

HIGHWAYS DIVISION

CROSS SECTIONS

FARRINGTON HIGHWAY DRAINAGE IMPROVEMENTS

Vicinity of Orange St.



Project No. 93B-01-11

Scale: AS NOTED


Date: FEB 2012

SHEET No. 1 OF 5 SHEETS

FED. ROAD DIST. NO.	STATE	FED. AID PROJ. NO.	FISCAL YEAR	SHEET NO.	TOTAL SHEETS
HAWAII	HAW.	93B-01-11	2011	28	38

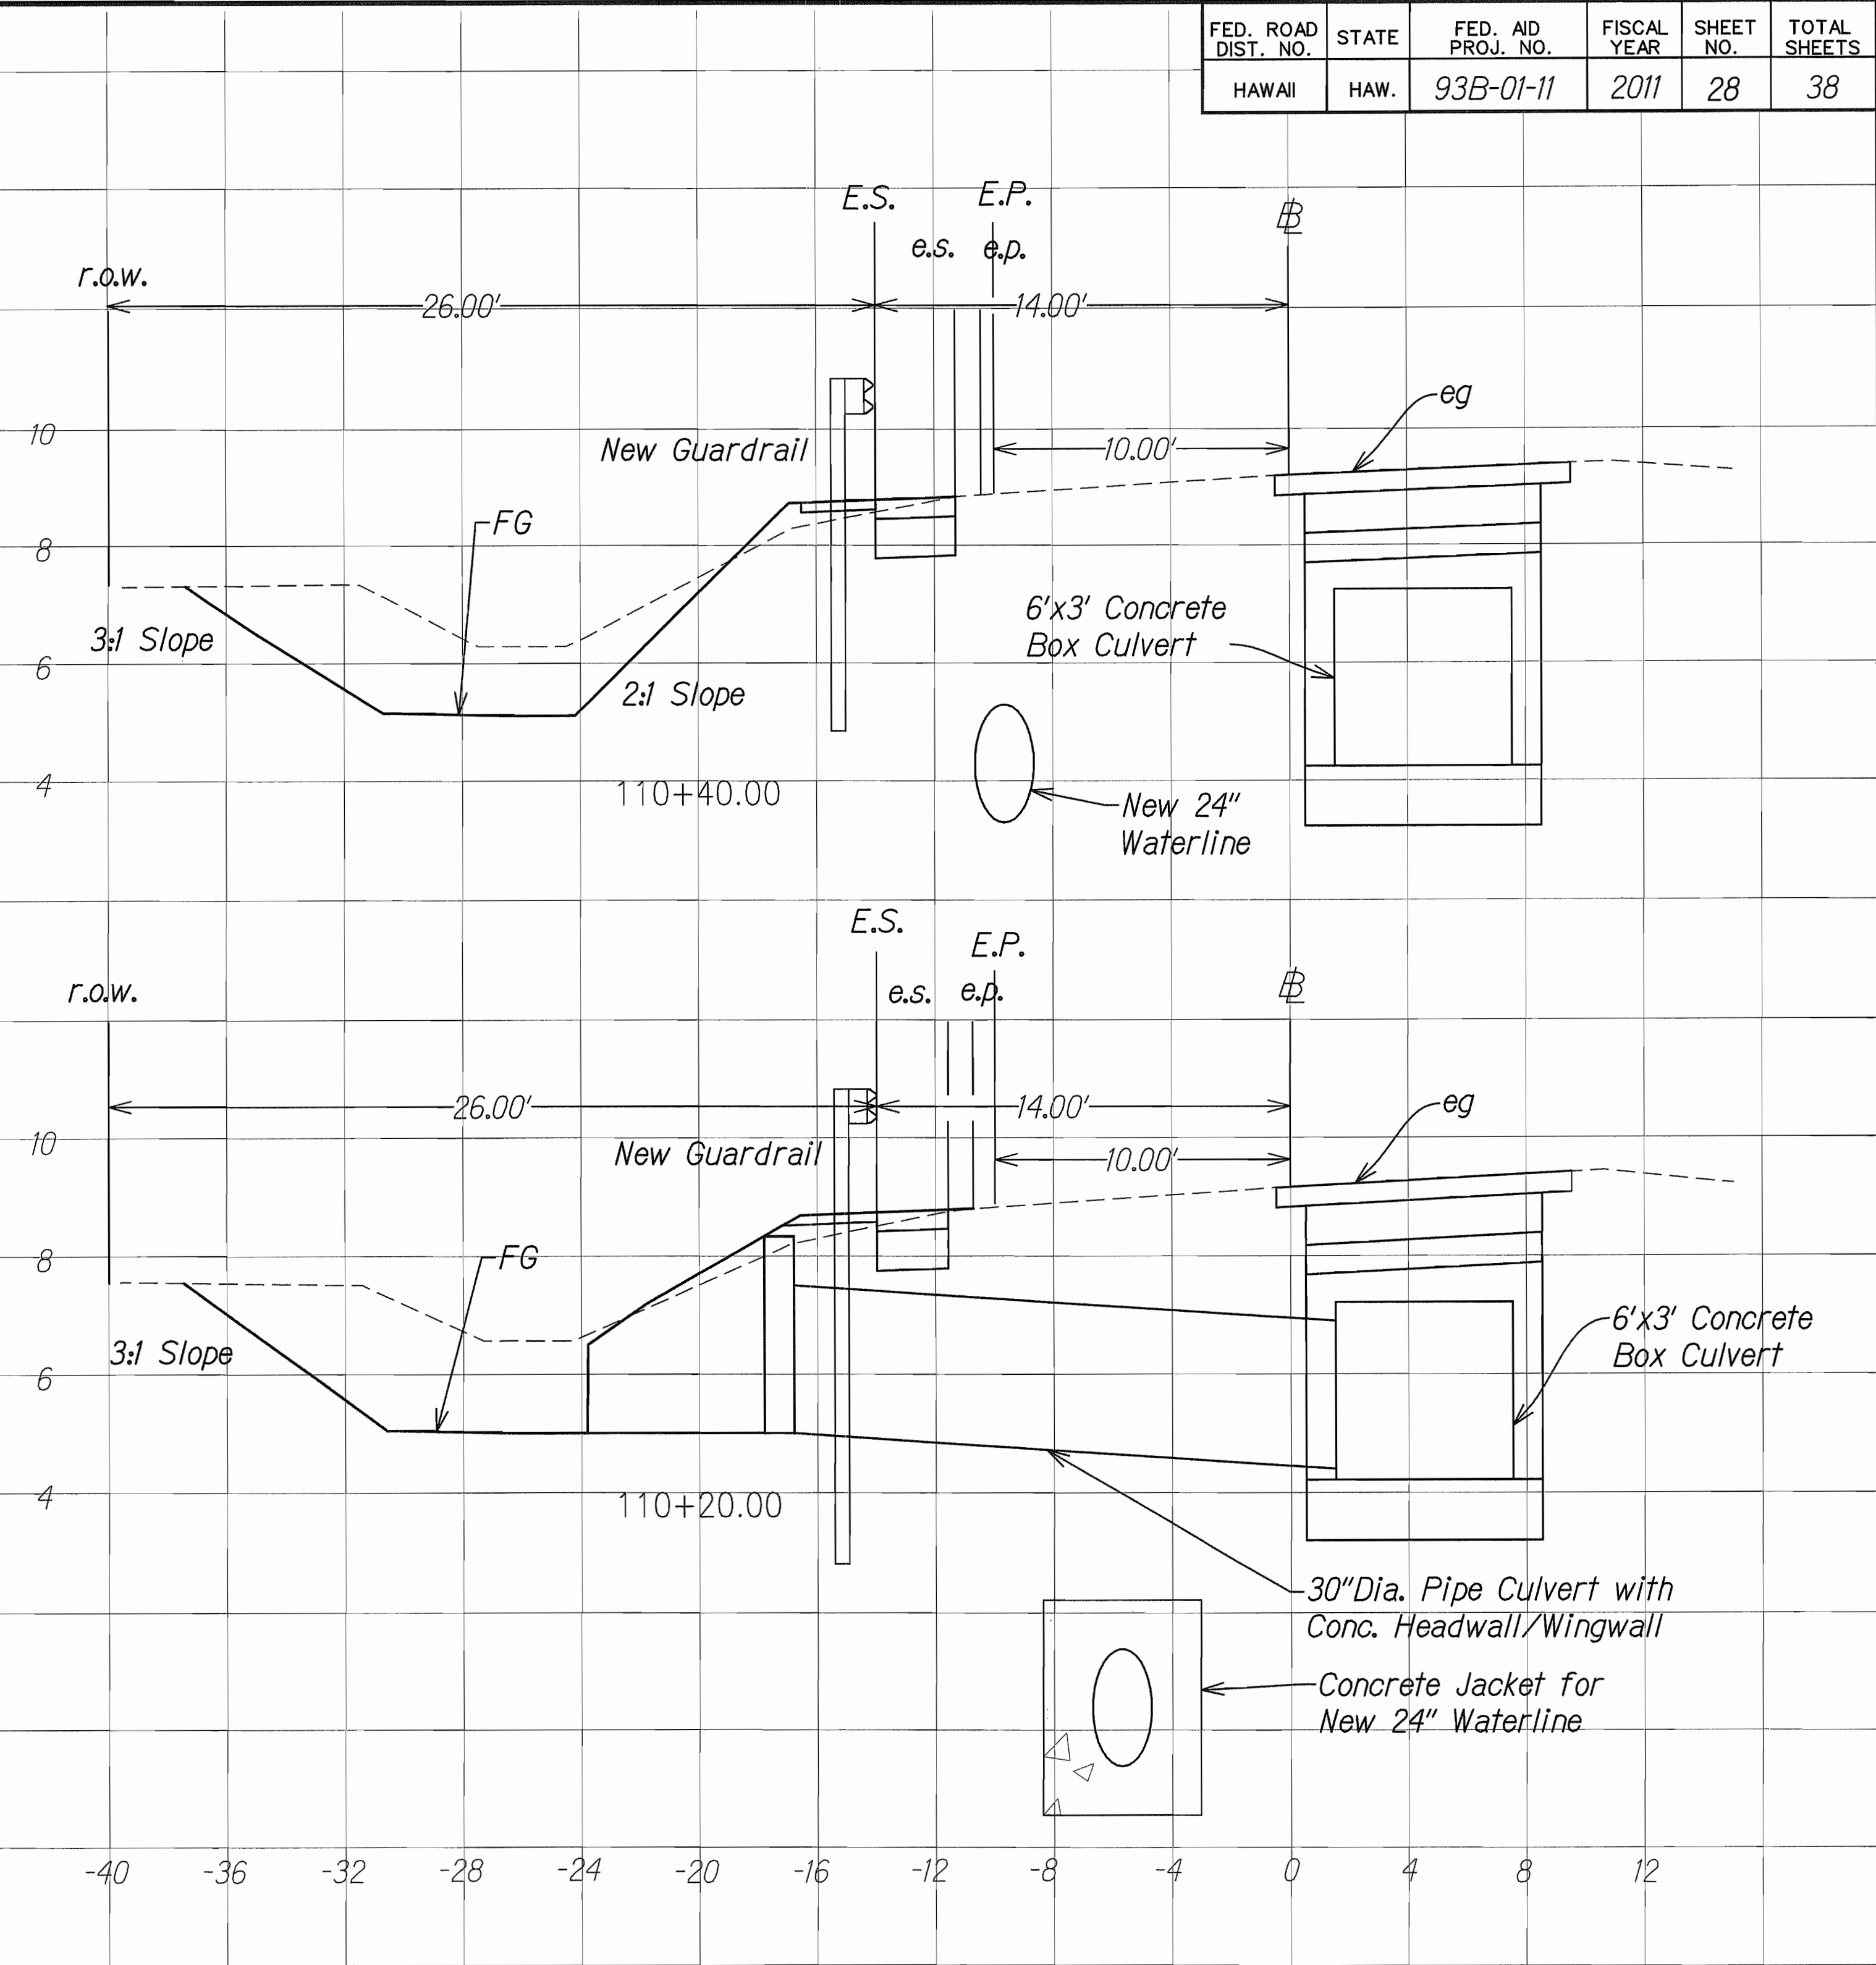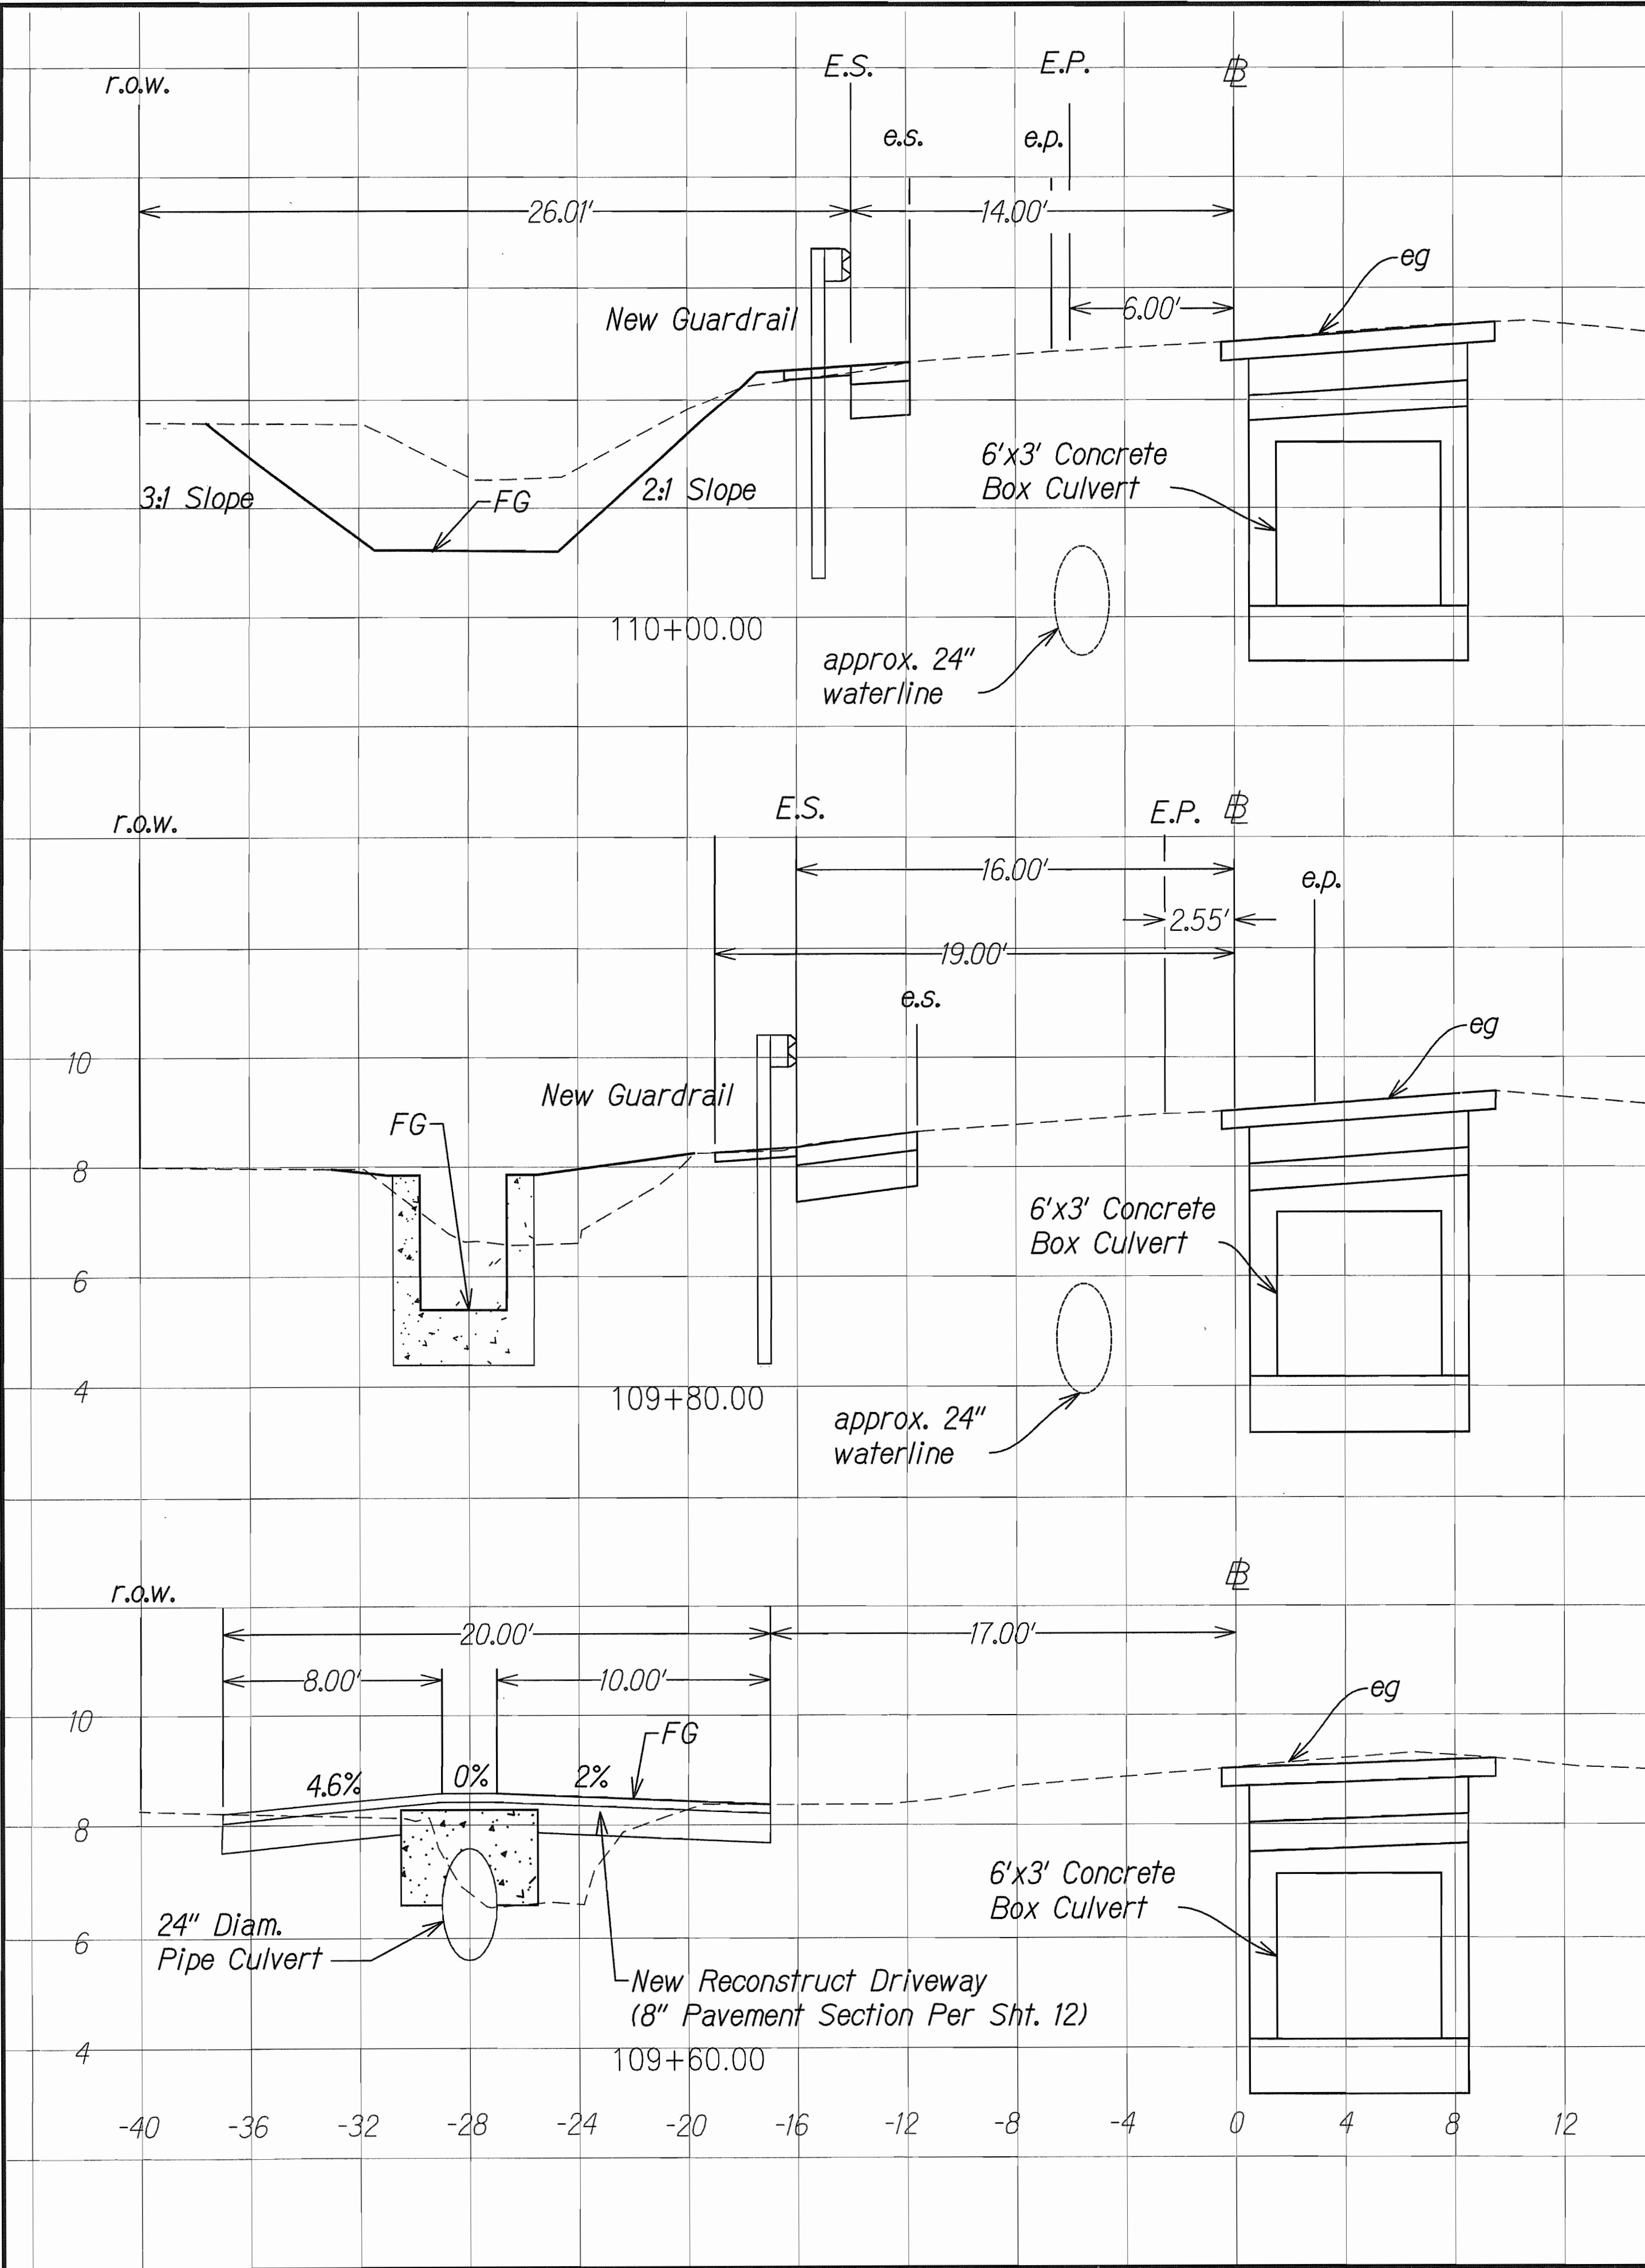

GRAPHICAL SCALE:

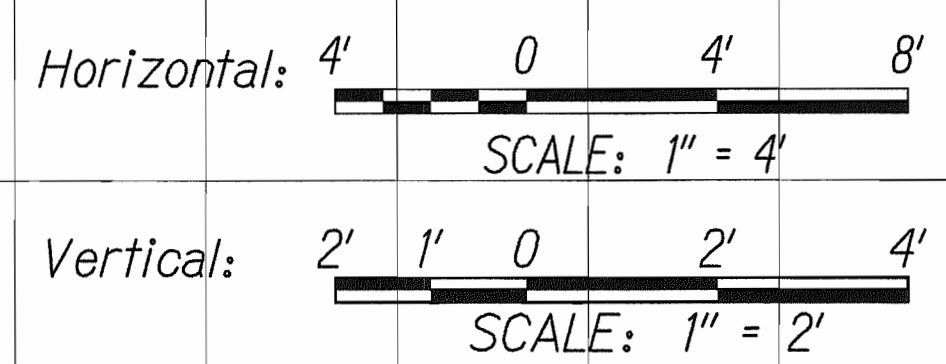

COREY M. MATSUOKA
LICENSED PROFESSIONAL ENGINEER
NO. 10330-C
HAWAII USA

THIS WORK WAS PREPARED BY ME OR UNDER MY SUPERVISION








SIGNATURE: COREY M. MATSUOKA
EXPIRATION DATE OF THE LICENSE: 4/30/12

STATE OF HAWAII
DEPARTMENT OF TRANSPORTATION
HIGHWAYS DIVISION

CROSS SECTIONS

FARRINGTON HIGHWAY DRAINAGE IMPROVEMENTS
Vicinity of Orange St.
Project No. 93B-01-11
Scale: AS NOTED Date: FEB 2012
SHEET No. 2 OF 5 SHEETS

FED. ROAD DIST. NO.	STATE	FED. AID PROJ. NO.	FISCAL YEAR	SHEET NO.	TOTAL SHEETS
HAWAII	HAW.	93B-01-11	2011	29	38

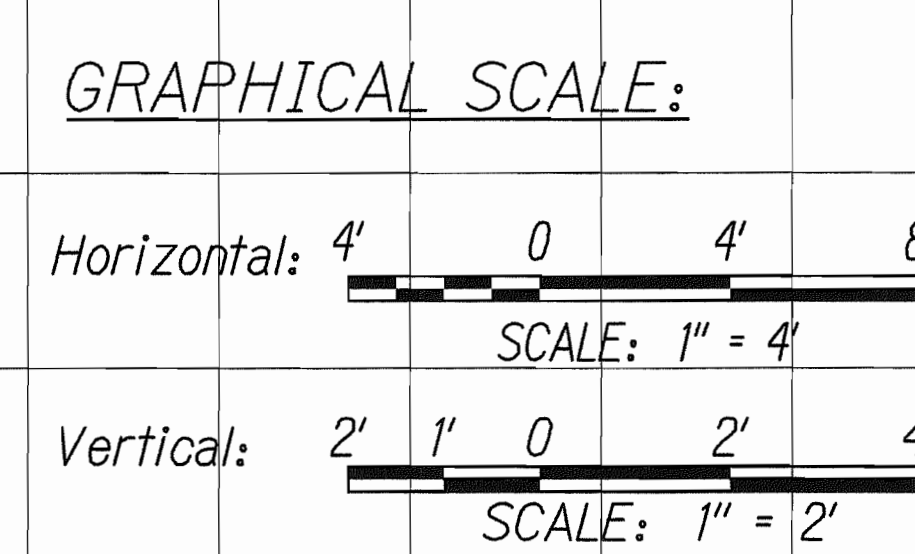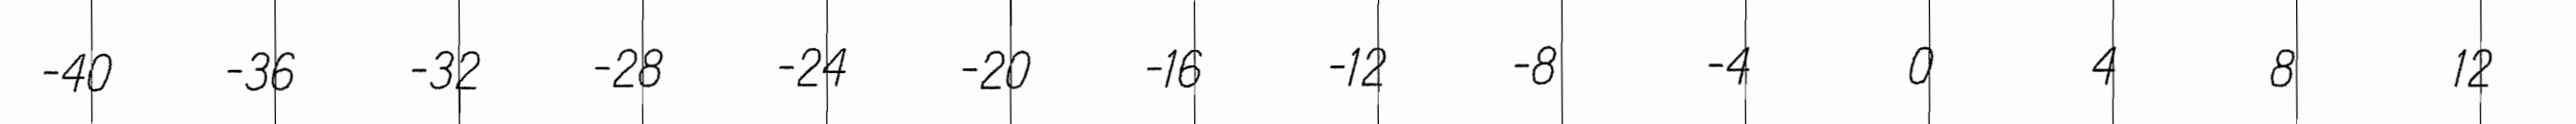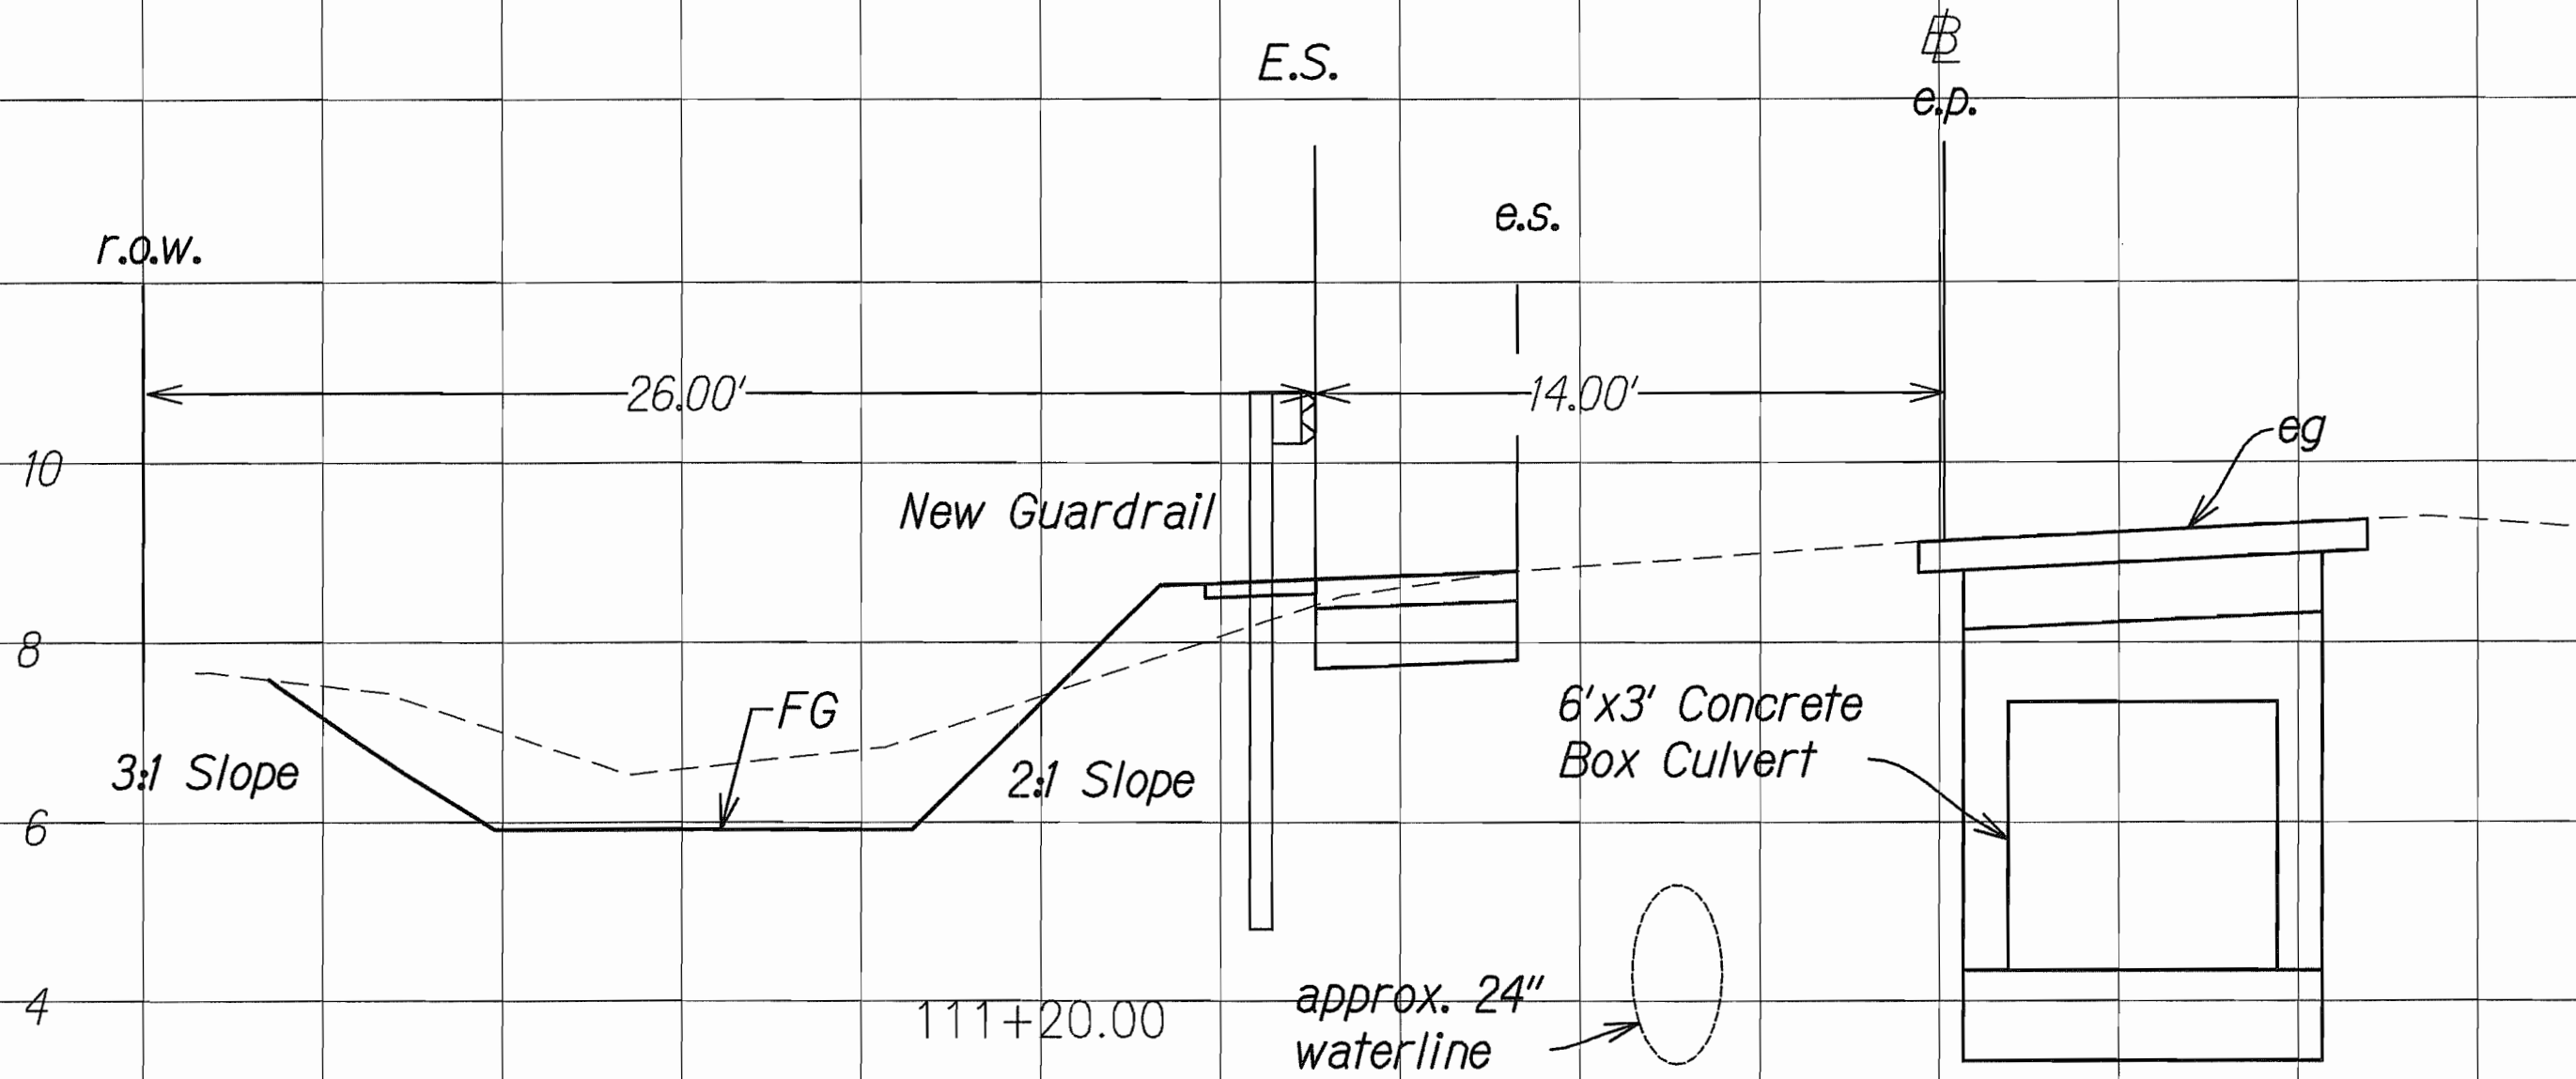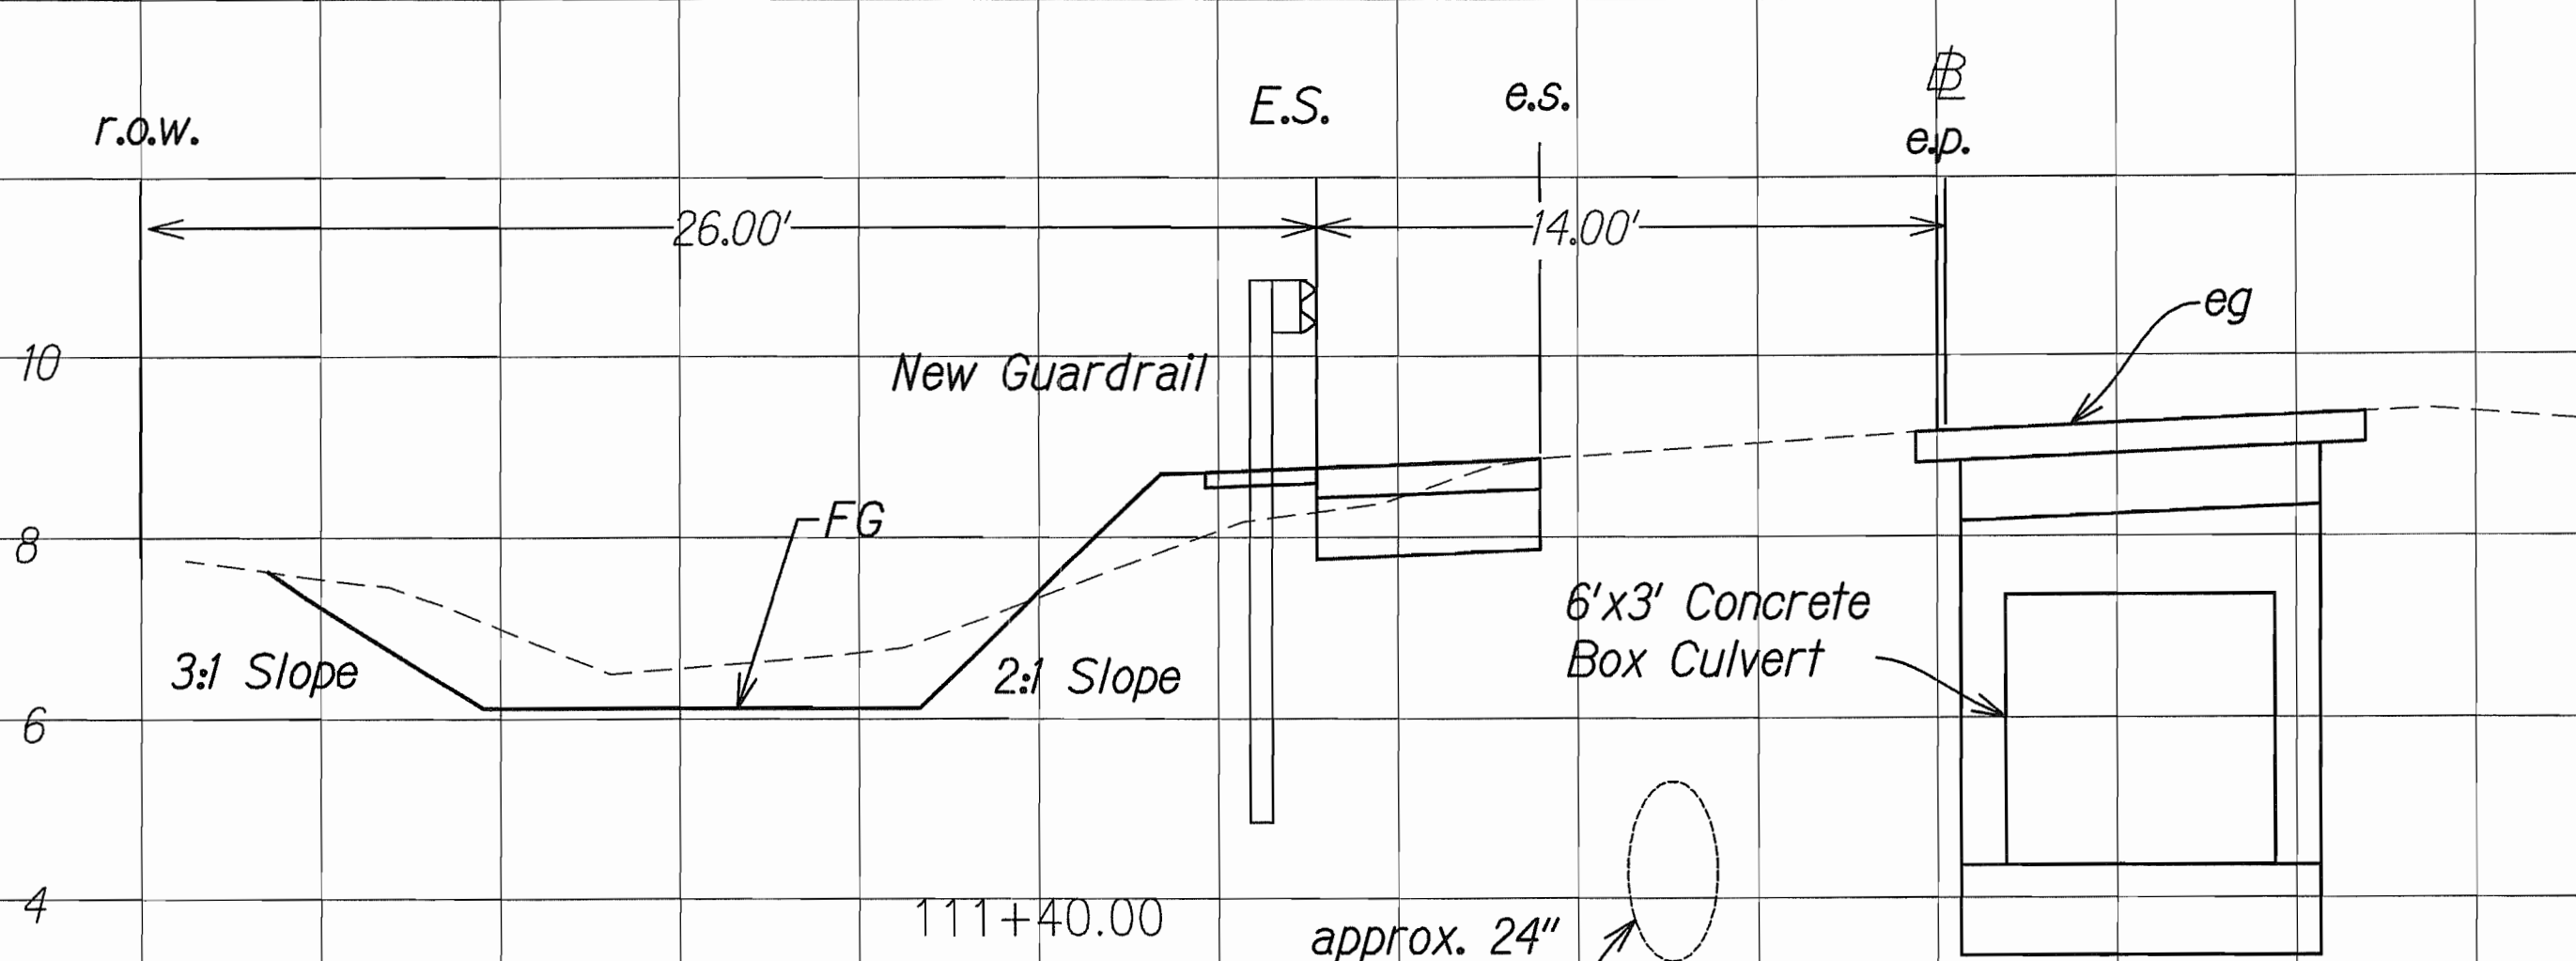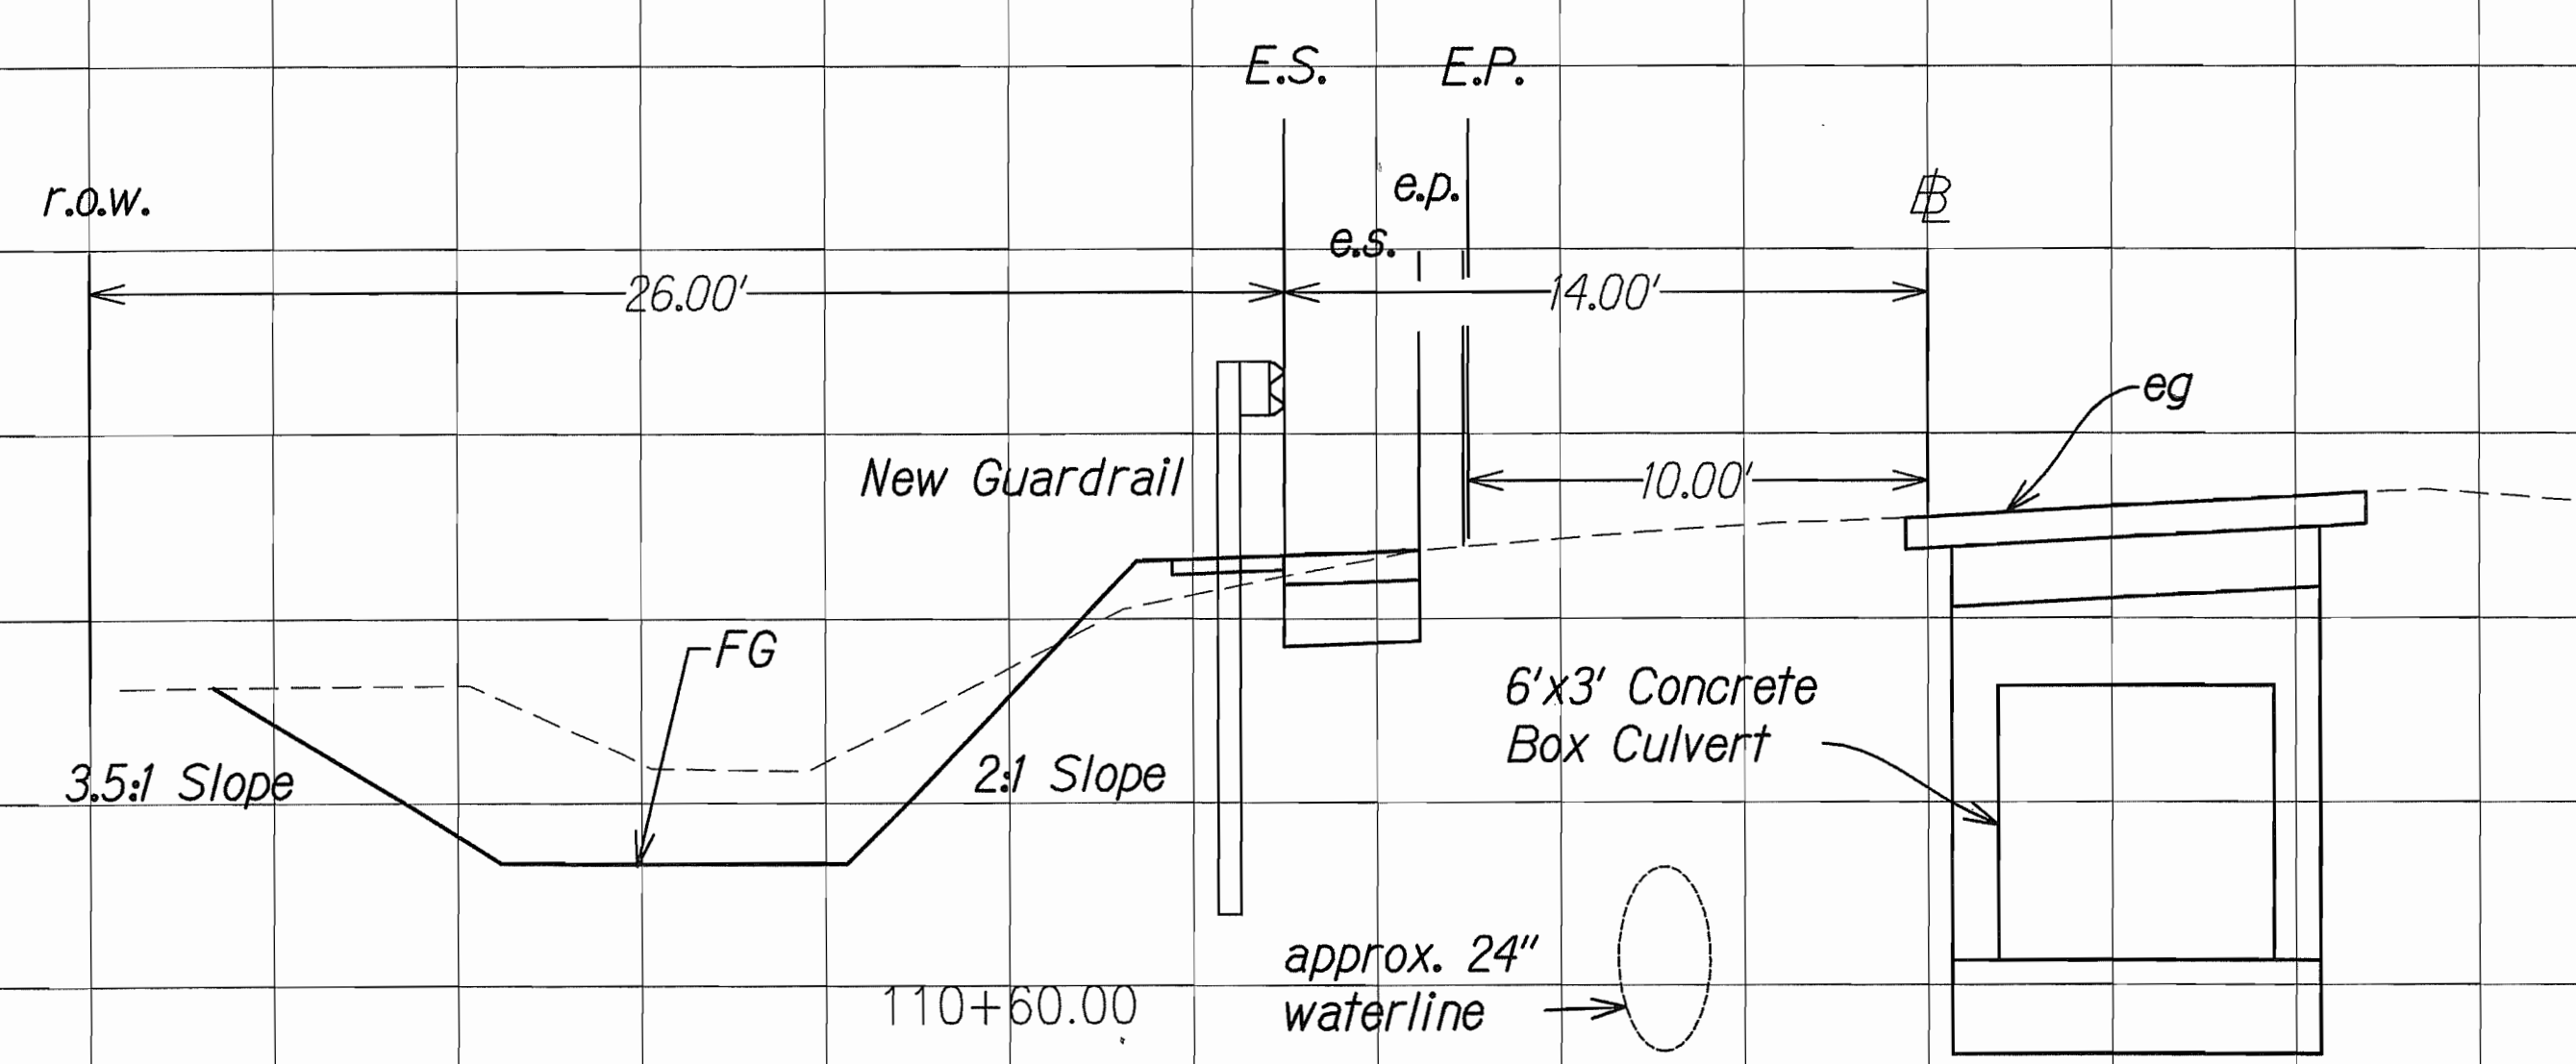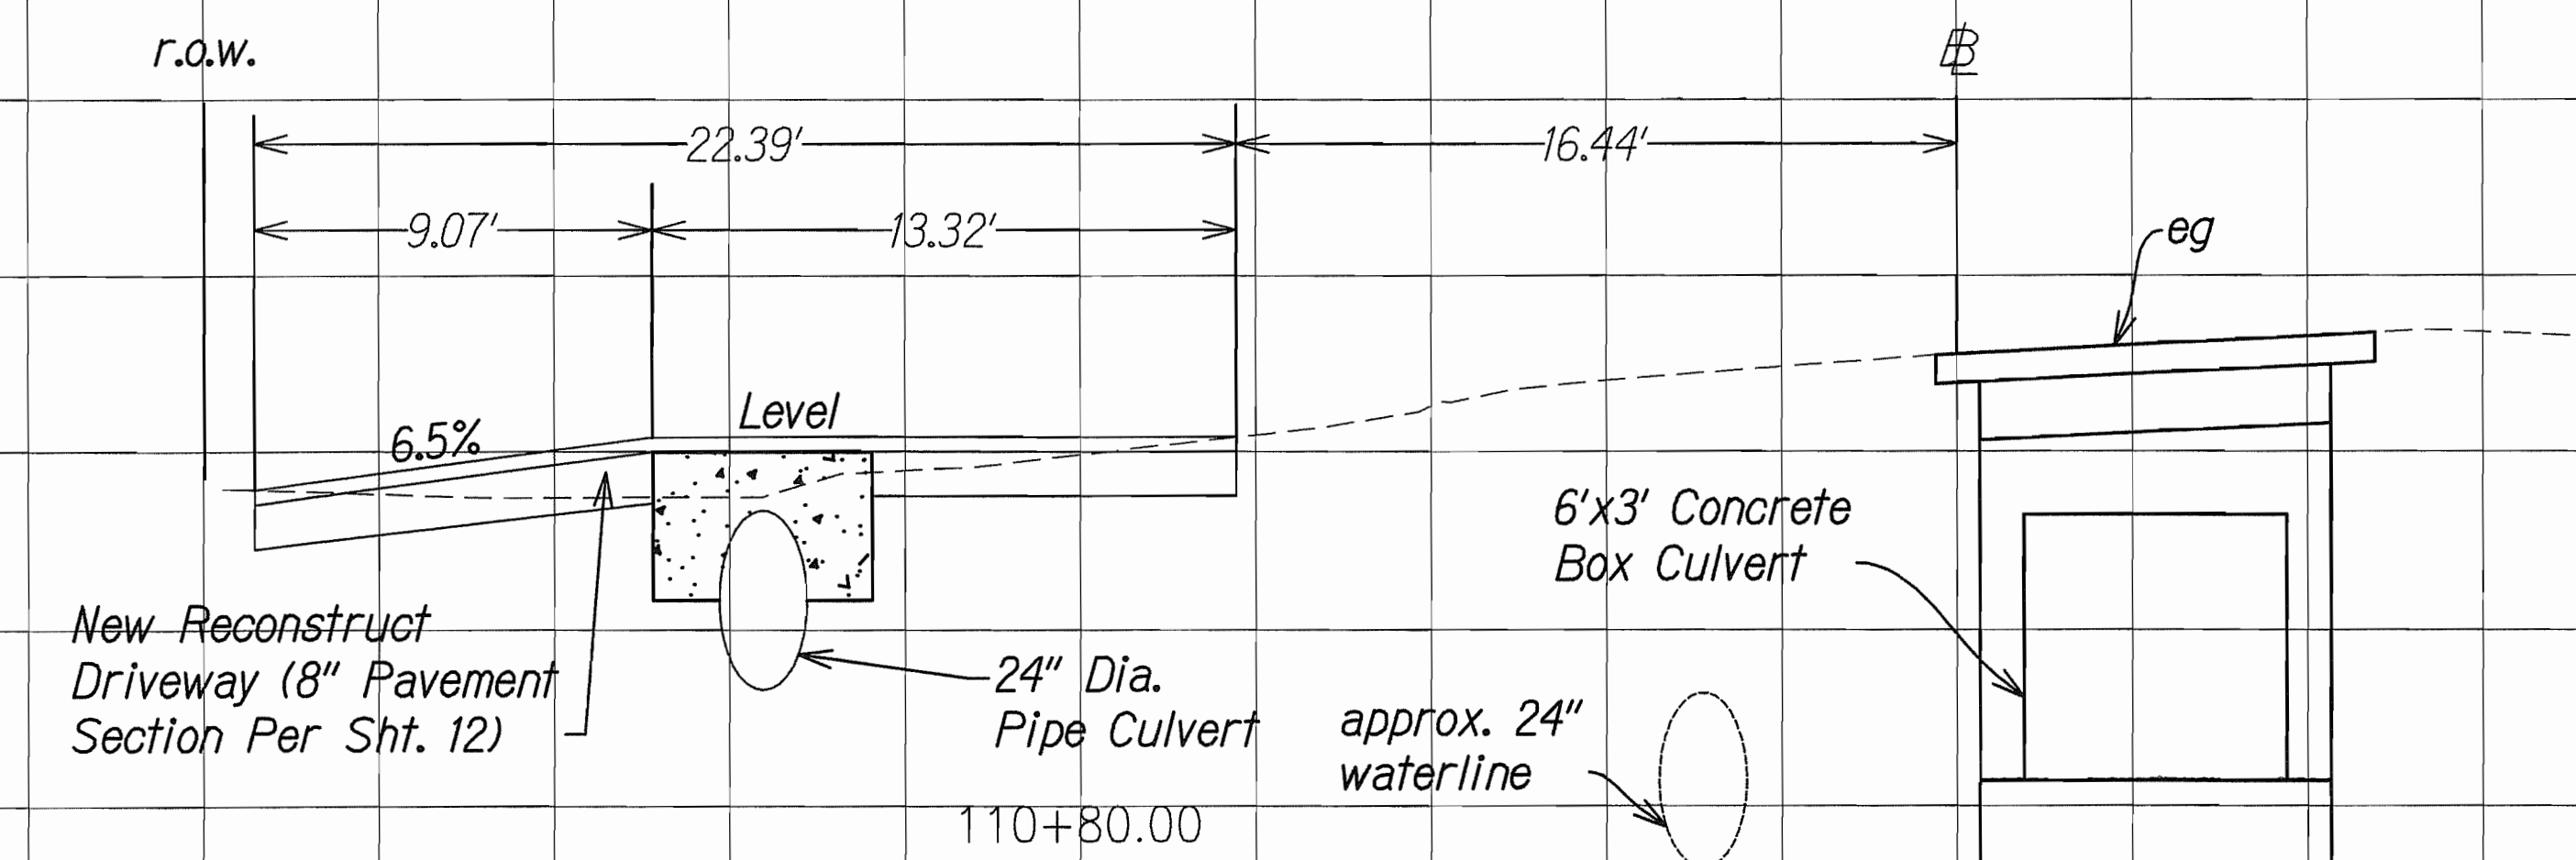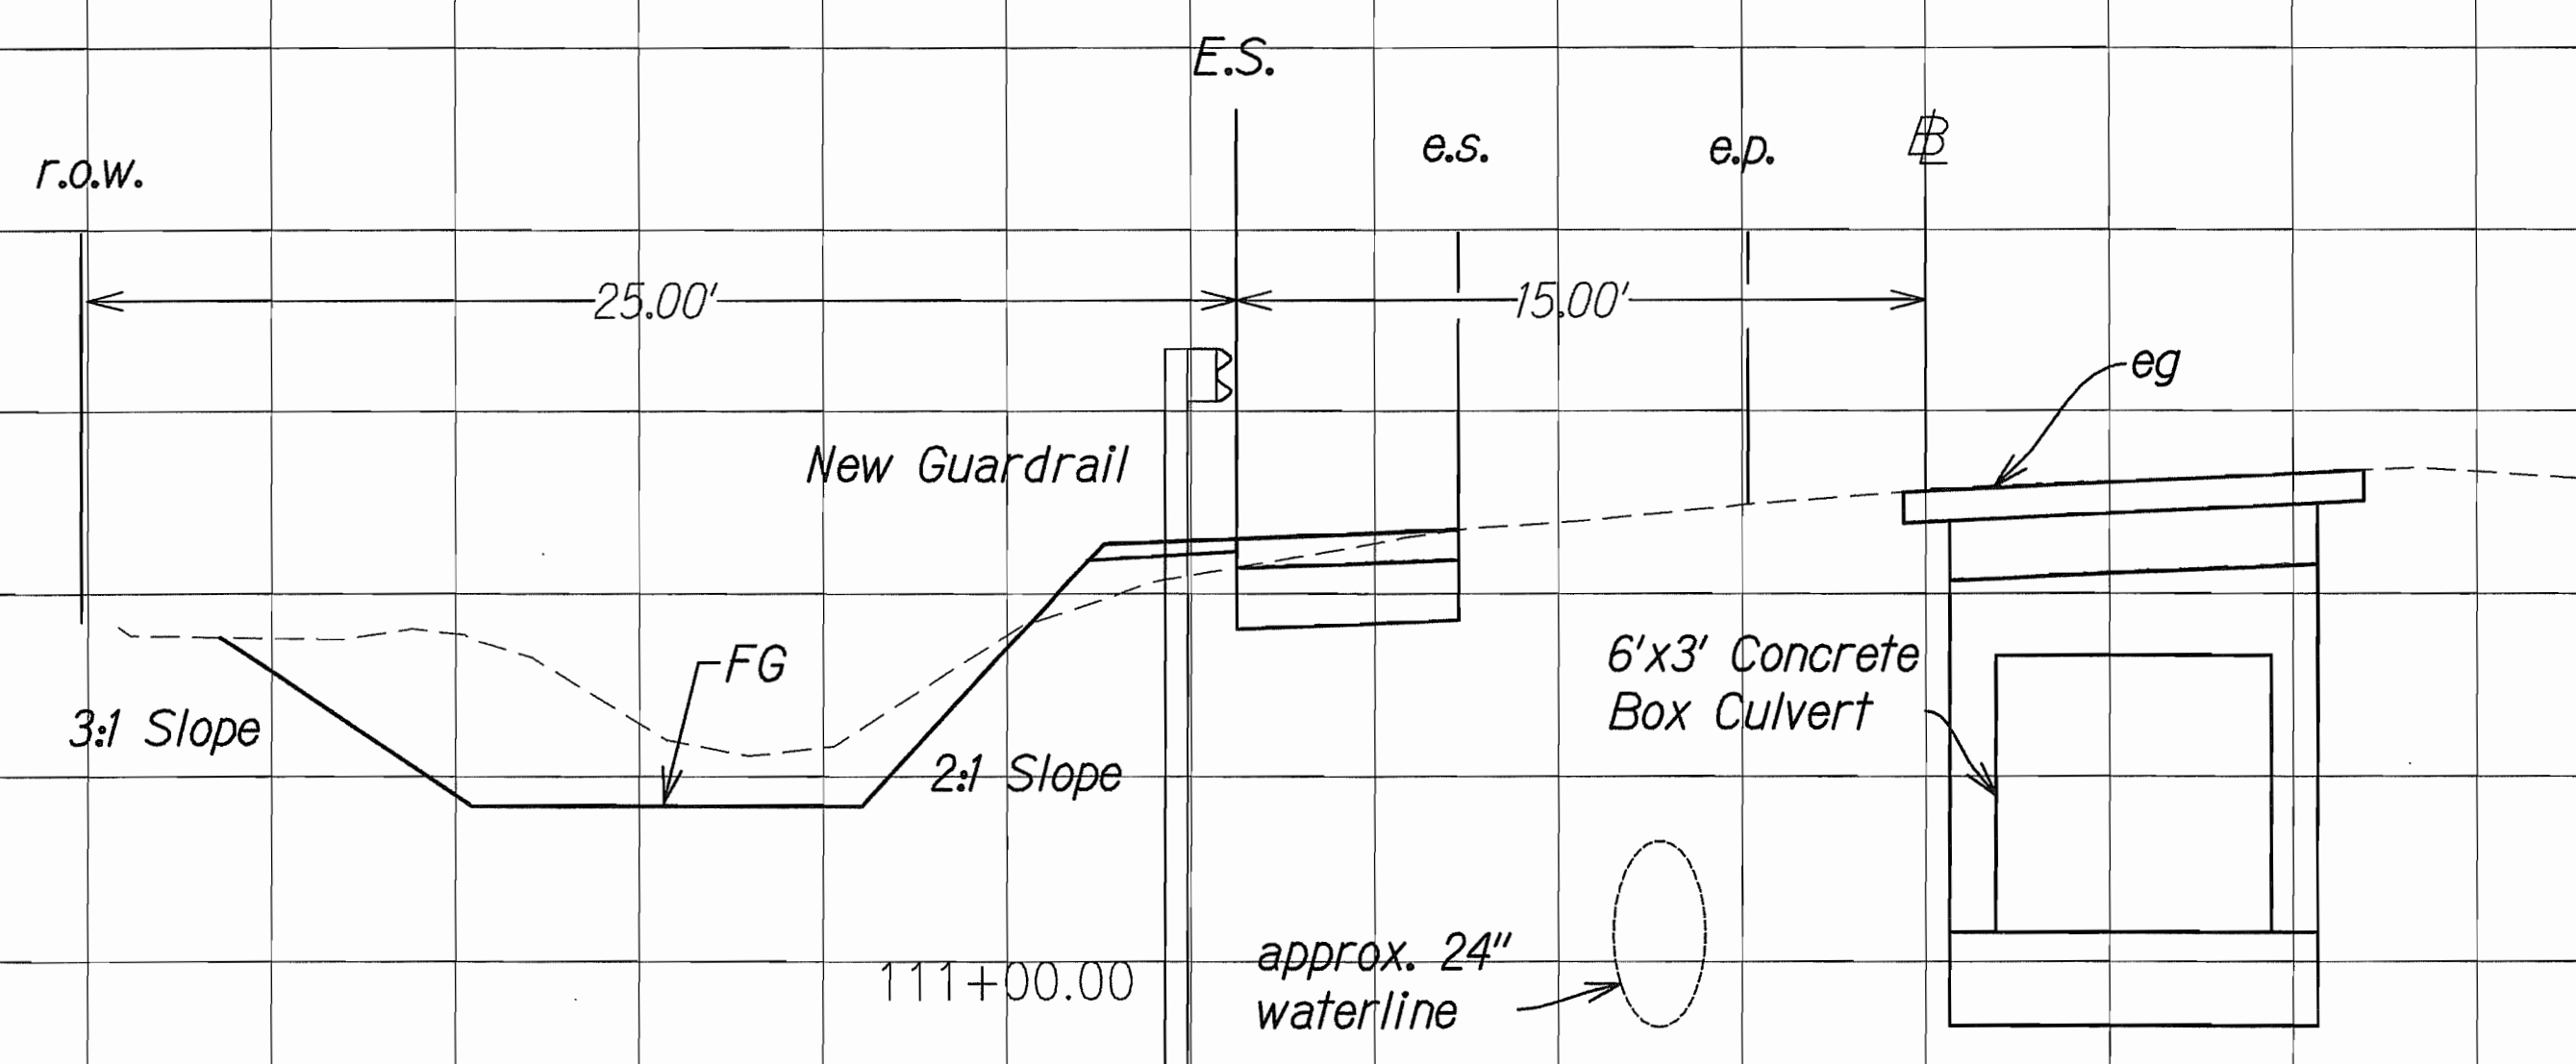

CORREY M. MATSUOKA
LICENSED PROFESSIONAL ENGINEER
NO. 10330-C
HAWAII USA

THIS WORK WAS PREPARED BY ME OR UNDER MY SUPERVISION

SIGNATURE: *Correy Matsuoka* 4/30/12


EXPIRATION DATE OF THE LICENSE

STATE OF HAWAII
DEPARTMENT OF TRANSPORTATION
HIGHWAYS DIVISION







CROSS SECTIONS

FARRINGTON HIGHWAY DRAINAGE IMPROVEMENTS
Vicinity of Orange St.
Project No. 93B-01-11
Scale: AS NOTED Date: FEB 2012
SHEET No. 3 OF 5 SHEETS


FED. ROAD DIST. NO.	STATE	FED. AID PROJ. NO.	FISCAL YEAR	SHEET NO.	TOTAL SHEETS
HAWAII	HAW.	93B-01-11	2011	30	38

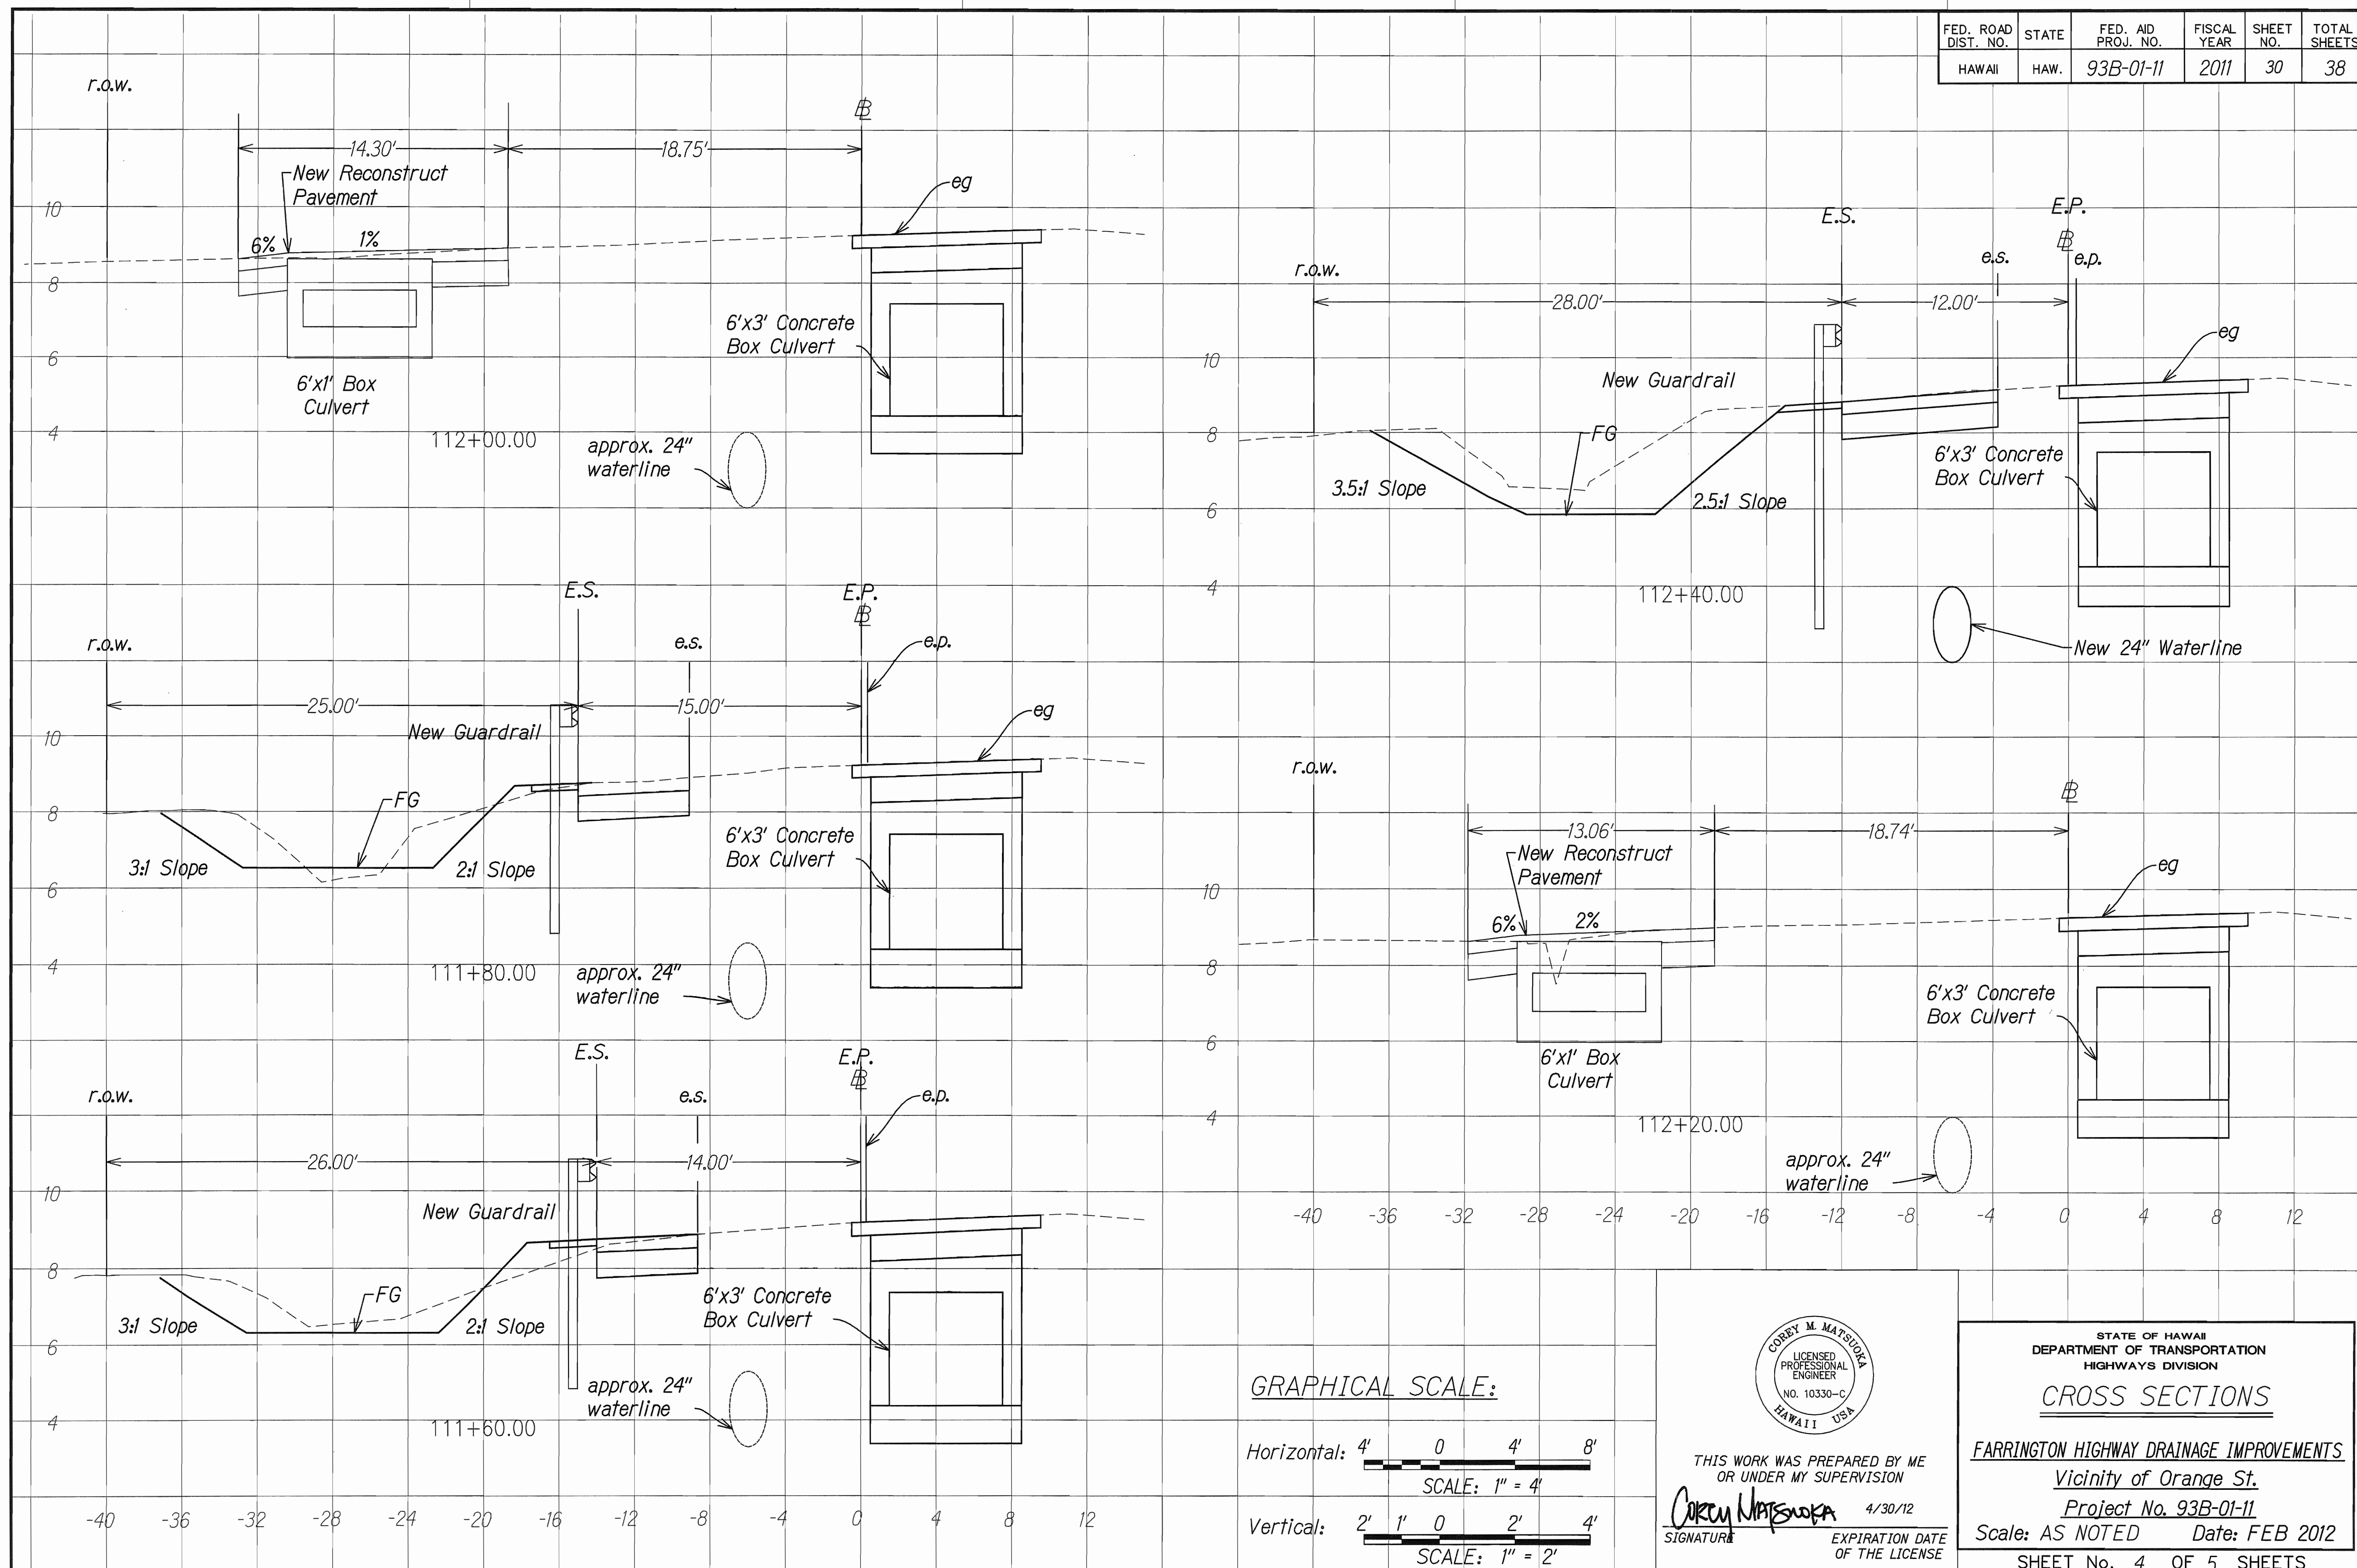

FED. ROAD DIST. NO.	STATE	FED. AID PROJ. NO.	FISCAL YEAR	SHEET NO.	TOTAL SHEETS
HAWAII	HAW.	93B-01-11	2011	31	38

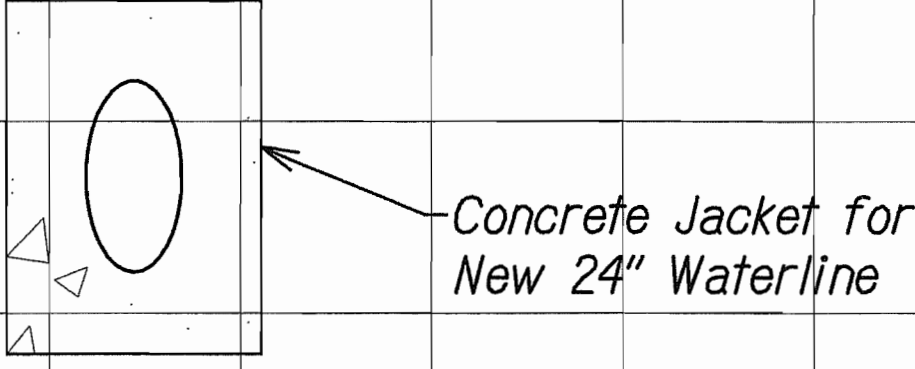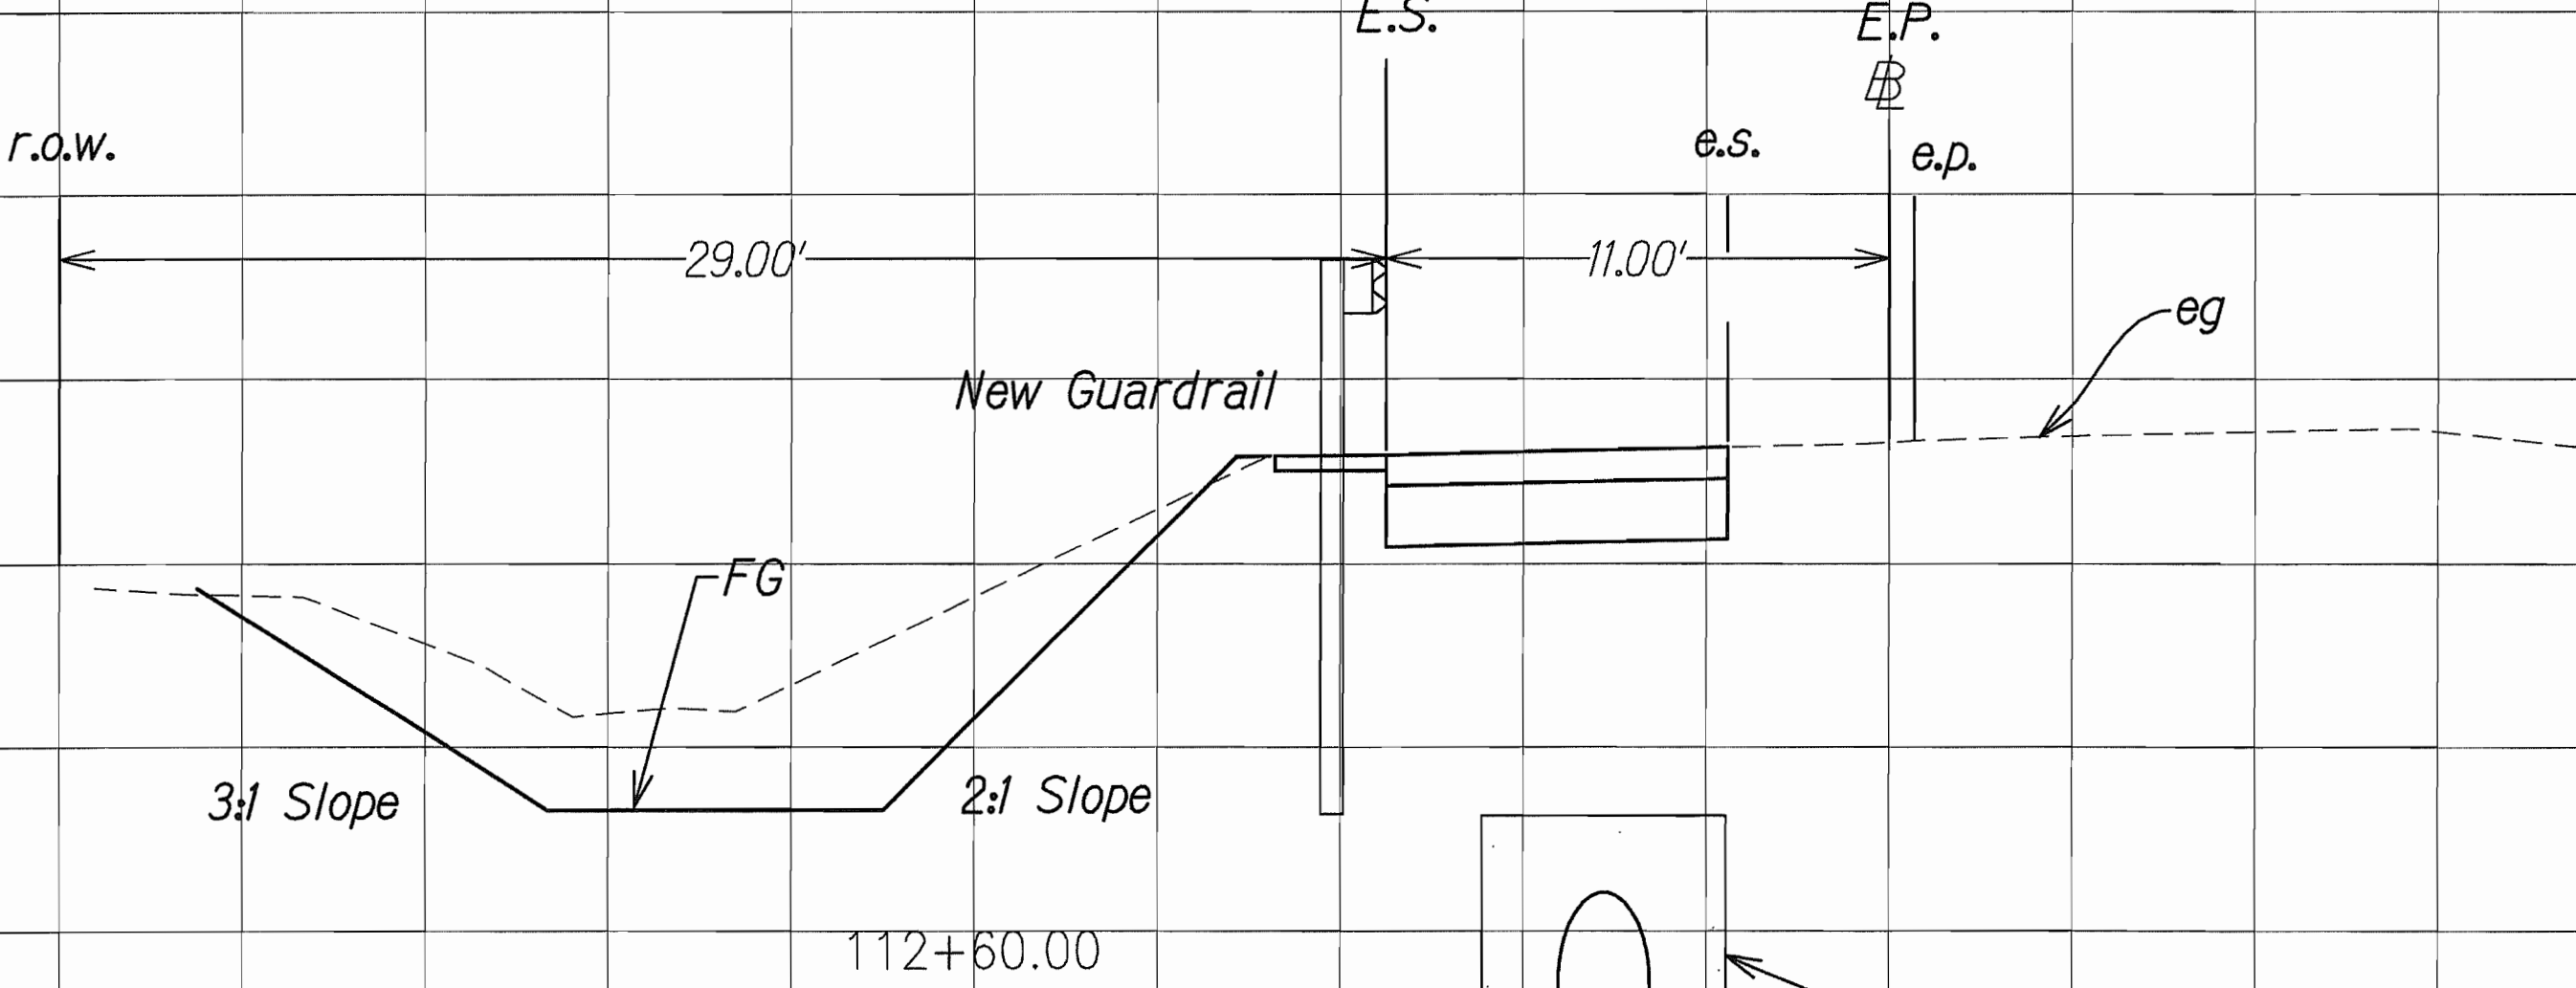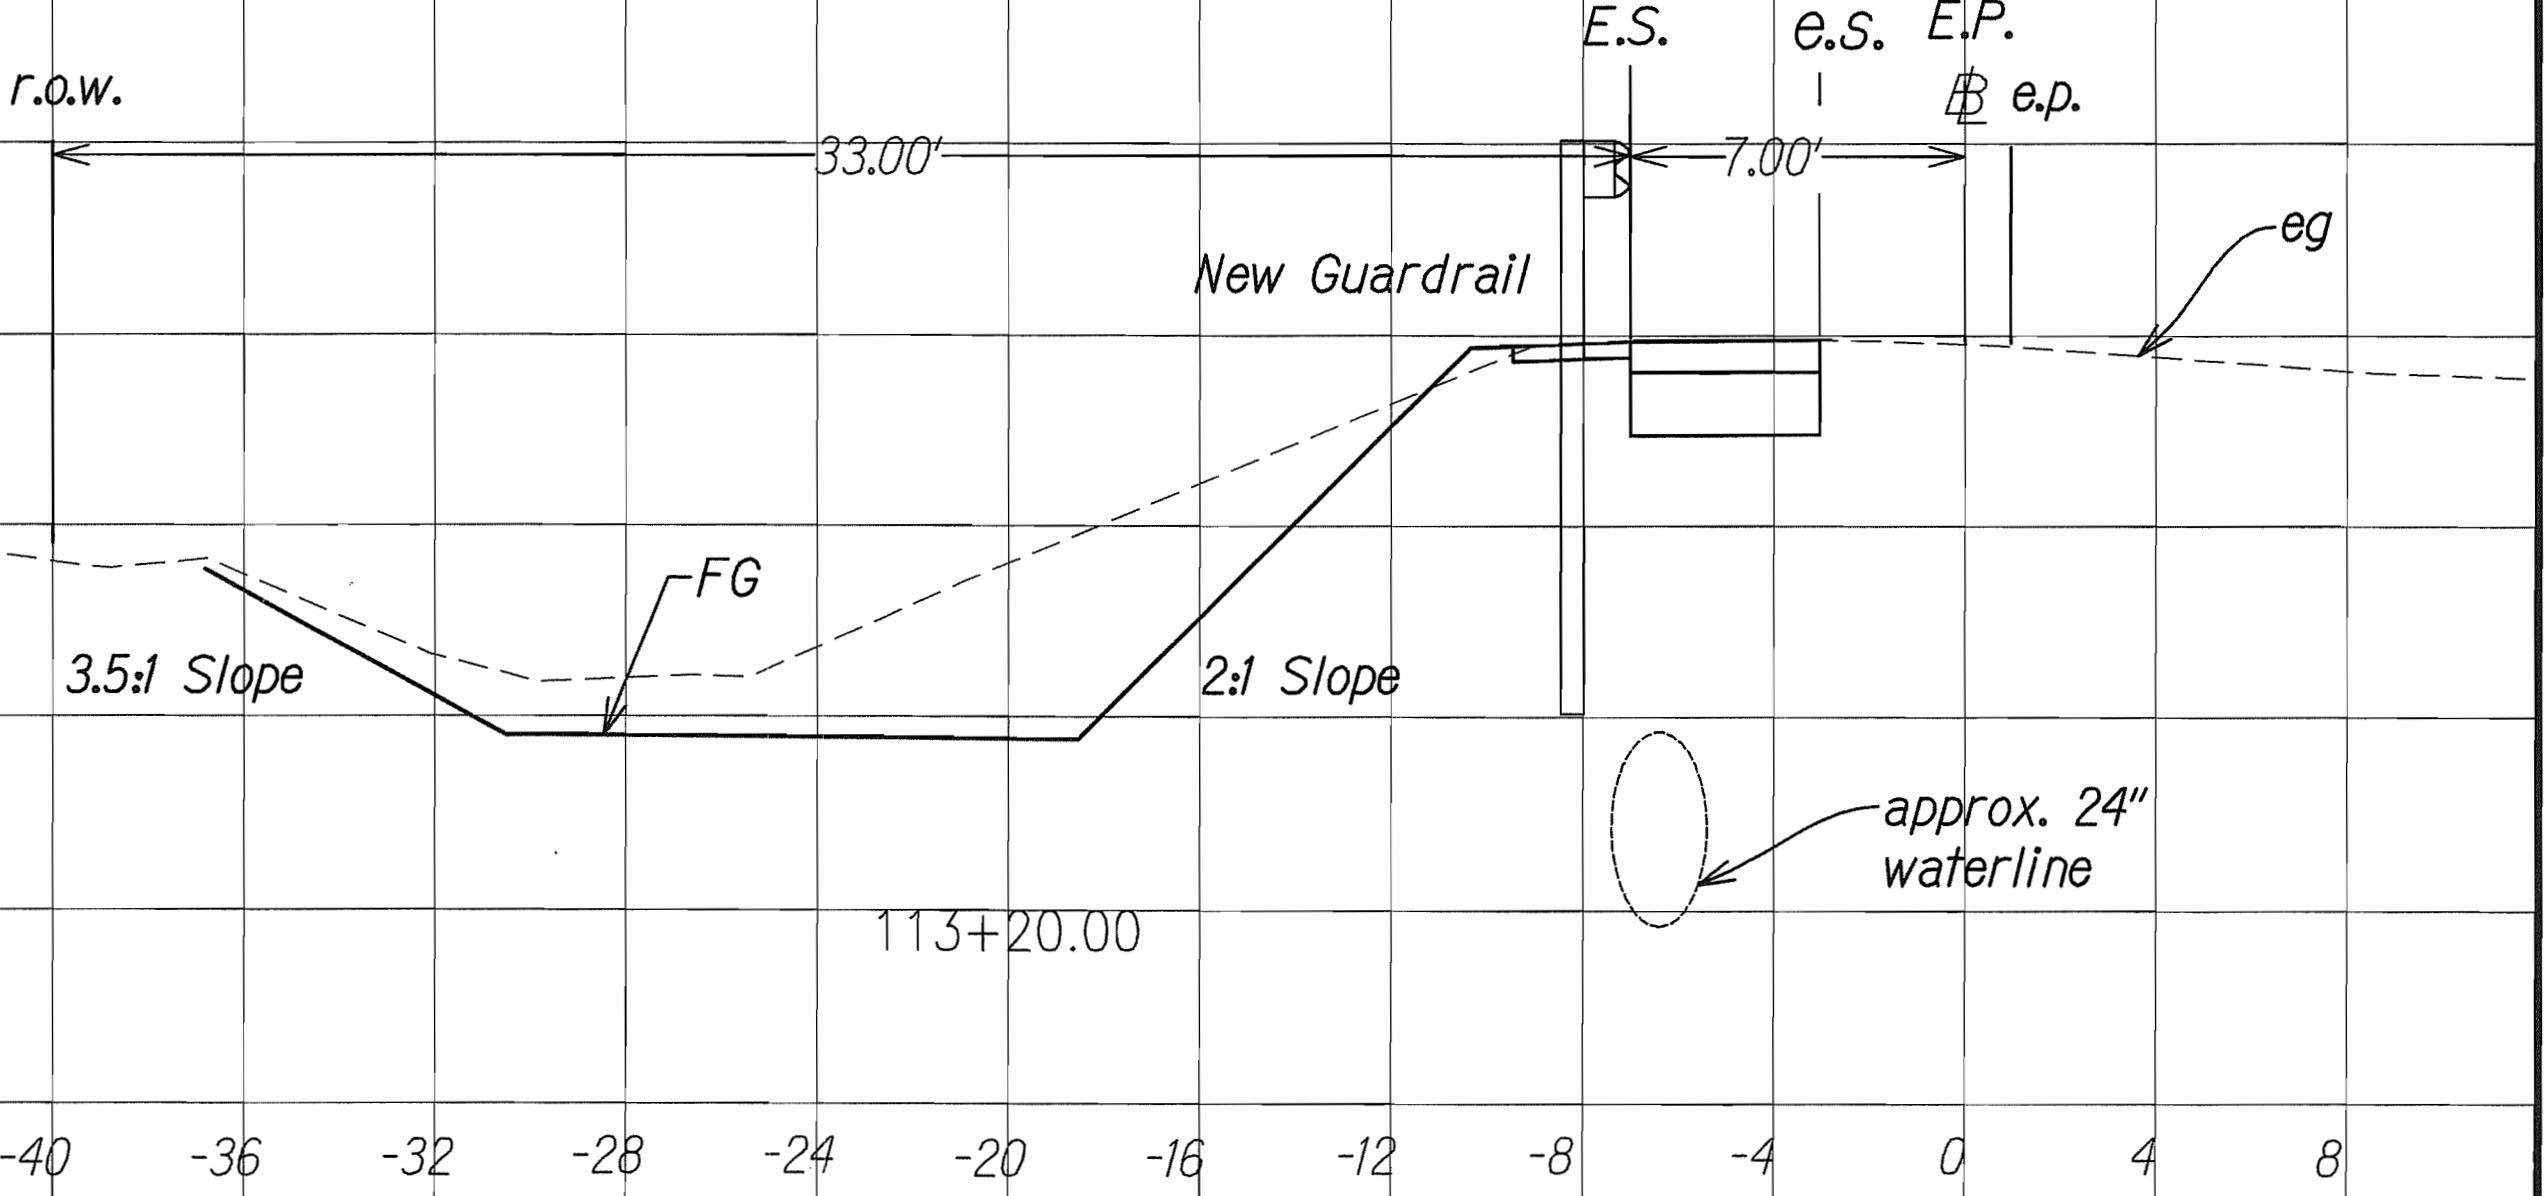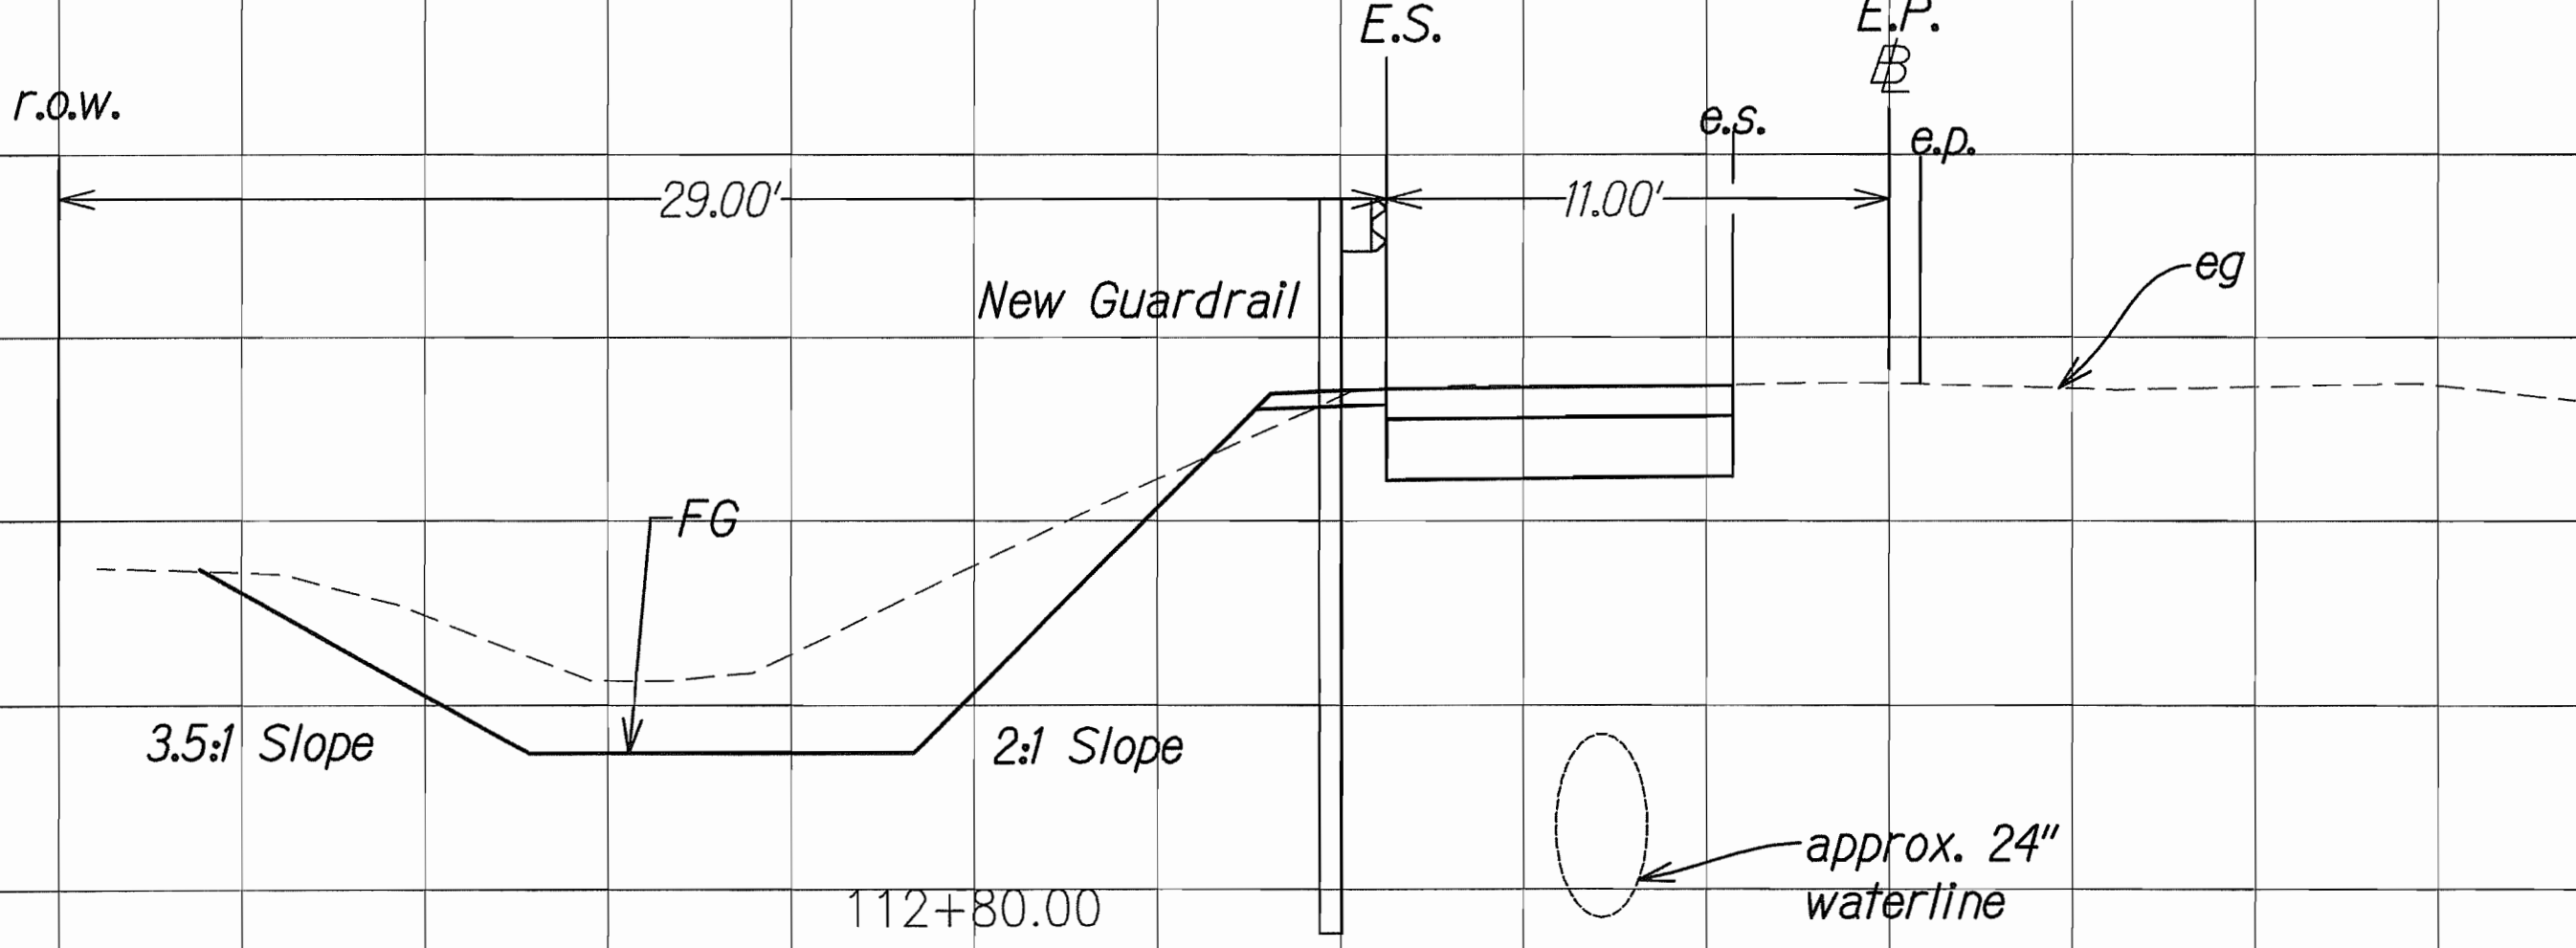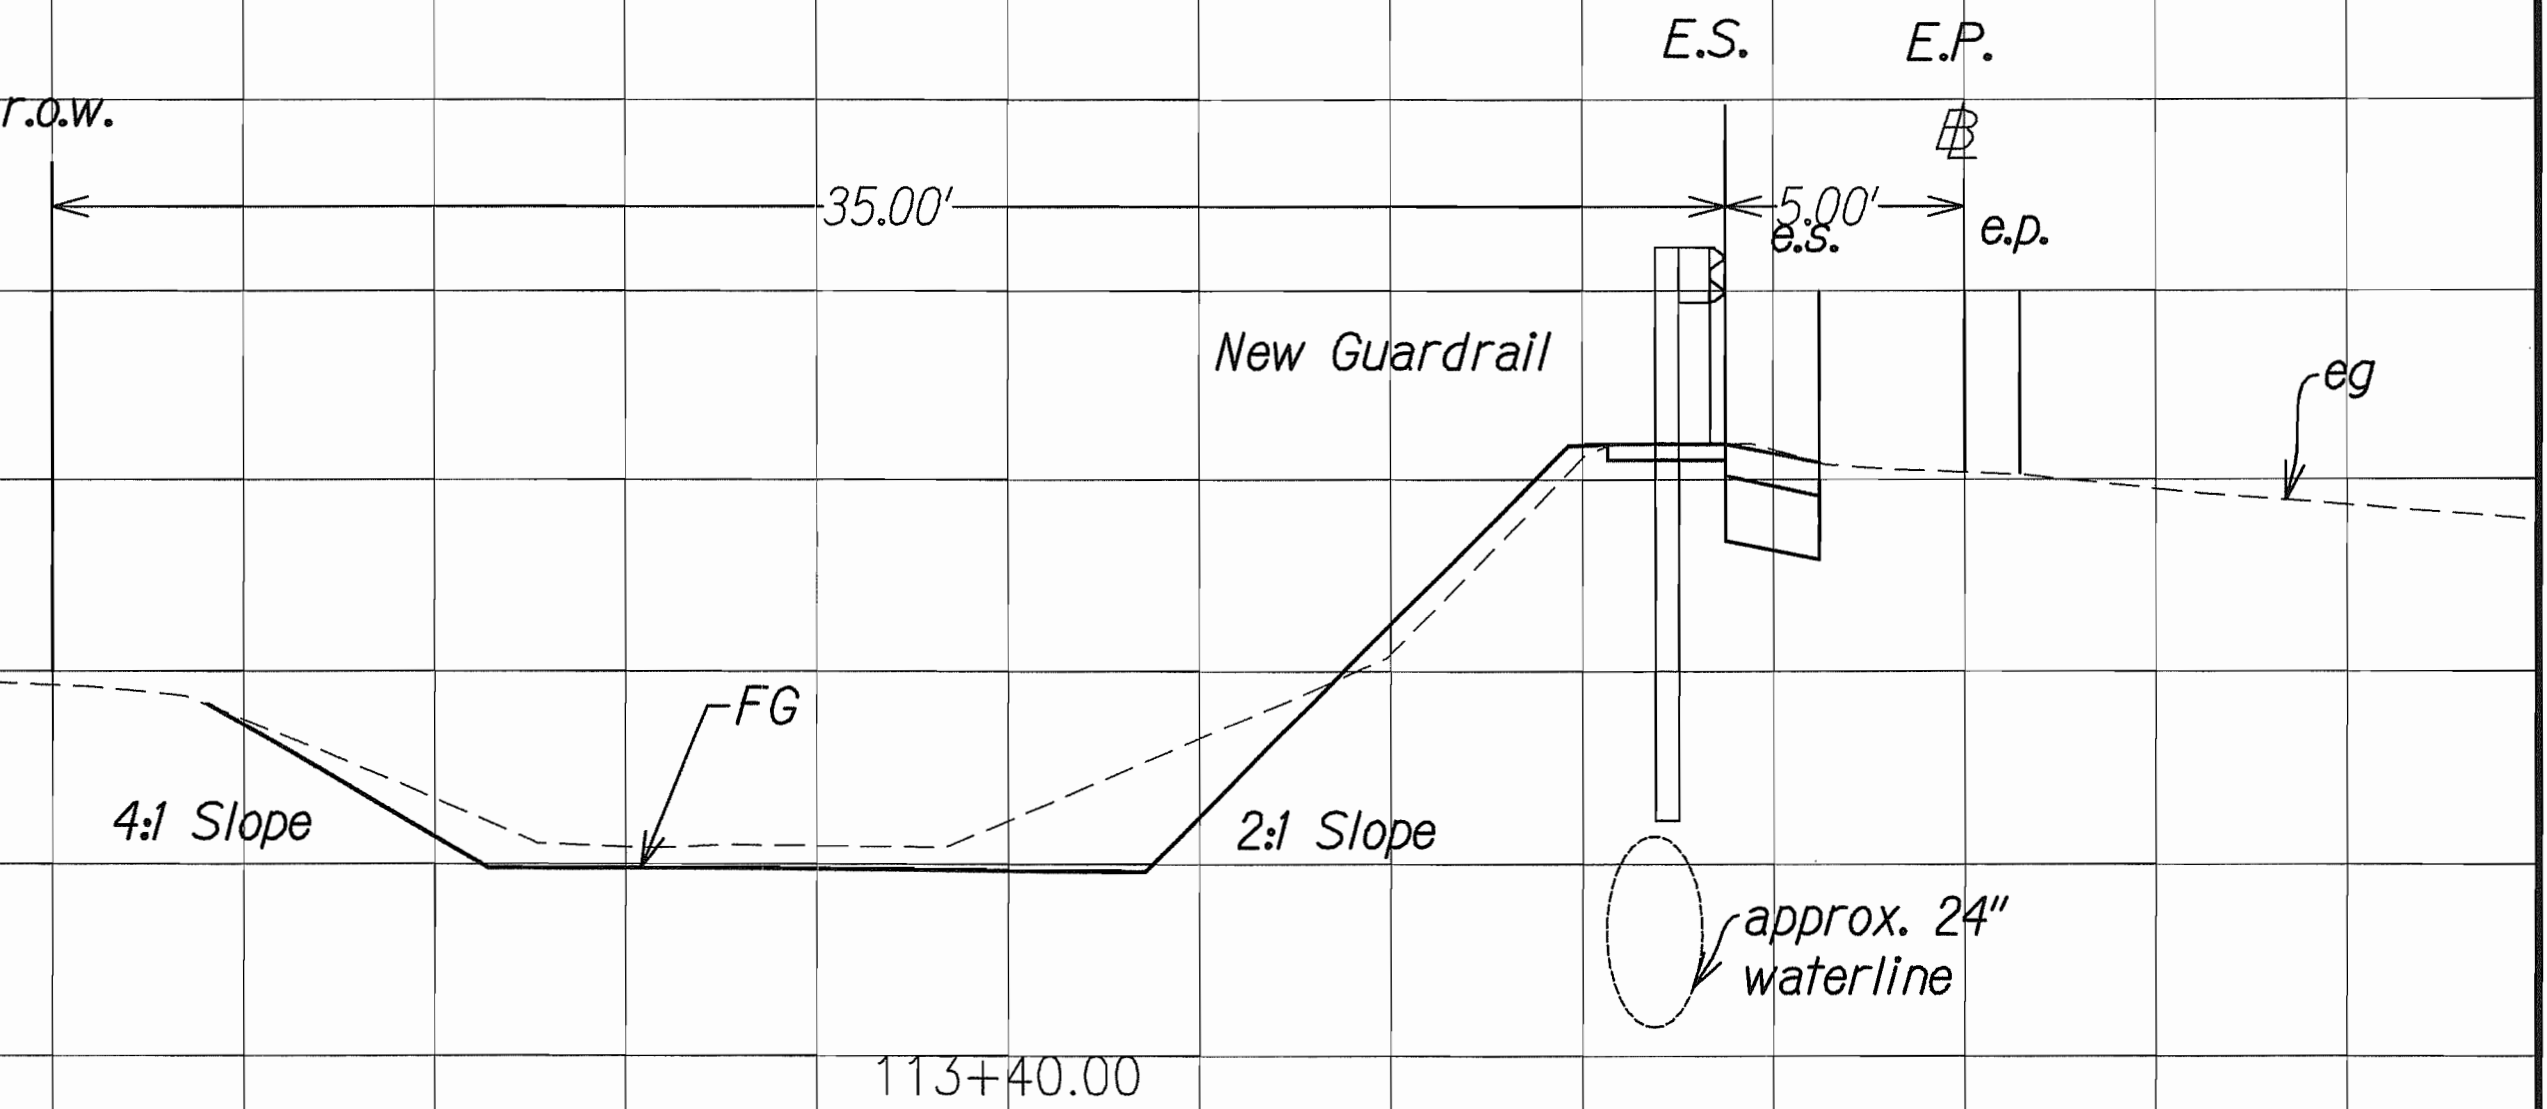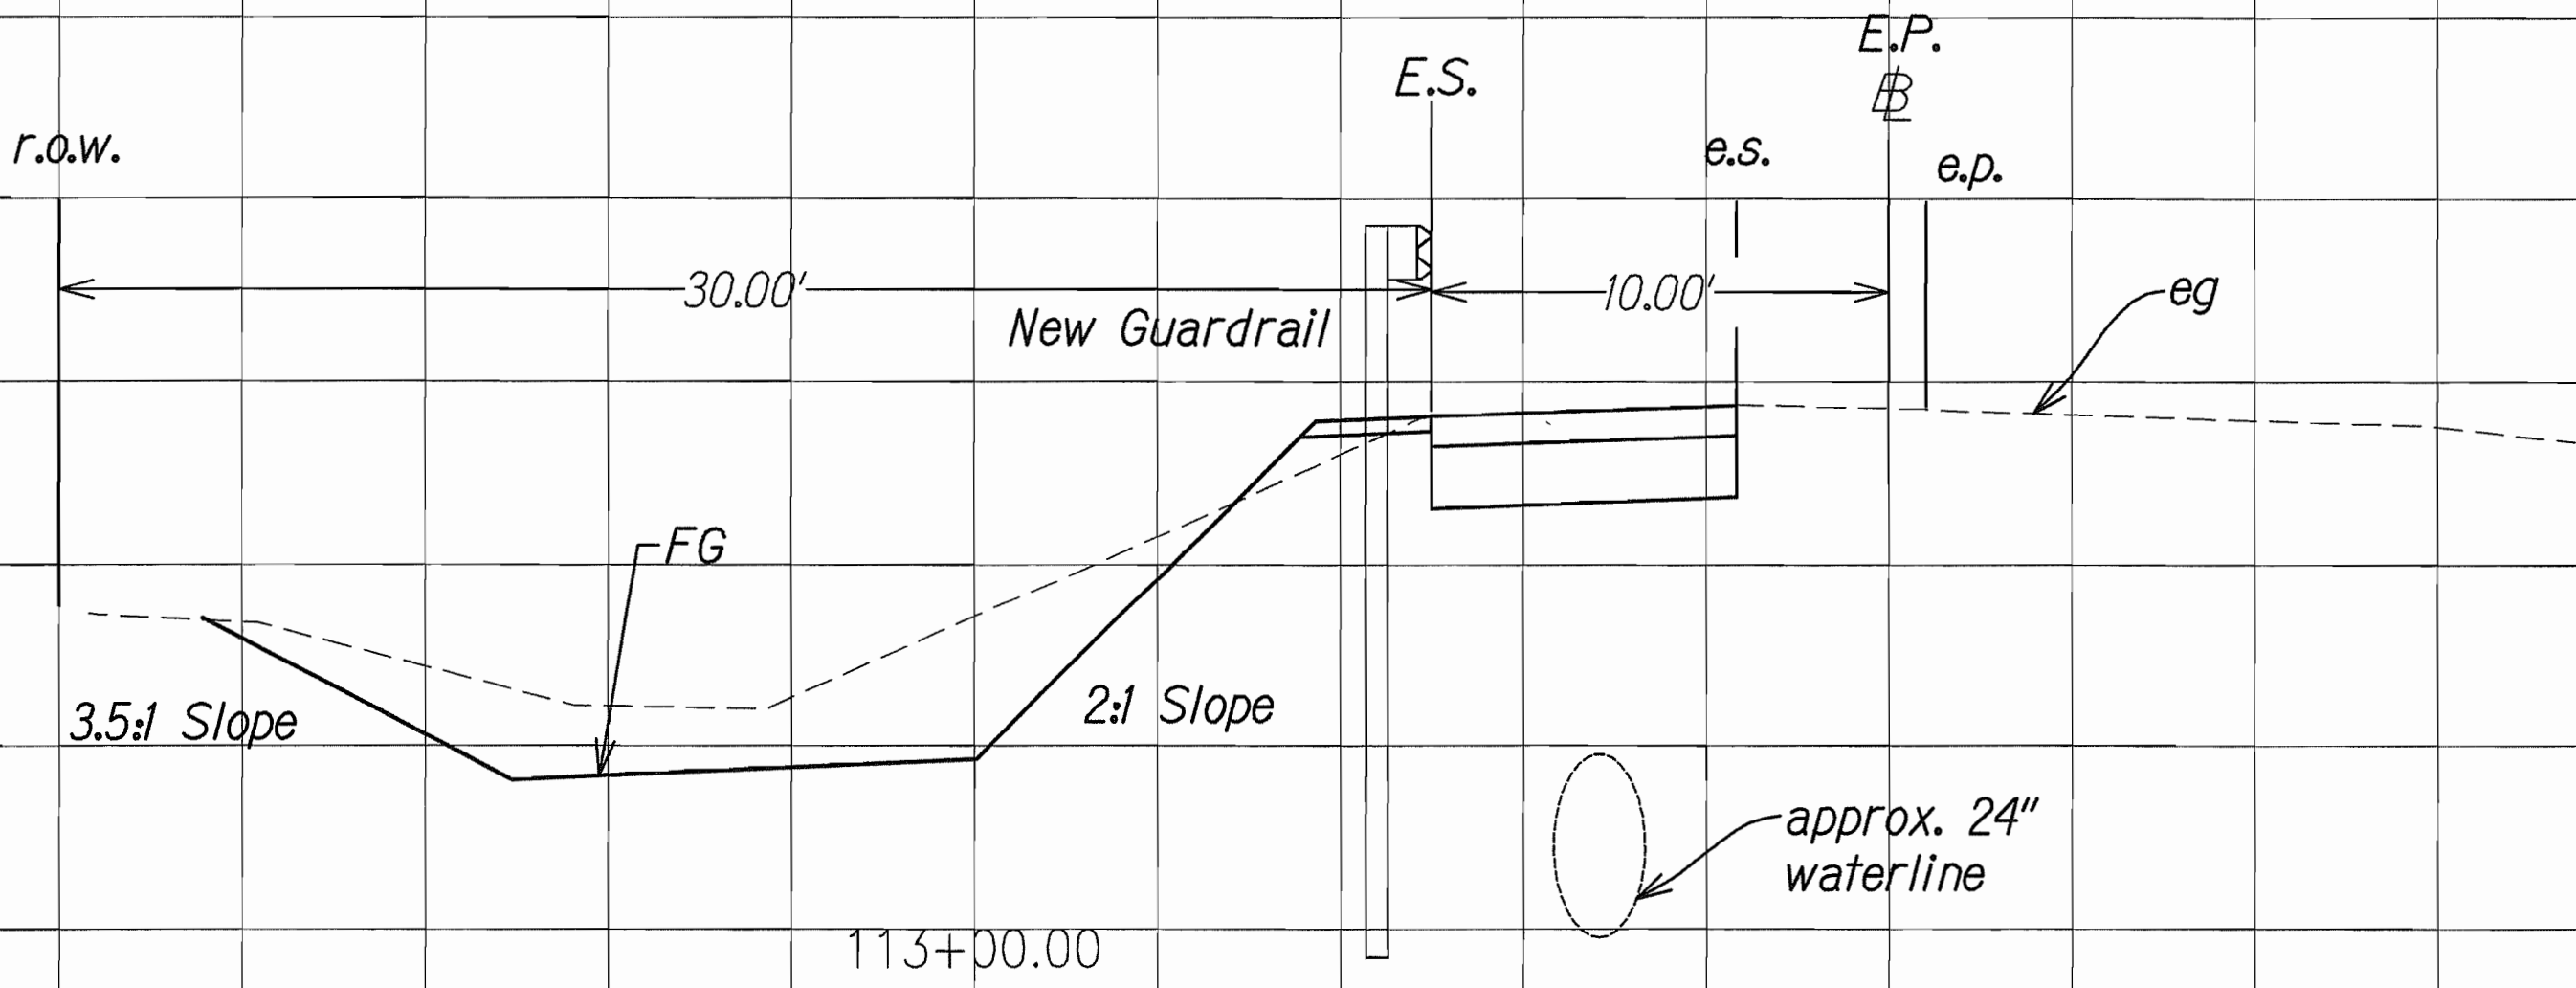

GRAPHICAL SCALE:

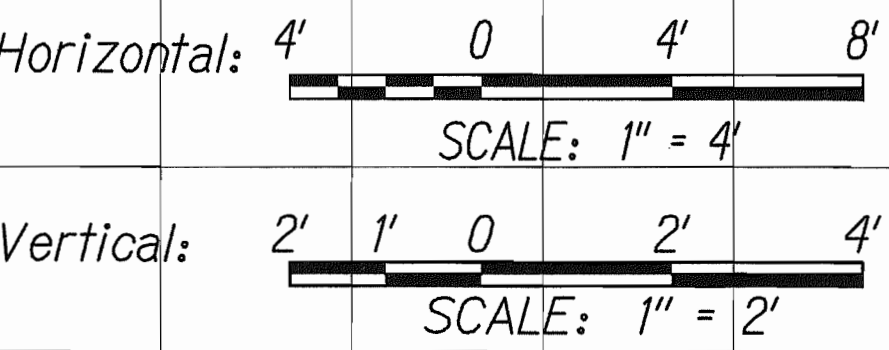

COREY M. MATSUDA
LICENSED PROFESSIONAL ENGINEER
NO. 10330-C
HAWAII, USA

THIS WORK WAS PREPARED BY ME
OR UNDER MY SUPERVISION

Corey Matsuda 4/30/12
SIGNATURE EXPIRATION DATE OF THE LICENSE

STATE OF HAWAII
DEPARTMENT OF TRANSPORTATION
HIGHWAYS DIVISION

CROSS SECTION

FARRINGTON HIGHWAY DRAINAGE IMPROVEMENTS
Vicinity of Orange St.
Project No. 93B-01-11
Scale: AS NOTED Date: FEB 2012

SHEET No. 5 OF 5 SHEETS