
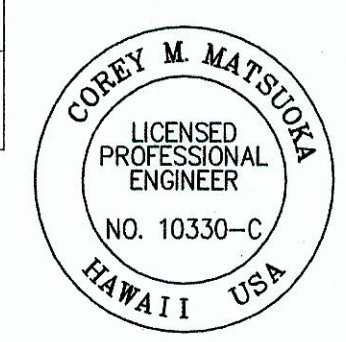
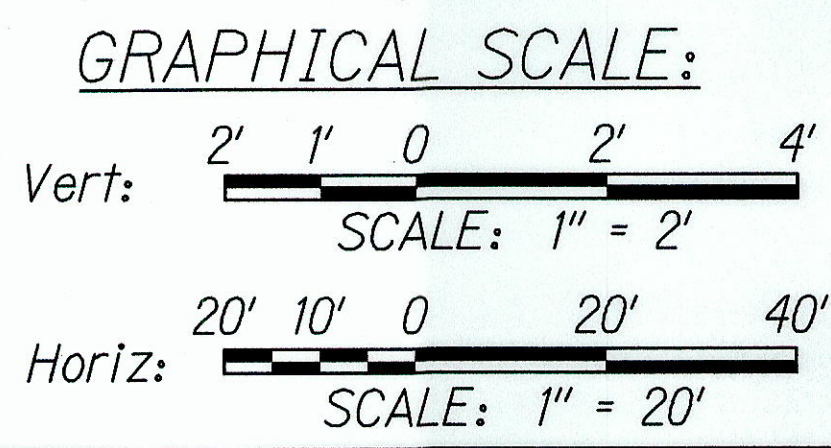
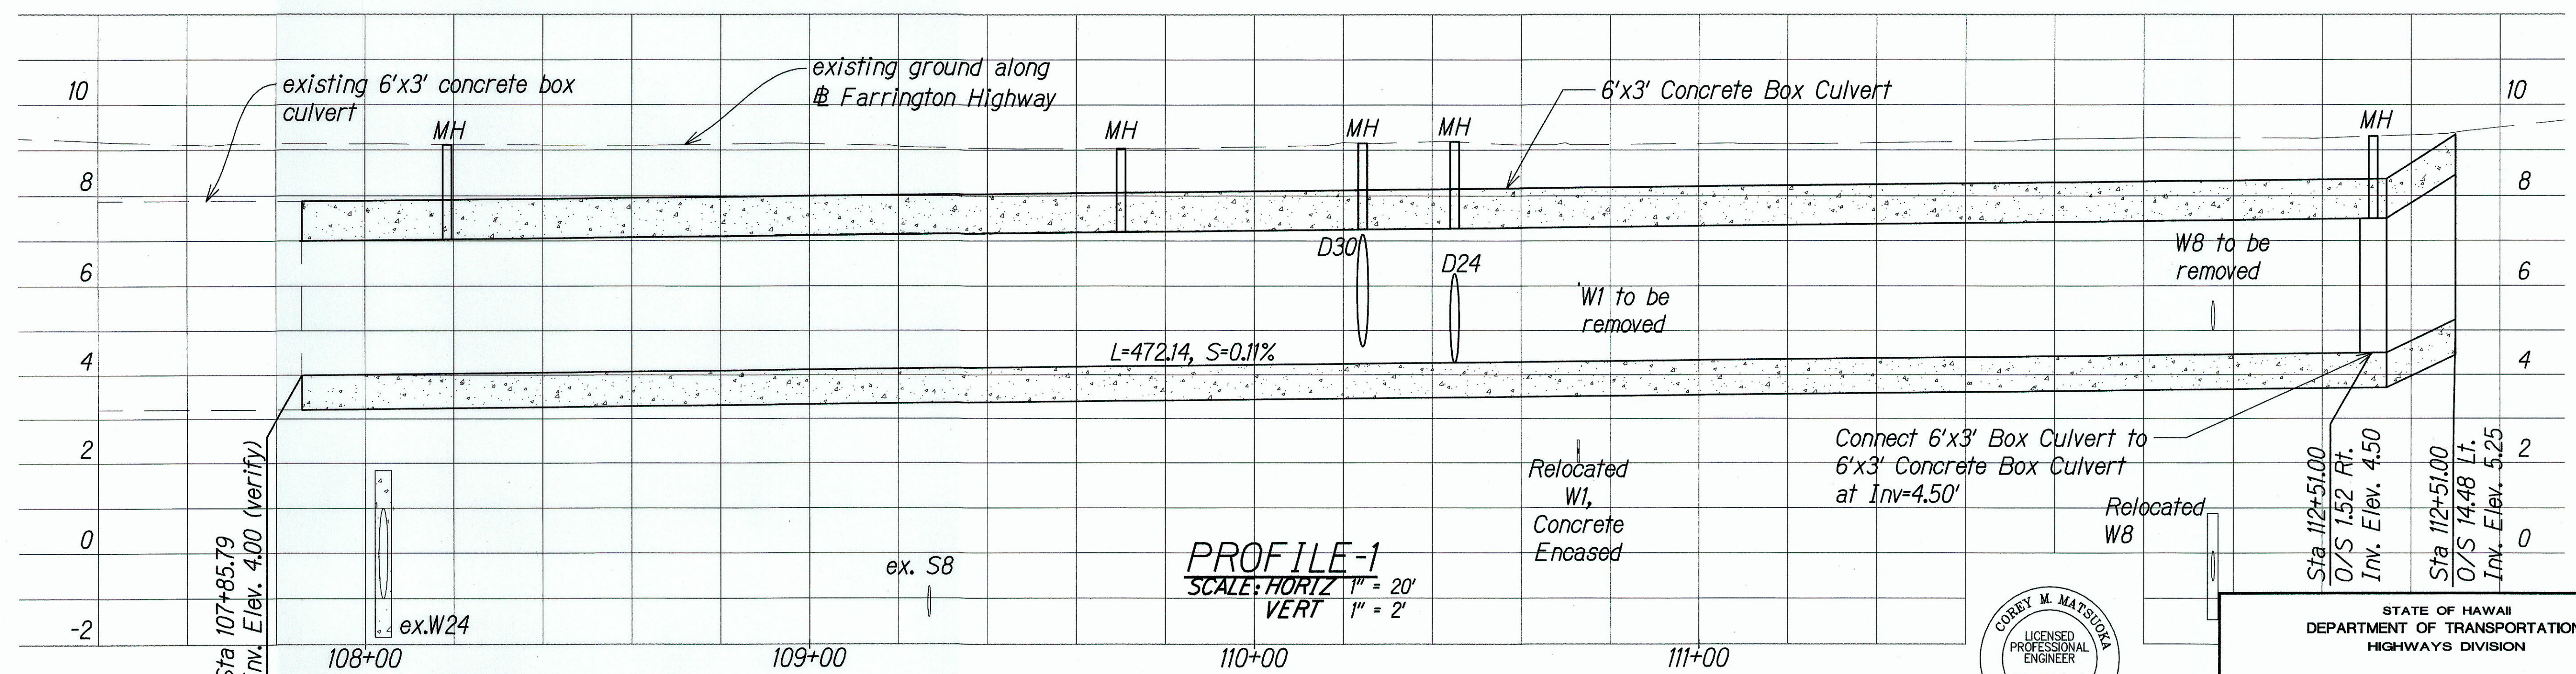


FED. ROAD DIST. NO.	STATE	FED. AID PROJ. NO.	FISCAL YEAR	SHEET NO.	TOTAL SHEETS
HAWAII	HAW.	93B-01-11	2012	16	38

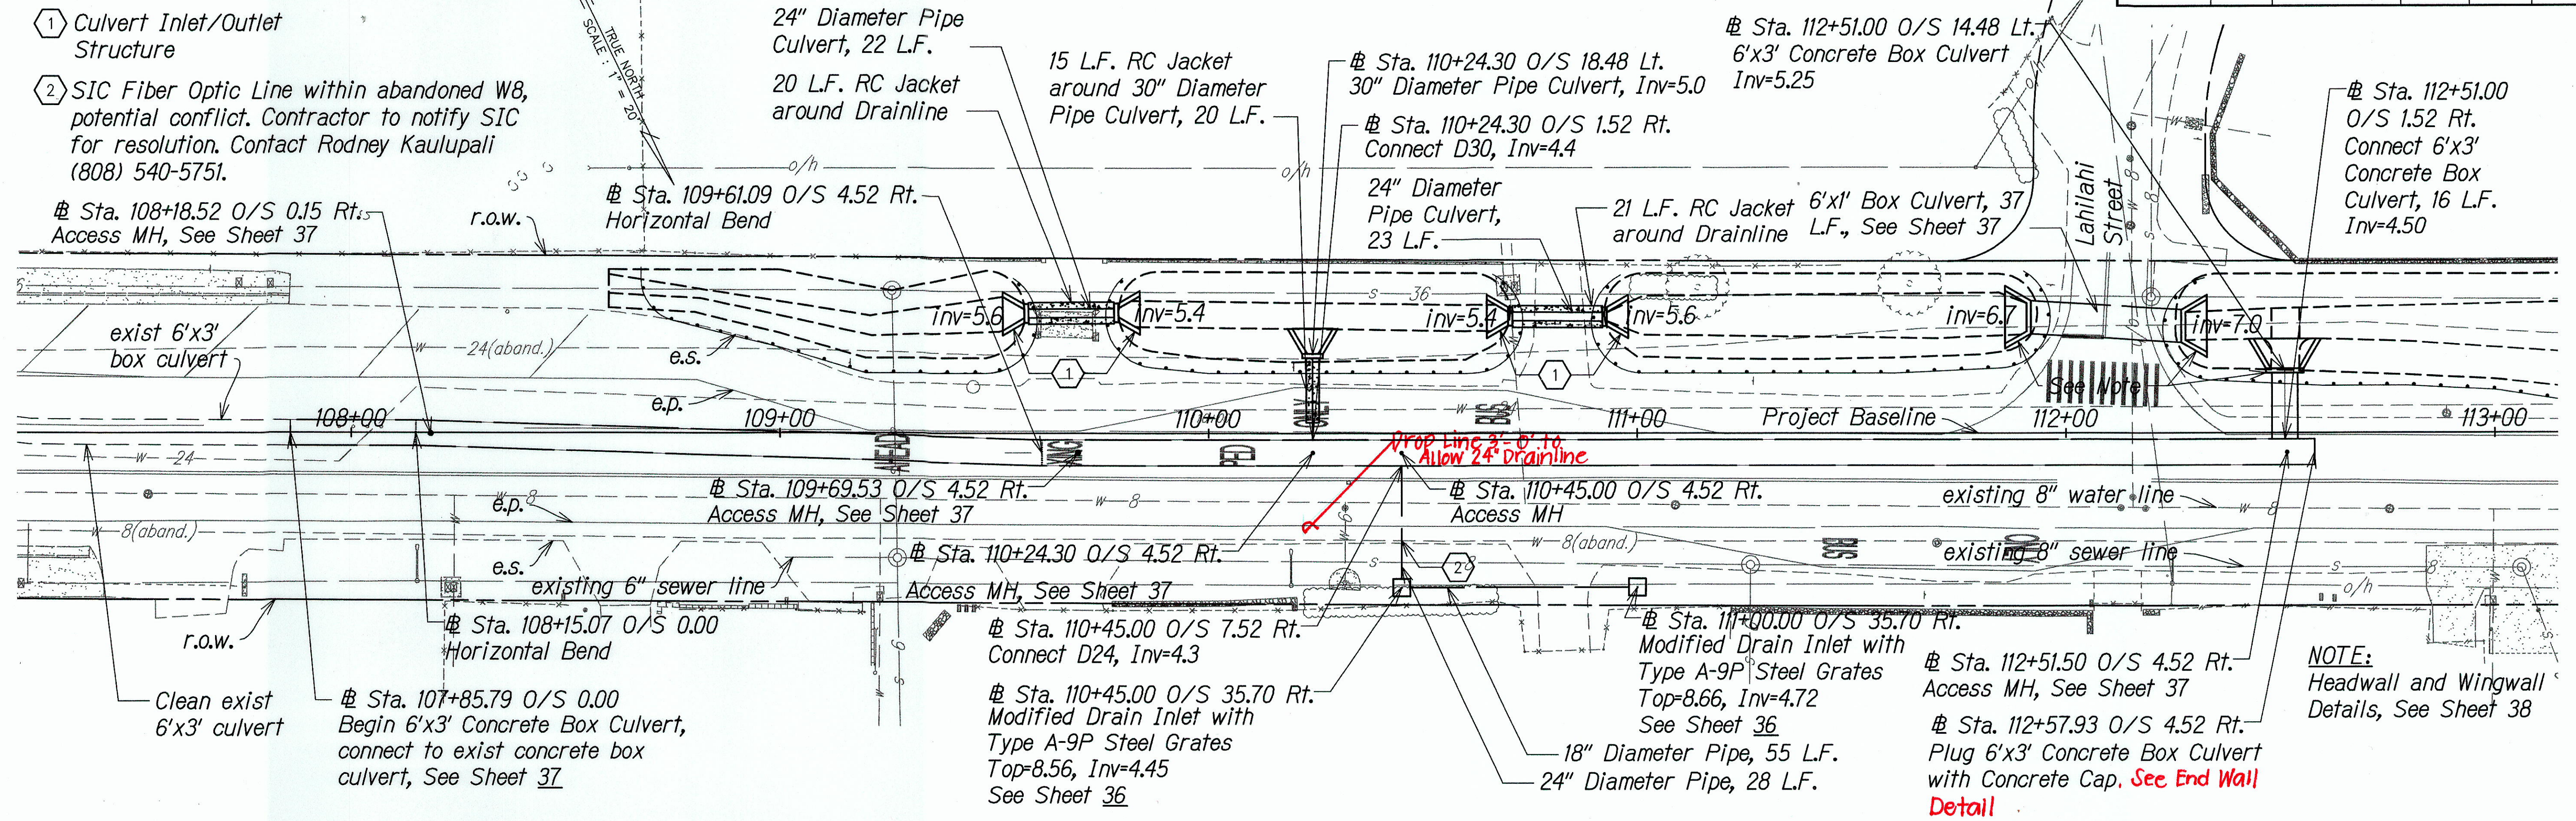

THIS WORK WAS PREPARED BY ME OR UNDER MY SUPERVISION

COREY MATSUSHITA

SIGNATURE

4/30/12

EXPIRATION DATE OF THE LICENSE

STATE OF HAWAII
DEPARTMENT OF TRANSPORTATION
HIGHWAYS DIVISION

DRAINAGE PLAN AND PROFILE

FARRINGTON HIGHWAY DRAINAGE IMPROVEMENTS

Vicinity of Orange St.

Project No. 93B-01-11

Scale: AS NOTED Date: FEB 2012

SHEET No. 1 OF 1 SHEETS

"AS-BUILT"