
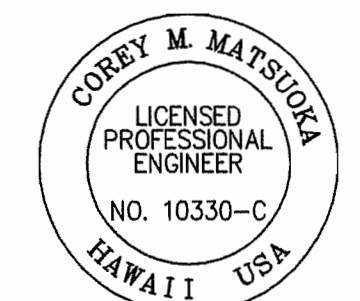


FED. ROAD DIST. NO.	STATE	FED. AID PROJ. NO.	FISCAL YEAR	SHEET NO.	TOTAL SHEETS
HAWAII	HAW.	93B-01-11	2012	15	38

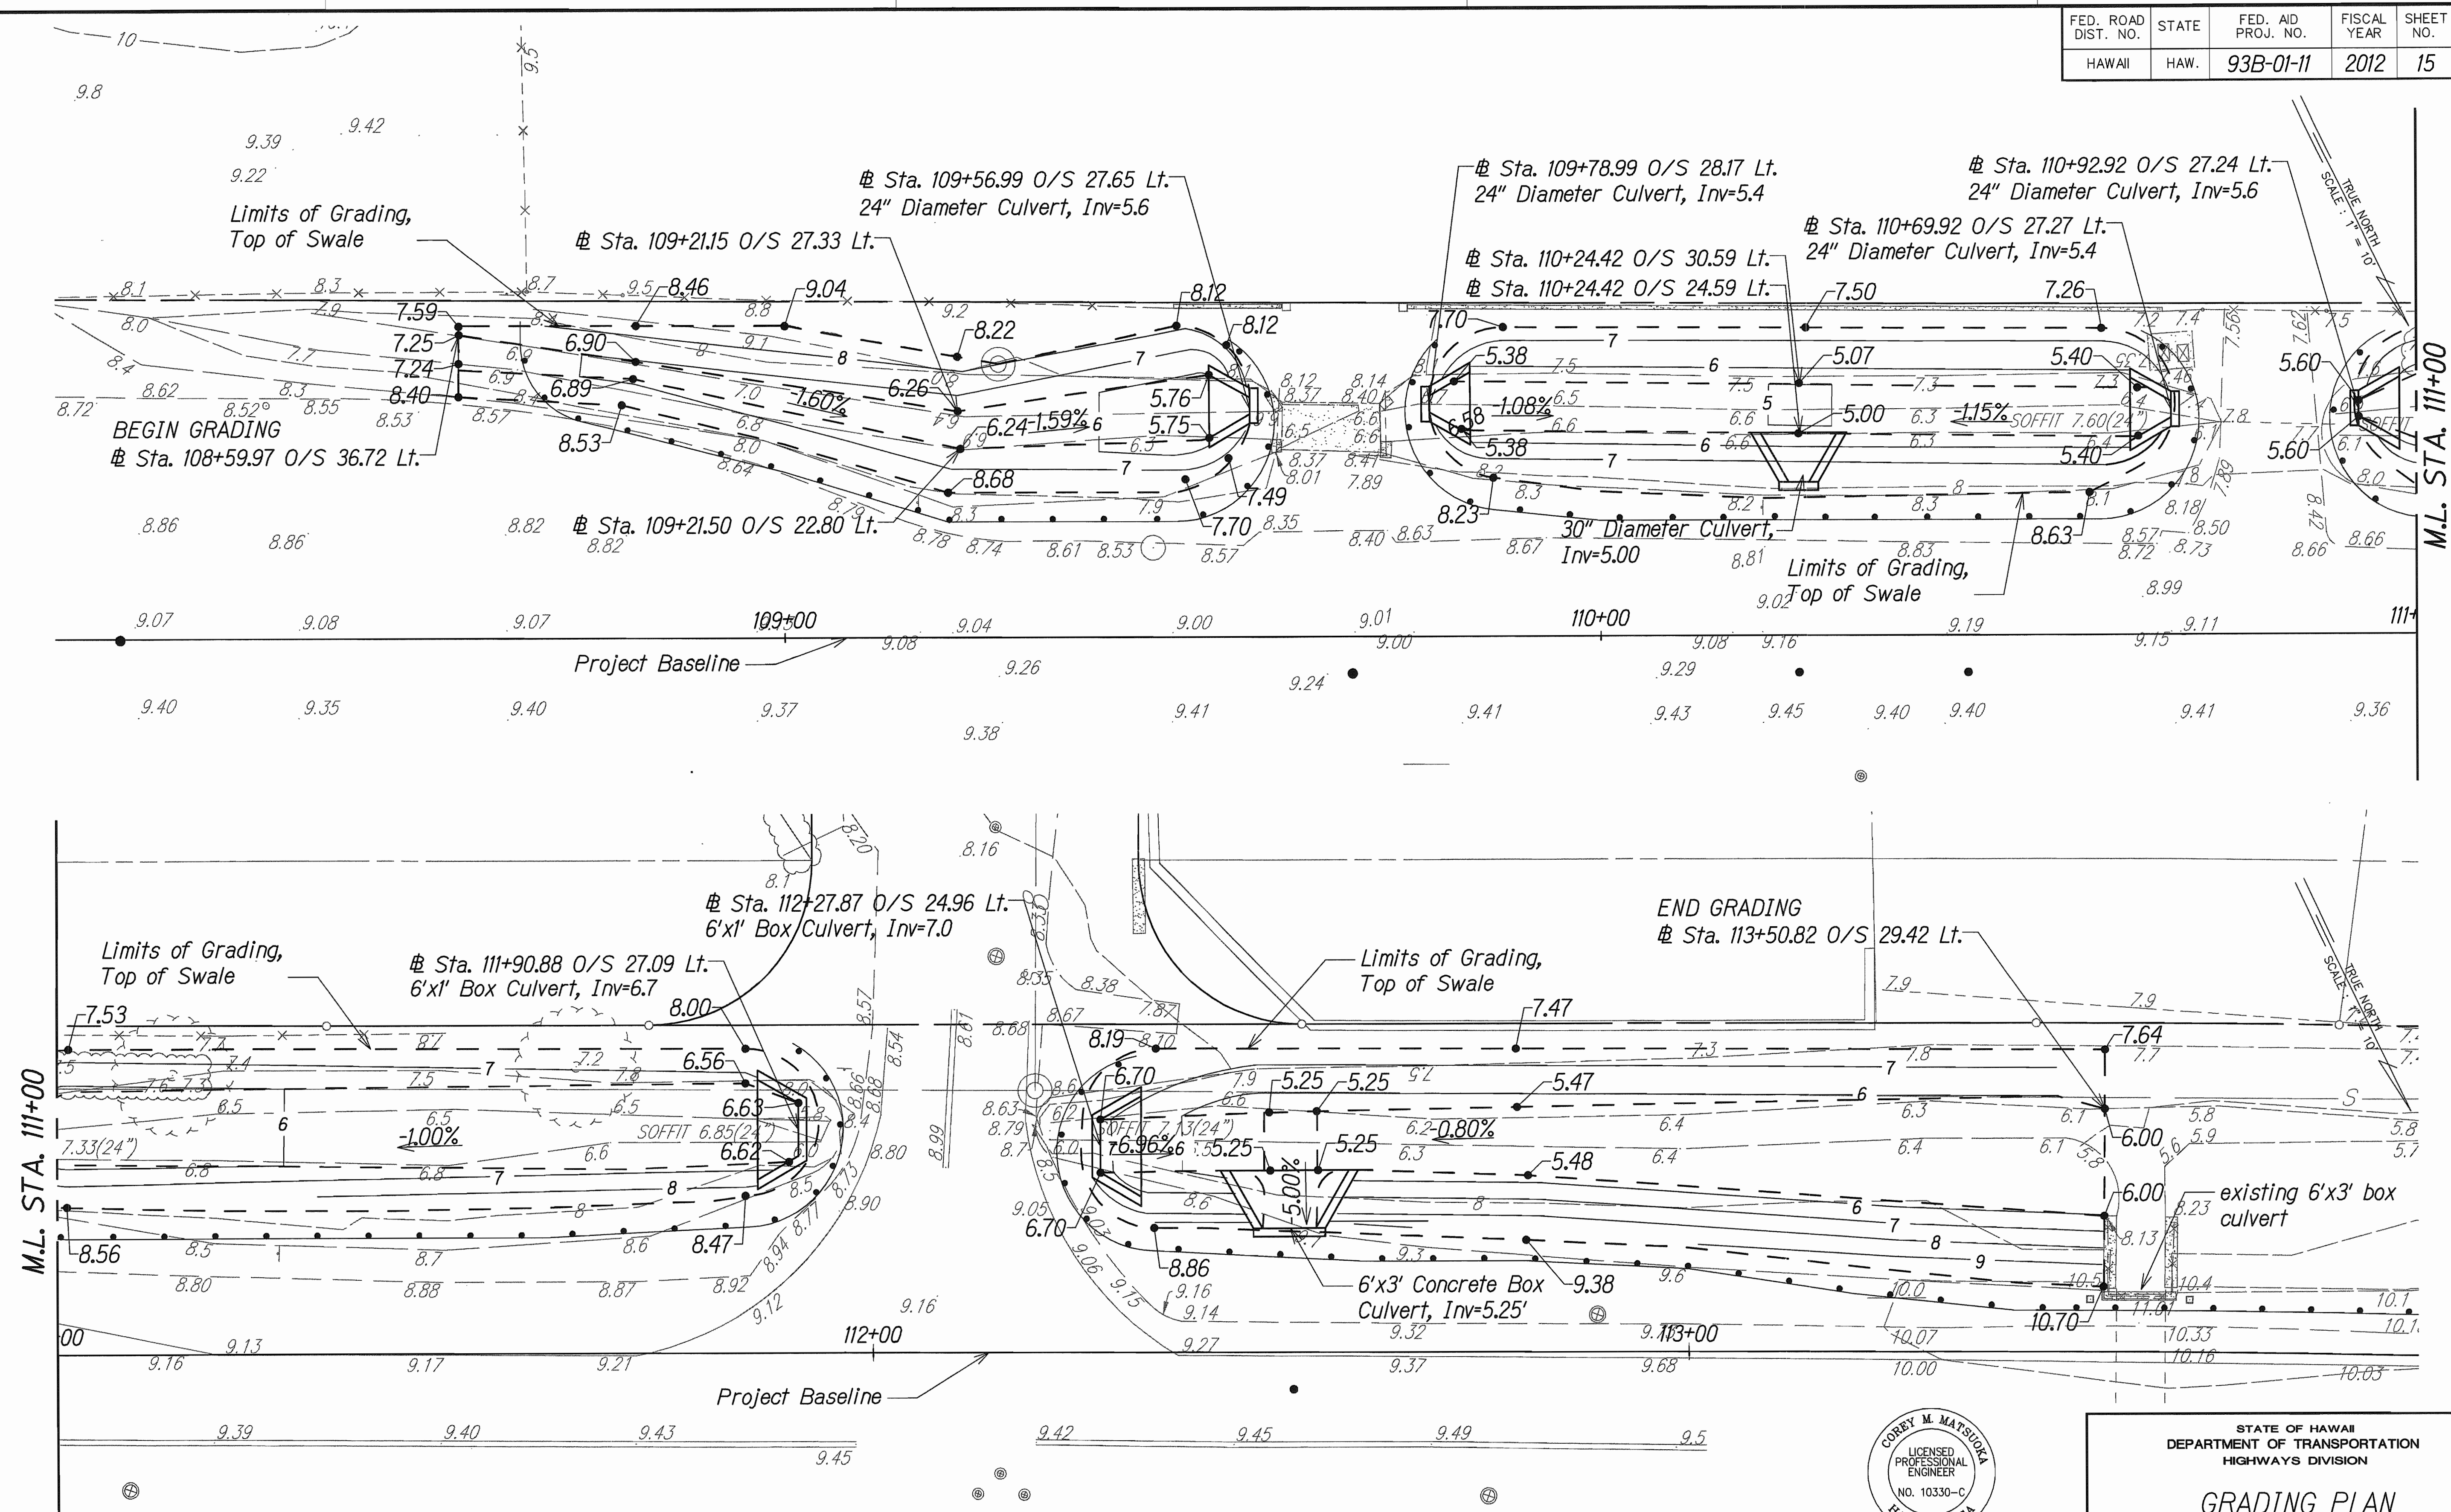

THIS WORK WAS PREPARED BY ME
OR UNDER MY SUPERVISION

Corey Matsuda
SIGNATURE

4/30/12
EXPIRATION
DATE OF THE
LICENSE

STATE OF HAWAII
DEPARTMENT OF TRANSPORTATION
HIGHWAYS DIVISION

GRADING PLAN

FARRINGTON HIGHWAY DRAINAGE IMPROVEMENTS
Vicinity of Orange St.
Project No. 93B-01-11

Scale: 1" = 10' Date: FEB 2012

SHEET No. 1 OF 1 SHEETS