




FED. ROAD DIST. NO.	STATE	FED. AID PROJ. NO.	FISCAL YEAR	SHEET NO.	TOTAL SHEETS
HAWAII	HAW.	93B-01-11	2012	36	38

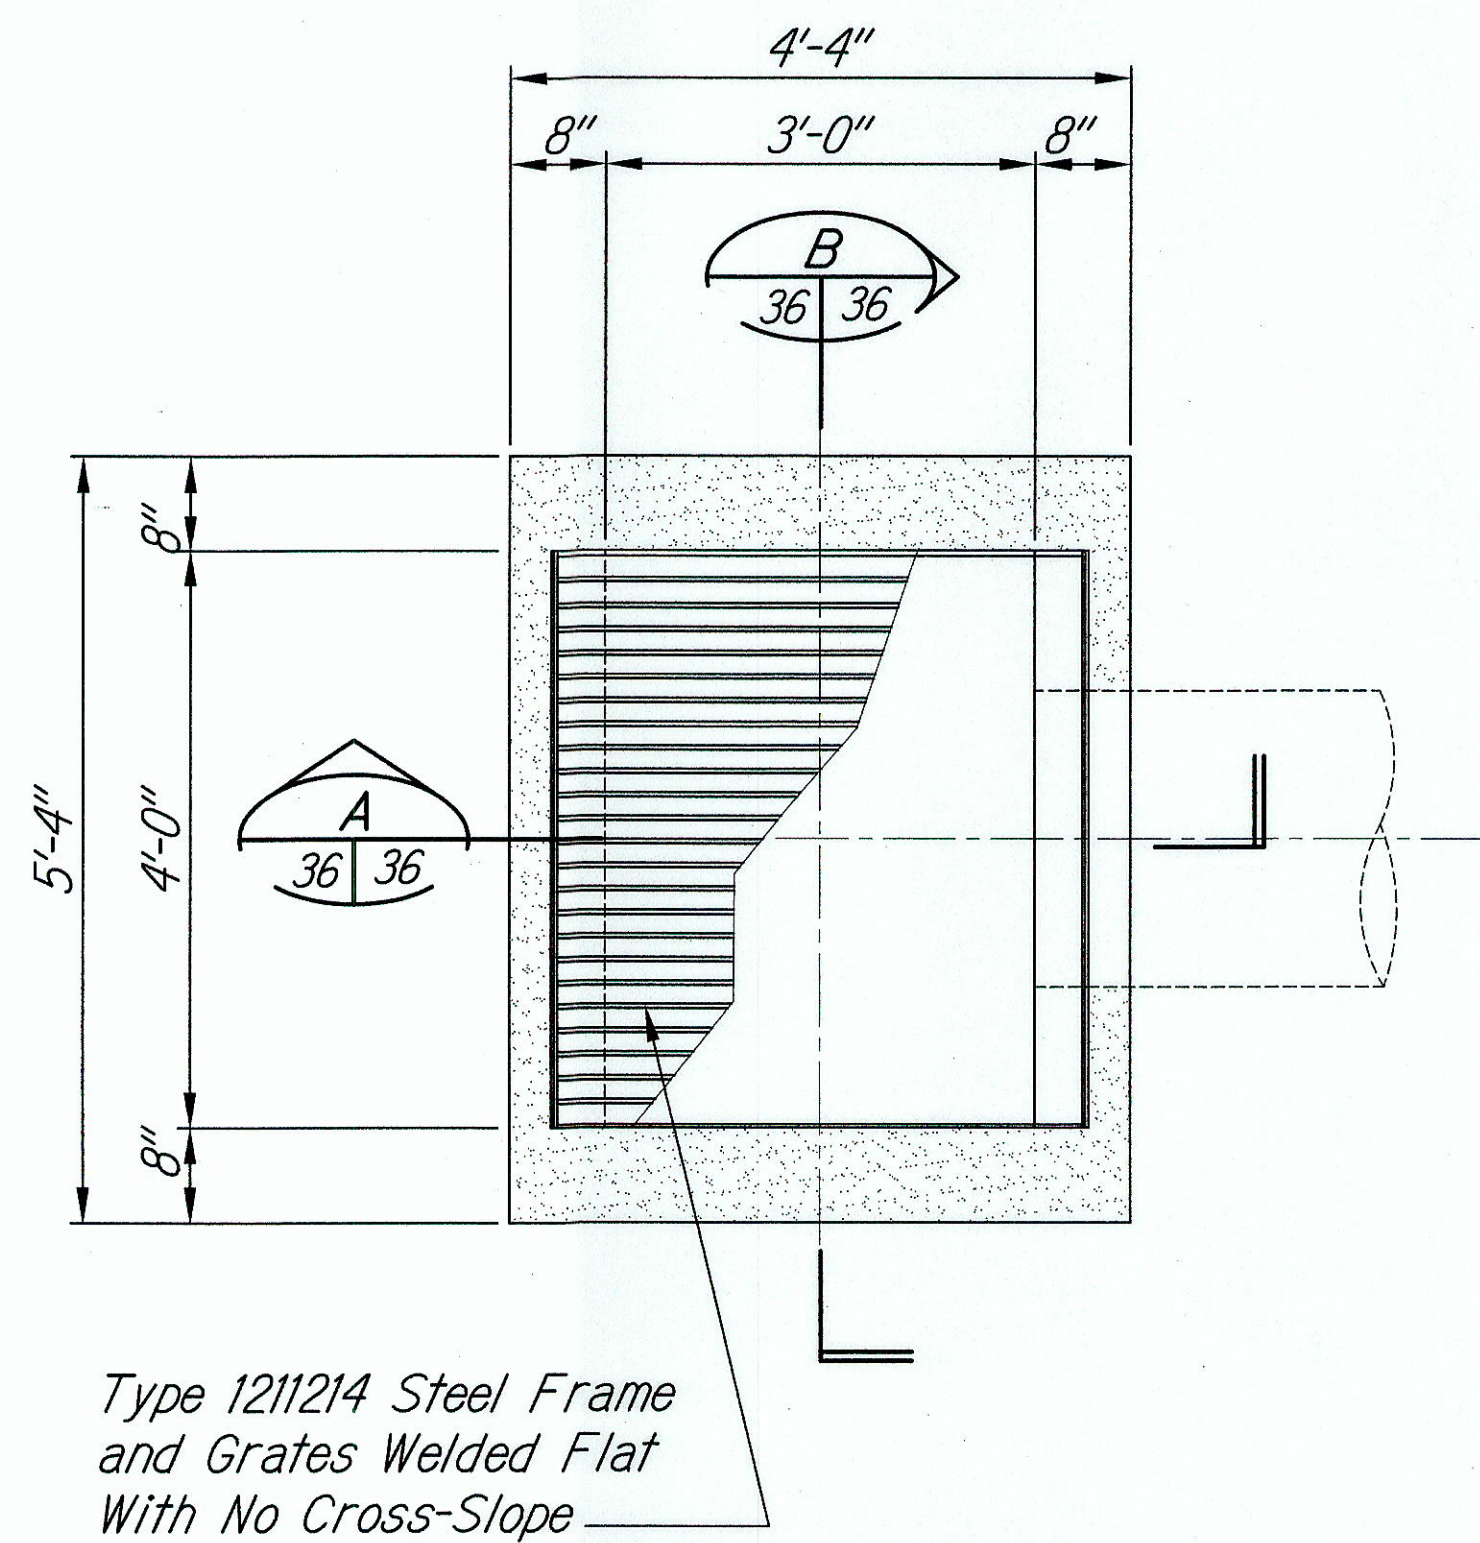


PLAN
Scale: 3/4" = 1'-0"

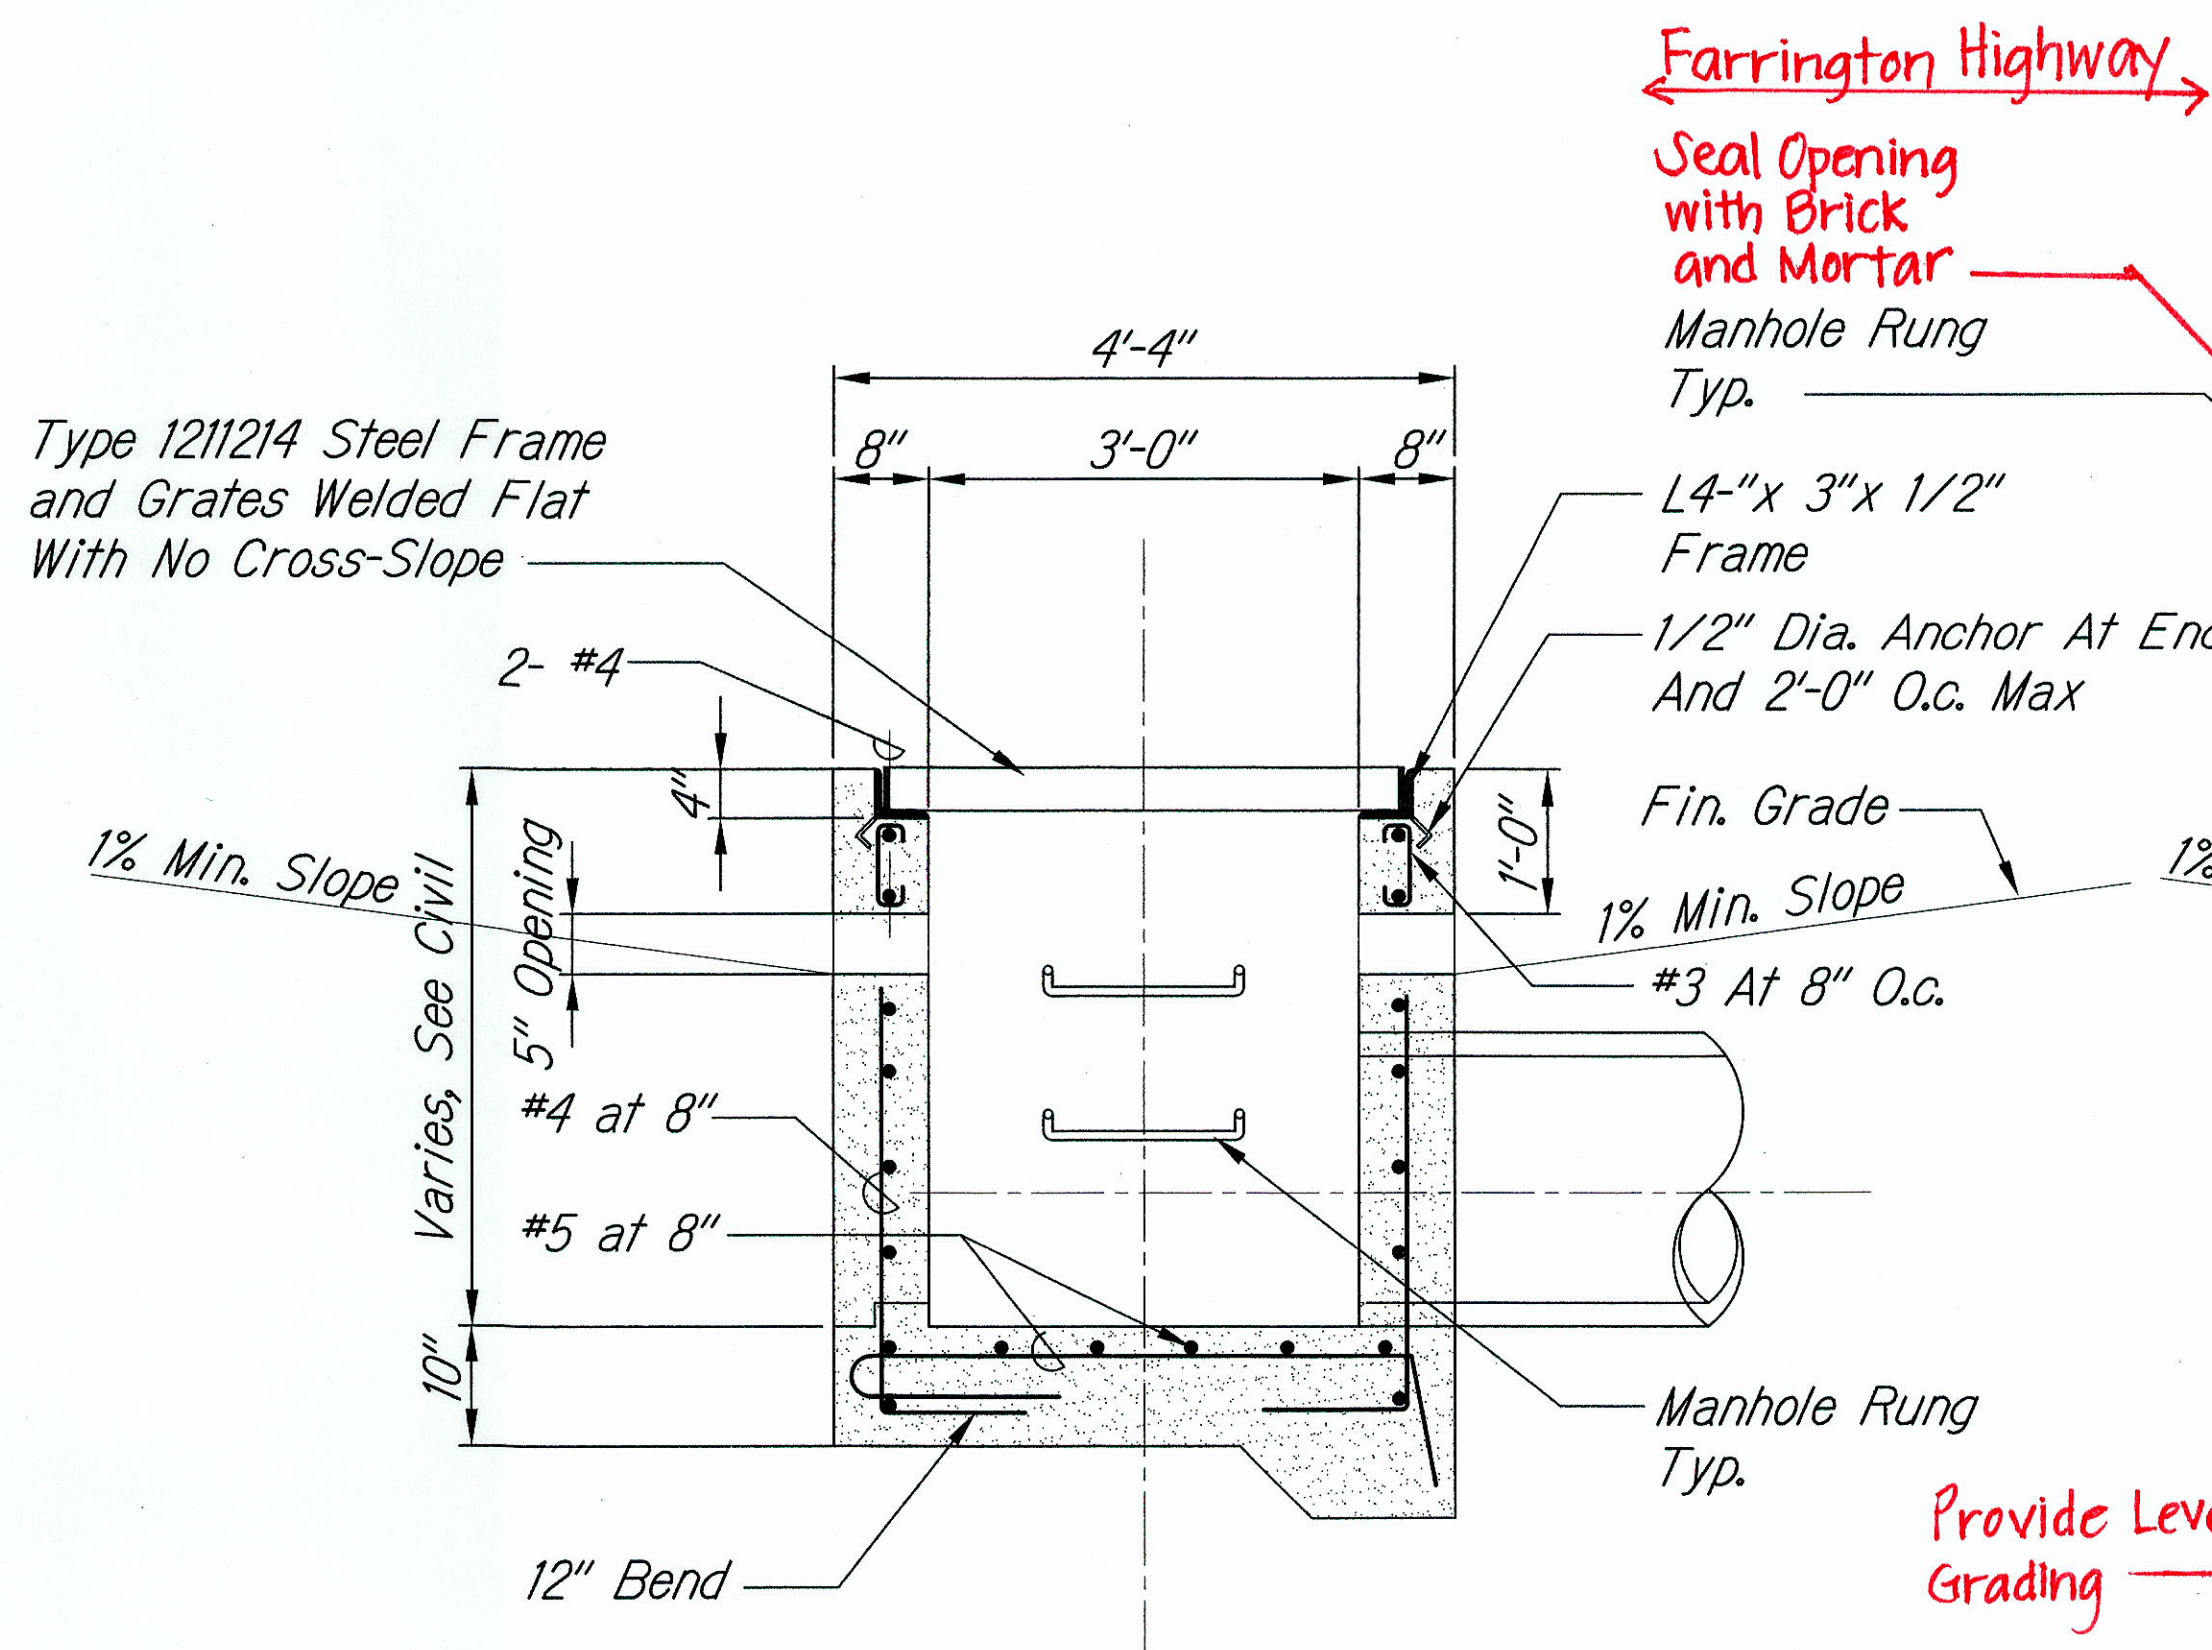


SECTION
Scale: 3/4" = 1'-0"

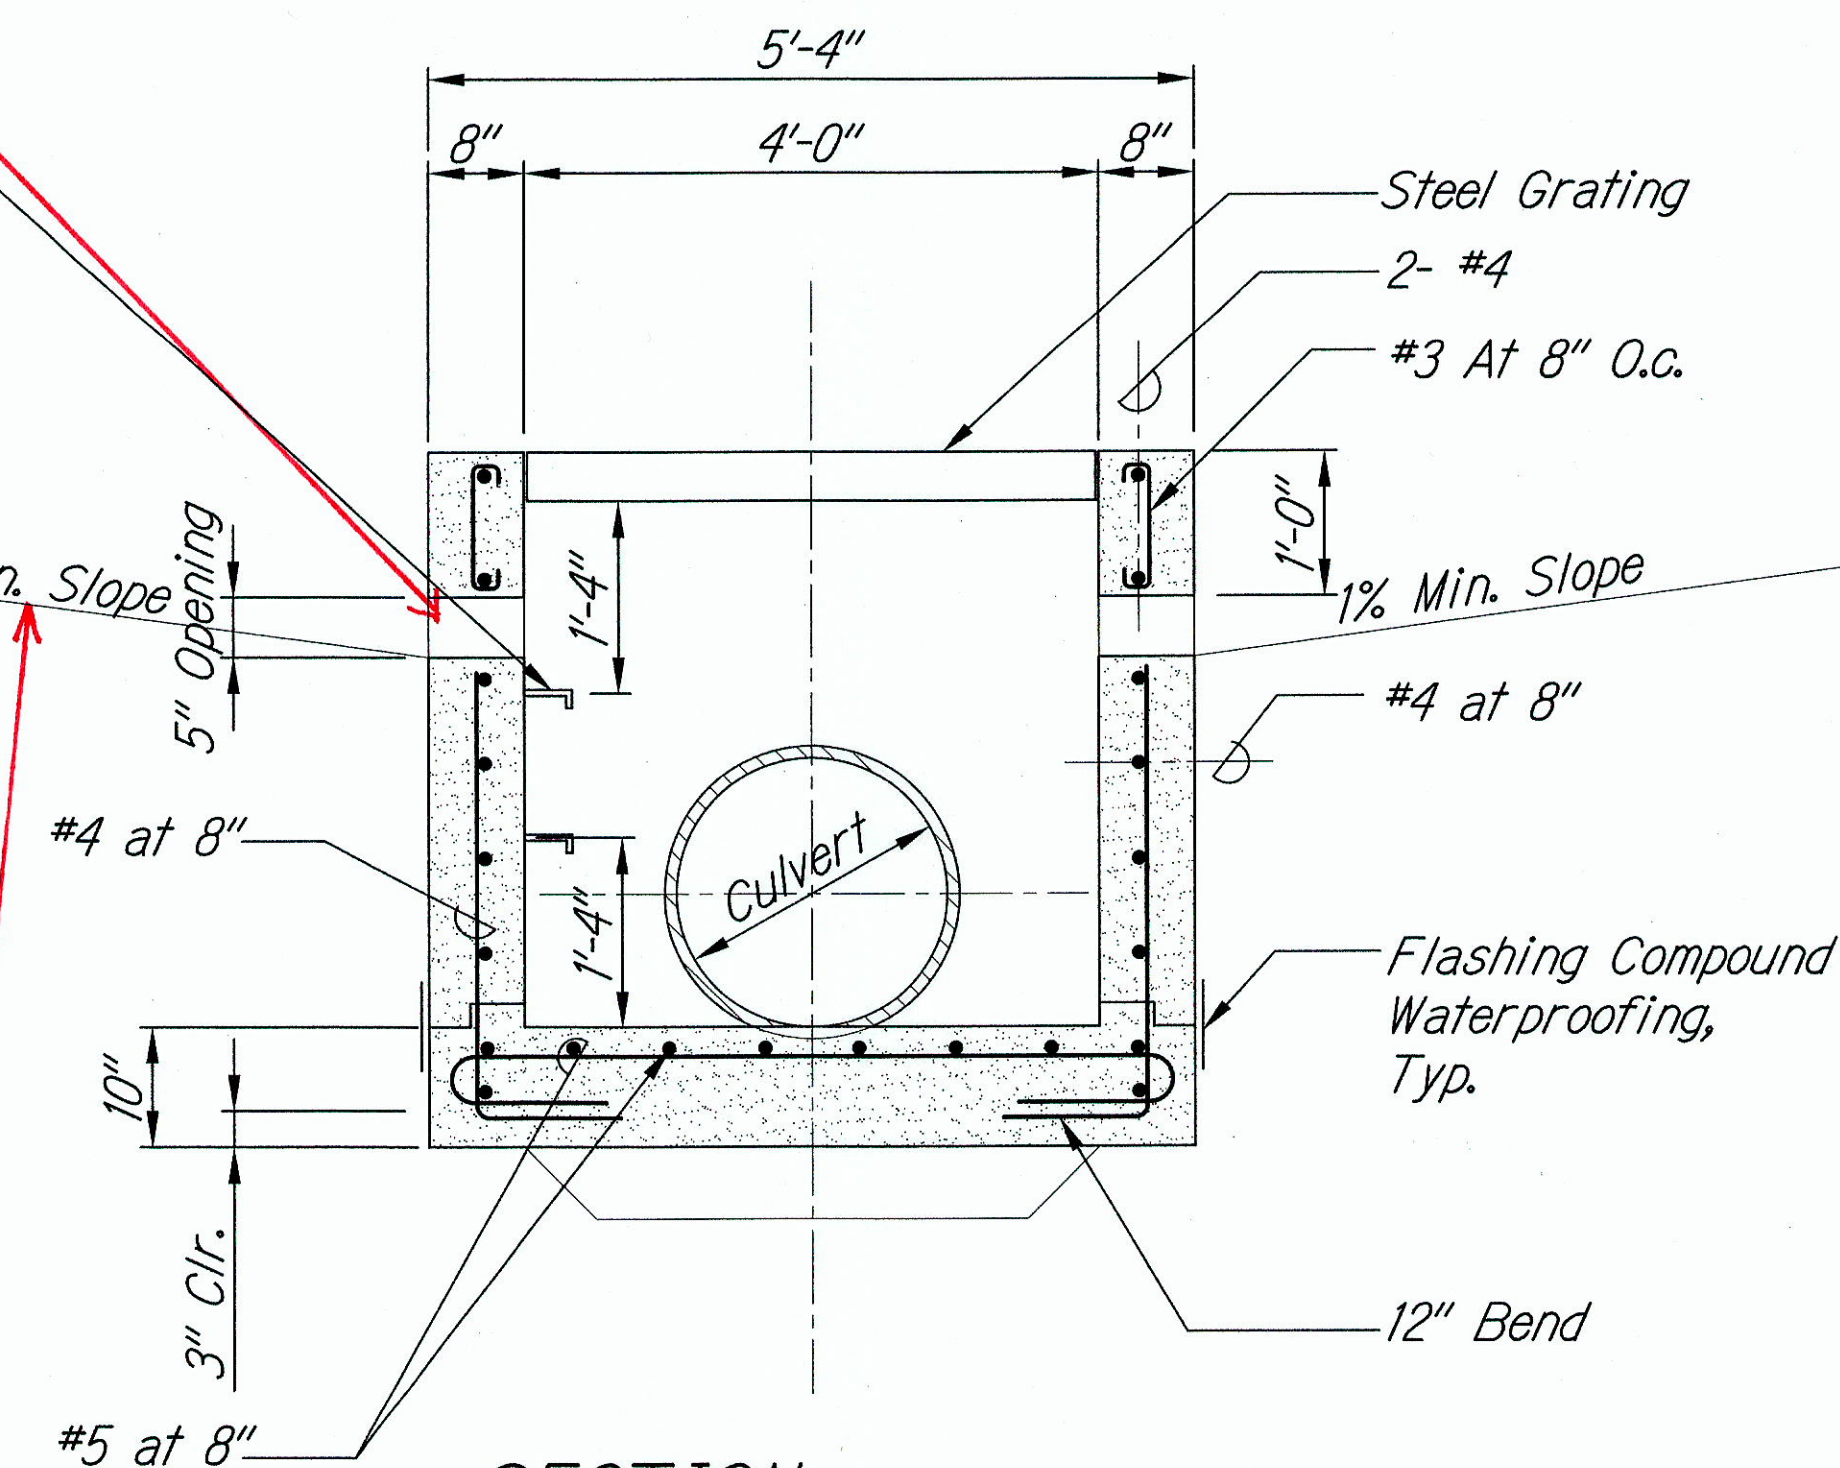

SECTION
Scale: 3/4" = 1'-0"

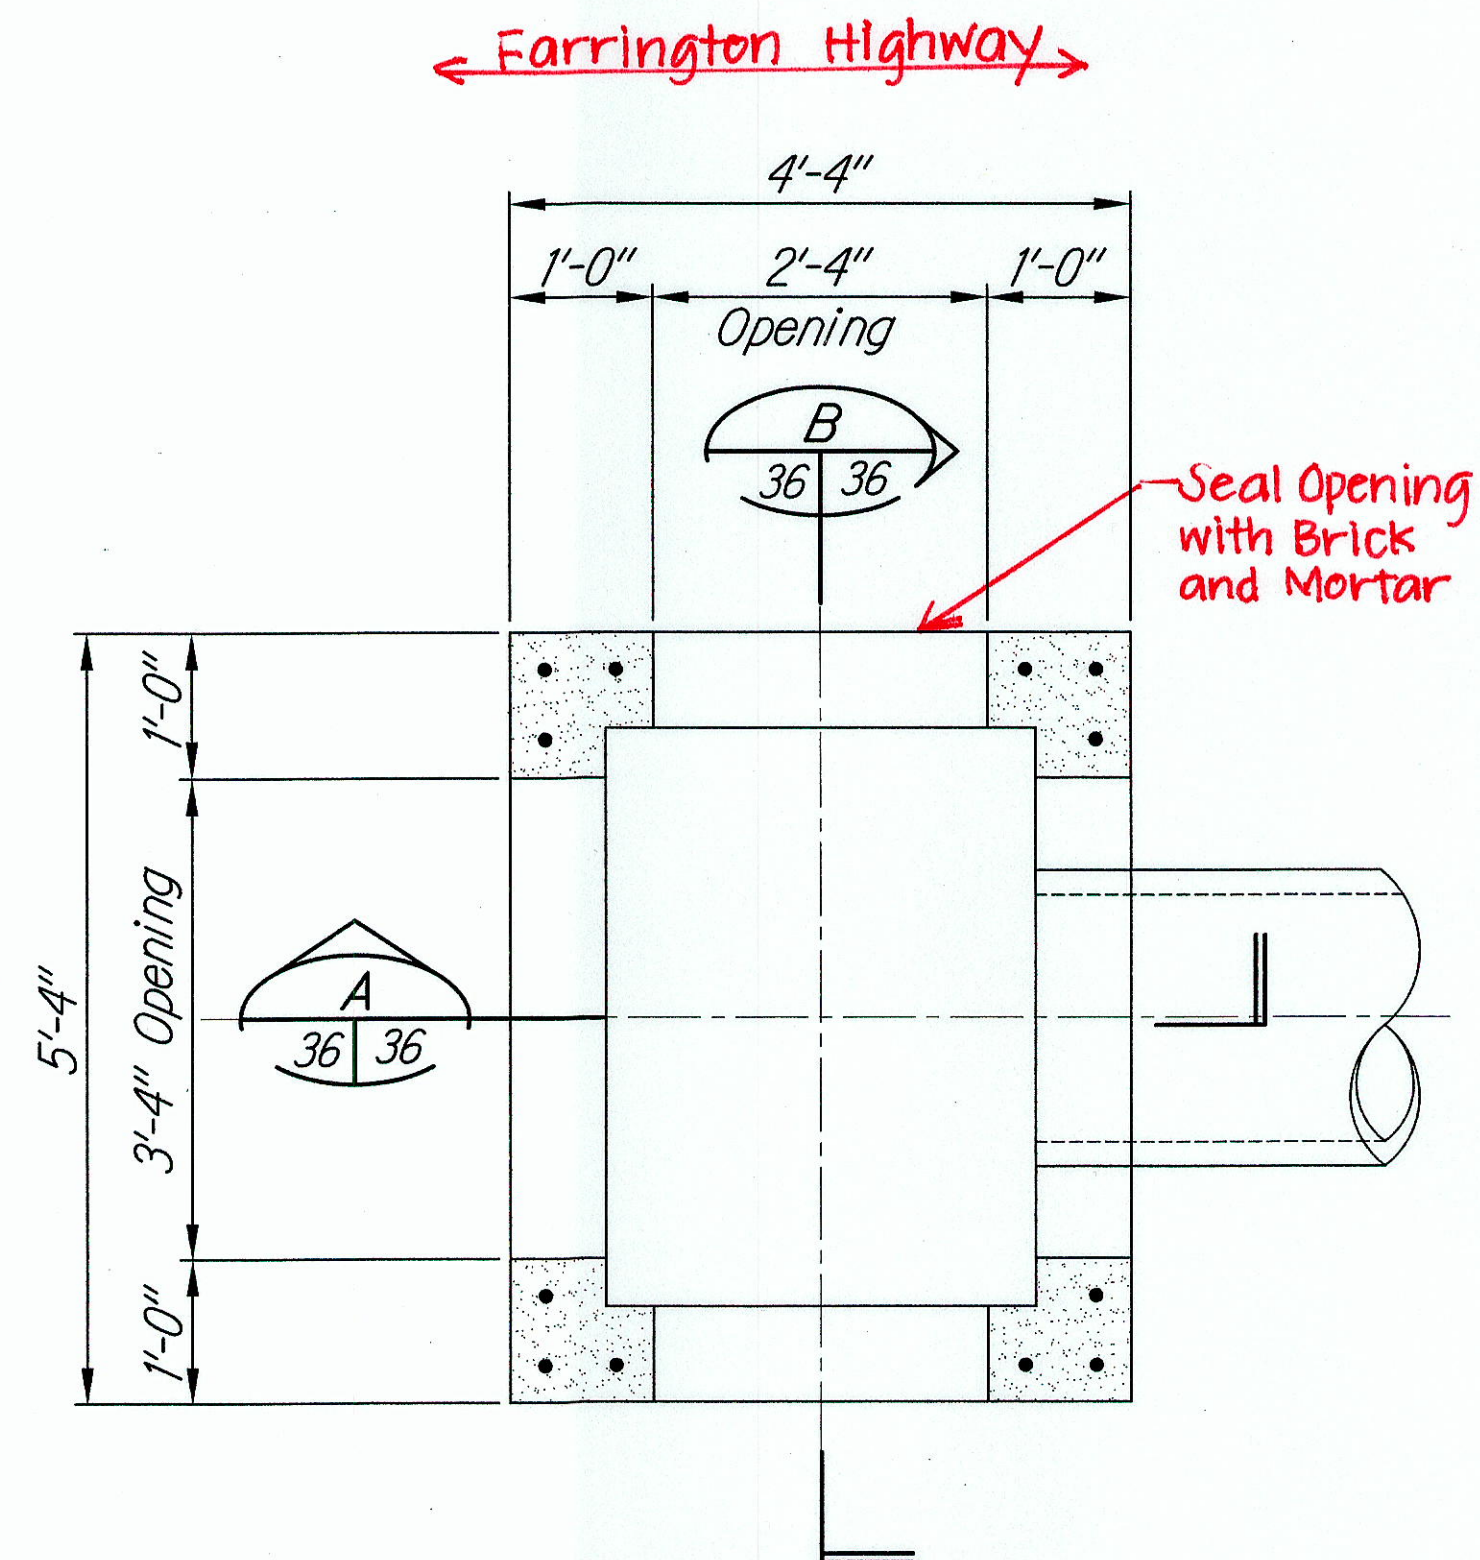


PLAN AT WALL WALL OPENING
Scale: 3/4" = 1'-0"

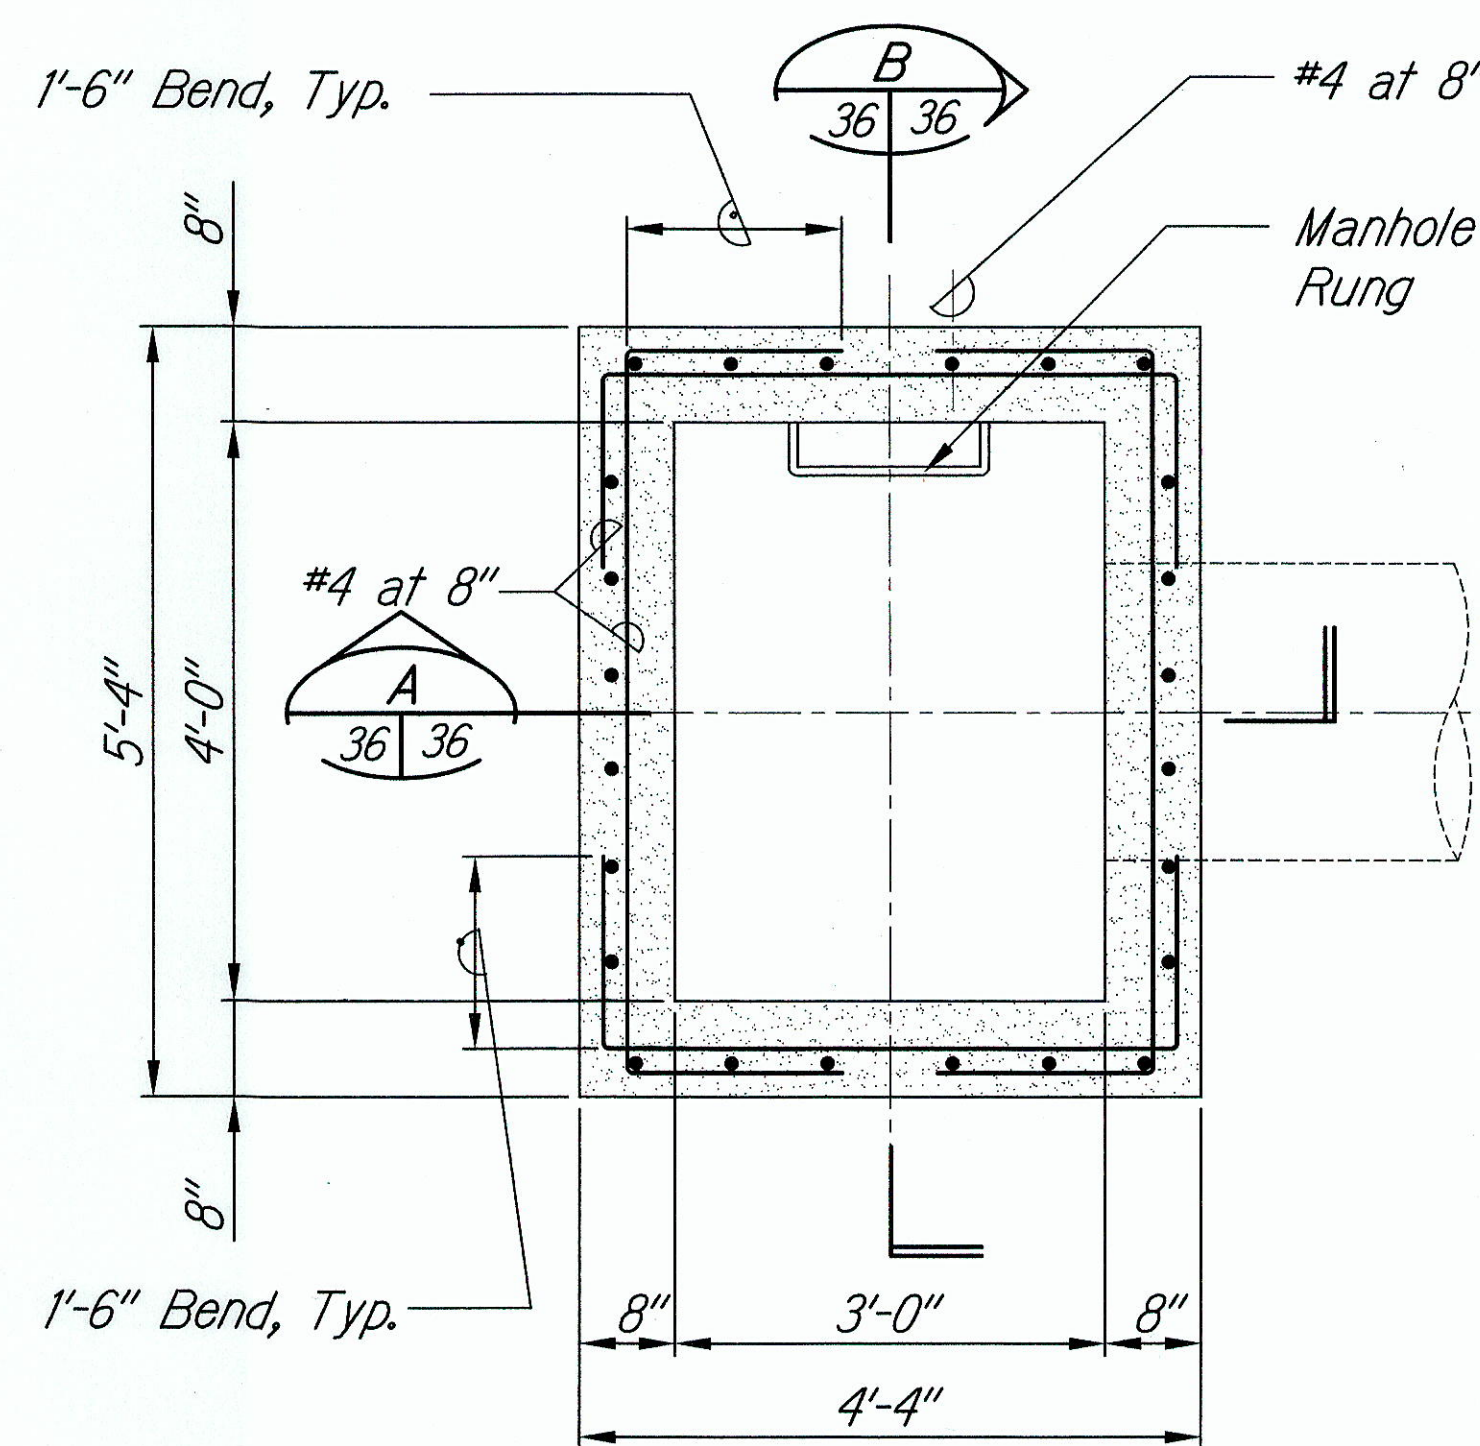

PLAN AT WALL REINFORCING
Scale: 3/4" = 1'-0"

ORIGINAL PLAN	DATE
DRAWN BY	
DESIGNED BY	
QUANTITIES BY	
CHECKED BY	

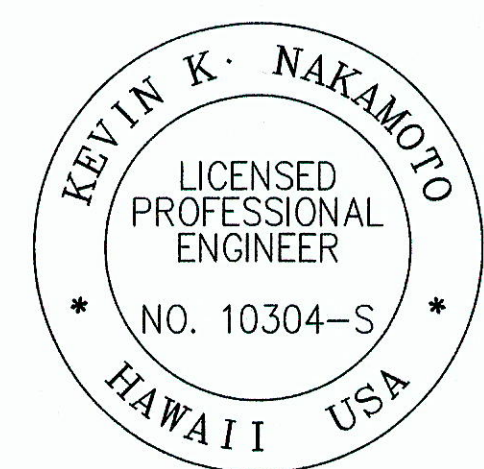

THIS WORK WAS PREPARED BY ME OR UNDER MY SUPERVISION

[Signature]

EXPIRATION DATE OF THE LICENSE

STATE OF HAWAII
DEPARTMENT OF TRANSPORTATION
HIGHWAYS DIVISION
MODIFIED DRAIN INLET DETAILS
FARRINGTON HIGHWAY DRAINAGE IMPROVEMENTS
Vicinity of Orange St.
Project No. 93B-01-11
Scale: AS SHOWN Date: FEB 2012
SHEET No. 1 OF 1 SHEETS

"AS-BUILT"