
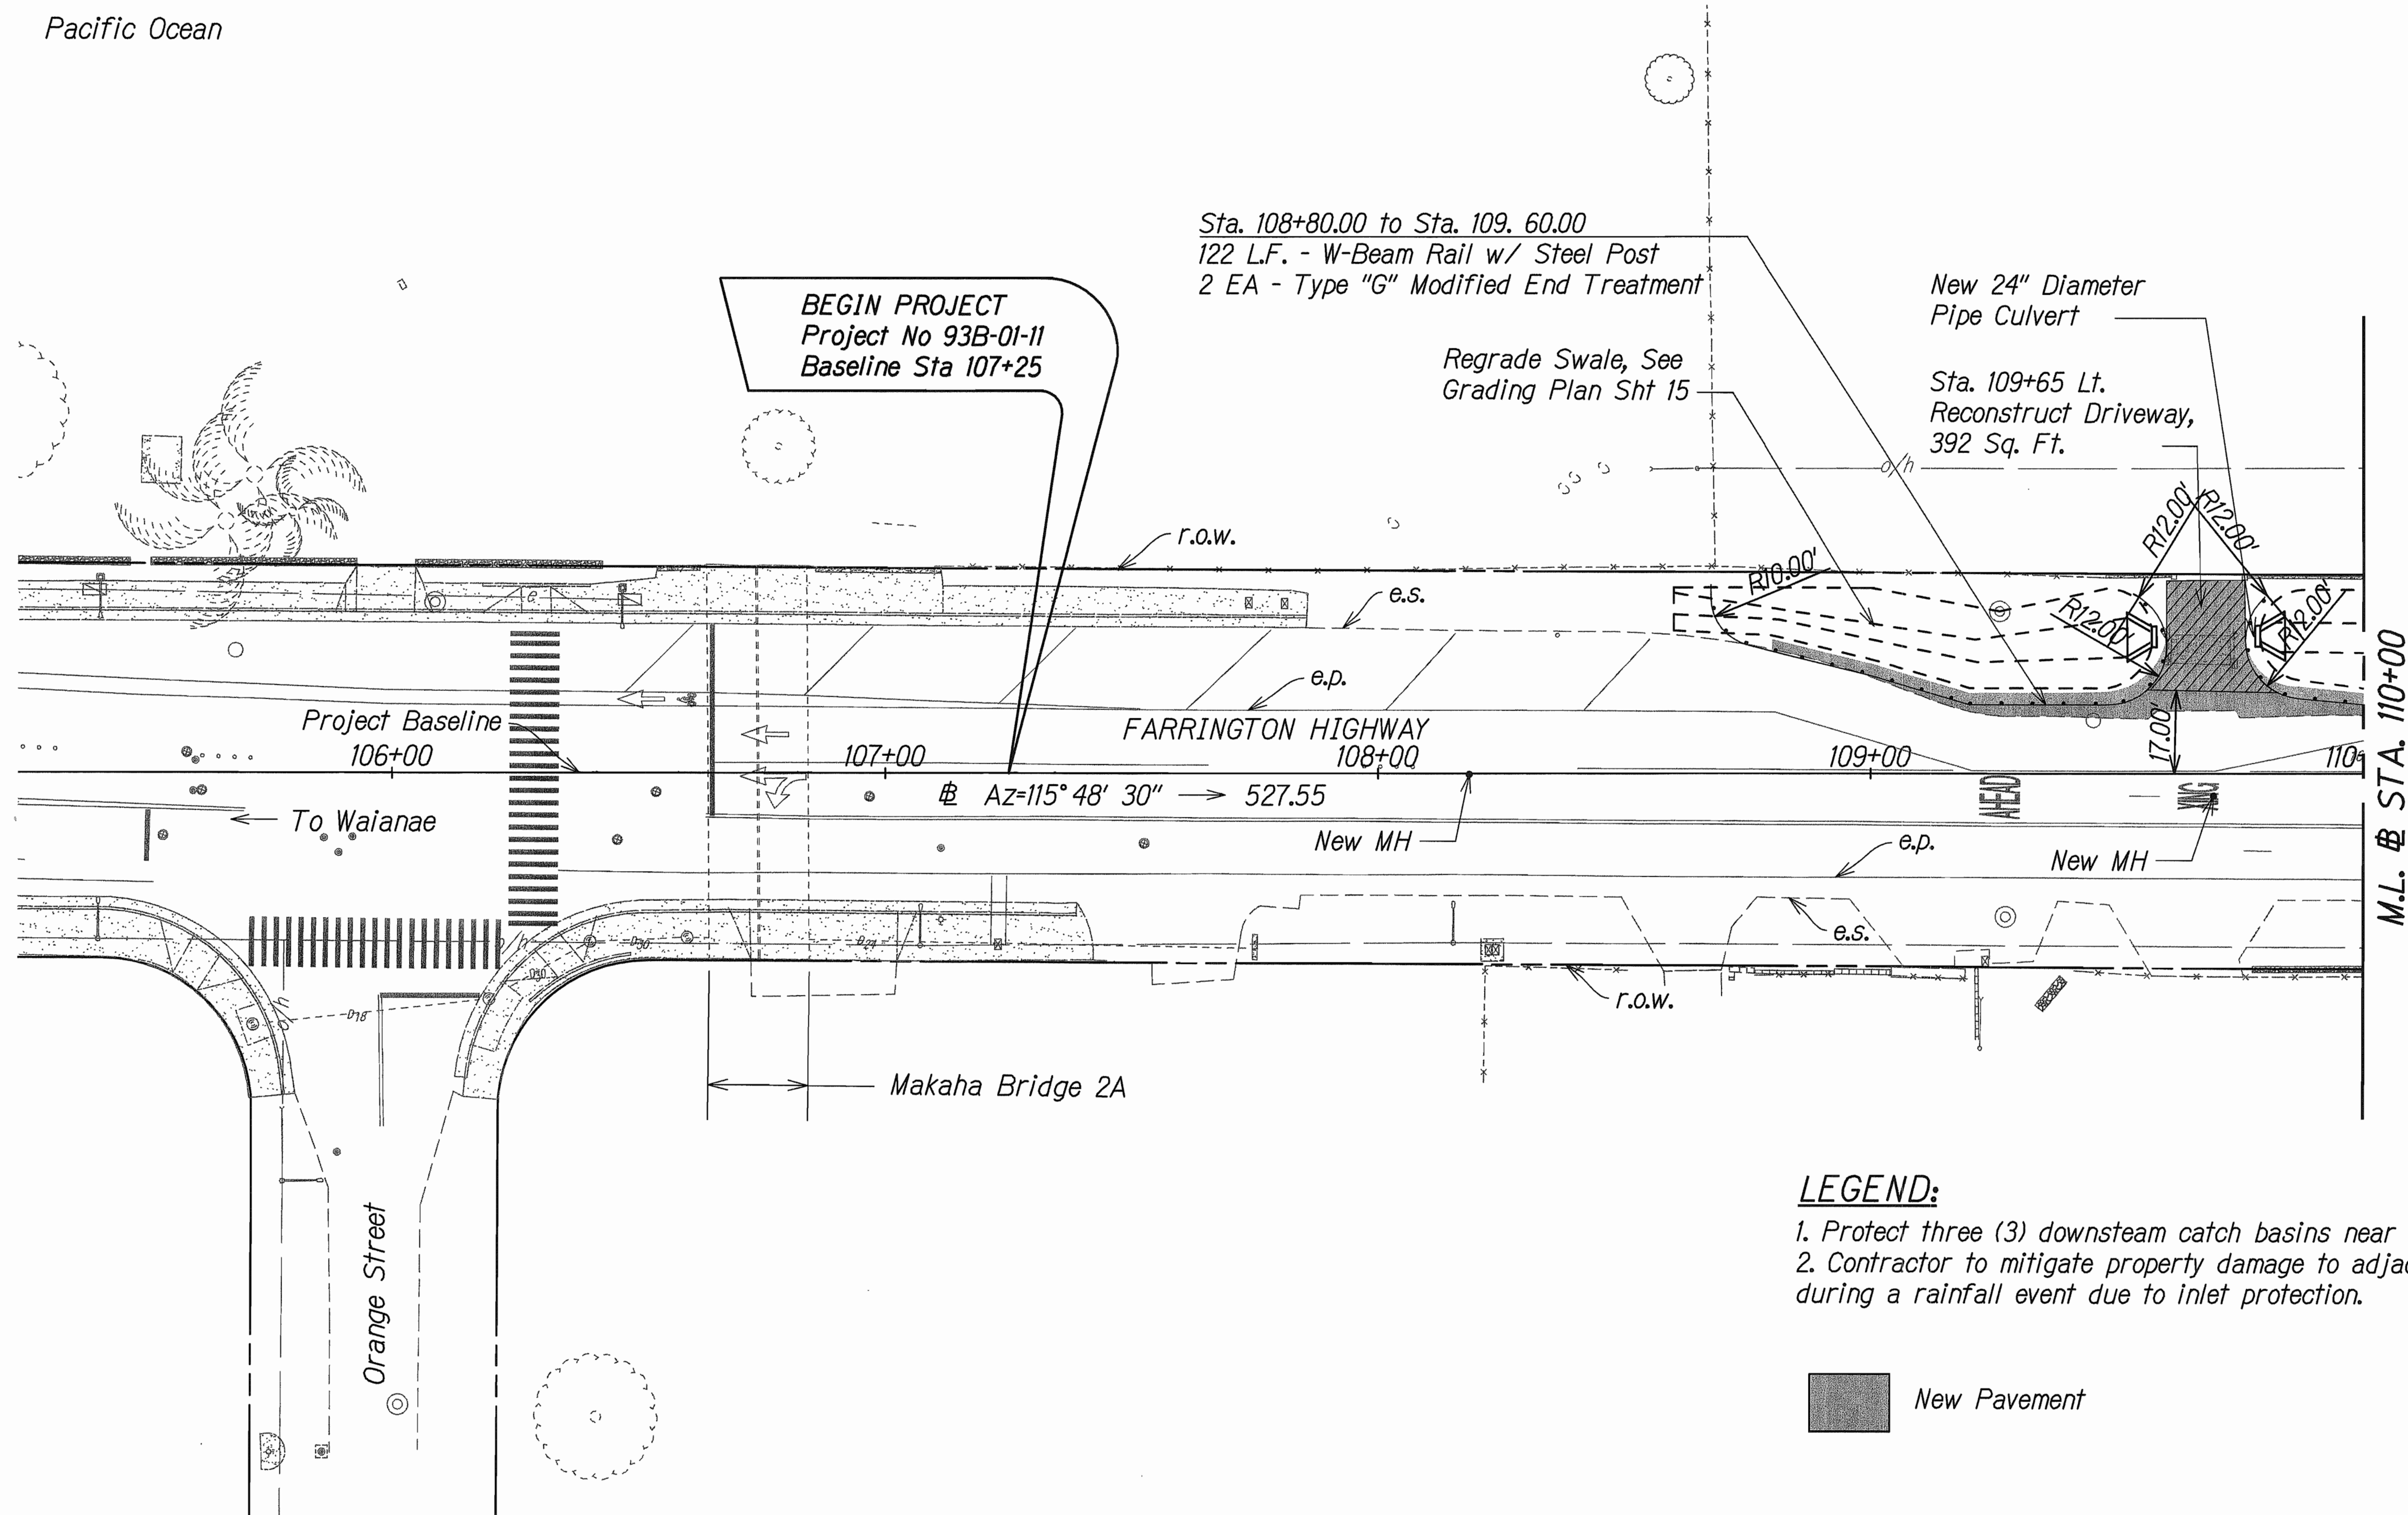



FED. ROAD DIST. NO.	STATE	FED. AID PROJ. NO.	FISCAL YEAR	SHEET NO.	TOTAL SHEETS
HAWAII	HAW.	93B-01-11	2012	13	38

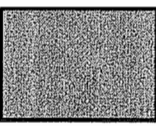

LEGEND:

1. Protect three (3) downstream catch basins near Orange Street.
2. Contractor to mitigate property damage to adjacent property during a rainfall event due to inlet protection.

 New Pavement

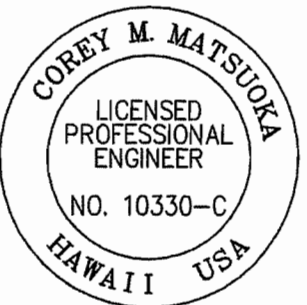

THIS WORK WAS PREPARED BY ME
OR UNDER MY SUPERVISION

Corey Matsuda
SIGNATURE

4/30/12

EXPIRATION
DATE OF THE
LICENSE


STATE OF HAWAII
DEPARTMENT OF TRANSPORTATION
HIGHWAYS DIVISION

ROADWAY PLAN

FARRINGTON HIGHWAY DRAINAGE IMPROVEMENTS
Vicinity of Orange St.
Project No. 93B-01-11
Scale: 1" = 20' Date: FEB 2012

SHEET No. 1 OF 2 SHEETS

FED. ROAD DIST. NO.	STATE	FED. AID PROJ. NO.	FISCAL YEAR	SHEET NO.	TOTAL SHEETS
HAWAII	HAW.	93B-01-11	2012	14	38

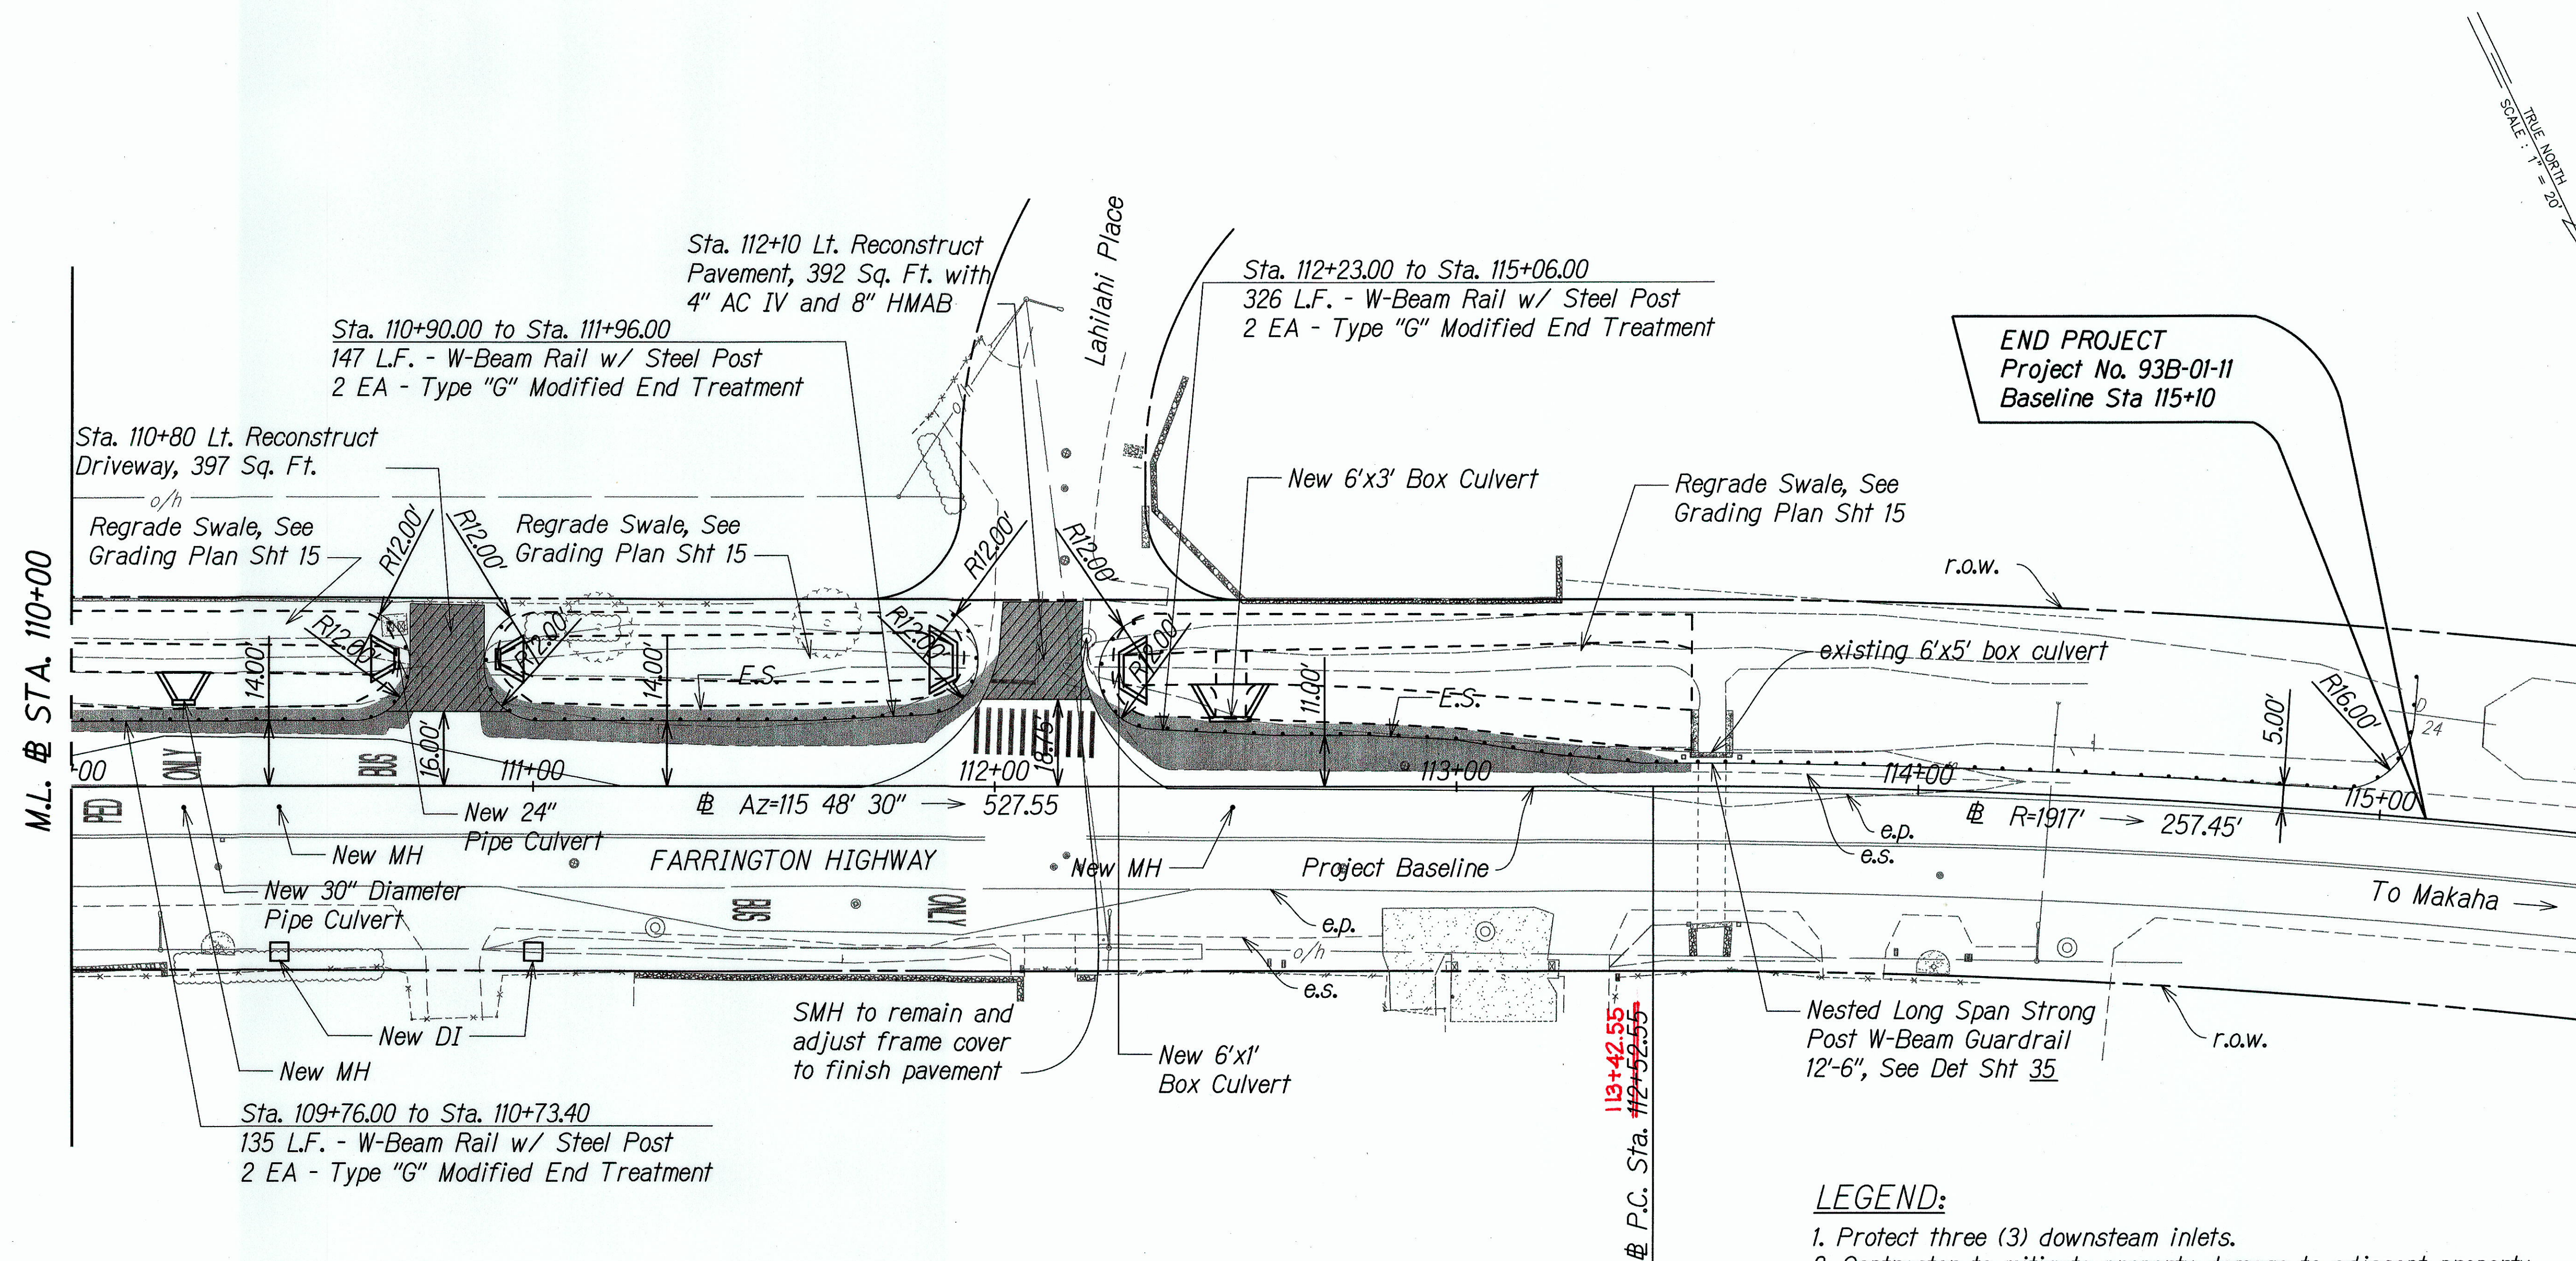

LEGEND:

1. Protect three (3) downstream inlets.
2. Contractor to mitigate property damage to adjacent property during a rainfall event due to inlet protection.

 New Pavement



THIS WORK WAS PREPARED BY ME
OR UNDER MY SUPERVISION

Corey Matsuda
SIGNATURE

4/30/12
EXPIRATION
DATE OF THE
LICENSE

STATE OF HAWAII
DEPARTMENT OF TRANSPORTATION
HIGHWAYS DIVISION

ROADWAY PLAN

FARRINGTON HIGHWAY DRAINAGE IMPROVEMENTS

Vicinity of Orange St.

Project No. 93B-01-11

Scale: 1" = 20' Date: FEB 2012

SHEET No. 2 OF 2 SHEETS

"AS-BUILT"