
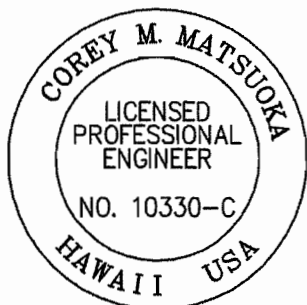


FED. ROAD DIST. NO.	STATE	FED. AID PROJ. NO.	FISCAL YEAR	SHEET NO.	TOTAL SHEETS
HAWAII	HAW.	93B-01-11	2012	24	38

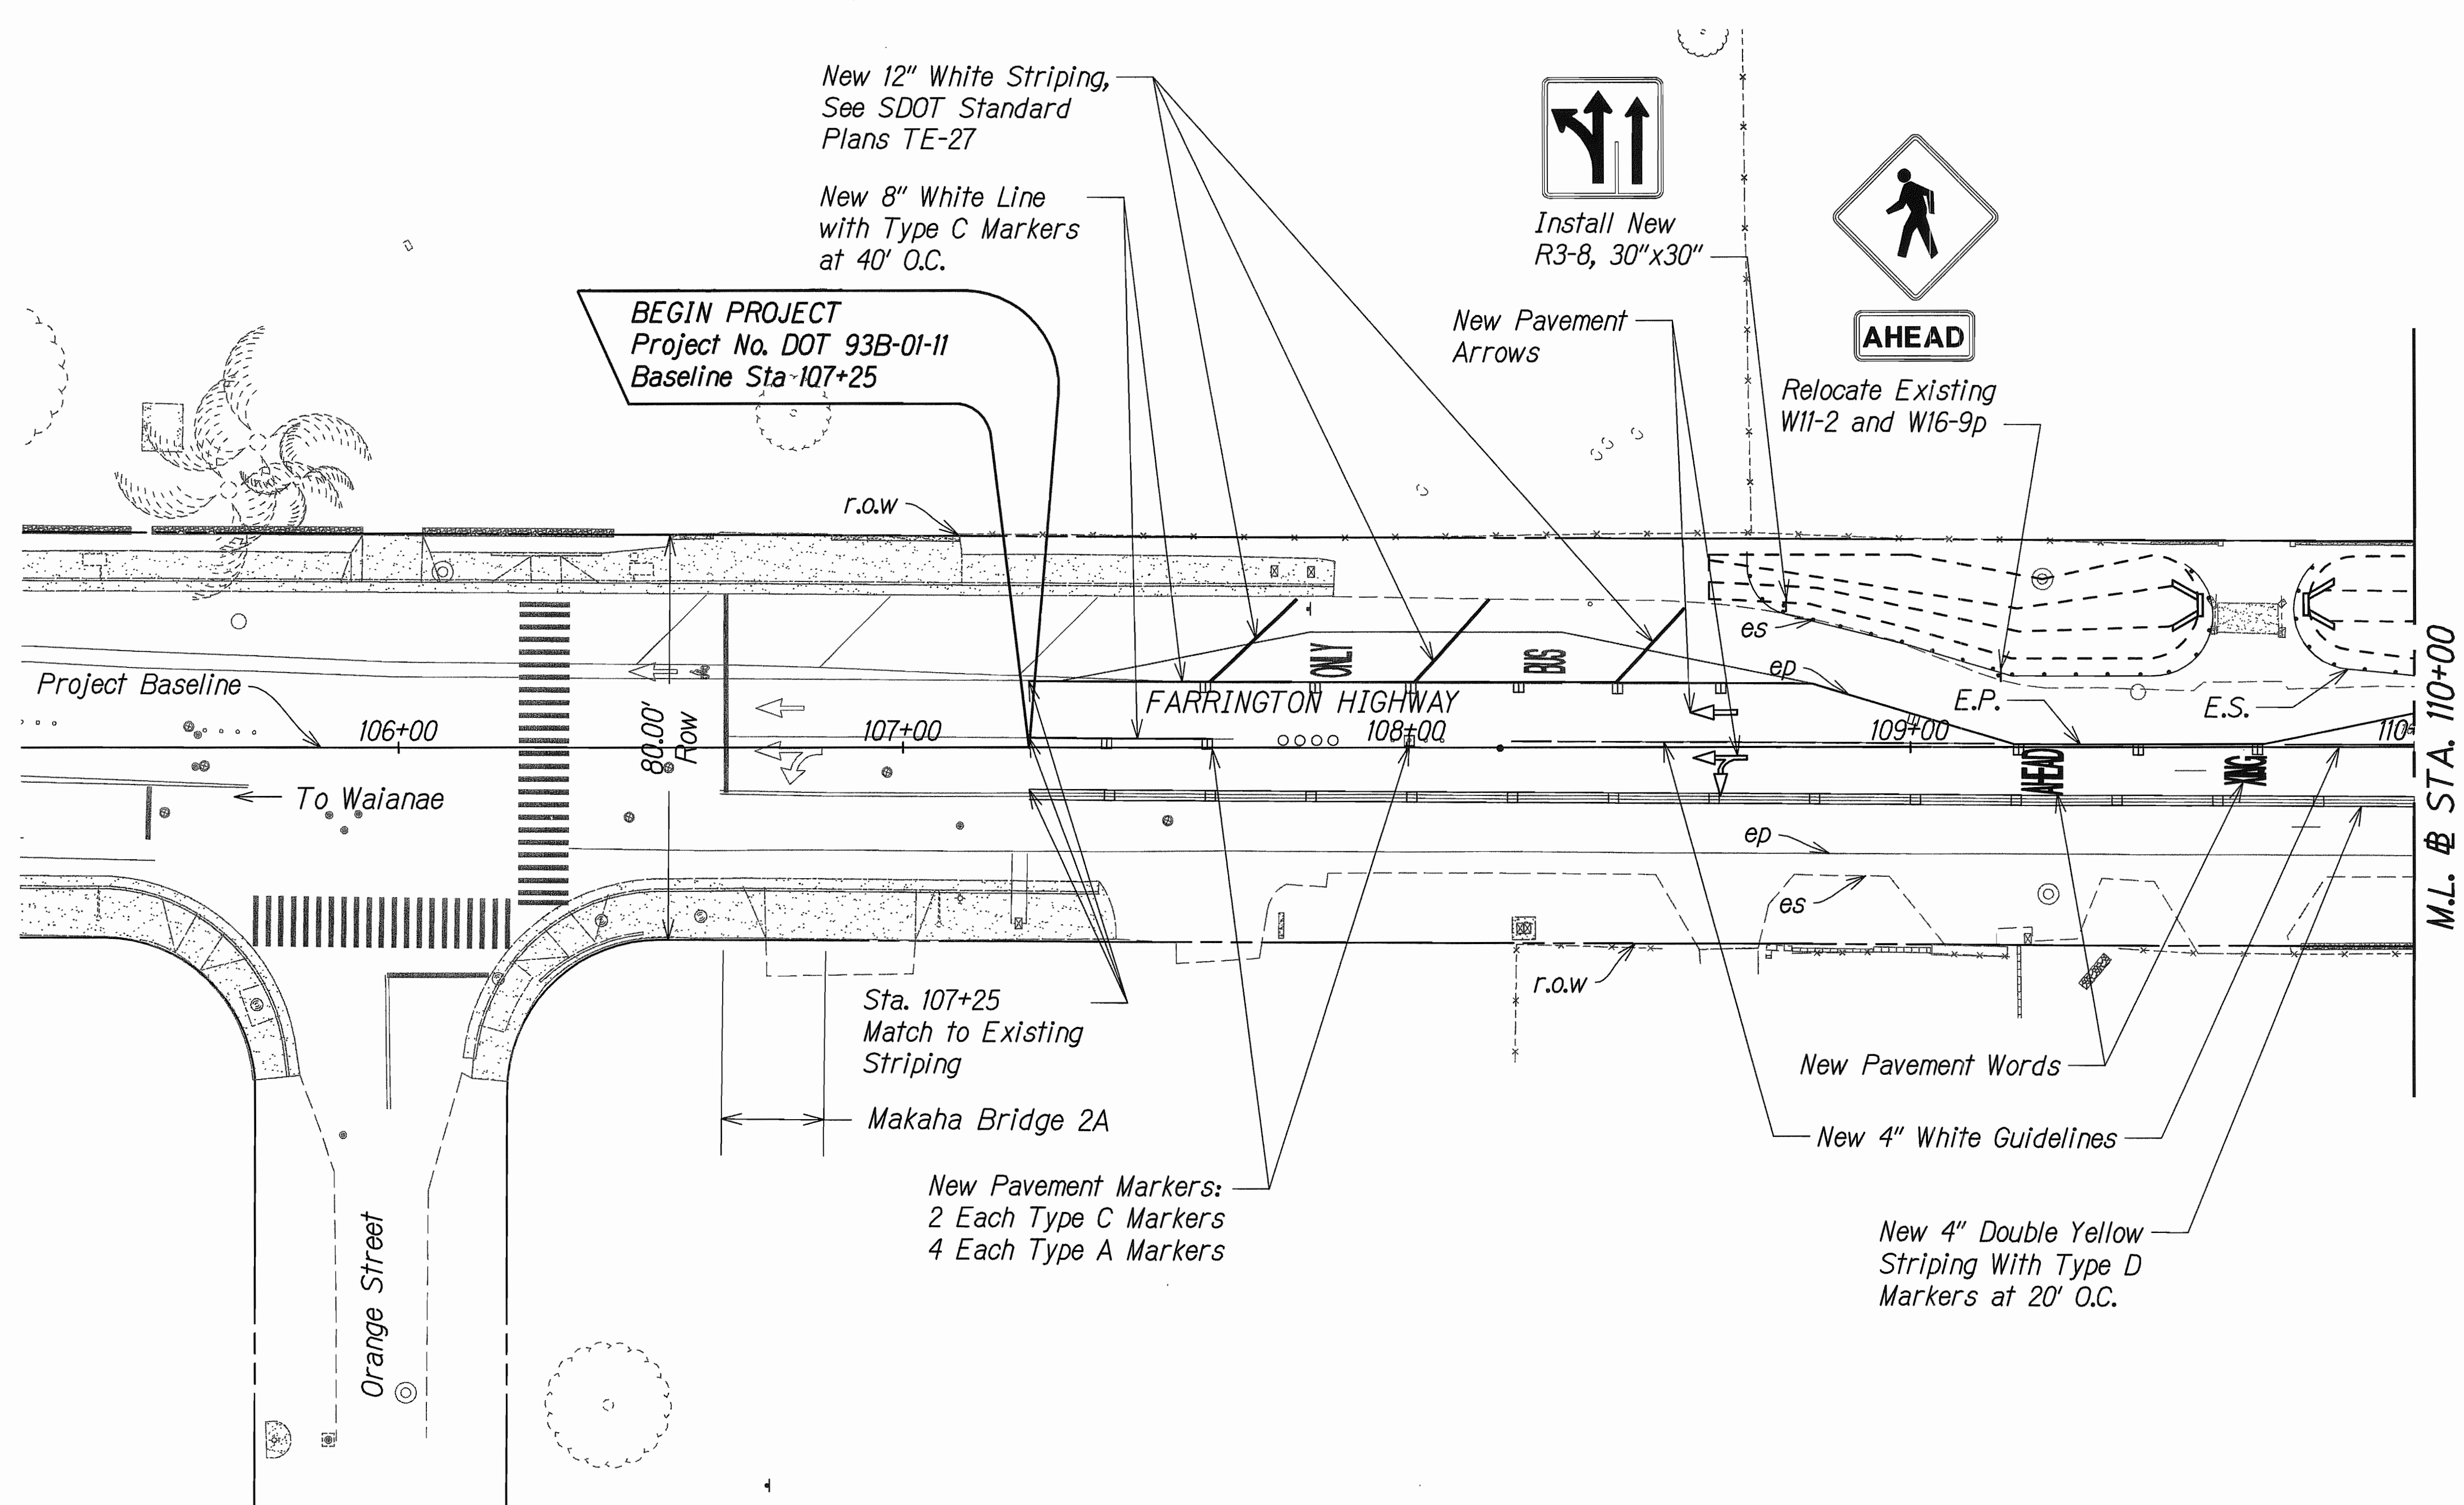

THIS WORK WAS PREPARED BY ME  
OR UNDER MY SUPERVISION

*Corey Matsuka*  
SIGNATURE

4/30/12  
EXPIRATION  
DATE OF THE  
LICENSE

STATE OF HAWAII  
DEPARTMENT OF TRANSPORTATION  
HIGHWAYS DIVISION


**STRIPING AND SIGNAGE PLAN**

FARRINGTON HIGHWAY DRAINAGE IMPROVEMENTS  
Vicinity of Orange St.  
Project No. 93B-01-11  
Scale: 1" = 20' Date: FEB 2012


SHEET No. 1 OF 2 SHEETS



FED. ROAD DIST. NO.	STATE	FED. AID PROJ. NO.	FISCAL YEAR	SHEET NO.	TOTAL SHEETS
HAWAII	HAW.	93B-01-11	2012	25	38

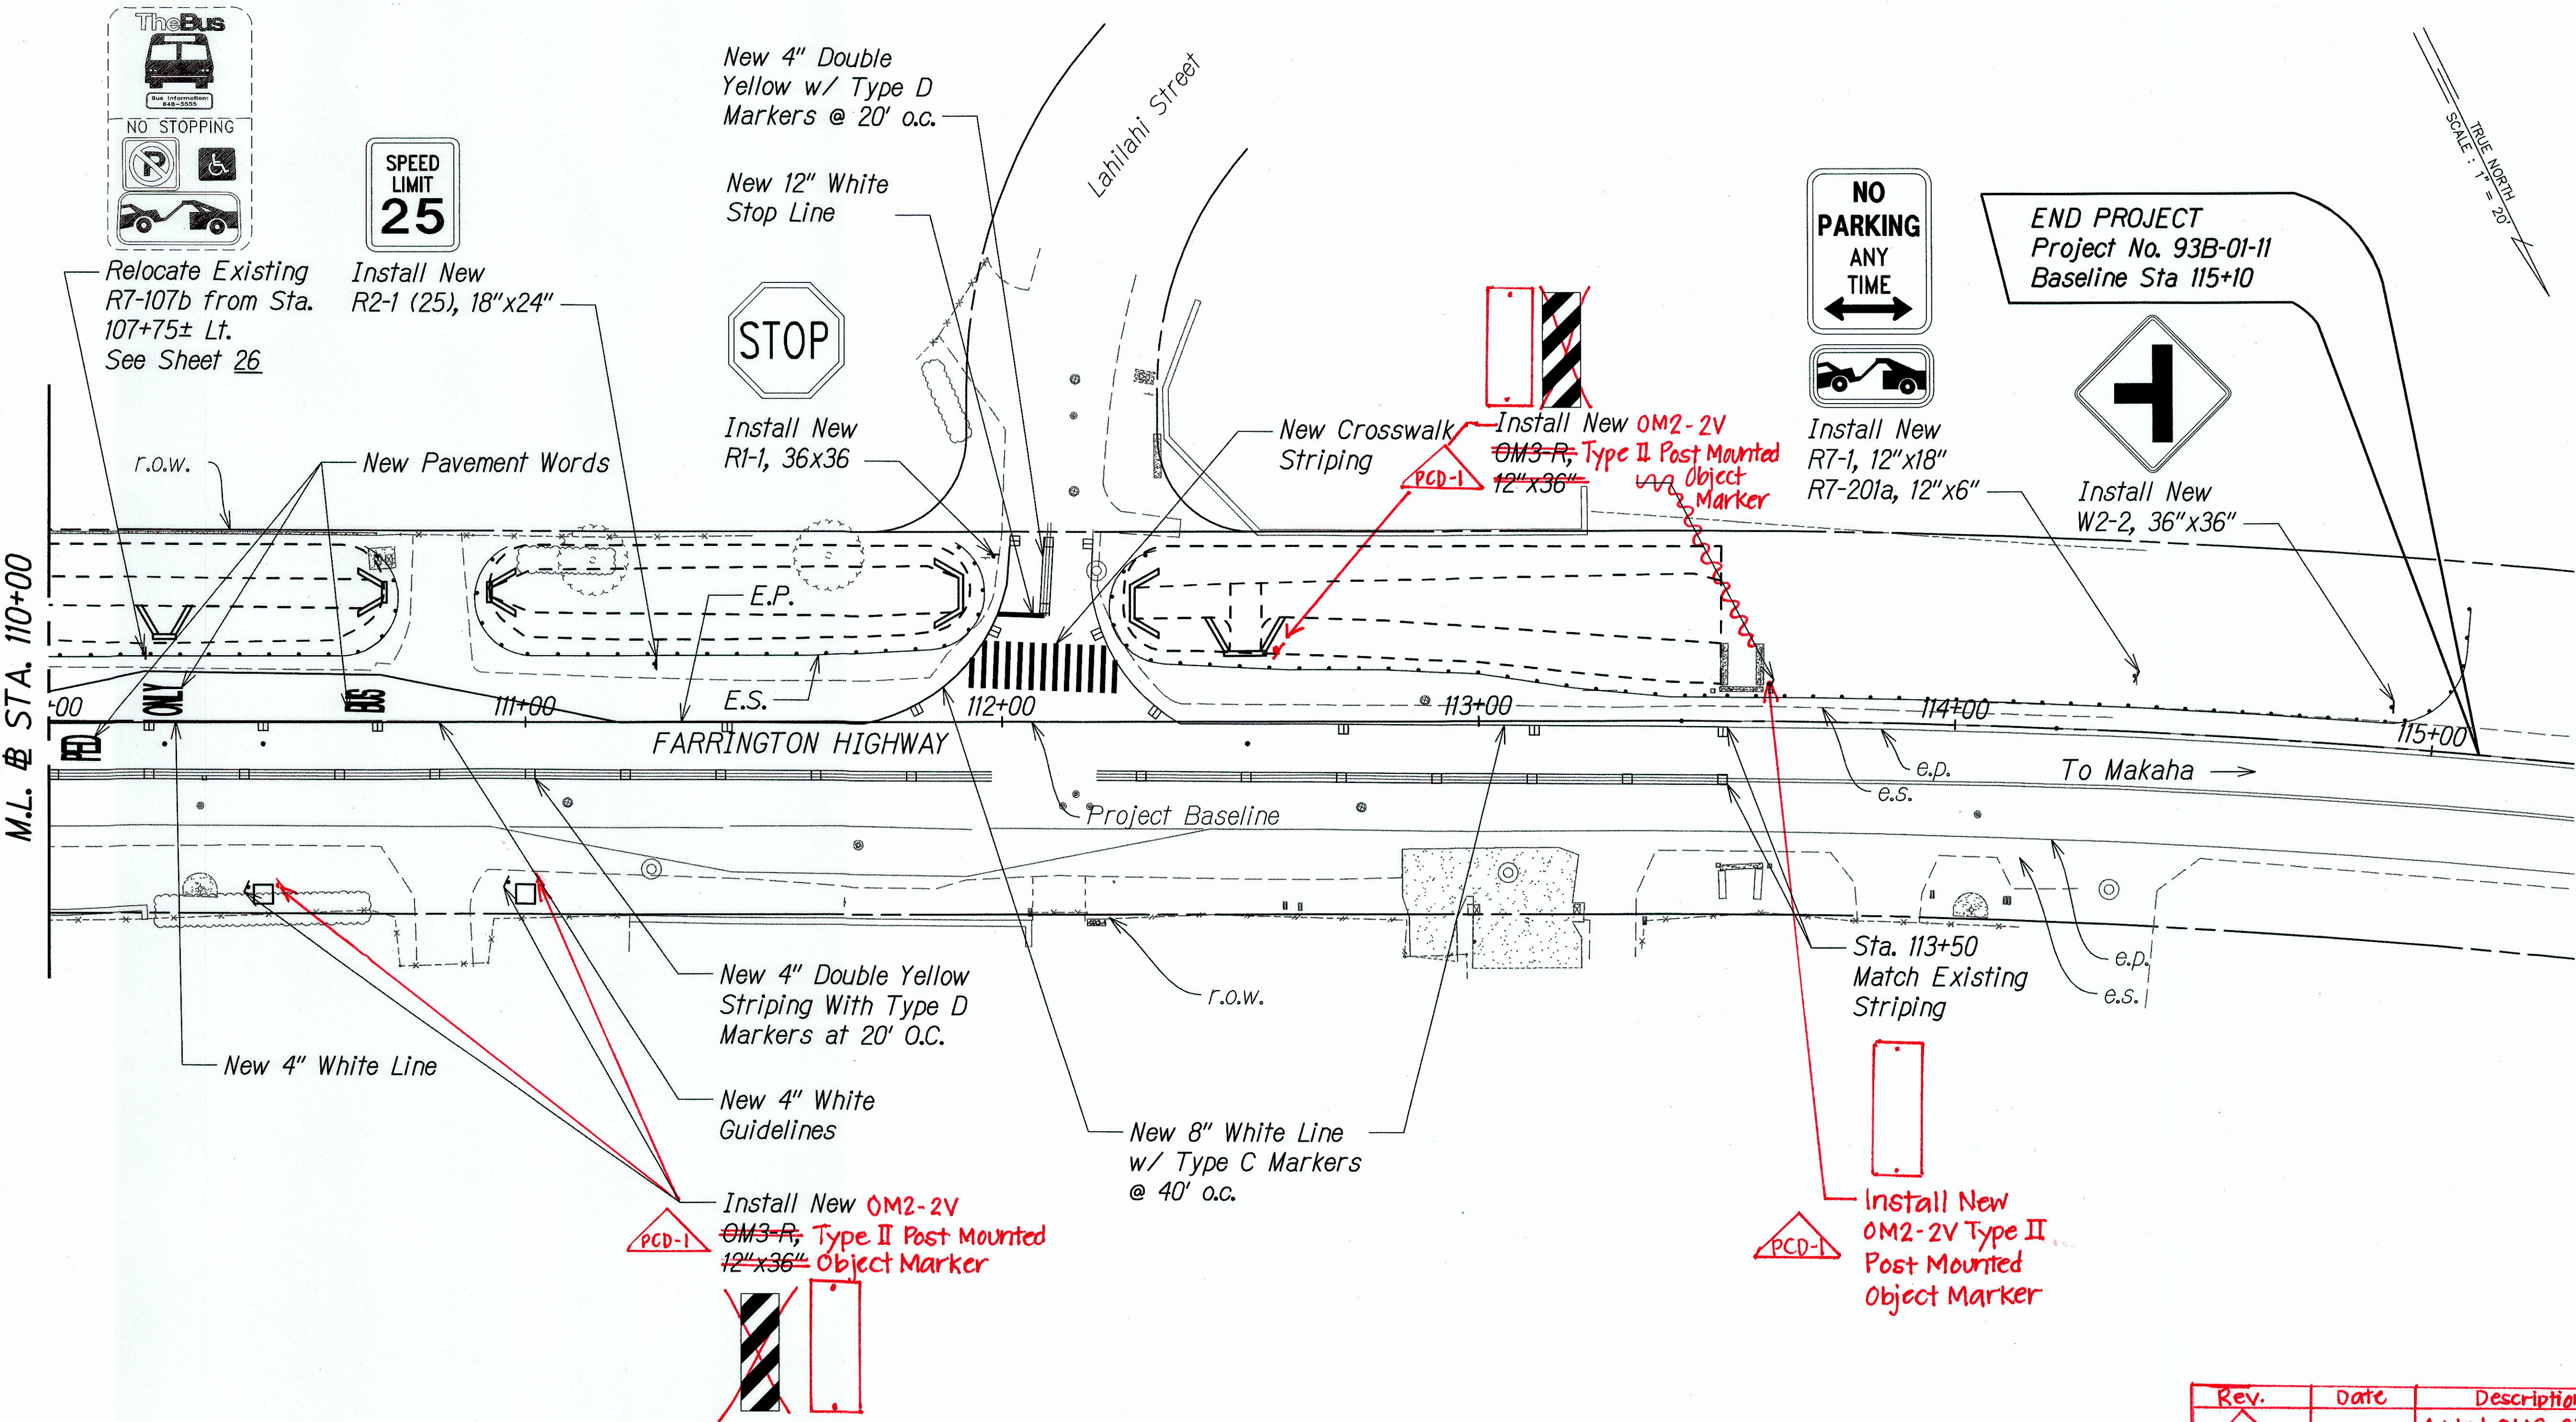

Rev.	Date	Description
PCD-1	6/10/13	Added OM2-2V OBJECT MARKERS

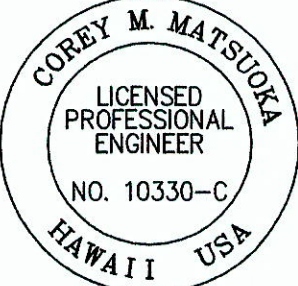

THIS WORK WAS PREPARED BY ME  
OR UNDER MY SUPERVISION

*Corey Matsuda*  
SIGNATURE

4/30/12

EXPIRATION  
DATE OF THE  
LICENSE

STATE OF HAWAII  
DEPARTMENT OF TRANSPORTATION  
HIGHWAYS DIVISION

STRIPING AND SIGNAGE PLAN  
FARRINGTON HIGHWAY DRAINAGE IMPROVEMENTS  
Vicinity of Orange St.  
Project No. 93B-01-11  
Scale: 1"=20'      Date: FEB 2012  
SHEET No. 2 OF 2 SHEETS

"AS-BUILT"