


FED. ROAD DIST. NO.	STATE	FED. AID PROJ. NO.	FISCAL YEAR	SHEET NO.	TOTAL SHEETS
HAWAII	HAW.	93B-01-11	2012	17	38

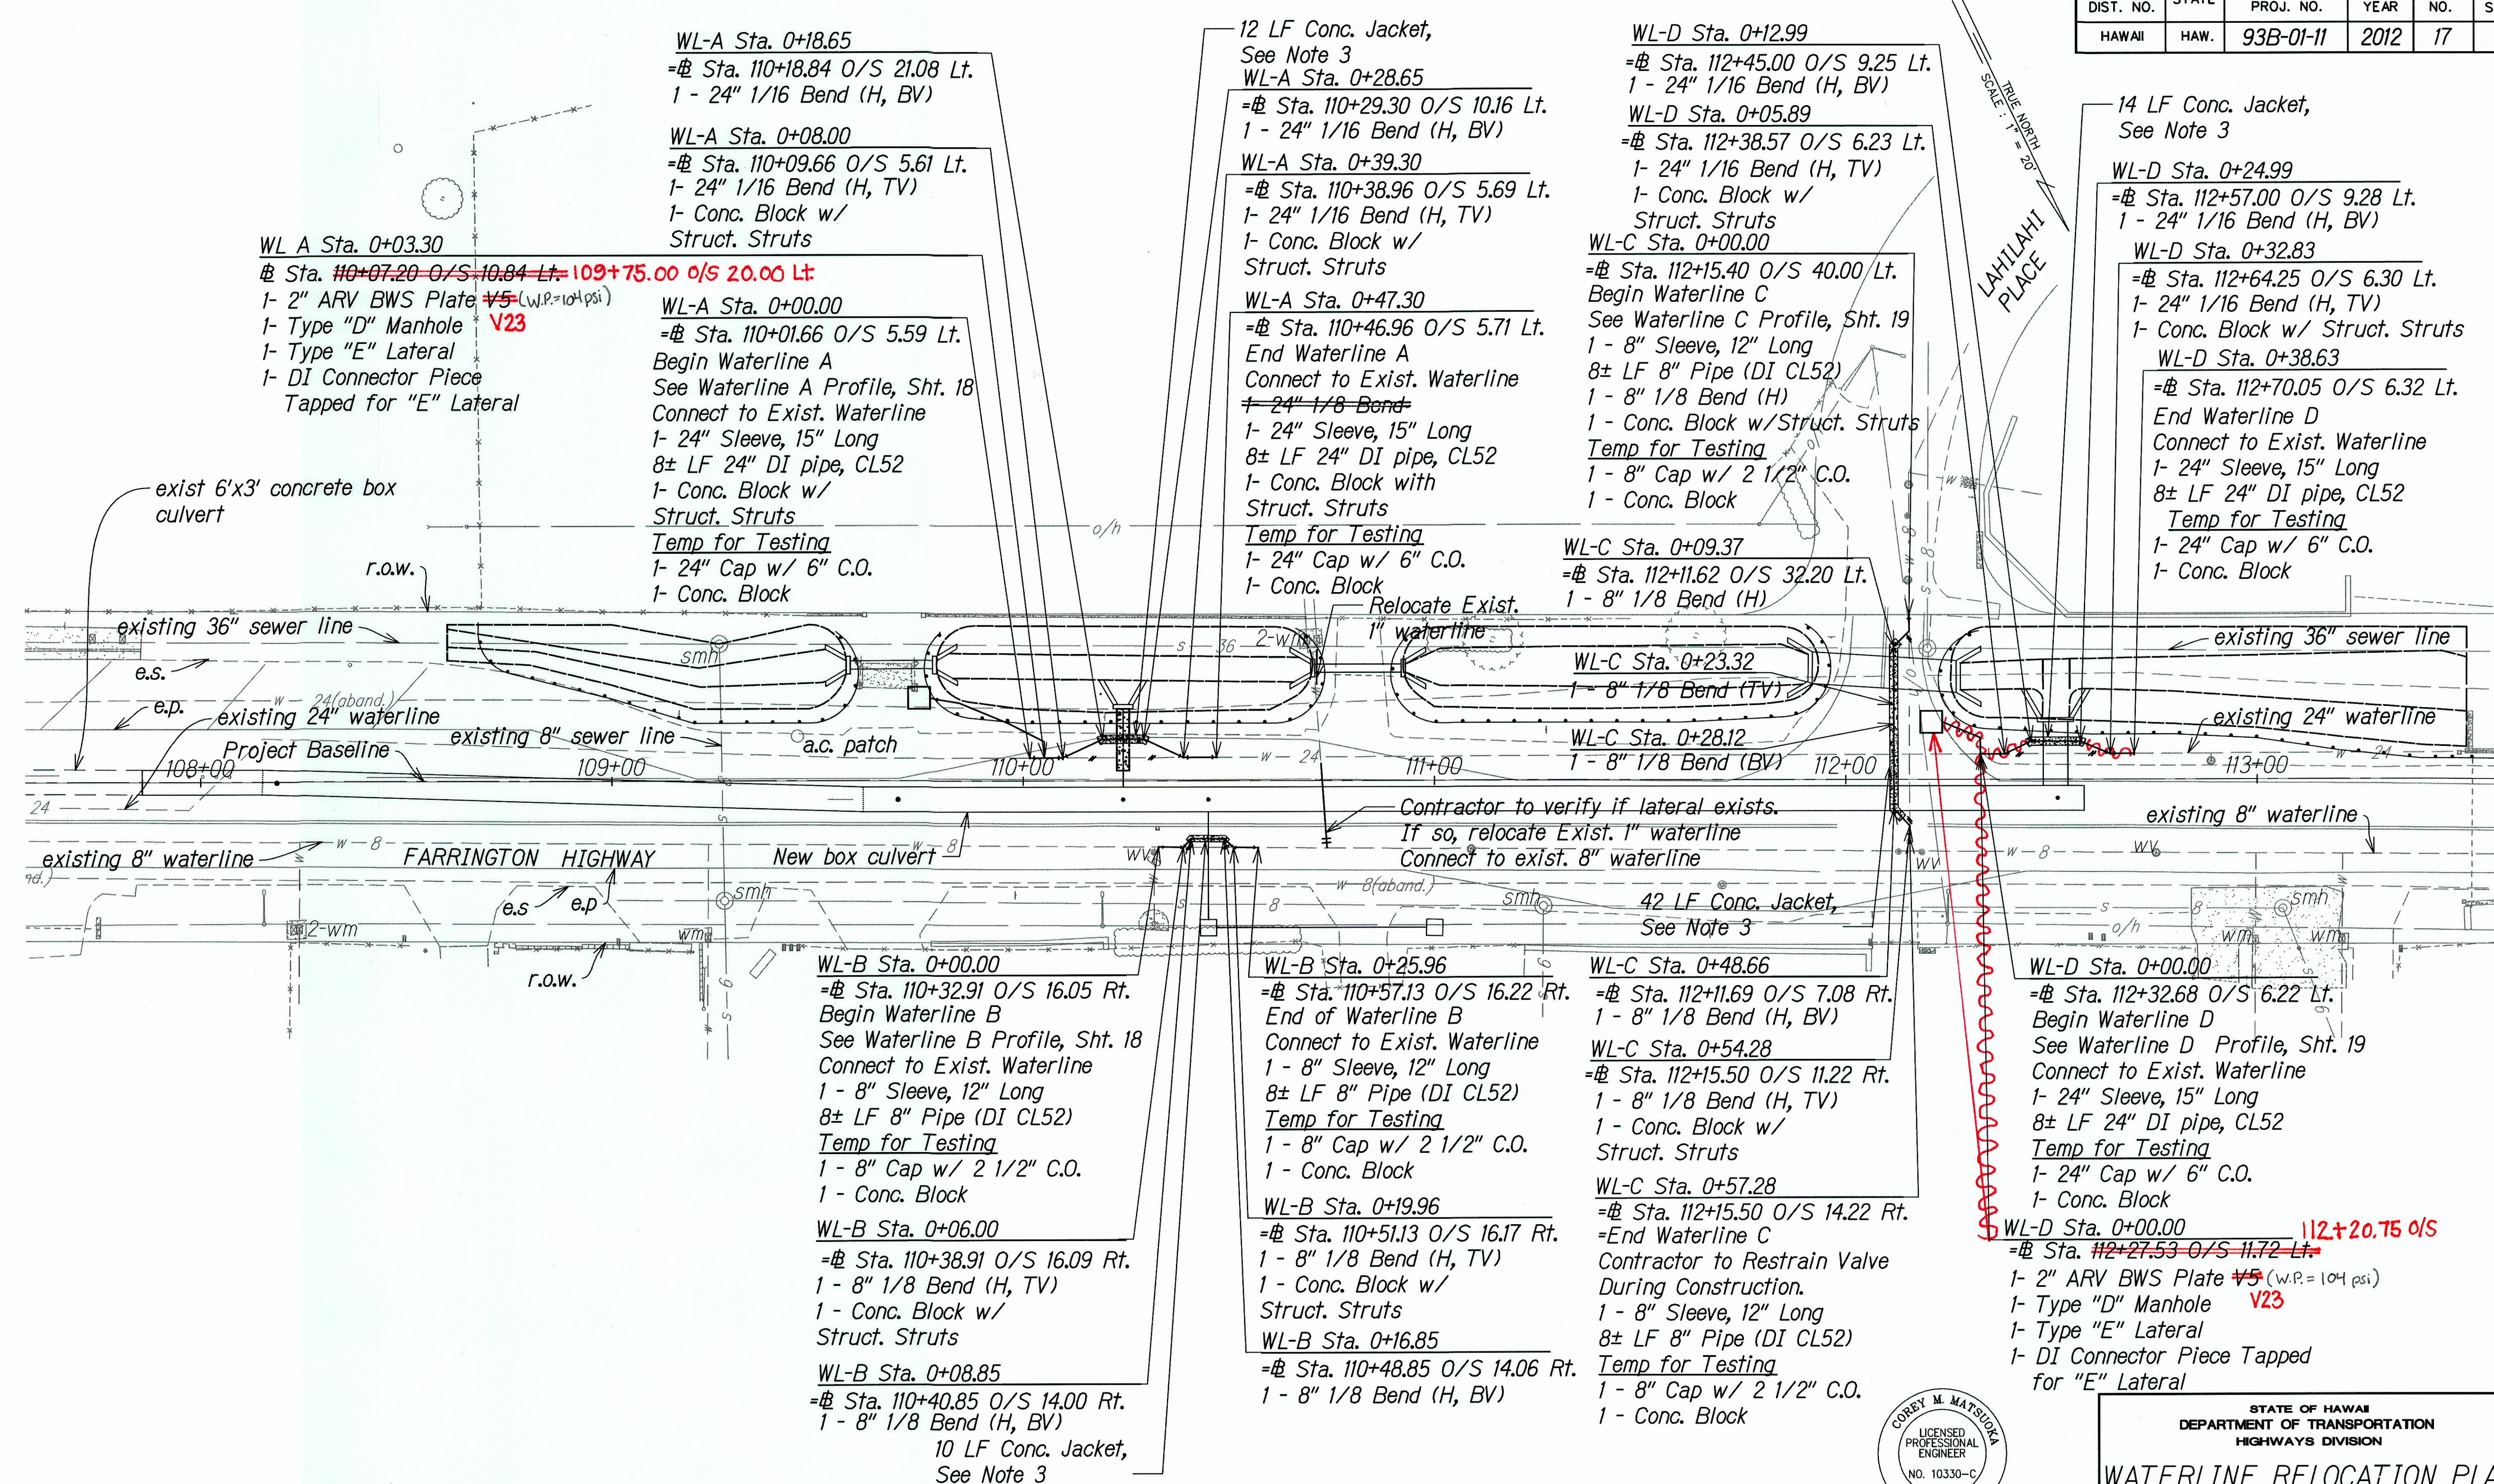

NOTES:


1. For 24" waterline concrete blocks, see Water Detail Sht. 20.
2. For 8" waterline concrete blocks, see BWS Standard Detail B3.
3. For concrete jacket, see BWS Standard Detail B1
4. For Type "D" Manhole, see BWS Standard Details MH20 and MH21
5. For Type "E" Lateral, see BWS Standard Details LI2

APPROVED:

 COREY M. MATSUDA
 MANAGER AND CHIEF ENGINEER, BWS DO
 (For work Affecting BWS Facilities In City/State R/W & BWS Easements only)
 DATE: 4/30/12

THIS WORK WAS PREPARED BY ME OR UNDER MY SUPERVISION

 COREY M. MATSUDA
 SIGNATURE
 EXPIRATION DATE OF THE LICENSE: 4/30/12

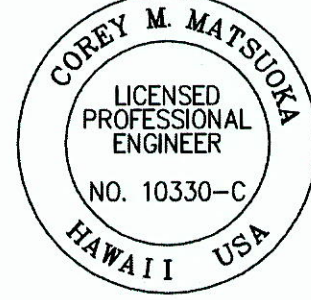

STATE OF HAWAII
 DEPARTMENT OF TRANSPORTATION
 HIGHWAYS DIVISION

WATERLINE RELOCATION PLAN

FARRINGTON HIGHWAY DRAINAGE IMPROVEMENTS
 Vicinity of Orange St.
 Project No. 93B-01-11
 Scale: 1" = 20' Date: FEB 2012

SHEET No. 1 OF 1 SHEETS

"AS-BUILT"