




FED. ROAD DIST. NO.	STATE	FED. AID PROJ. NO.	FISCAL YEAR	SHEET NO.	TOTAL SHEETS
HAWAII	HAW.	93B-01-11	2012	18	38

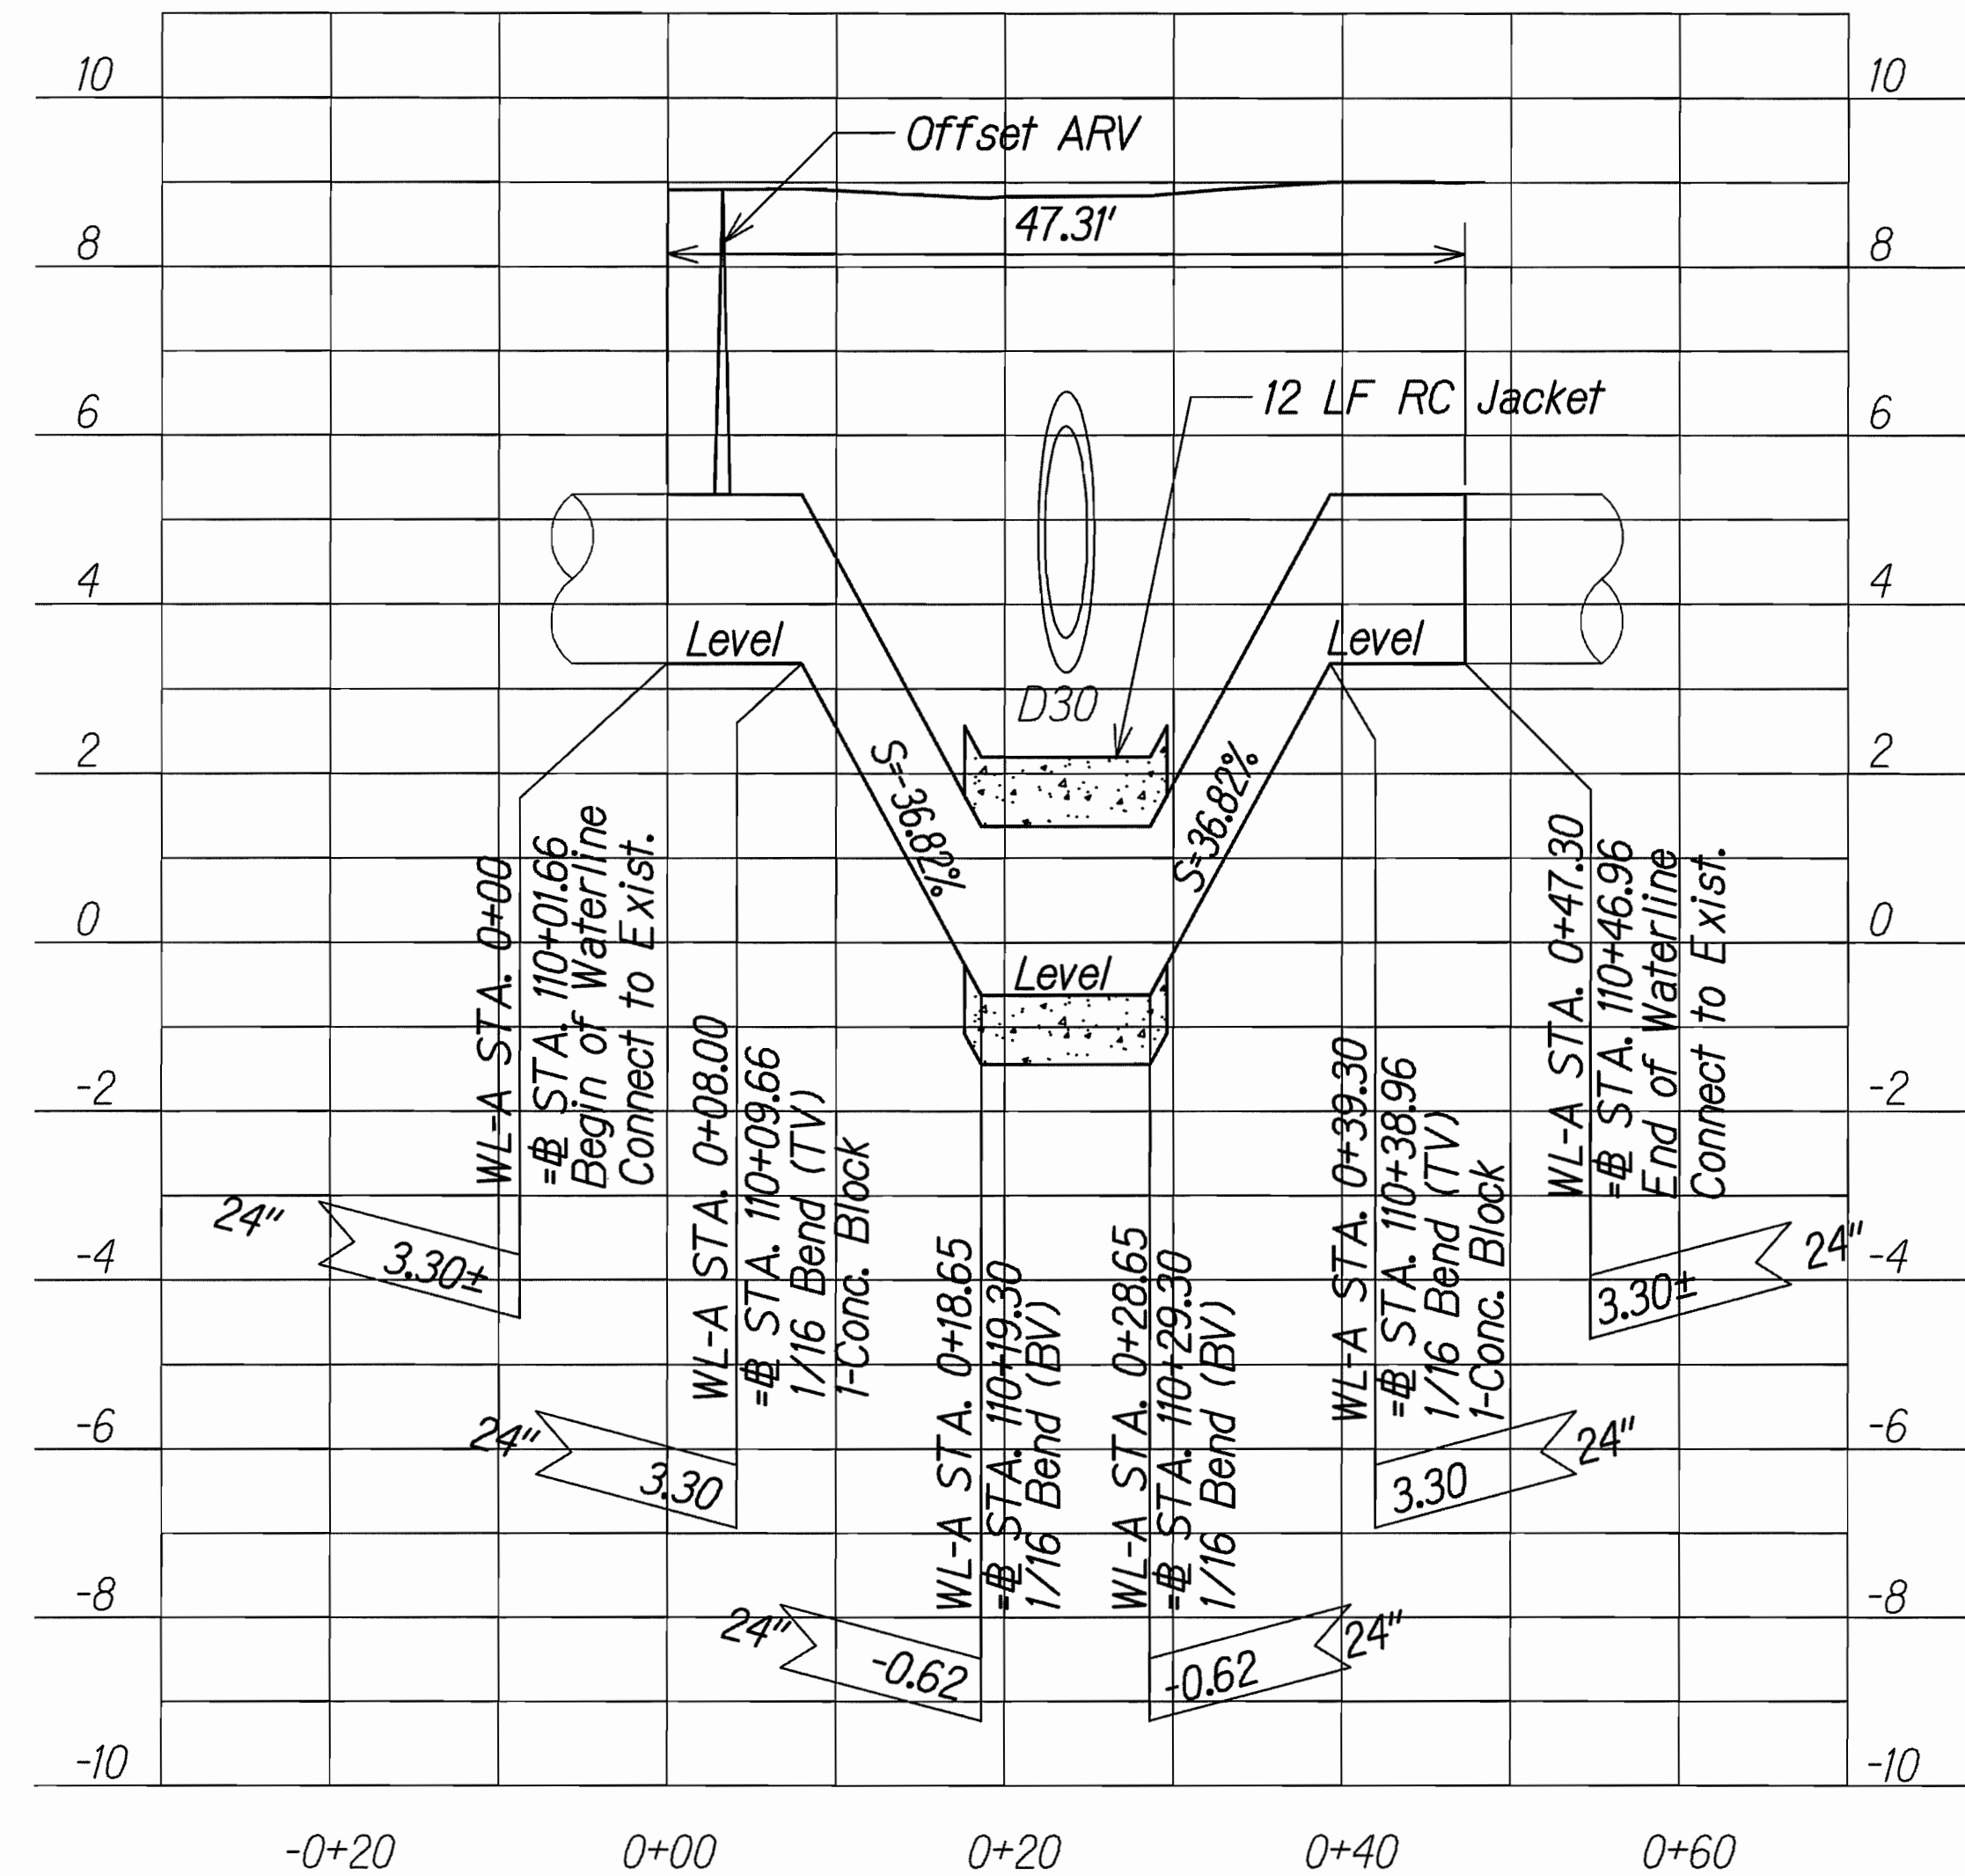

WATERLINE A
 SCALE: HORIZ 1" = 10'
 VERT 1" = 2'

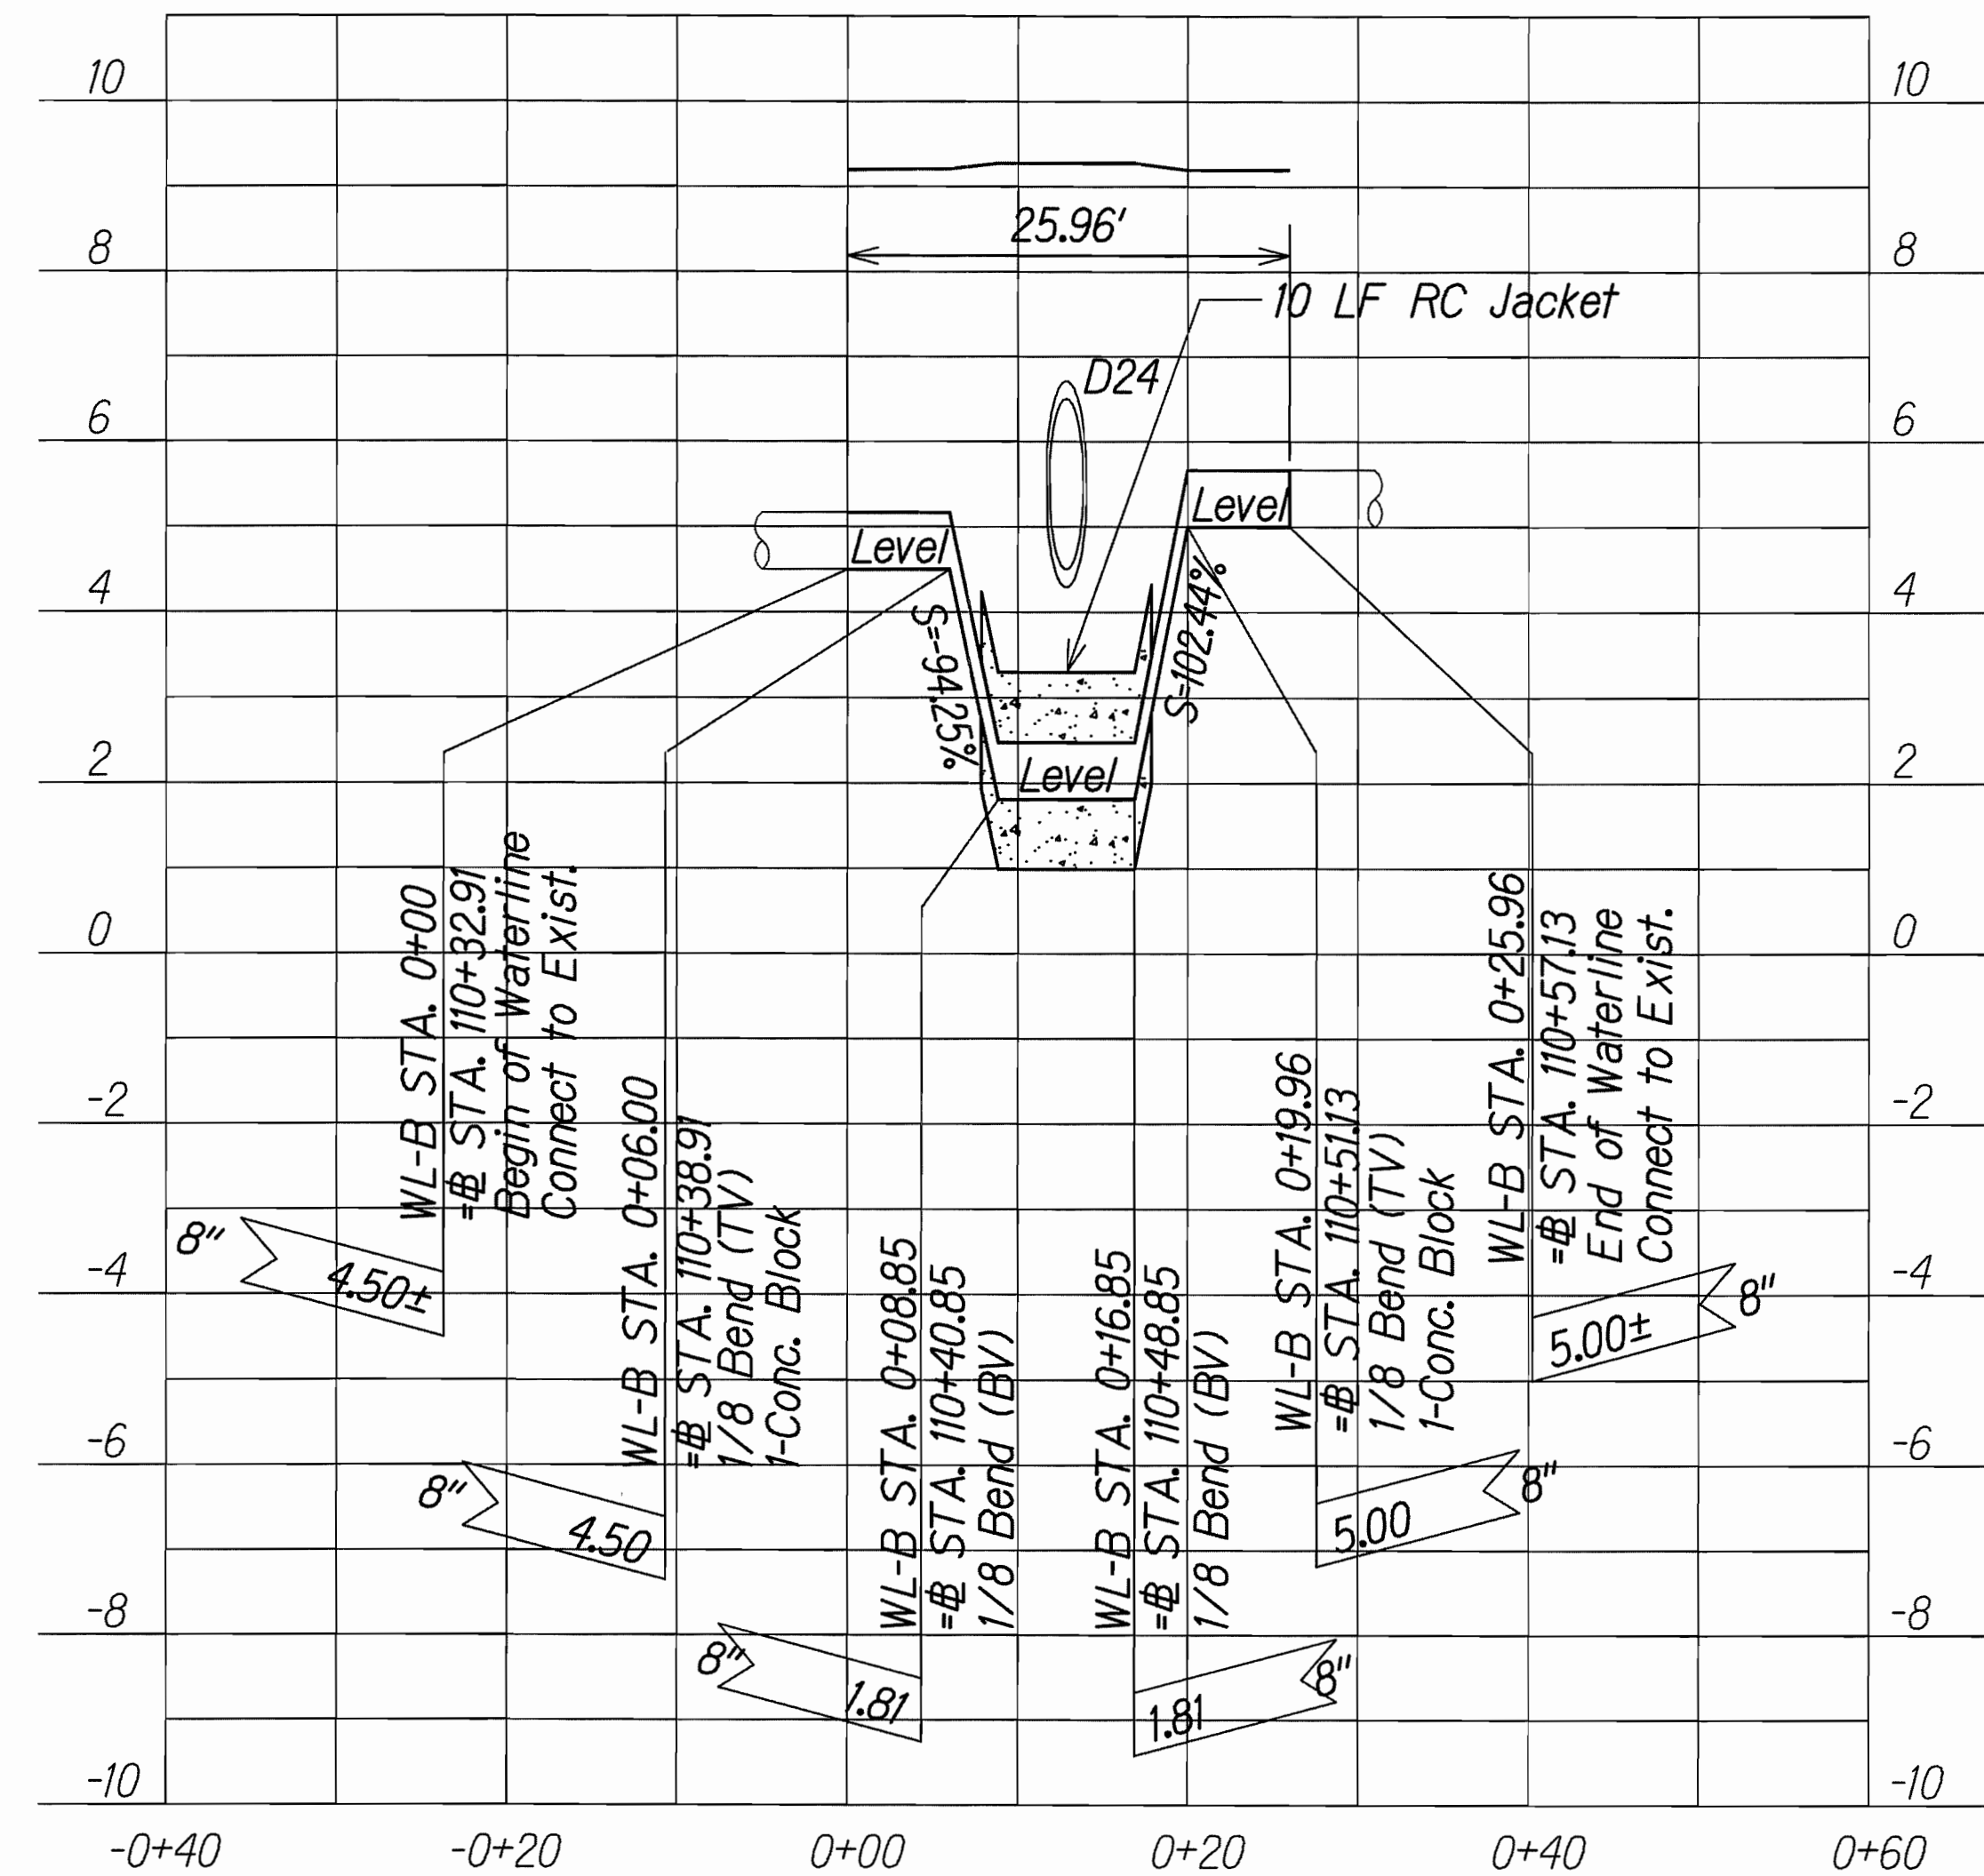

WATERLINE B
 SCALE: HORIZ 1" = 10'
 VERT 1" = 2'

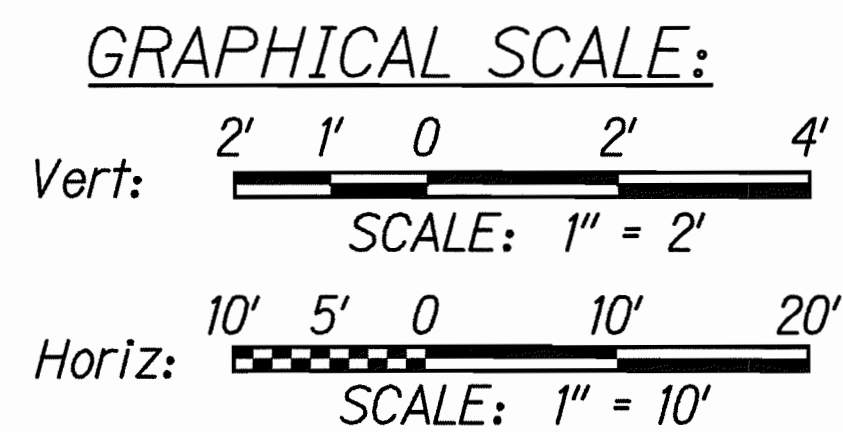

APPROVED:
 [Signature]
 MANAGER AND CHIEF ENGINEER, BWS
 (For work Affecting BWS Facilities in City/State R/W & BWS Easements only)
 DATE 4/4/12

CORREY M. MATSUOKA
 LICENSED PROFESSIONAL ENGINEER
 NO. 10330-C
 HAWAII USA

THIS WORK WAS PREPARED BY ME OR UNDER MY SUPERVISION


CORREY M. MATSUOKA
 SIGNATURE
 DATE OF THE LICENSE 4/30/12

STATE OF HAWAII
 DEPARTMENT OF TRANSPORTATION
 HIGHWAYS DIVISION



WATER RELOCATION PROFILES

FARRINGTON HIGHWAY DRAINAGE IMPROVEMENTS
 Vicinity of Orange St.
 Project No. 93B-01-11
 Scale: AS NOTED Date: FEB 2012
 SHEET No. 1 OF 2 SHEETS

FED. ROAD DIST. NO.	STATE	FED. AID PROJ. NO.	FISCAL YEAR	SHEET NO.	TOTAL SHEETS
HAWAII	HAW.	93B-01-11	2012	19	38

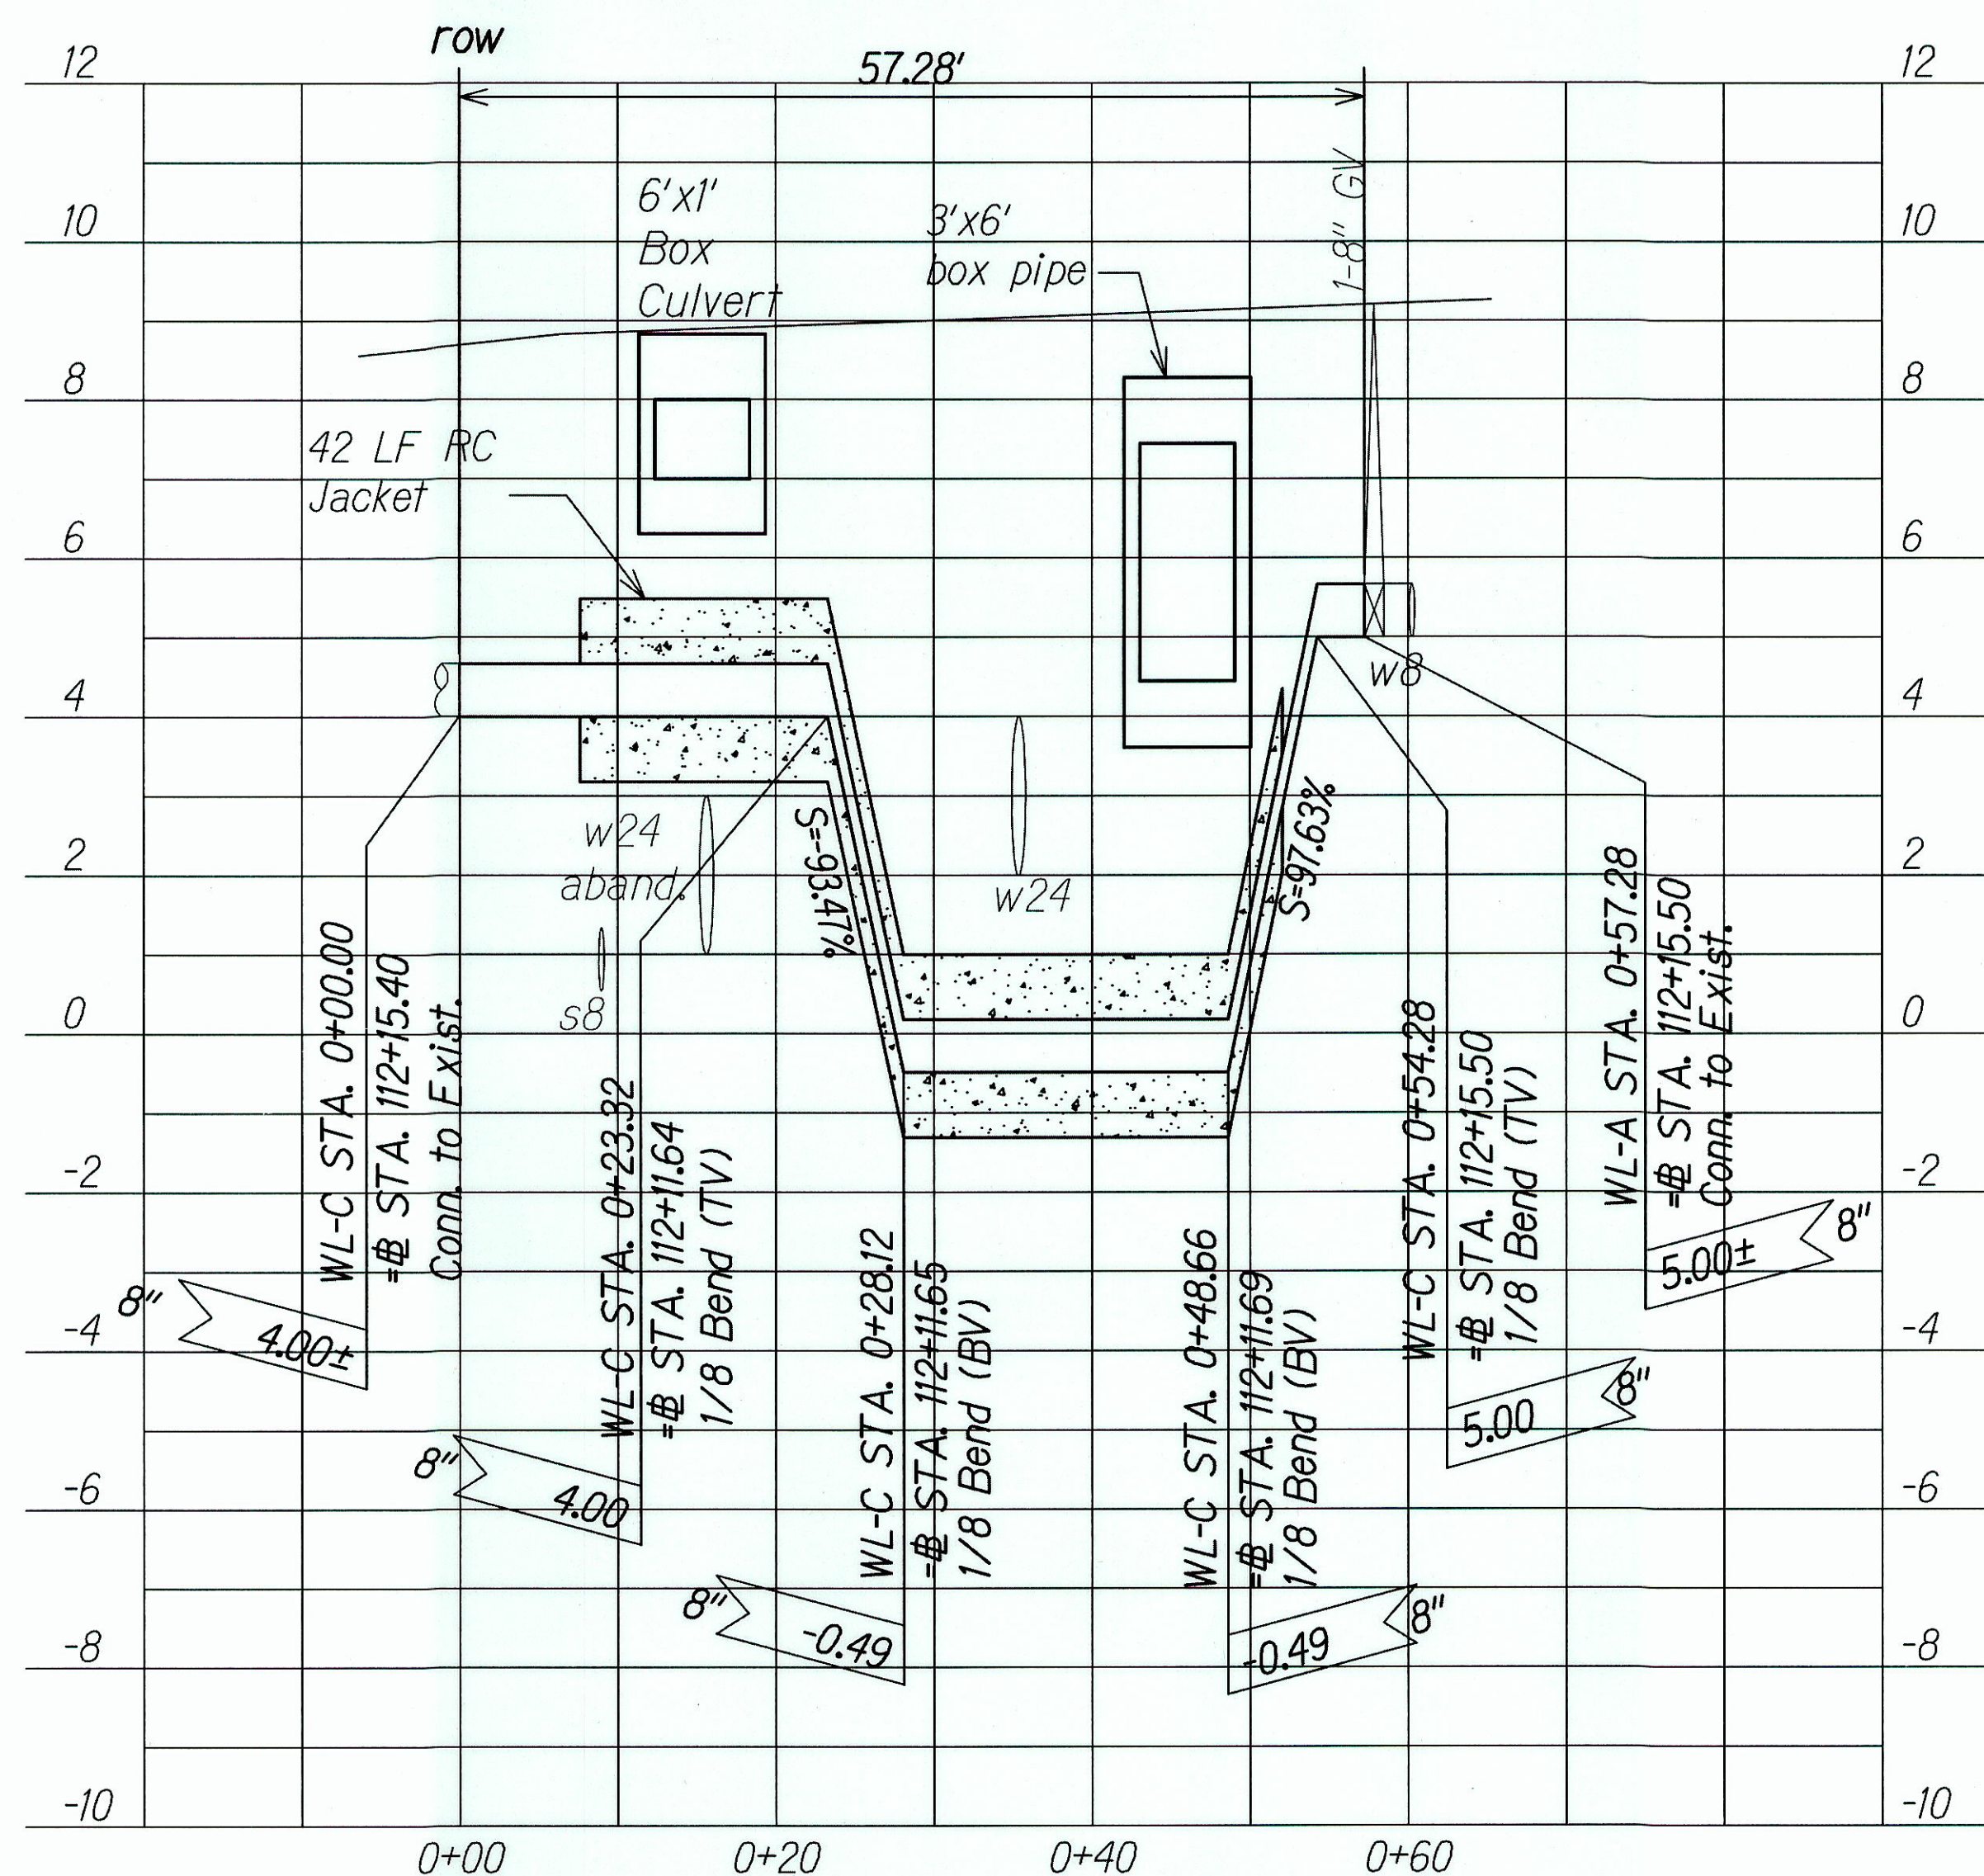


WATERLINE C
 SCALE: HORIZ 1" = 20'
 VERT 1" = 2'

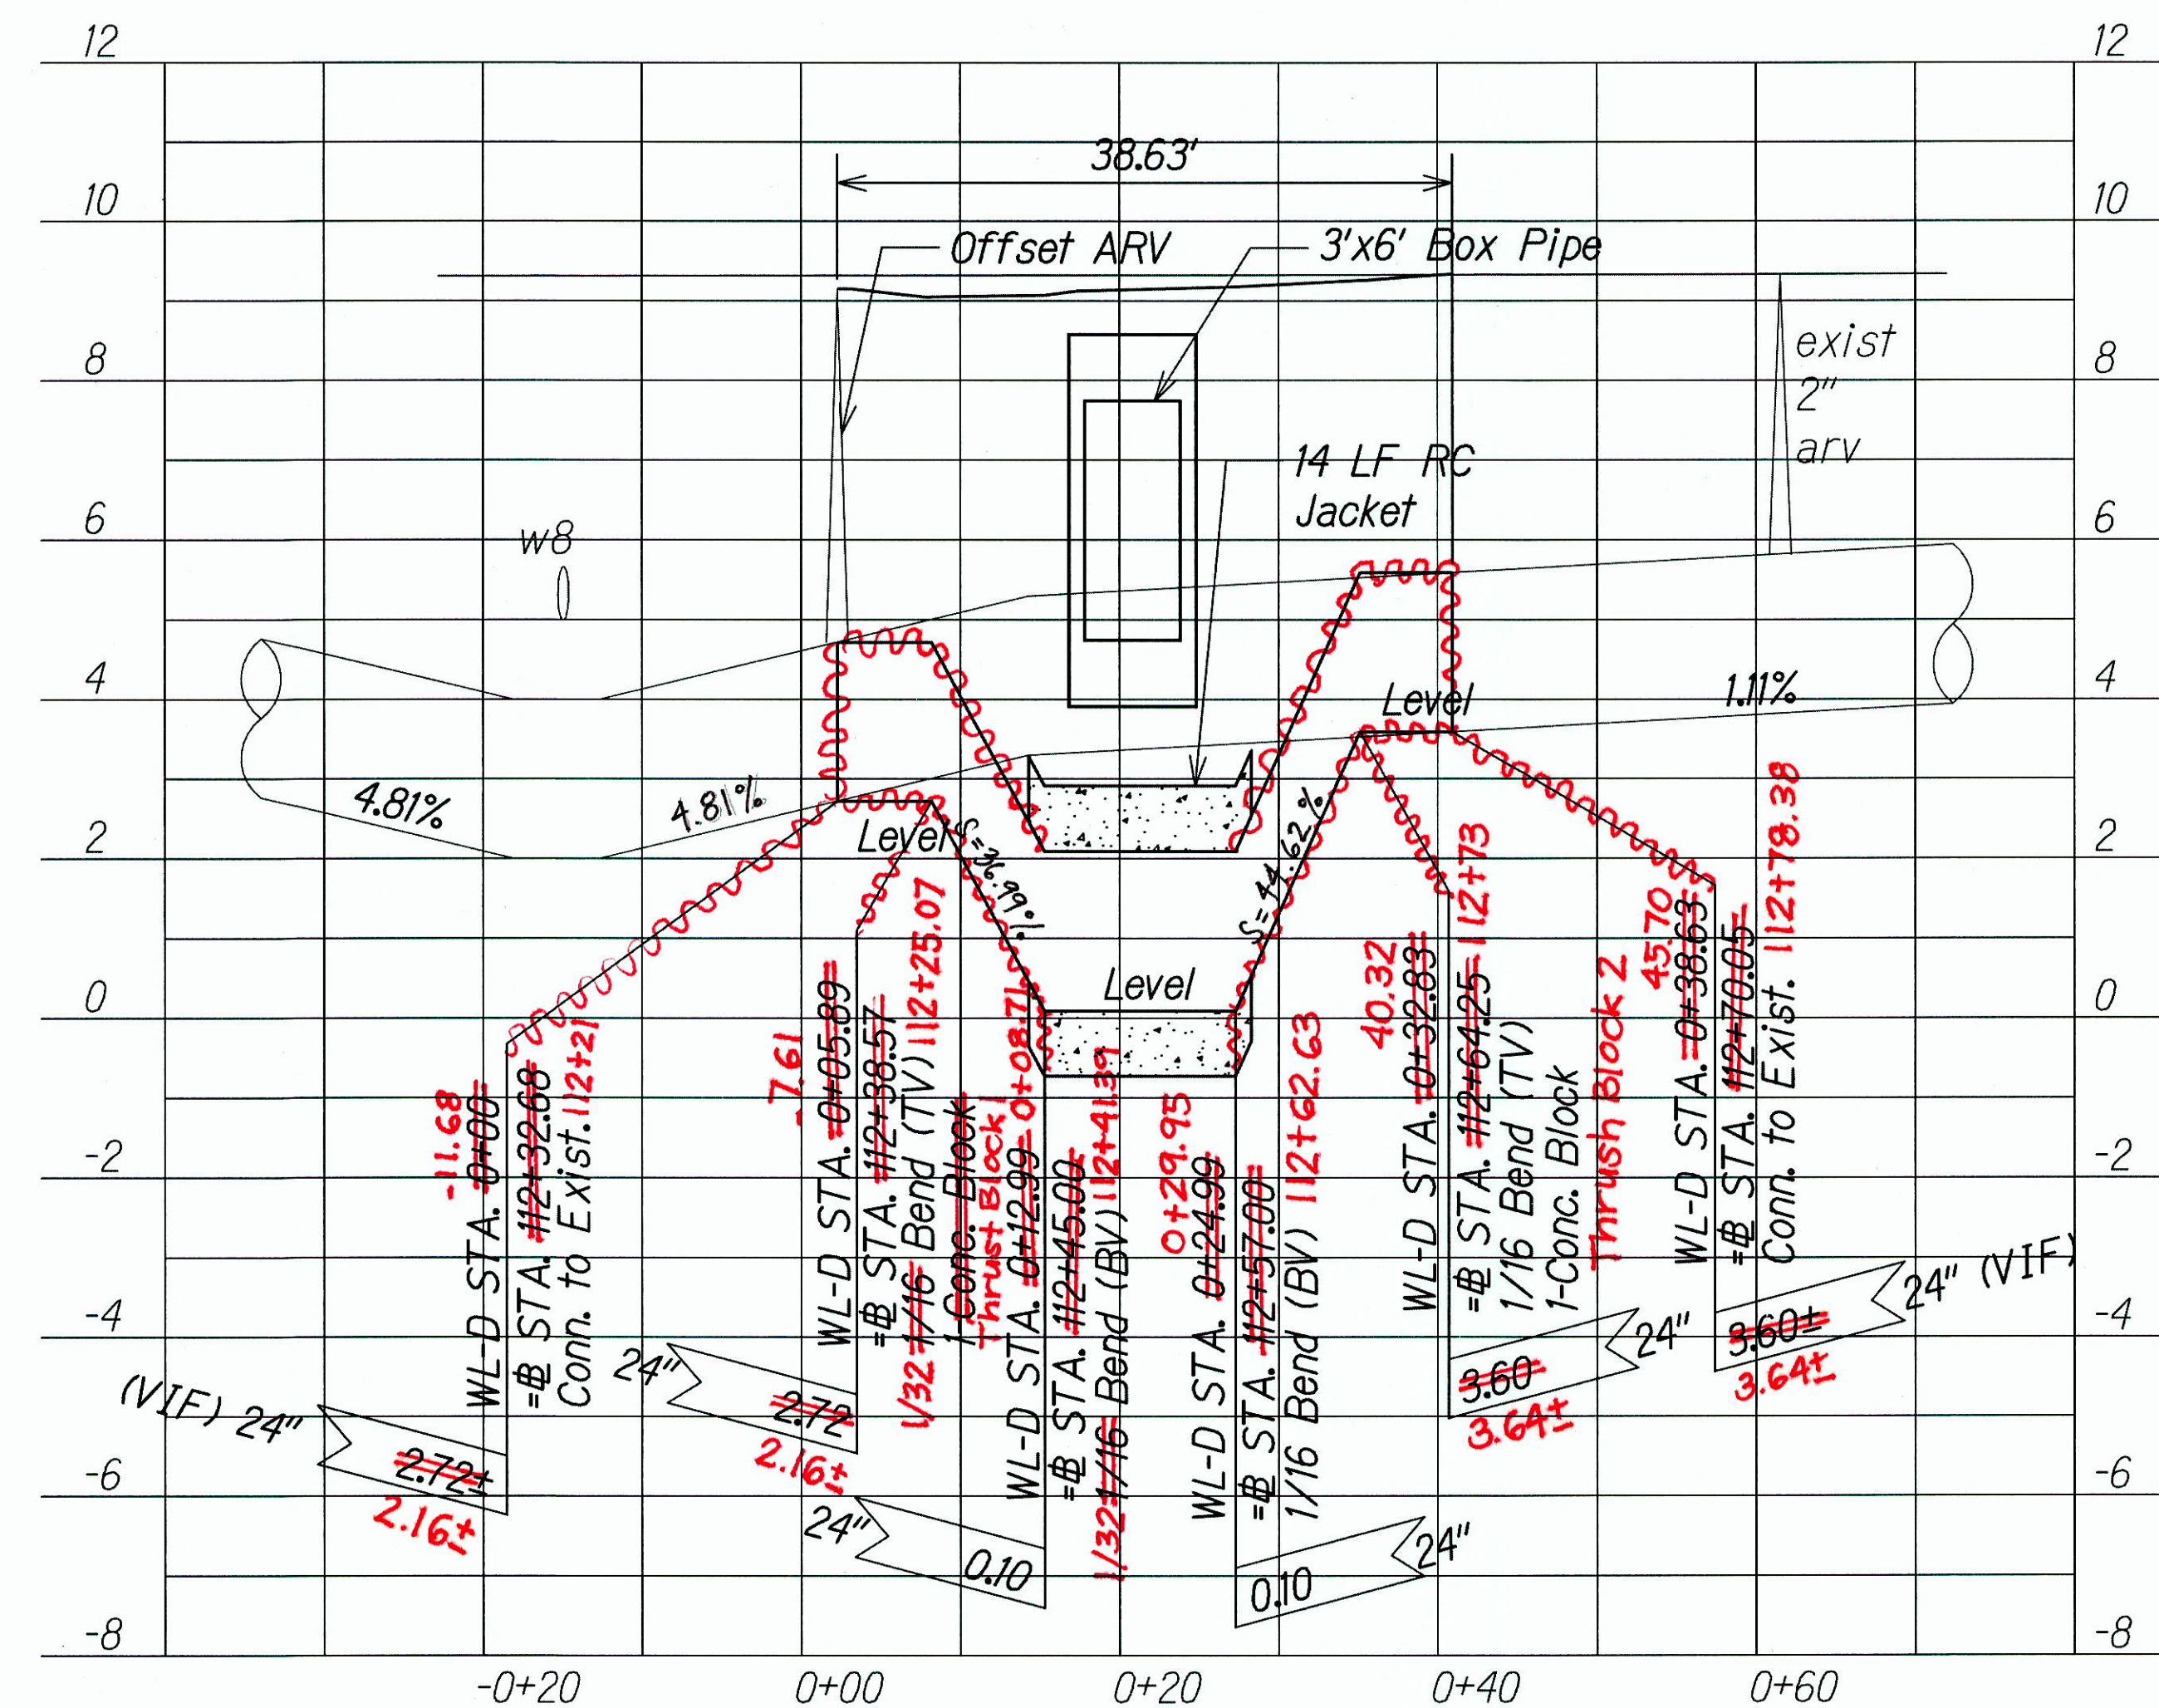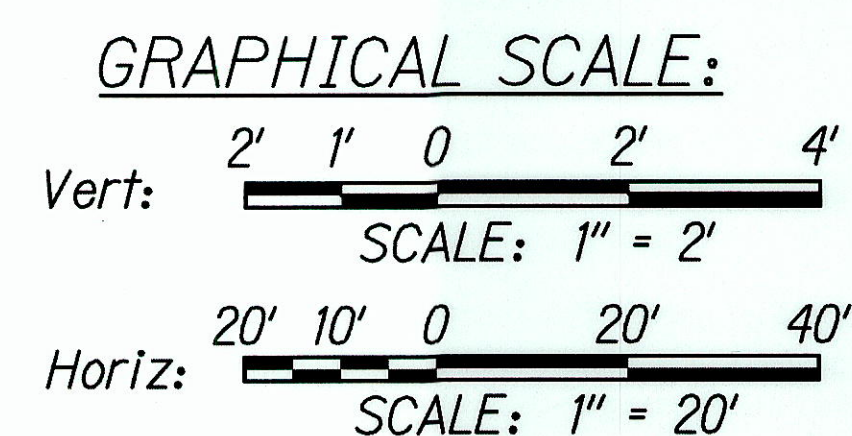

WATERLINE D
 SCALE: HORIZ 1" = 20'
 VERT 1" = 2'

APPROVED:
 [Signature]
 MANAGER AND CHIEF ENGINEER, BWS
 (For work Affecting BWS Facilities in City/State R/W & BWS Easements only)
 DATE: 4/24/12

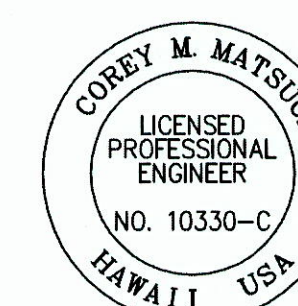

THIS WORK WAS PREPARED BY ME OR UNDER MY SUPERVISION
 [Signature]
 SIGNATURE
 DATE OF THE LICENSE: 4/30/12

STATE OF HAWAII
DEPARTMENT OF TRANSPORTATION
HIGHWAYS DIVISION

WATER RELOCATION PROFILES
FARRINGTON HIGHWAY DRAINAGE IMPROVEMENTS
Vicinity of Orange St.
Project No. 93B-01-11
Scale: AS NOTED Date: FEB 2012
SHEET No. 2 OF 2 SHEETS

"AS-BUILT"