


FED. ROAD DIST. NO.	STATE	FED. AID PROJ. NO.	FISCAL YEAR	SHEET NO.	TOTAL SHEETS
HAWAII	HAW.	STP-093-1(026)	2016	48	110

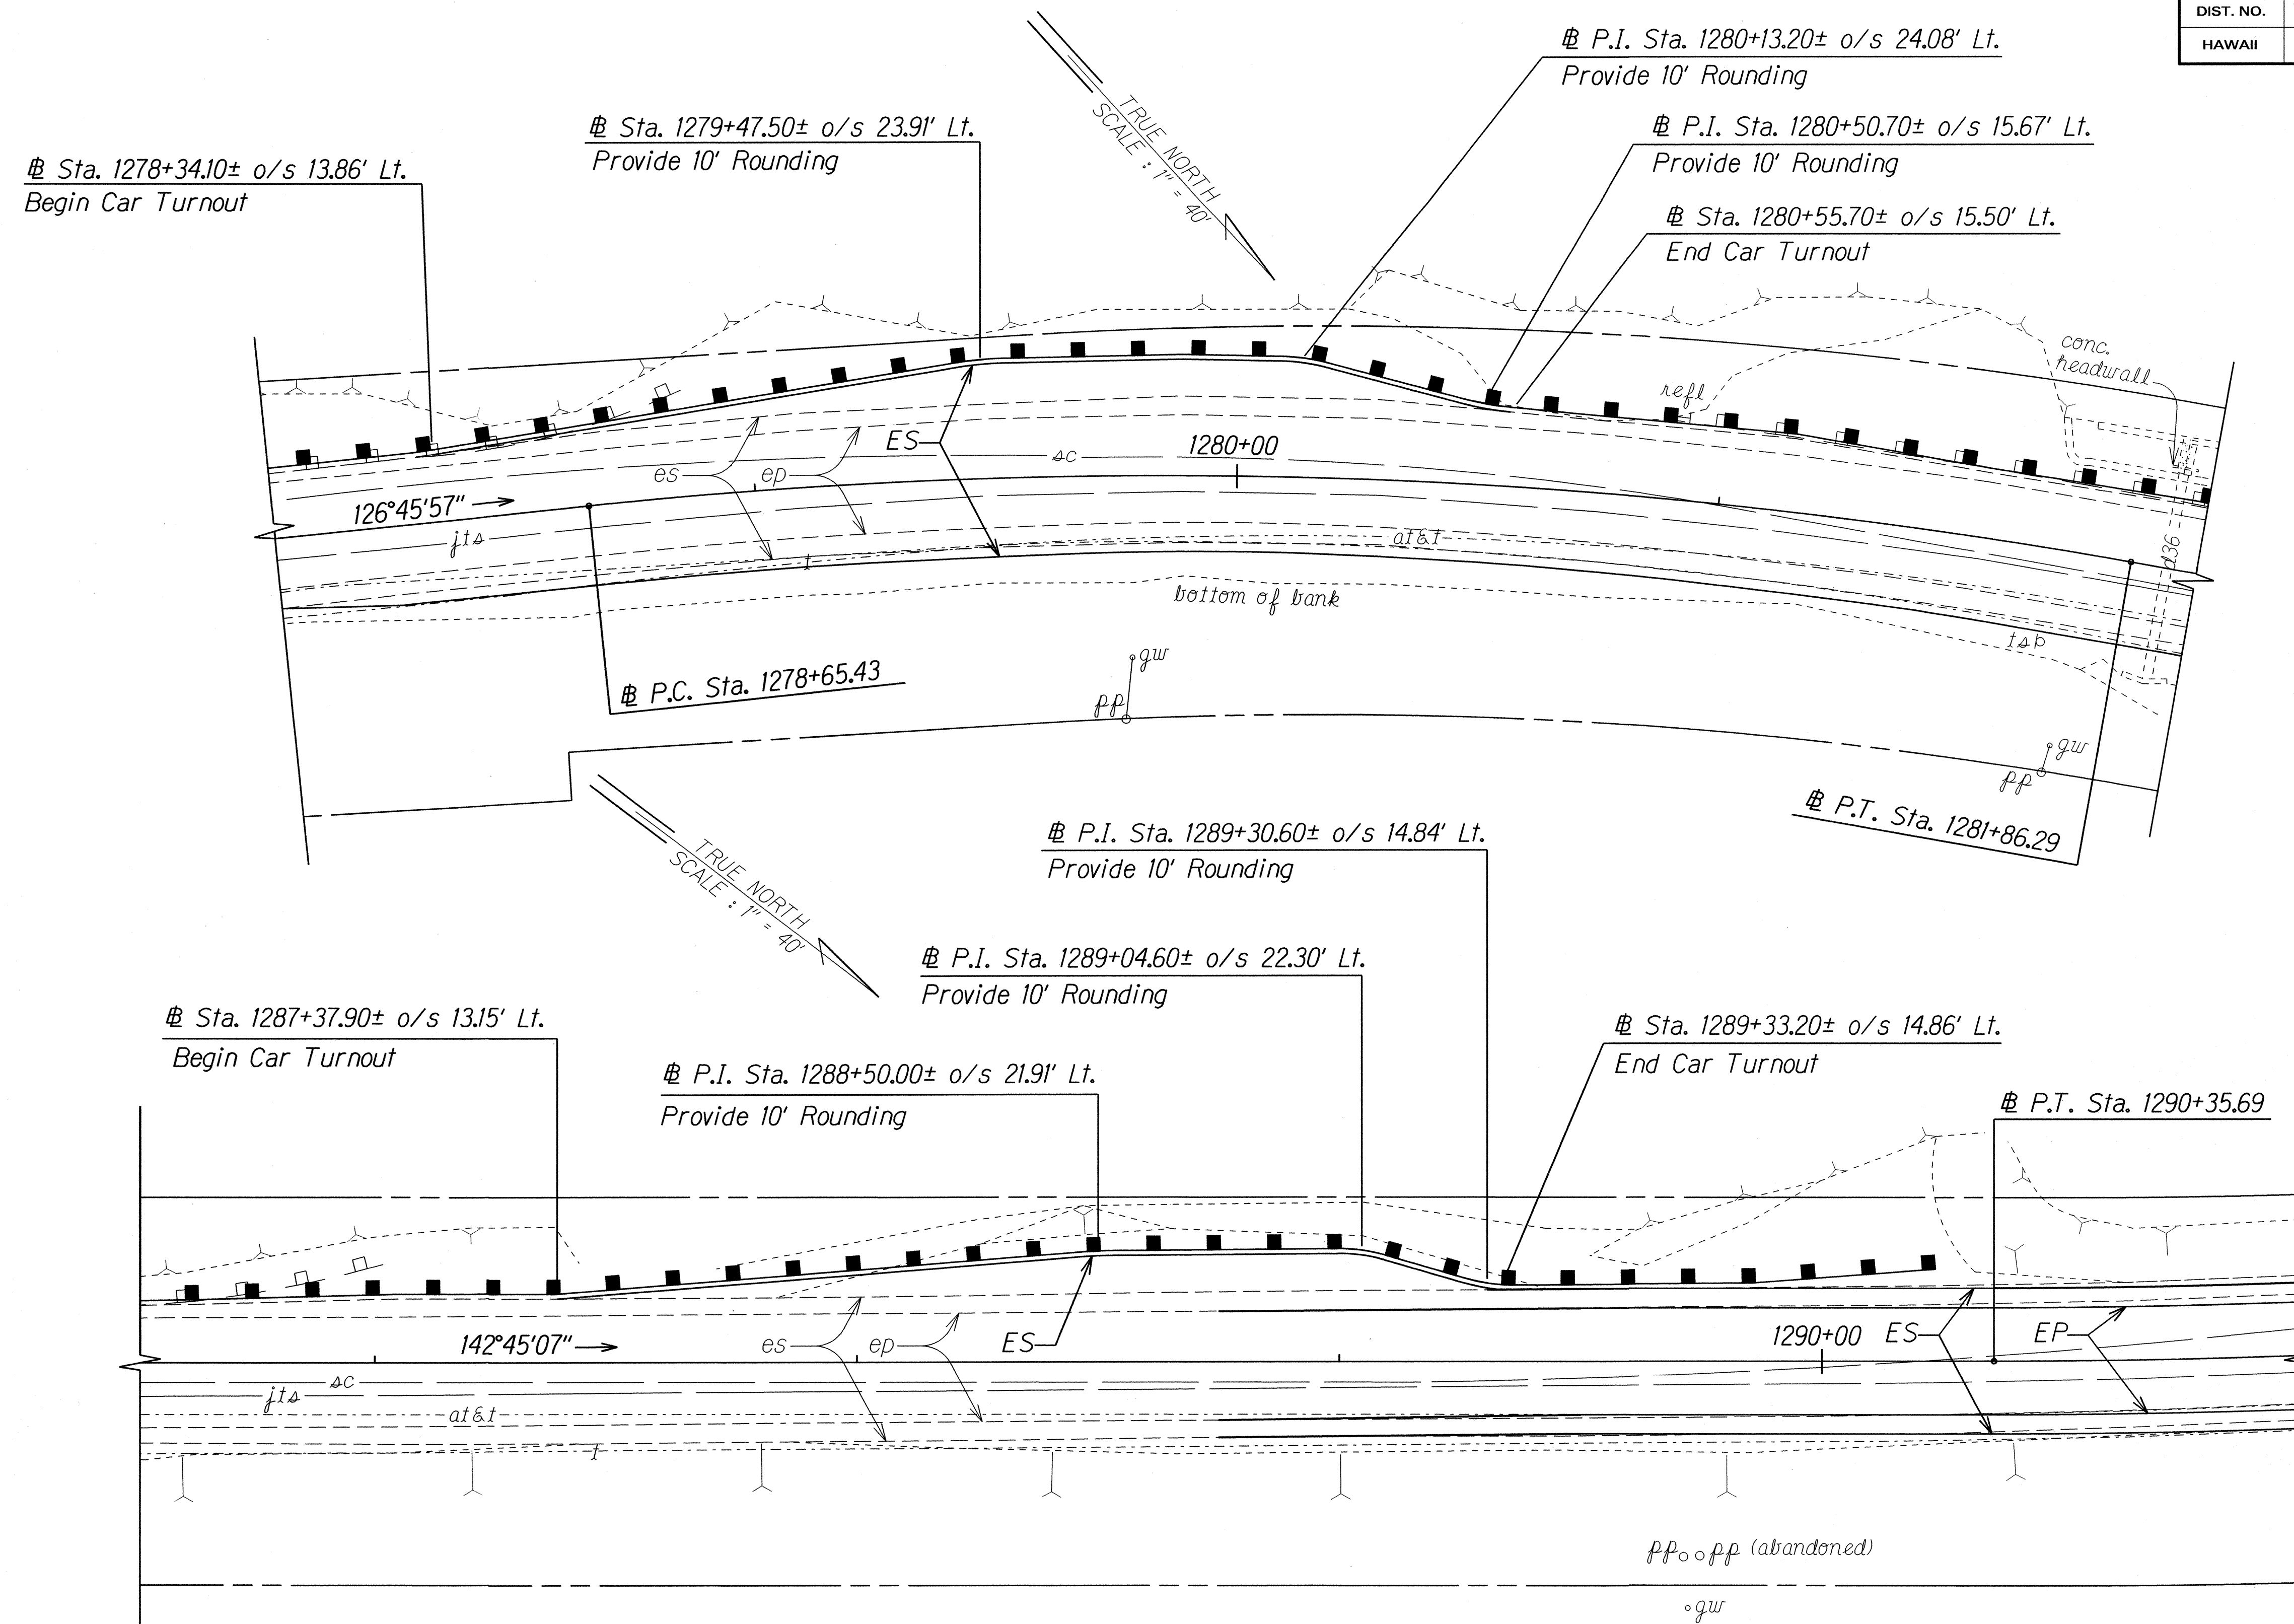

PLAN
Scale: 1" = 20'

ORIGINAL PLAN	DATE
DRAWN BY	
DESIGNED BY	
QUANTITIES BY	
CHECKED BY	

STATE OF HAWAII
DEPARTMENT OF TRANSPORTATION
HIGHWAYS DIVISION

CAR TURNOUT PLAN
FARRINGTON HIGHWAY RESURFACING
Vicinity of Kili Drive to
Satellite Tracking Station Road
Federal Aid Project No. STP-093-1(026)
Scale 1"=20' Date: April, 2016

SHEET No. 1 OF 1 SHEETS