



FED. ROAD DIST. NO.	STATE	FED. AID PROJ. NO.	FISCAL YEAR	SHEET NO.	TOTAL SHEETS
HAWAII	HAW.	STP-093-1(026)	2016	ADD.17S-1	110

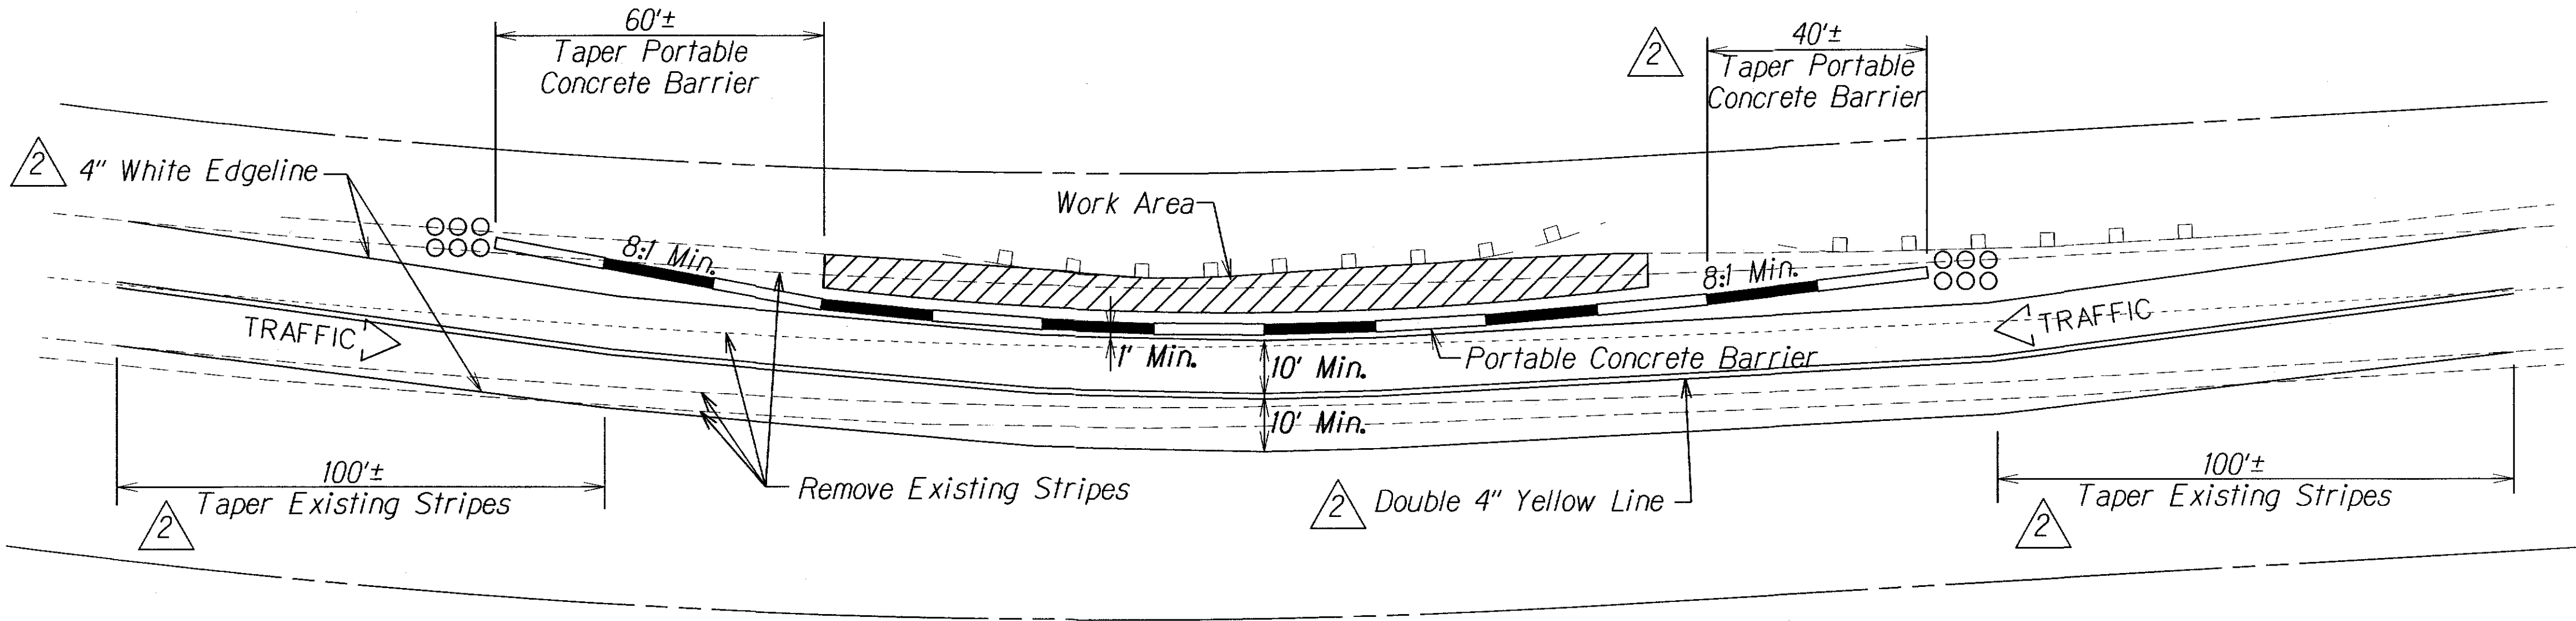


PORTABLE CONCRETE BARRIER PLAN FOR ROAD STABILIZATION WORK
 @ STA. 1292+85± TO @ STA. 1294+35±

Scale: Not to Scale

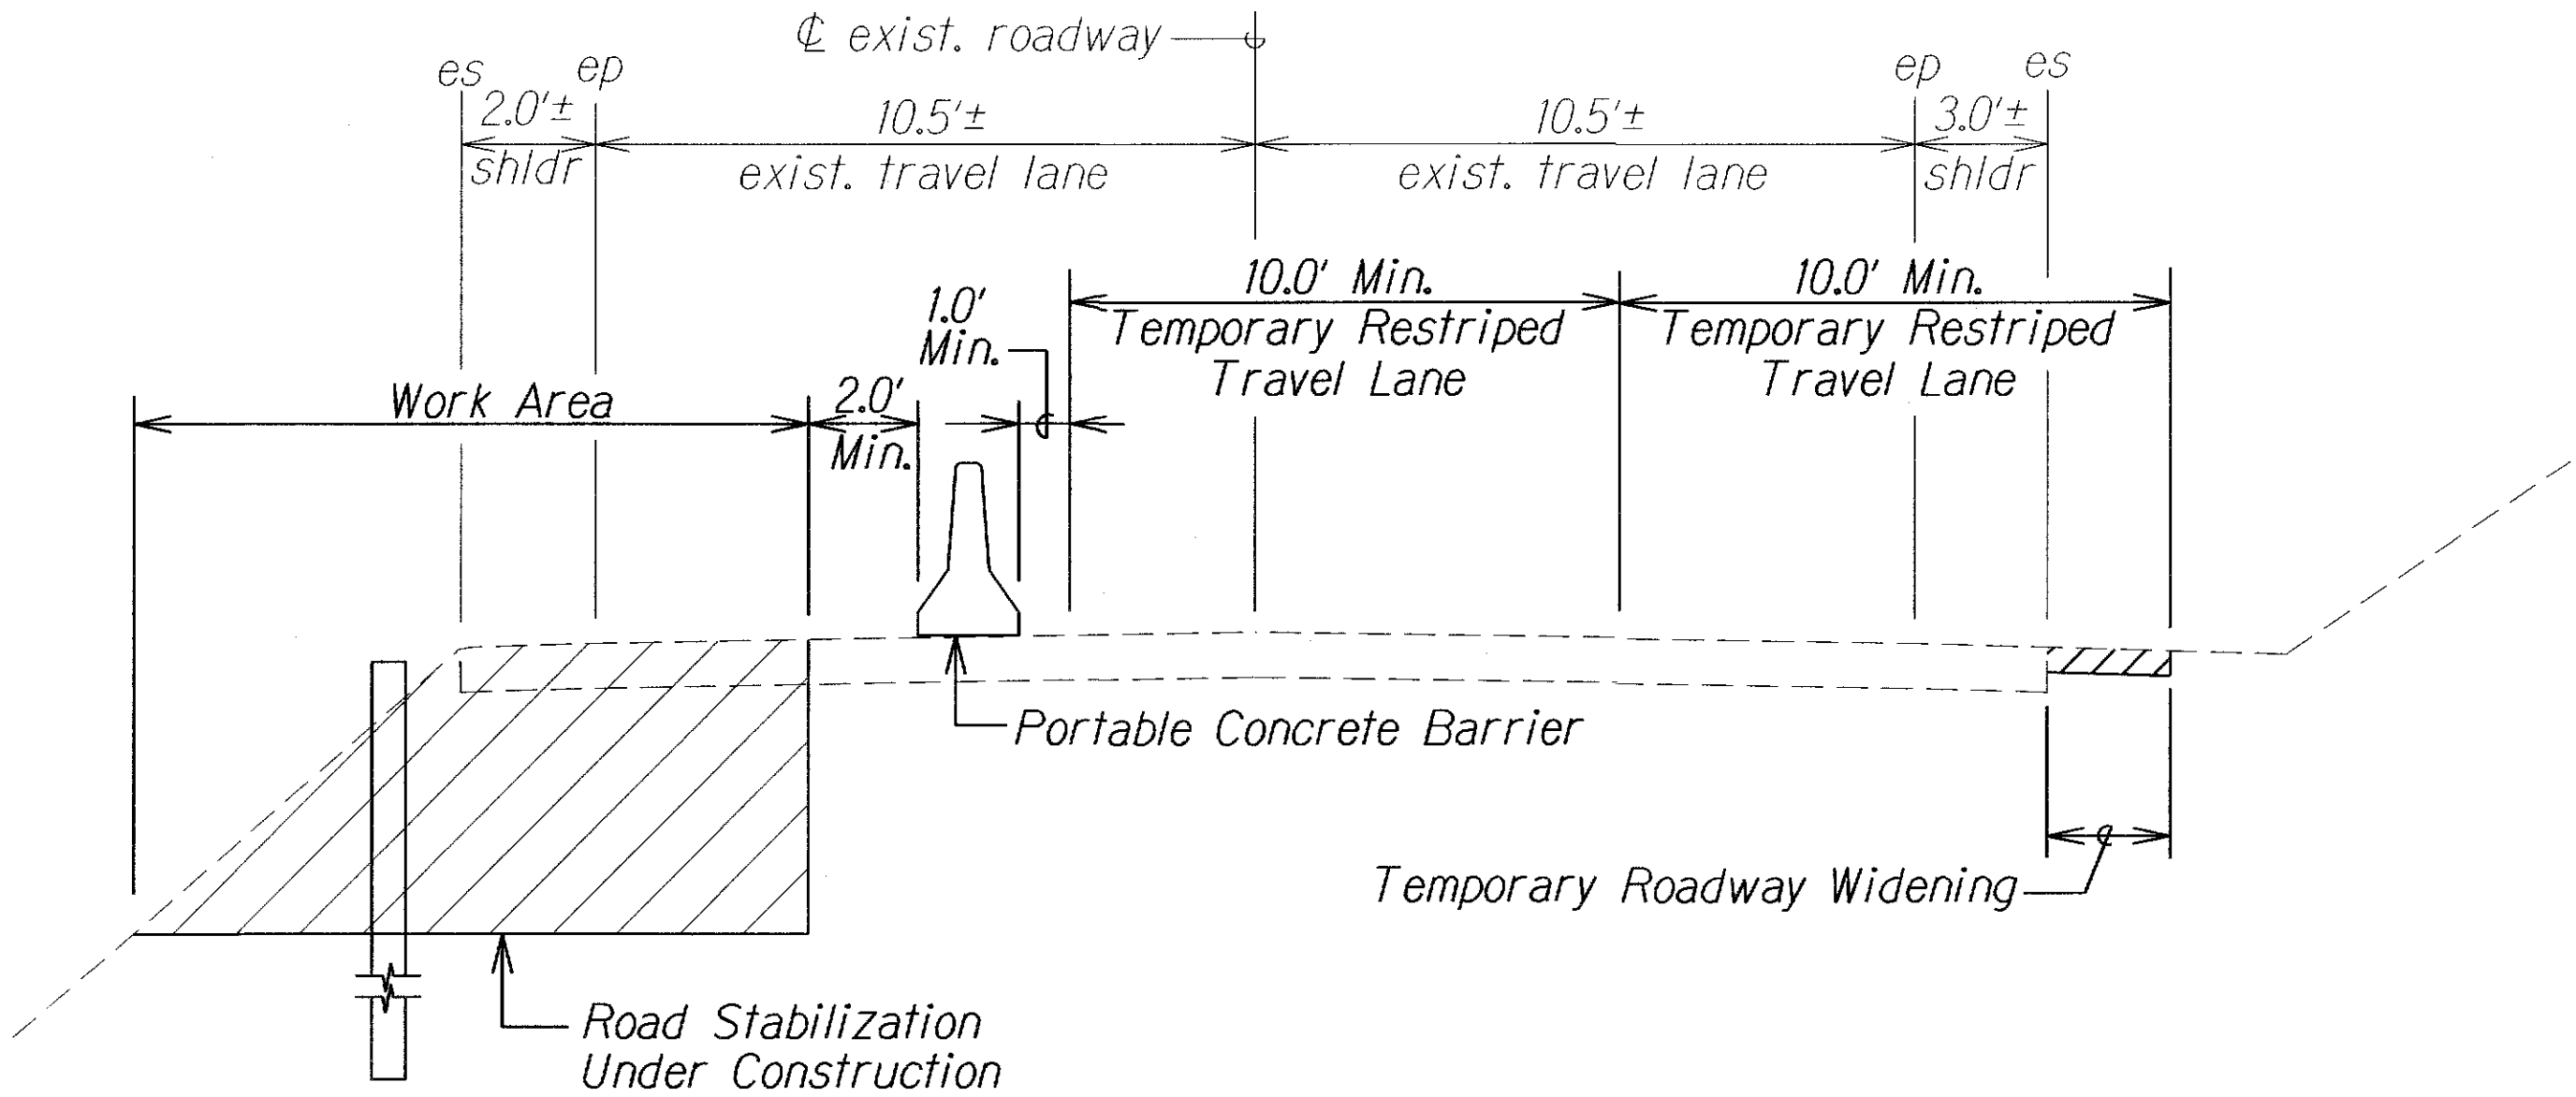

PORTABLE CONCRETE BARRIER POSITION DETAIL FOR ROAD STABILIZATION WORK
 @ STA. 1292+85± TO @ STA. 1294+35±

Scale: Not to Scale

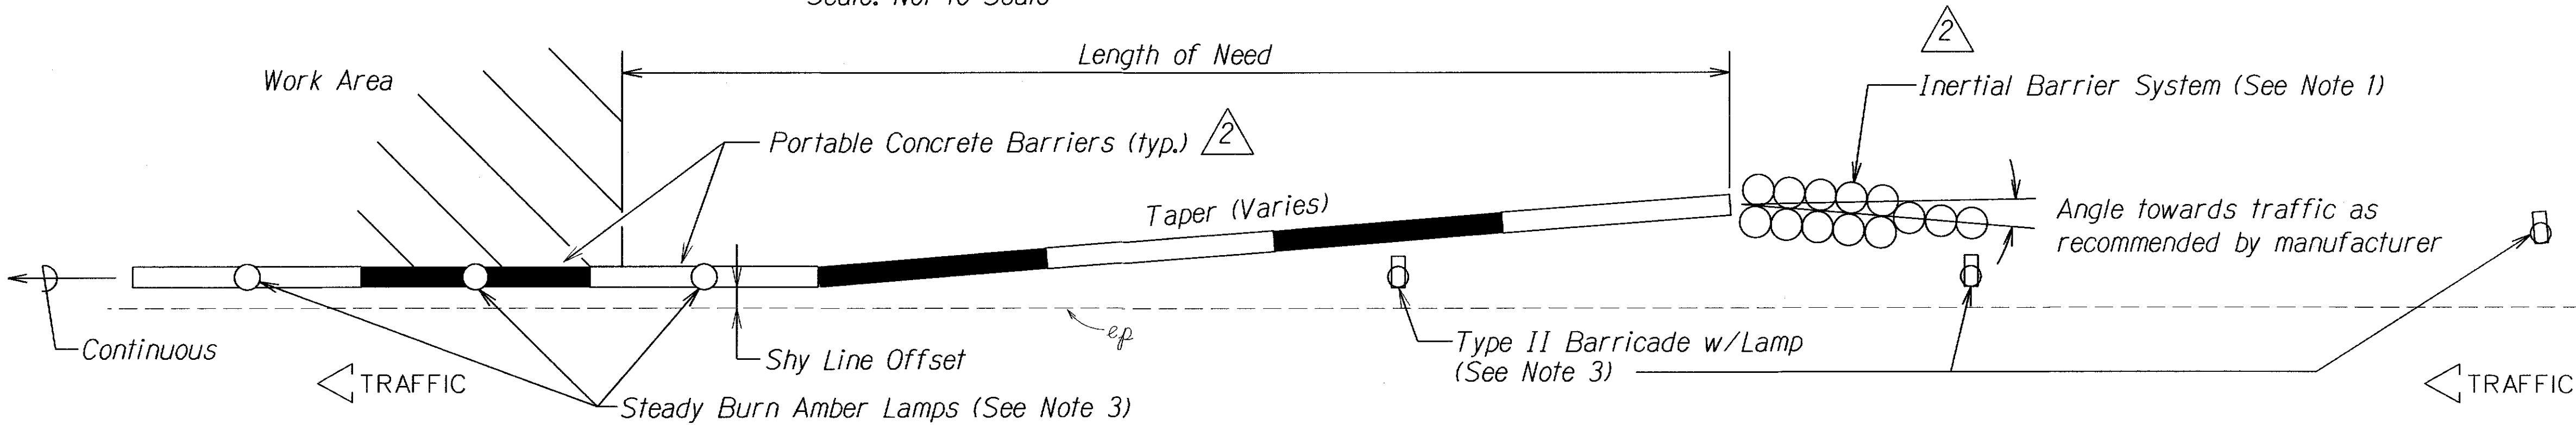

TYPICAL DETAIL - PORTABLE CONCRETE BARRIER INSTALLATION

Scale: N.T.S.

Notes:

1. Inertial Barrier System shall comply with the manufacturer's recommendations/requirements and shall be paid under Contract Item No. 695.2000 - Inertial Barrier System.
2. Place Type II Barricade w/Lamp at spacings and positions that comply with part 6 of the MUTCD, Typical Application 5, and install steady burn amber lamps on Portable Concrete Barriers @ 20.0' o.c. Installing, maintaining and removing each steady burn amber lamp including changing of batteries and bulbs shall be considered incidental to Contract Item No. 695.1000 - State-Furnished Portable Concrete Barrier.
3. Travel Lanes shall be temporarily restriped and adjusted to 10 feet to accommodate Portable Concrete Barrier Installation and use. Following the completion of road stabilization work, Travel Lanes shall be striped according to the traffic plans. This work shall be considered incidental to Contract Item No. 695.1000 - State-Furnished Portable Concrete Barrier and shall not be paid for separately.
4. The Contractor shall develop a Traffic Control Plan to include all necessary Traffic Control Devices. This work shall be considered incidental to Contract Item No. 645.0100 - Traffic Control and shall not be paid for separately.

6/7/16	Revised various notes.
6/2/16	Added new sheet.

DATE REVISION

STATE OF HAWAII
 DEPARTMENT OF TRANSPORTATION
 HIGHWAYS DIVISION

TEMPORARY PORTABLE CONCRETE BARRIER PLAN

FARRINGTON HIGHWAY RESURFACING

Vicinity of Kili Drive to

Satellite Tracking Station Road

Federal Aid Project No. STP-093-1(026)

Scale: Not to Scale Date: April, 2016

SHEET No. 8 OF 12 SHEETS

ADD. 17S-1