


FED. ROAD DIST. NO.	STATE	FED. AID PROJ. NO.	FISCAL YEAR	SHEET NO.	TOTAL SHEETS
HAWAII	HAW.	STP-093-1(026)	2016	40R	110

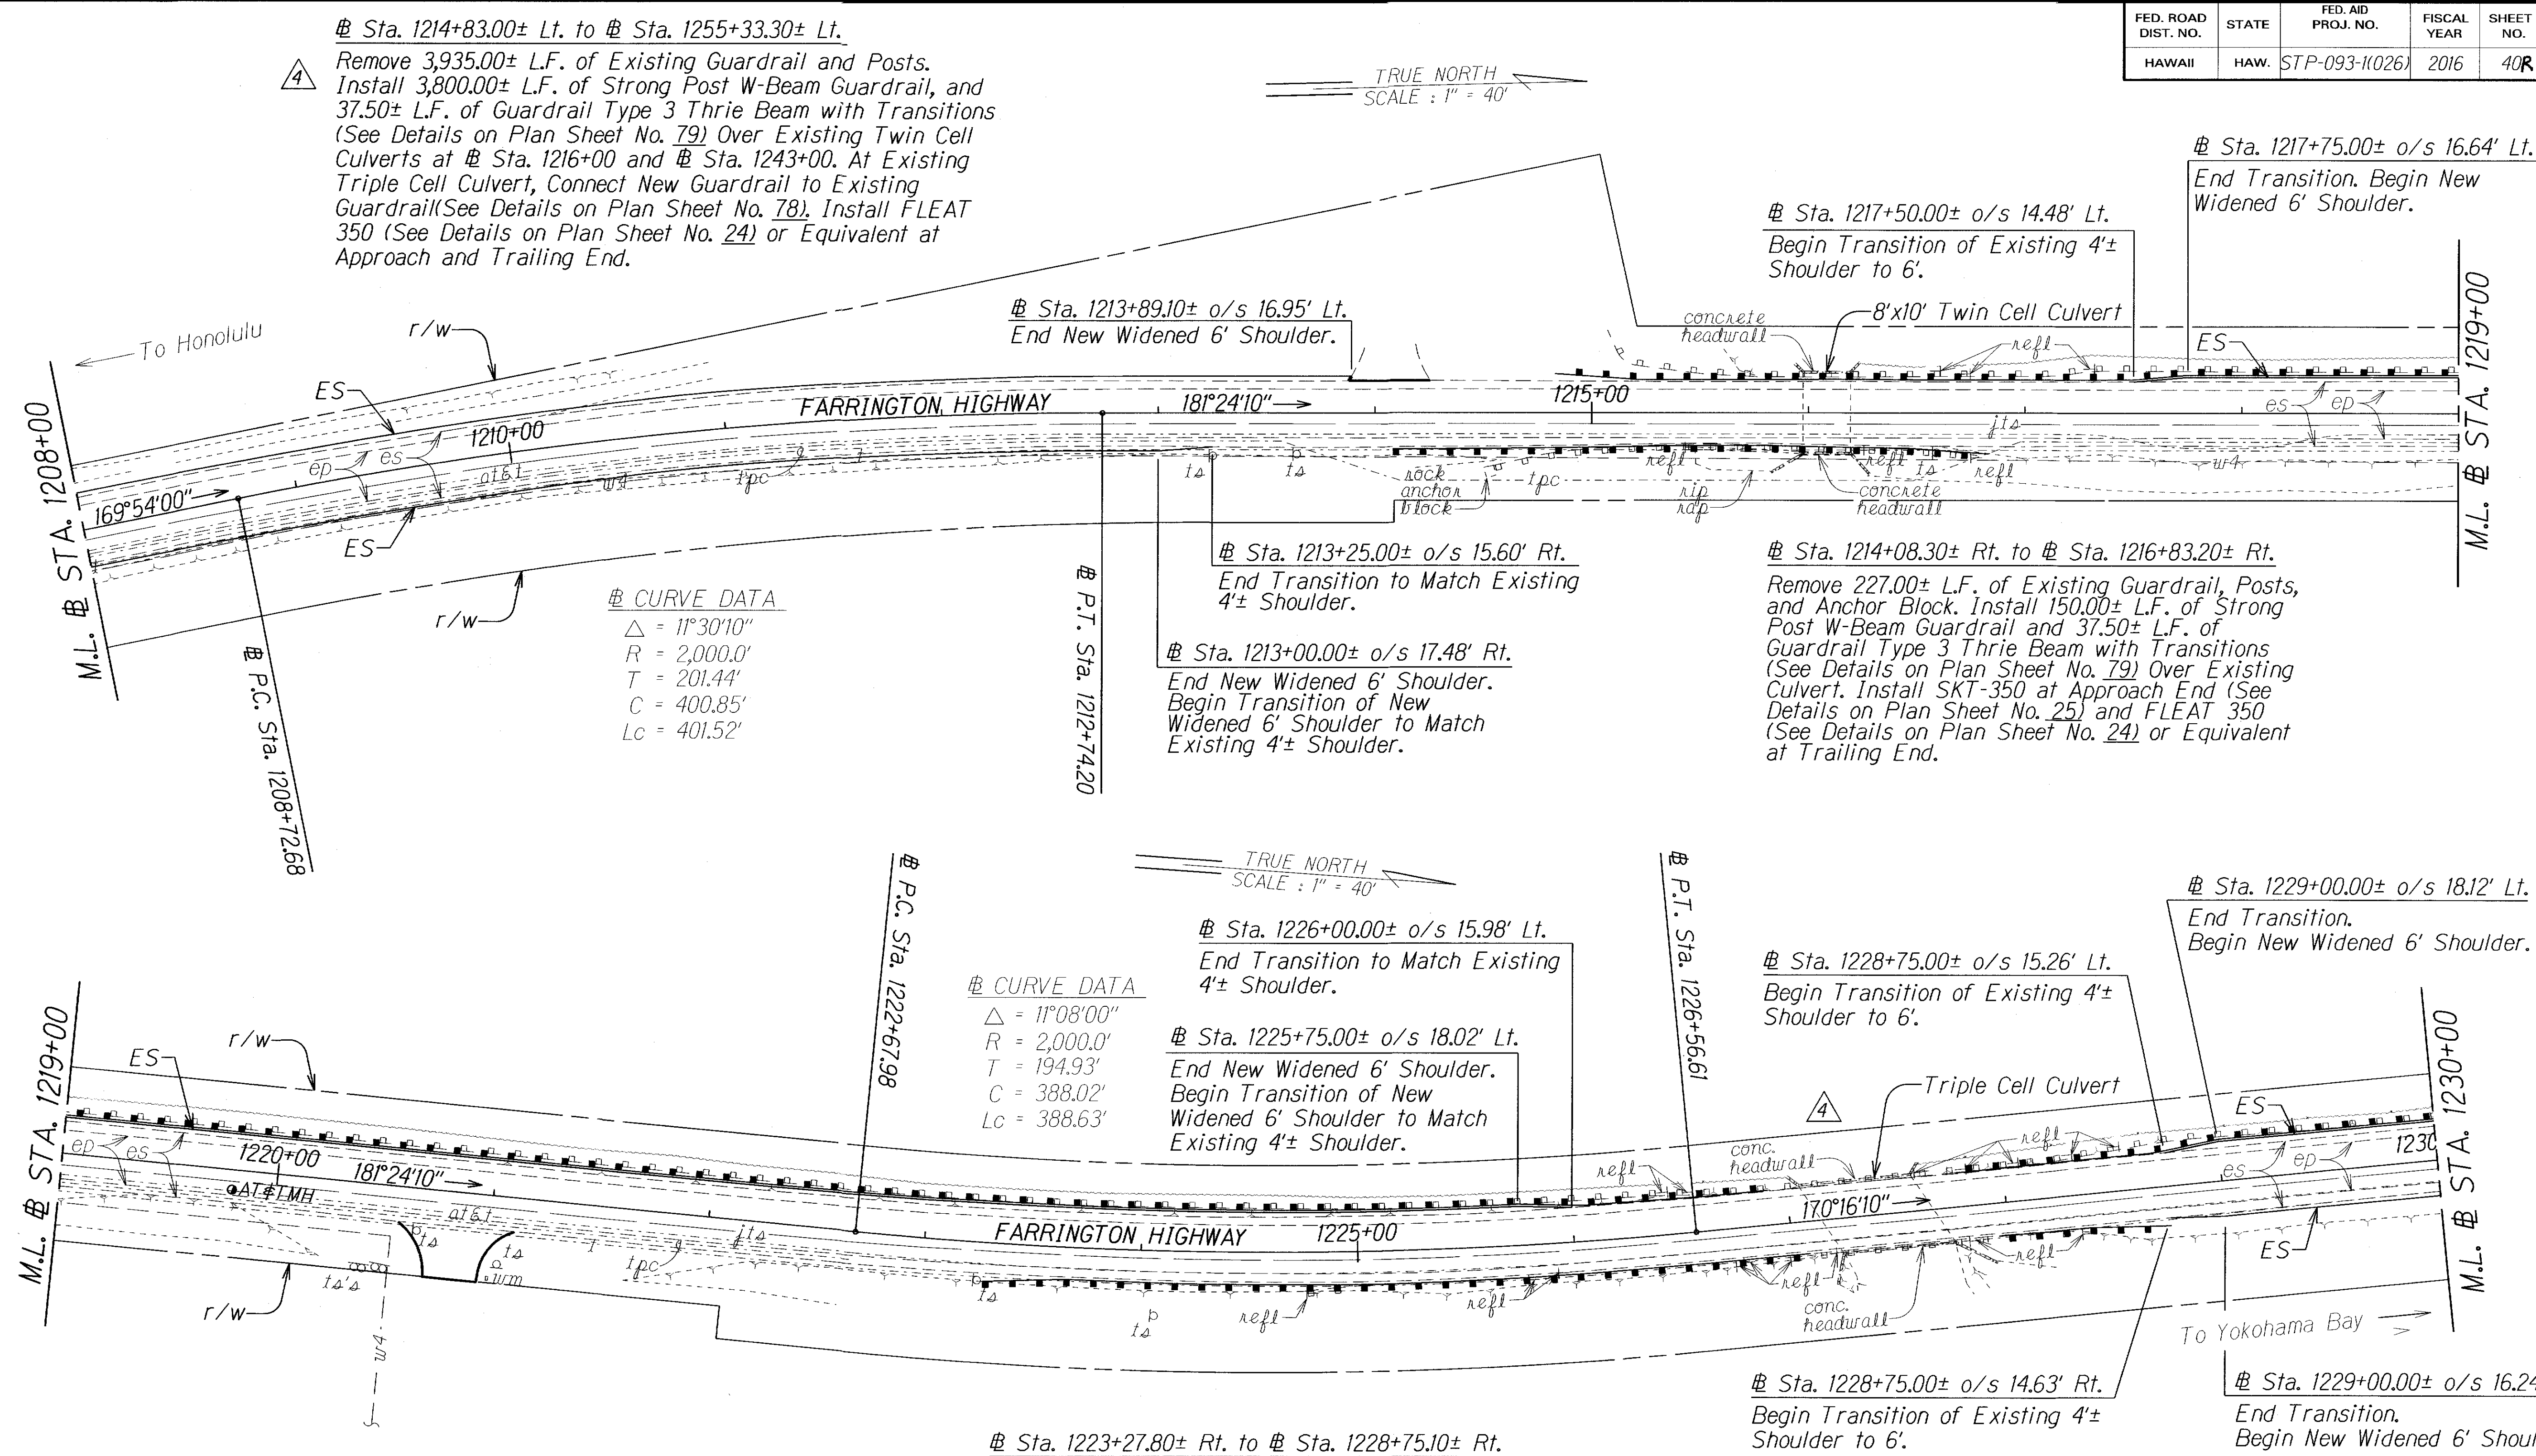

Note:

- Based on requirements resulting from NHPA Section 106 Consultations, the limits of staging area shall be from # Sta. 1211+00 to # Sta. 1215+00 and kept within the State Right-of-way. Driveway/side road access shall not be blocked. See Plan Sheet No. 32 for other staging area location.
- For pavement design of shoulder widening, see Typical Sections.
- Removal and disposal of existing guardrail, posts, and anchor block shall be considered incidental to New Guardrail.

4	6/16/16	Revised per Addendum #4
DATE	REVISION	

STATE OF HAWAII
 DEPARTMENT OF TRANSPORTATION
 HIGHWAYS DIVISION
ROADWAY PLANS
 FARRINGTON HIGHWAY RESURFACING
 Vicinity of Kili Drive to
 Satellite Tracking Station Road
 Federal Aid Project No. STP-093-1(026)
 Scale 1"=40' Date: April, 2016
 SHEET No. 10 OF 14 SHEETS

DATE	
SURVEY BLANKET BY	
PLAN	
DRAWN BY	
DESIGNED BY	
CHECKED BY	
NOTED BY	
QUANTITIES BY	
NO. 411101	