
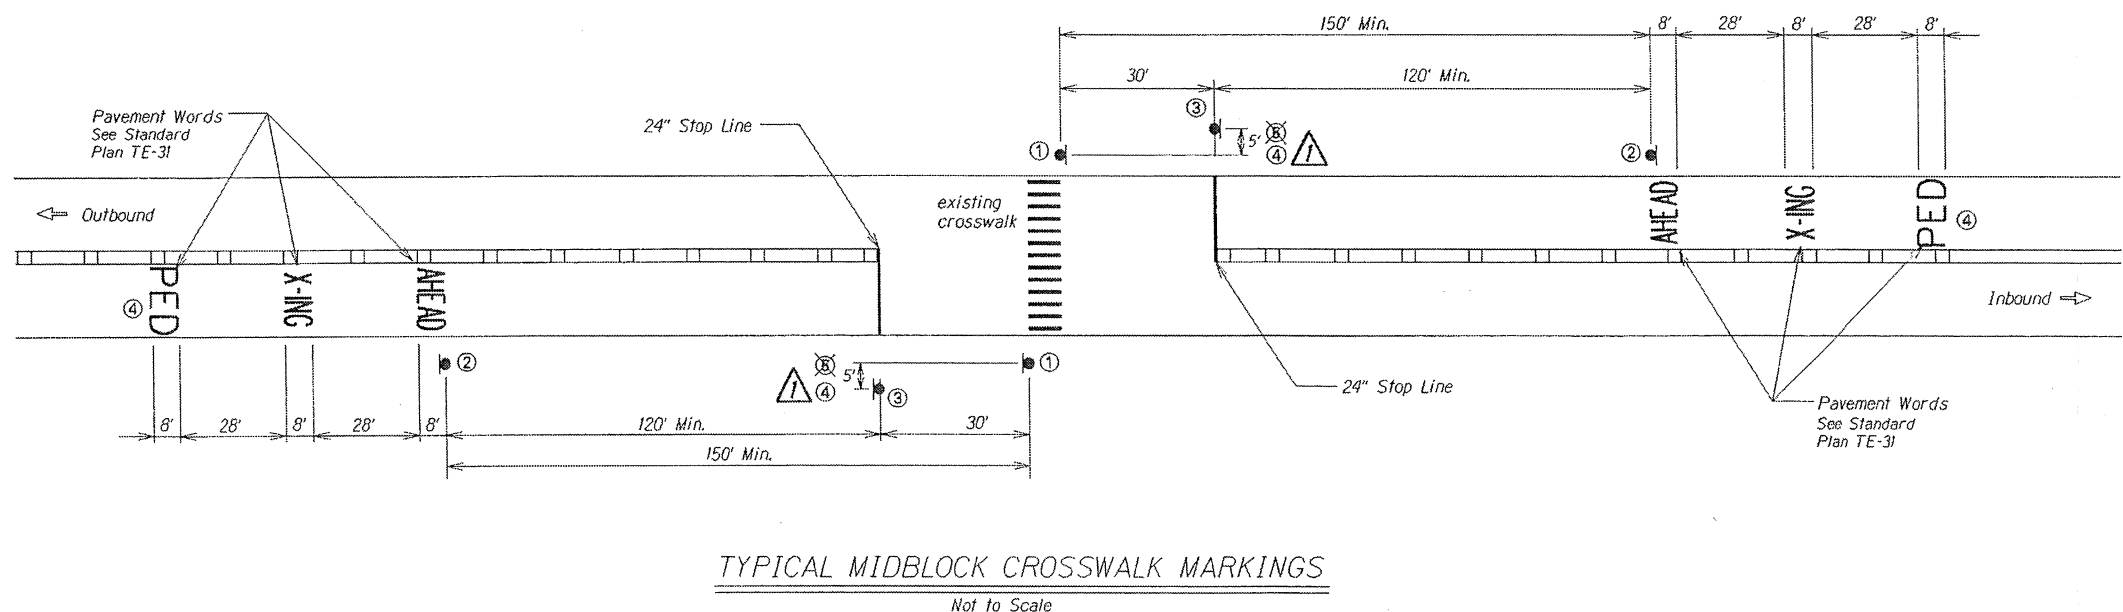
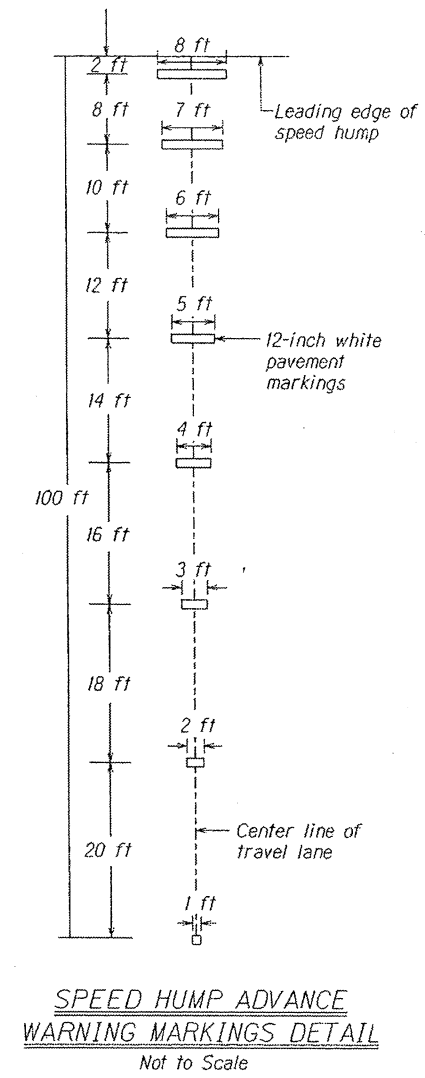
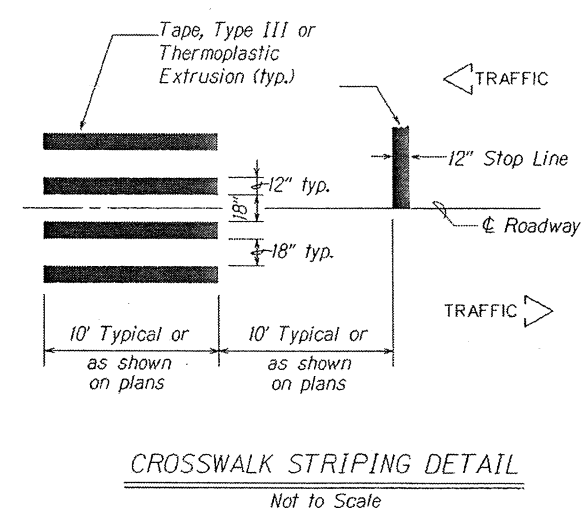


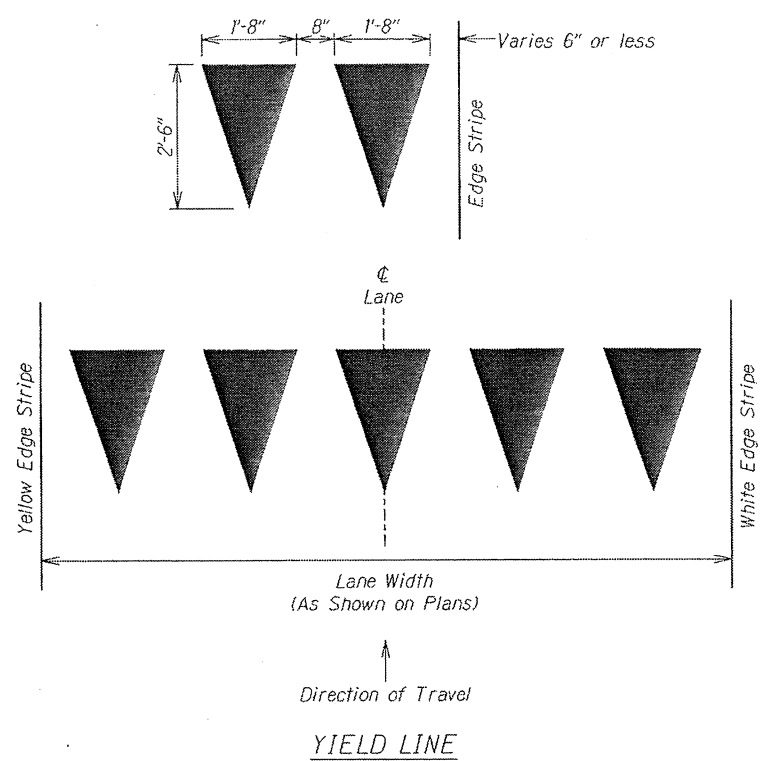

①

W11-2
30"x30"
36"x36"

W16-7p
24"x12"

Black legend on flourescent yellow green background

②

STOP
HERE
FOR
PEDESTRIANS

Revised R1-5aL
30"x36"
36"x42"

Black legend on white background
See attached sheet for detail

NOTE:
Offset 5' horizontally with crossing sign.
Do not install if insufficient space to offset signs.

③

W11-2
30"x30"
36"x36"

W16-9p
24"x12"

AHEAD

Black legend on flourescent yellow green background

④

NOTE:
If distance is <50', offset Stop Here For Pedestrians sign 5' horizontally with crossing sign.

DATE	6/13/16	Revised reference number
DATE		REVISION
STATE OF HAWAII DEPARTMENT OF TRANSPORTATION HIGHWAYS DIVISION PAVEMENT MARKING LEGEND, DETAILS & NOTES FARRINGTON HIGHWAY RESURFACING Vicinity of Kili Drive to Satellite Tracking Station Road Federal Aid Project No. STP-093-1(026) Scale: As Noted Date: Apr., 2016 SHEET No. 72 OF 22 SHEETS		


SURVEY PLOTTED BY: _____
 DATE: _____
 DRAWN BY: _____
 CHECKED BY: _____
 NOTE BOOK: _____
 QUANTITIES BY: _____
 CHECKED BY: _____
 ORIGINAL PLAN: _____
 DATE: _____

FED. ROAD DIST. NO.	STATE	FED. AID PROJ. NO.	FISCAL YEAR	SHEET NO.	TOTAL SHEETS
HAWAII	HAW.	STP-093-K026	2016	ADD. 100	110

STA. 1172+76 to # STA. 1303+02
Install Centerline Milled Rumble Strip;
See detail on Plan Sheet No. T20.

STA. 1298+88 Lt. to # STA. 1301+62 Lt.
Install Shoulder Milled Rumble Strip;
See detail on Plan Sheet No. T22.

STA. 1304+30 to # STA. 1304+70
Install Centerline Milled Rumble Strip;
See detail on Plan Sheet No. T20.

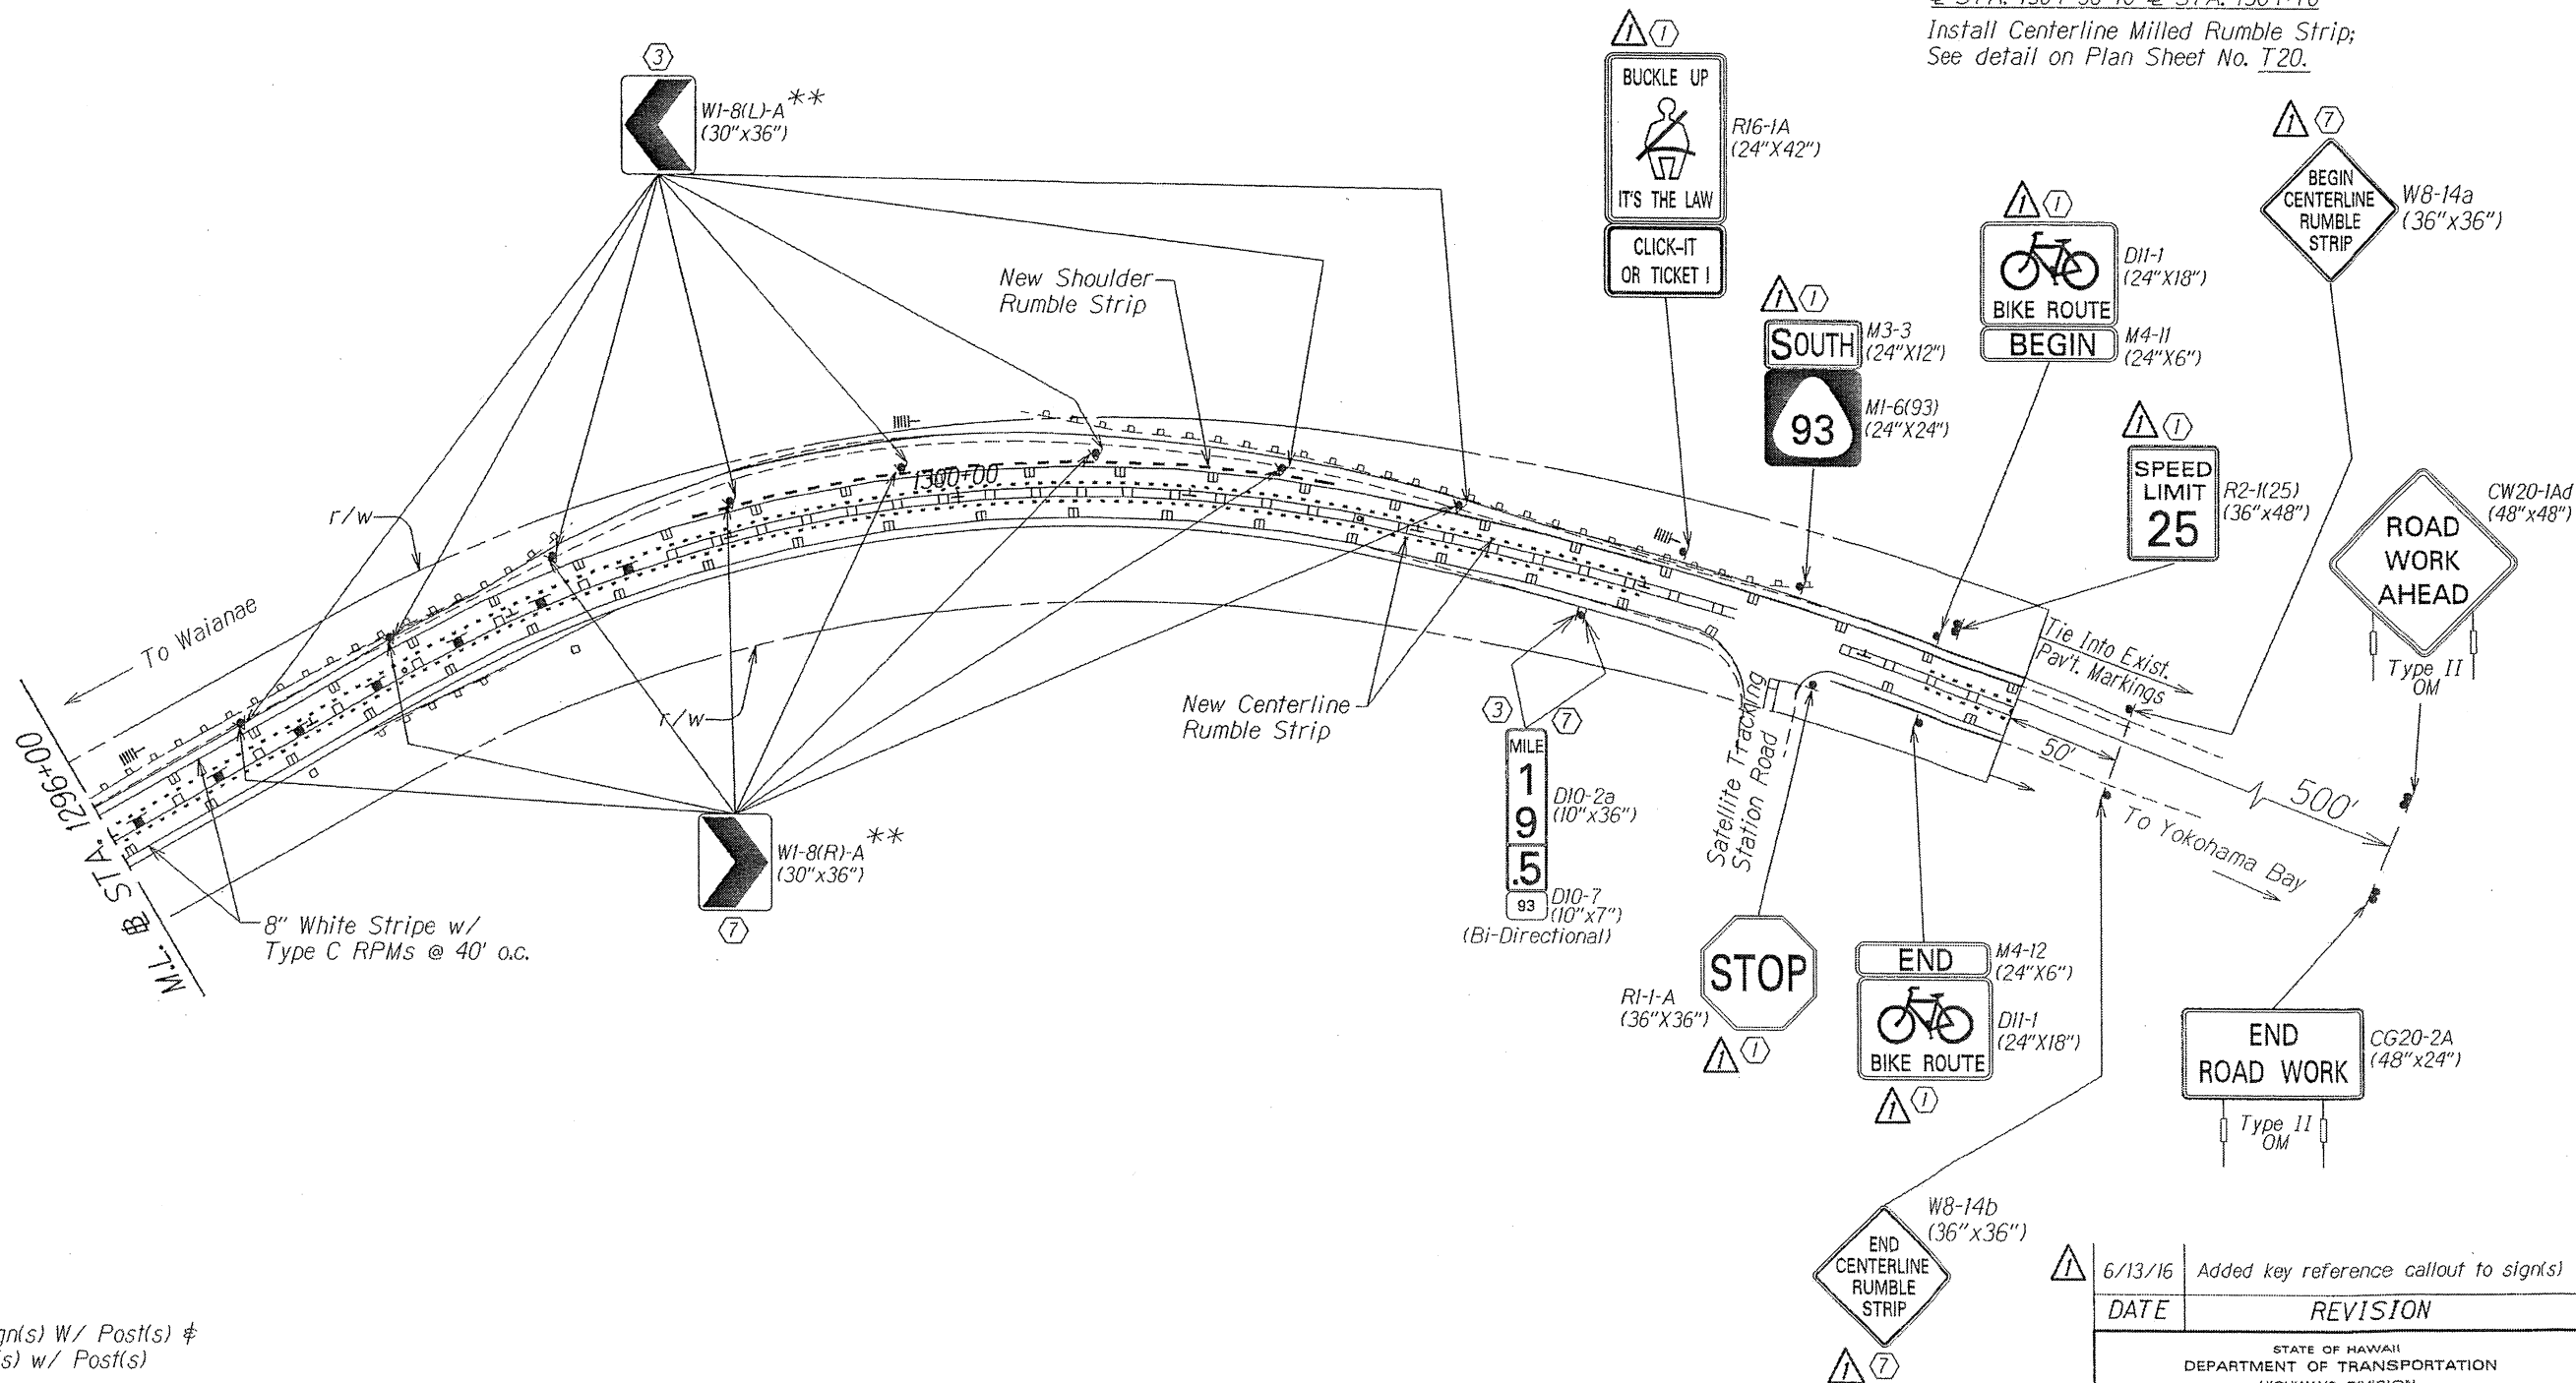

KEY:

- ① Remove Exist. Sign(s) w/ Post(s) & Install New Sign(s) w/ Post(s)
- ② Remove Exist. Sign(s)
- ③ Install New Sign(s)
- ④ Exist. Sign(s) & Post(s) to Remain
- ⑤ Remove Exist. Sign(s) w/ Post(s)
- ⑥ Exist. Sign(s) to Remain
- ⑦ Install New Sign(s) w/ Post(s)
- ⑧ Remove Exist. Sign(s) & Install New Sign(s)

**Fluorescent Yellow Sign Sheeting

LEGEND:

- ||— Reflector Marker (RM-2, White) w/ Flexible Post
- ||||— Reflector Marker (RM-5, White)

NOTE:

||||— Reflector Markers (RM-5) shall be mounted every 25 feet on all new and existing metal guardrails except on Terminal Sections. For new guardrail installation, furnishing and installing of each RM-5 shall be considered incidental to the adjacent guardrail system. Unless otherwise noted, the Contractor shall be responsible for mounting RM-5s on all existing metal guardrails even when not shown on plans.

6/13/16	Added key reference callout to sign(s)
DATE	REVISION
STATE OF HAWAII DEPARTMENT OF TRANSPORTATION HIGHWAYS DIVISION	
PAVEMENT MARKING & SIGNING PLAN	
FARRINGTON HIGHWAY RESURFACING	
Vicinity of Kili Drive to Satellite Tracking Station Road	
Federal Aid Project No. STP-093-K026	
Scale 1"=40'	Date: Apr., 2016
SHEET No. T18 OF 22 SHEETS	

ADD. 100