

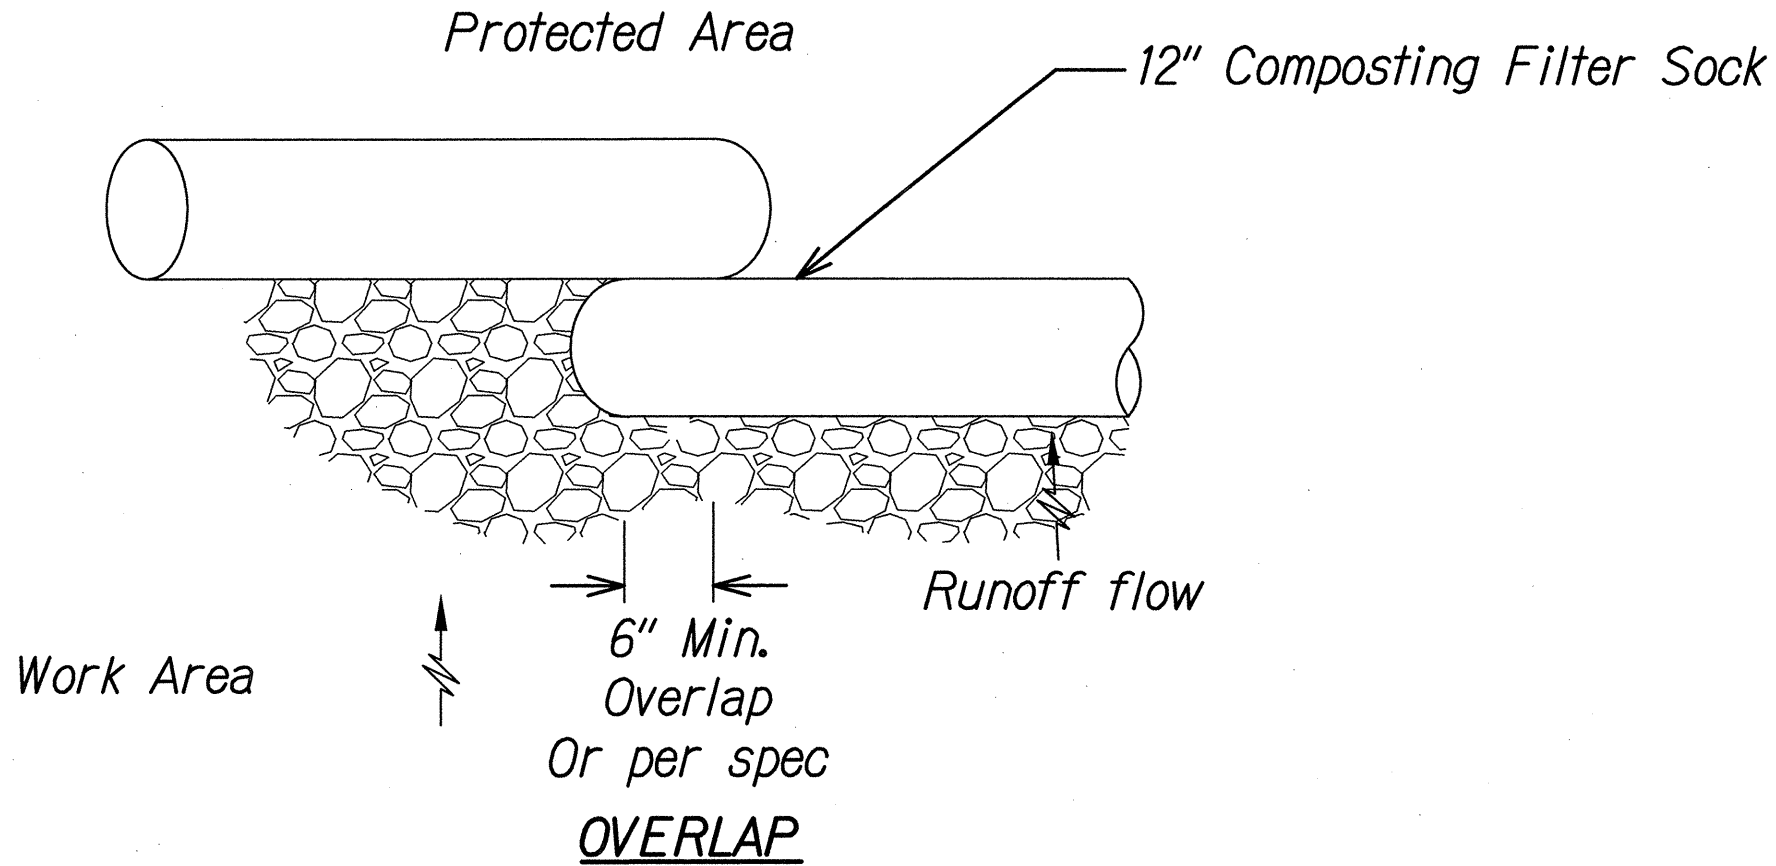



FED. ROAD DIST. NO.	STATE	PROJ. NO.	FISCAL YEAR	SHEET NO.	TOTAL SHEETS
HAWAII	HAW.	93A-01-12	2016	12	29

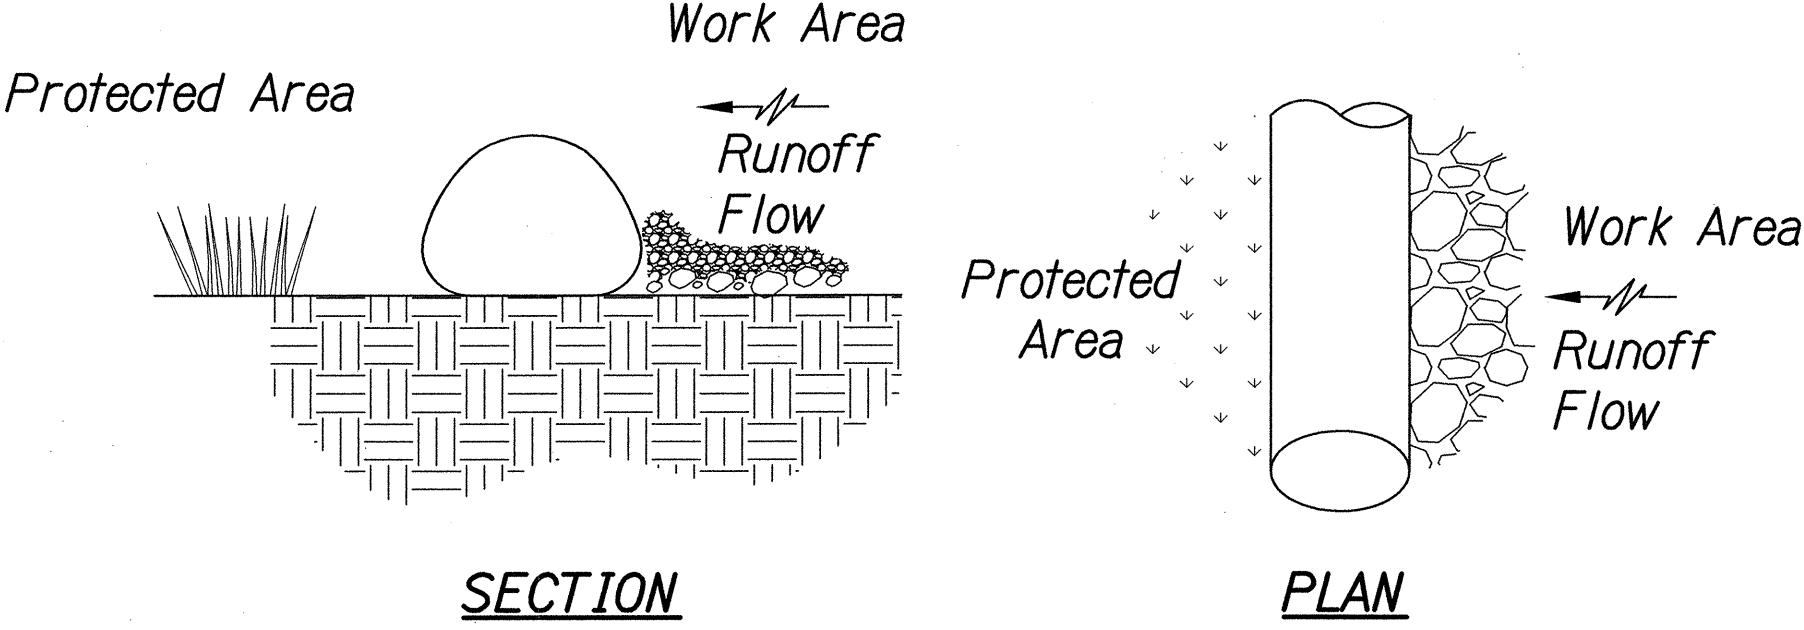

COMPOSTING FILTER SOCK DETAIL

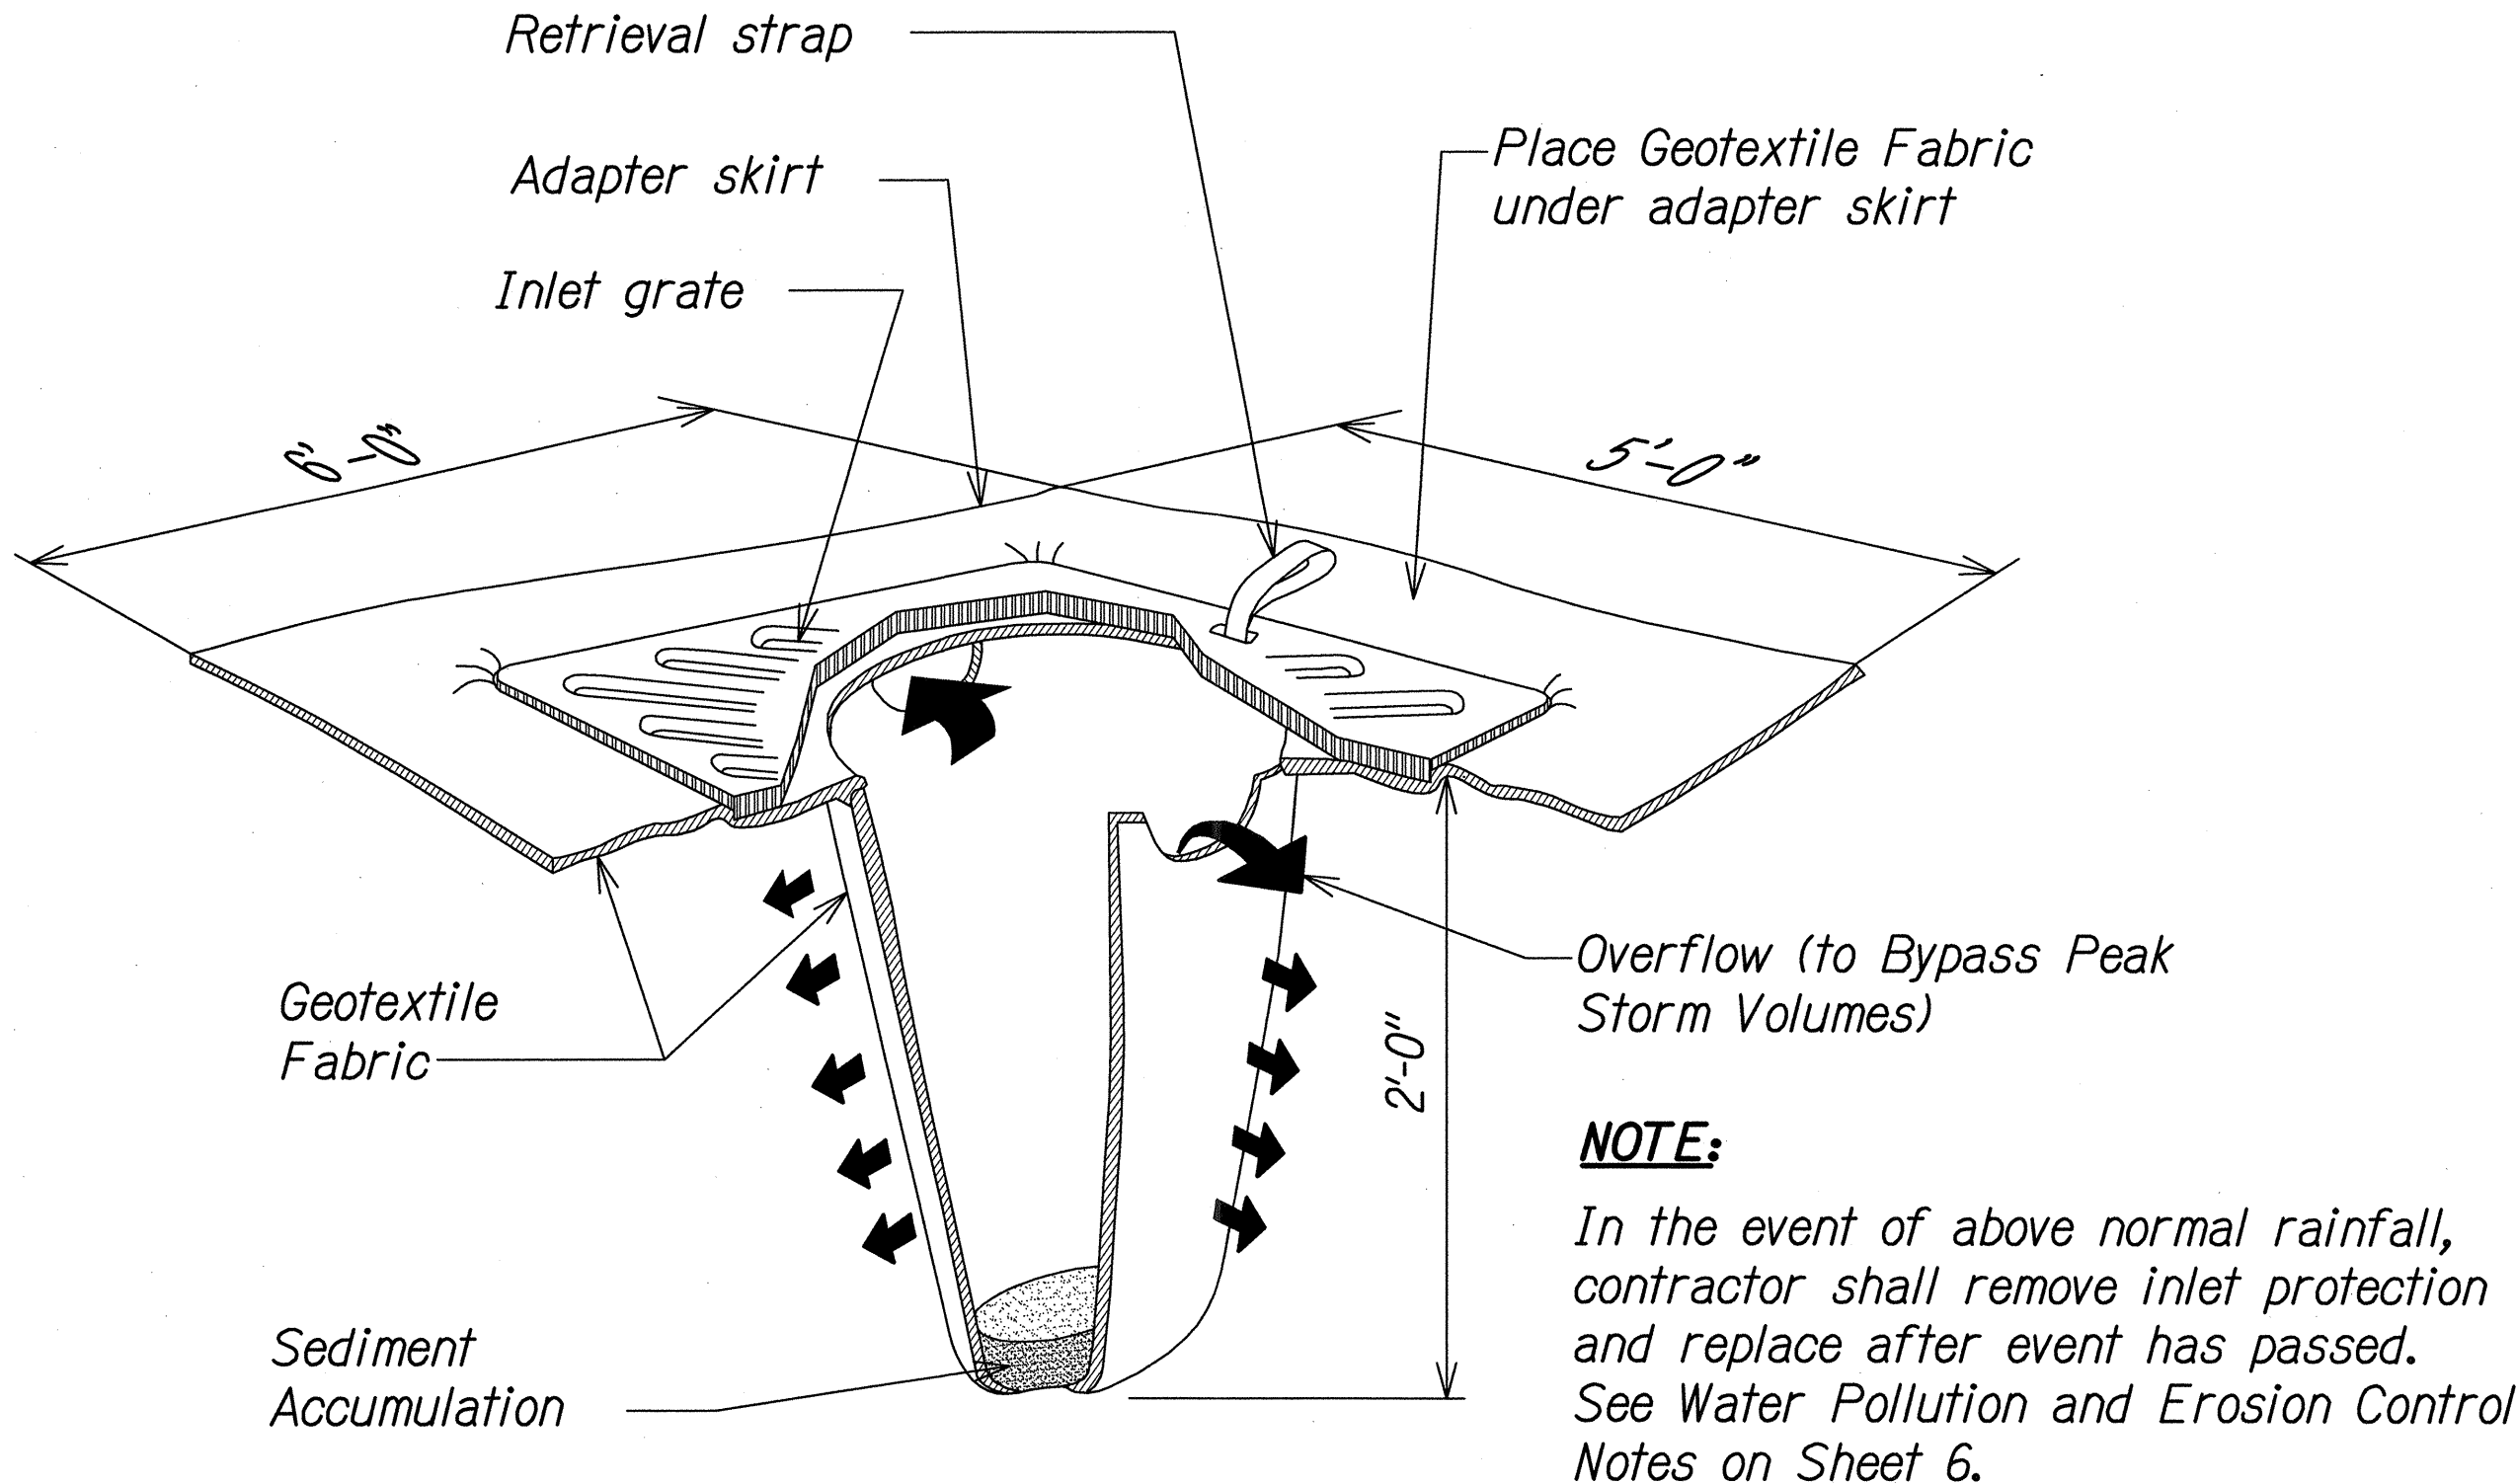


TEMPORARY INLET/DRYWELL PROTECTION

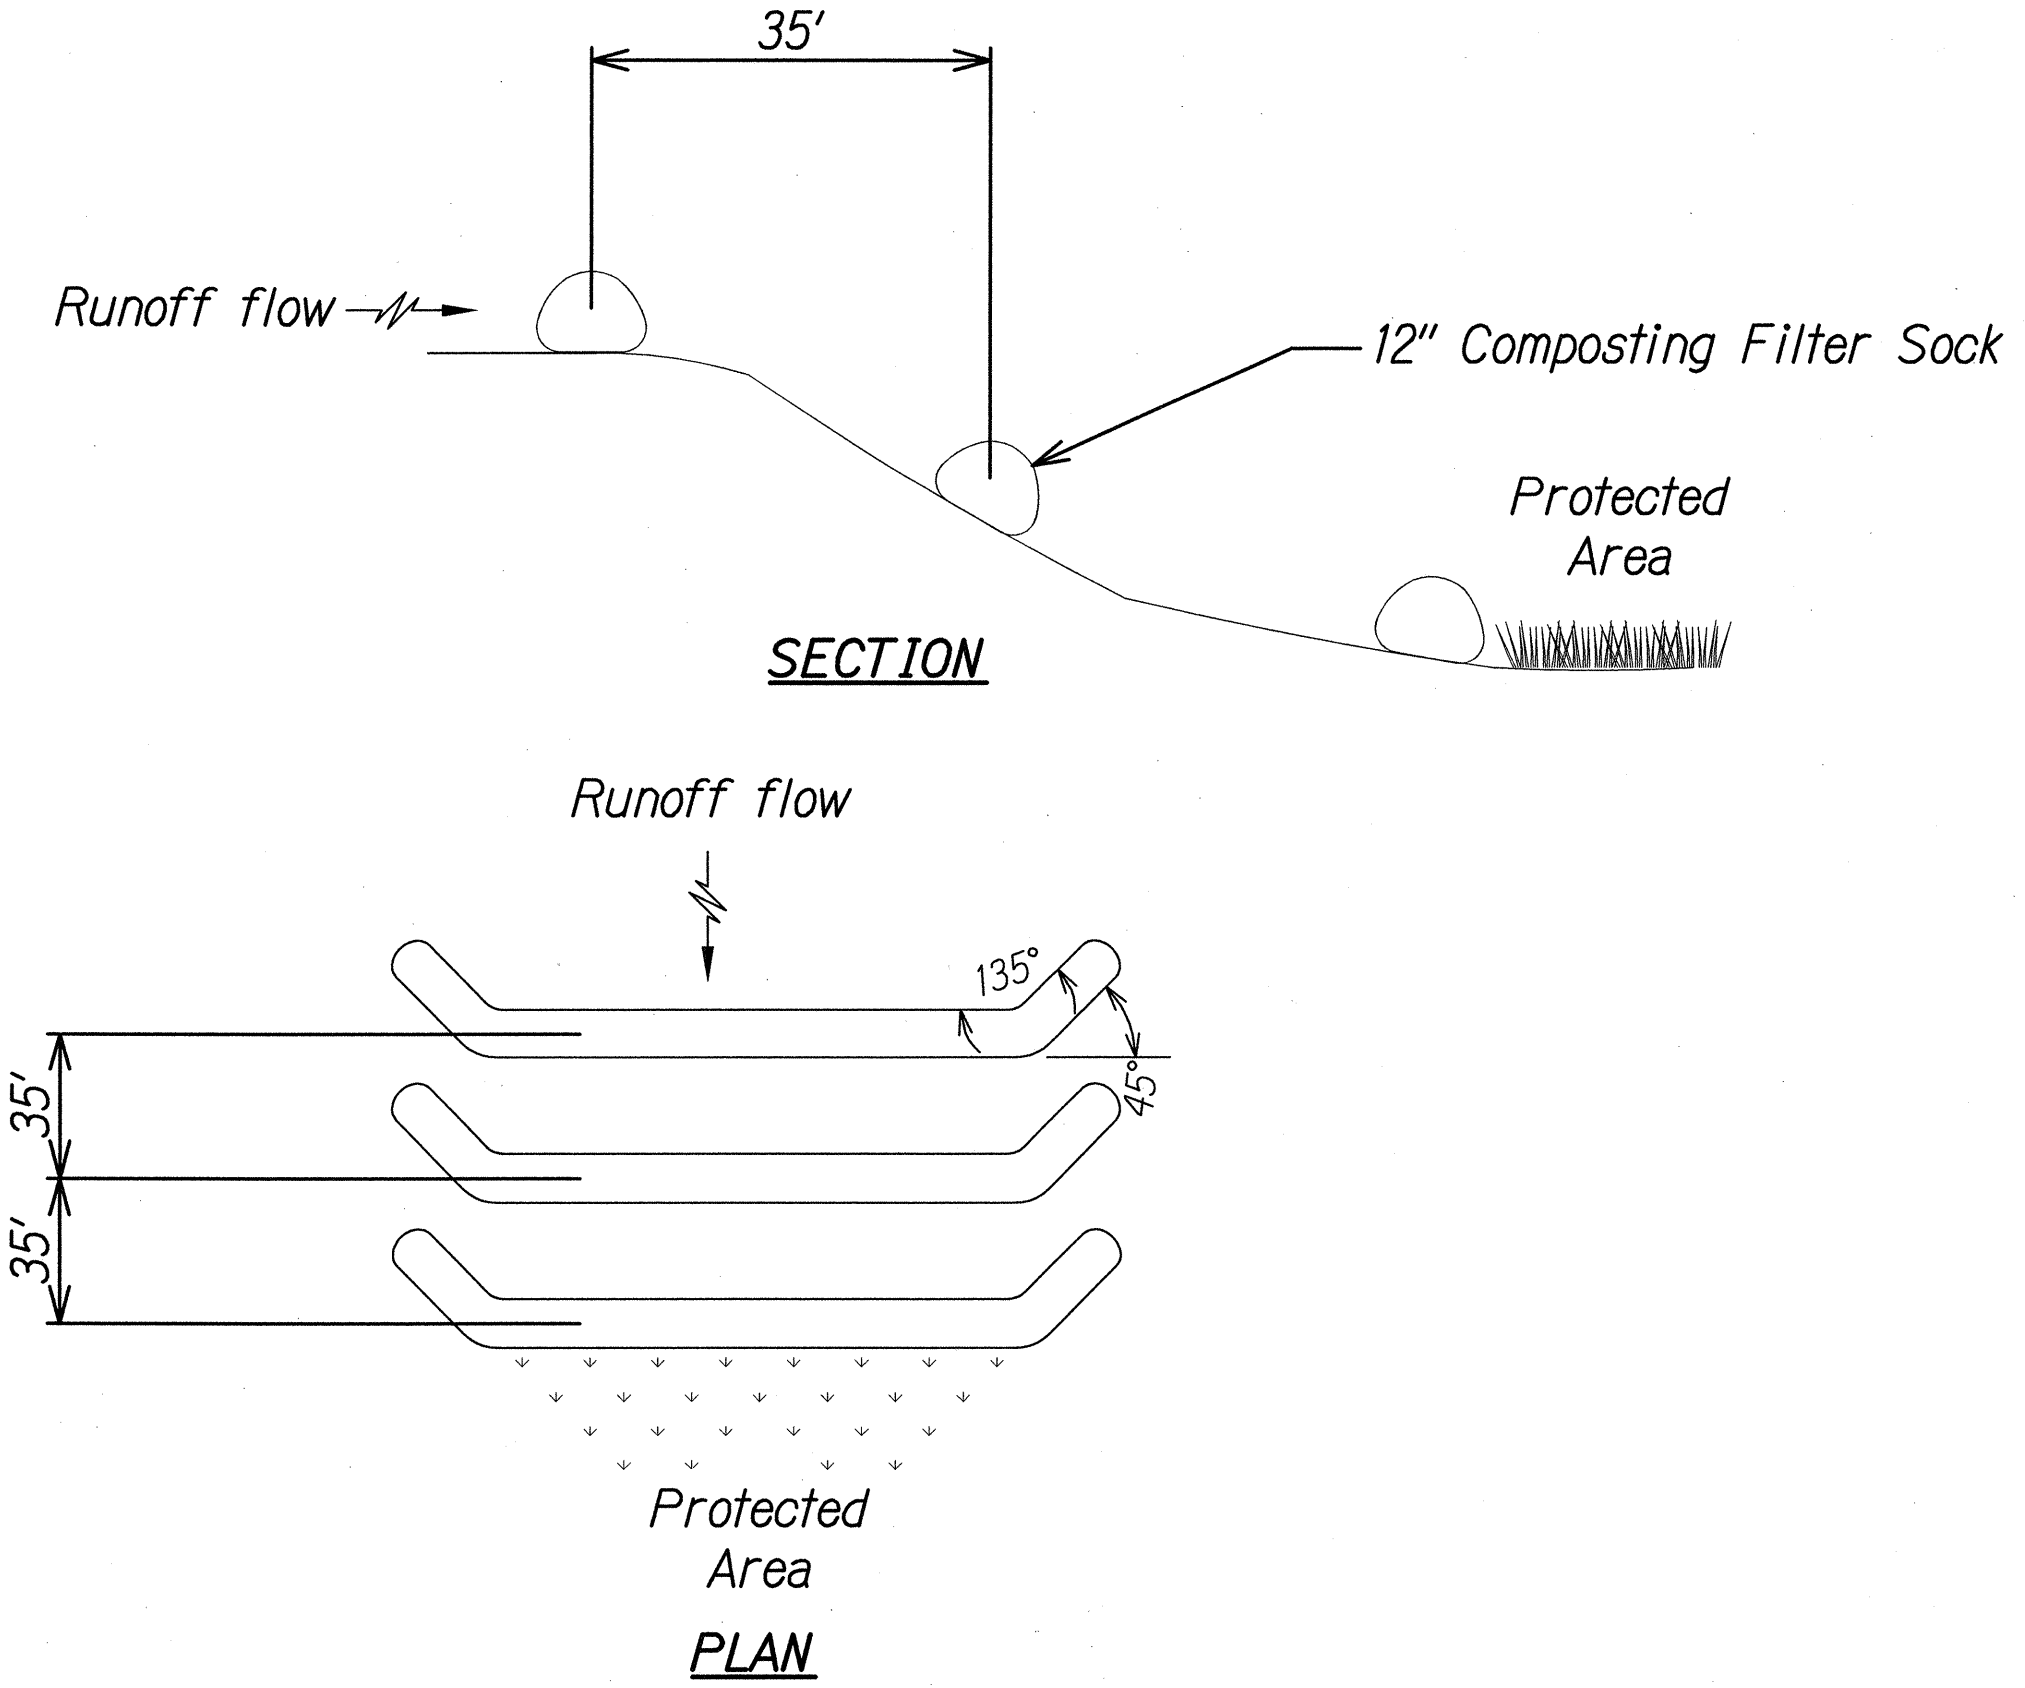

TEMPORARY SLOPE PROTECTION

SURVEY PLOTTED BY	DATE
DRAWN BY	
TRACED BY	
DESIGNED BY	
CHECKED BY	
ORIGINAL PLAN	
NOTE BOOK	
No.	

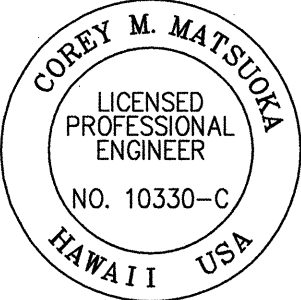

THIS WORK WAS PREPARED BY ME
OR UNDER MY SUPERVISION
Corey Matsuka
SIGNATURE
EXPIRATION DATE OF THE LICENSE 4/30/16

STATE OF HAWAII
DEPARTMENT OF TRANSPORTATION
HIGHWAYS DIVISION

EROSION CONTROL DETAILS
FARRINGTON HIGHWAY DRAINAGE IMPROVEMENTS
Vicinity of Princess Kahanu Avenue
Project No. 93A-01-12
Scale: Not to Scale Date: Oct. 2015
SHEET No. 1 OF 1 SHEETS