




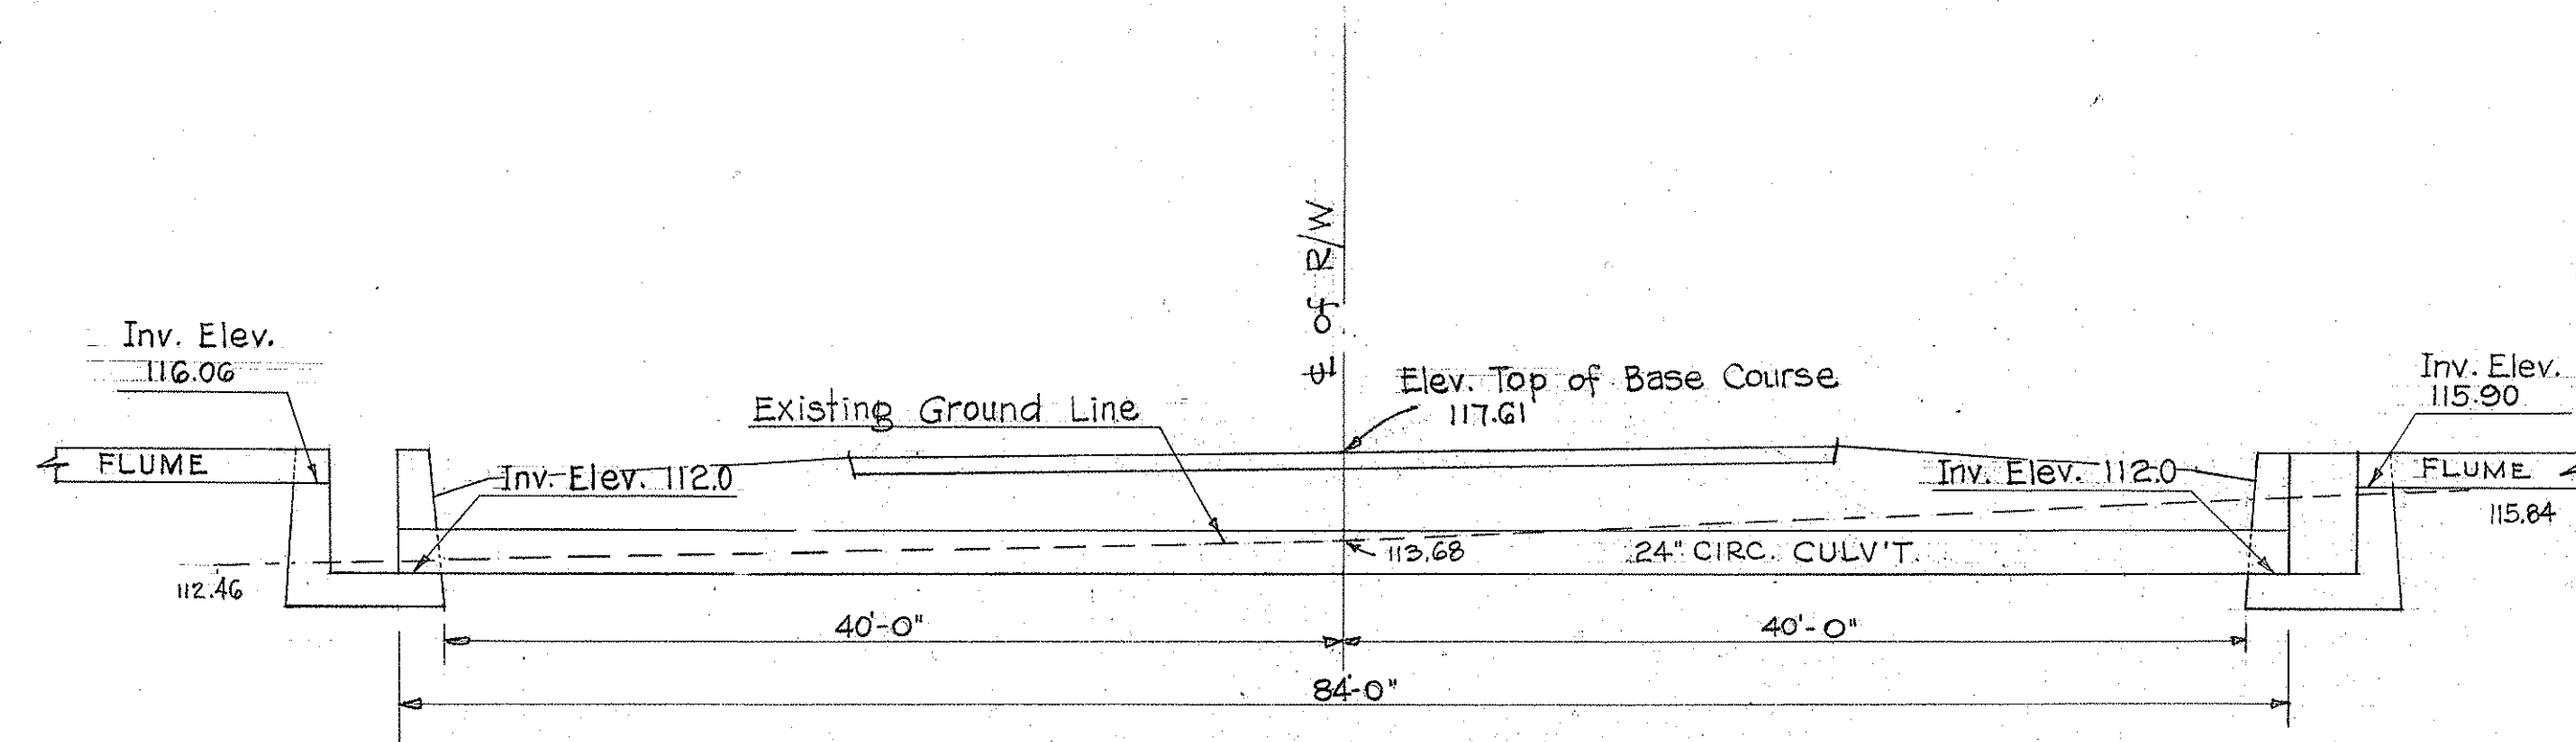

SECTION AT STATION 63+39
Scale: $\frac{1}{8}$ " = 1'-0"

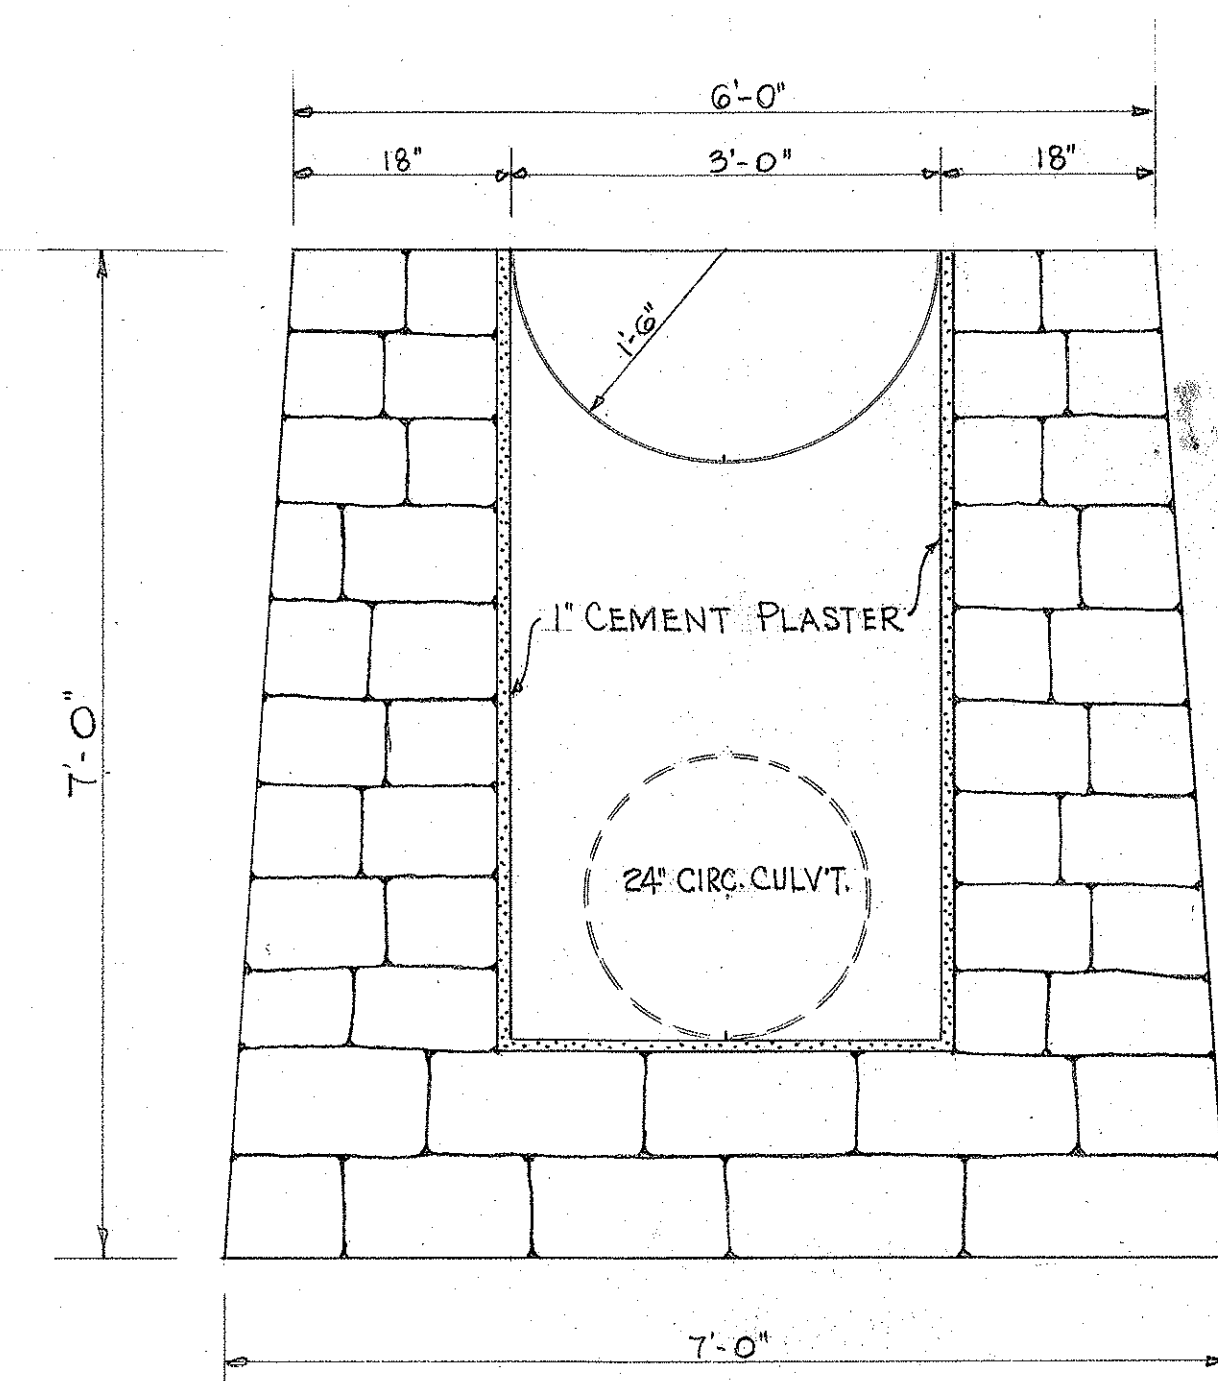

SECTION "A-A"
Scale: $\frac{3}{4}$ " = 1'-0"

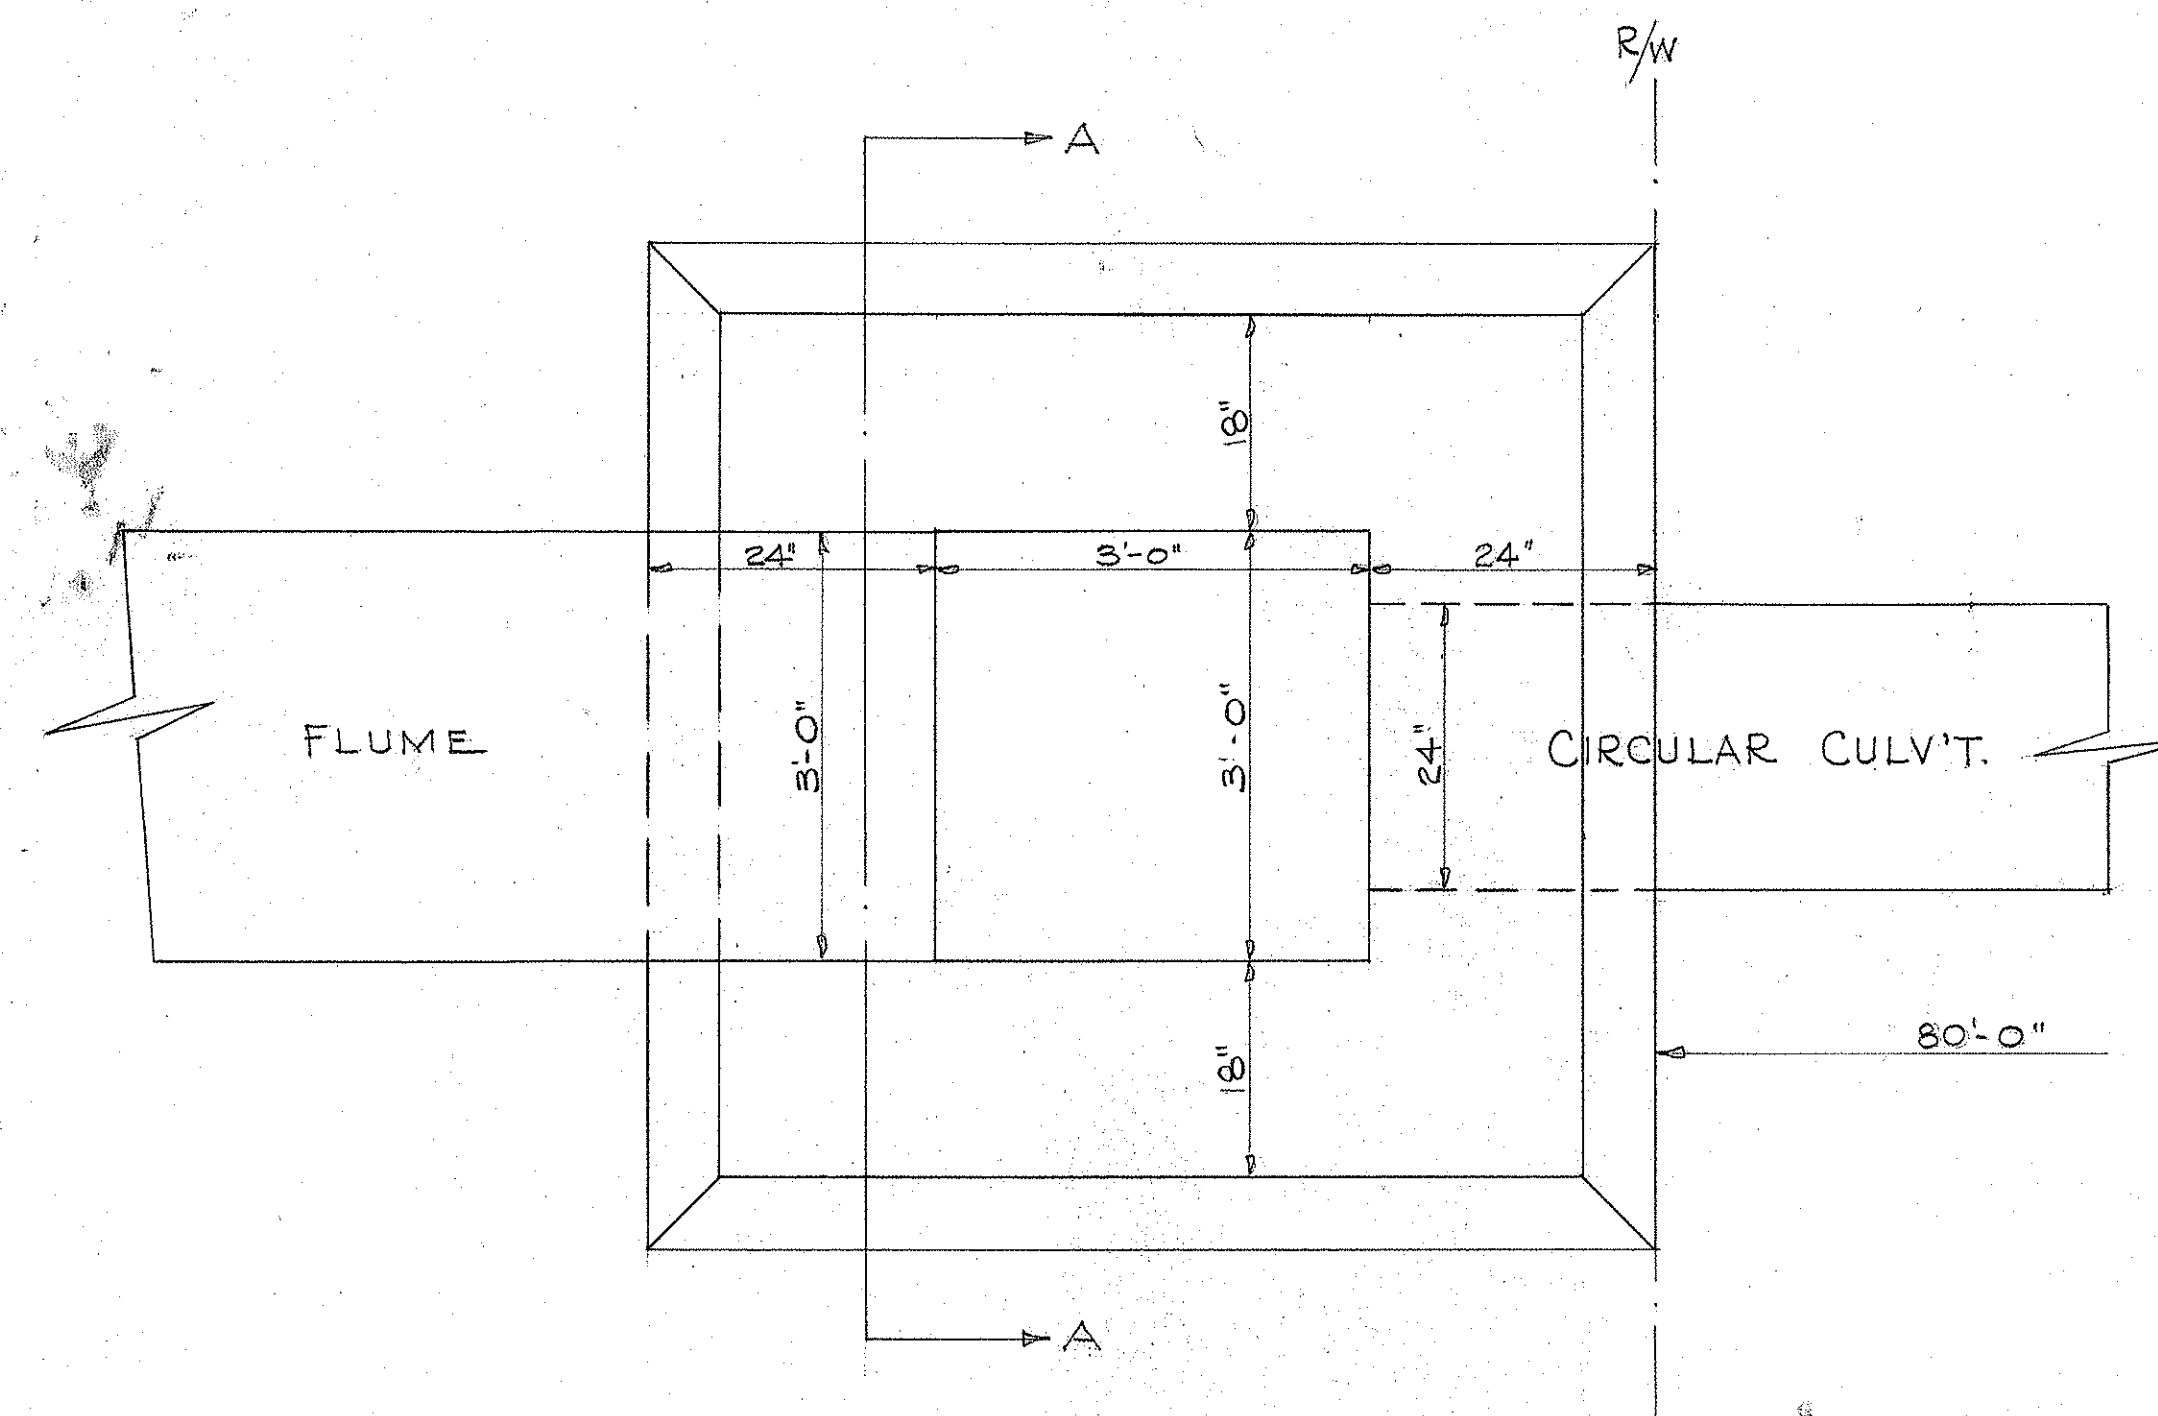

PLAN OF INTAKE
Scale: $\frac{3}{4}$ " = 1'-0"

ESTIMATED QUANTITIES

Excavation - 40 c.y.
Cement Rubble Masonry - 10 c.y.
24" Circ. Culvert - 84 lin. ft.

TERRITORIAL HIGHWAY DEPARTMENT
TERRITORY OF HAWAII

SIPHON AT STA. 63+39

F.A.P. DC. 39-A (2)

OCTOBER 1941

SHEET No. 13 OF 50 SHEETS

5088.13