

INDEX TO DRAWINGS		
COMPOSITE SHEET NO.	DESCRIPTION	SET SHT. NO.
163	TITLE SHEET	1
164 - 165	TYPICAL ROADWAY SECTIONS	2 - 3
166 - 168	PLAN & PROFILE	4 - 6
169 - 170	DETAIL ROADWAY PLANS	7 - 8
171 - 172	PAVEMENT GRADE & GRADING PLANS	9 - 10
46 - 50 173 - 174	ORDER WORK & DETOURS	11 - 12
28 - 31 175 - 176	MISC. ROADWAY DETAILS	13 - 14
176 - 185	UTILITIES; PLANS & DETAILS	14 - 23
46-49 52 186	ROADWAY SIGNS AND LANDSCAPING W/DETAILS	24
60-61 63-65 187 - 189	DESTINATION & EXPRESSWAY SIGNS WITH DETAILS	25 - 27
190 - 191	HIGHWAY LIGHTING	28 - 29
97, 100 192 - 194	DRAINAGE DETAILS	30 - 32
195 - 199	IRRIGATION PLANS & DETAILS	33 - 37
120 200 - 207	PALAILAI INTERCHANGE STRUC. PLANS AND DETAILS	38 - 45
208 - 217	CROSS SECTIONS	46 - 55
(208)	INTERSTATE	(46)
(209 - 212)	ROAD A	(47 - 50)
(213)	ROAD B	(51)
(214)	ROAD C	(52)
(215 - 217)	RAMP CI	(53 - 55)


STATE OF HAWAII
DEPARTMENT OF TRANSPORTATION
HIGHWAYS DIVISION
HONOLULU, HAWAII
"AS BUILT"
PLANS FOR
CONSTRUCTION OF A PORTION OF
INTERSTATE ROUTE H-1
BARBERS POINT TO KUNIA ROAD
(PALAILAI INTERCHANGE)
FEDERAL AID INTERSTATE PROJECT No. I-HI-1(20)

DISTRICT OF EWA
ISLAND OF OAHU

LOCATION OF PROJECT
F.A.I. Project No. I-HI-1(20)

SCALES:
PLAN & PROFILEHOR — 1"= 100'
VER — 1"= 10'

CROSS SECTIONSHOR — 1"= 10'
VER — 1"= 10'

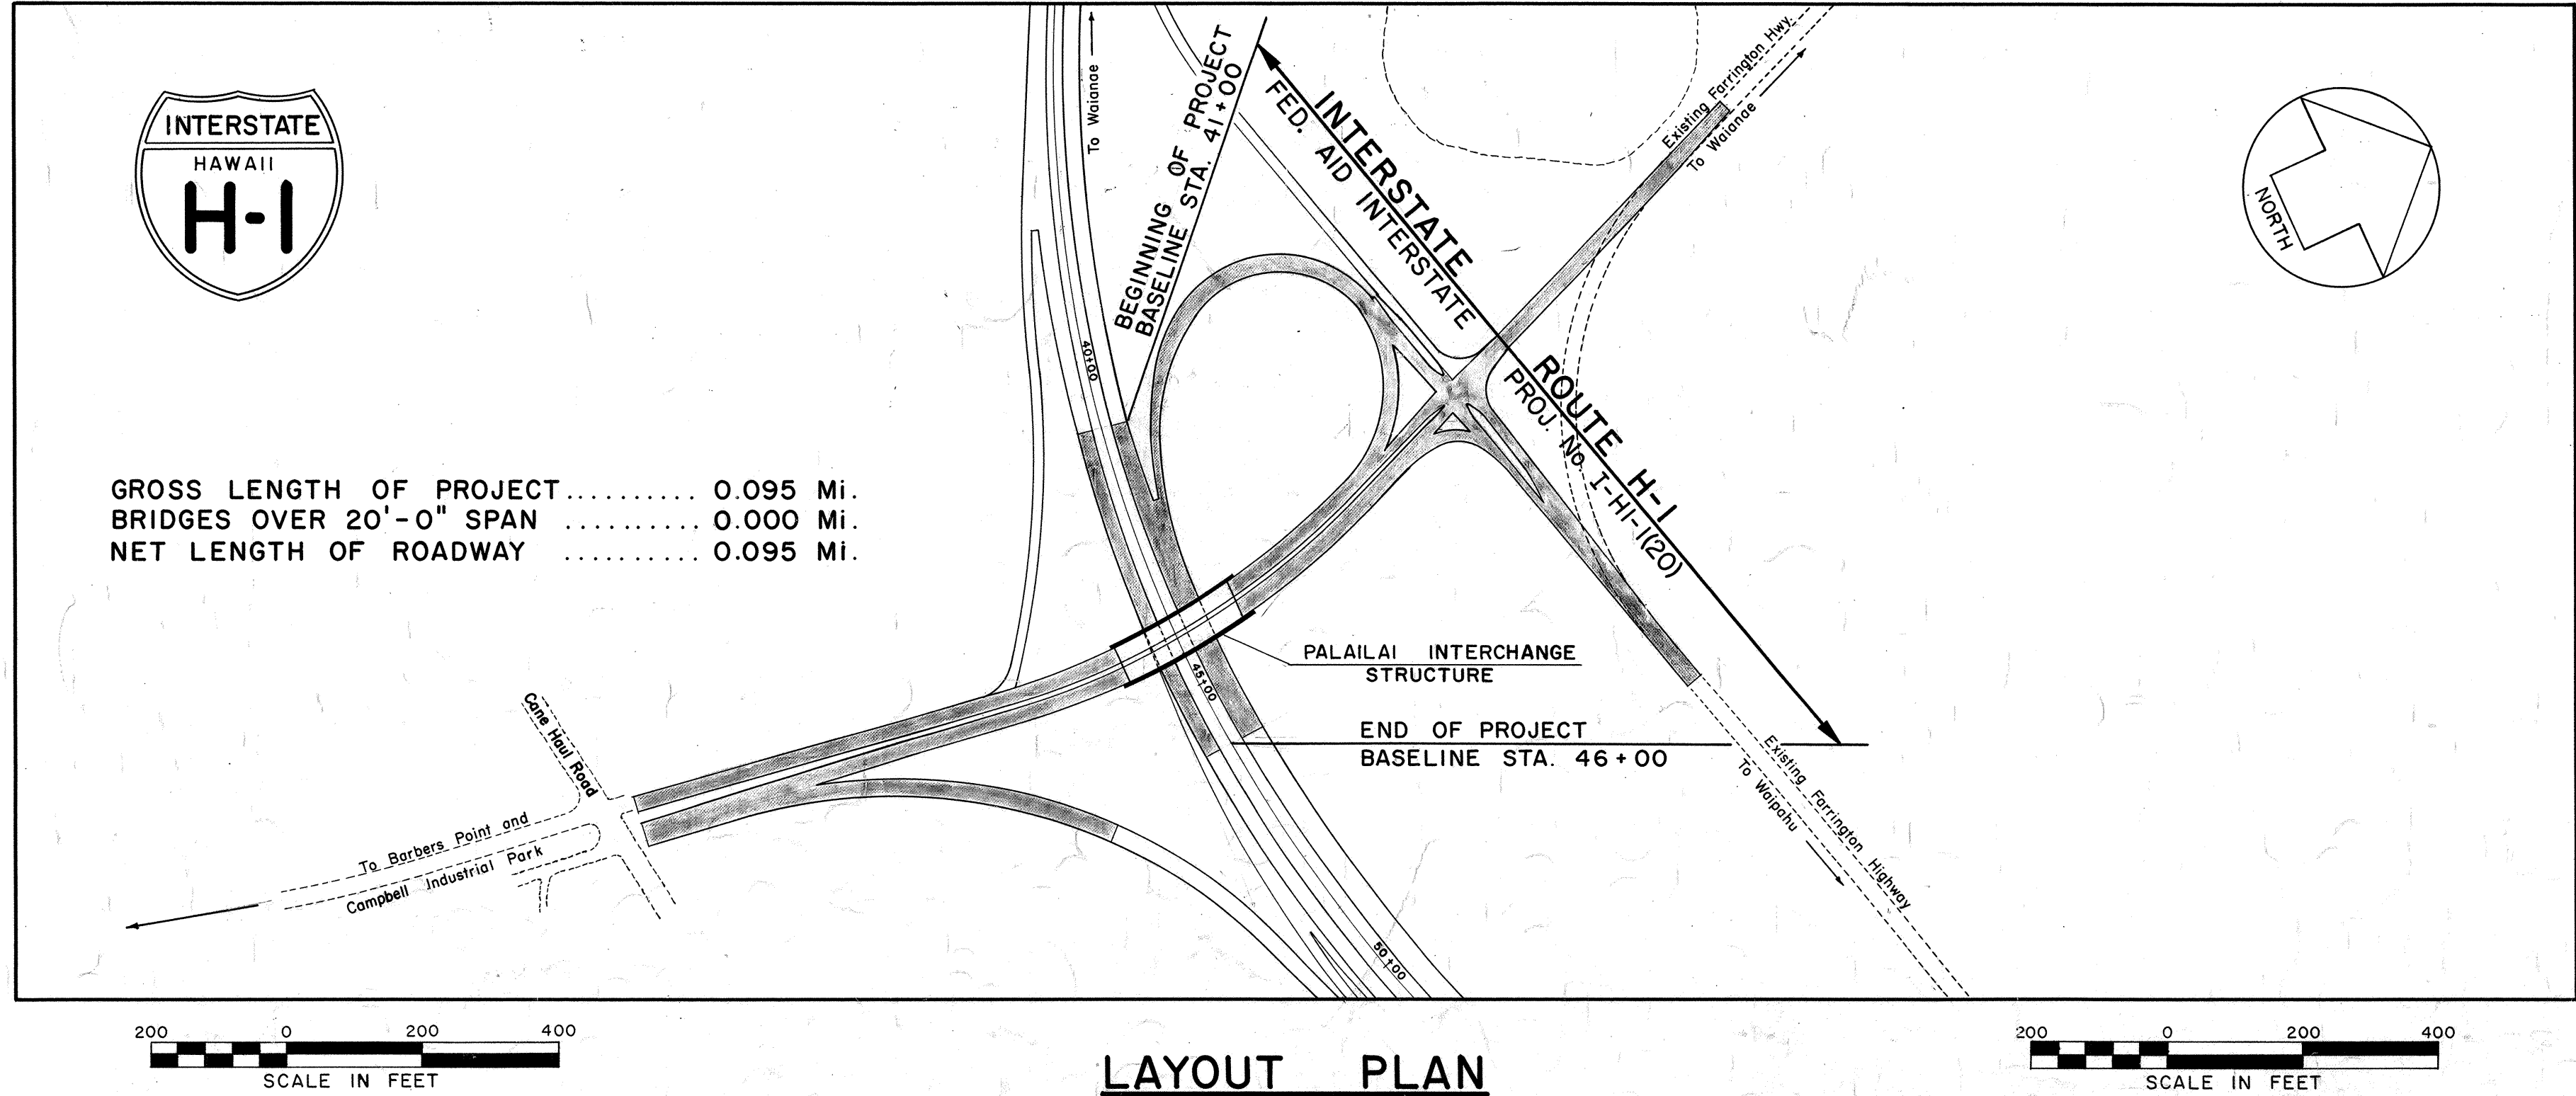

DESIGN CLASSIFICATION

ADT (1965) 0
DESIGN ADT (1985) 22,300
DHV 2,230
D 60/40
T 4 %
V 70 MPH

NOTE:
ALL CHANGES MADE DURING
CONSTRUCTION HAVE BEEN
NOTED IN RED ON THESE
TRACINGS AND CHECKED BY

PROJ. ENG'R
2/19/69
DATE

DEPARTMENT OF TRANSPORTATION
STATE OF HAWAII
APPROVED:

ACTING DIRECTOR

11-3-65
DATE

DEPARTMENT OF COMMERCE
BUREAU OF PUBLIC ROADS
APPROVED:

DIVISION ENGINEER

2-7-66
DATE